



DIST. NO. STATE FED. AID PROJ. NO. FISCAL SHEET NO. SHEETS

MAUI HAW. BR-030-1(37) 2024 36 42

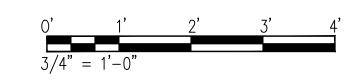

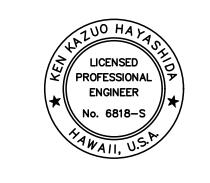

THIS WORK WAS PREPARED BY ME OR UNDER MY SUPERVISION.

APRIL 30, 2026

STATE OF HAWAI'I
DEPARTMENT OF TRANSPORTATION
HIGHWAYS DIVISION

Abutment and Wingwall Sections

<u>Honoapi'ilani Highway</u> <u>Rehabilitation of Honolua Bridge</u> <u>F.A.P No. BR-030-1(37)</u>

Scale: As Shown

Shown Date: August 2024

SHEET No. S4.2 OF 42 SHEETS