



DIST. NO.	STATE	FED. AID PROJ. NO.	FISCAL YEAR	SHEET NO.	TOTAL SHEETS
MAUI	HAW.	BR-030-1(37)	2024	ADD.35	42

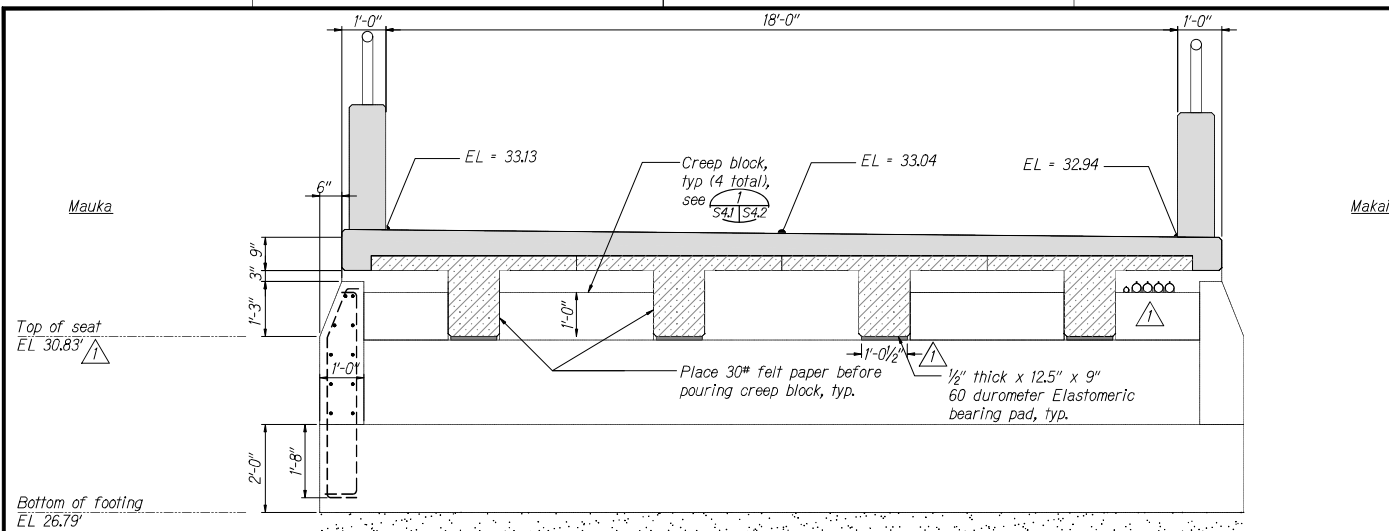

ABUTMENT 1 ELEVATION
Scale: 3/4" = 1'-0"

1
S4J S4J

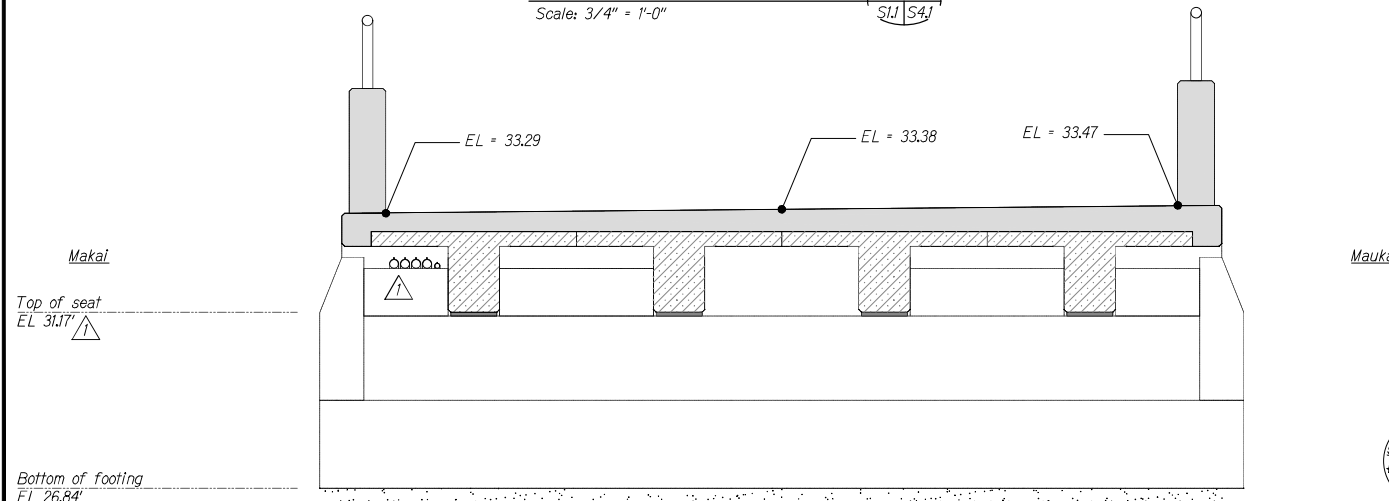

ABUTMENT 2 ELEVATION
Scale: 3/4" = 1'-0"

2
S4J S4J

0' 1' 2' 3' 4'
3/4" = 1'-0"



THIS WORK WAS PREPARED BY
ME OR UNDER MY SUPERVISION
[Signature]
APRIL 30, 2024
LIC. EXP. DATE

11/26/24	Revised bearing pad # elev.
DATE	REVISION

STATE OF HAWAII
DEPARTMENT OF TRANSPORTATION
HIGHWAYS DIVISION

Abutment Elevations

Honoapi'ilani Highway
Rehabilitation of Honolua Bridge
F.A.P. No. BR-030-1(37)

Scale: As Shown Date: August 2024
SHEET No. S4J OF 42 SHEETS

ADD.35

DESIGNED BY	SAFETY CHECKED BY
DRAWN BY	REVIEWED BY
CHECKED BY	APPROVED BY
IN CHARGE	
DATE	