



DIST. NO.	STATE	FED. AID PROJ. NO.	FISCAL YEAR	SHEET NO.	TOTAL SHEETS
MAUI	HAW.	BR-030-1 (37)	2024	ADD.34	42

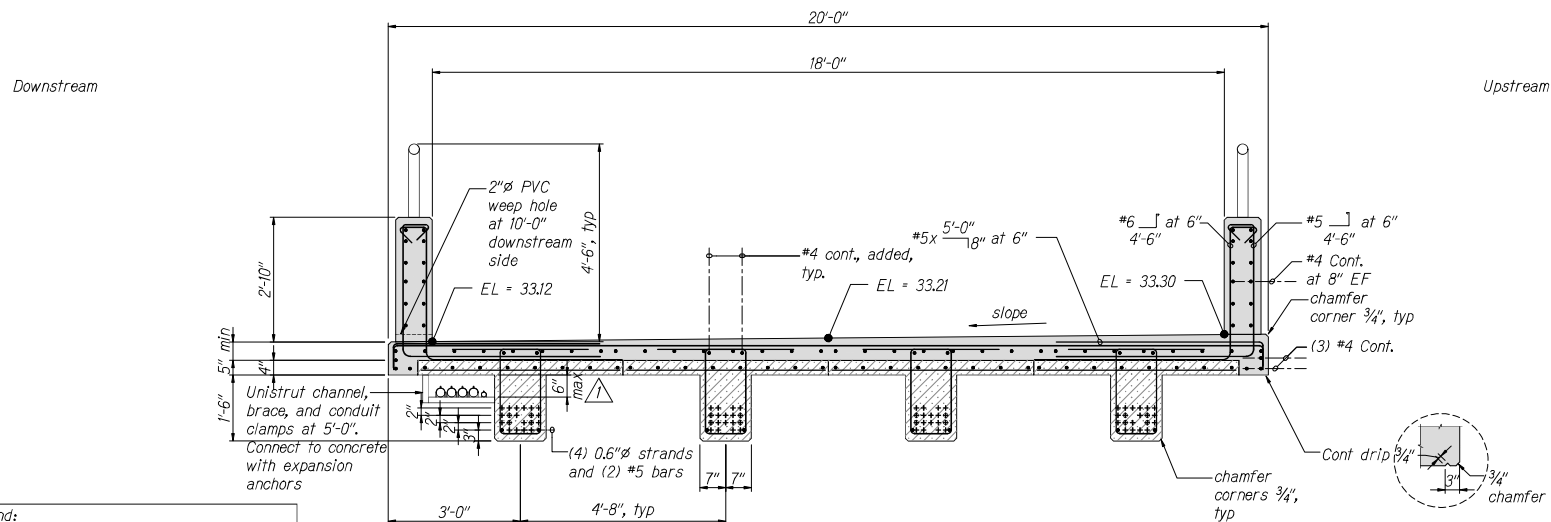


Legend:

- 0.6"Ø strands
- 0.6"Ø strands masked at each end

SECTION AT MIDSPAN 1
Scale: 3/4" = 1'-0" S11, S22 | S32

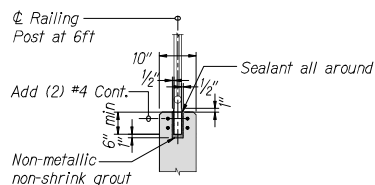

POST EMBEDMENT DETAIL 2
Scale: 3/4" = 1'-0" S32 | S32

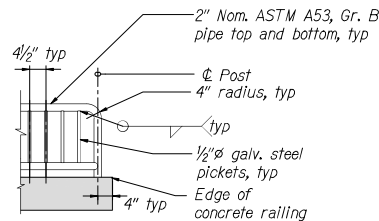

TYPICAL GUARDRAIL END DETAIL 3
Scale: 3/4" = 1'-0" S32 | S32



THIS WORK WAS PREPARED BY ME OR UNDER MY SUPERVISION
[Signature]
APRIL 30, 2024
LIC. EXP. DATE

11/26/24	Added dimension
DATE	REVISION

STATE OF HAWAII
DEPARTMENT OF TRANSPORTATION
HIGHWAYS DIVISION

Bridge Cross Sections

Honoapi'ilani Highway
Rehabilitation of Honolua Bridge
F.A.P. No. BR-030-1137

Scale: As Shown Date: August 2024
SHEET No. S32 OF 42 SHEETS

0' 1' 2' 3' 4'
3/4" = 1'-0"

ADD.34