



FED. ROAD DIST. NO.	STATE	PROJ. NO.	FISCAL YEAR	SHEET NO.	TOTAL SHEETS
HAWAII	HAW.	30A-03-04M	2004	6	9

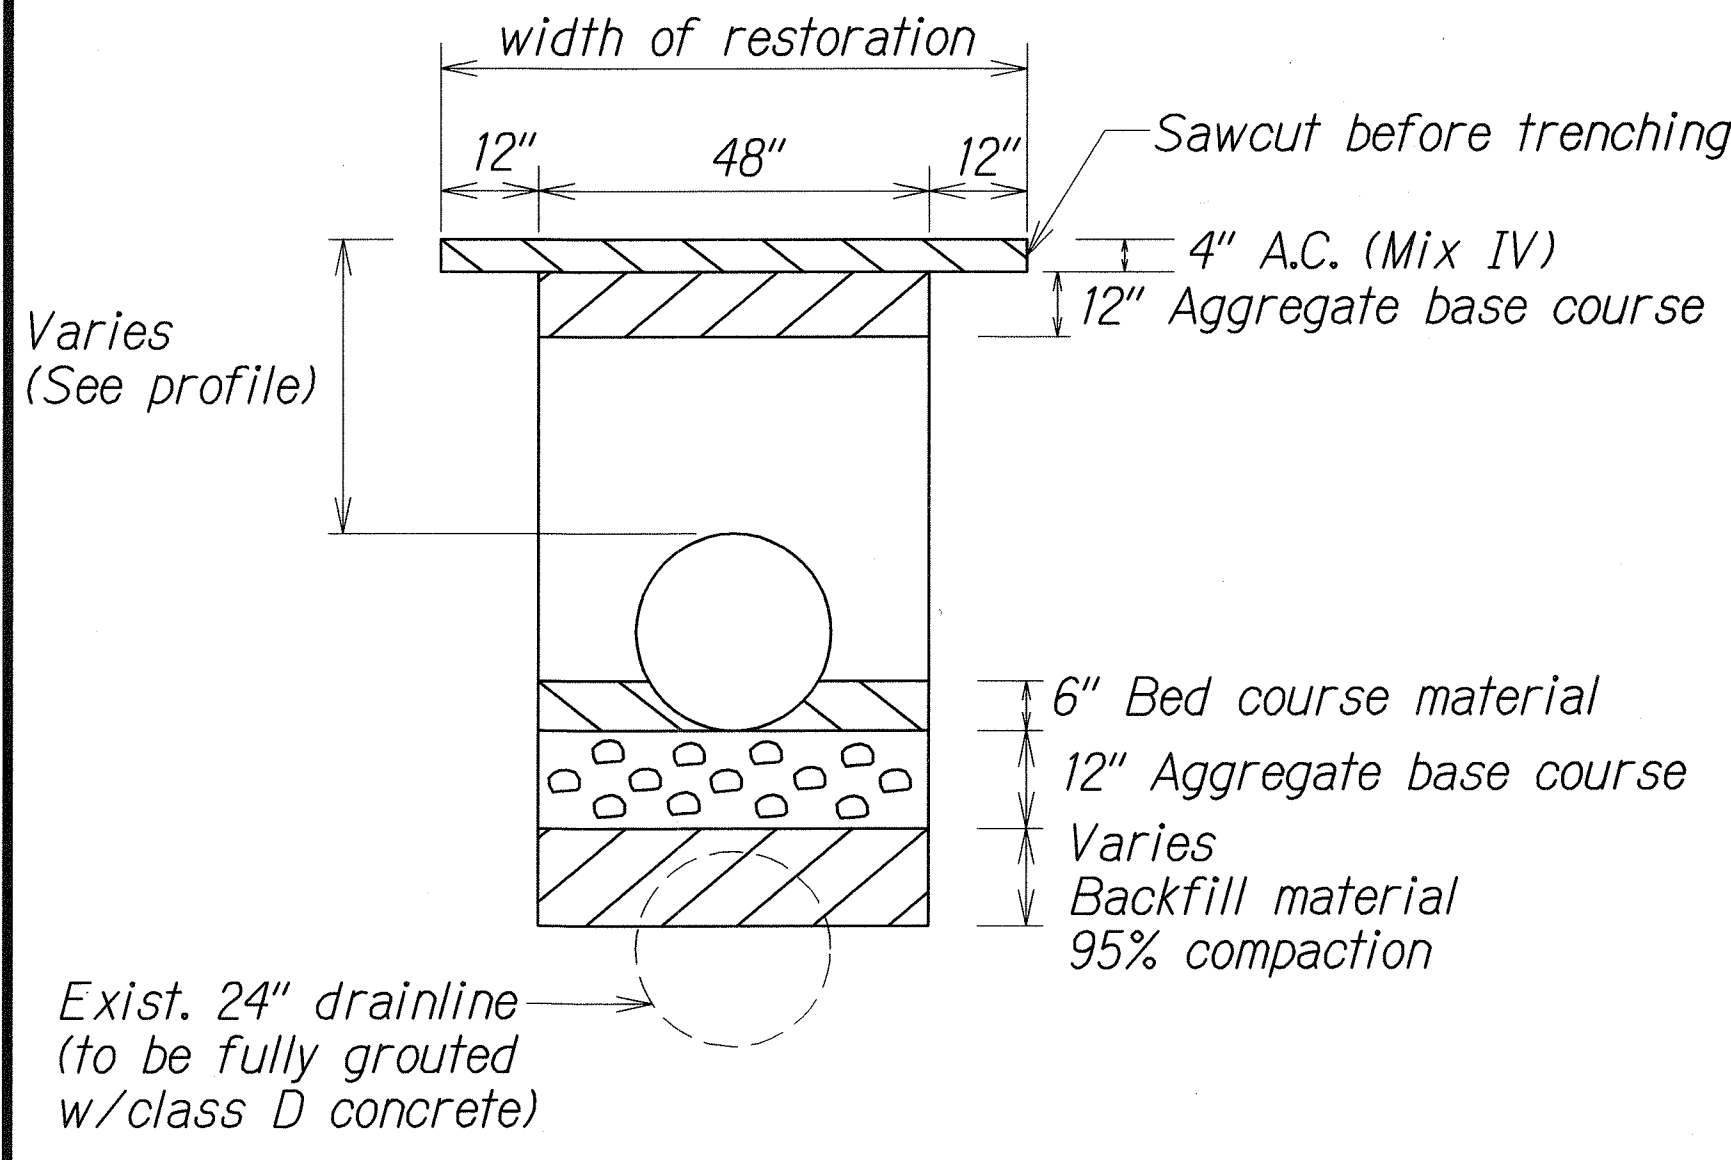


TRENCH RESTORATION DETAIL
Not To Scale

Sta. 0+00
Construct Hand-Laid Riprap and Extend The New Concrete Headwall (Top, Left and Right Side)

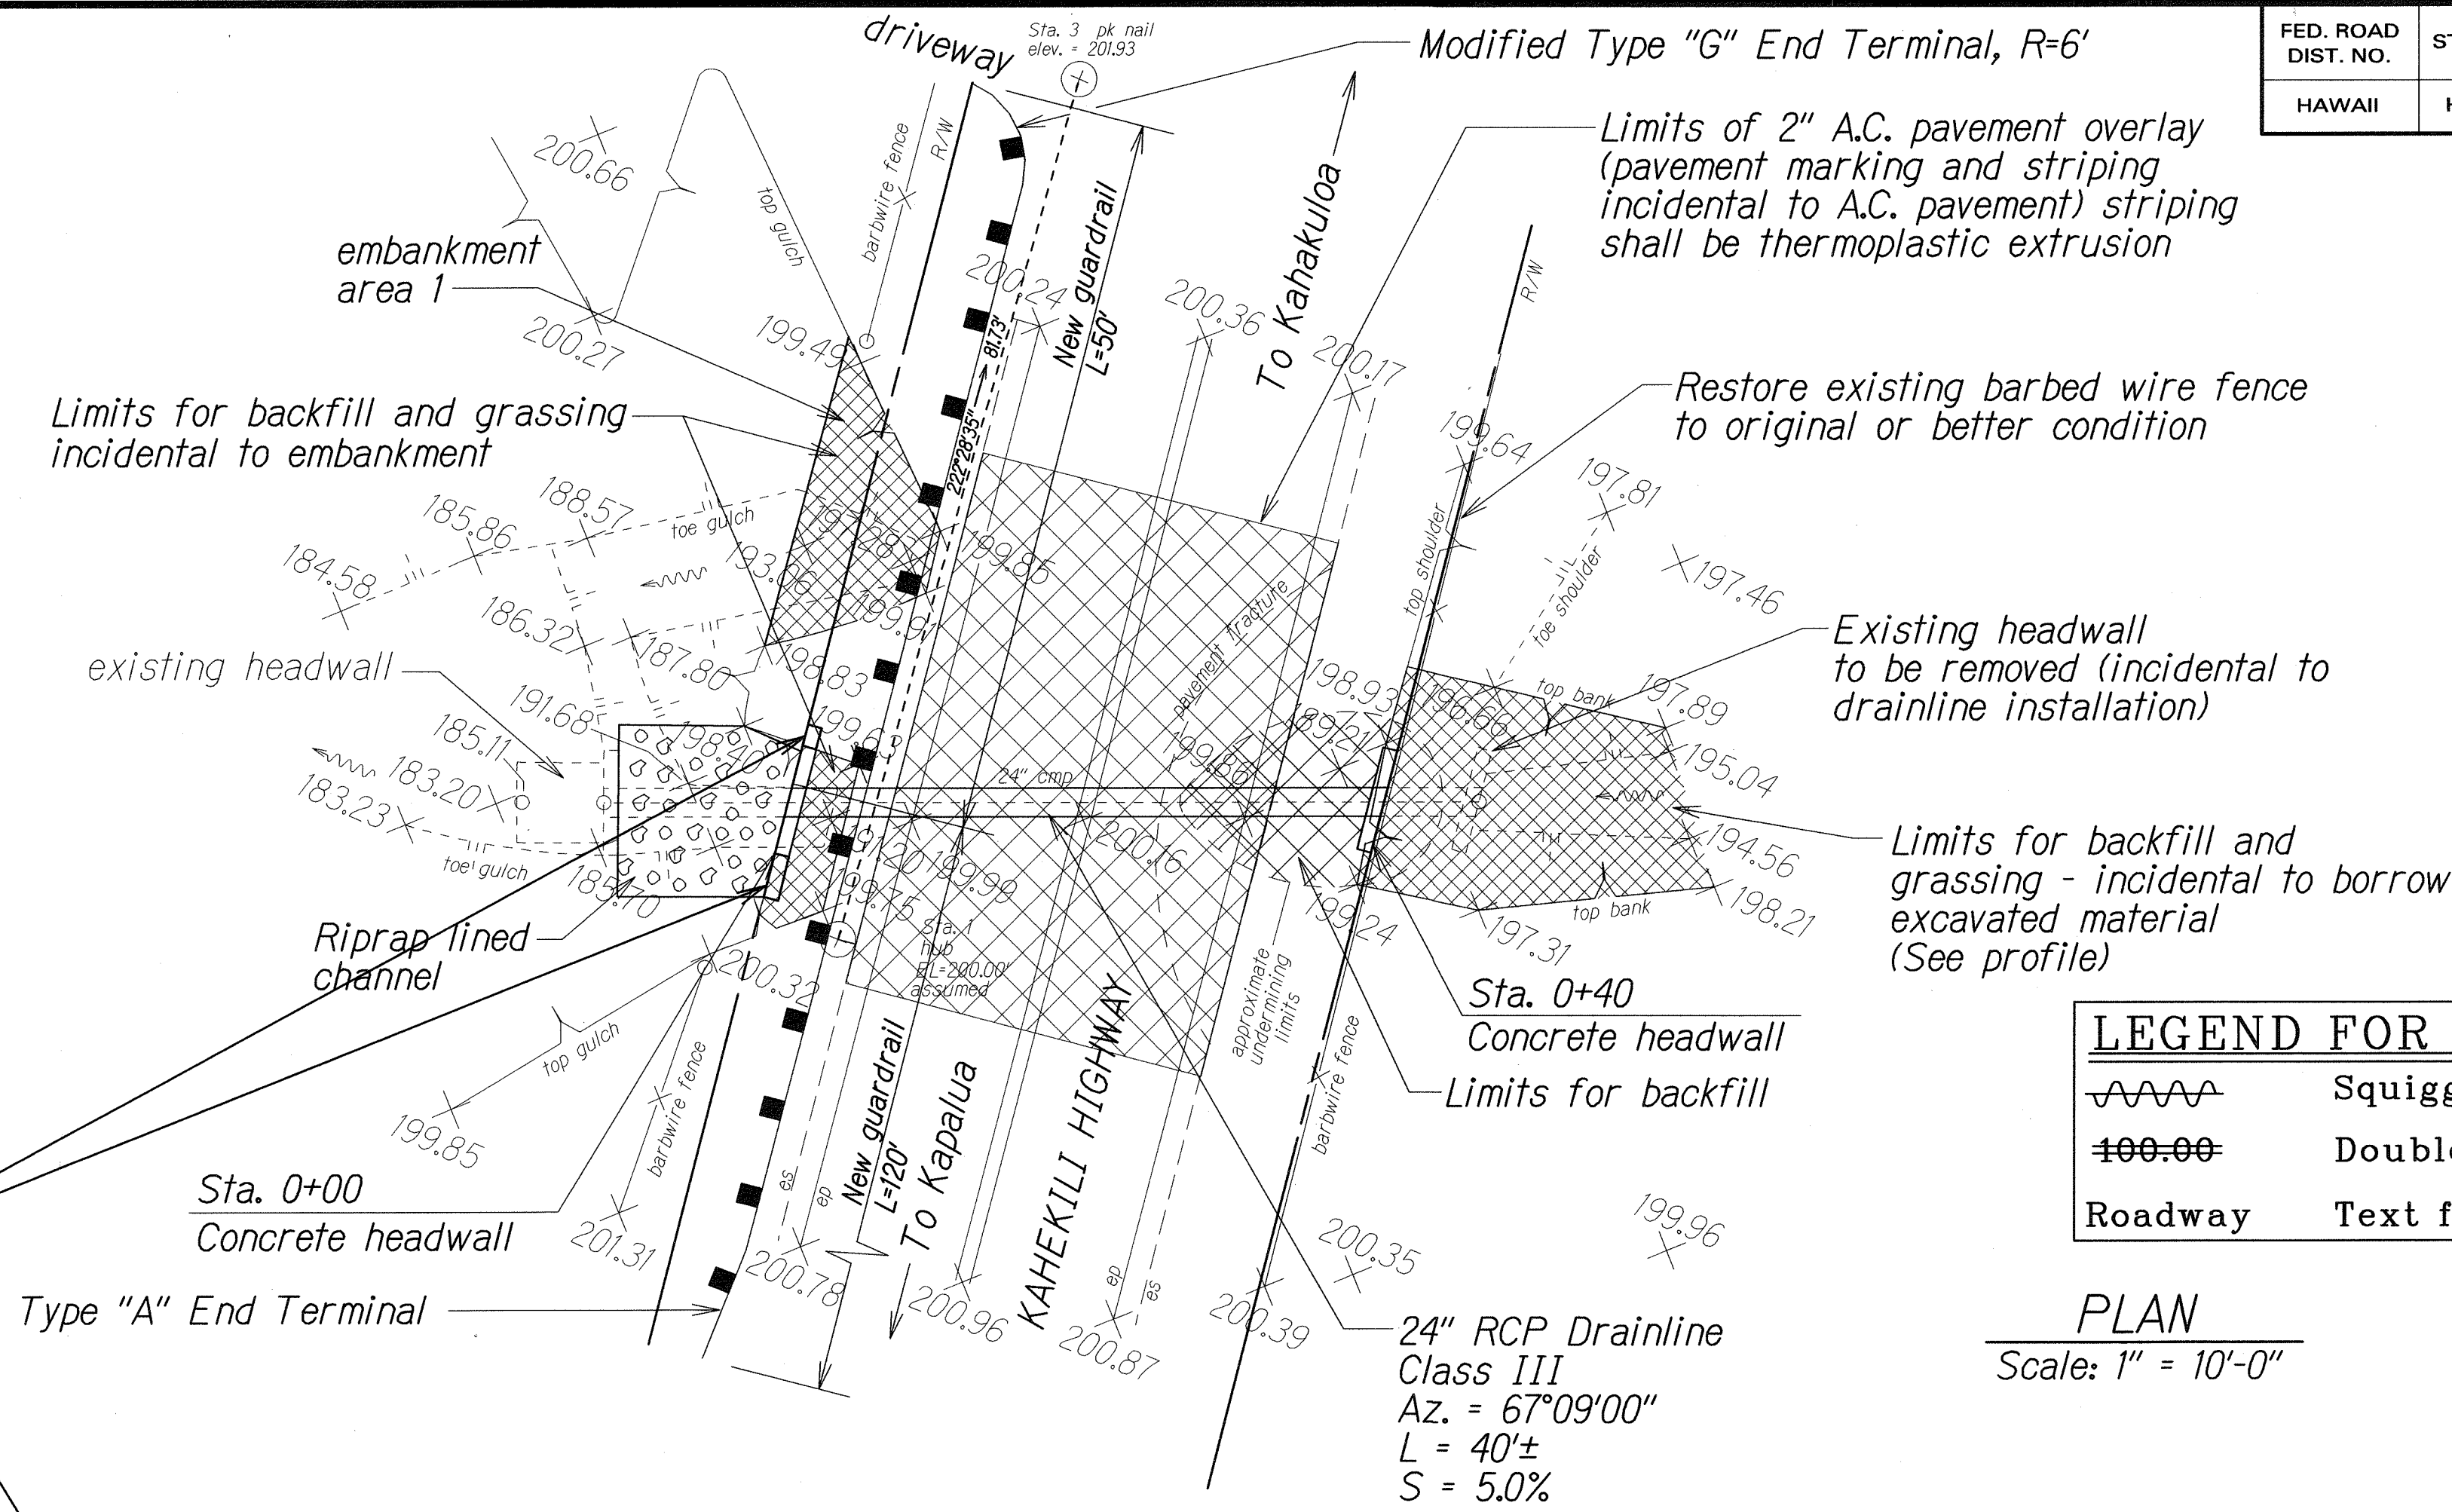

LEGEND FOR AS-BUILT POSTINGS	
	Squiggly line for as-built deletion
	Double line for as-built deletion
Roadway	Text for as-built posting

PLAN
Scale: 1" = 10'-0"

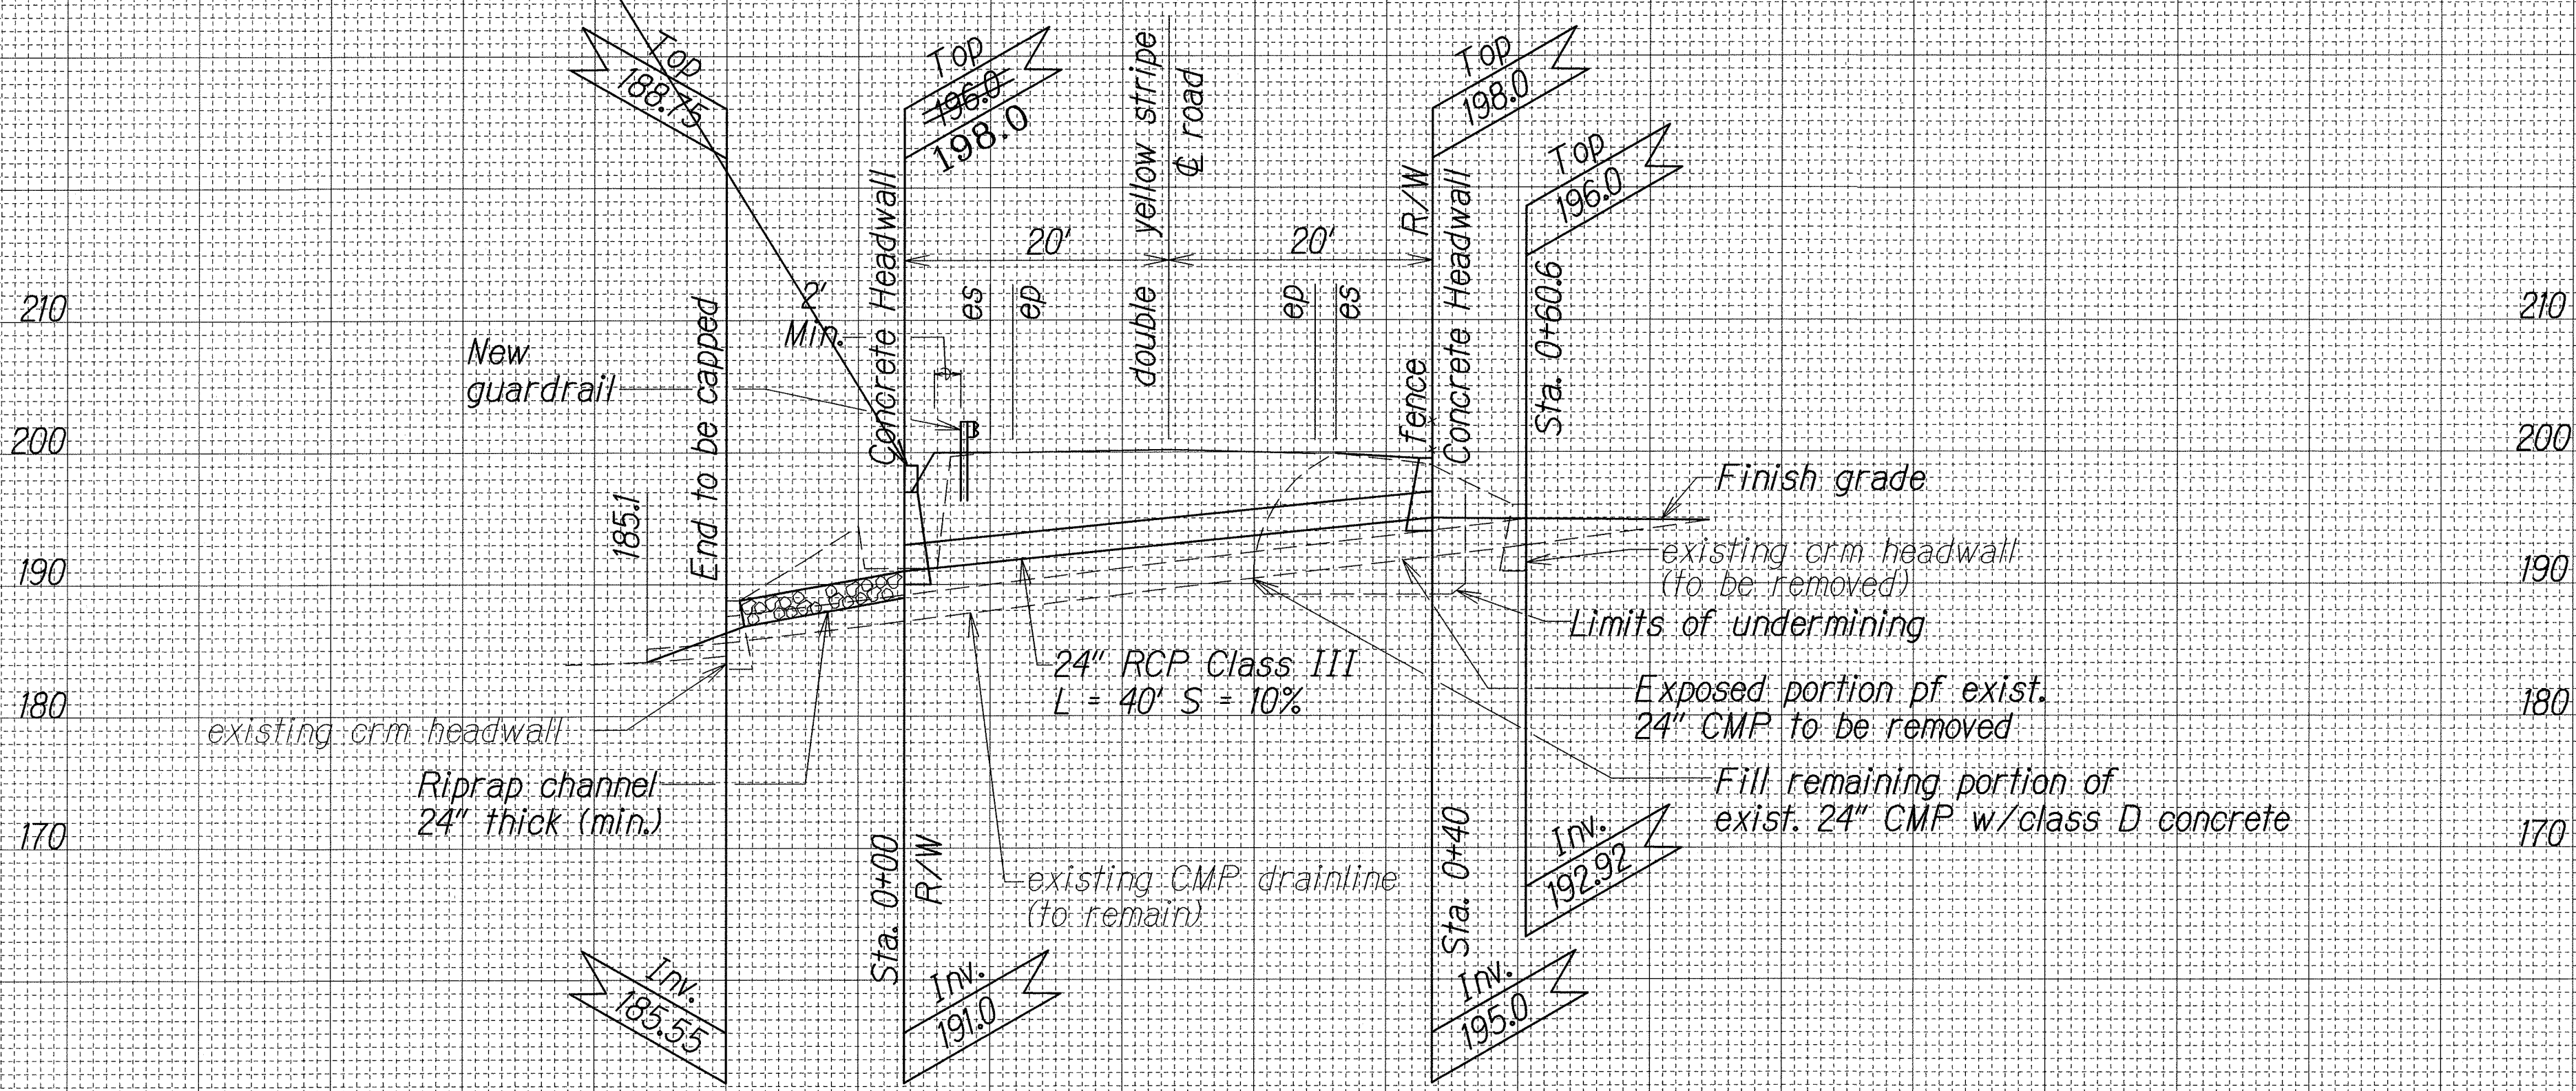

PROFILE - 24" CMP CULVERT
Scale: Horiz. 1" = 10'
Vert. 1" = 10'

STATE OF HAWAII
DEPARTMENT OF TRANSPORTATION
HIGHWAYS DIVISION

DRAINAGE PLAN

**KAHEKILI HIGHWAY DRAINAGE
REPAIRS AT MILEPOST 38.10**

Project No. 30A-03-04M

Scale: As Shown Date: January, 2004

SHEET No. 1 OF 1 SHEETS

"AS-BUILT"