

INDEX TO DRAWINGS	
SHEET NO.	DESCRIPTION
1	TITLE SHEET
2	STANDARD PLANS SUMMARY
3	GENERAL NOTES AND LEGEND
4 - 5	WATER POLLUTION & EROSION CONTROL NOTES
6 - 7	TYPICAL SECTIONS AND DETAILS
8 - 12	GUARDRAIL DETAILS
13 - 21	ROADWAY PLANS
22	PAVEMENT MARKING LEGEND, DETAILS & NOTES
23 - 25	RUMBLE STRIP DETAILS & NOTES
26 - 28	TRAFFIC COUNTING STATION DETAILS
29	WORK ZONE SIGNING PLAN, NOTES & DETAILS
30 - 31	SIGN PANEL LAYOUTS
32 - 40	SIGNING AND PAVEMENT MARKING PLANS

STATE OF HAWAII

DEPARTMENT OF TRANSPORTATION

HIGHWAYS DIVISION

HONOLULU, HAWAII

"AS-BUILT"

PLANS FOR

HONOAPIILANI HIGHWAY RESURFACING




VICINITY OF HOOHUI ROAD TO PLANTATION ESTATES GOLF COURSE

PROJECT NO. 30A-01-10M

DISTRICT OF LAHAINA

ISLAND OF MAUI

FED. ROAD DIST. NO.	STATE	PROJ. NO.	FISCAL YEAR	SHEET NO.	TOTAL SHEETS
HAWAII	HAW.	30A-01-10M	2011	1	40

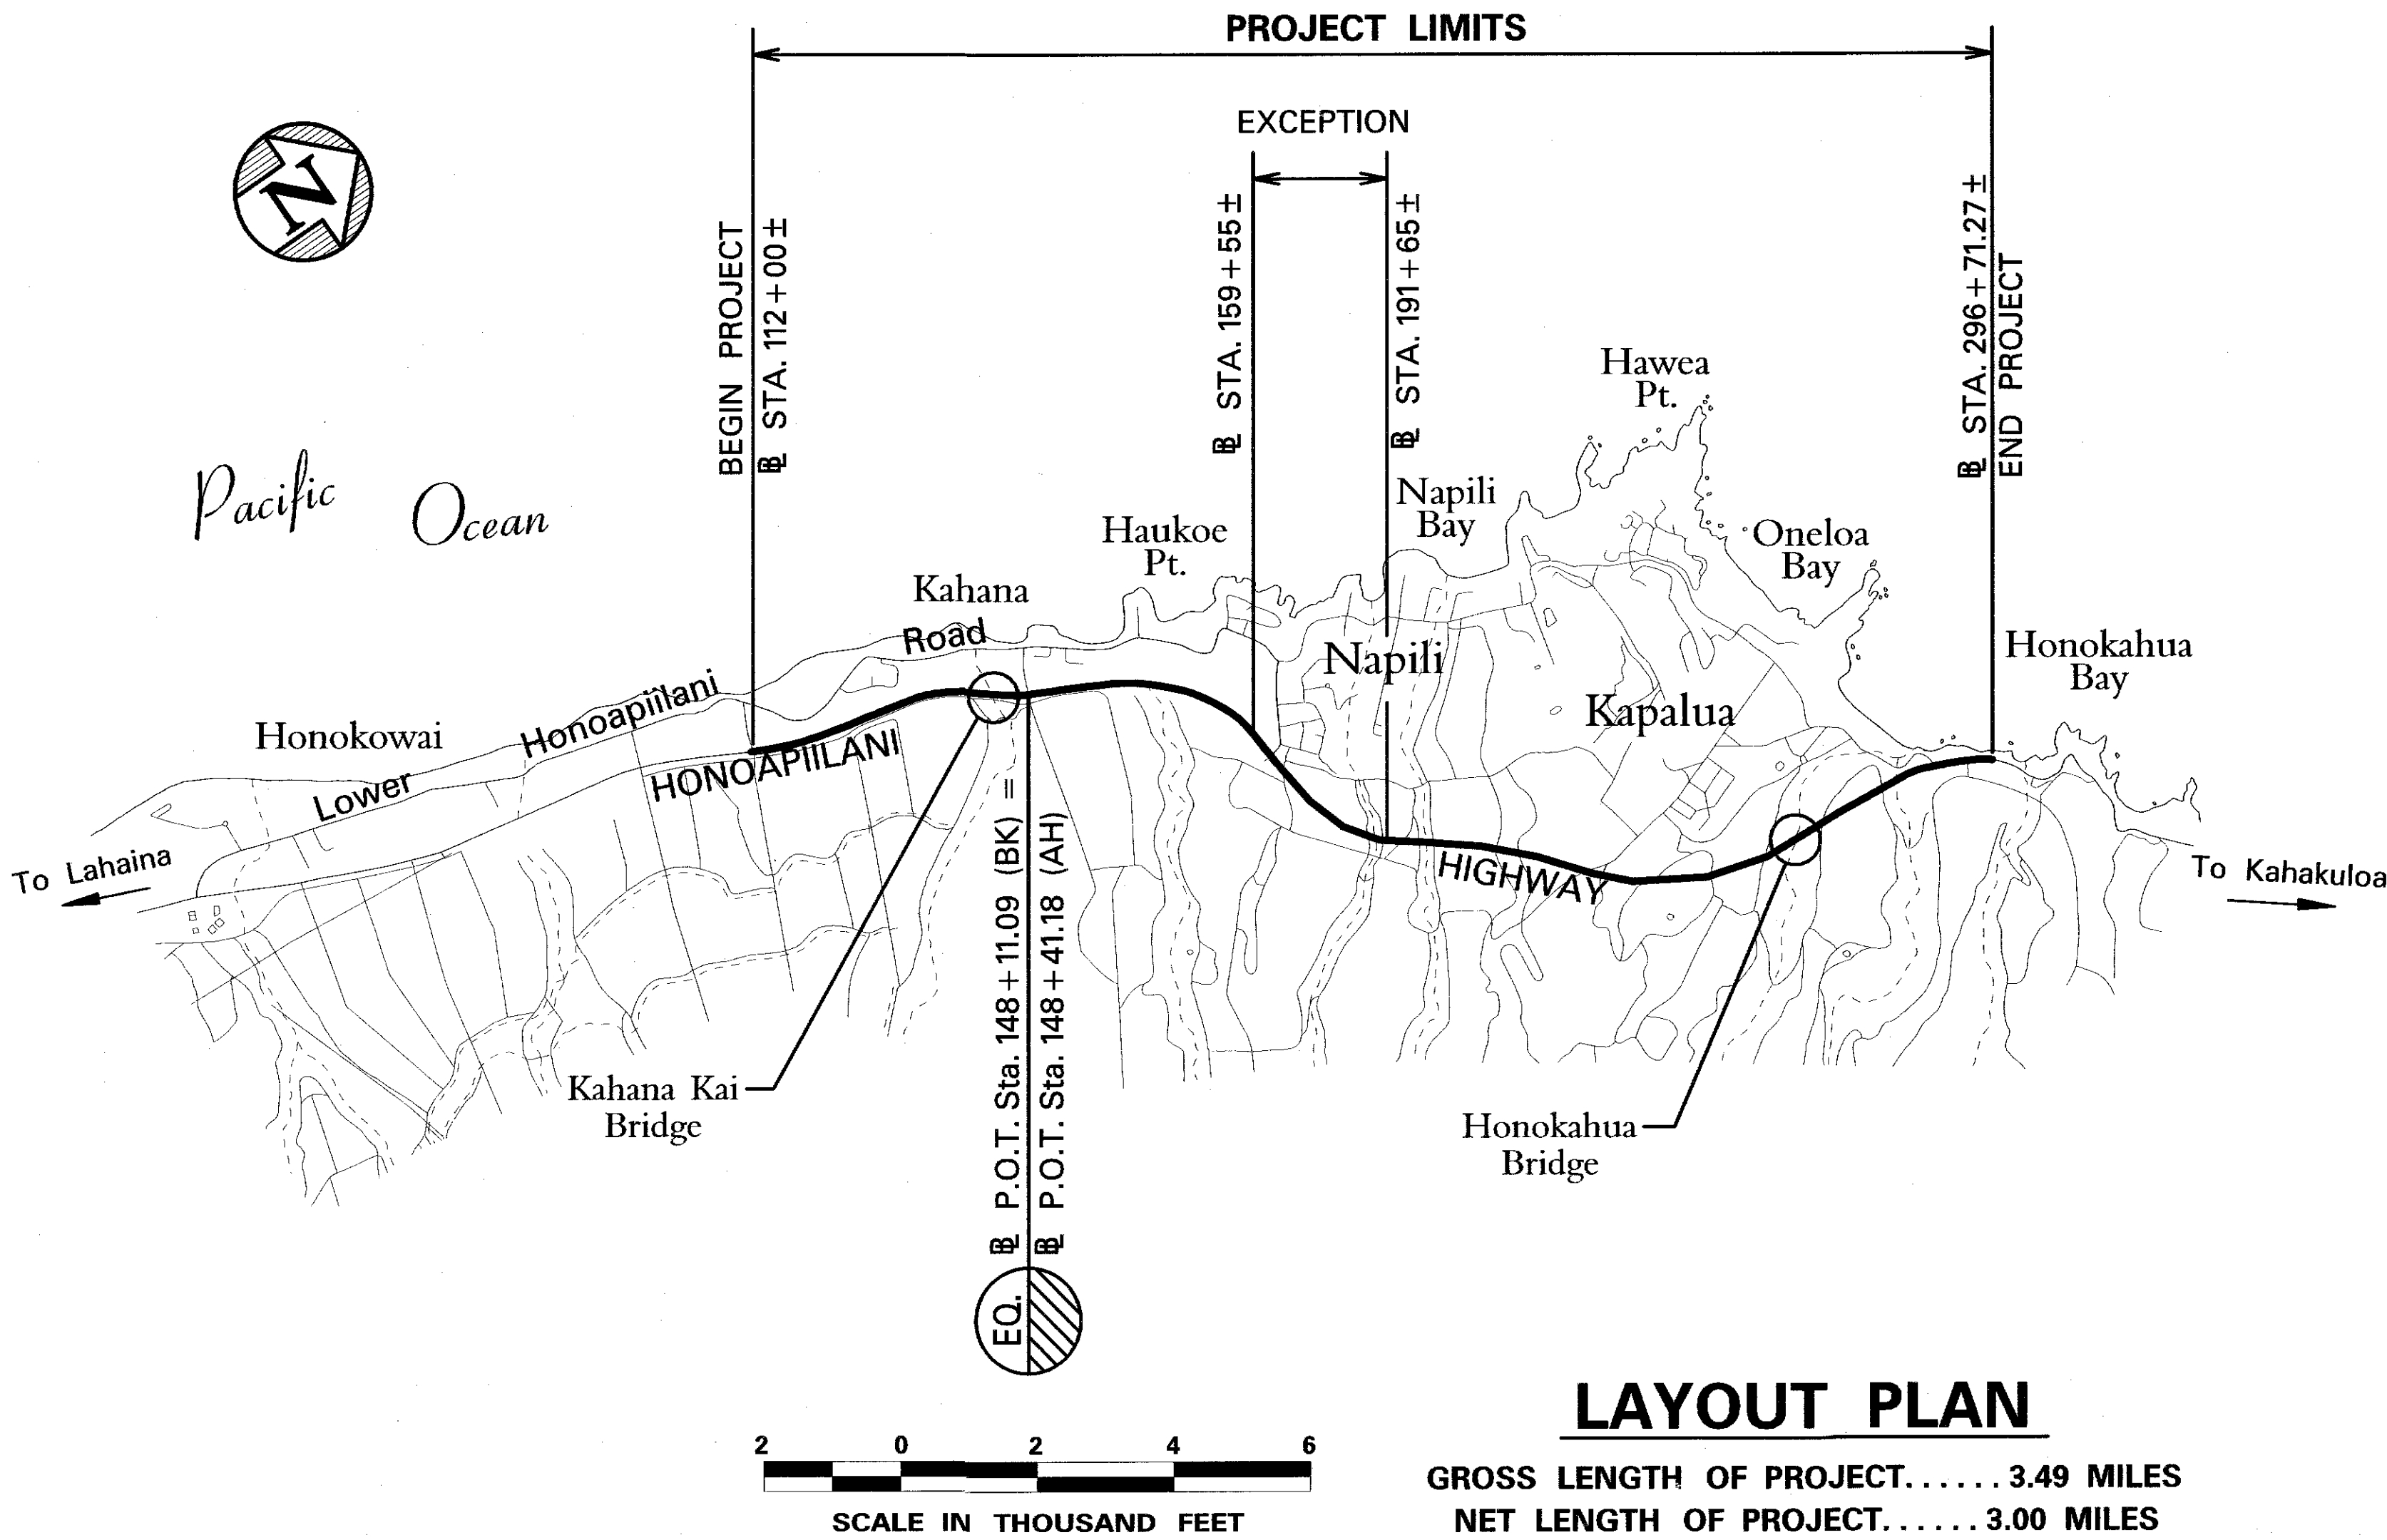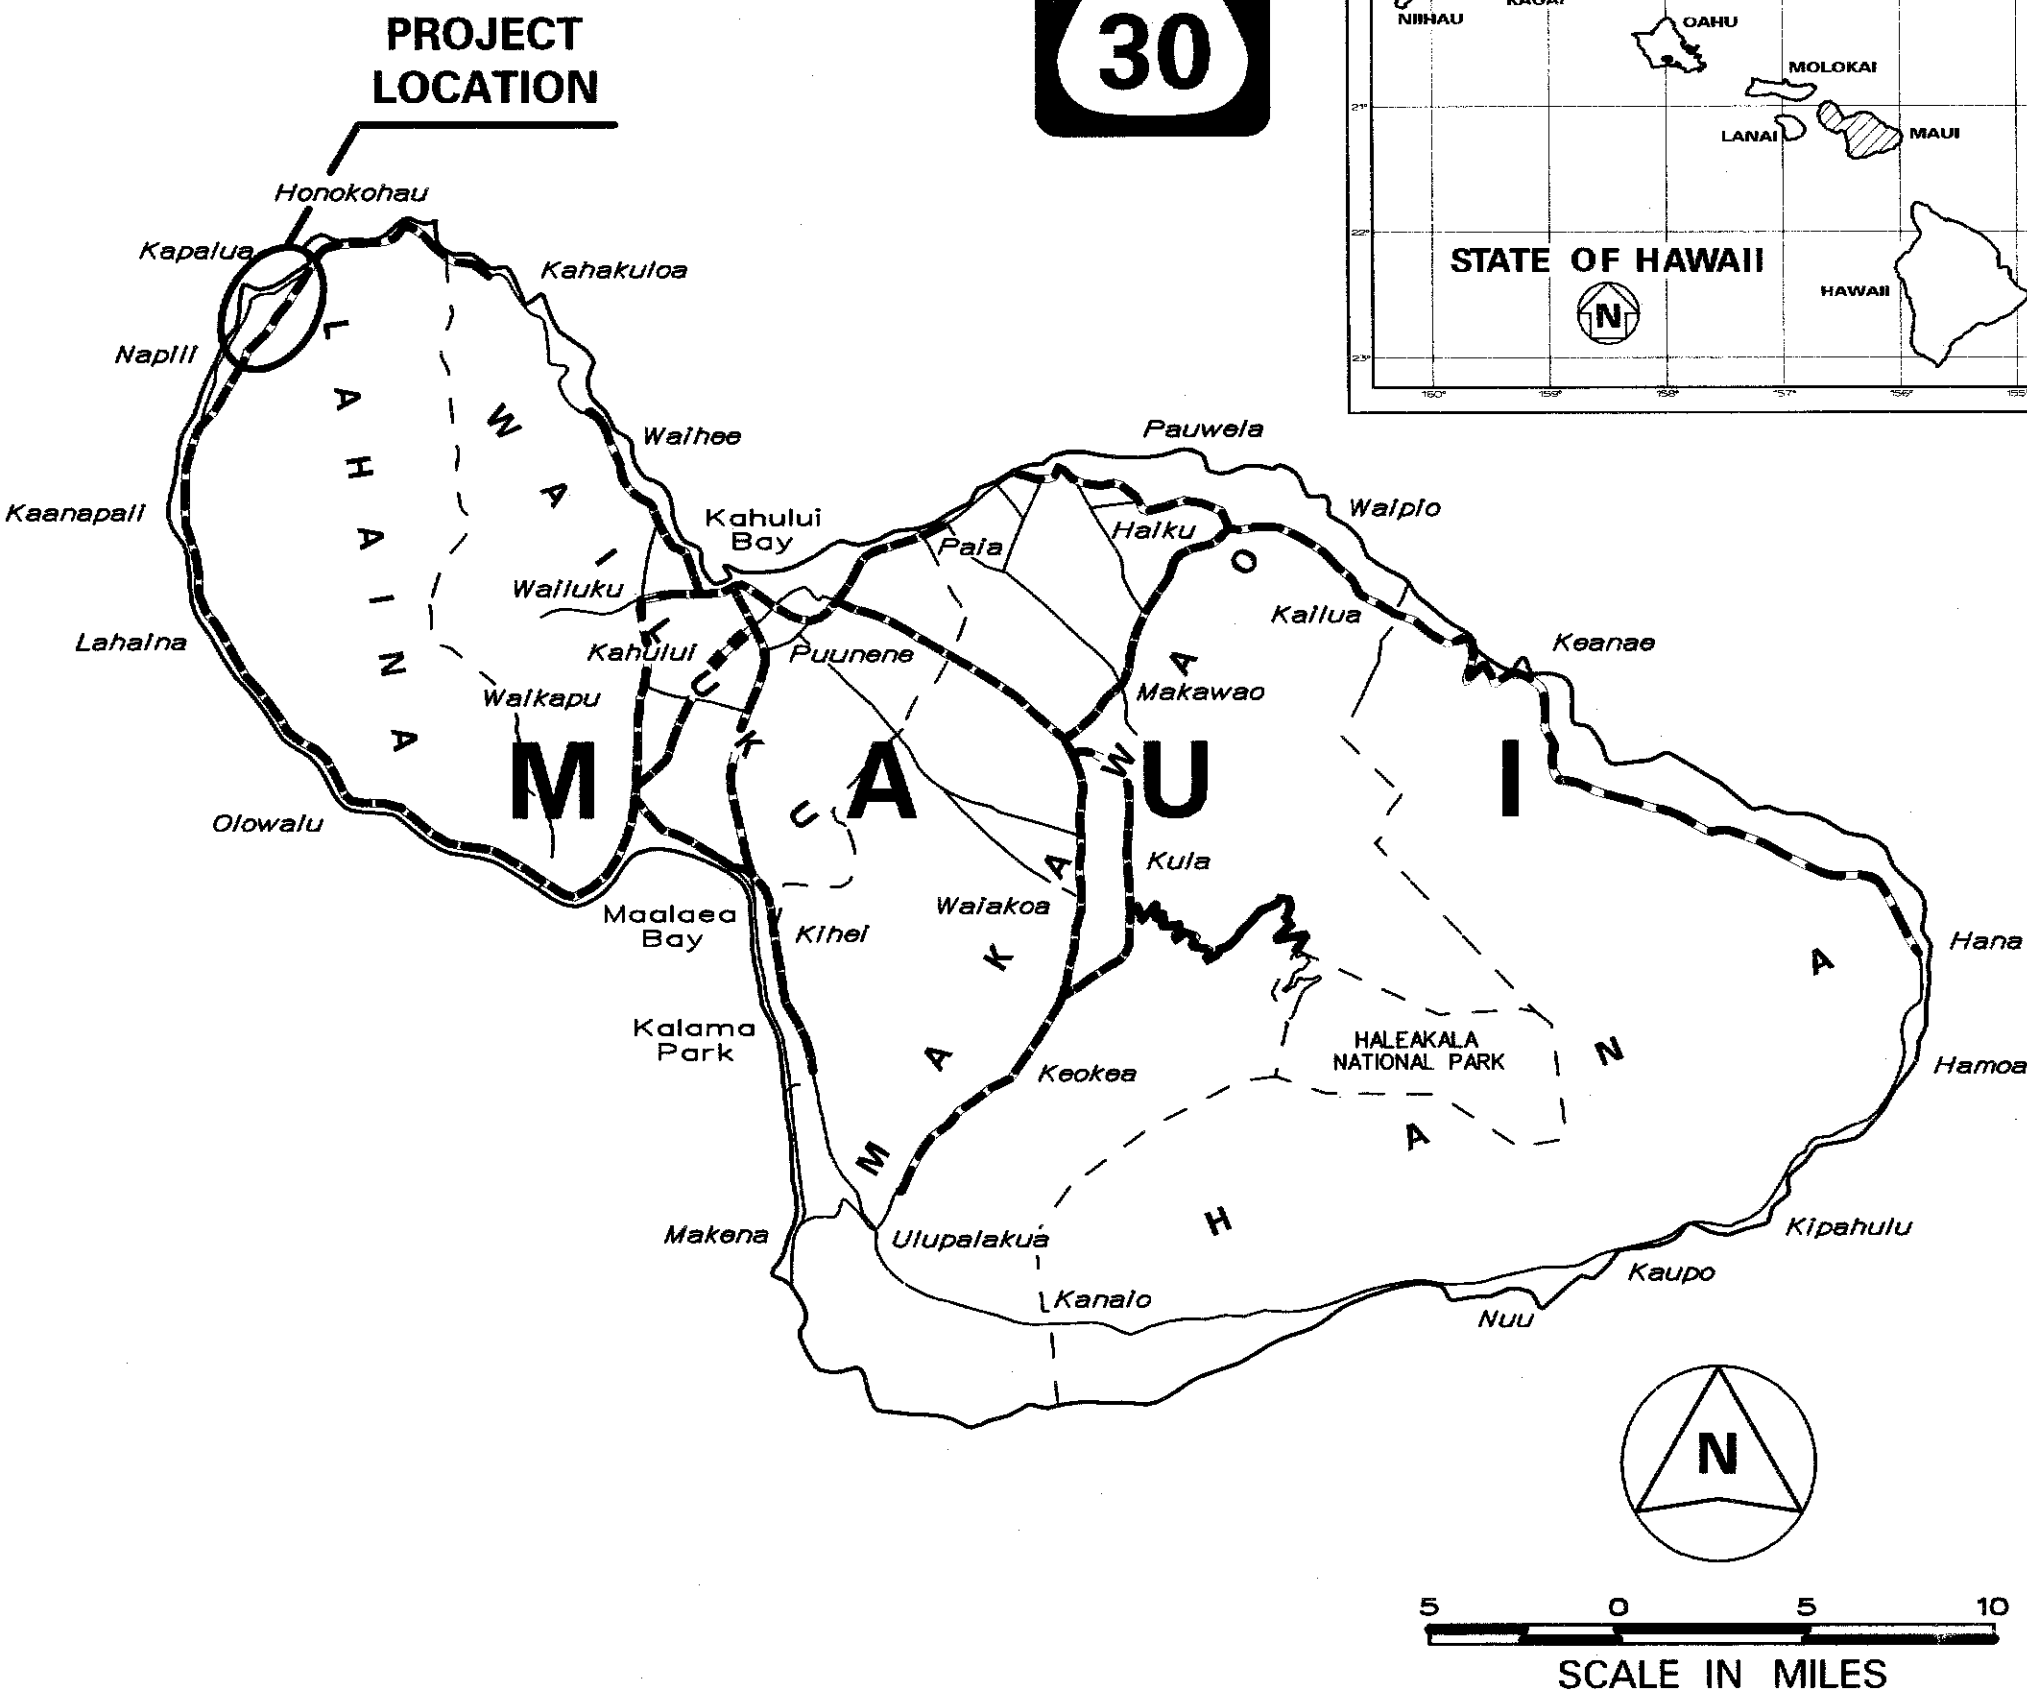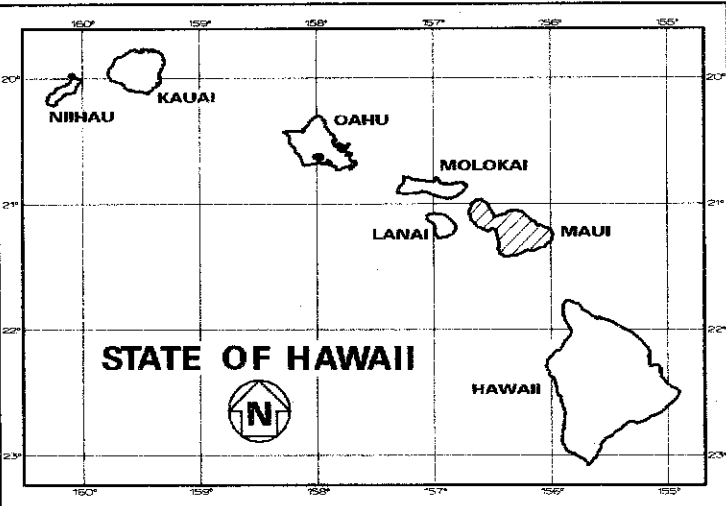

----- FEDERAL AID PROJECTS PREVIOUSLY CONSTRUCTED OR UNDER CONSTRUCTION
 MILE POST 27.74 TO MILE POST 31.23

HWY-DD DESIGNED BY _____
 HWY-DD MANAGED BY _____
 692-7570 PHONE _____
 OCT. 2010 DATE _____

LAYOUT PLAN
 GROSS LENGTH OF PROJECT..... 3.49 MILES
 NET LENGTH OF PROJECT..... 3.00 MILES

CHANGES MADE DURING CONSTRUCTION HAVE BEEN INCORPORATED ON THESE PLANS EXCEPT CHANGES IN THE ORIGINAL THEORETICAL QUANTITIES. FOR ACTUAL QUANTITIES, REFER TO PROJECT LEDGER AND/OR COMPUTATION BOOK.
 [Signature] 12/28/16
 RESIDENT ENGINEER DATE

DEPARTMENT OF TRANSPORTATION
 STATE OF HAWAII
 APPROVED: [Signature]
 DIR. OF TRANSPORTATION SEP 30 2010 DATE