


FED. ROAD DIST. NO.	STATE	PROJ. NO.	FISCAL YEAR	SHEET NO.	TOTAL SHEETS
HAWAII	HAW.	30A-01-10M	2011	13	40

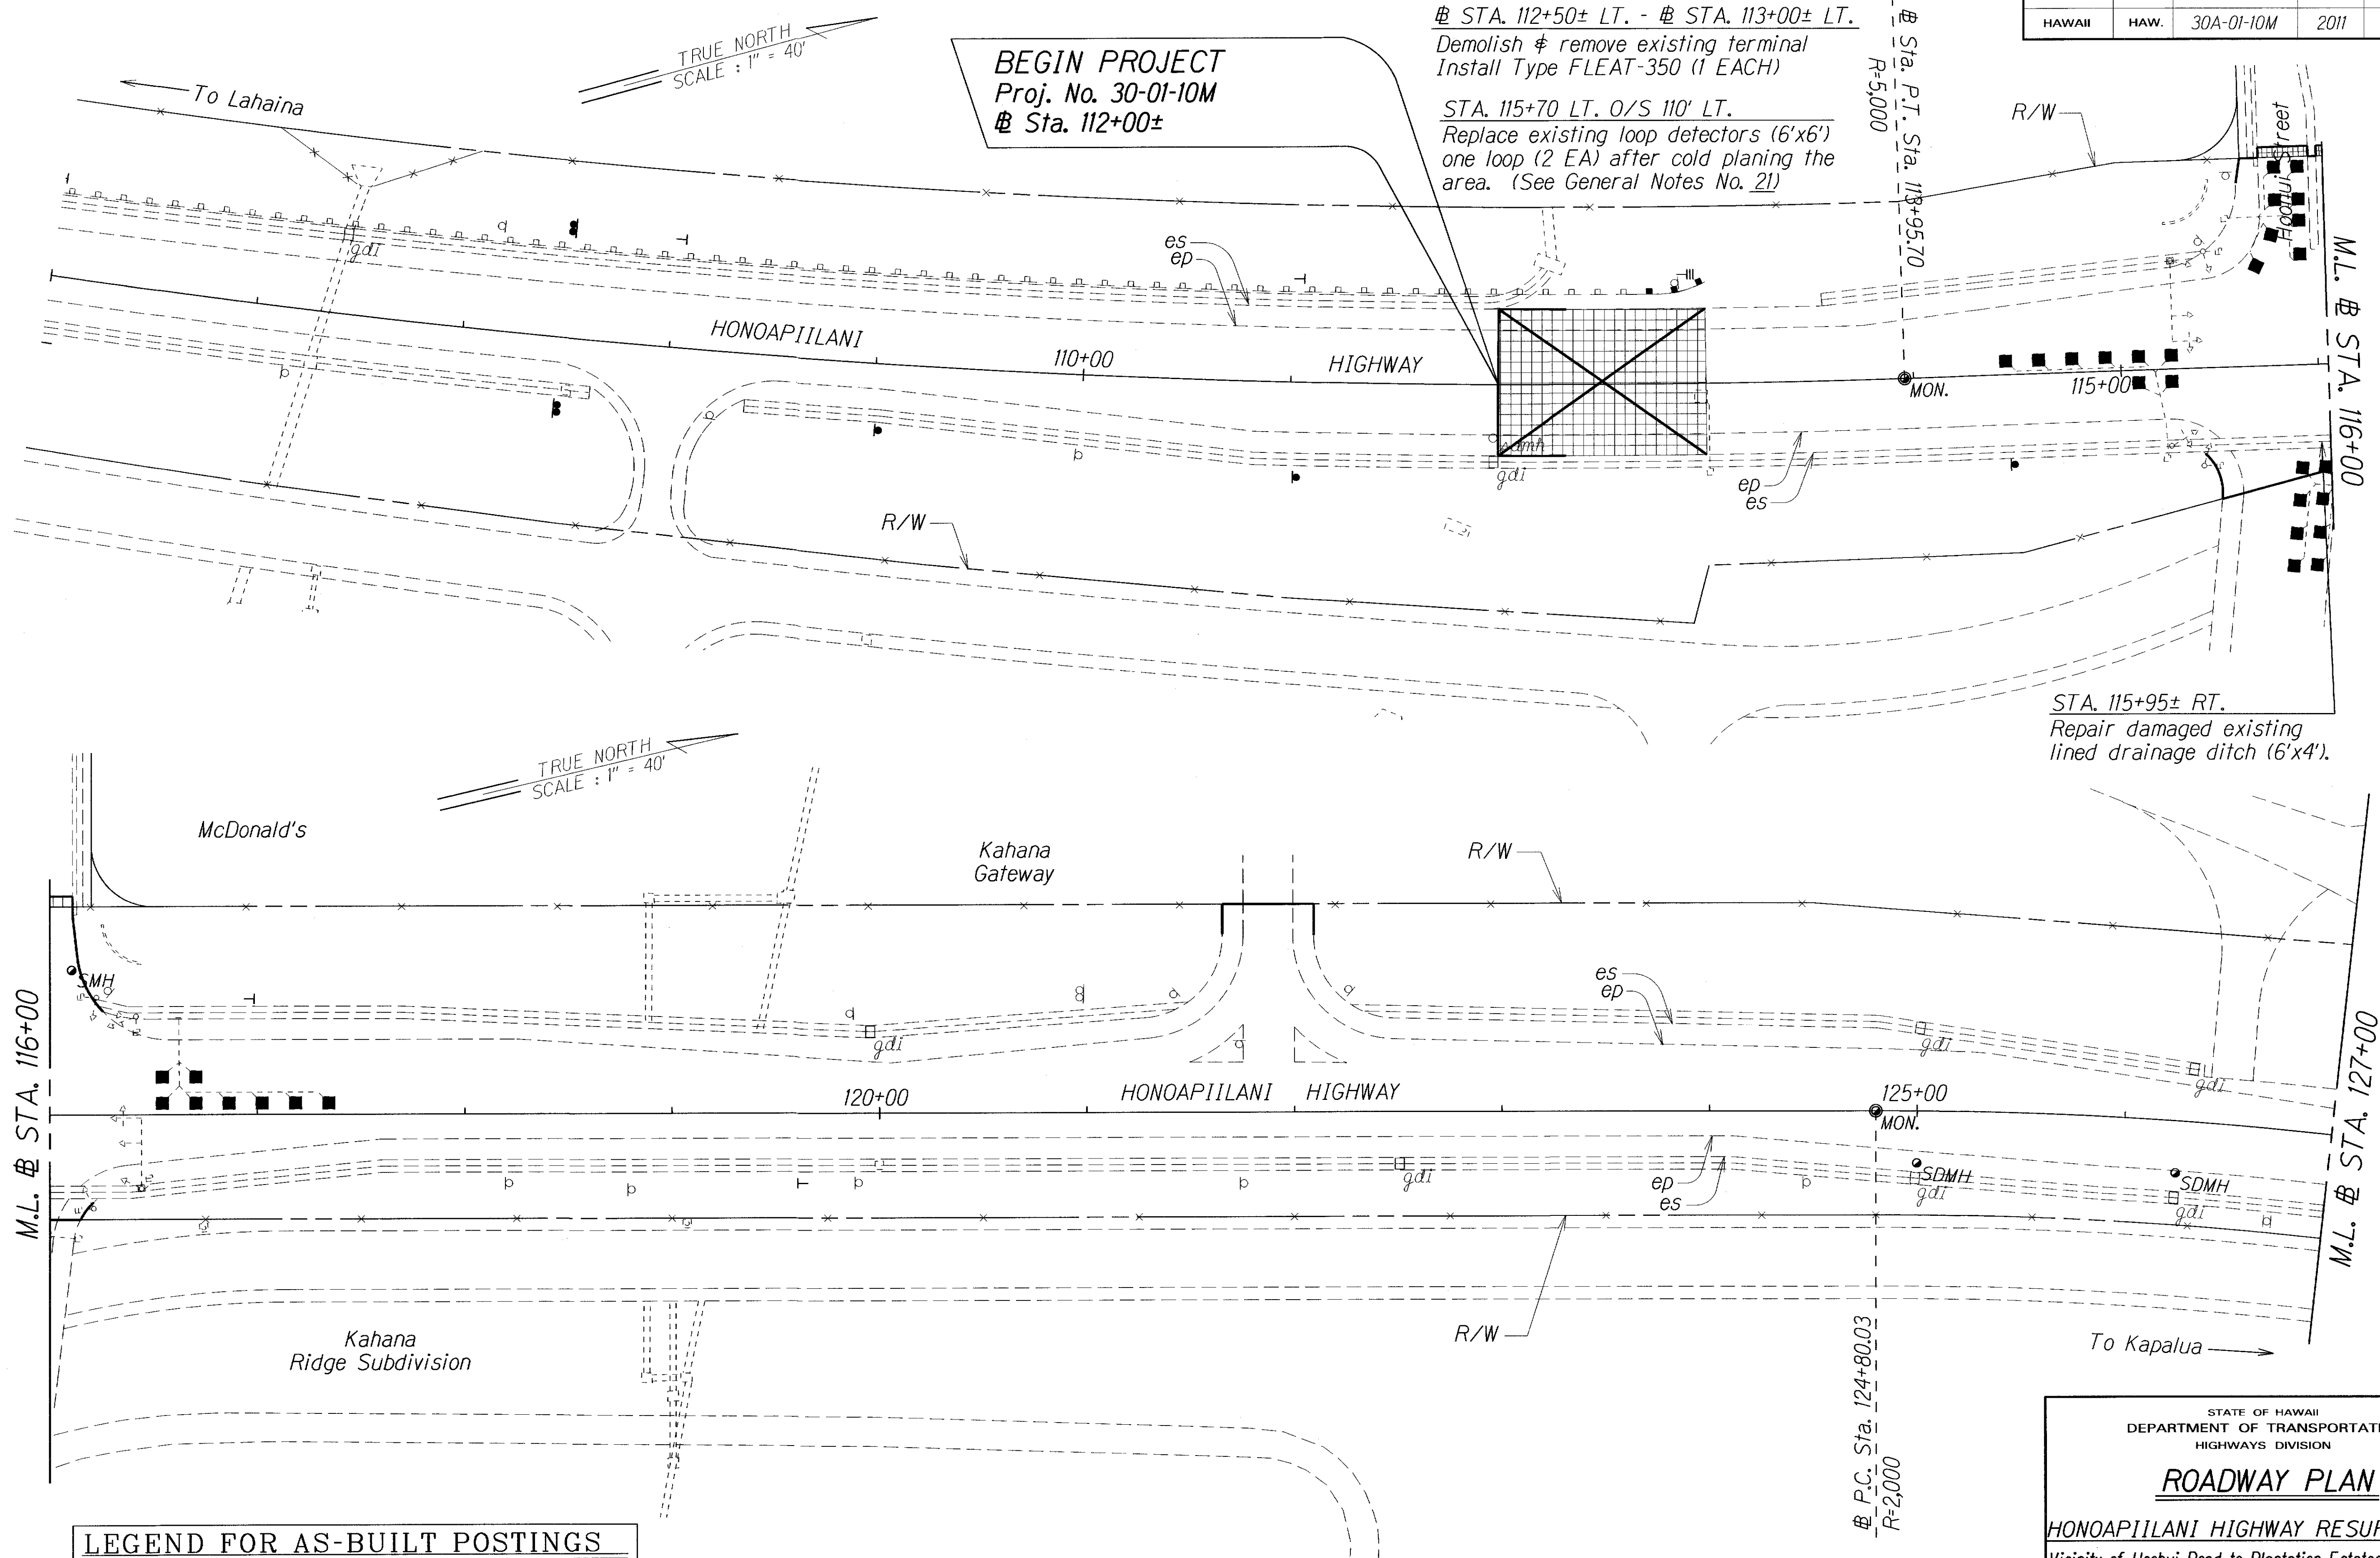


LEGEND FOR AS-BUILT POSTINGS	
	Squiggly line for as-built deletion
	Double line for as-built deletion
Roadway	Text for as-built posting

STATE OF HAWAII
DEPARTMENT OF TRANSPORTATION
HIGHWAYS DIVISION
ROADWAY PLAN
HONOAPIILANI HIGHWAY RESURFACING
Vicinity of Hoohui Road to Plantation Estates Golf Course
Project No. 30A-01-10M
Scale: 1" = 40' Date: May, 2009
SHEET No. 1 OF 9 SHEETS

"AS-BUILT"

FED. ROAD DIST. NO.	STATE	PROJ. NO.	FISCAL YEAR	SHEET NO.	TOTAL SHEETS
HAWAII	HAW.	30A-01-10M	2011	ADD.14	40

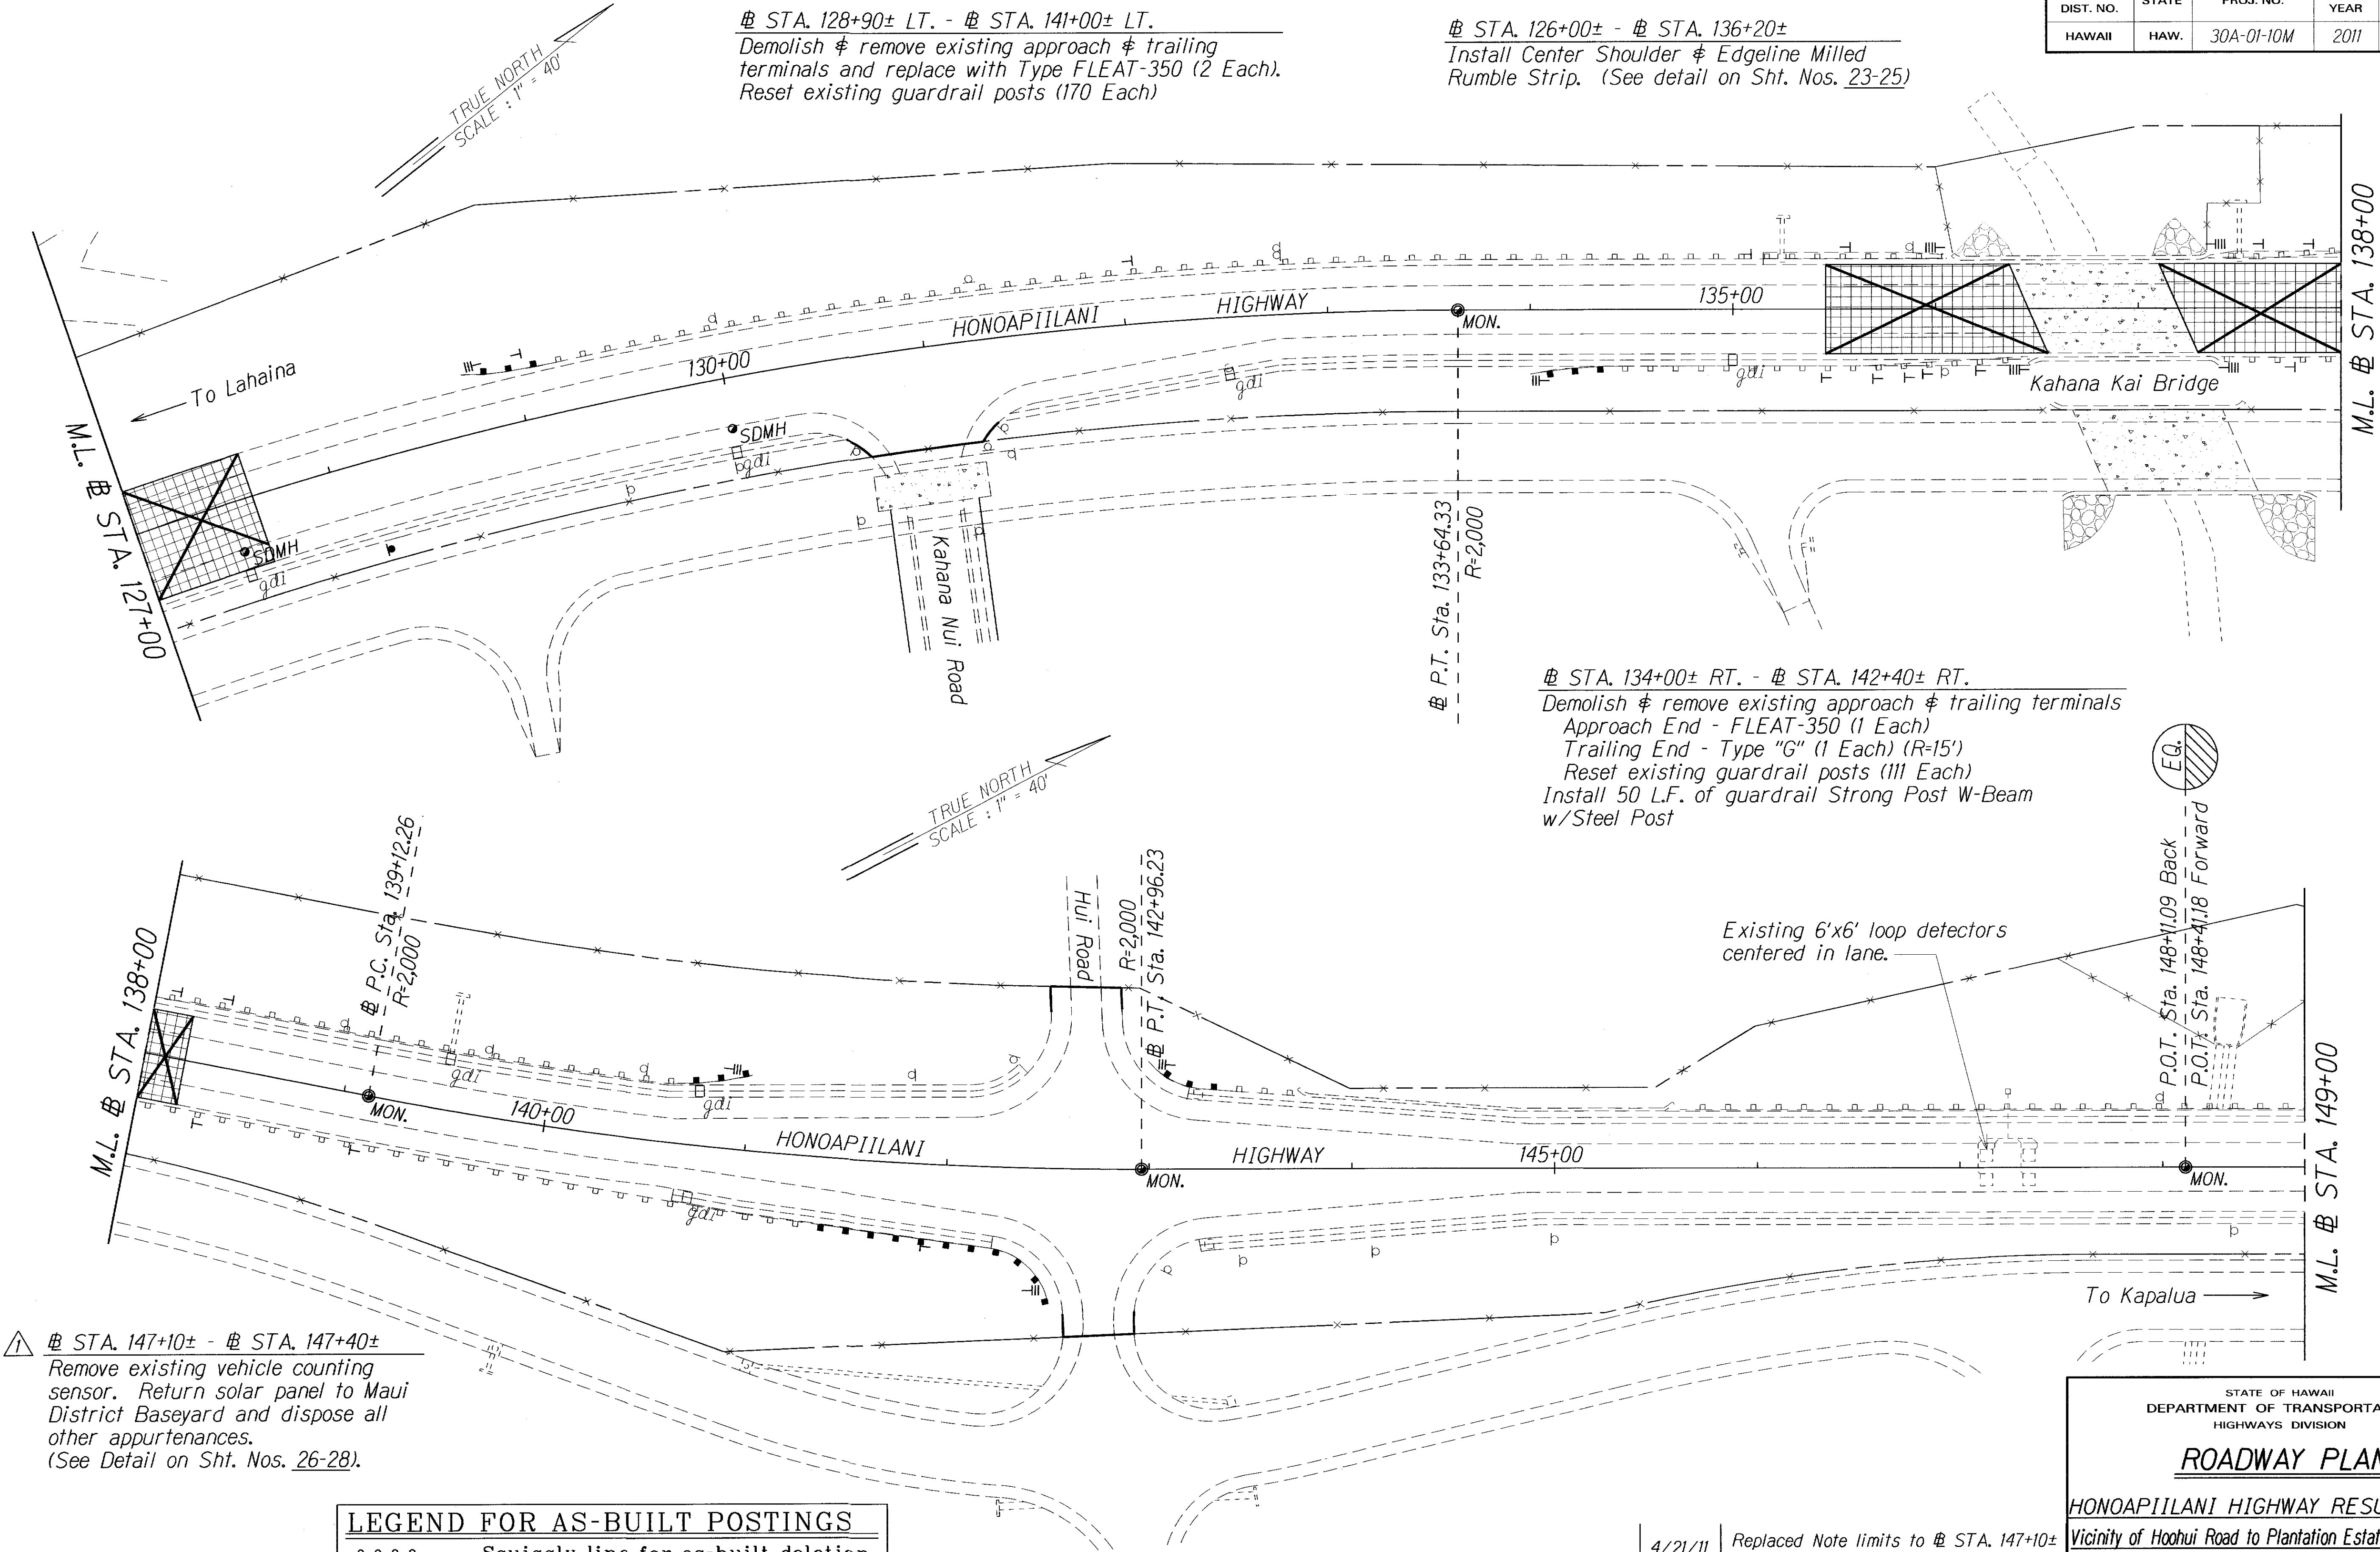

⚠ STA. 147+10± - STA. 147+40±
 Remove existing vehicle counting sensor. Return solar panel to Maui District Baseyard and dispose all other appurtenances.
 (See Detail on Sht. Nos. 26-28).

LEGEND FOR AS-BUILT POSTINGS	
	Squiggly line for as-built deletion
	Double line for as-built deletion
Roadway	Text for as-built posting

4/21/11	Replaced Note limits to STA. 147+10± to STA. 147+40±, per Addendum No. 1
DATE	REVISION

STATE OF HAWAII
DEPARTMENT OF TRANSPORTATION
HIGHWAYS DIVISION


ROADWAY PLAN
HONOAPIʻILANI HIGHWAY RESURFACING
Vicinity of Hooehi Road to Plantation Estates Golf Course
Project No. 30A-01-10M
Scale: 1" = 40' Date: May, 2009
SHEET No. 2 OF 9 SHEETS

ORIGINAL PLAN	SURVEY PLOTTED BY	DATE
NOTE BOOK	DESIGNED BY	
	QUANTITIES BY	
	CHECKED BY	

"AS-BUILT"

ADD.14

△ @ STA. 143+00± LT. - @ STA. 150+50± LT.
Demolish & remove existing approach & trailing terminals

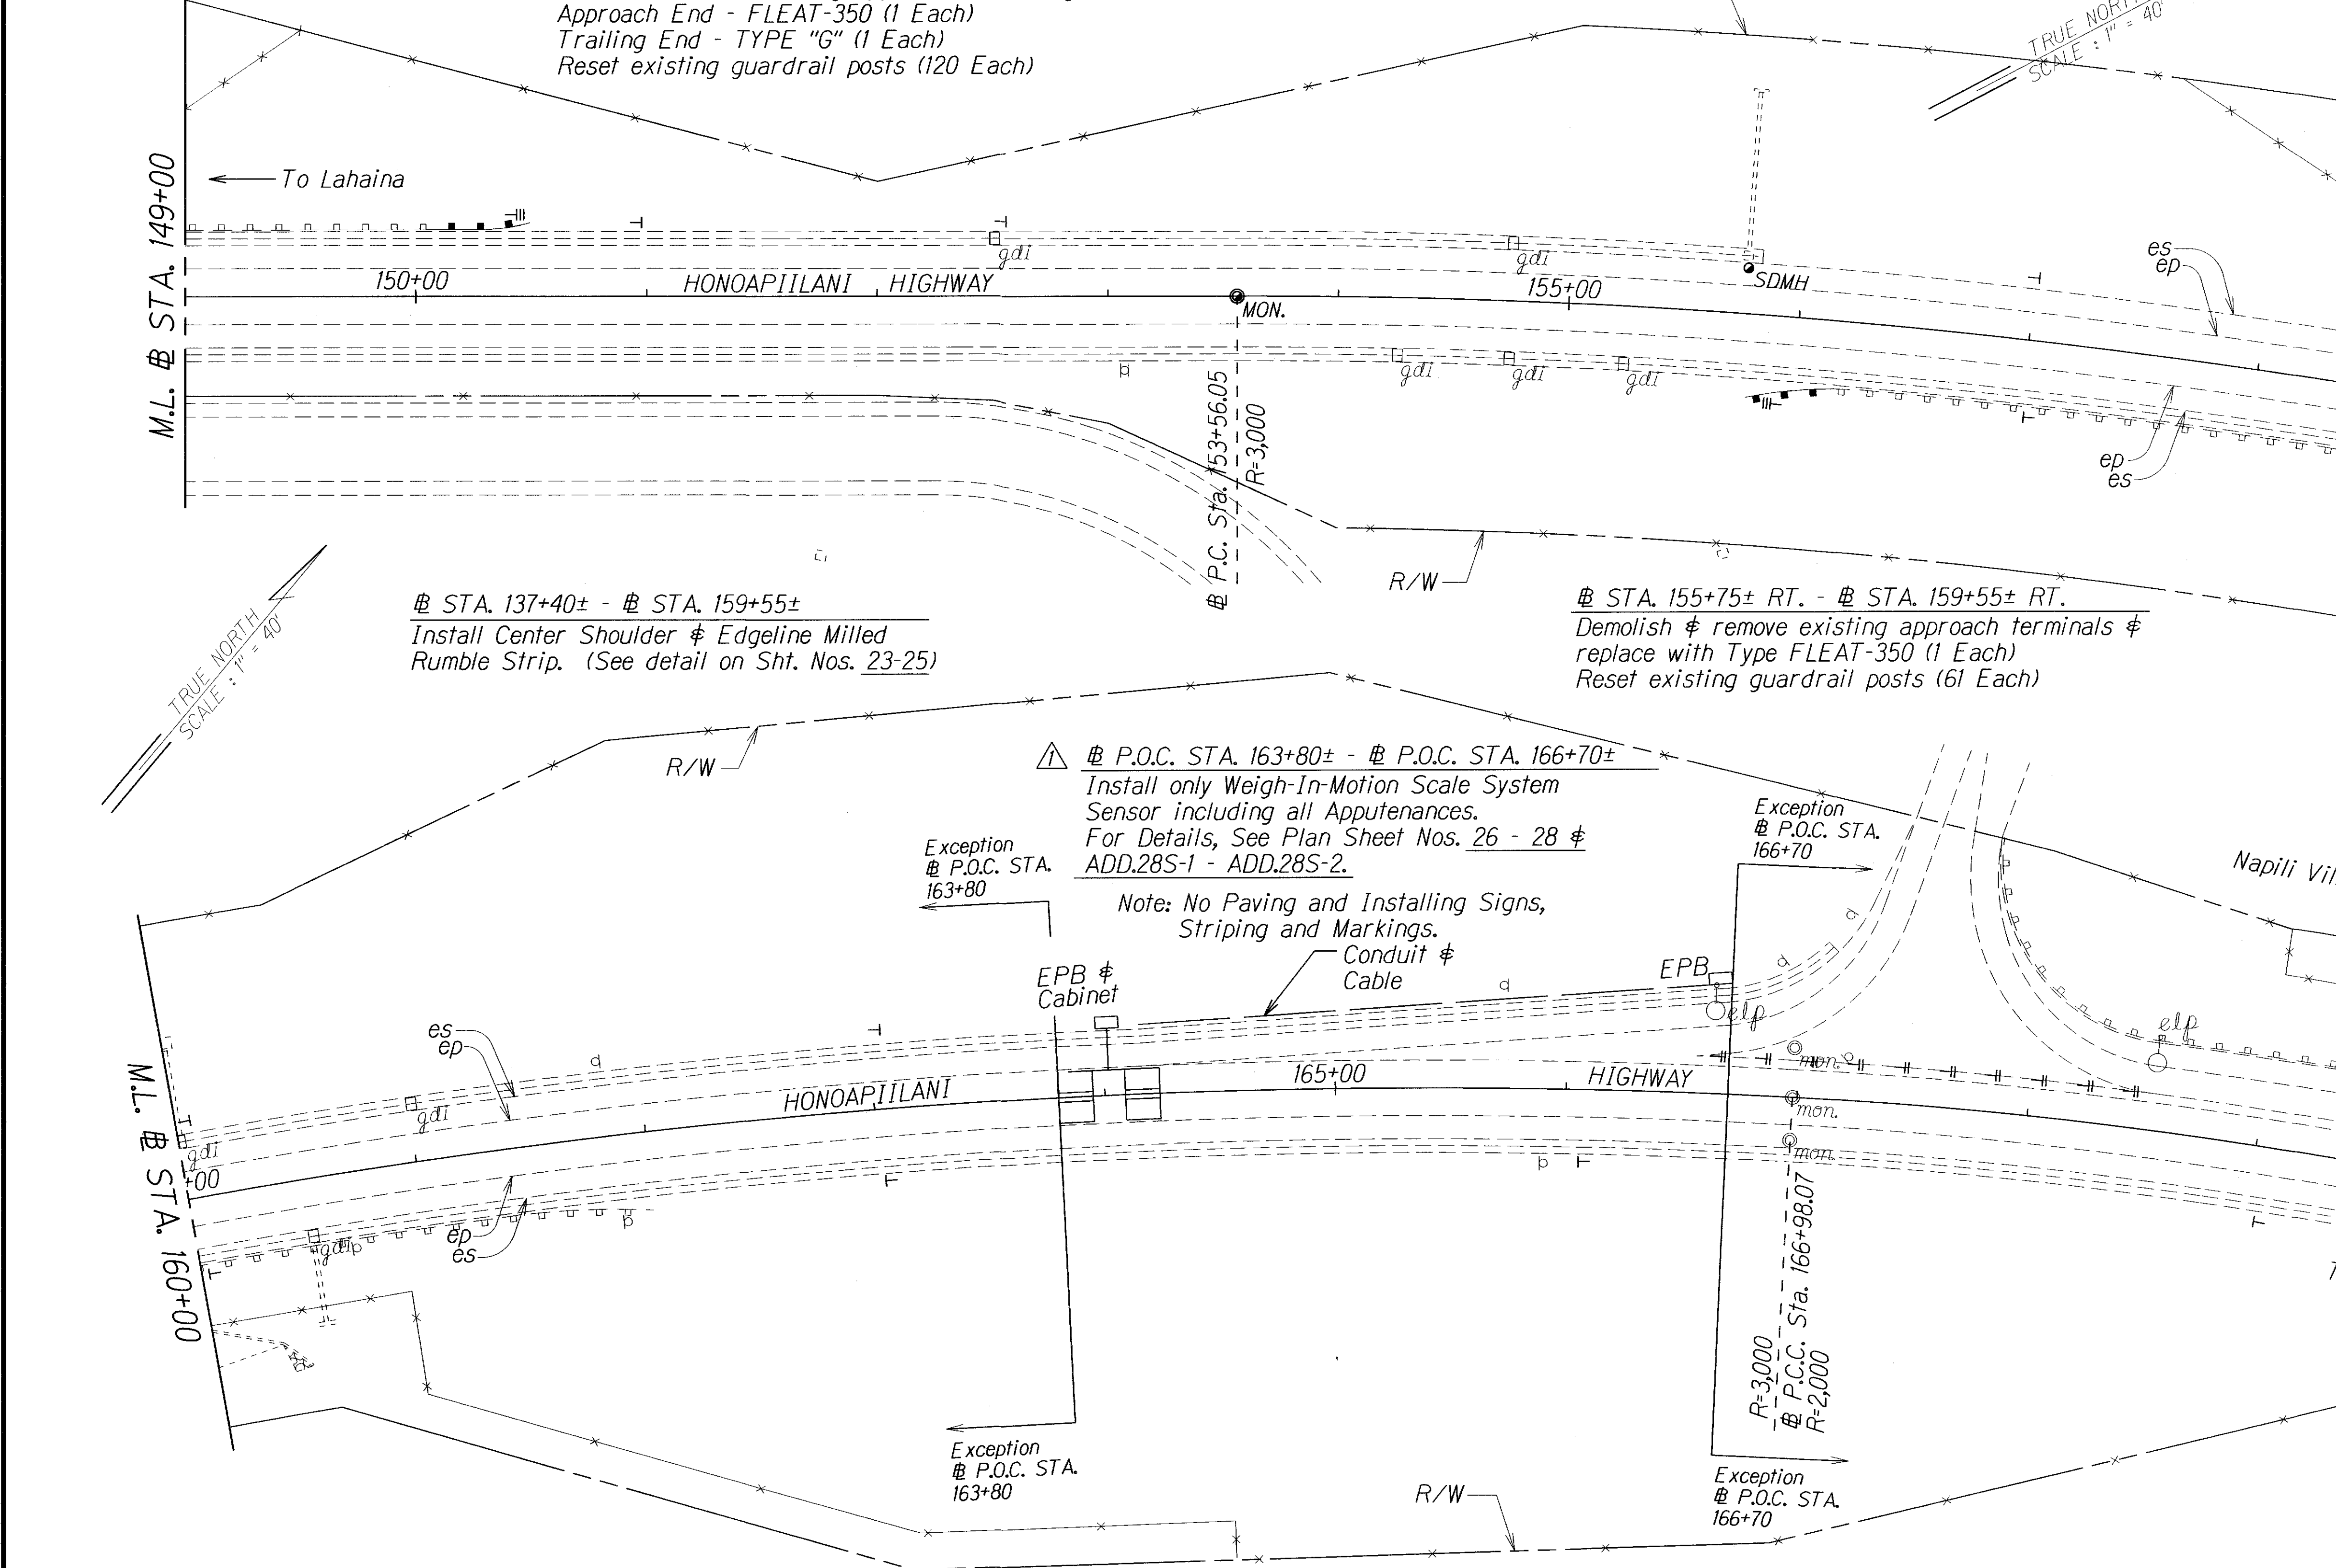

LEGEND FOR AS-BUILT POSTINGS	
	Squiggly line for as-built deletion
	Double line for as-built deletion
Roadway	Text for as-built posting

12/6/10	Corrected Note. $\triangle 1$
DATE	REVIS.

STATE OF HAWAII
DEPARTMENT OF TRANSPORTATION
HIGHWAYS DIVISION

ROADWAY PLAN

HONOAPIILANI HIGHWAY RESURFACING
Vicinity of Hoohui Road to Plantation Estates Golf Course
Project No. 30A-01-10M


Scale: 1" =40' Date: May, 2009

SHEET No. 3 OF 9 SHEETS

"AS-BUILT"

ADD.15

FED. ROAD DIST. NO.	STATE	PROJ. NO.	FISCAL YEAR	SHEET NO.	TOTAL SHEETS
HAWAII	HAW.	30A-01-10M	2011	16	40

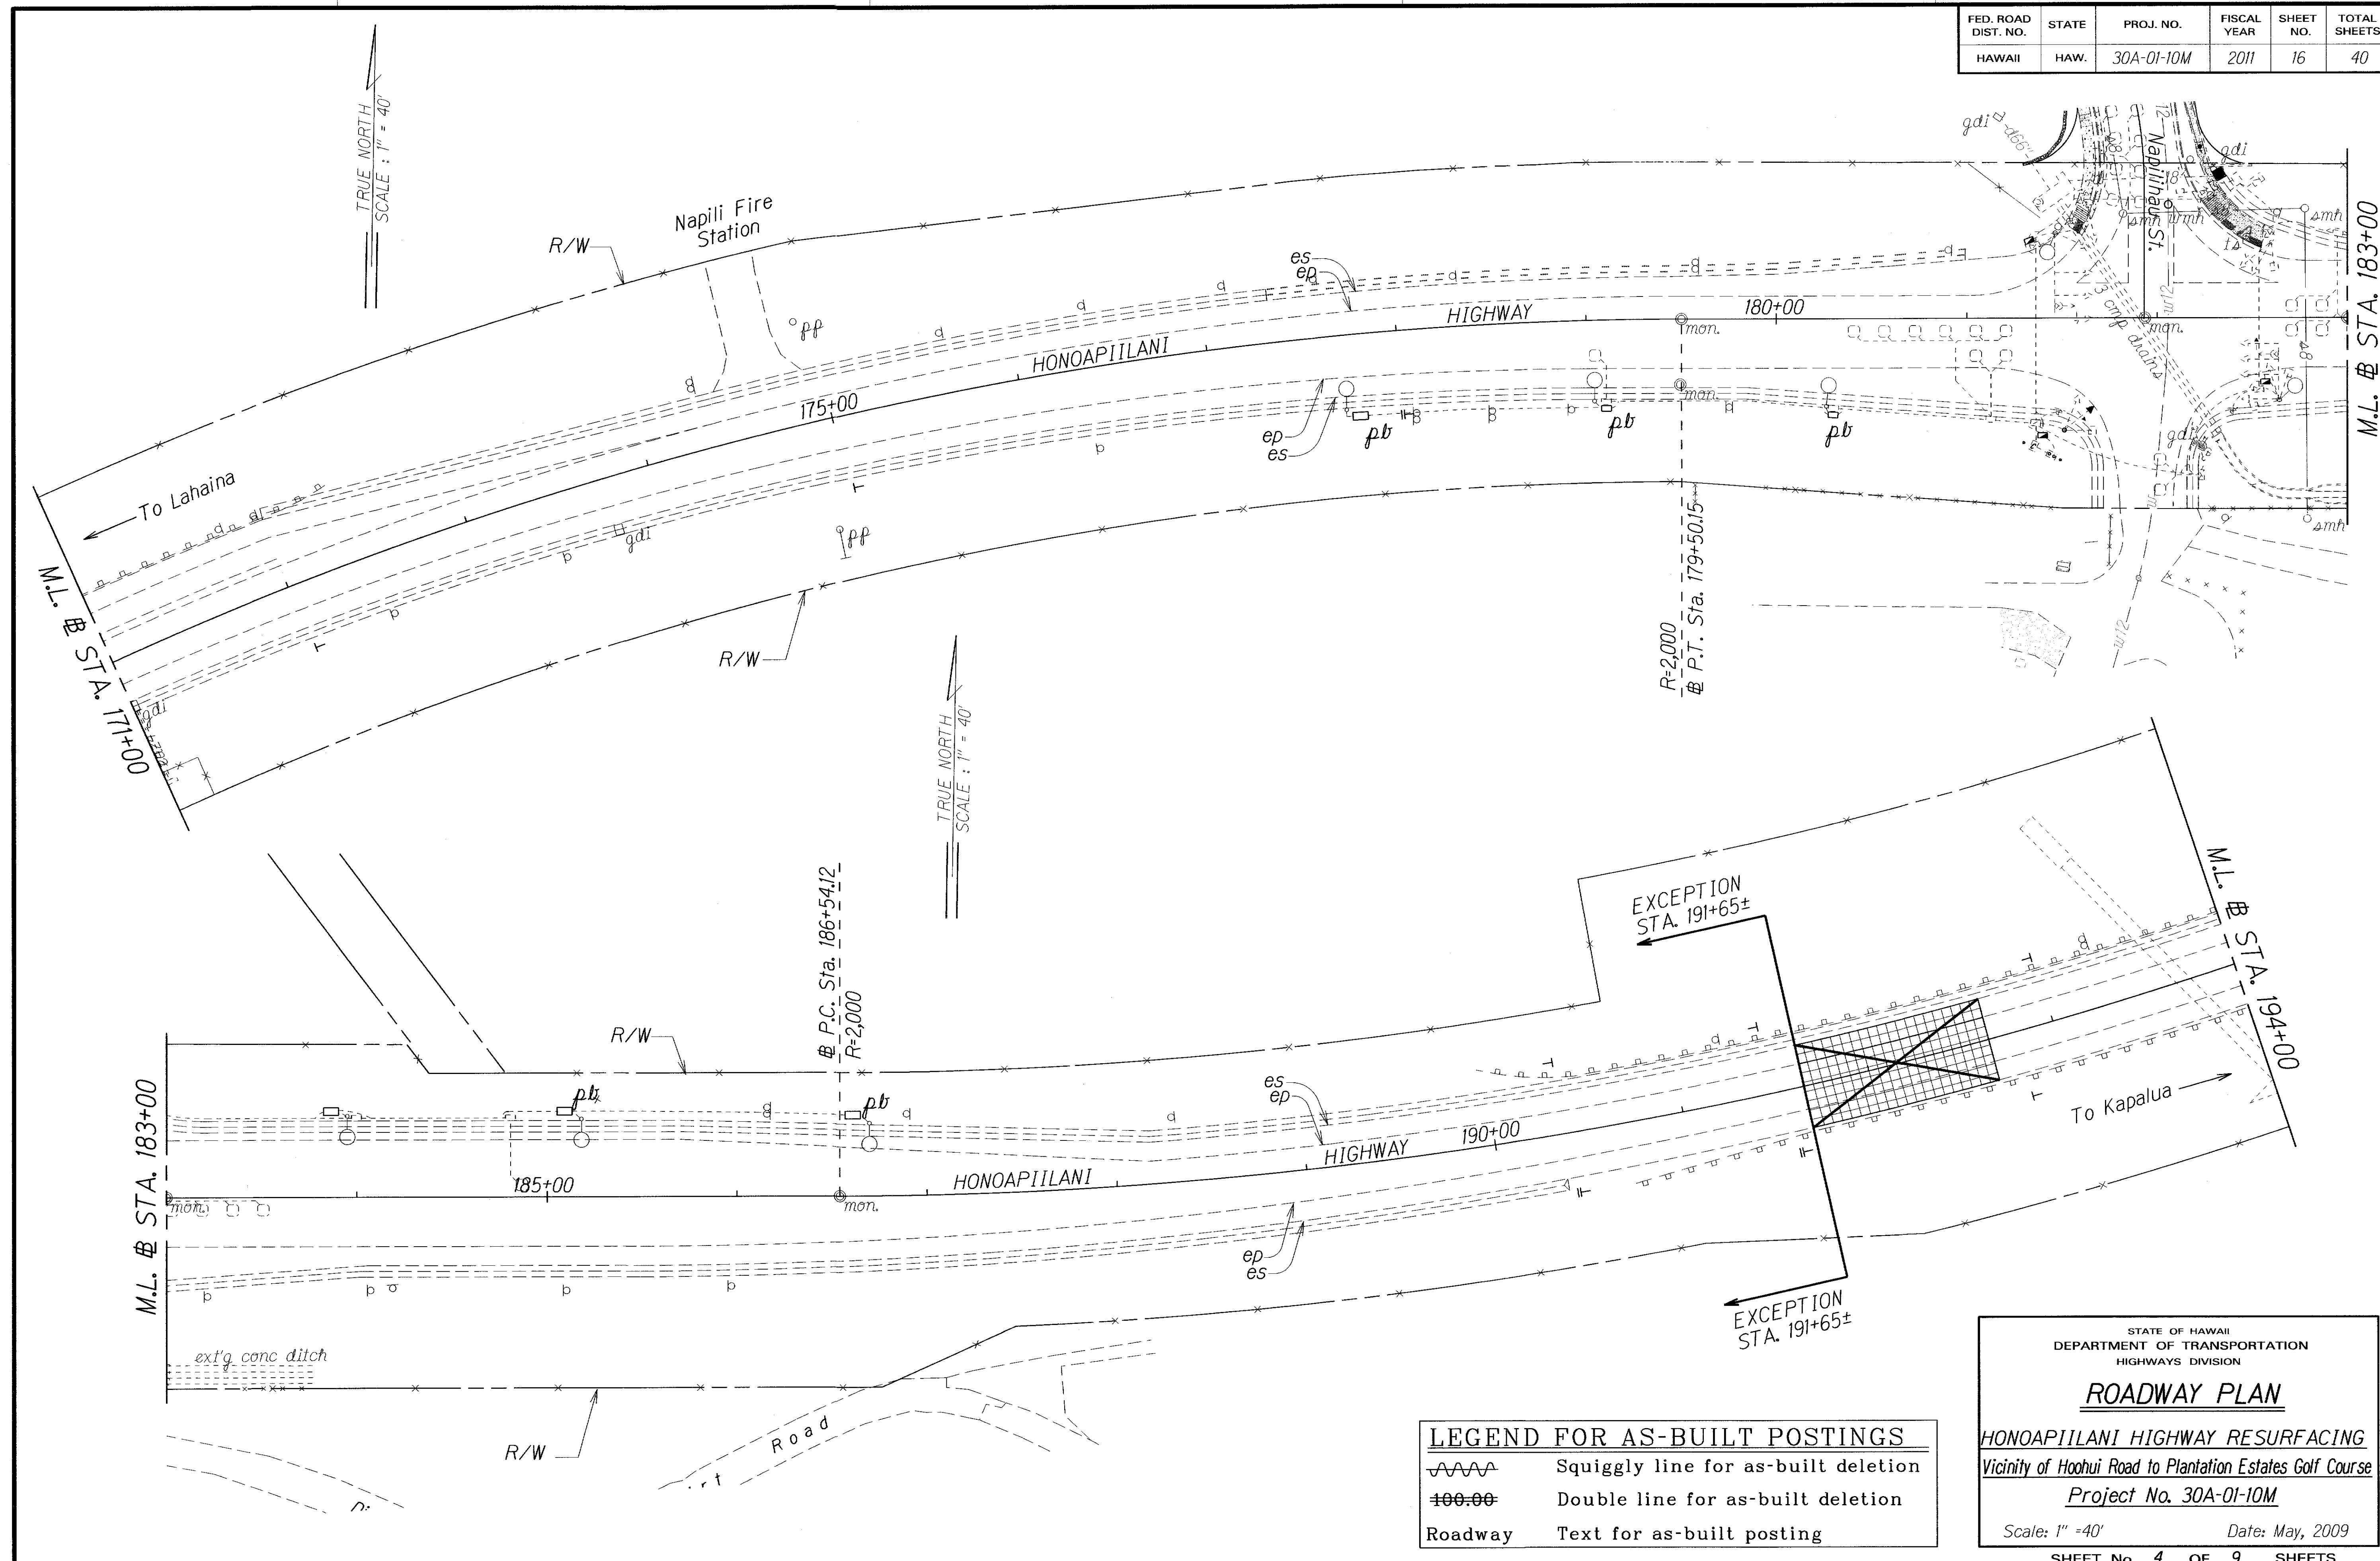

DESIGNED BY	DATE
DRAWN BY	
CHECKED BY	
NOTED BY	
QUANTITIES BY	
CHECKED BY	

LEGEND FOR AS-BUILT POSTINGS	
	Squiggly line for as-built deletion
	Double line for as-built deletion
Roadway	Text for as-built posting

STATE OF HAWAII
DEPARTMENT OF TRANSPORTATION
HIGHWAYS DIVISION

ROADWAY PLAN


HONOAPIILANI HIGHWAY RESURFACING
Vicinity of Hoohui Road to Plantation Estates Golf Course
Project No. 30A-01-10M

Scale: 1" = 40' Date: May, 2009

SHEET No. 4 OF 9 SHEETS

"AS-BUILT"

FED. ROAD DIST. NO.	STATE	PROJ. NO.	FISCAL YEAR	SHEET NO.	TOTAL SHEETS
HAWAII	HAW.	30A-01-10M	2011	ADD.17	40

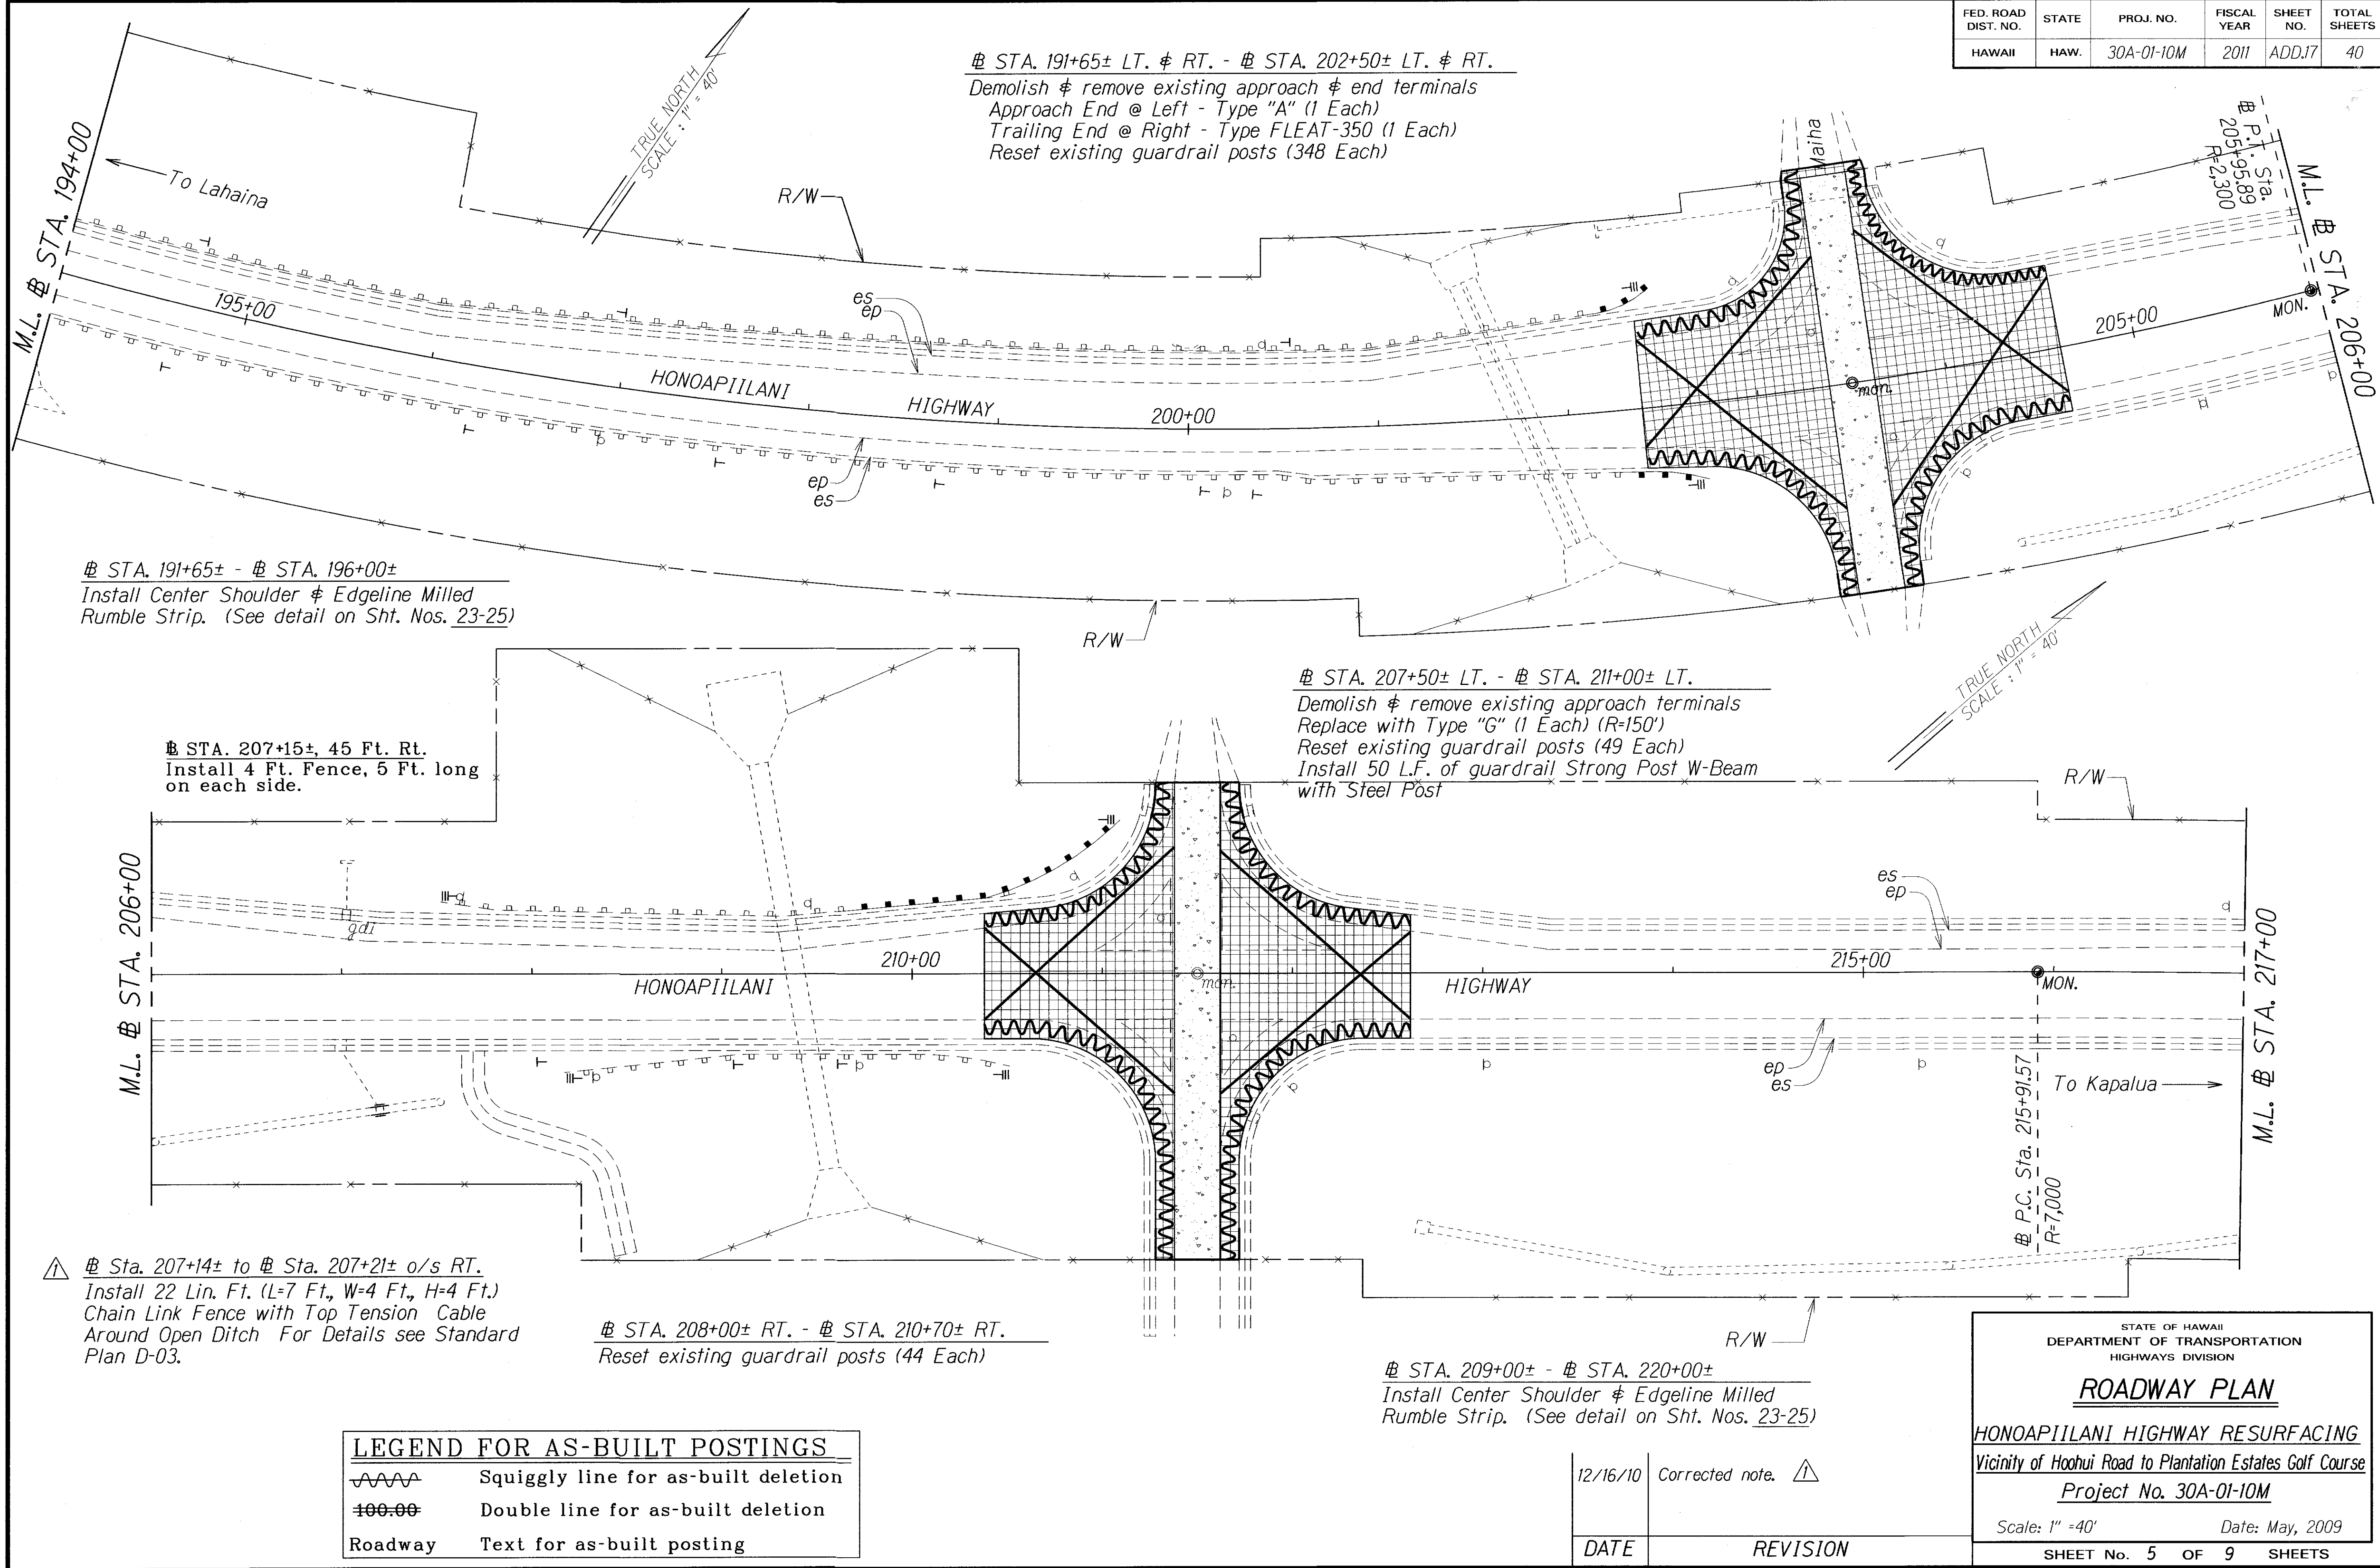

SURVEY PLOTTED BY	DATE
DRAWN BY	
TRACED BY	
CHECKED BY	
NOTED BY	
QUANTITIES BY	
CHECKED BY	
ORIGINAL PLAN	
NOTE BOOK	
DATE	

▲ Sta. 207+14± to Sta. 207+21± o/s RT.
 Install 22 Lin. Ft. (L=7 Ft., W=4 Ft., H=4 Ft.)
 Chain Link Fence with Top Tension Cable
 Around Open Ditch For Details see Standard
 Plan D-03.

Sta. 208+00± RT. - Sta. 210+70± RT.
 Reset existing guardrail posts (44 Each)

Sta. 207+50± LT. - Sta. 211+00± LT.
 Demolish & remove existing approach terminals
 Replace with Type "G" (1 Each) (R=150')
 Reset existing guardrail posts (49 Each)
 Install 50 L.F. of guardrail Strong Post W-Beam
 with Steel Post

Sta. 191+65± - Sta. 196+00±
 Install Center Shoulder & Edgeline Milled
 Rumble Strip. (See detail on Sht. Nos. 23-25)

Sta. 207+15±, 45 Ft. Rt.
 Install 4 Ft. Fence, 5 Ft. long
 on each side.


Sta. 191+65± LT. & RT. - Sta. 202+50± LT. & RT.
 Demolish & remove existing approach & end terminals
 Approach End @ Left - Type "A" (1 Each)
 Trailing End @ Right - Type FLEAT-350 (1 Each)
 Reset existing guardrail posts (348 Each)

Sta. 209+00± - Sta. 220+00±
 Install Center Shoulder & Edgeline Milled
 Rumble Strip. (See detail on Sht. Nos. 23-25)

12/16/10 Corrected note. ▲

DATE REVISION


FED. ROAD DIST. NO.	STATE	PROJ. NO.	FISCAL YEAR	SHEET NO.	TOTAL SHEETS
HAWAII	HAW.	30A-01-10M	2011	18	40

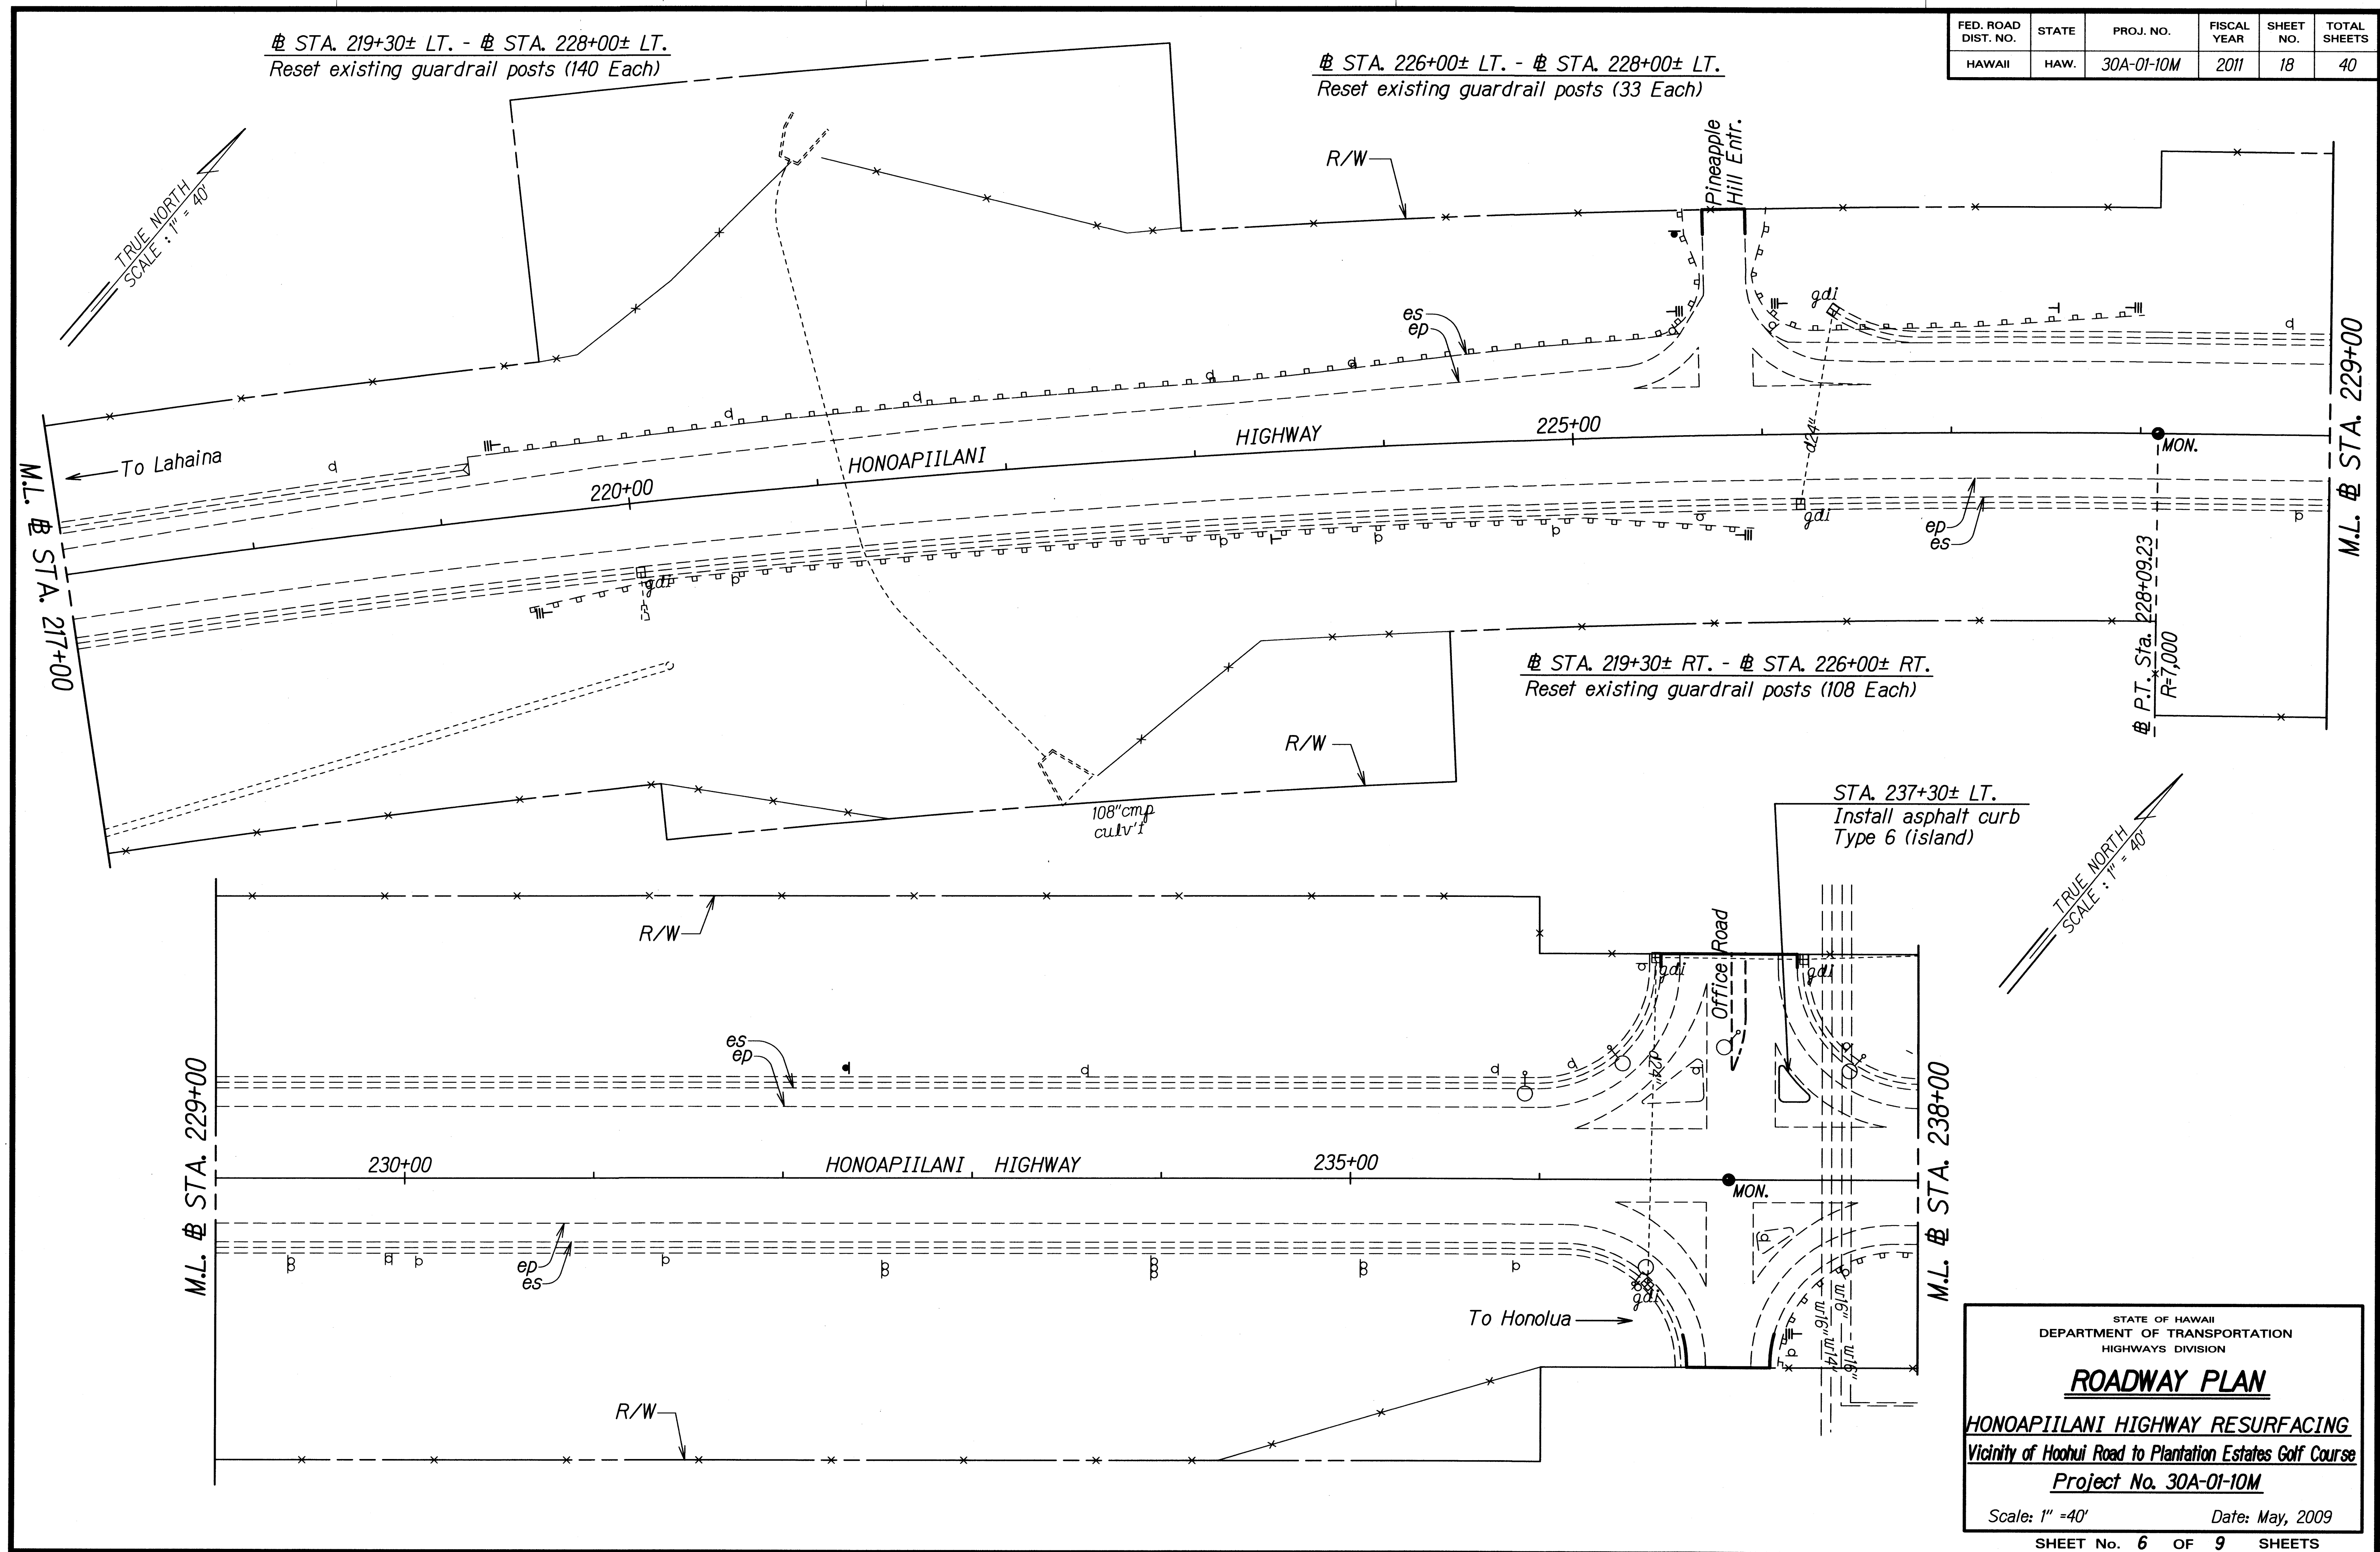

ORIGINAL PLAN	DATE
SURVEY PLOTTED BY	
DRAWN BY	
DESIGNED BY	
QUANTITIES BY	
CHECKED BY	

STATE OF HAWAII
 DEPARTMENT OF TRANSPORTATION
 HIGHWAYS DIVISION
ROADWAY PLAN
HONOAPIILANI HIGHWAY RESURFACING
 Vicinity of Hooihui Road to Plantation Estates Golf Course
 Project No. 30A-01-10M
 Scale: 1" = 40' Date: May, 2009
 SHEET No. 6 OF 9 SHEETS


2.80
~~STA. 238+00± LT. - STA. 256+00± LT.~~
 Demolish & remove existing approach terminal and
 replace with Type "A" (1 Each)

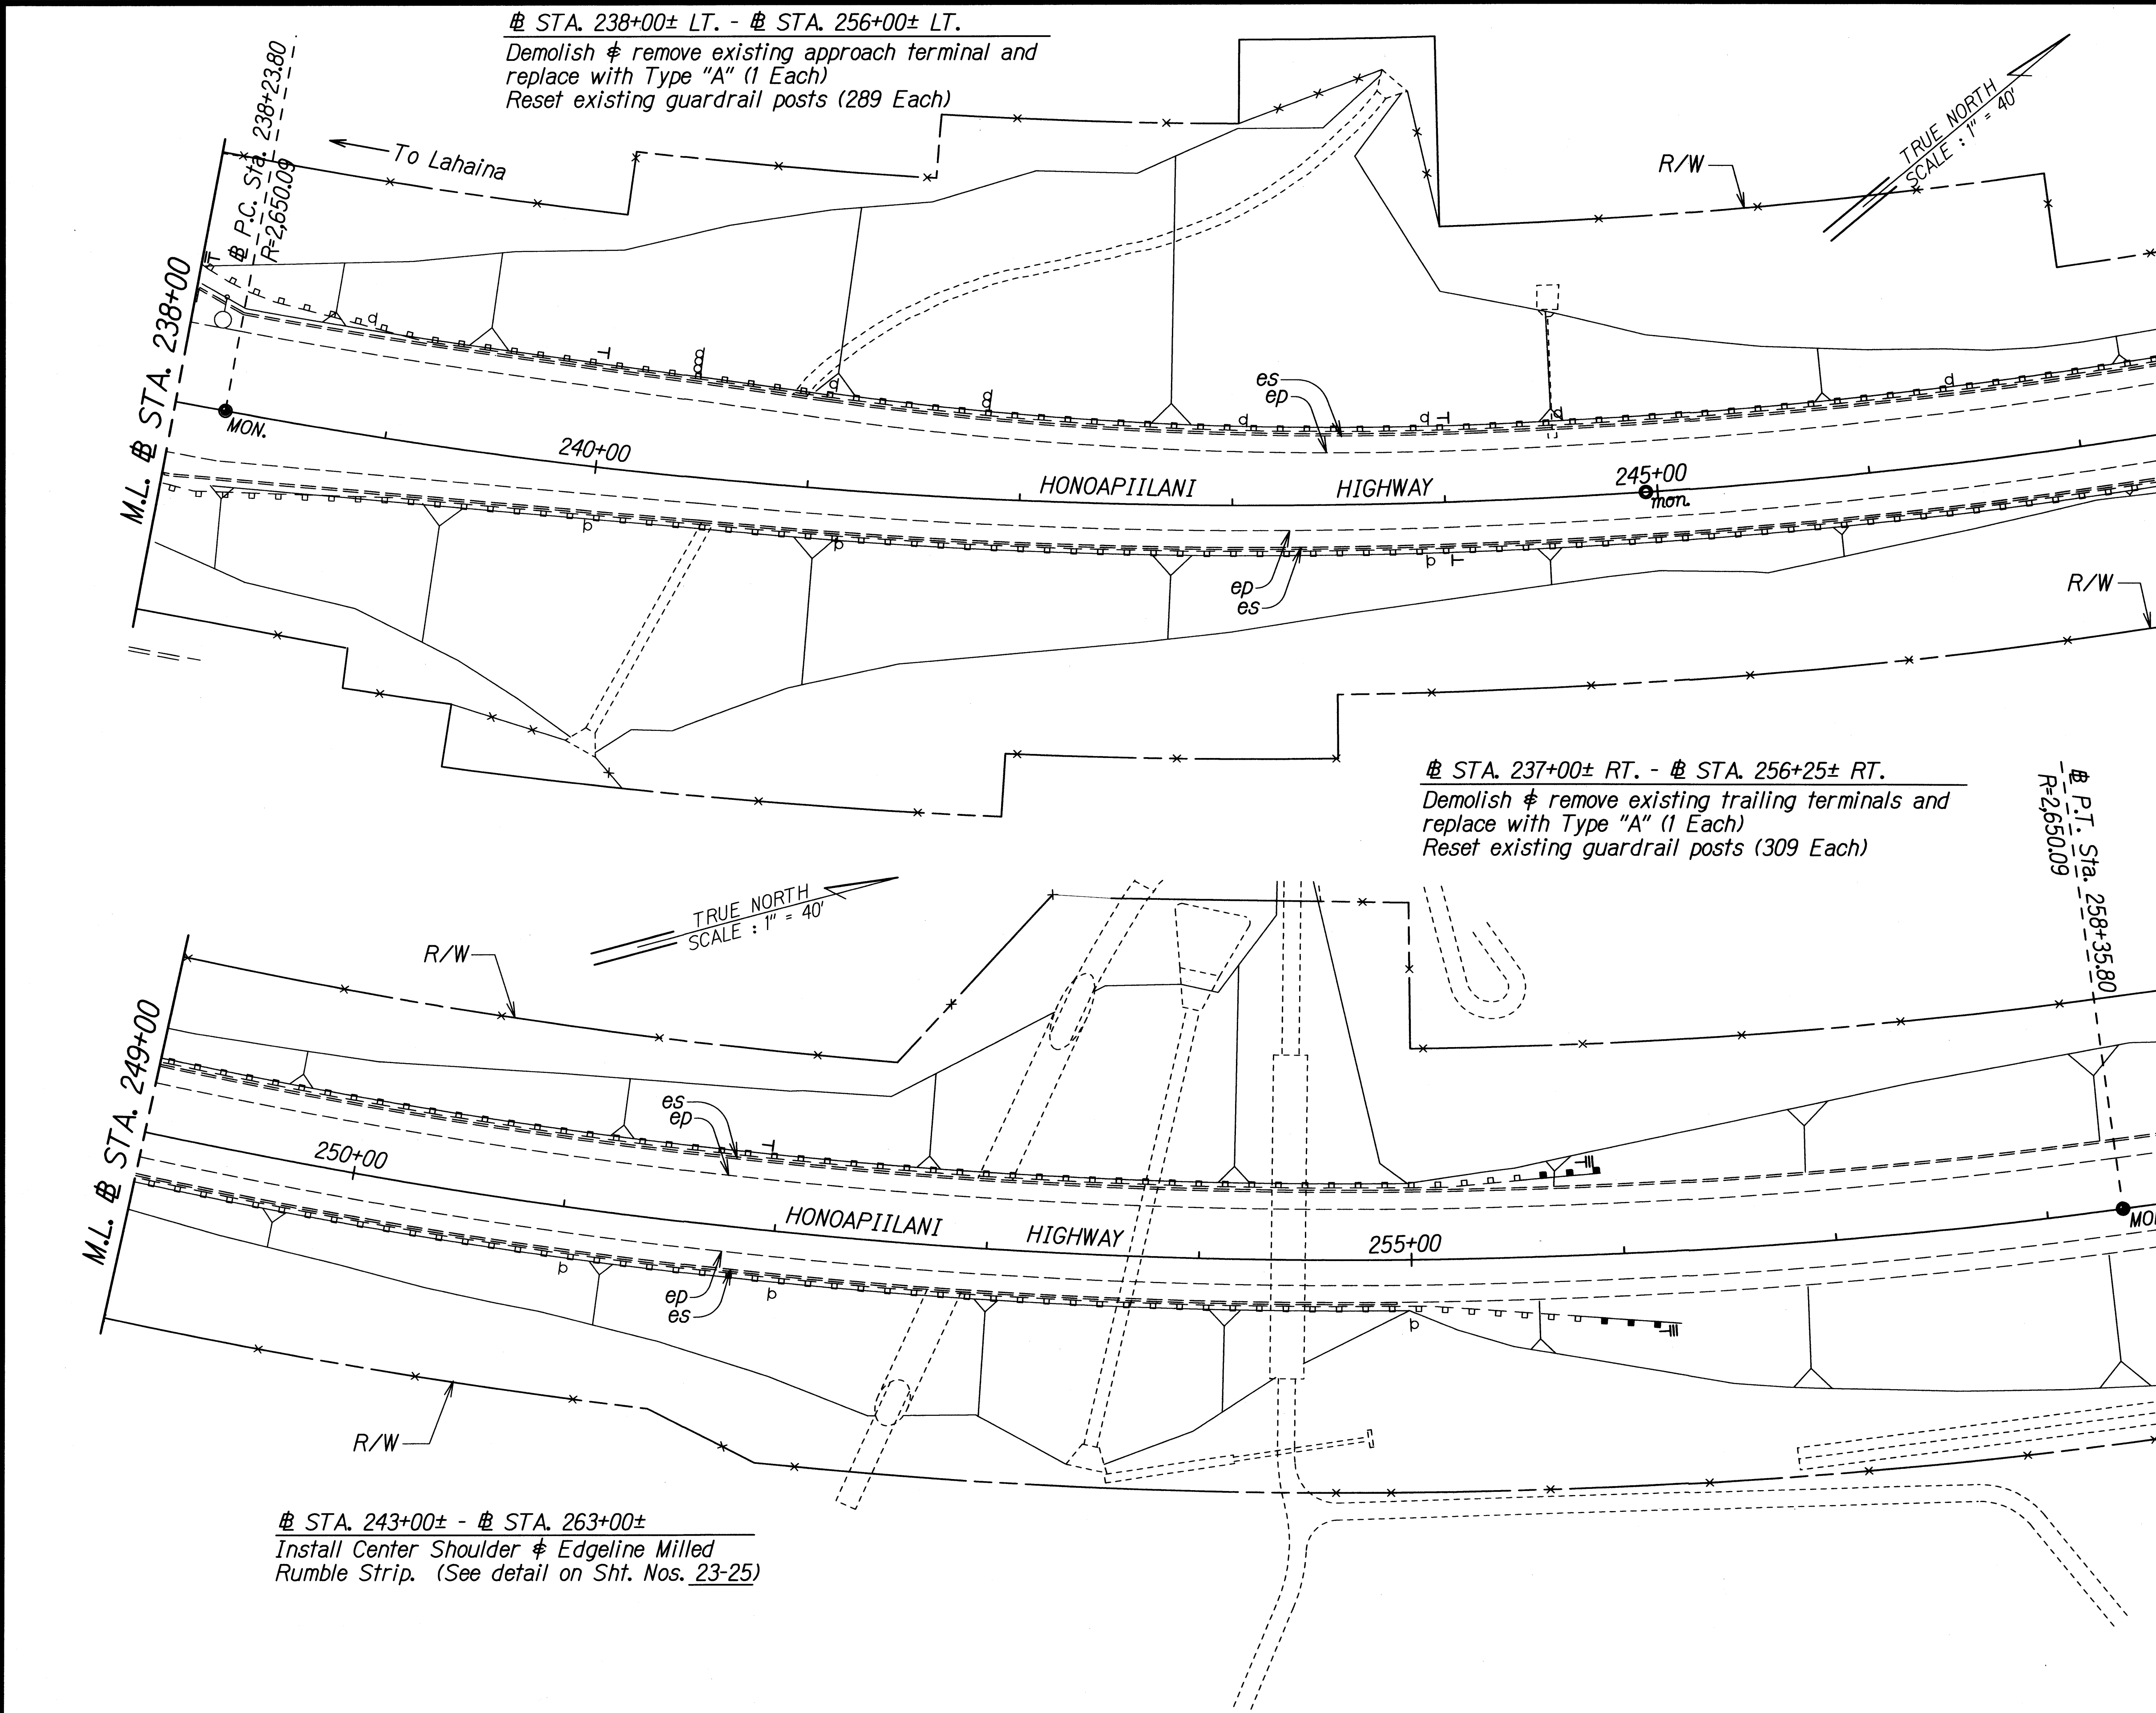

M.S.
 HIGHWAY
 255+00
 ep
 es
 p
 R/W
 # STA. 243+00± - # STA. 263+00±
 Install Center Shoulder & Edgeline Milled
 Rumble Strip. (See detail on Sht. Nos. 23-25)

± STA. 243+00± - ± STA. 263+00±
 Install Center Shoulder & Edgeline Milled
 Rumble Strip. (See detail on Sht. Nos. 23-25)

FED. ROAD DIST. NO.	STATE	PROJ. NO.	FISCAL YEAR	SHEET NO.	TOTAL SHEETS
HAWAII	HAW.	30A-01-10M	2011	20	40

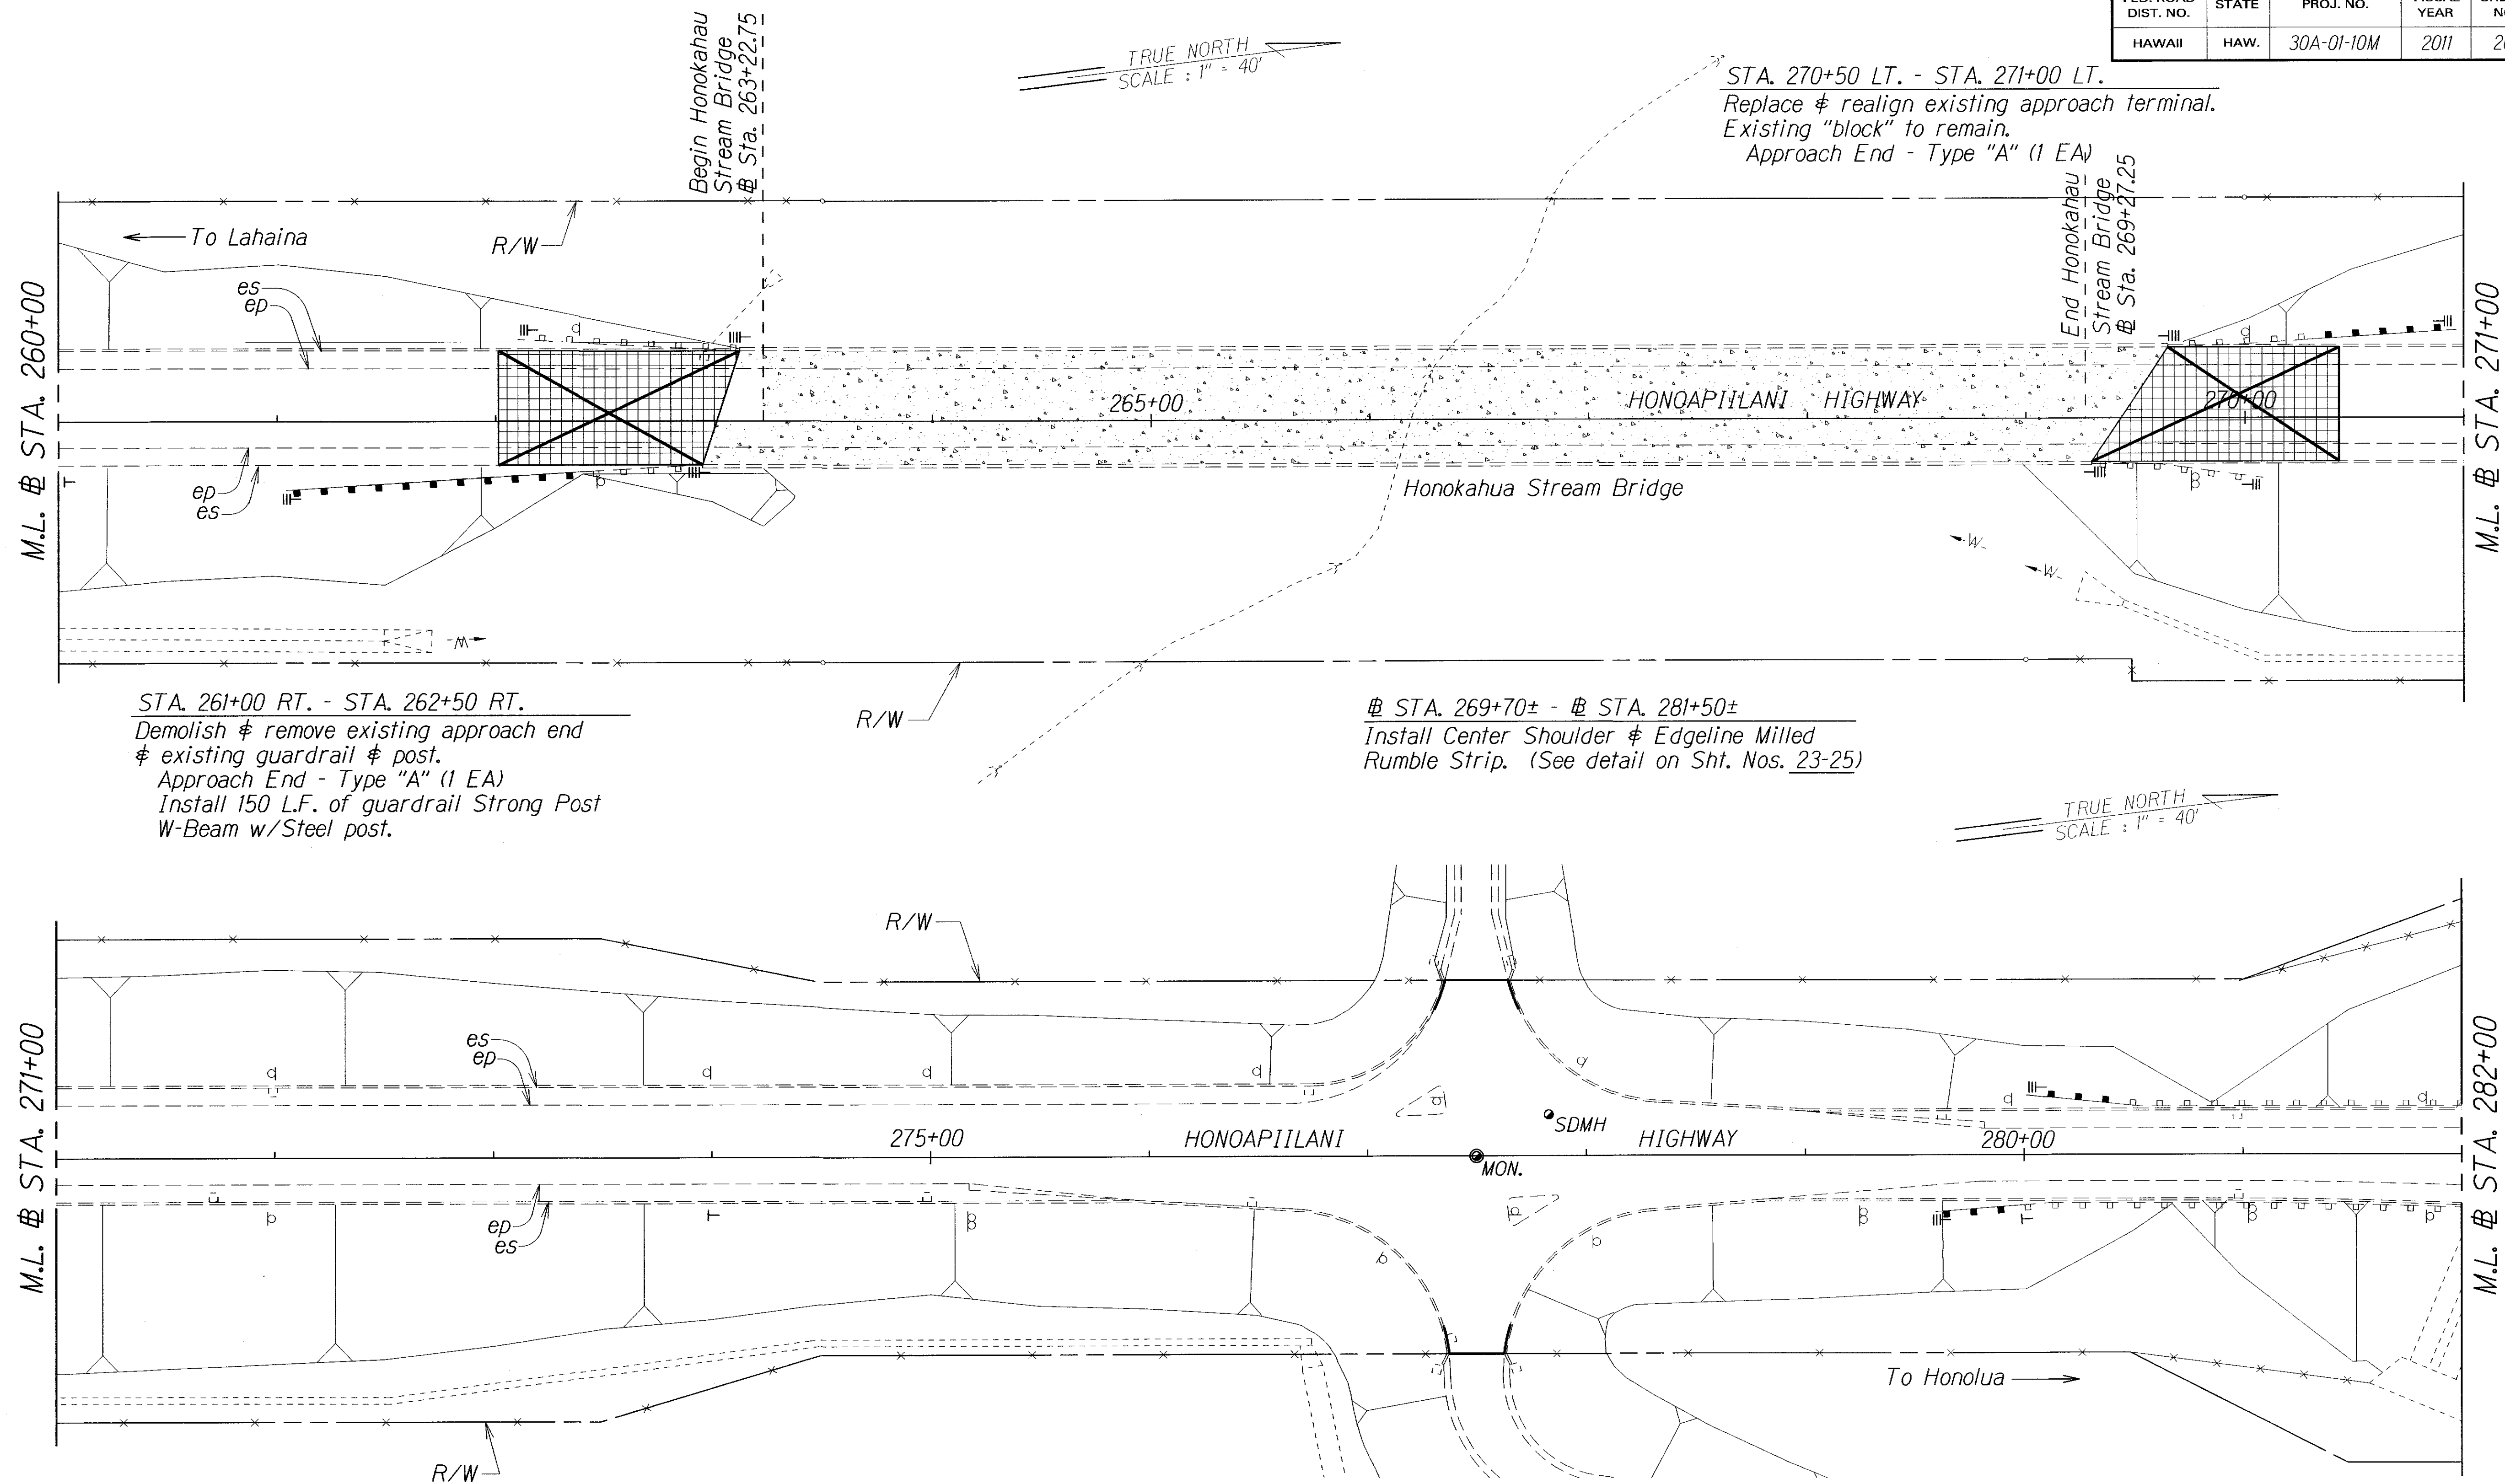

DESIGNED BY	DATE
DRAWN BY	
CHECKED BY	
NOTED BY	
QUANTITIES BY	
CHECKED BY	

LEGEND FOR AS-BUILT POSTINGS	
	Squiggly line for as-built deletion
	Double line for as-built deletion
Roadway	Text for as-built posting

STATE OF HAWAII DEPARTMENT OF TRANSPORTATION HIGHWAYS DIVISION	
ROADWAY PLAN	
HONOAPIILANI HIGHWAY RESURFACING Vicinity of Hooihui Road to Plantation Estates Golf Course Project No. 30A-01-10M	
Scale: 1" = 40'	Date: May, 2009
SHEET No. 8 OF 9 SHEETS	

"AS-BUILT"

