



GENERAL NOTES:

1. The location of new inductance loops, pullboxes and cabinets/junction boxes shall be staked out in the field by the Contractor and approved by the Engineer prior to installation.
2. The Contractor shall inform the Engineer at least three days prior to saw-cutting pavement and installing inductance loops and peizo sensors.
3. Continuity of inductance loops, piezo sensors and lead-in wires shall be tested and warranted for one year from date of acceptance by the Contractor.
4. Upon completion of sleeve, pull in in-bound lanes loop detector's cable and class 1 BL sensor cables, cables shall be tested for acceptance before and after installation into sleeve.
5. The Contractor shall restore all affected areas to their original condition. This item of work shall not be paid for separately, but shall be considered incidental of work of other paid items.
6. The Contractor shall verify the location of the existing utilities and underground structures whether or not shown on plans.
7. The Contractor shall assume that existing underground utilities not shown on the plans may exist, therefore, he shall contact the different utility companies for information and toning.
8. The Contractor shall be held liable for any damages incurred to the existing utilities and underground structures as a result of his operations. All damaged portions shall be replaced in accordance with the standards and specifications of the affected utility company at no cost to the State.
9. Changes to the contract plans and specifications shall not be permitted, unless otherwise authorized by the Engineer upon written justification and request for approval by the Contractor.
10. Highway crossing sleeve shall be provided with 36" cover.

LOOP LAYOUT NOTES:

1. Detector loop shall consist of four turns of 1c#12 cable meeting IMSA spec 5I-5 or equivalent embedded in a 3/8" minimum sawcut, except as noted.
2. Loop and lead-in to the first pullbox shall be one continuous wire. Lead-in wires from the same loop shall be twisted in pairs, two turns per foot. Do not twist on loop-pair with another loop-pair.
3. All lead-in wires shall be crimped with open end lugs that will fit into the terminal board slots snugly.
4. Stagger traffic loops on roadway less than 12 foot lane width.
5. The Contractor shall connect the inductance wires to each terminal slot.
6. The left lane in the direction of traffic flow is designated as lane 1, and the lane next to its right as lane 2 and so on as indicated on plans.
7. Vacuum and clean sawcut thoroughly before installing sensors and/or cables and filling with hot tar or epoxy sealant.
8. All loop lead-in wires in all enclosures including pullboxes shall be identified and labeled by direction of traffic flow and lane number as shown on plans.
9. All cables and wires terminated within an enclosure shall have a minimum 12" additional slack.


LEGEND FOR AS-BUILT POSTINGS

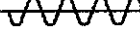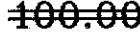	Squiggly line for as-built deletion
	Double line for as-built deletion
Roadway	Text for as-built posting

LOOP LABEL LEGEND:

E = East
W = West
N = North
S = South
A = Approaching
T = Trailing

E2T
└┐ Indicates approaching or trailing loop
└┐ Indicates lane number
└┐ Indicates direction*

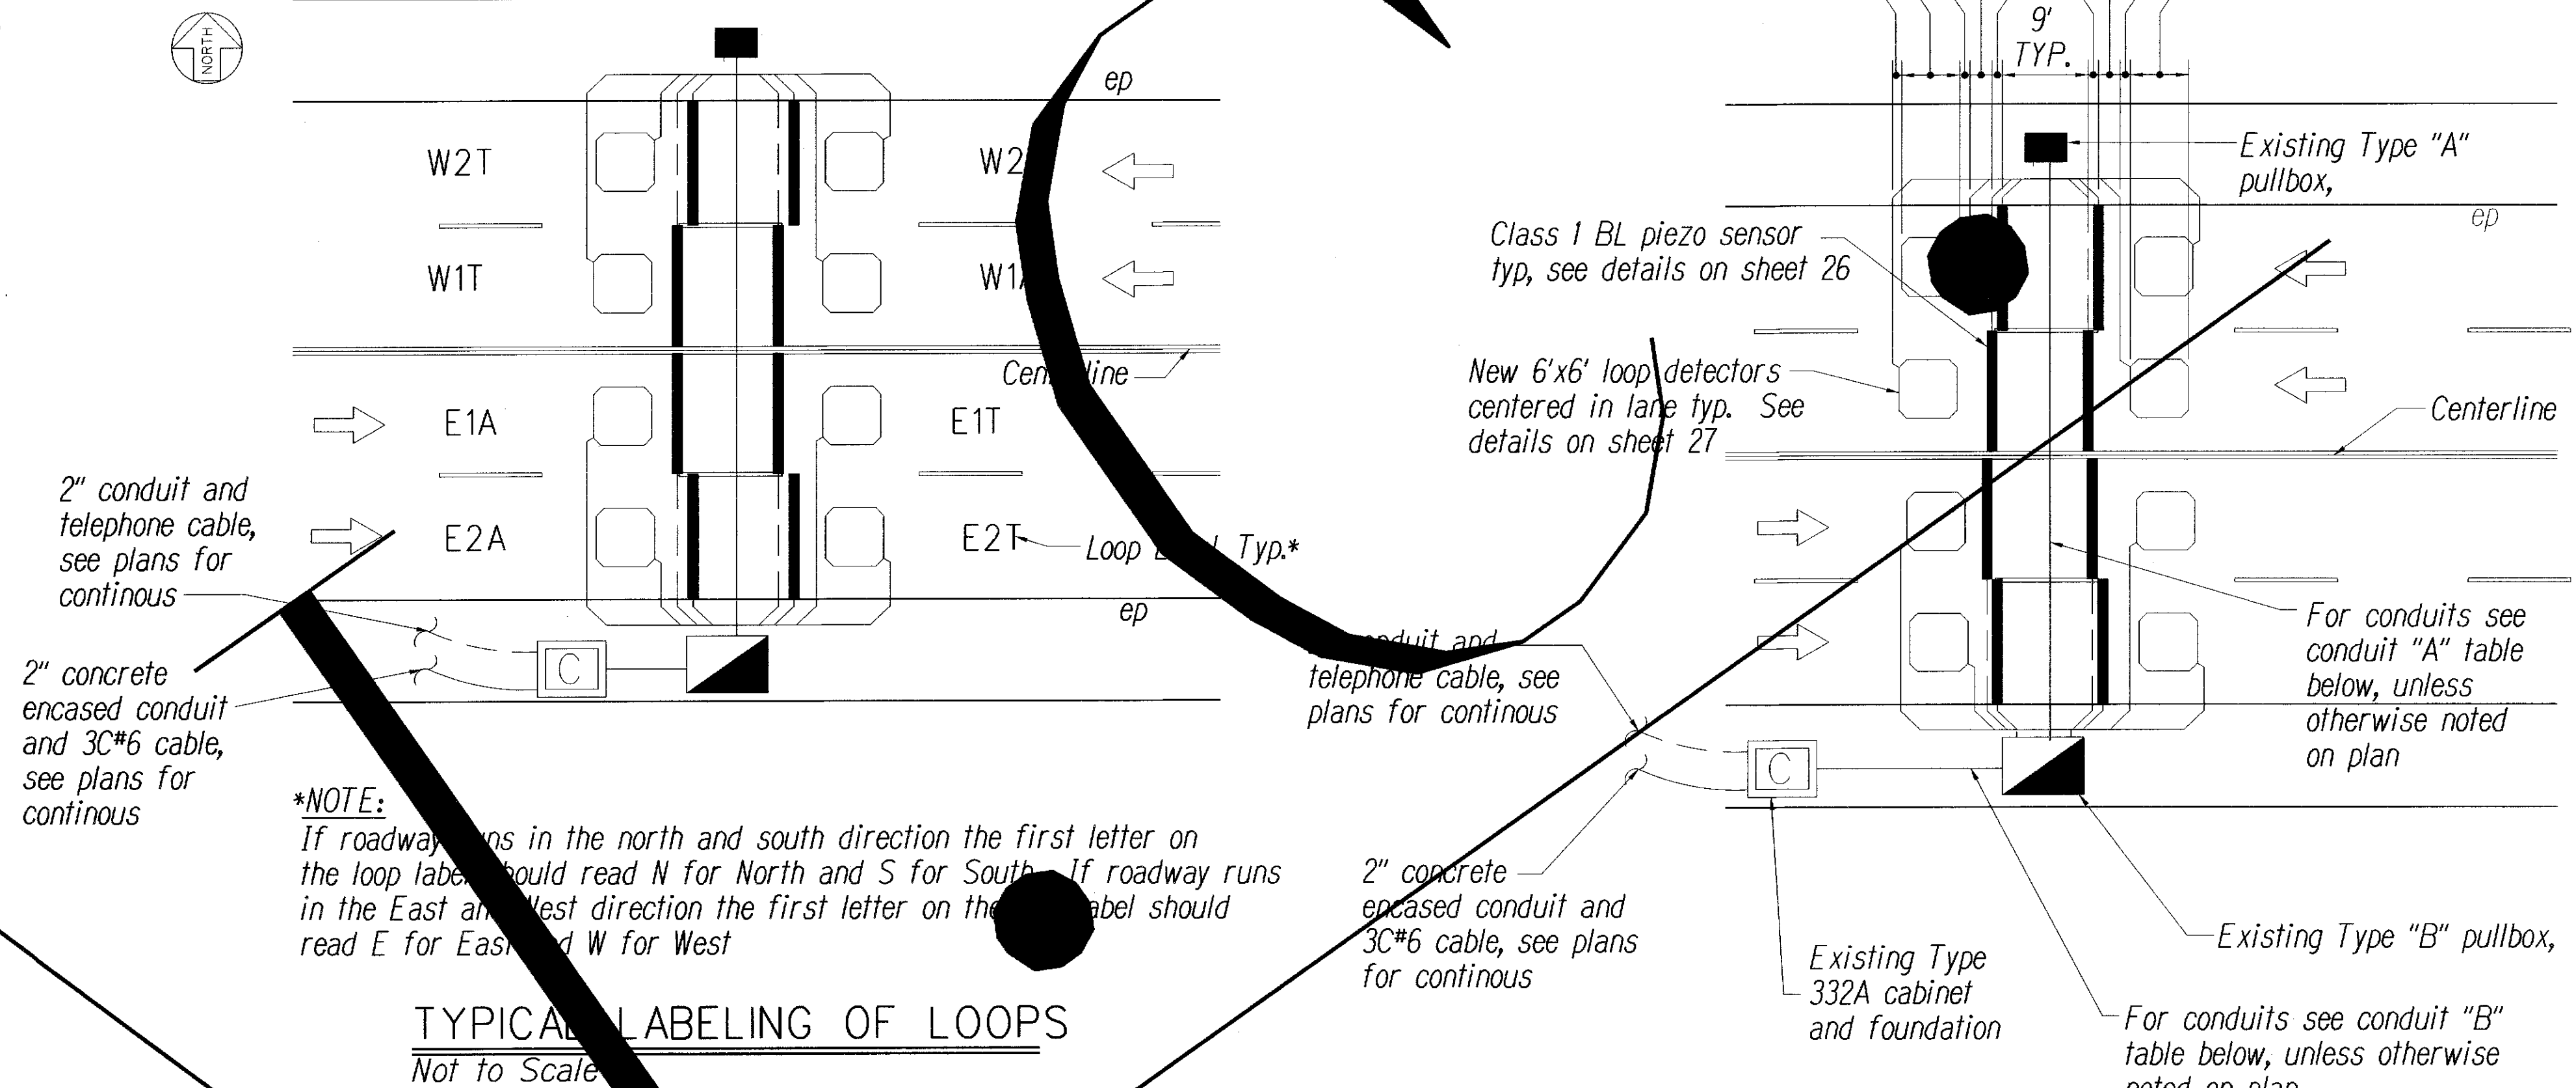

Top of terminal block

W2A
W1A
E1A
E2A
W2T
W1T
E1T
E2T

Bottom of terminal block

Connecting layout of loop lead-in wires to terminal block inside cabinet

TYPICAL FOUR-LANE ROADWAY TERMINAL BLOCK WIRING DETAILS

Not to Scale

Top of terminal block

W1A
E1A
W1T
E1T

Bottom of terminal block

Connecting layout of loop lead-in wires to terminal block inside cabinet

TYPICAL TWO-LANE ROADWAY TERMINAL BLOCK WIRING DETAILS

Not to Scale

NOTES:


1. All dimensions and callouts are typical unless otherwise noted on plan.
2. 332A cabinets shall not be placed next to exist. Sprinkler heads.

TYPICAL TRAFFIC COUNTING STATION LAYOUT DETAIL

Not to Scale

STATE OF HAWAII DEPARTMENT OF TRANSPORTATION HIGHWAYS DIVISION	
TRAFFIC COUNTING STATION DETAILS	
HONOAPIILANI HIGHWAY RESURFACING Vicinity of Hooihui Road to Plantation Estates Golf Course Project No. 30A-01-10M	
Scale: As Shown	Date: August, 2009
SHEET No. 1 OF 3 SHEETS	

FED. ROAD DIST. NO.	STATE	PROJ. NO.	FISCAL YEAR	SHEET NO.	TOTAL SHEETS
HAWAII	HAW.	30A-01-10M	2011	26	40

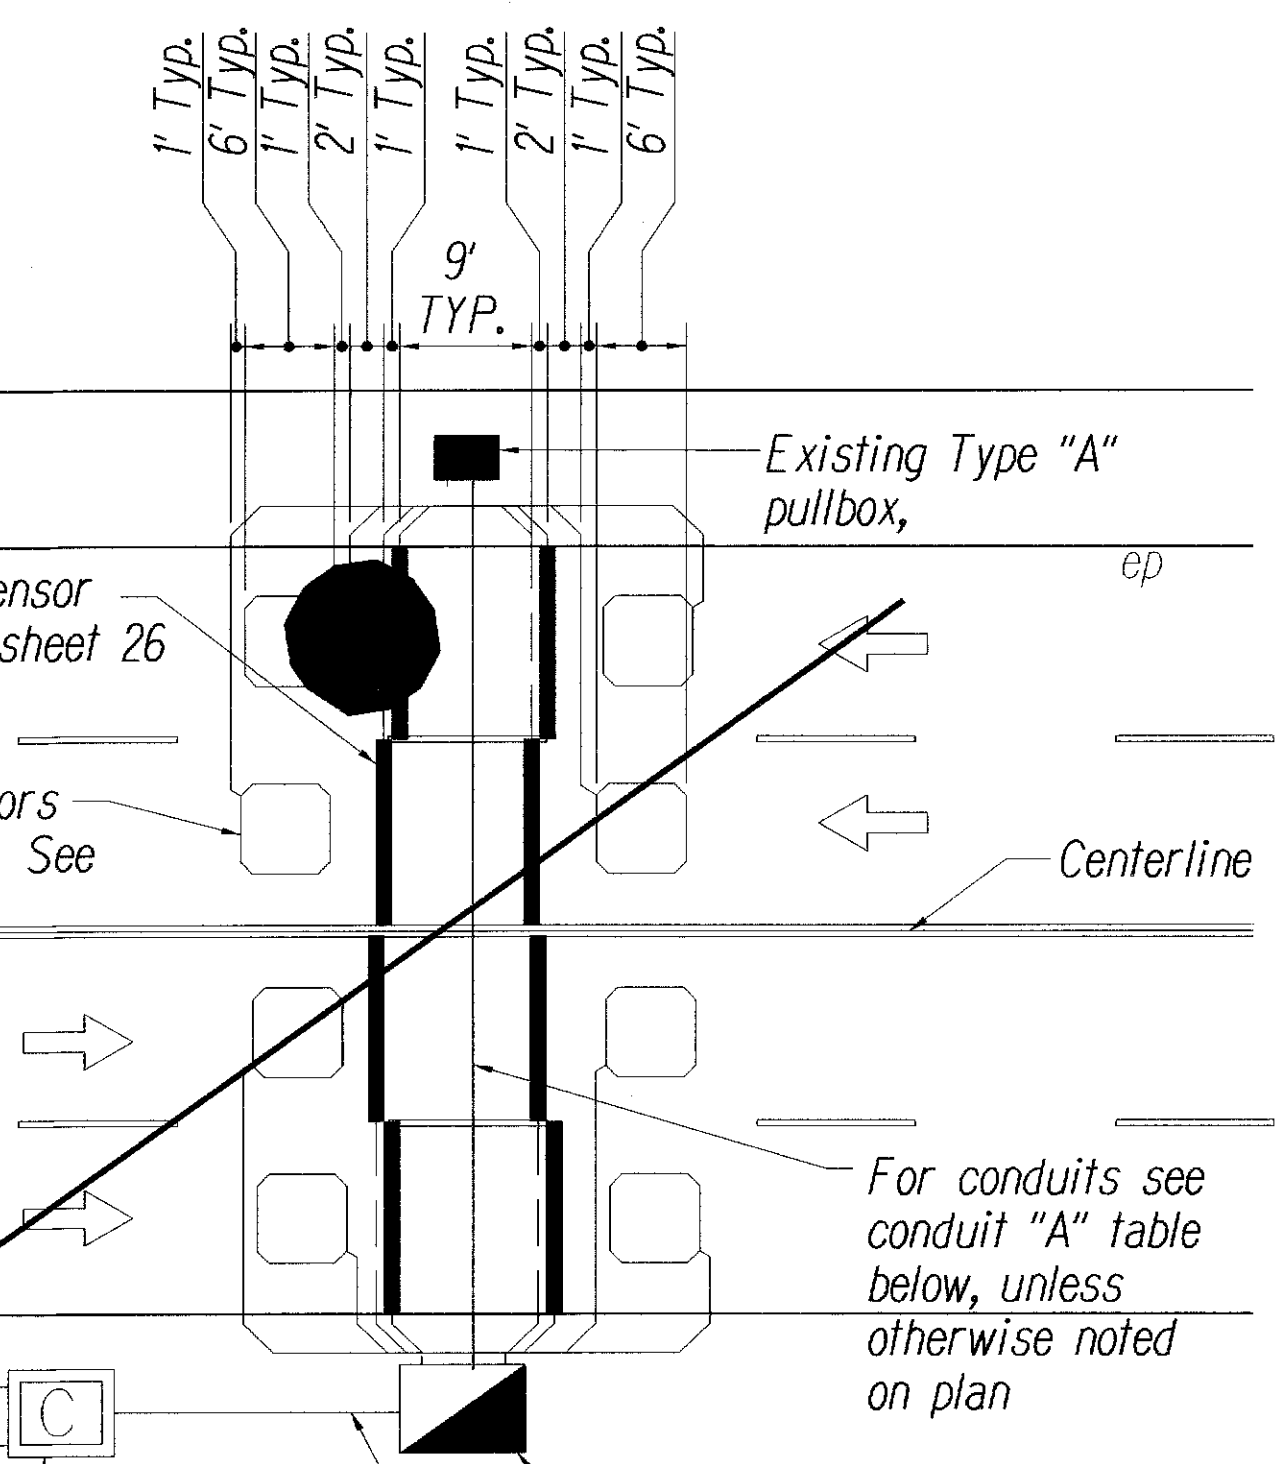

Conduit "A" Table:

Number of lanes	Conduit* #size	Class 1 BL sensor lead cables	2c #14 Loop detector cables
2	1-4"	2	2
4	1-4", 1-2"	4	4

*Conduits shall be concrete encased

Conduit "B" Table:


Number of lanes	Conduit* #size	Class 1 BL sensor lead cables	2c #14 Loop detector cables
2	1-4", 1-2"	4	4
4	3-4"	8	8

"AS-BUILT"



26

FED. ROAD DIST. NO.	STATE	PROJ. NO.	FISCAL YEAR	SHEET NO.	TOTAL SHEETS
HAWAII	HAW.	30A-01-10M	2011	28	40

NOTE:
1. Pavement structure shall be restored to equal or better than original condition in thickness and quality.

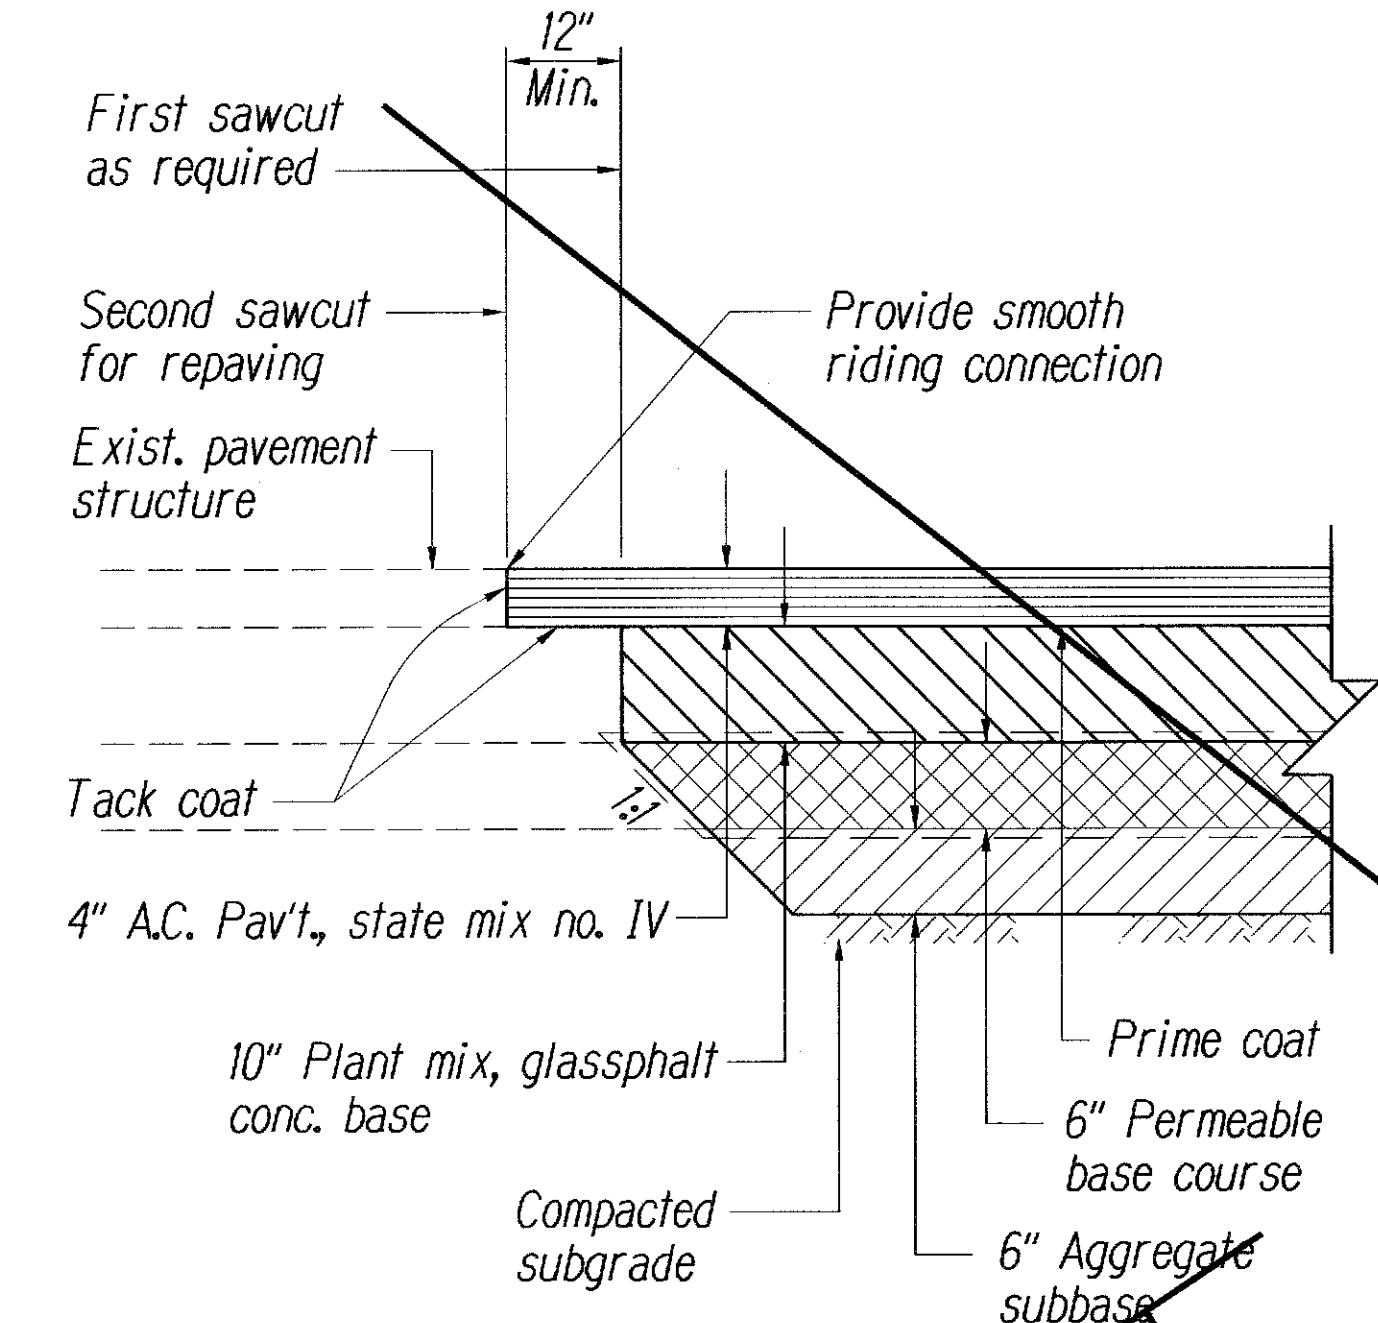


EXIST. A.C. PAVEMENT RESTORATION DETAIL
Not to Scale

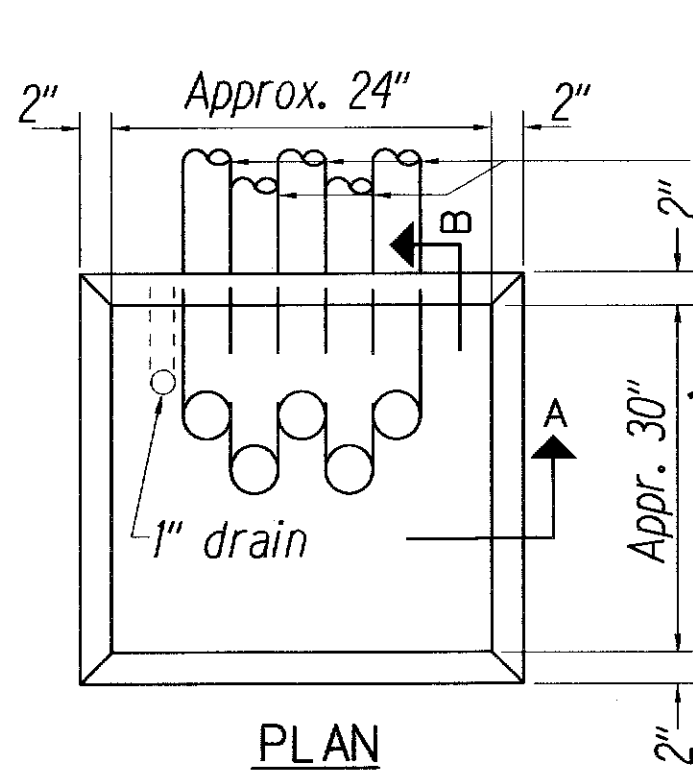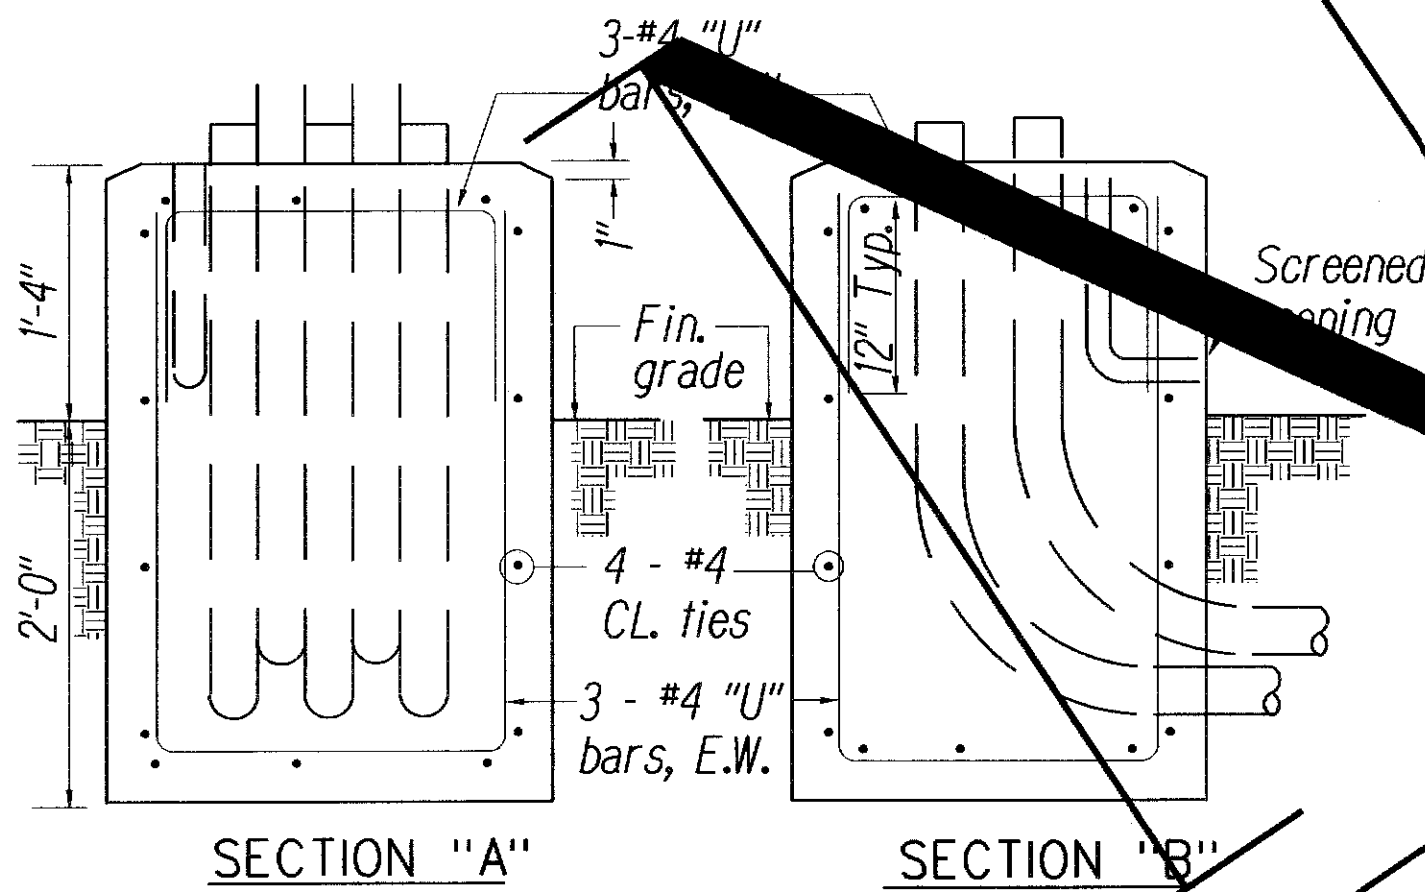

TYPE "D" CONC. BASE FOR CONTROLLER CABINETS
Not to Scale



5 - 2 Conduits unless otherwise noted

NOTES:
1. Concrete shall be class "B".
2. Dimensions shall be altered to suit controller cabinet actually furnished.
3. Conduit bends and drain are incidental to concrete base.
4. Refer to cabinet manufacturer's specifications for details of anchor bolts and base setting.
5. All exposed surfaces of concrete base shall have a class 2, rubbed finish.

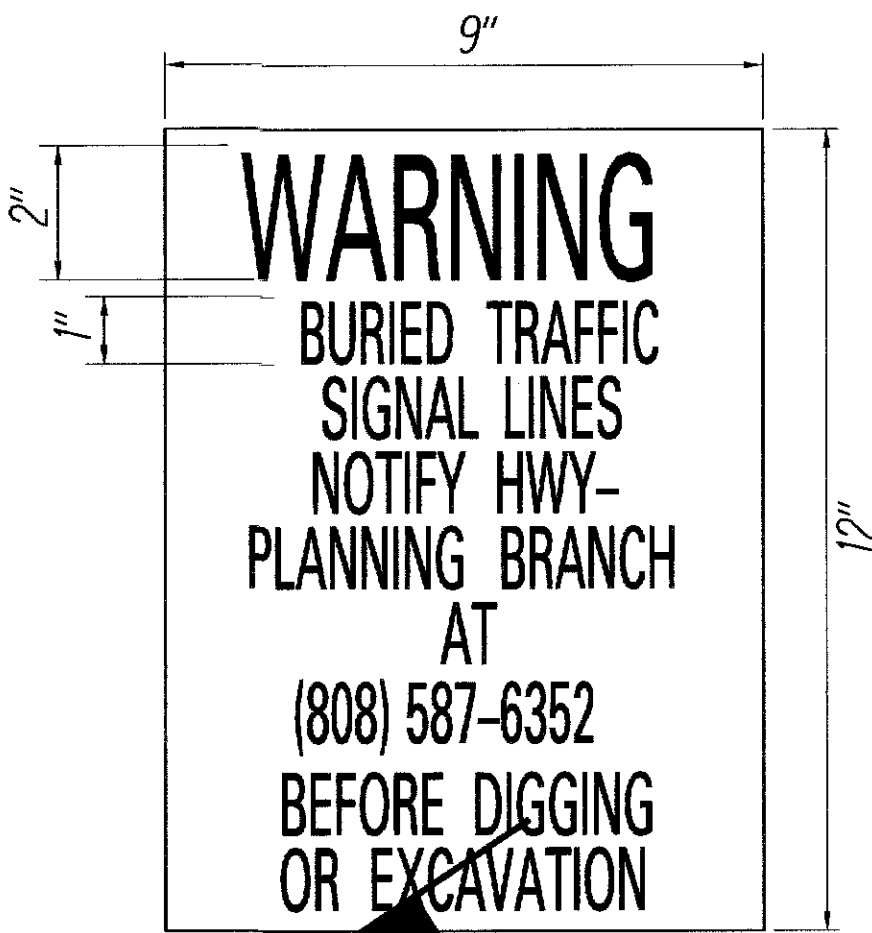

NOTES:
1. For sign post detail see standard plans TE-01 thru TE-04.
2. Two (2) warning signs shall be placed on each sign post "Back-to-Back".
3. Text on sign shall be lettered both ways.


WARNING SIGN DETAIL
Not to Scale

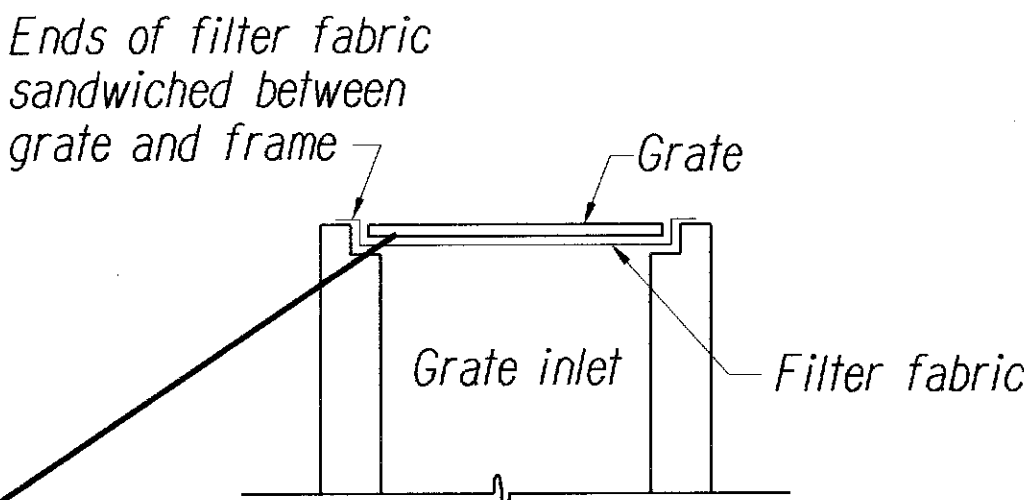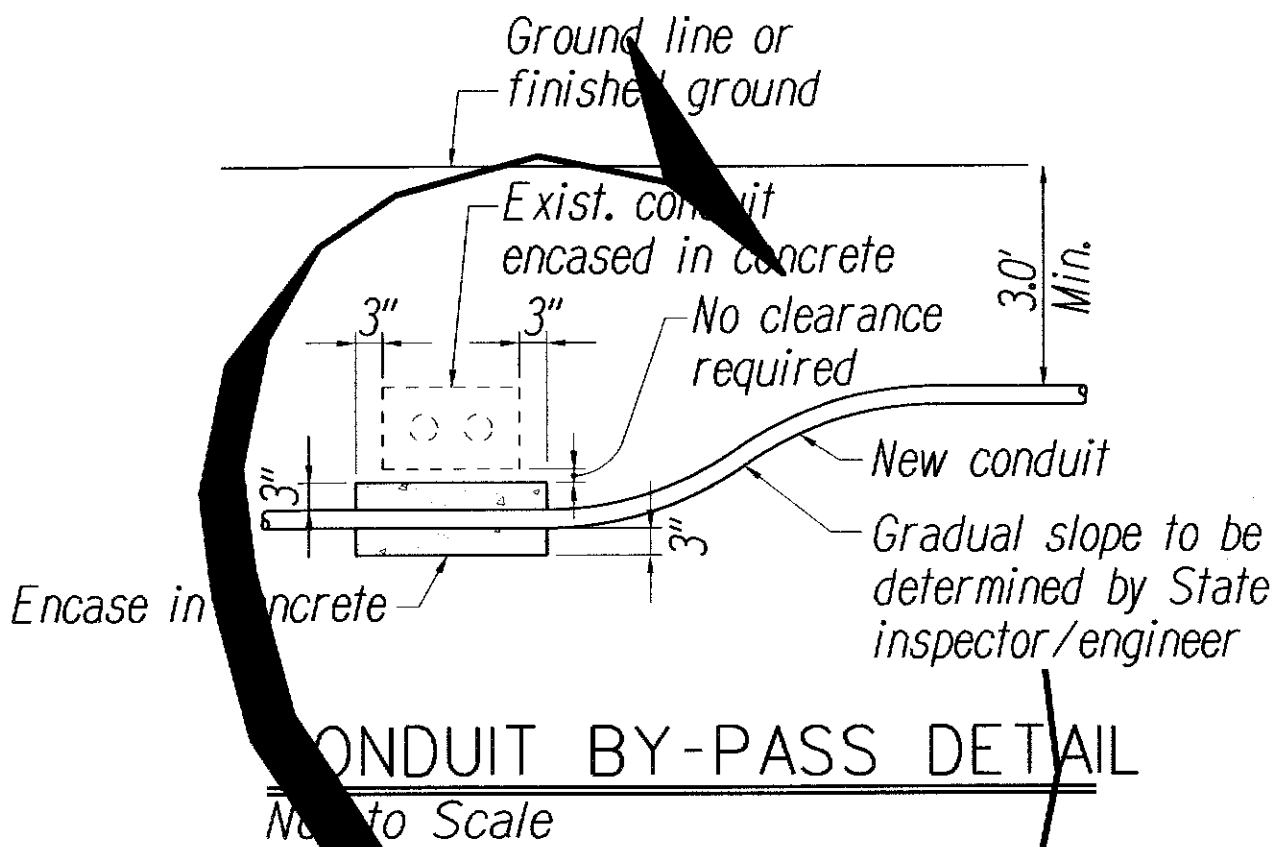


NOTES:
1. Contractor shall install sediment barrier at drain inlets located downstream of construction site.
2. Filter fabric shall be 15 mil (min.) "envirofence #10800" by nicolon corp. or approval equal.
3. Contractor shall check the condition of the filter at the beginning and ending of each work day and repair/clean as necessary.

TEMPORARY SEDIMENT BARRIER AT DRAIN INLET
Not to Scale

NOTES:
1. Contractors shall install sediment control filter at catch basins located downstream of construction site.
2. During an above normal rainfall event, contractor shall remove sediment filters from curb opening and replace once the event has passed. Contractor shall check the condition of filter after each storm and clean/repair as necessary.

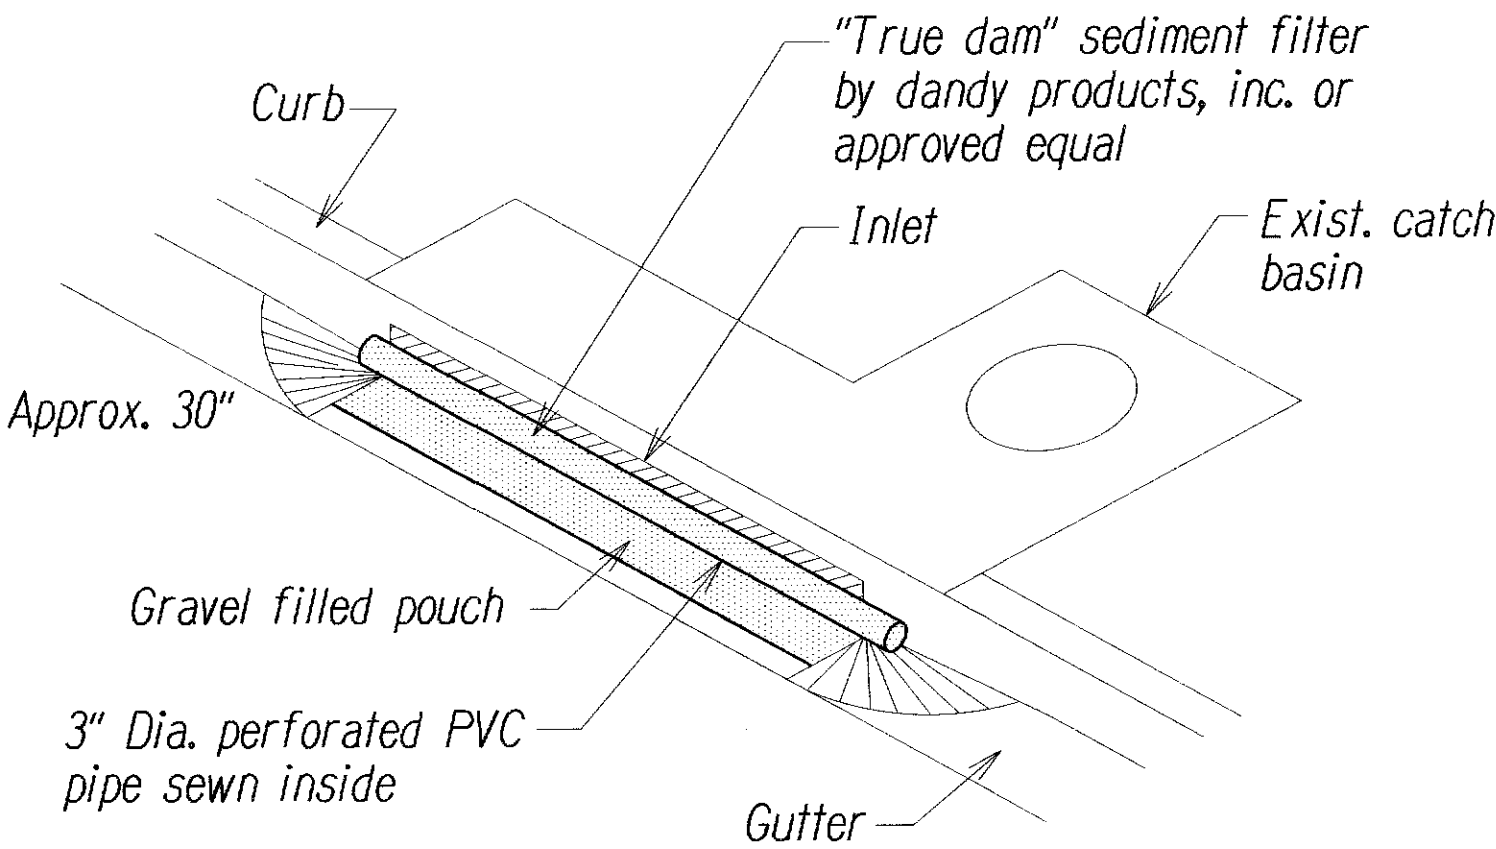

SEDIMENT CONTROL FILTER AT CATCH BASIN
Not to Scale

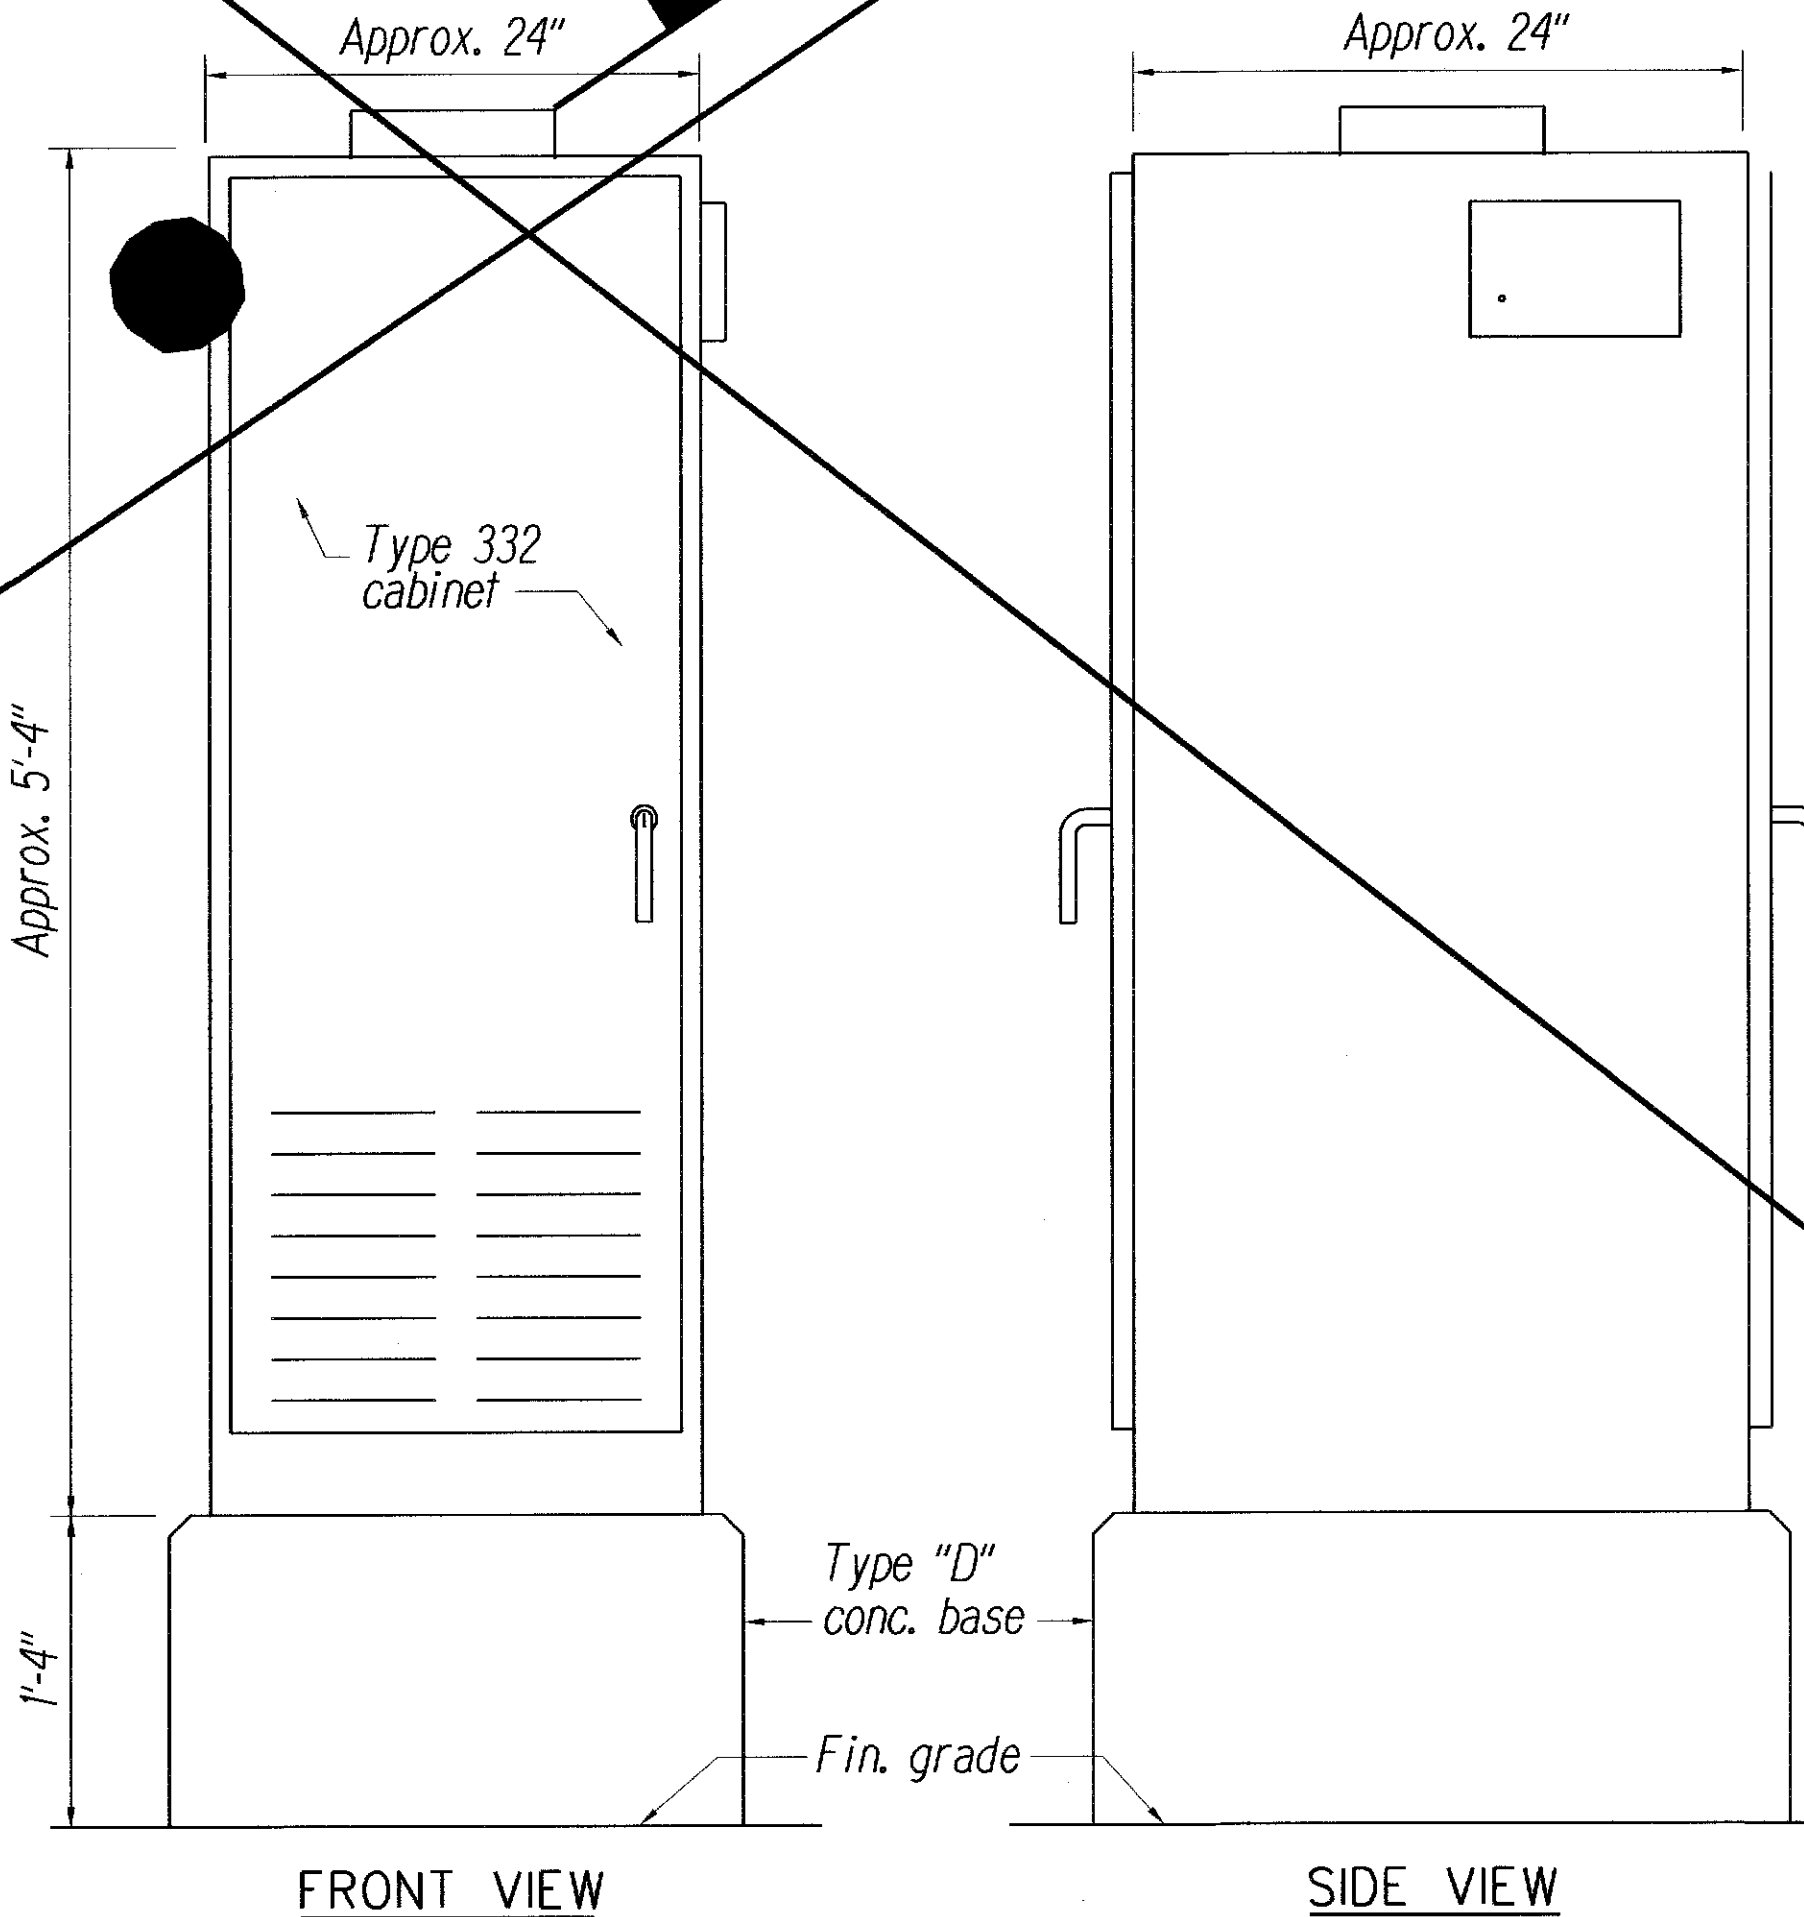

332 CABINET (EXISTING)
Not to Scale

LEGEND FOR AS-BUILT POSTINGS	
	Squiggly line for as-built deletion
	Double line for as-built deletion
	Text for as-built posting


STATE OF HAWAII
DEPARTMENT OF TRANSPORTATION
HIGHWAYS DIVISION

**TRAFFIC COUNTING
STATION DETAILS**
HONOAPIILANI HIGHWAY RESURFACING
Vicinity of Hoohui Road to Plantation Estates Golf Course
Project No. 30A-01-10M
Scale: As Shown Date: August, 2009
SHEET No. 3 OF 3 SHEETS



DESIGNED BY	DATE
CHECKED BY	
NOTED BY	
QUANTITIES BY	
PLANNED BY	
ORIGINAL PLAN	

FED. ROAD DIST. NO.	STATE	PROJ. NO.	FISCAL YEAR	SHEET NO.	TOTAL SHEETS
HAWAII	HAW.	30A-01-10M	2011	ADD.28S-1	40

If grassed area, provide 6" thick top soil & sod
If paved area, reconstruct pavement equal to or better than existing

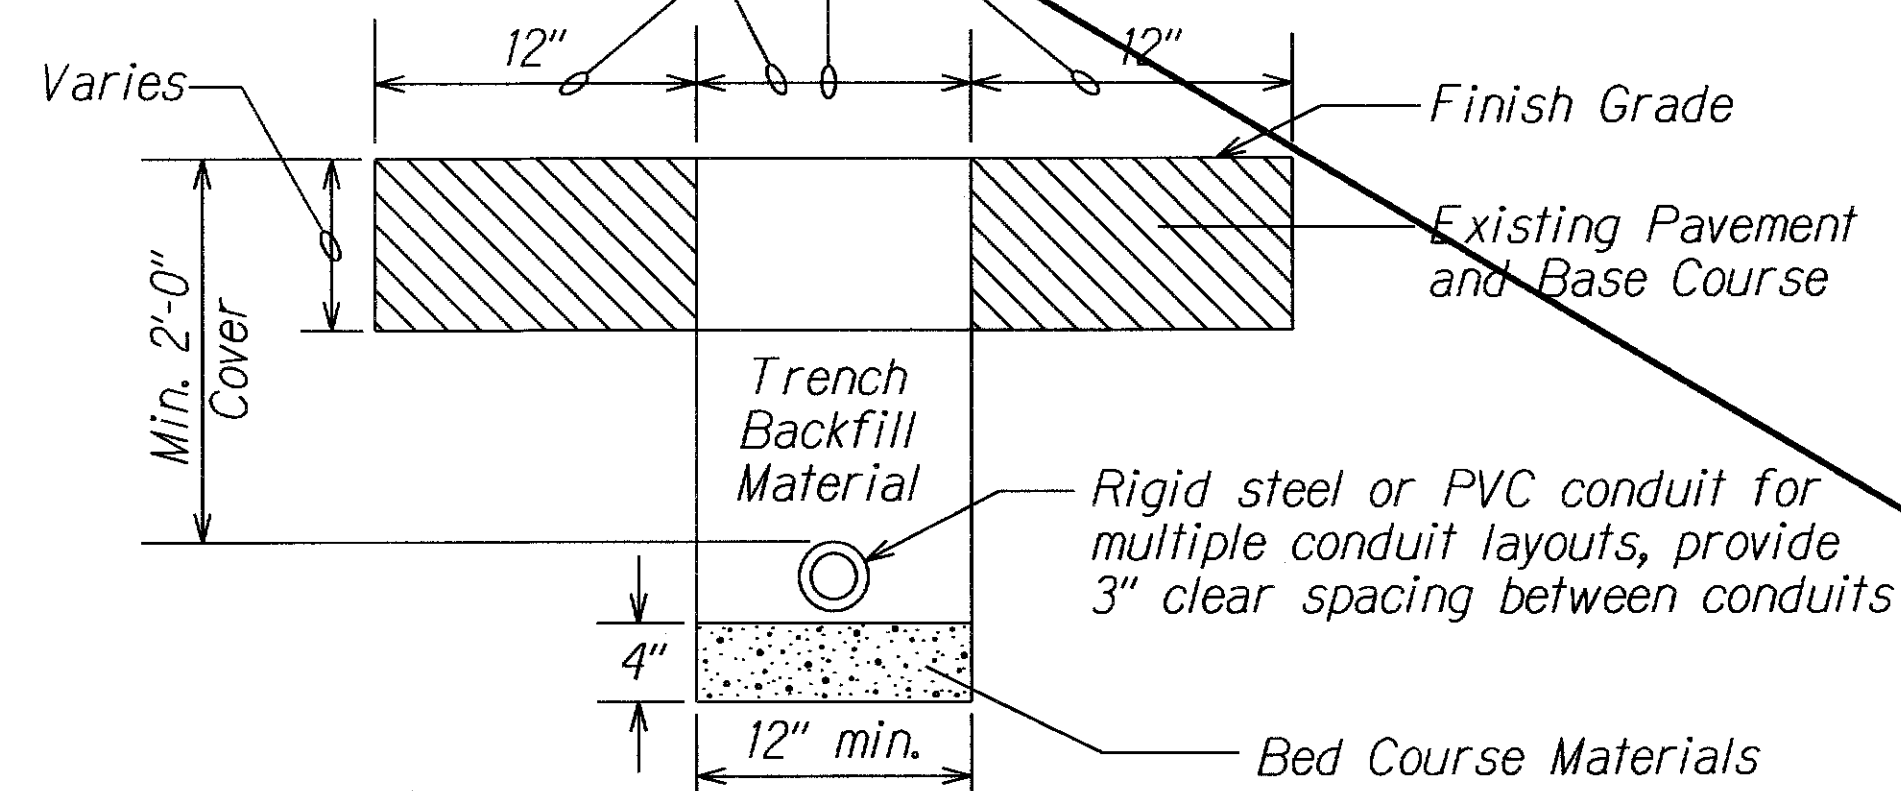

TYPICAL TRENCH SECTION
FOR CONDUIT
Not to Scale

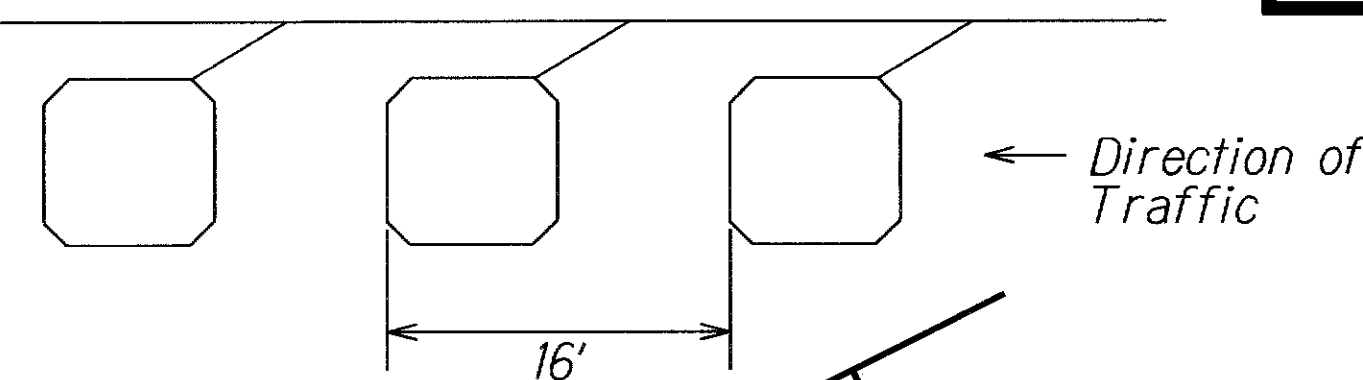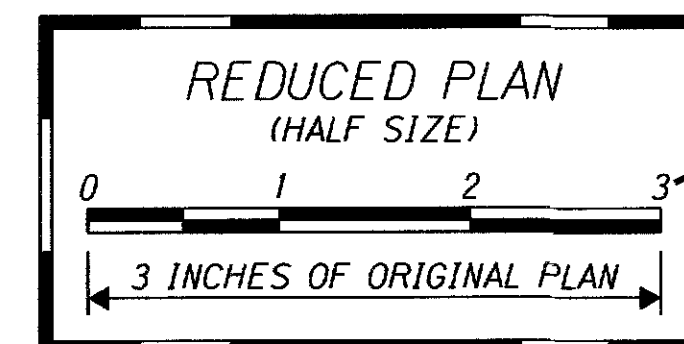


LOOP-PIEZO LAYOUT
Not to Scale


LOOP LAYOUT NOTES:

1. Detector loop shall consist of three (3) turns of 1/C 14 AWG RHW-USE-XLP wire or equivalent embedded in a 3/8" minimum sawcut, except as noted.
2. Loop and lead-in to the first pullbox shall be one continuous wire. Lead-in wires from the same loop shall be twisted in pairs, two (2) turns per foot. DO NOT twist loop pairs with another loop-pairs.
3. All lead-in wires shall be crimped with open end lugs that will fit into the terminal board slots snugly.
4. The Contractor shall connect the inductance wires on each terminal slot.
5. The left lane in the direction of traffic flow is designated as lane 1, and the lane next to its right as lane 2 and so on as indicated on plans.
6. Clean sawcut thoroughly before filling with appropriate sealant.
7. All loop lead-in wires in all enclosures including pullboxes shall be identified and labeled by direction of traffic flow and lane numbers as shown on plans.
8. All cables and wires terminated within an enclosure shall have a minimum 12" additional slack.

6" thick Class "A" conc. slab reinforced w/#4 bars 12" O. C. both ways

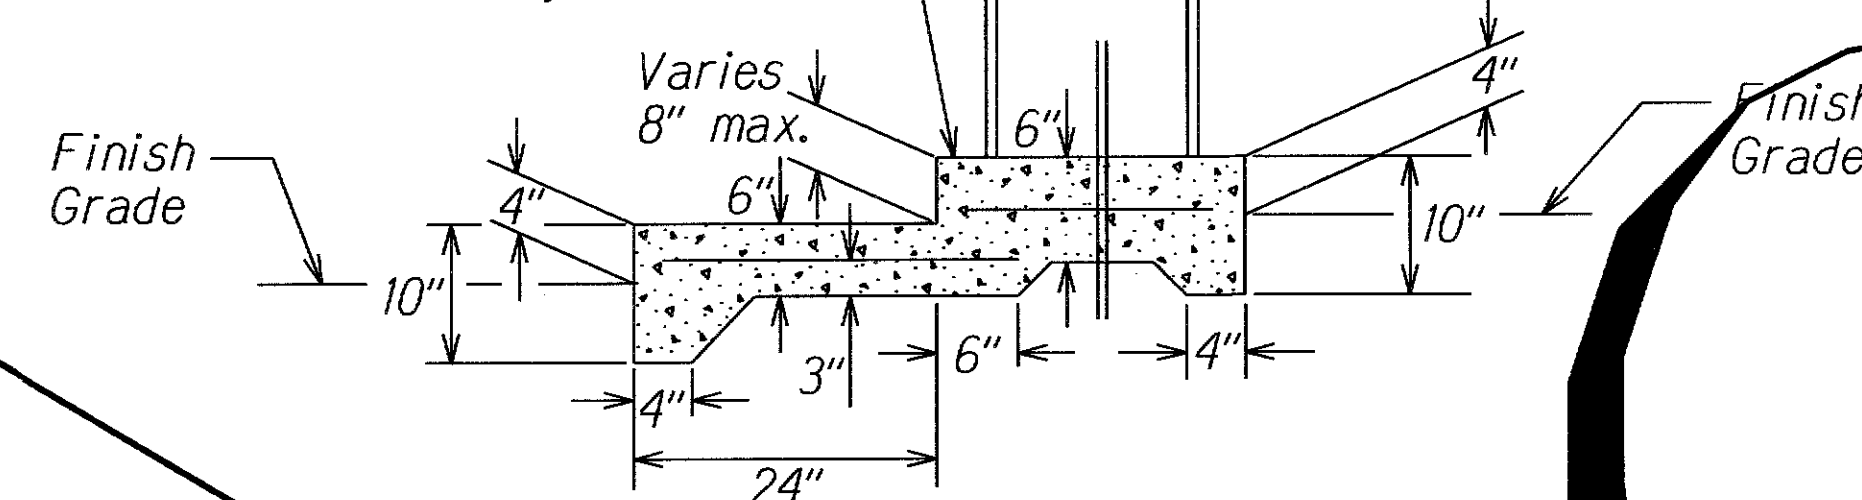

SECTION B-B

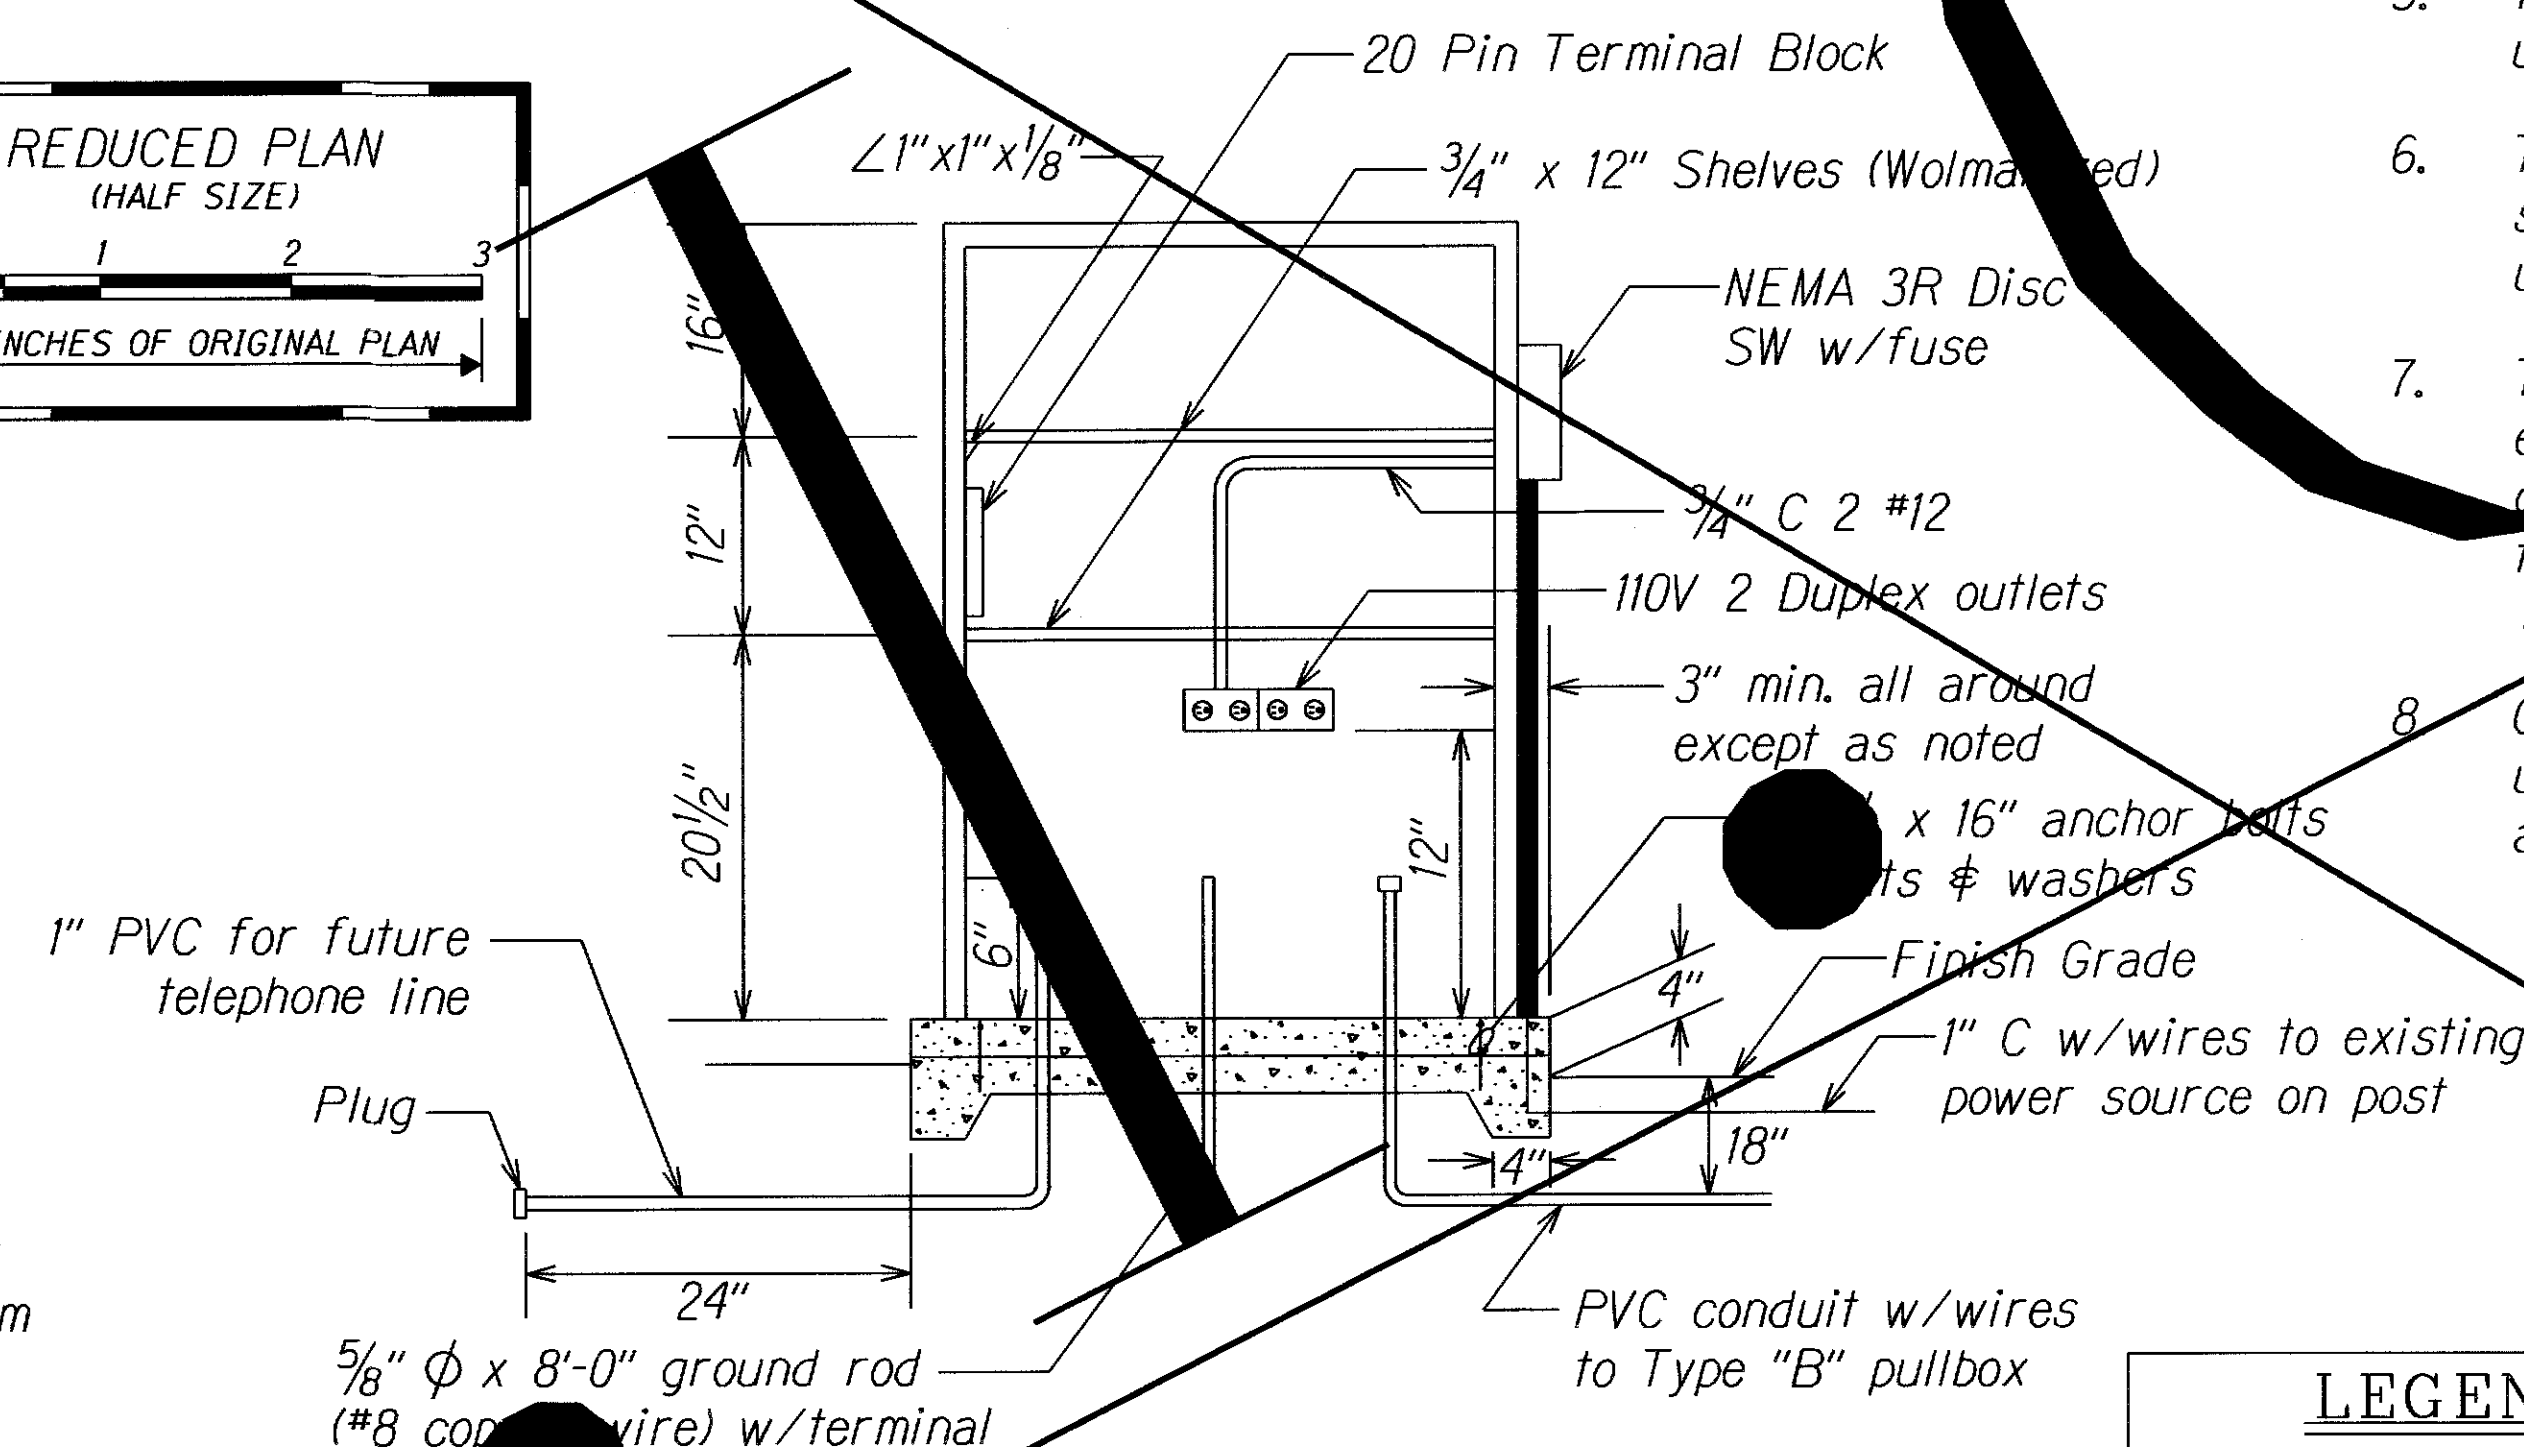


SECTION A-A

CONCRETE PAD AND CABINET
Not to Scale

LEGEND FOR AS-BUILT POSTINGS


	Squiggly line for as-built deletion
	Double line for as-built deletion
Roadway	Text for as-built posting

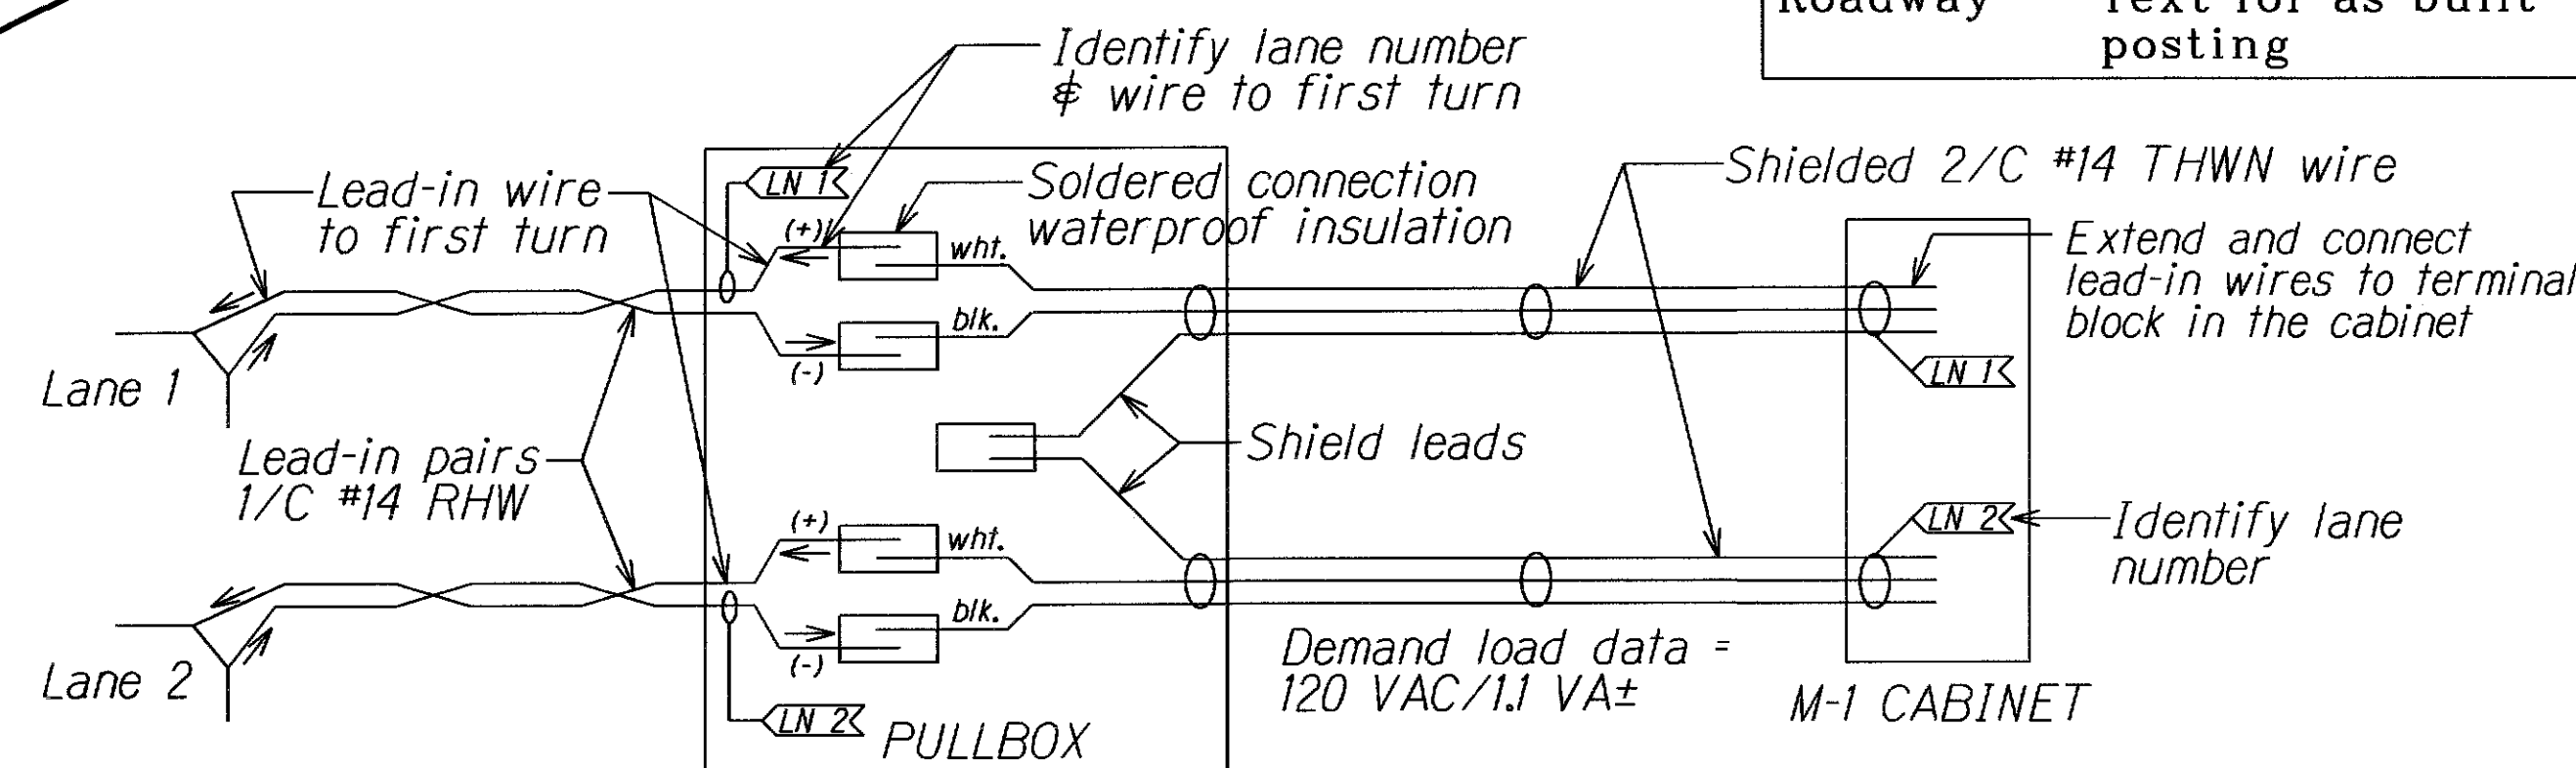

DETECTOR LOOP LEAD-IN WIRING & IDENTIFICATION IN PULLBOX & CABINET
Not to Scale

GENERAL NOTES:

1. The locations of new inductance loops, pullboxes and cabinets/junction boxes shall be staked out in the field by the Contractor and approved by the Engineer prior to installation.
2. The Contractor shall inform the Engineer at least one (1) day prior to posting of the concrete slab/pad, saw-cutting pavement and installing inductance loops.
3. Continuity of inductance loops and lead-in wires shall be tested and warranted for one (1) year from date of acceptance by the Contractor.
4. The Contractor shall restore all affected areas to their original condition. This item of work shall not be paid for separately, but shall be considered incidental to work of other paid items.
5. The Contractor shall verify the location of the existing utilities and underground structures whether or not shown on the plans.
6. The Contractor shall assume that existing underground utilities not shown on the plans may exist, therefore, he shall contact the different utility companies for information and toning.
7. The Contractor shall be held liable for any damages incurred to the existing utilities and underground structures as a result of his operations. All damaged portions shall be replaced in accordance with the standards and specifications of the affected utility company at no cost to the STATE.
8. Changes to the contract plans and specifications shall not be permitted, unless otherwise authorized by the Engineer upon written justification and request for approval by the Contractor.

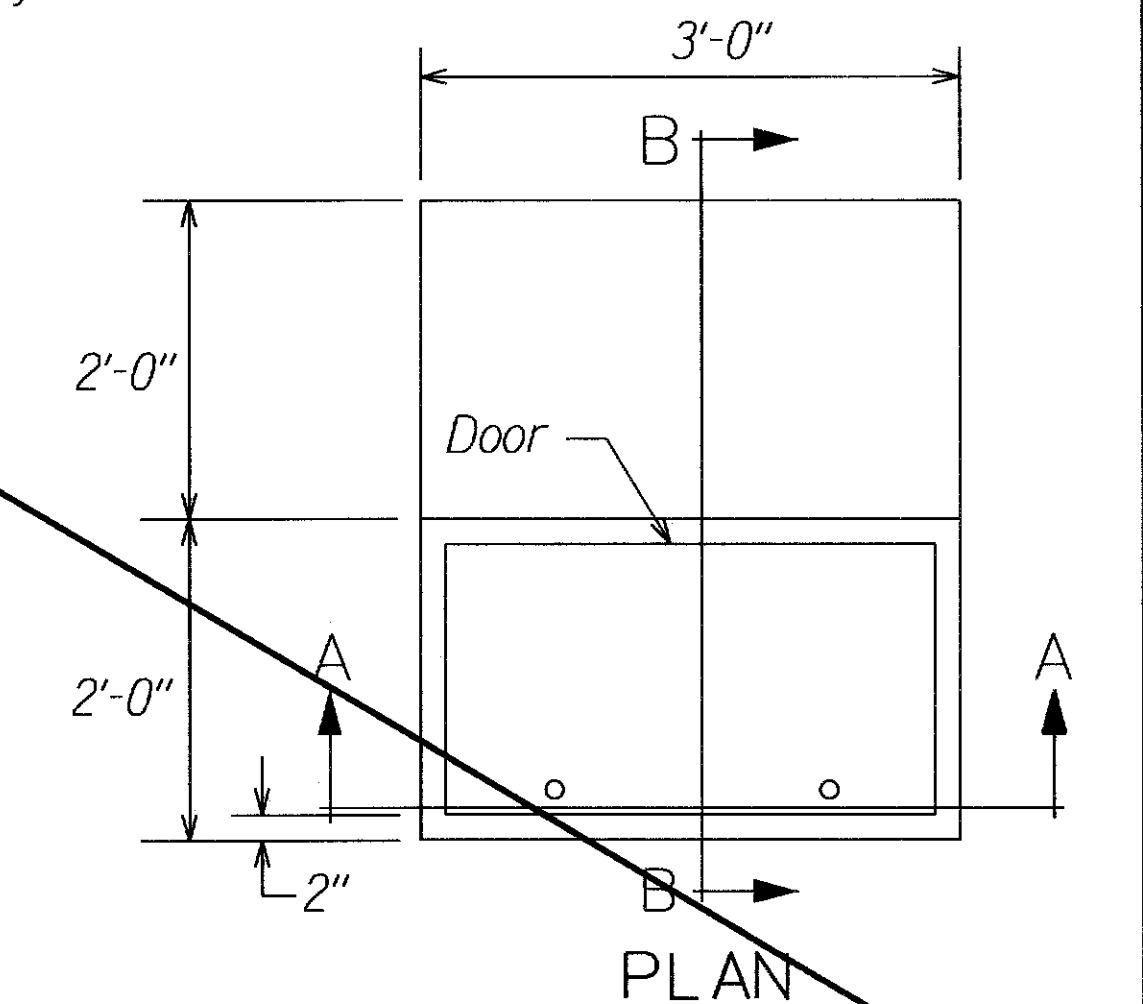

12/3/10	Added sheet
---------	-------------

DATE	REVISION
------	----------

STATE OF HAWAII DEPARTMENT OF TRANSPORTATION HIGHWAYS DIVISION TRAFFIC COUNTING STATION DETAILS HONOAPIILANI HIGHWAY RESURFACING Vicinity of Hoohui Road to Plantation Estates Golf Course Project No. 30A-01-10M Not to Scale Date: Dec., 2010
--

SHEET No. 1 OF 2 SHEETS


"AS-BUILT"

ADD.28S-1

FED. ROAD DIST. NO.	STATE	PROJ. NO.	FISCAL YEAR	SHEET NO.	TOTAL SHEETS
HAWAII	HAW.	30A-01-10M	2011	ADD28S-2	40

GENERAL NOTES:

- Provide a minimum of one 16 ϕ x 2.5m Copperweld Ground Rod in each pullbox. When directed by the Traffic Signal Inspector/Engineer, install additional Ground Rods. Cost of Ground Rods shall be incidental to the pullboxes.
- All pre-cast concrete pullboxes shall be manufactured in two pieces.
- The pullbox with cover shall be capable of supporting an MS 18 Loading.
- The maximum weight of the pullbox cover shall not exceed 27 kilograms.
- The openings for the conduits on all pullboxes shall be pre-cast concrete knockouts.
- After installing the conduits in the openings of the pullboxes, the Contractor shall fill the excess opening in the pre-cast knockouts with concrete mortar.
- Prior to installing the pullboxes, the Contractor shall compact the bottom of the trench and achieve a minimum of 95% relative compaction of the bottom of the trench.
- All concrete shall be Class A (25MPa, min.)
- Reinforcing shall be Grade 300 and all lapped splices shall be 360mm minimum.
- The #57 or #67 size aggregate shall conform to latest version of AASHTO M43 (ASTM D 448).
- Type "C" Pullbox shall be installed in a location protected from vehicular traffic (i.e. raised sidewalk, behind A.C. curbs, traffic signal standard or pipe guards).



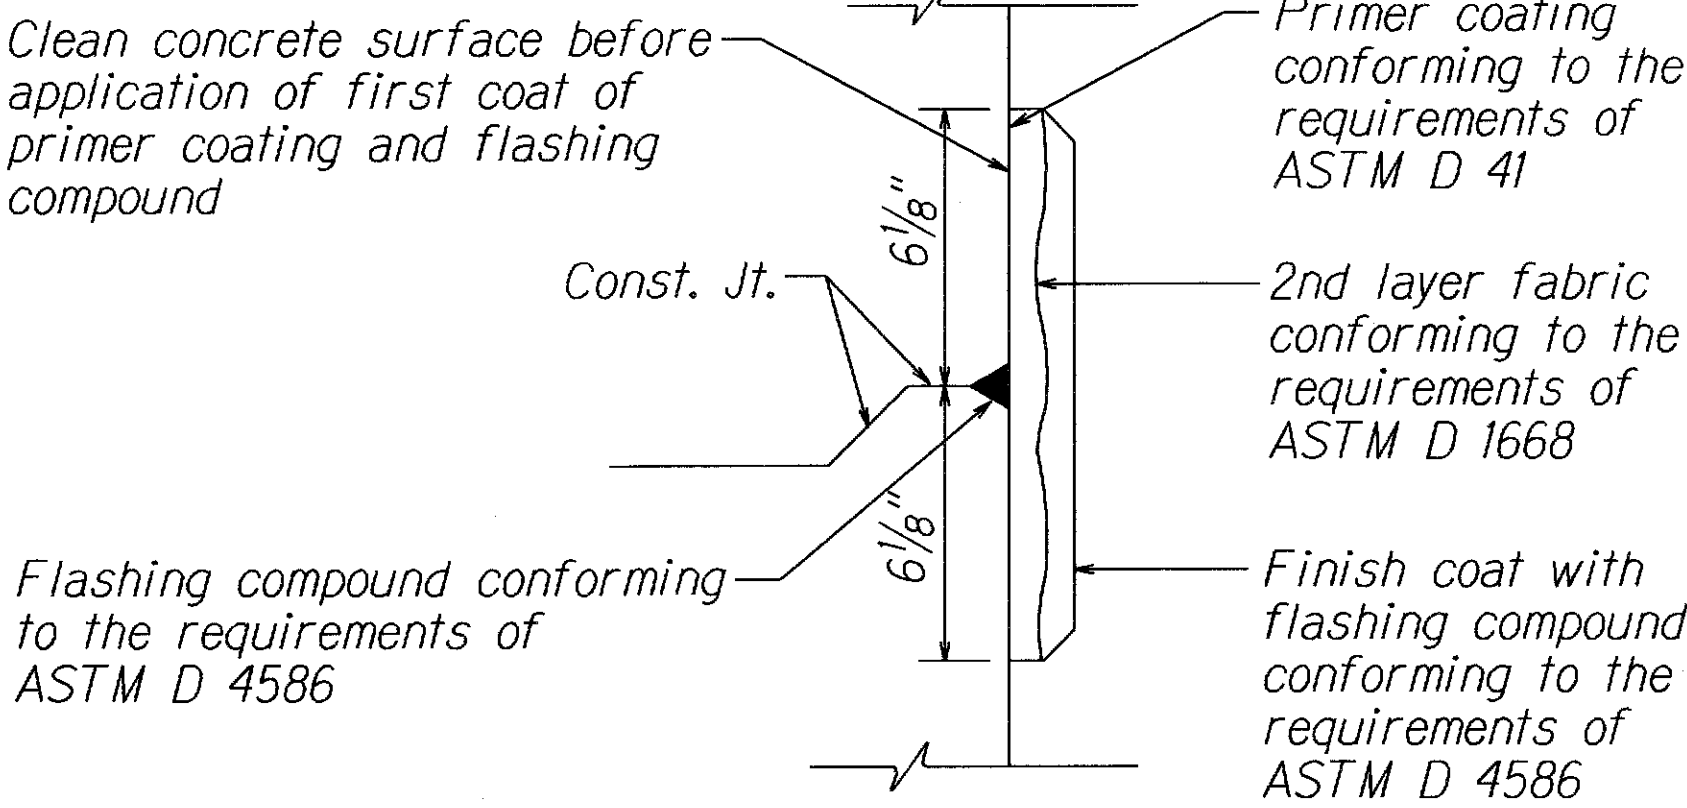


TYPICAL FLASHING COMPOUND WATERPROOFING DETAILS

Not to Scale
12/3/10 Added Sheet

DATE REVISION

STATE OF HAWAII DEPARTMENT OF TRANSPORTATION HIGHWAYS DIVISION TRAFFIC COUNTING STATION DETAILS HONOAPIILANI HIGHWAY RESURFACING Vicinity of Hoohui Road to Plantation Estates Golf Course Project No. 30A-01-10M Not to Scale Date: Dec., 2010	
SHEET NO. 2	OF 2 SHEETS

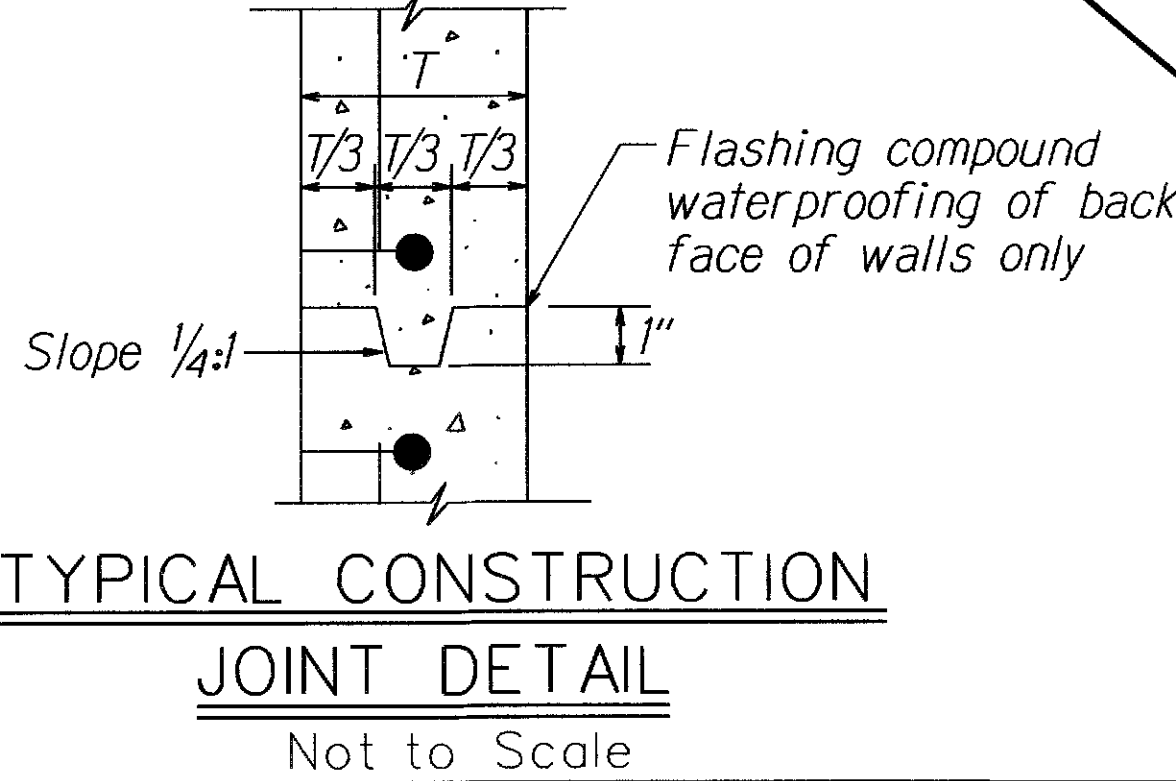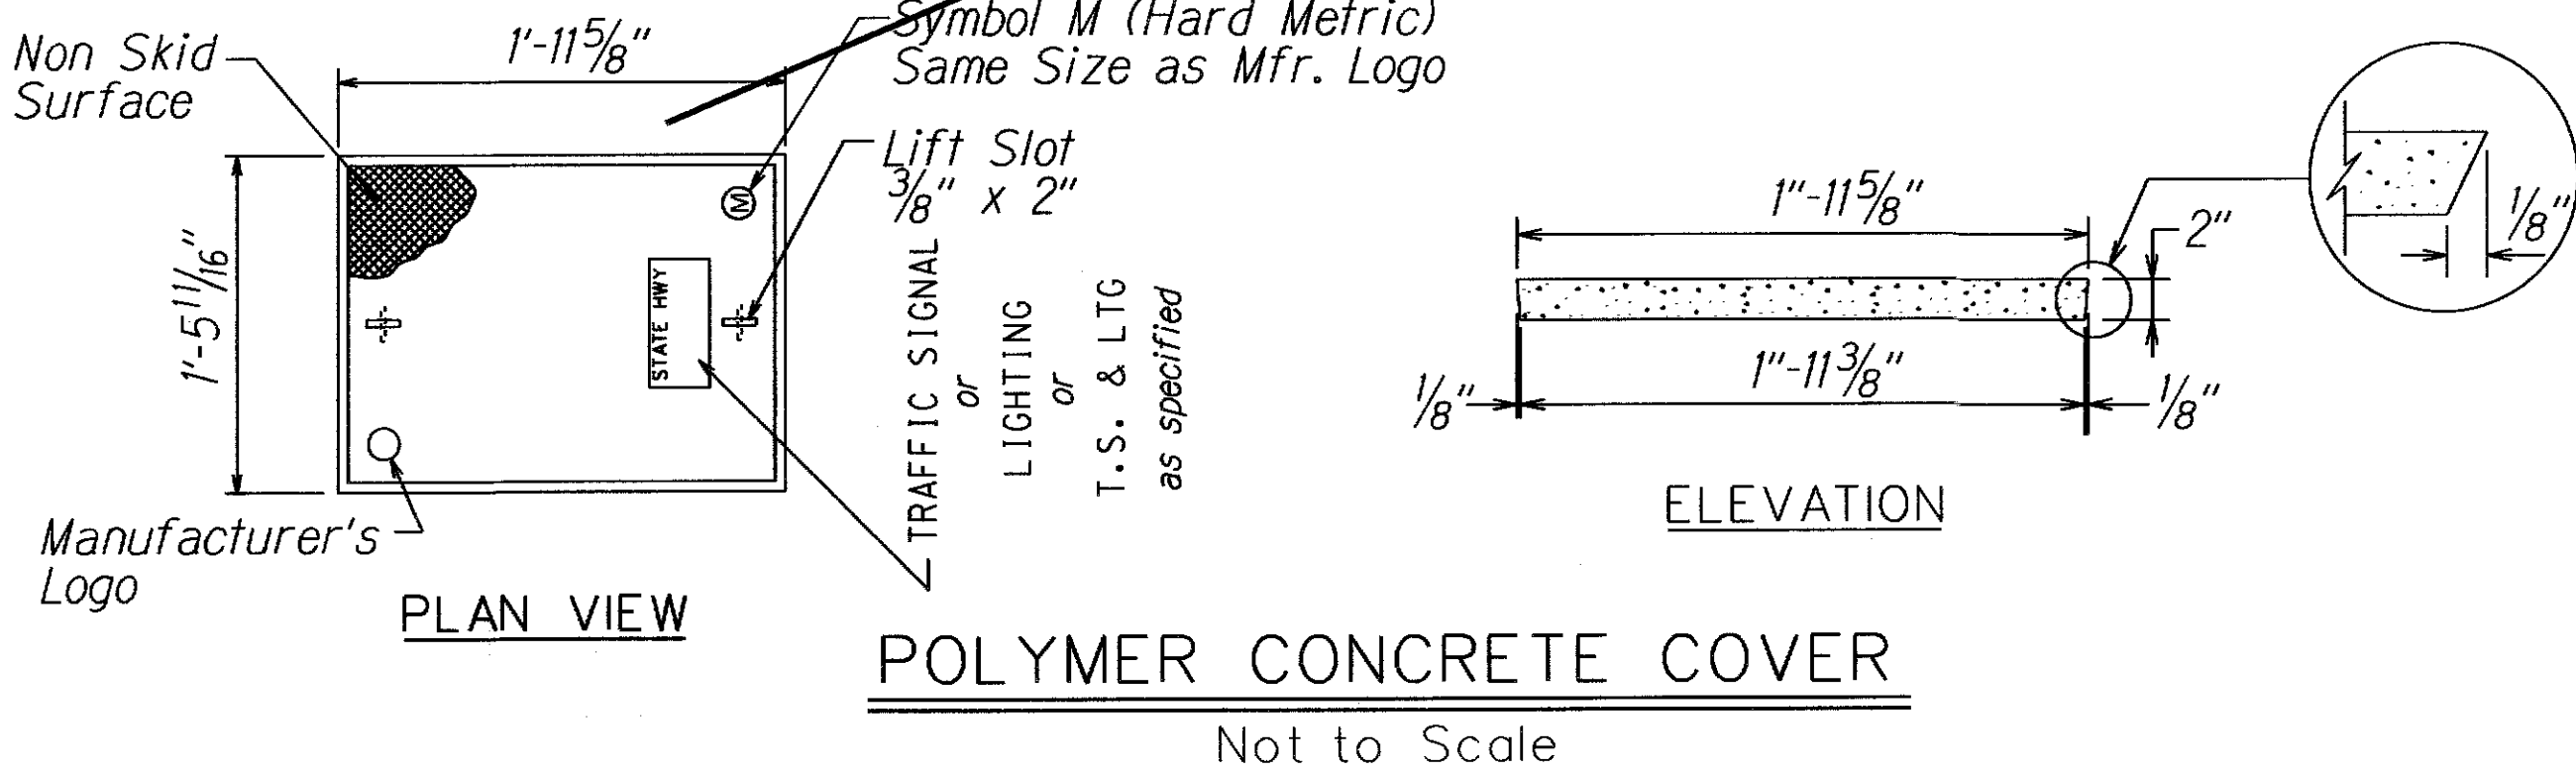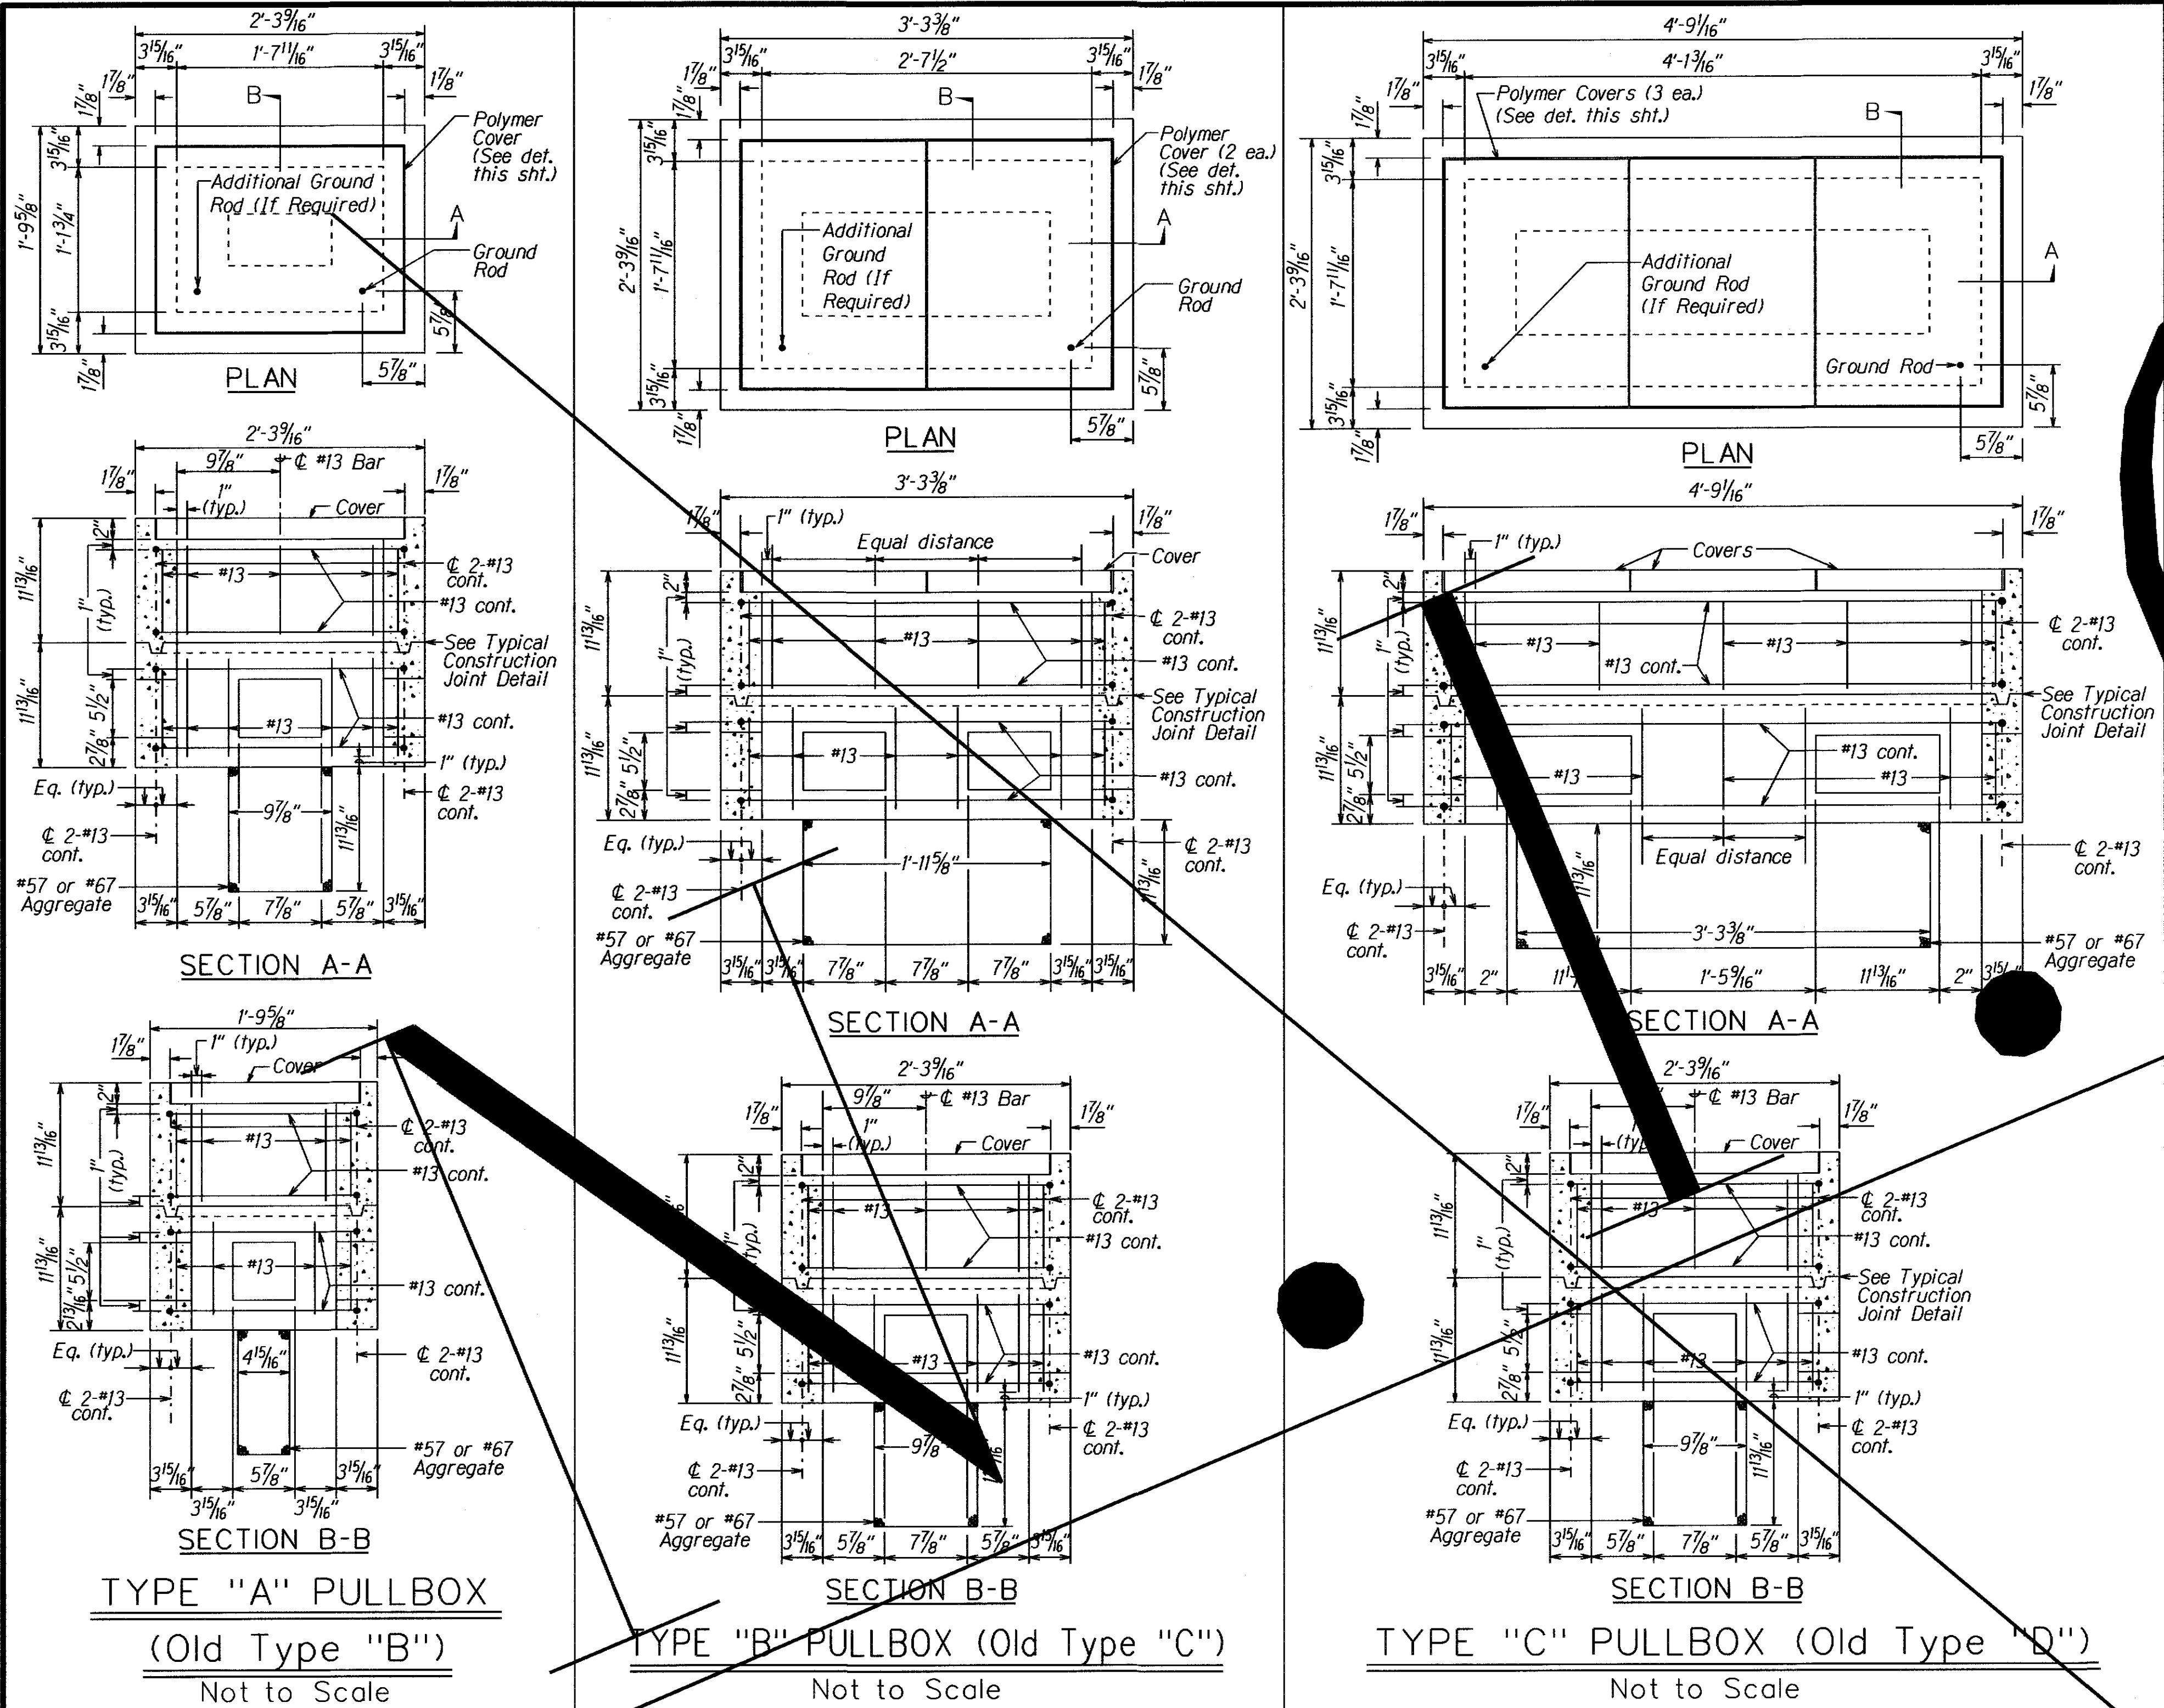

LEGEND FOR AS-BUILT POSTINGS	
	Squiggly line for as-built deletion
	Double line for as-built deletion
	Text for as-built posting

"AS-BUILT"

ADD.28S-2