


FED. ROAD DIST. NO.	STATE	PROJ. NO.	FISCAL YEAR	SHEET NO.	TOTAL SHEETS
HAWAII	HAW.	30A-01-10M	2011	6	40

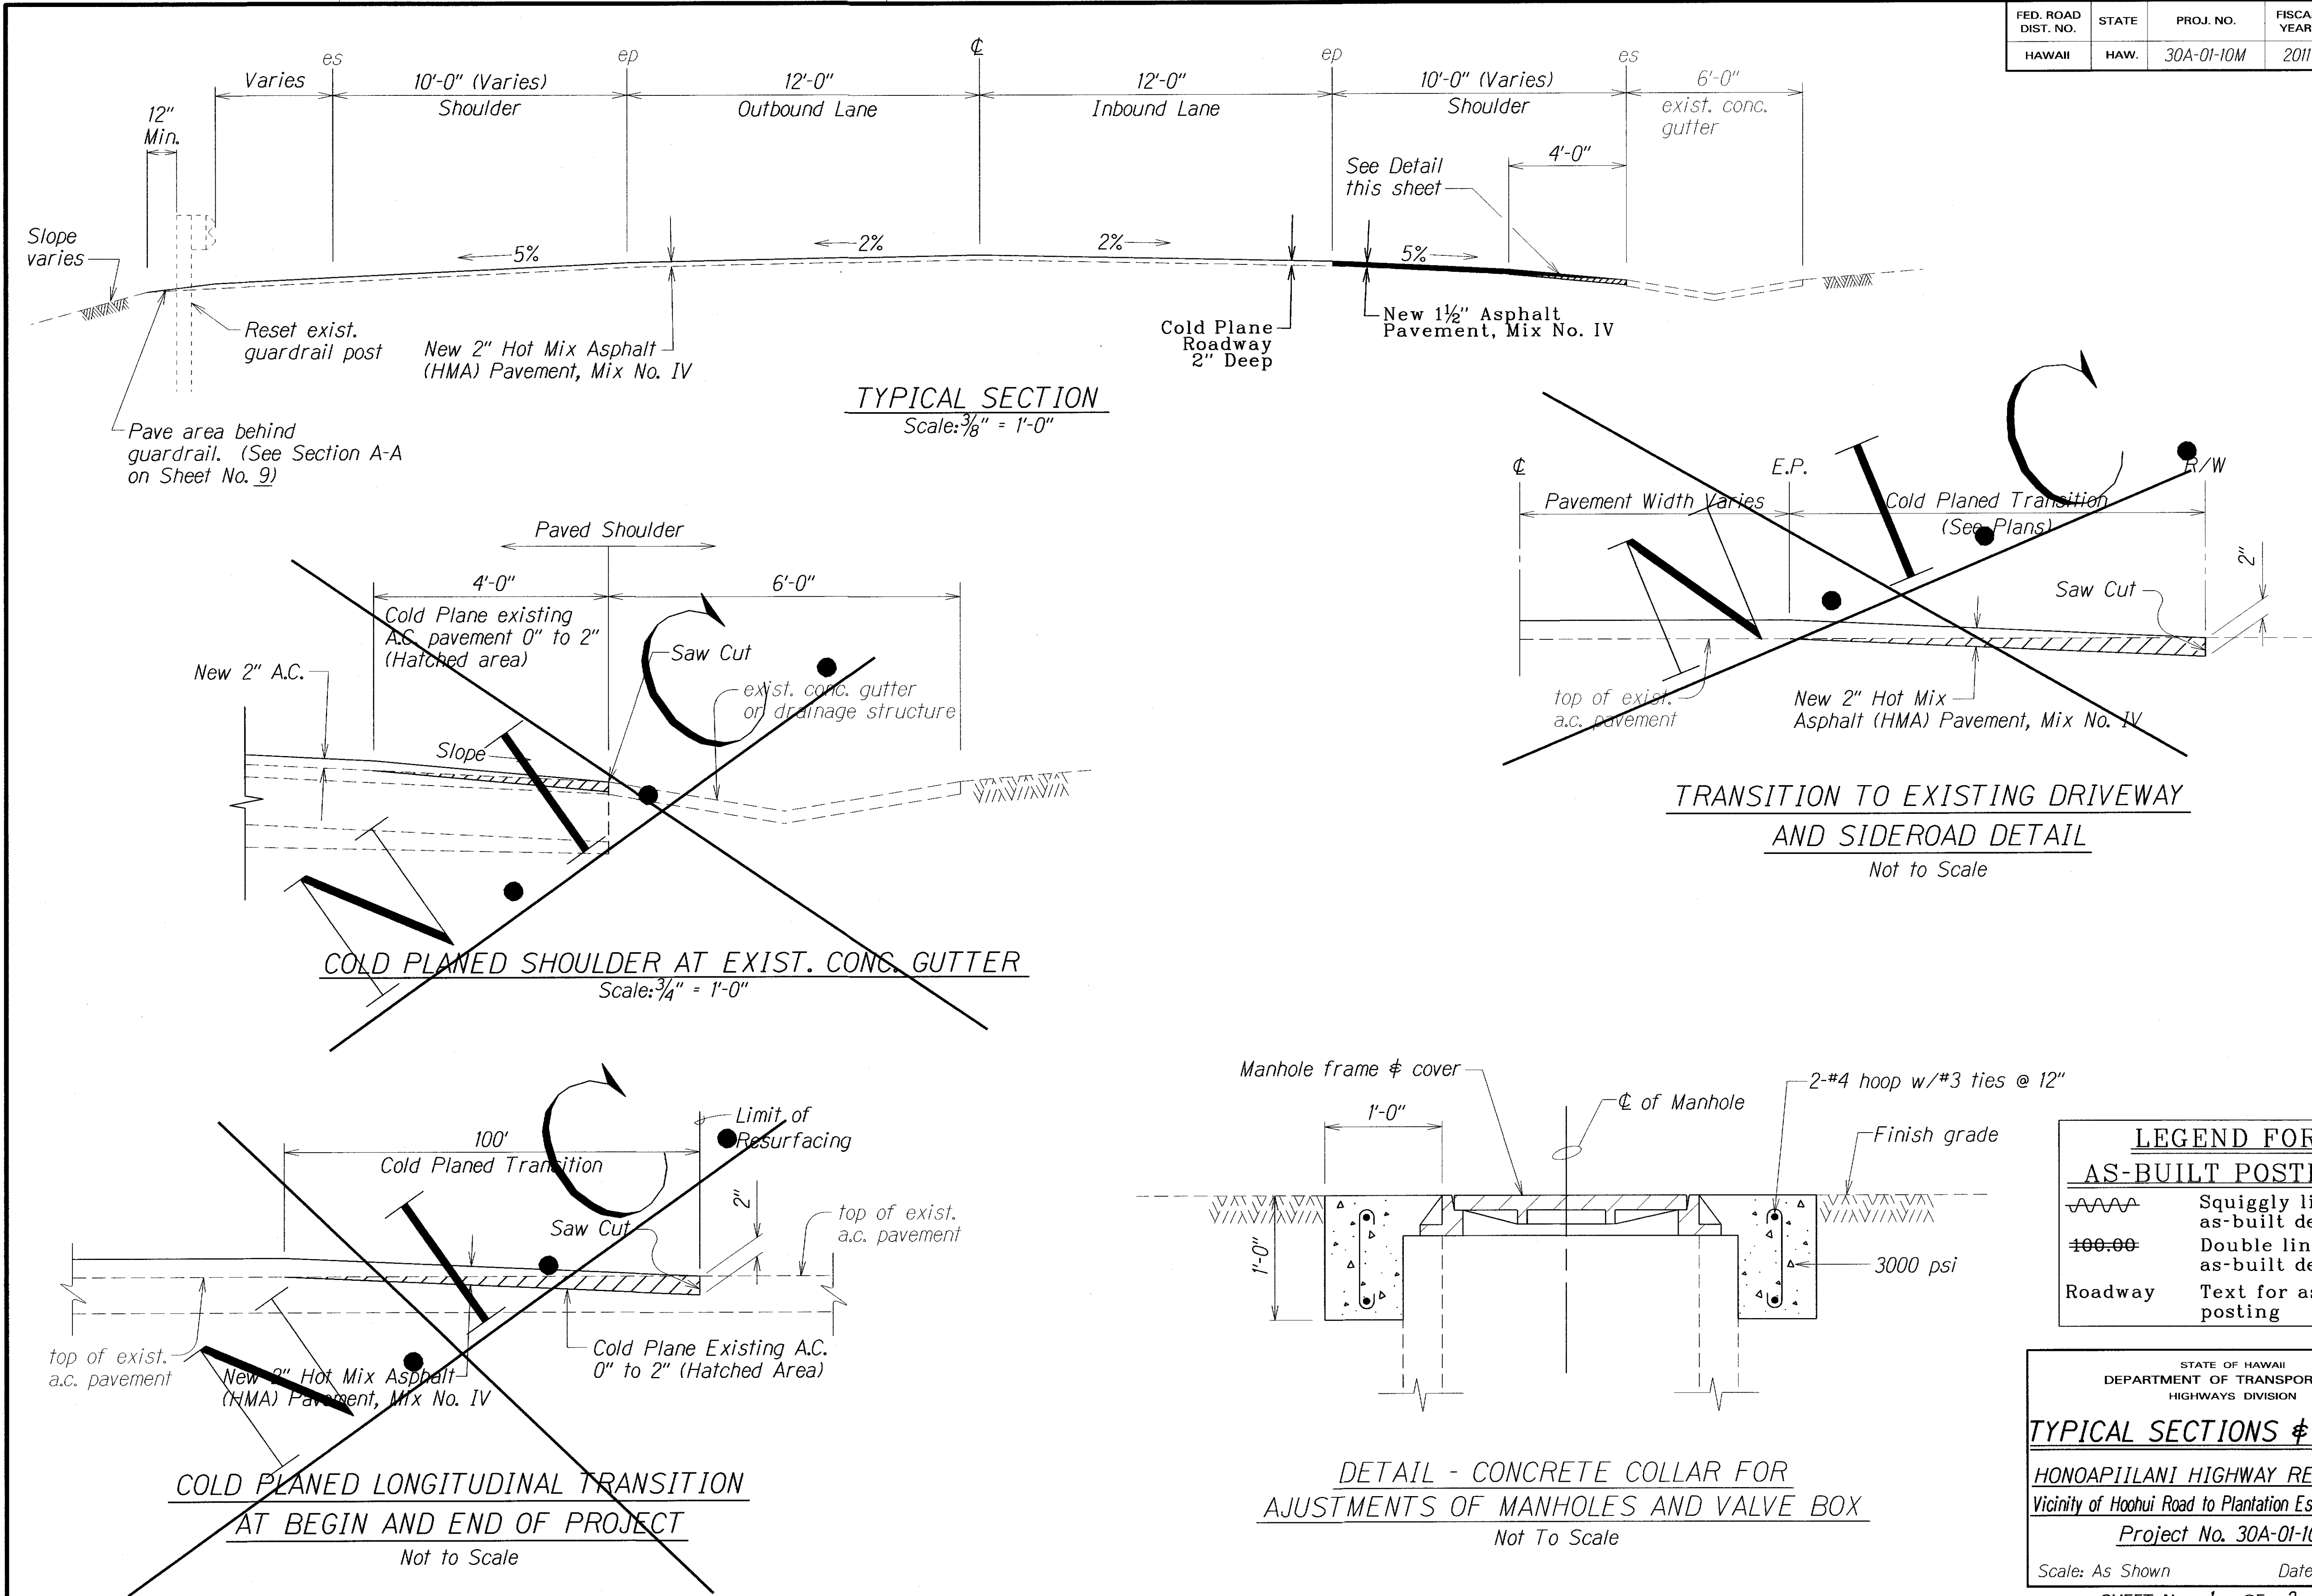




SURVEY PLOTTED BY	DATE
DRAWN BY	10/1/09
DESIGNED BY	
CHECKED BY	
QUANTITIES BY	
NOTES	
ORIGINAL PLAN	

LEGEND FOR AS-BUILT POSTINGS	
	Squiggly line for as-built deletion
	Double line for as-built deletion
Roadway	Text for as-built posting

STATE OF HAWAII DEPARTMENT OF TRANSPORTATION HIGHWAYS DIVISION	
<b>TYPICAL SECTIONS &amp; DETAILS</b>	
HONOAPIILANI HIGHWAY RESURFACING Vicinity of Hooihui Road to Plantation Estates Golf Course Project No. 30A-01-10M	
Scale: As Shown	Date: April, 2009
SHEET No. 1 OF 2 SHEETS	

"AS-BUILT"

FED. ROAD DIST. NO.	STATE	PROJ. NO.	FISCAL YEAR	SHEET NO.	TOTAL SHEETS
HAWAII	HAW.	30A-01-10M	2011	7	40

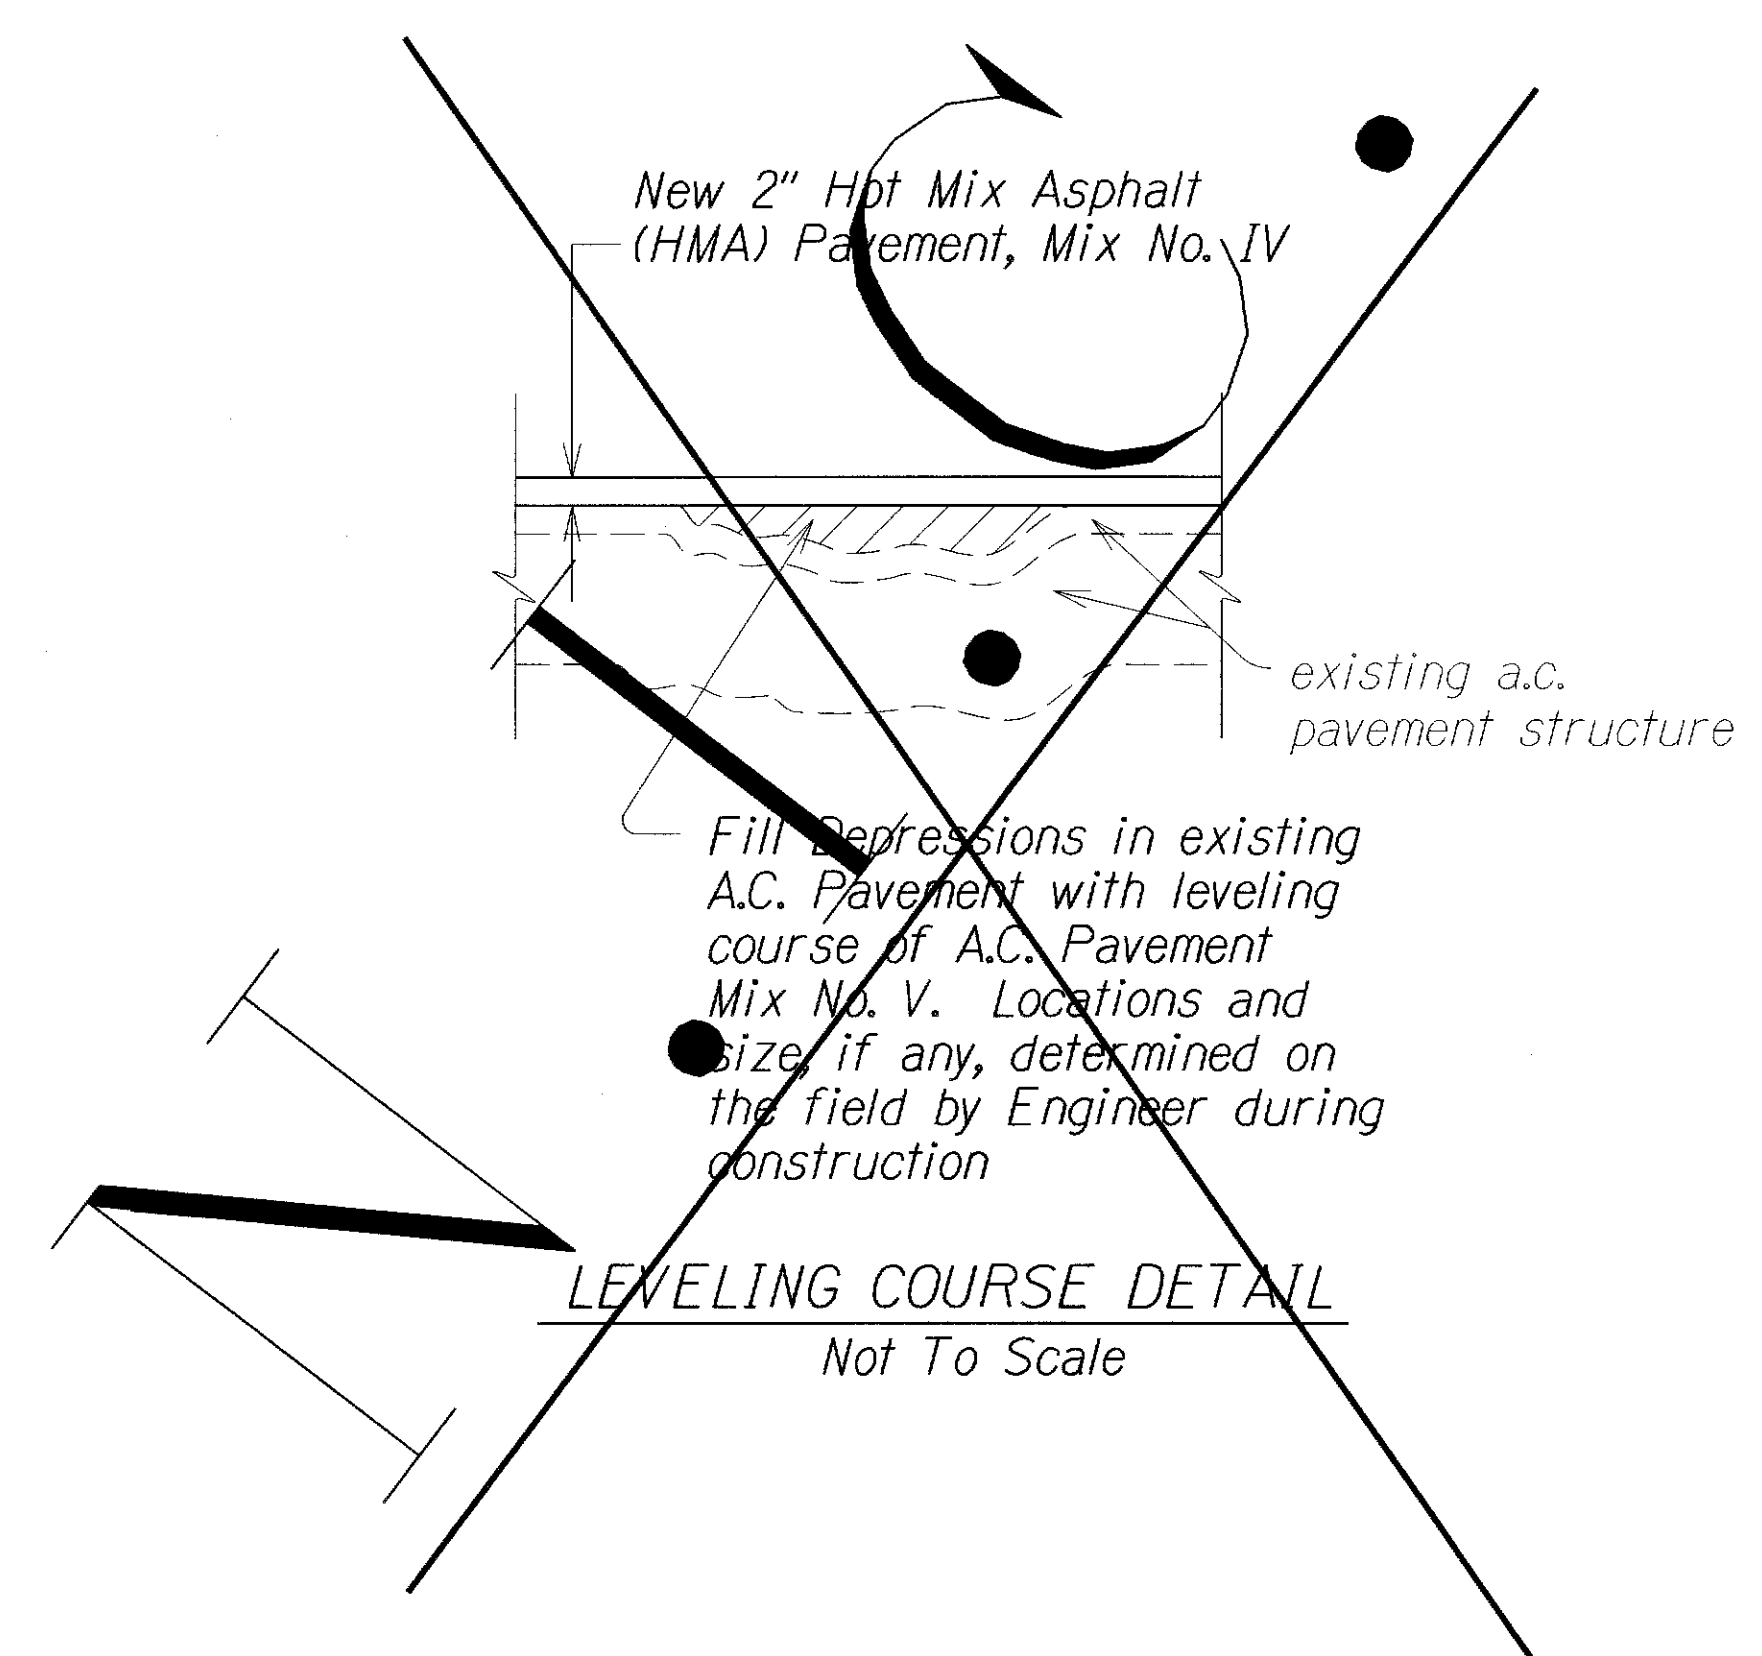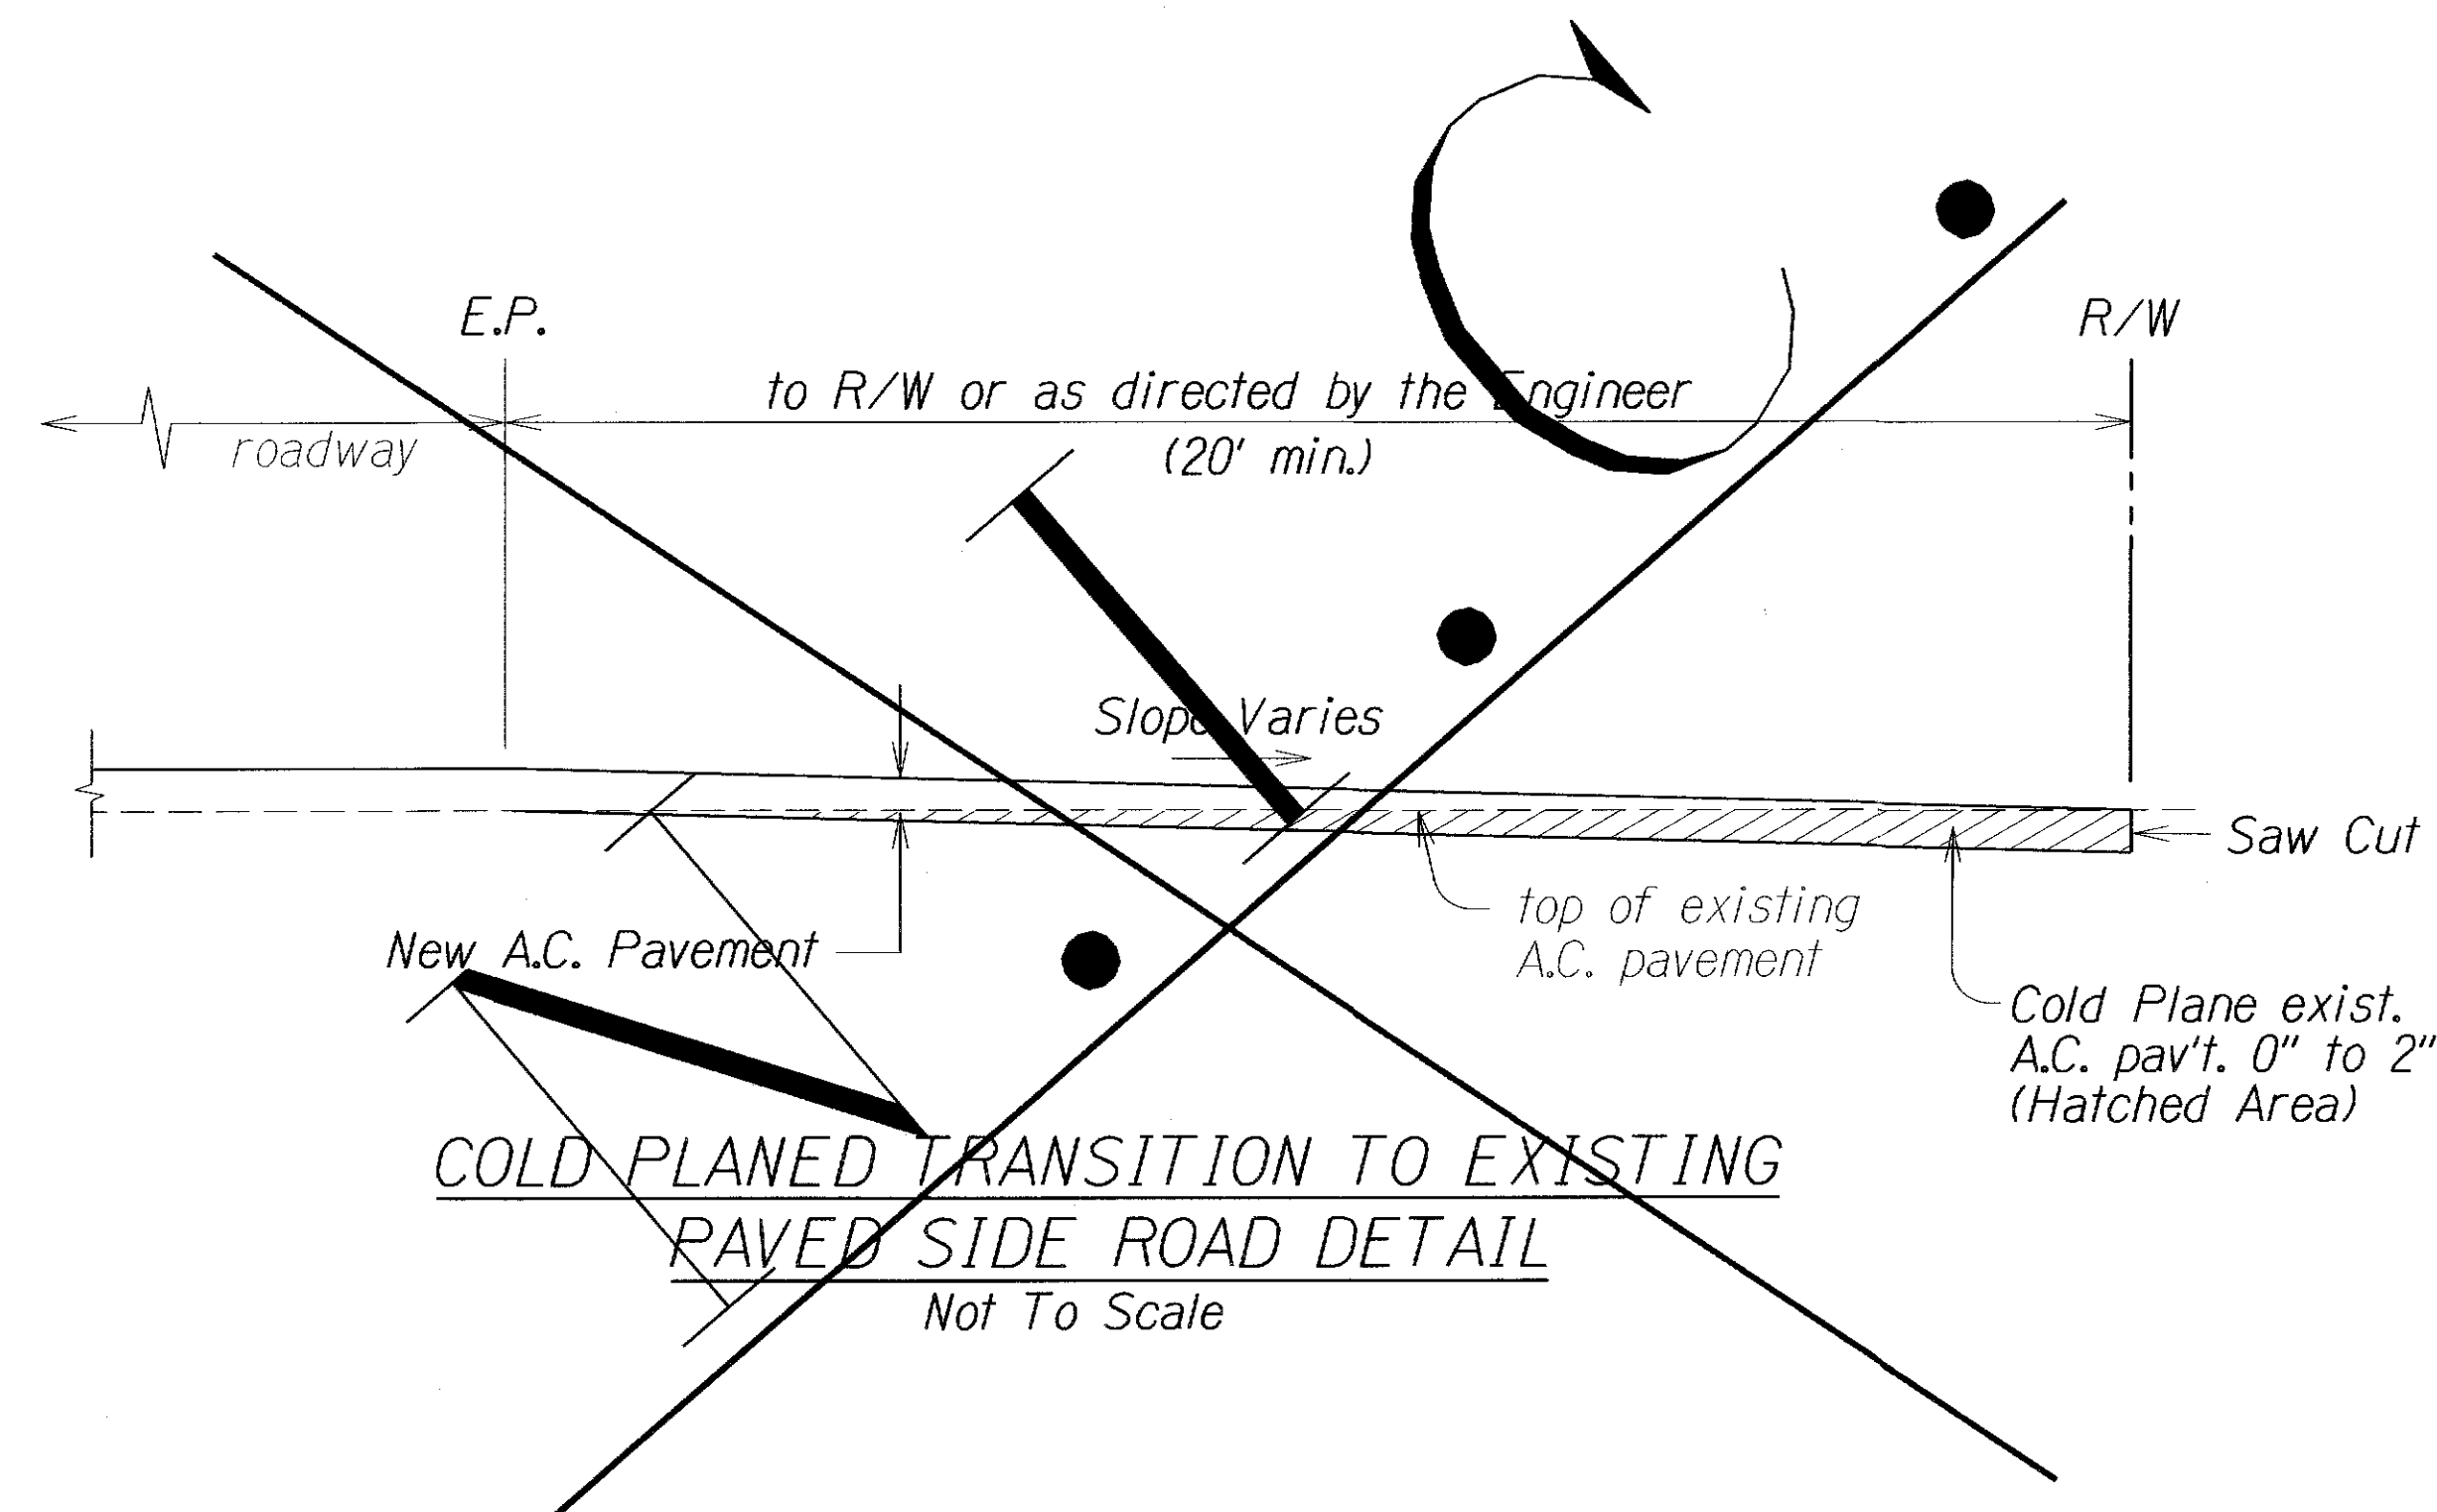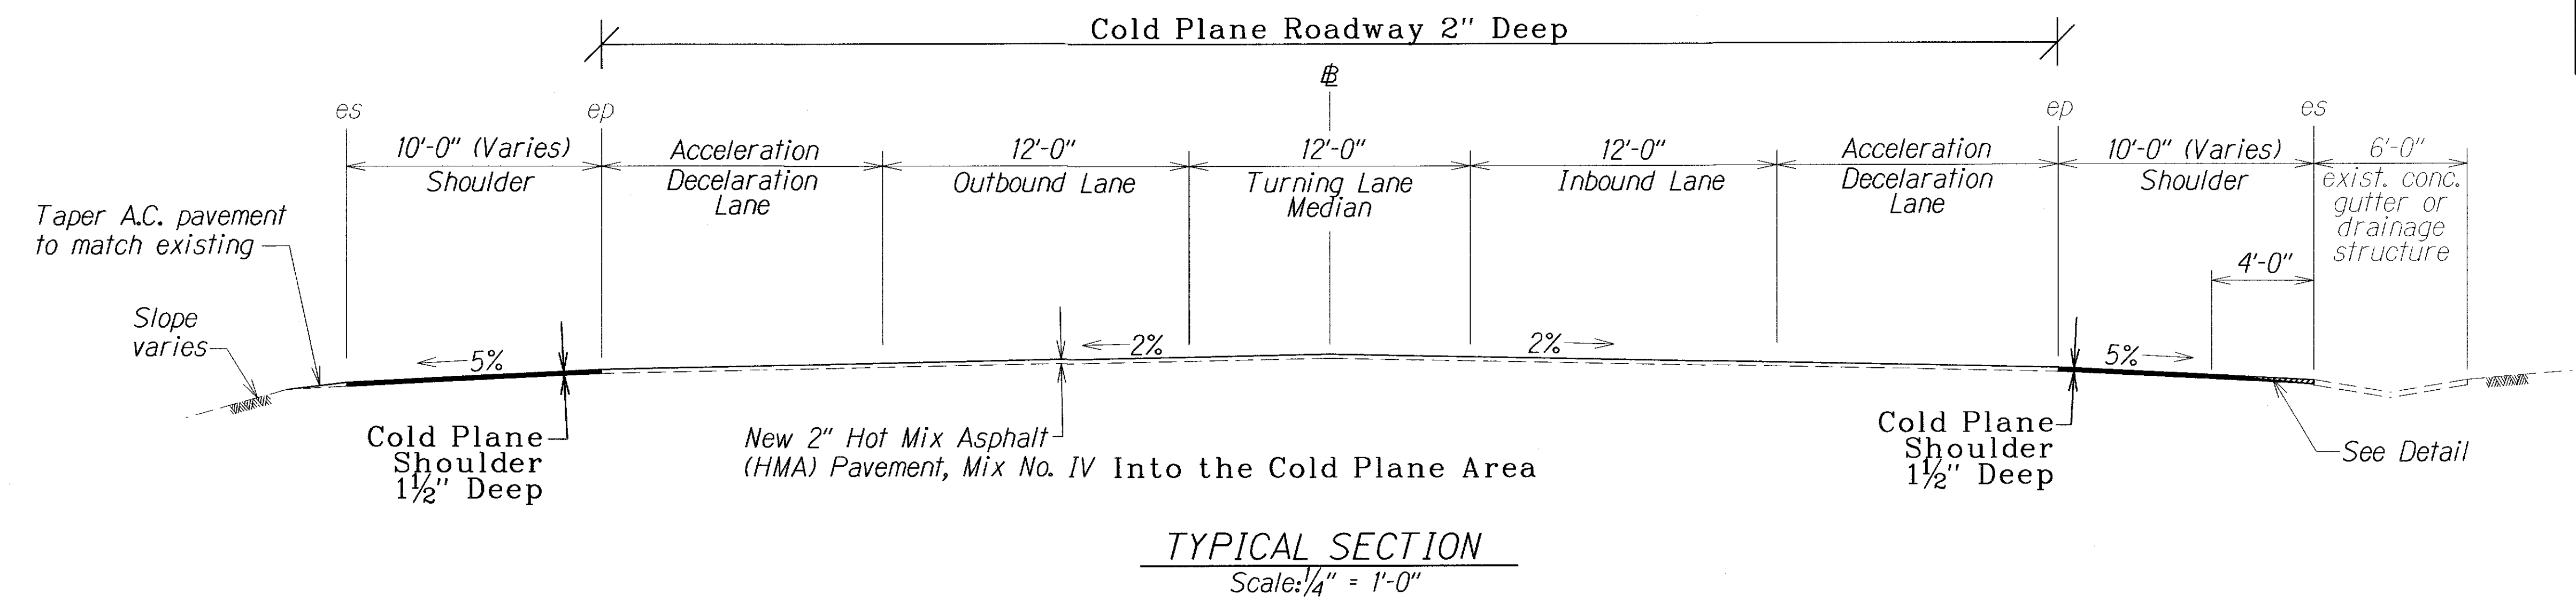

ORIGINAL PLAN	DESIGNED BY	DATE
NOTED BY	DESIGNED BY	DATE
QUANTITIES BY	DESIGNED BY	DATE
CHECKED BY	DESIGNED BY	DATE

LEGEND FOR AS-BUILT POSTINGS	
	Squiggly line for as-built deletion
	Double line for as-built deletion
Roadway	Text for as-built posting

STATE OF HAWAII  
DEPARTMENT OF TRANSPORTATION  
HIGHWAYS DIVISION  
**TYPICAL SECTIONS & DETAILS**  
HONOAPIILANI HIGHWAY RESURFACING  
Vicinity of Hoohui Road to Plantation Estates Golf Course  
Project No. 30A-01-10M  
Scale: As Shown Date: April, 2009  
SHEET No. 2 OF 2 SHEETS

"AS-BUILT"