


FED. ROAD DIST. NO.	STATE	PROJ. NO.	FISCAL YEAR	SHEET NO.	TOTAL SHEETS
HAWAII	HAW.	30A-01-97	1998	6	7

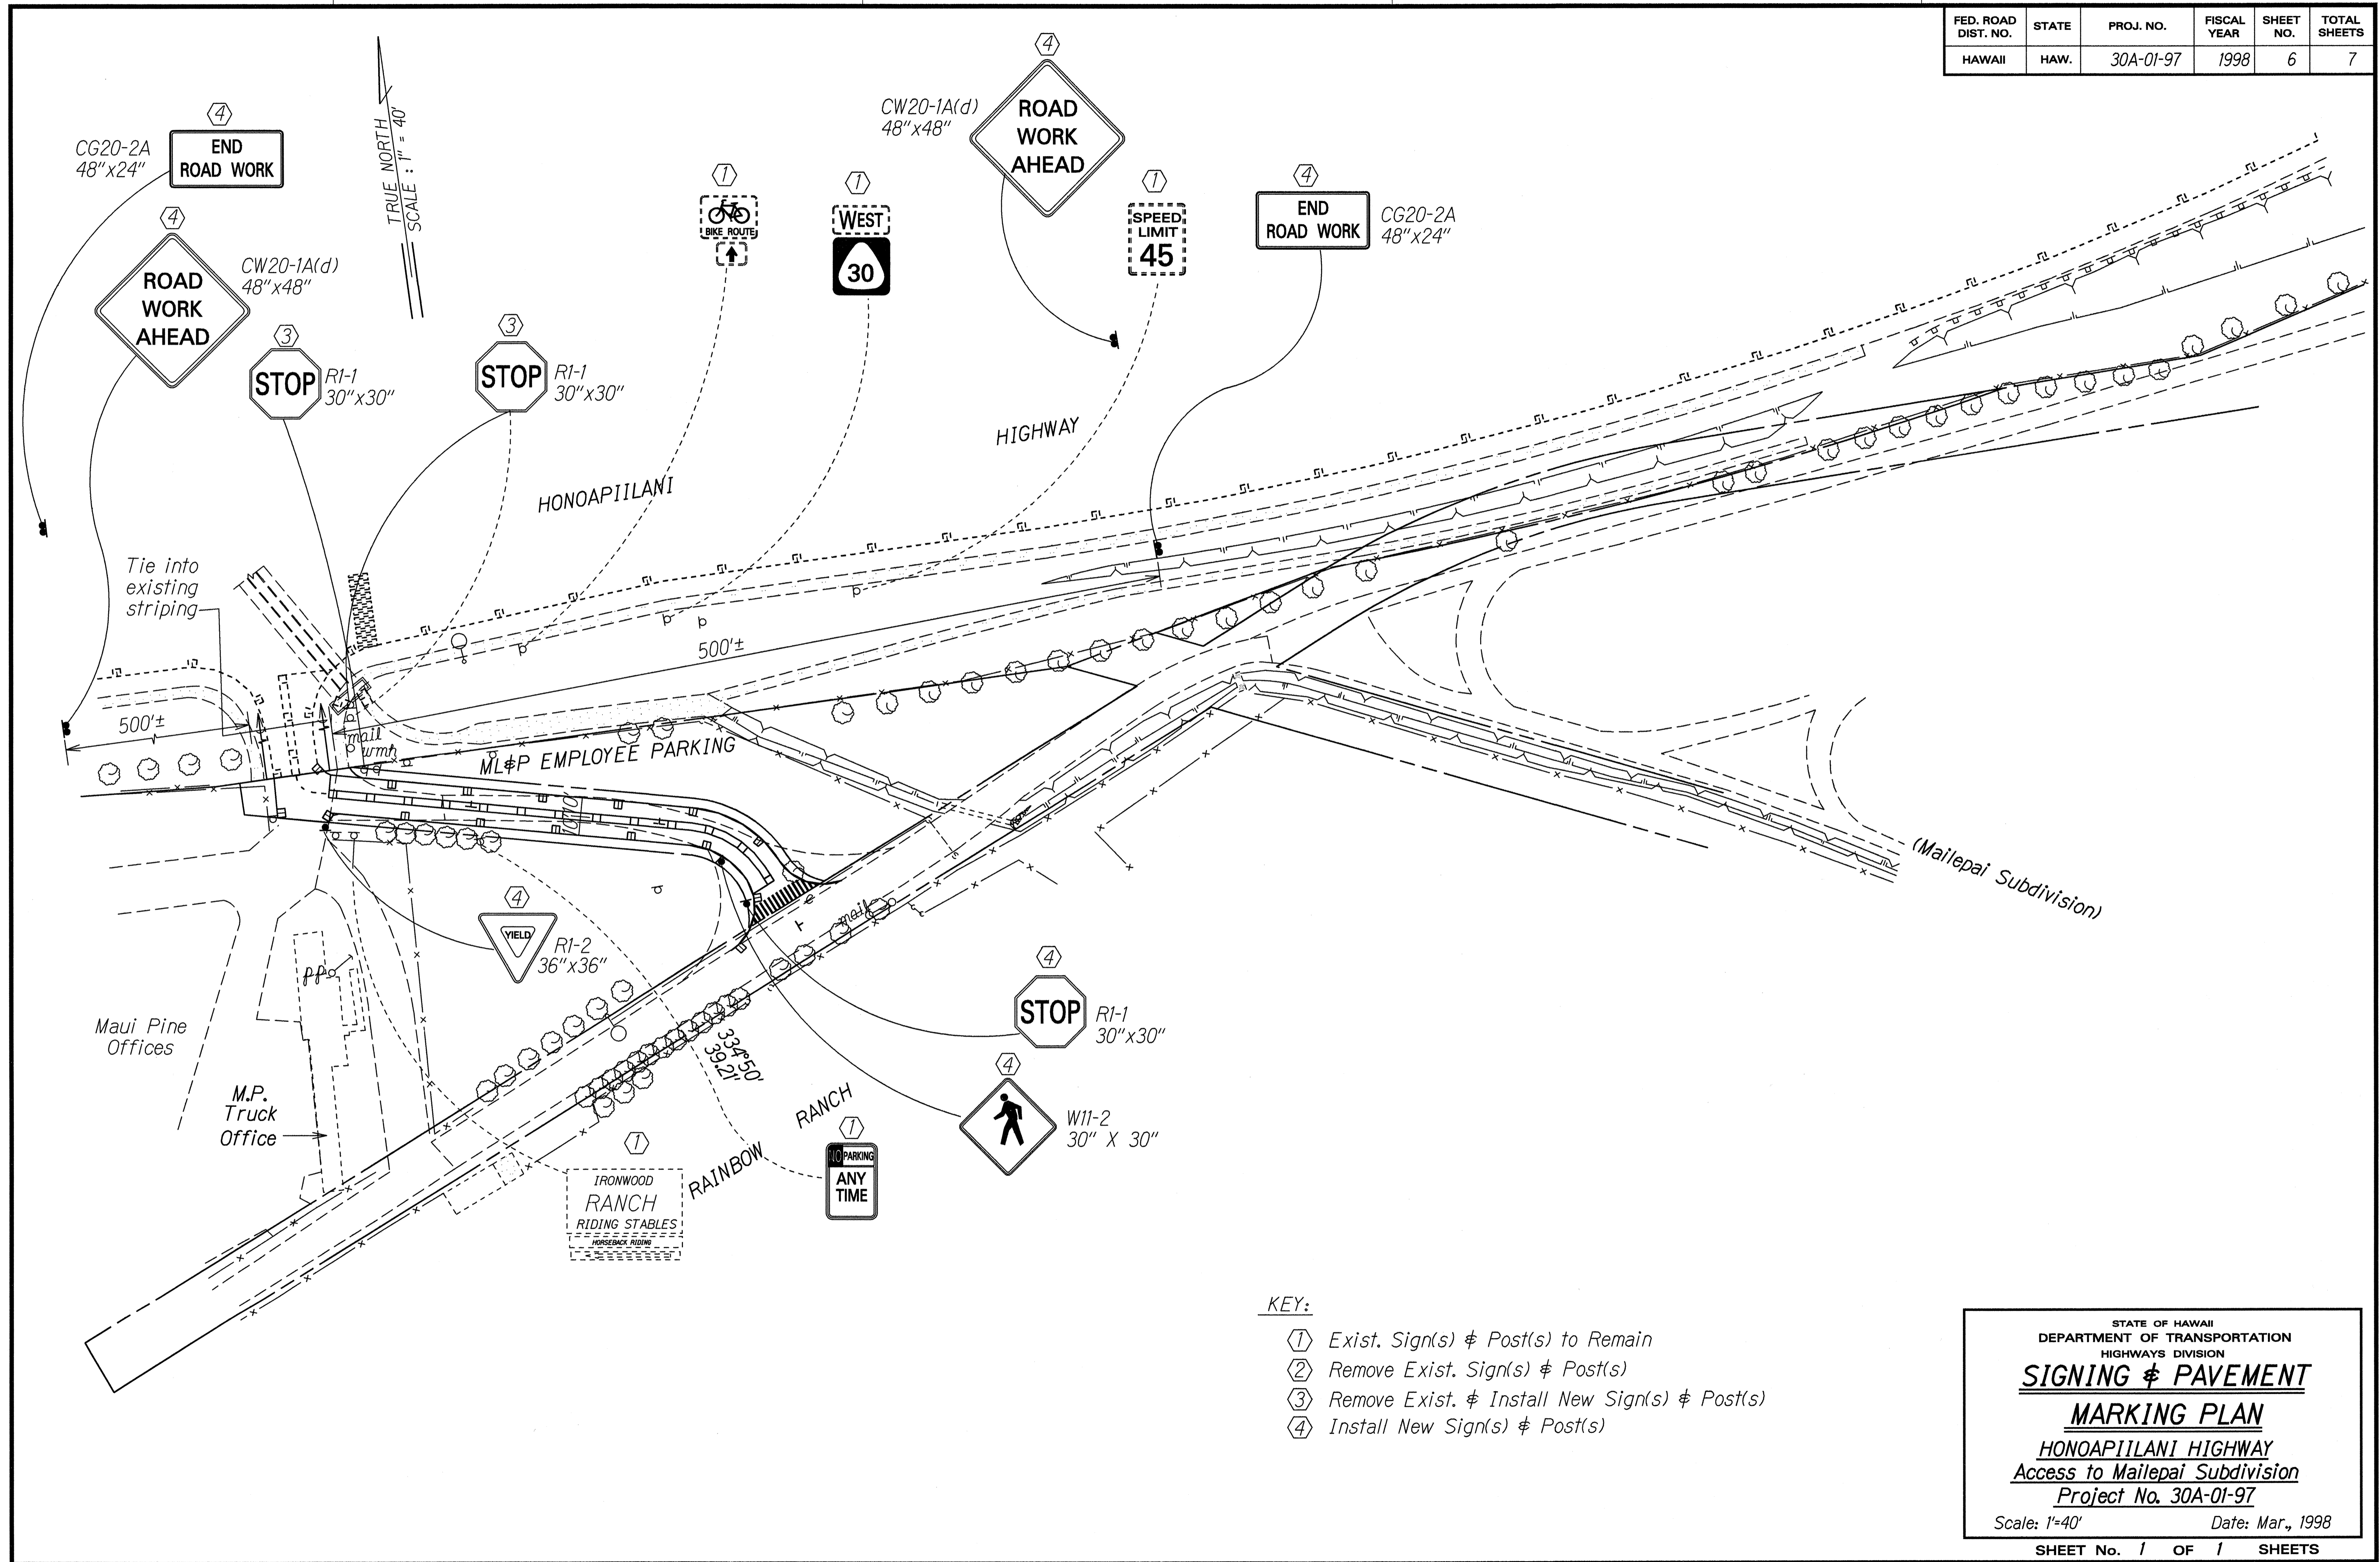

ORIGINAL PLAN DATE: 9/20/97
 SURVEY PLOTTED BY: [Name]
 DRAWN BY: [Name]
 TRACED BY: [Name]
 NOTE BOOK DESIGNED BY: [Name]
 QUANTITIES BY: [Name]
 CHECKED BY: [Name]

- KEY:**
- ① Exist. Sign(s) & Post(s) to Remain
 - ② Remove Exist. Sign(s) & Post(s)
 - ③ Remove Exist. & Install New Sign(s) & Post(s)
 - ④ Install New Sign(s) & Post(s)

STATE OF HAWAII
 DEPARTMENT OF TRANSPORTATION
 HIGHWAYS DIVISION
SIGNING & PAVEMENT
MARKING PLAN
 HONOAPIILANI HIGHWAY
 Access to Mailepai Subdivision
 Project No. 30A-01-97
 Scale: 1"=40' Date: Mar., 1998
 SHEET No. 1 OF 1 SHEETS