
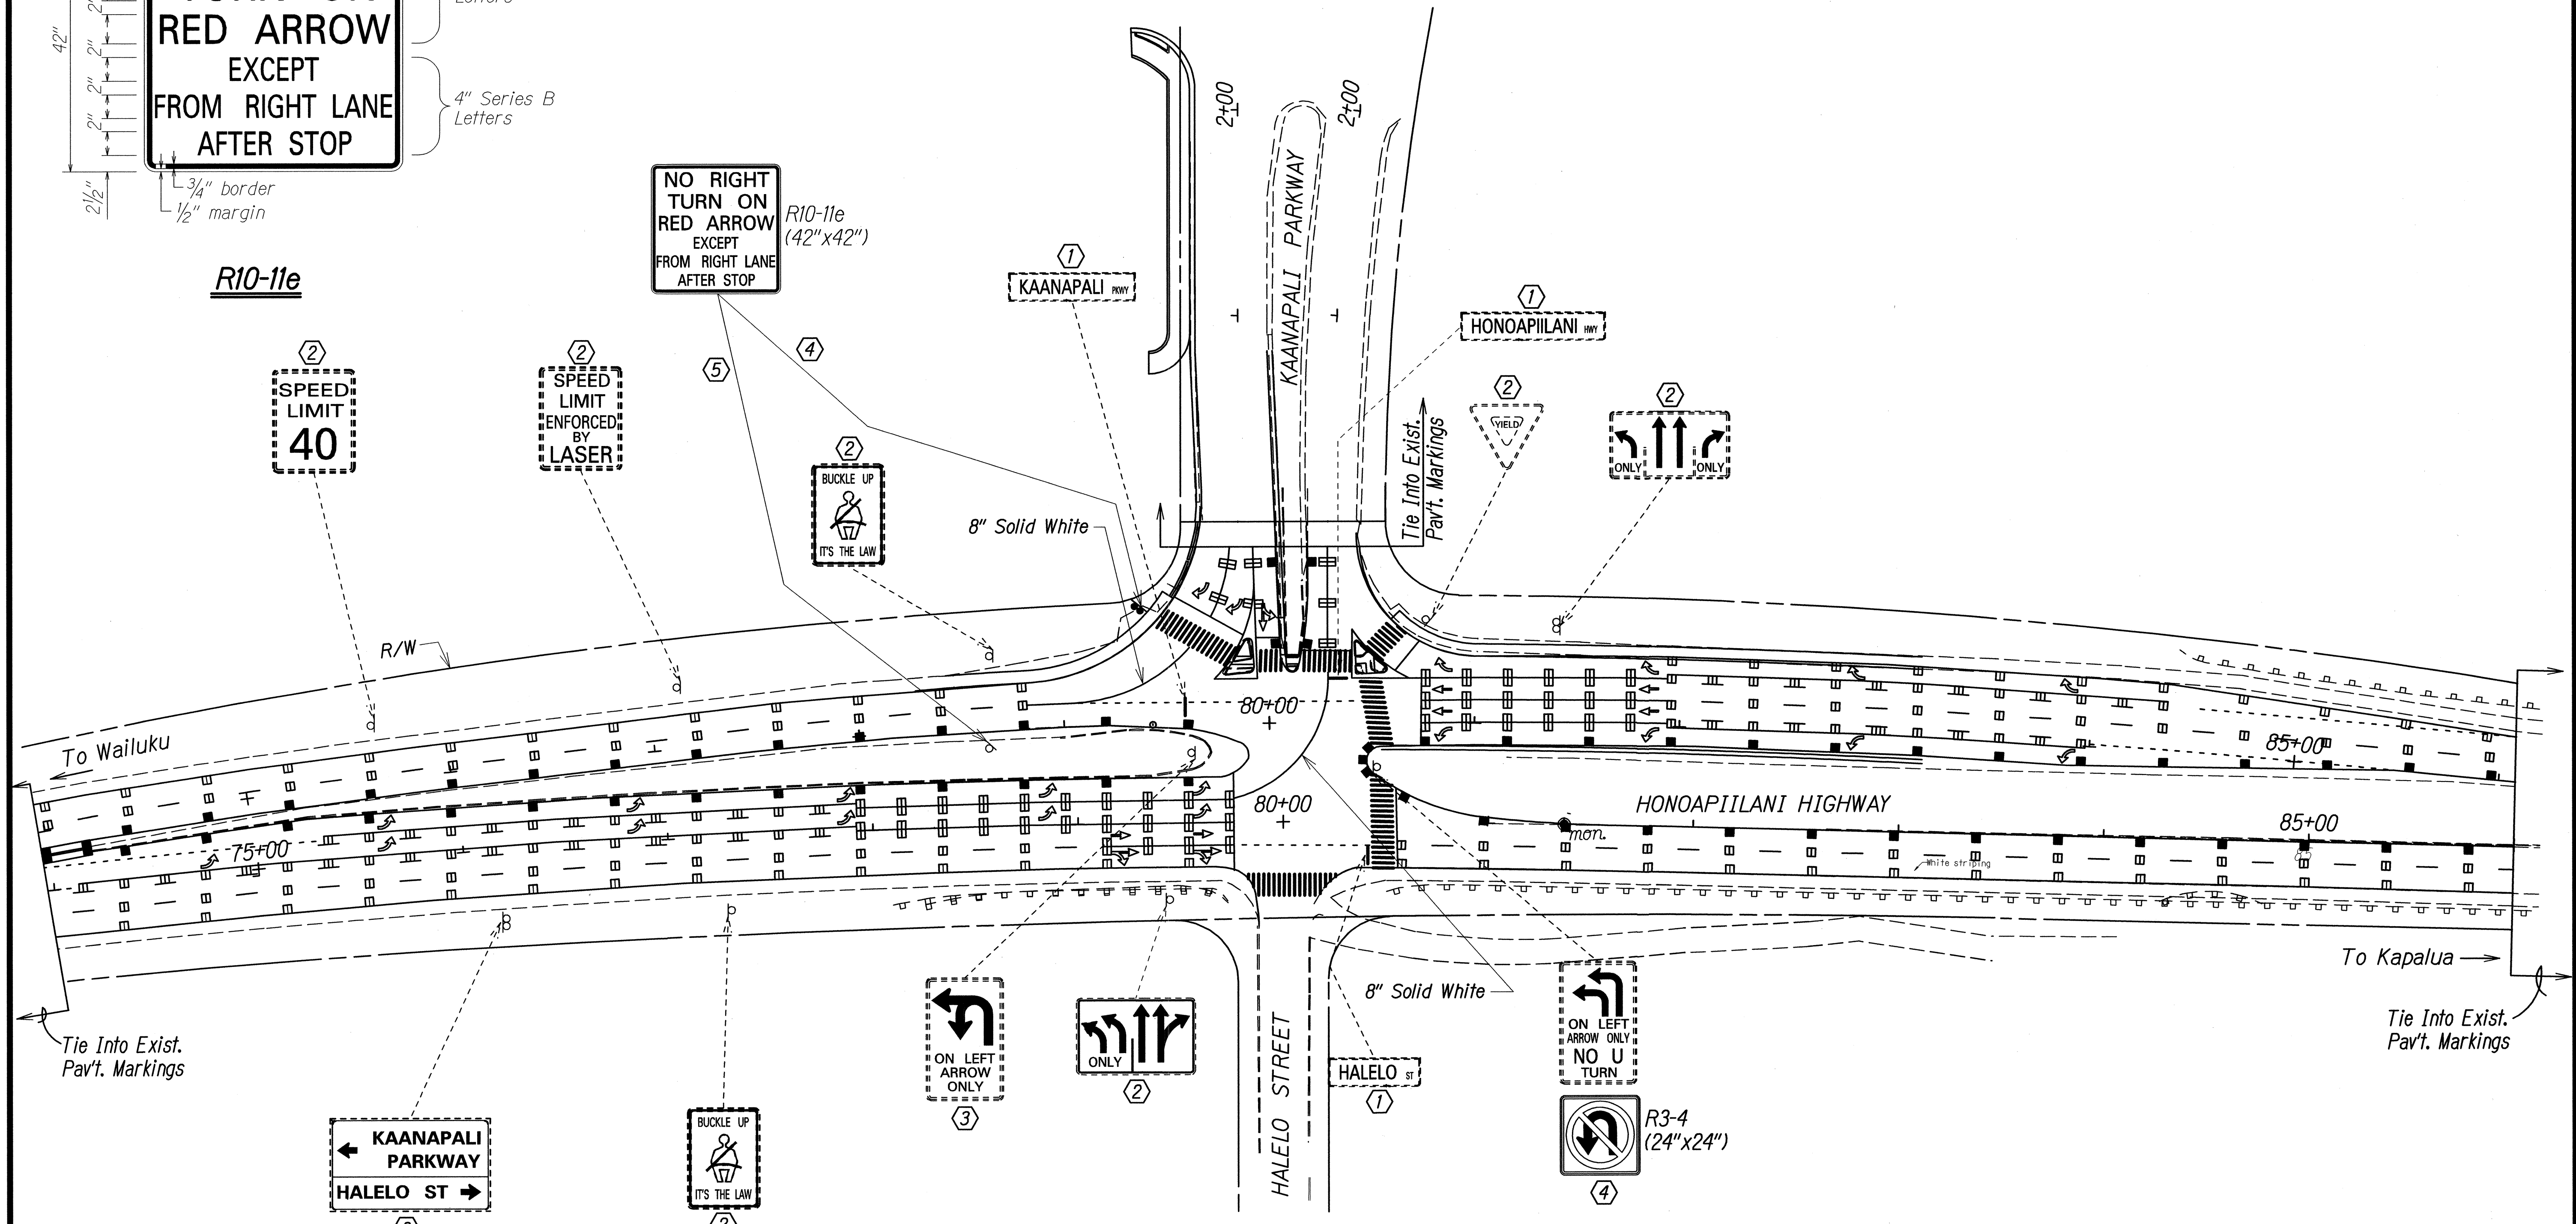


FED. ROAD DIST. NO.	STATE	FED. AID PROJ. NO.	FISCAL YEAR	SHEET NO.	TOTAL SHEETS
HAWAII	HAW.	HSIP-030-1(42)	2013	10	21

TRUE NORTH  
SCALE: 1" = 40'

NOTE: All stop lines are 24" wide

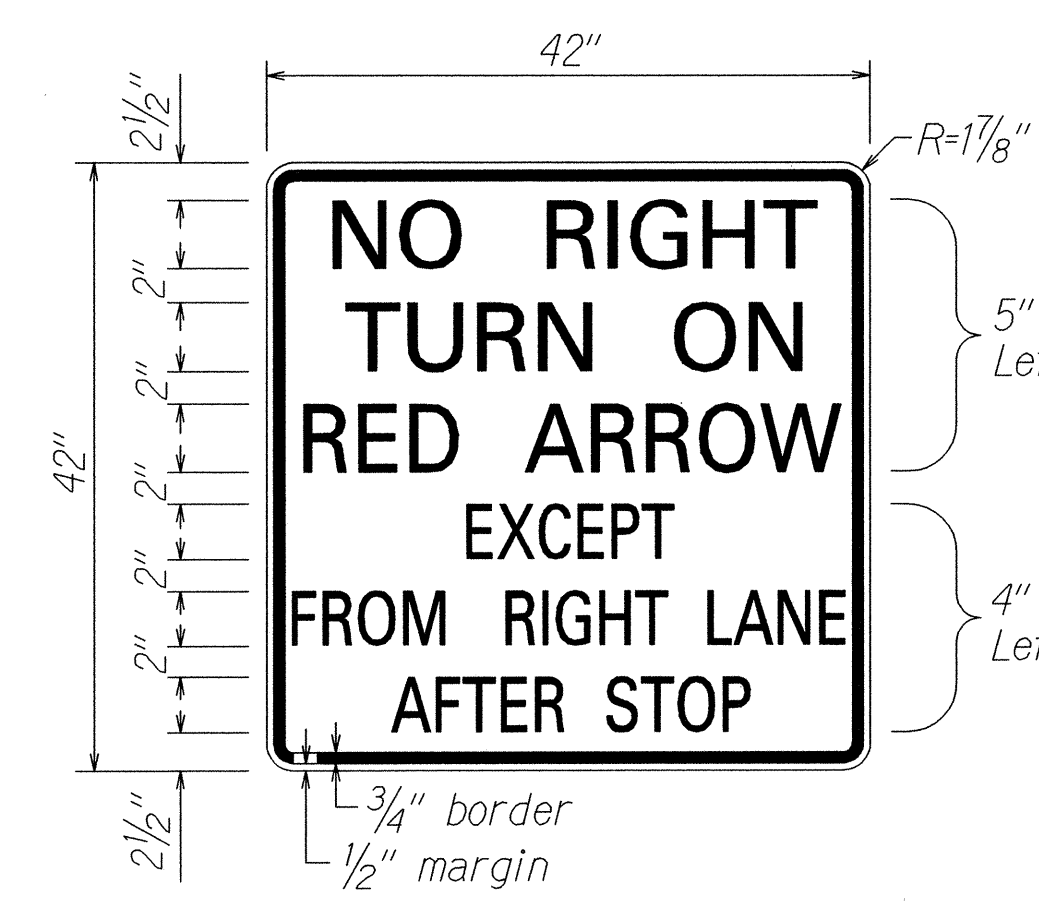

SURVEY PLOTTED BY	DATE
DESIGNED BY	
TRACED BY	
NOTE BOOK	
DESIGNED BY	
QUANTITIES BY	
CHECKED BY	
NO.	

- KEY:**
- ① Exist. Sign(s) to Remain
  - ② Exist. Sign(s) & Post(s) to Remain
  - ③ Remove Exist. Sign(s) w/ Post(s)
  - ④ Remove Exist. Sign(s) w/ Post(s) & Install New Sign(s) w/ New Post(s)
  - ⑤ Remove Exist. Sign(s) on Traffic Signal Standard & Install New Sign(s) on Traffic Signal Standard

STATE OF HAWAII  
DEPARTMENT OF TRANSPORTATION  
HIGHWAYS DIVISION

**PAVEMENT MARKING & SIGNING PLAN**

**HONOAPIILANI HIGHWAY, SAFETY IMPROVEMENTS AT KAAPALI PARKWAY AND HALELO STREET**

Federal Aid Project No. HSIP-030-1(42)  
Scale: 1"=40' Date: May 2012

SHEET No. 1 OF 1 SHEETS