


FED. ROAD DIST. NO.	STATE	FED. AID PROJ. NO.	FISCAL YEAR	SHEET NO.	TOTAL SHEETS
HAWAII	HAW.	HSIP-030-1(42)	2013	8	21

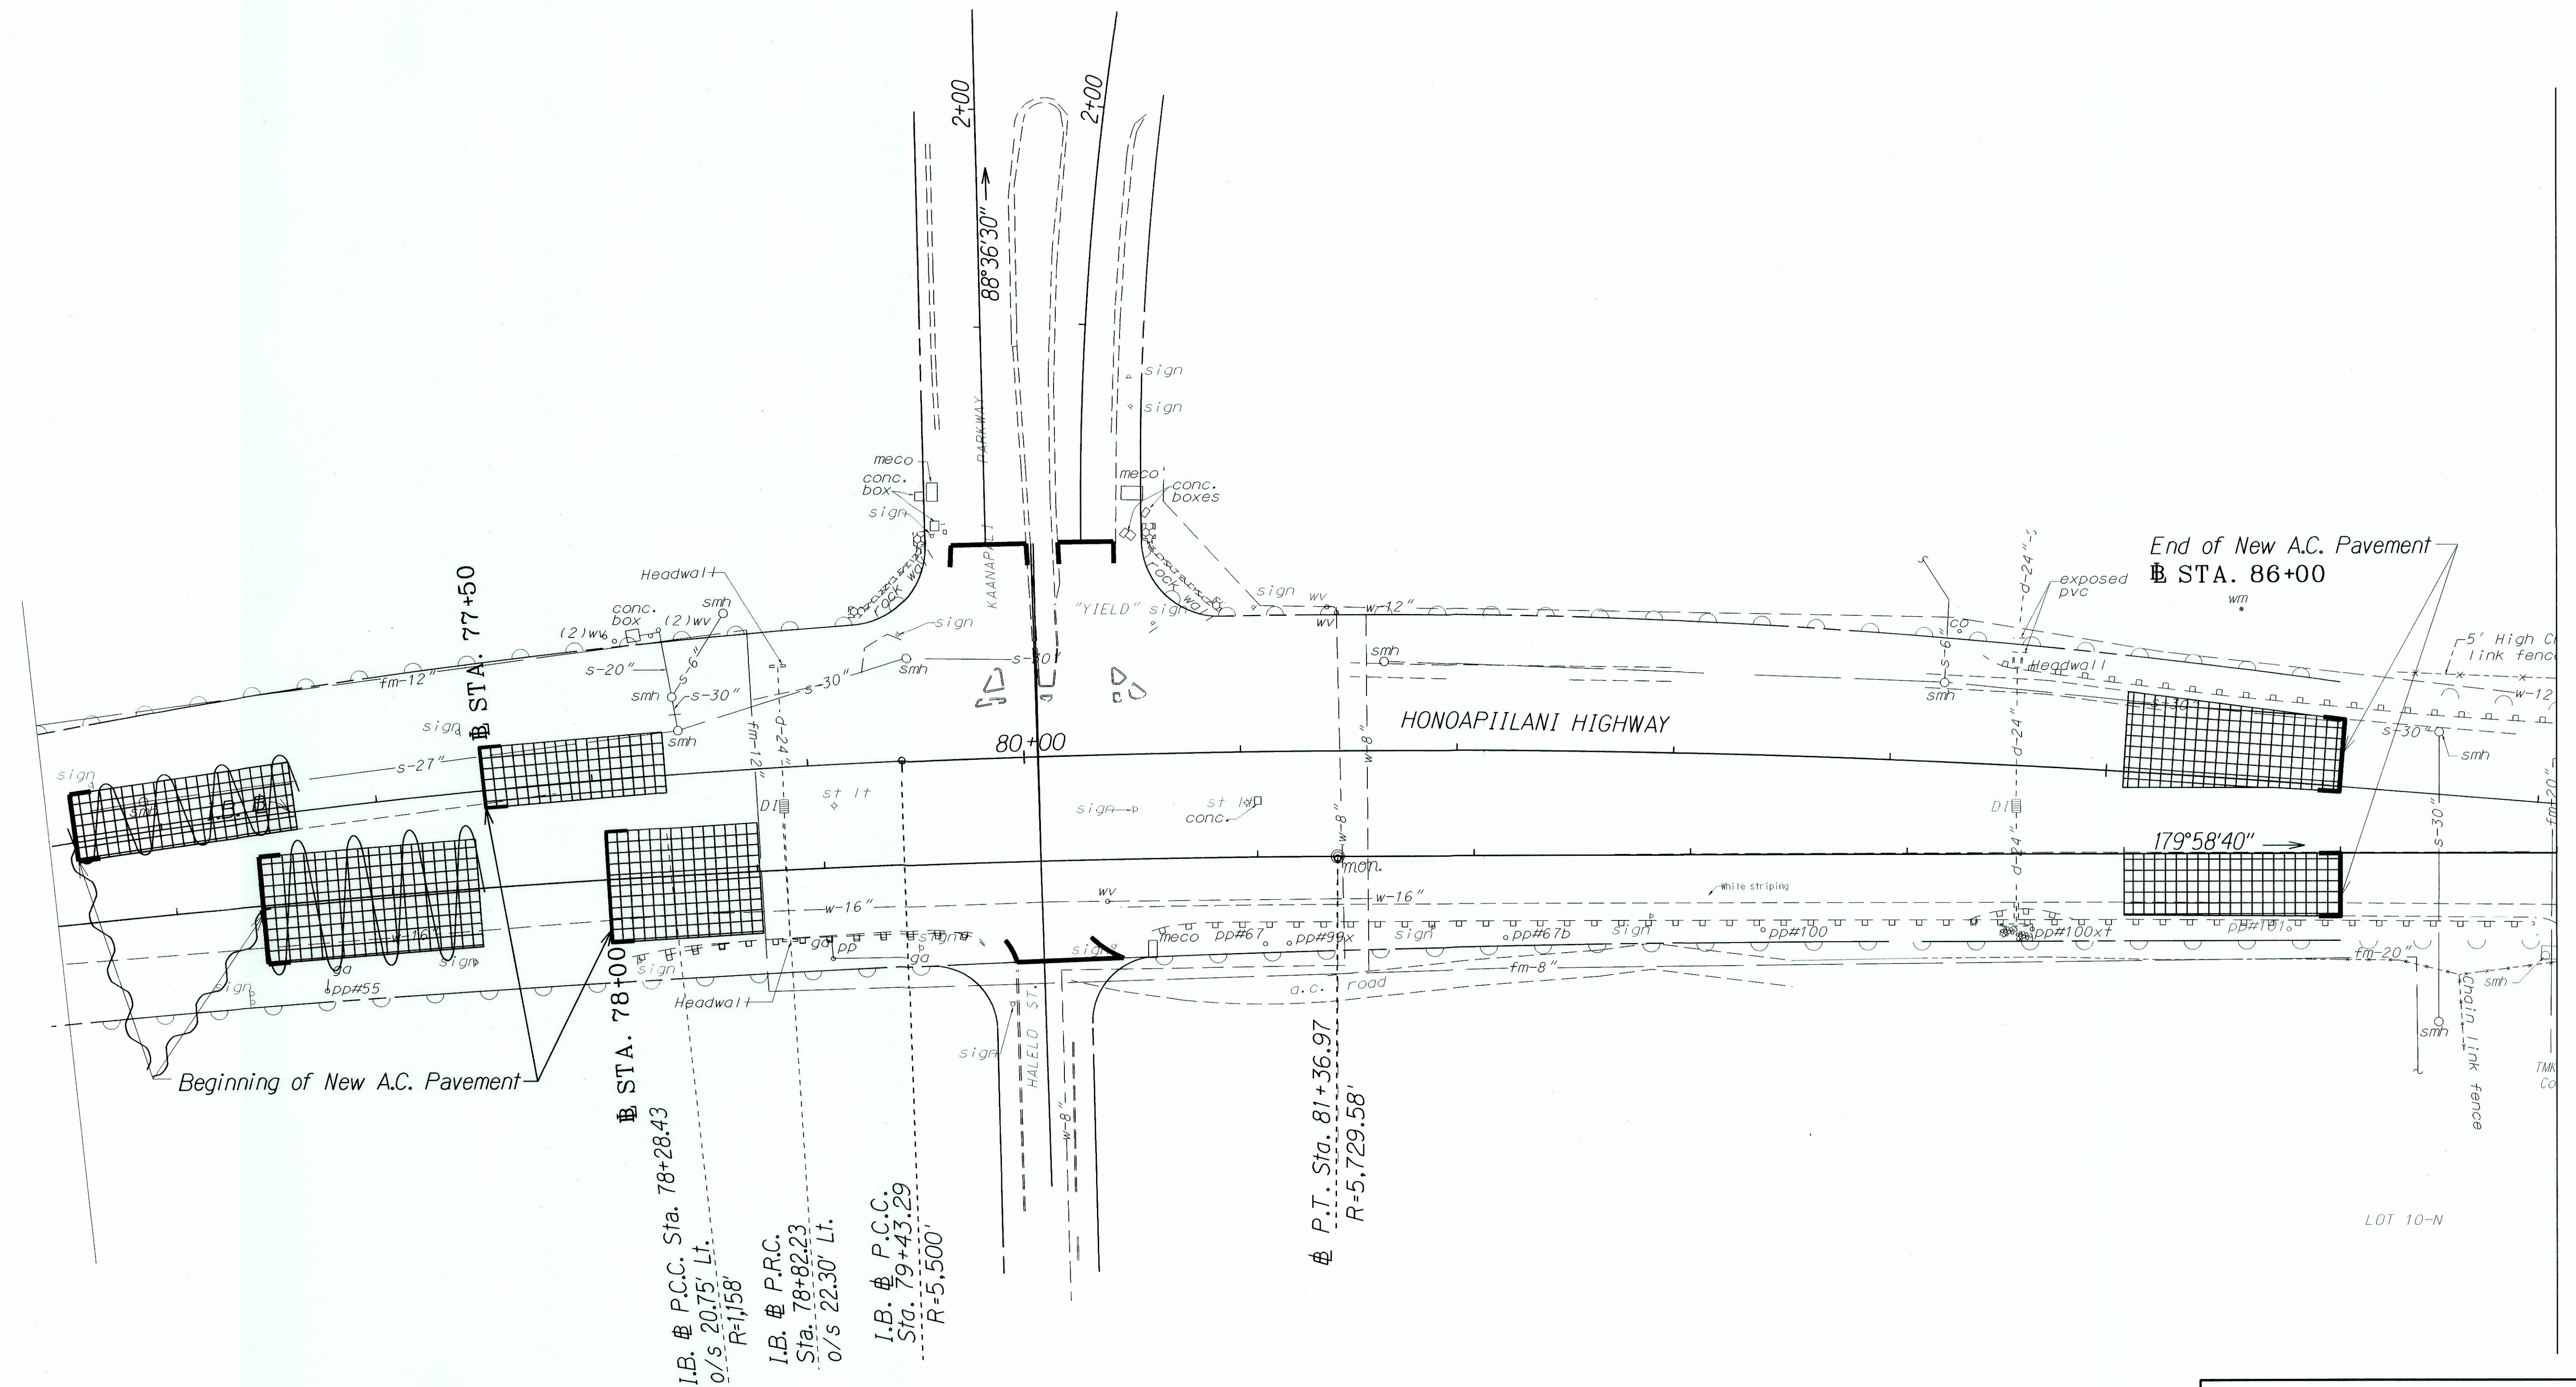

ORIGINAL PLAN	SURVEY PLOTTED BY	DATE
DRAWN BY		
NOTE BOOK		
QUANTITIES BY		
CHECKED BY		

LEGEND FOR AS-BUILT POSTINGS	
	Squiggly line for as-built deletion
	Double line for as-built deletion
Roadway	Text for as-built posting

STATE OF HAWAII DEPARTMENT OF TRANSPORTATION HIGHWAYS DIVISION	
ROADWAY PLANS	
HONOAPIILANI HIGHWAY, SAFETY IMPROVEMENTS AT KAAPALI PARKWAY AND HALELO STREET	
Federal Aid Project No. HSIP-030-1(42)	
Scale: 1"=40'	Date: May 2012
SHEET No. 1 OF 1 SHEETS	

"AS-BUILT"