


FED. ROAD DIST. NO.	STATE	FED. AID PROJ. NO.	FISCAL YEAR	SHEET NO.	TOTAL SHEETS
HAWAII	HAW.	HSIP-030-1(42)	2013	14	21

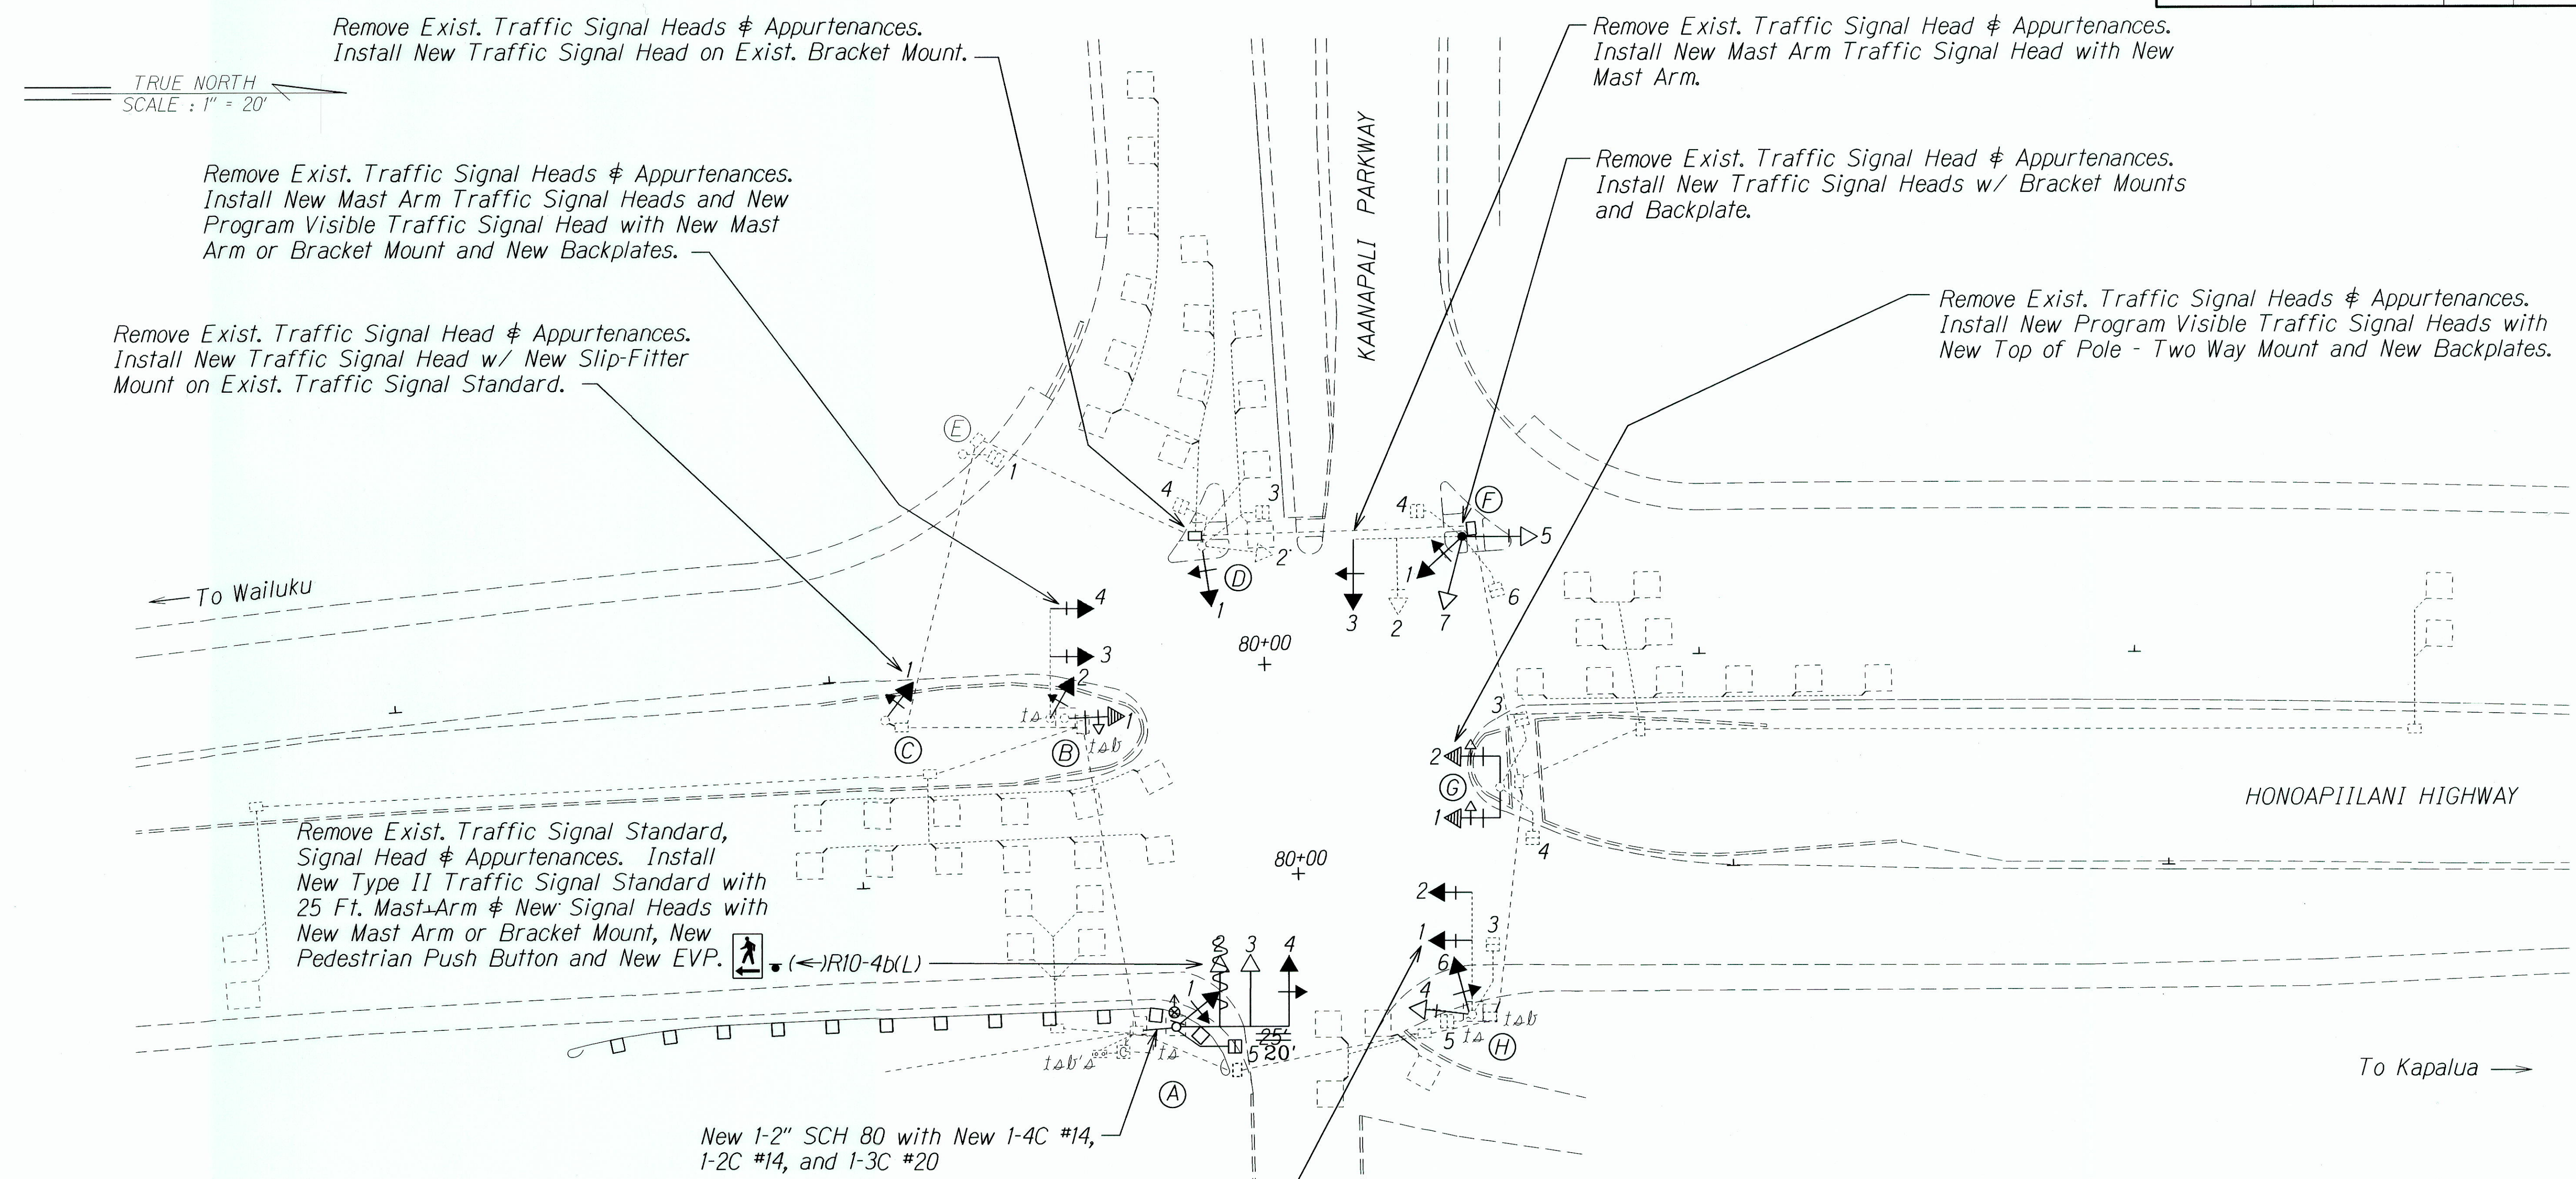

ORIGINAL PLAN	SURVEY PLOTTED BY	DATE
NOTE BOOK	DRAWN BY	
142m	CHECKED BY	
N. 5/10/12		

LEGEND FOR AS-BUILT POSTINGS	
	Squiggly line for as-built deletion
	Double line for as-built deletion
Roadway	Text for as-built posting

A-2	A-1	B-2 (RE)	B-3 (REXBP)	D-3 (ER)
A-3	A-4	C-1 (RE)	B-4 (REXBP)	D-4 (ER)
D-2 (ER)	B-1 (PVS)(REXBP)		H-1 (REXBP)	E-1 (ER)
F-2 (ER)	D-1 (RE)		H-2 (REXBP)	F-4 (ER)
F-5 (BP)	F-1 (RE)			F-6 (ER)
F-7	F-3 (RE)			G-3 (ER)
H-4 (REXBP)	G-1 (PVS)(REXBP)			G-4 (ER)
	G-2 (PVS)(REXBP)			H-3 (ER)
	H-6 (RE)			H-5 (ER)

RE = Replace Existing  
ER=Existing to Remain  
BP=Back Plate  
PVS=Programmed Visible Signal

SIGNAL INDICATION

STATE OF HAWAII  
DEPARTMENT OF TRANSPORTATION  
HIGHWAYS DIVISION

**TRAFFIC SIGNAL PLAN**  
HONOAPIILANI HIGHWAY, SAFETY  
IMPROVEMENTS AT KAA NAPALI  
PARKWAY AND HALELO STREET  
Federal Aid Project No. HSIP-030-1(42)  
Scale: 1"=20' Date: May 2012