
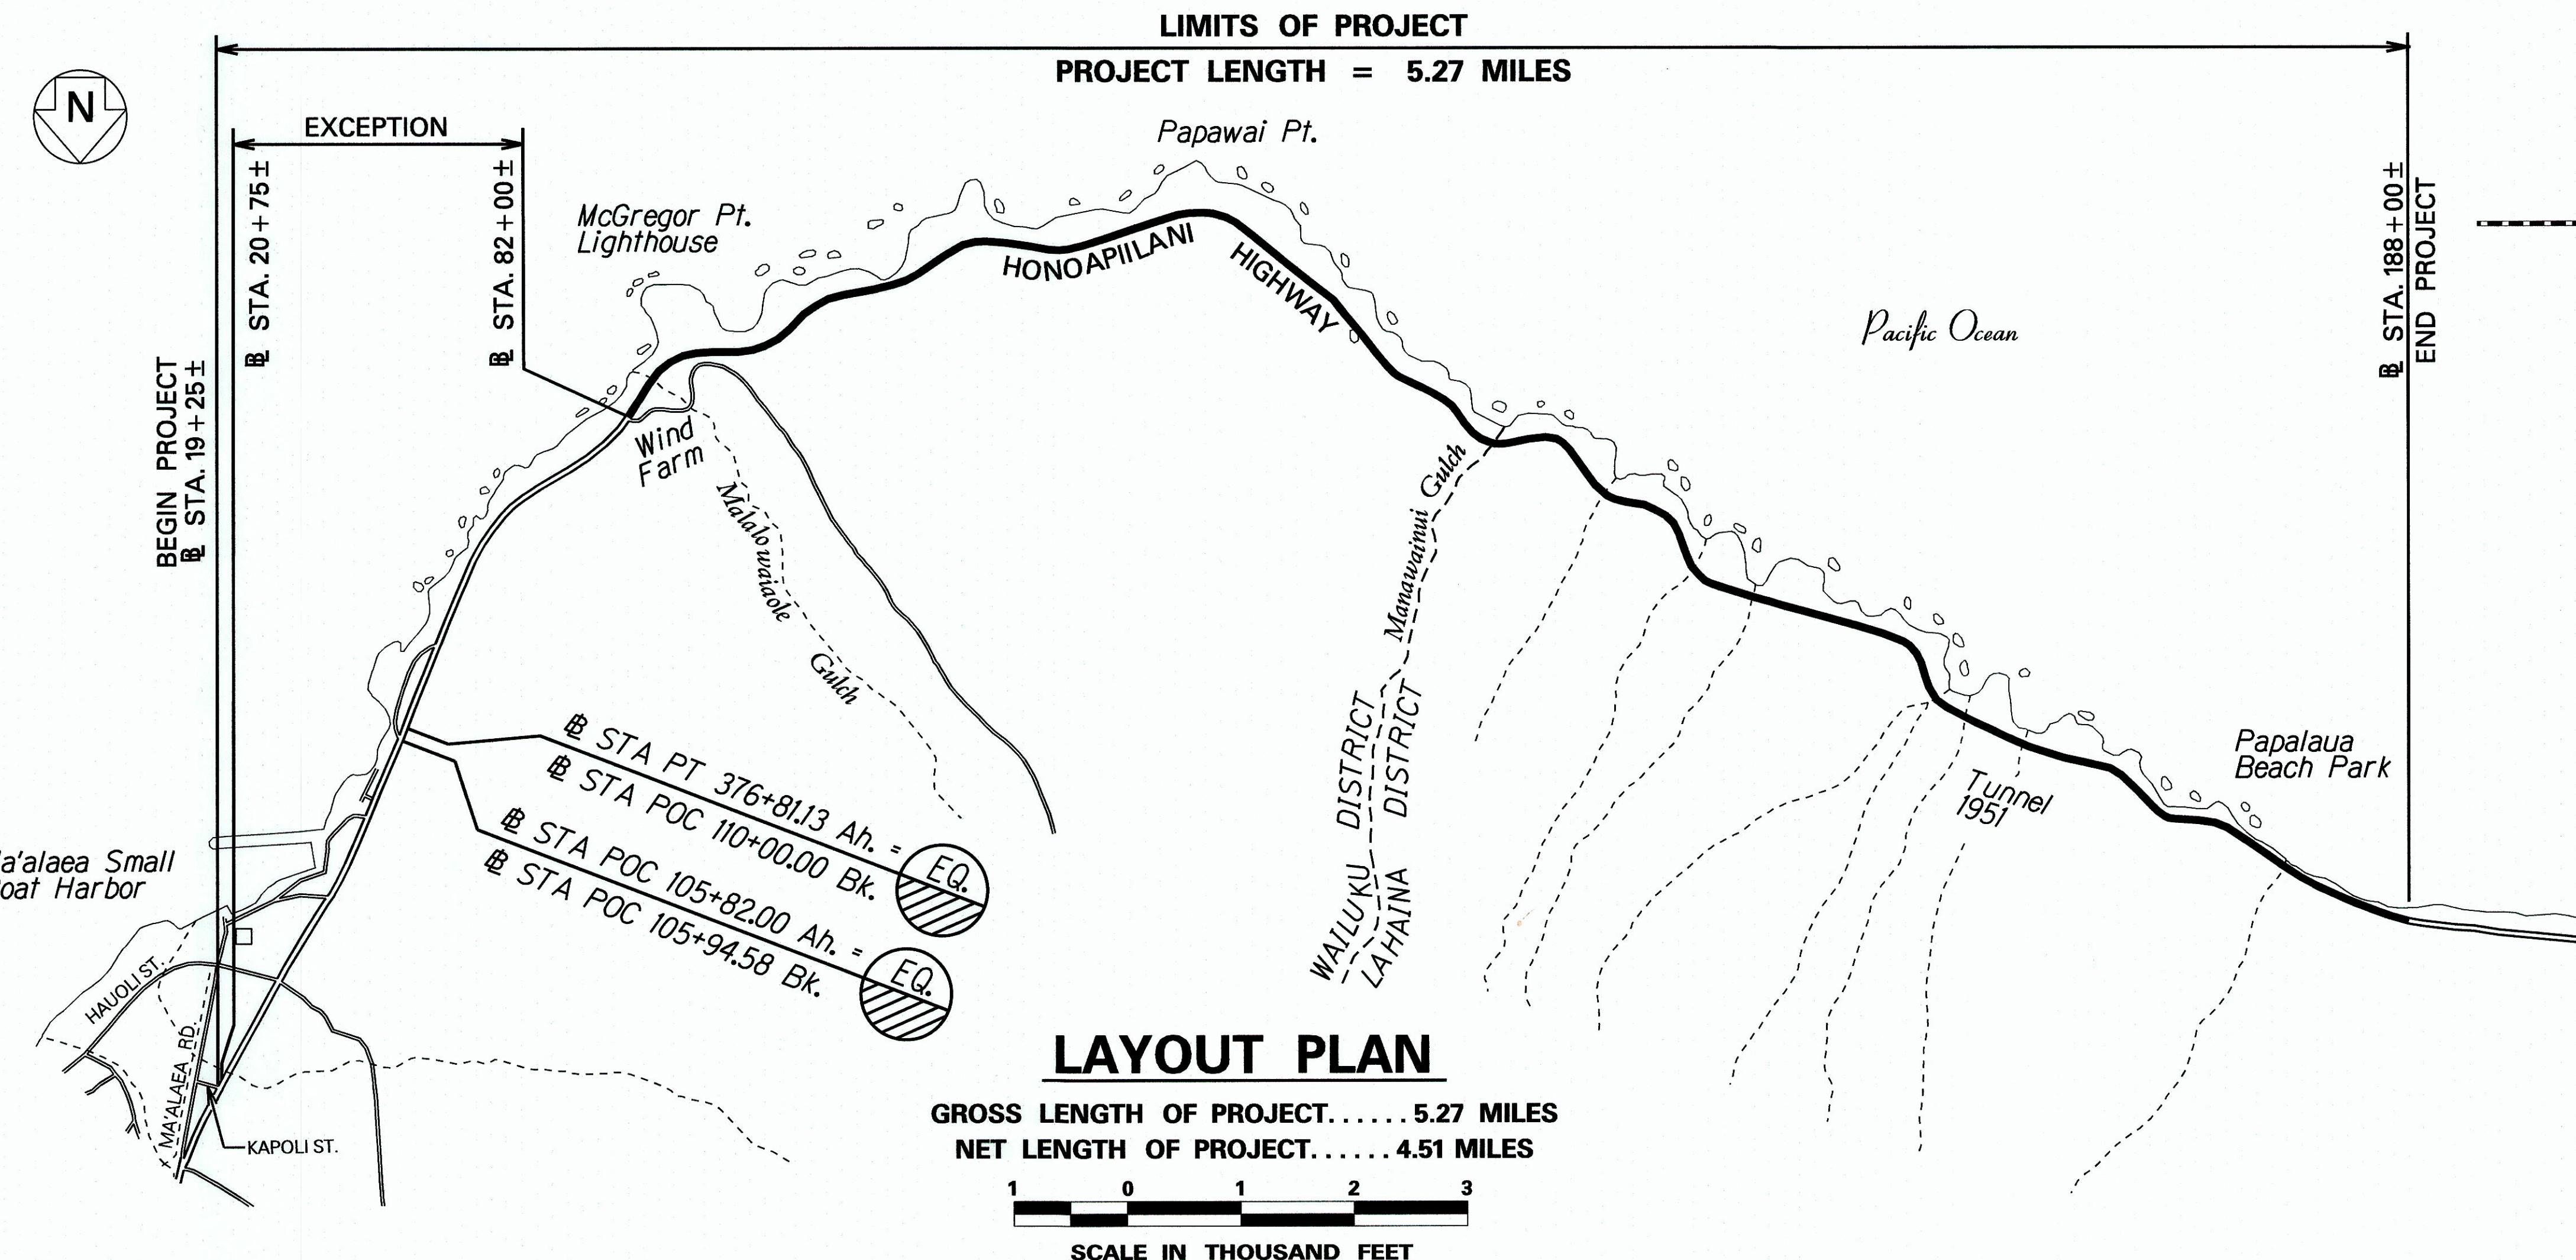
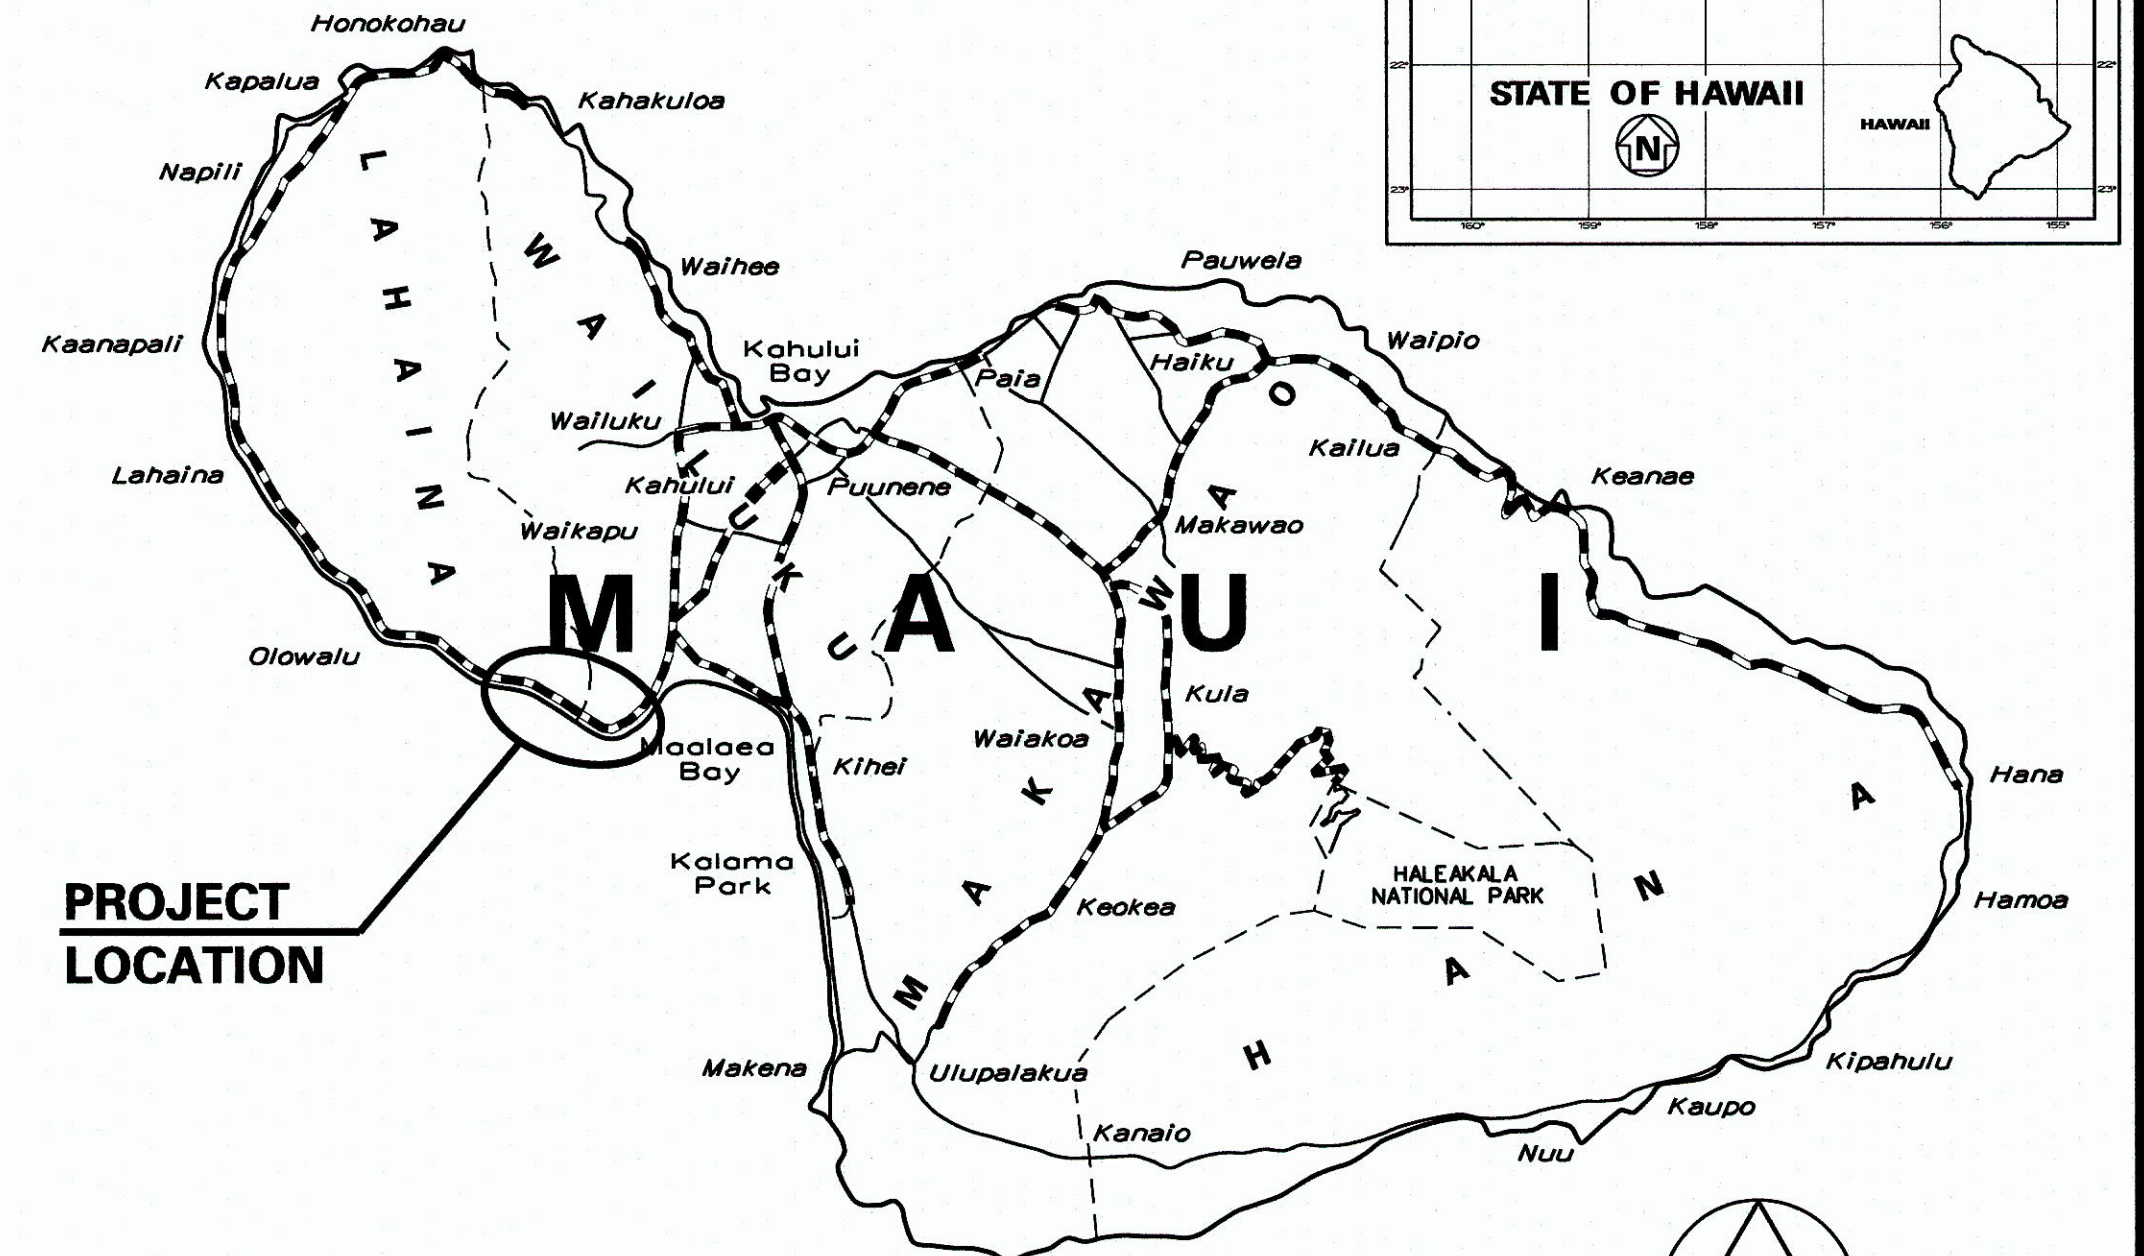


INDEX TO DRAWINGS	
SHEET NO.	DESCRIPTION
1	TITLE SHEET
2	STANDARD PLANS AND SUMMARY
3	GENERAL NOTES AND LEGEND
4 - 6	WATER POLLUTION & EROSION CONTROL NOTES
7	TYPICAL SECTIONS AND DETAILS
8 - 14	GUARDRAIL DETAILS & NOTES
15 - 25	ROADWAY PLANS
26 - 31	DRAINAGE DETAILS & PLANS ①
32 - 48	TRAFFIC NOTES & LEGEND AND PAVEMENT MARKING & STRIPING

Sheet No. ① 31S-1 to 31S-10 are Supplementary Sheets to this Project. Total Sheet Count After "As-built" Posting 58 Sheets.

STATE OF HAWAII
DEPARTMENT OF TRANSPORTATION
HIGHWAYS DIVISION
HONOLULU, HAWAII
"AS-BUILT"
PLANS FOR
HONOAPIILANI HIGHWAY SAFETY IMPROVEMENTS
KAPOLI STREET TO PAPALAUA BEACH PARK
FEDERAL-AID PROJECT NO. HSIP-030-1(45)
DISTRICTS OF WAILUKU and LAHAINA
ISLAND OF MAUI

FED. ROAD DIST. NO.	STATE	FED. AID PROJ. NO.	FISCAL YEAR	SHEET NO.	TOTAL SHEETS
HAWAII	HAW.	HSIP-030-1(45)	2019	1	48

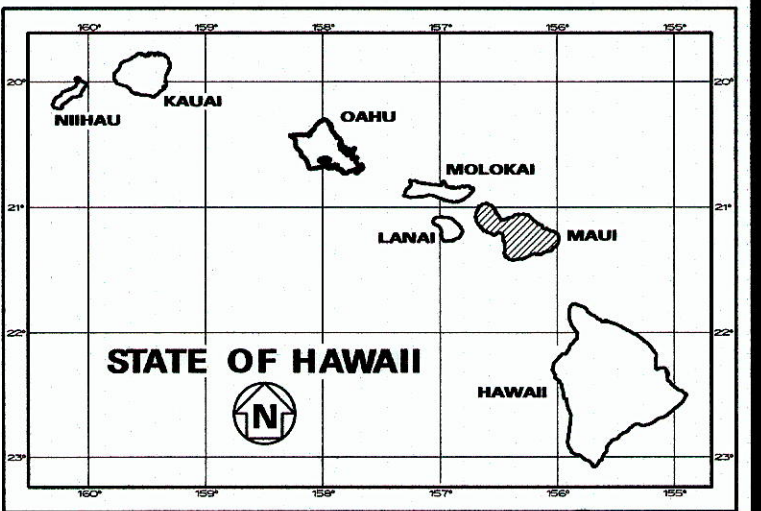

----- FEDERAL AID PROJECTS PREVIOUSLY CONSTRUCTED OR UNDER CONSTRUCTION

MILE POST 6.40 TO MILE POST 11.67

DESIGN DESIGNATION

ADT (2017)	30,100
ADT (2027)	34,100
DHV	2,730
D	55/45
T	3.5 %

CHANGES MADE DURING CONSTRUCTION HAVE BEEN INCORPORATED ON THESE PLANS EXCEPT CHANGES IN THE ORIGINAL THEORETICAL QUANTITIES. FOR ACTUAL QUANTITIES, REFER TO PROJECT LEDGER AND/OR COMPUTATION BOOK.

[Signature] 5/19/21
RESIDENT ENGINEER DATE

DEPARTMENT OF TRANSPORTATION
STATE OF HAWAII
APPROVED: *[Signature]* 8/22/18
DIRECTOR OF TRANSPORTATION DATE