



FED. ROAD DIST. NO.	STATE	FED. AID PROJ. NO.	FISCAL YEAR	SHEET NO.	TOTAL SHEETS
HAWAII	HAW.	STP-030-1(046)	2011	9	28

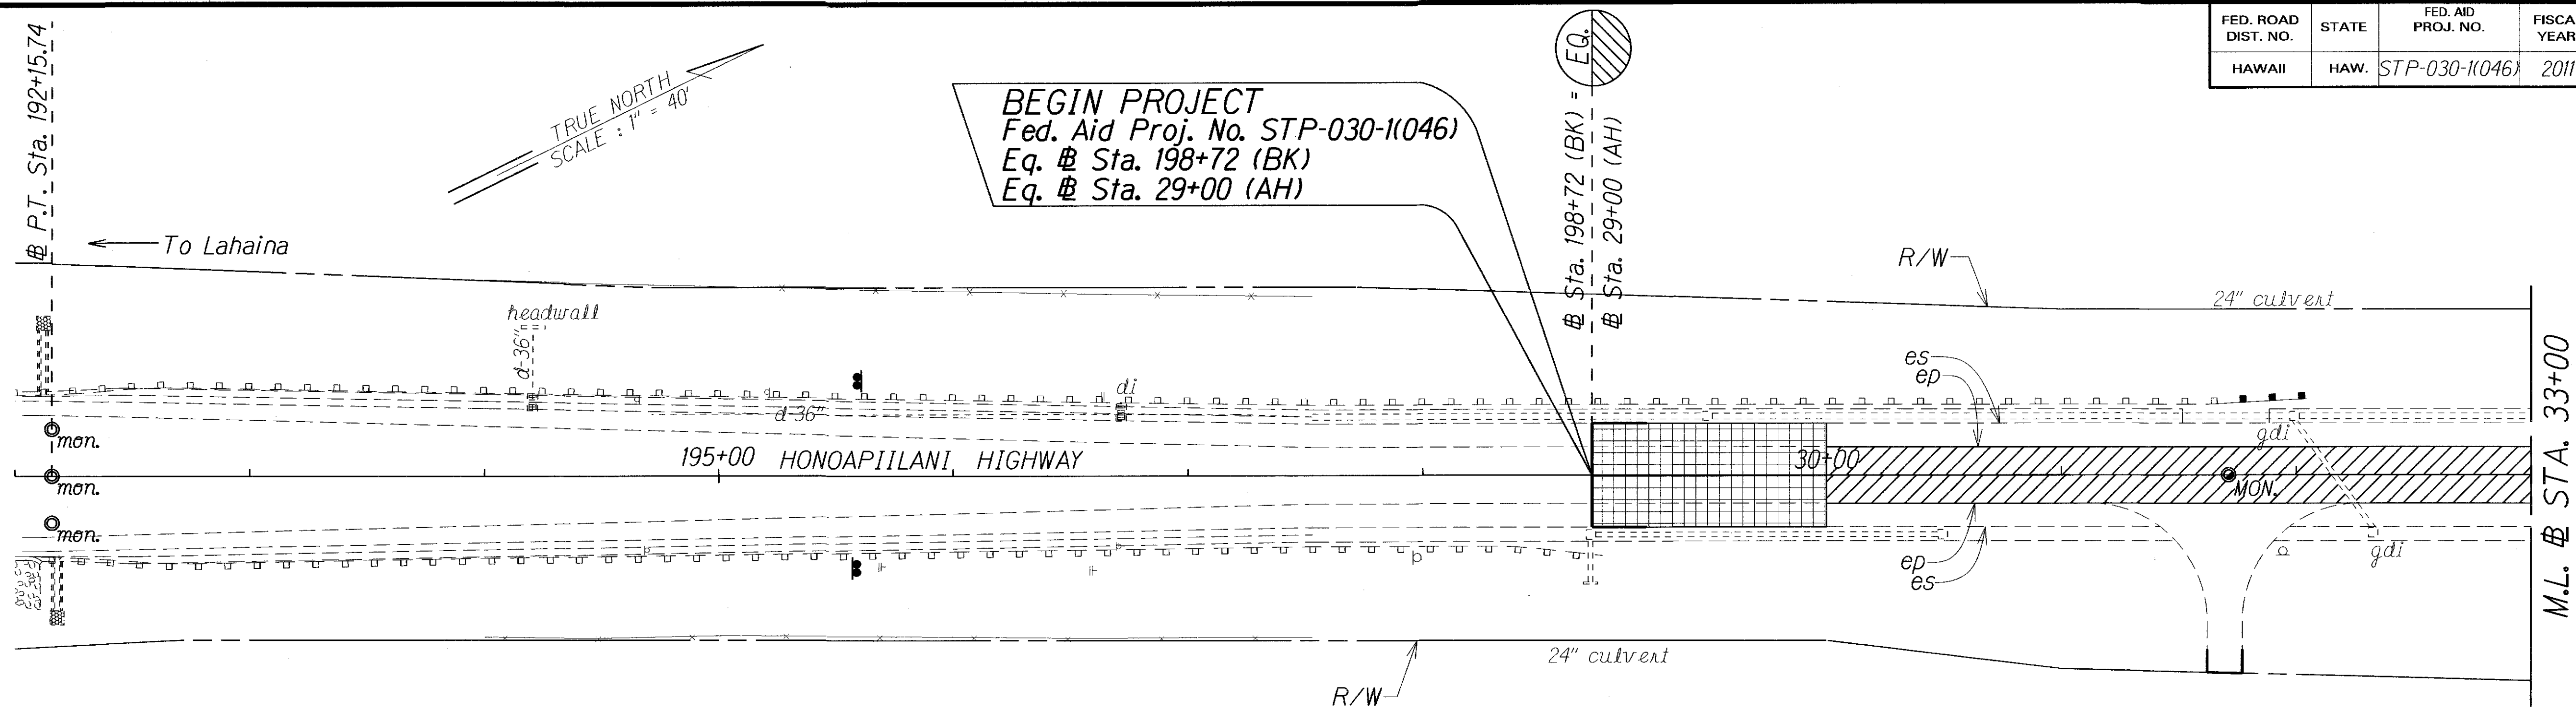

STA. 29+00± LT. - STA. 32+00± LT.
 Demolish & remove existing approach end
 and replace Type FLEAT-350 (1 EACH).
 Reset existing guardrail post (43 EACH)
 Install RM-5 on rail @ 25' o.c. (13 EACH)

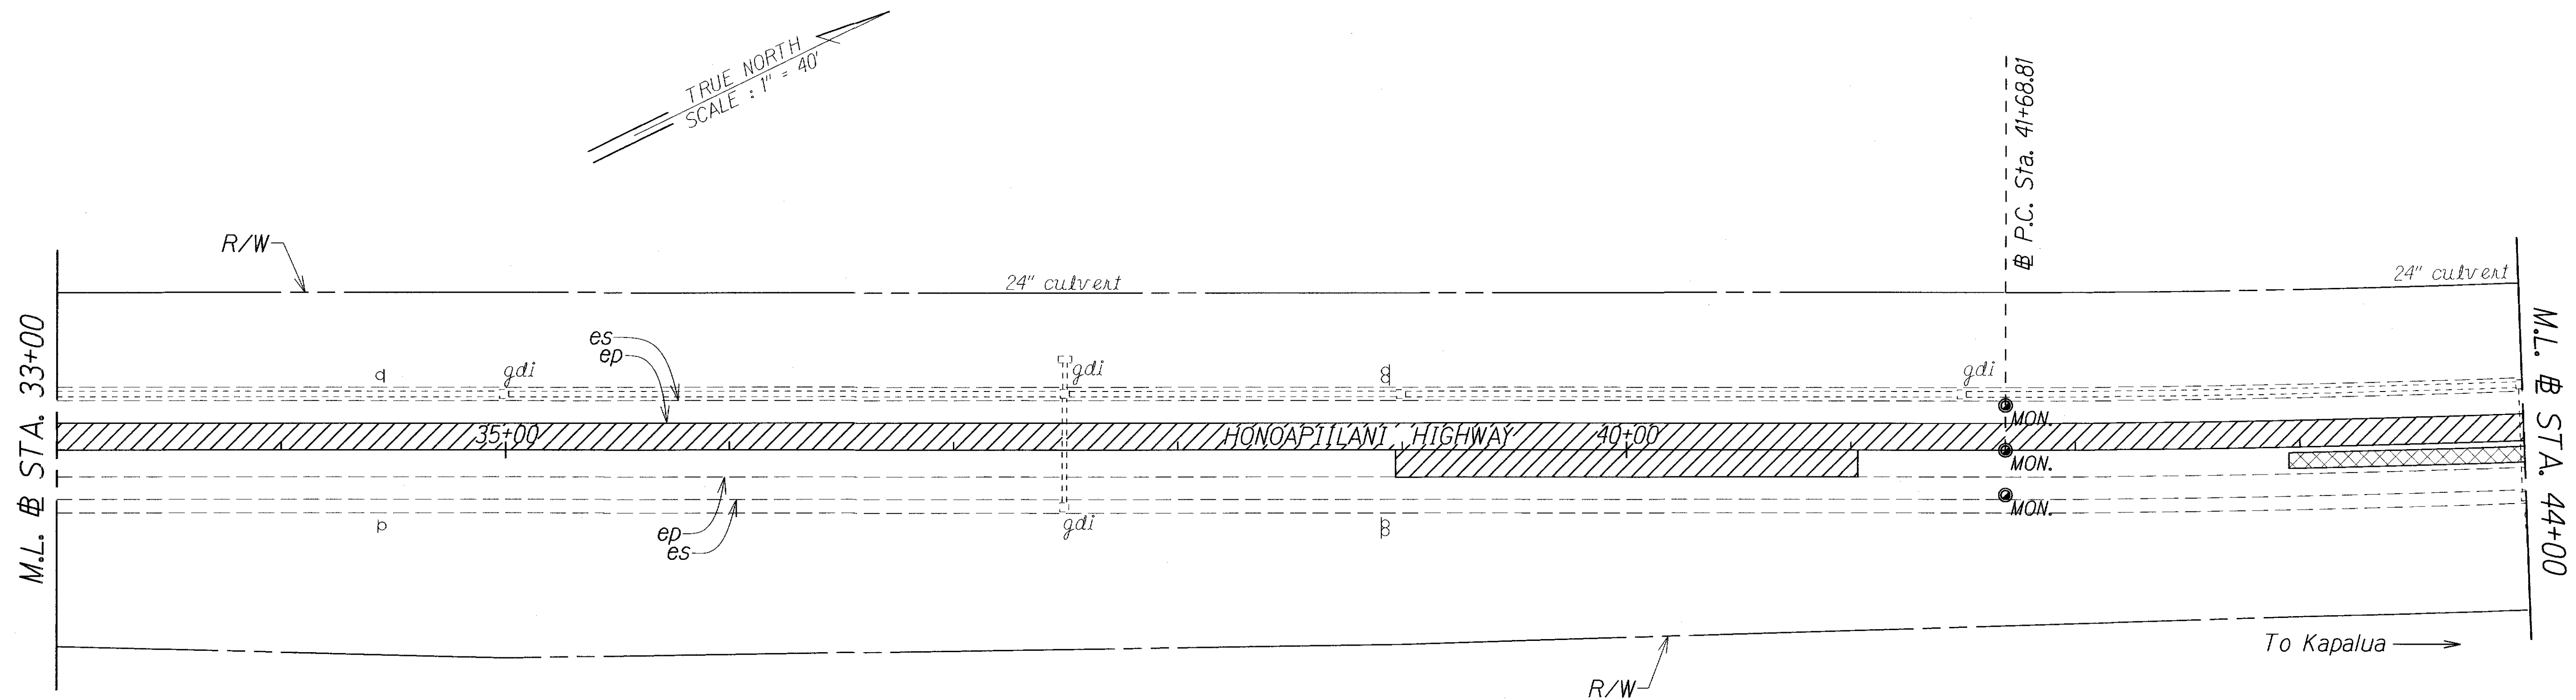

STA. 42+95± RT. - STA. 44+55± RT.
 Pavement Reconstruction (7' x 160')

LEGEND FOR AS-BUILT POSTINGS	
	Squiggly line for as-built deletion
	Double line for as-built deletion
Roadway	Text for as-built posting

STATE OF HAWAII
DEPARTMENT OF TRANSPORTATION
HIGHWAYS DIVISION

ROADWAY PLAN
HONOAPIILANI HIGHWAY RESURFACING
Honokowai to Kahana
Federal-Aid Project No. STP-030-1(046)

Scale: 1" = 40'
Date: November, 2010


SHEET No. 1 OF 5 SHEETS

ORIGINAL PLAN	SURVEY PLOTTED BY	DATE
NOTE BOOK	DRAWN BY	11/10
DESIGNED BY	CHECKED BY	
CHECKED BY		


"AS-BUILT"

FED. ROAD DIST. NO.	STATE	FED. AID PROJ. NO.	FISCAL YEAR	SHEET NO.	TOTAL SHEETS
HAWAII	HAW.	STP-030-110461	2011	10	28

STA. 45+00± LT. - STA. 53+50± LT.
 Demolish & remove existing approach & trailing ends and replace Type FLEAT-350 (2 EACH).
 Reset existing guardrail post (125 EACH)
 Install RM-5 on rail @ 25' o.c. (35 EACH)

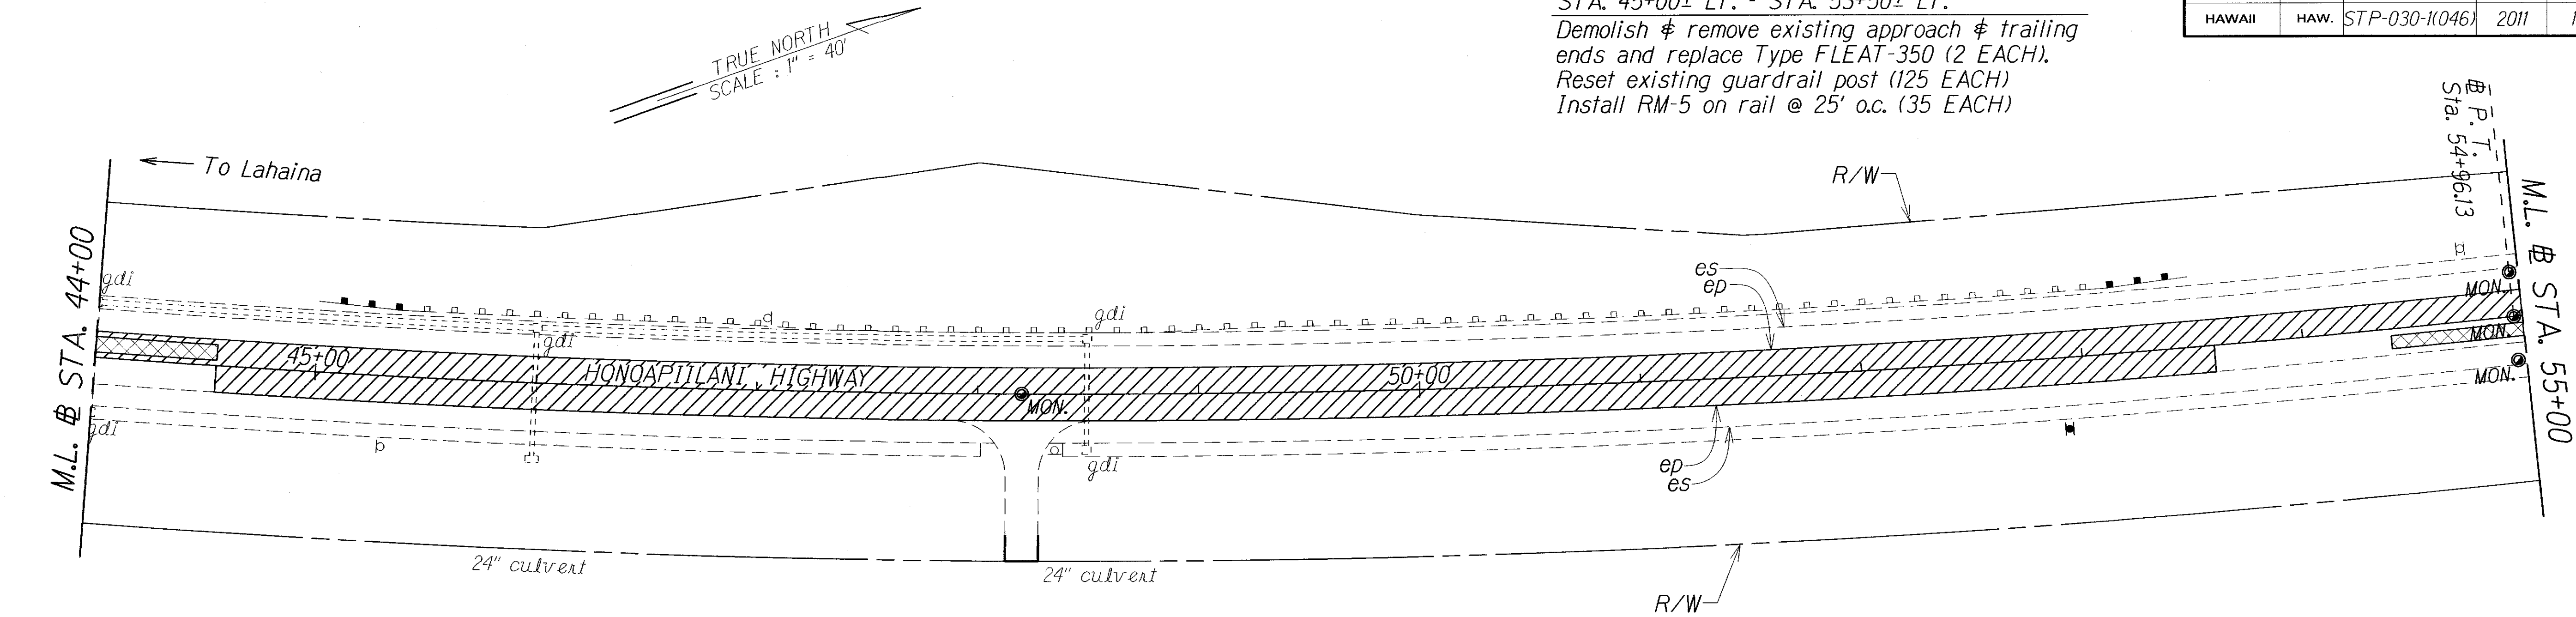

STA. 62+90± LT. - STA. 64+40± LT.
 Pavement Reconstruction (9' x 150')

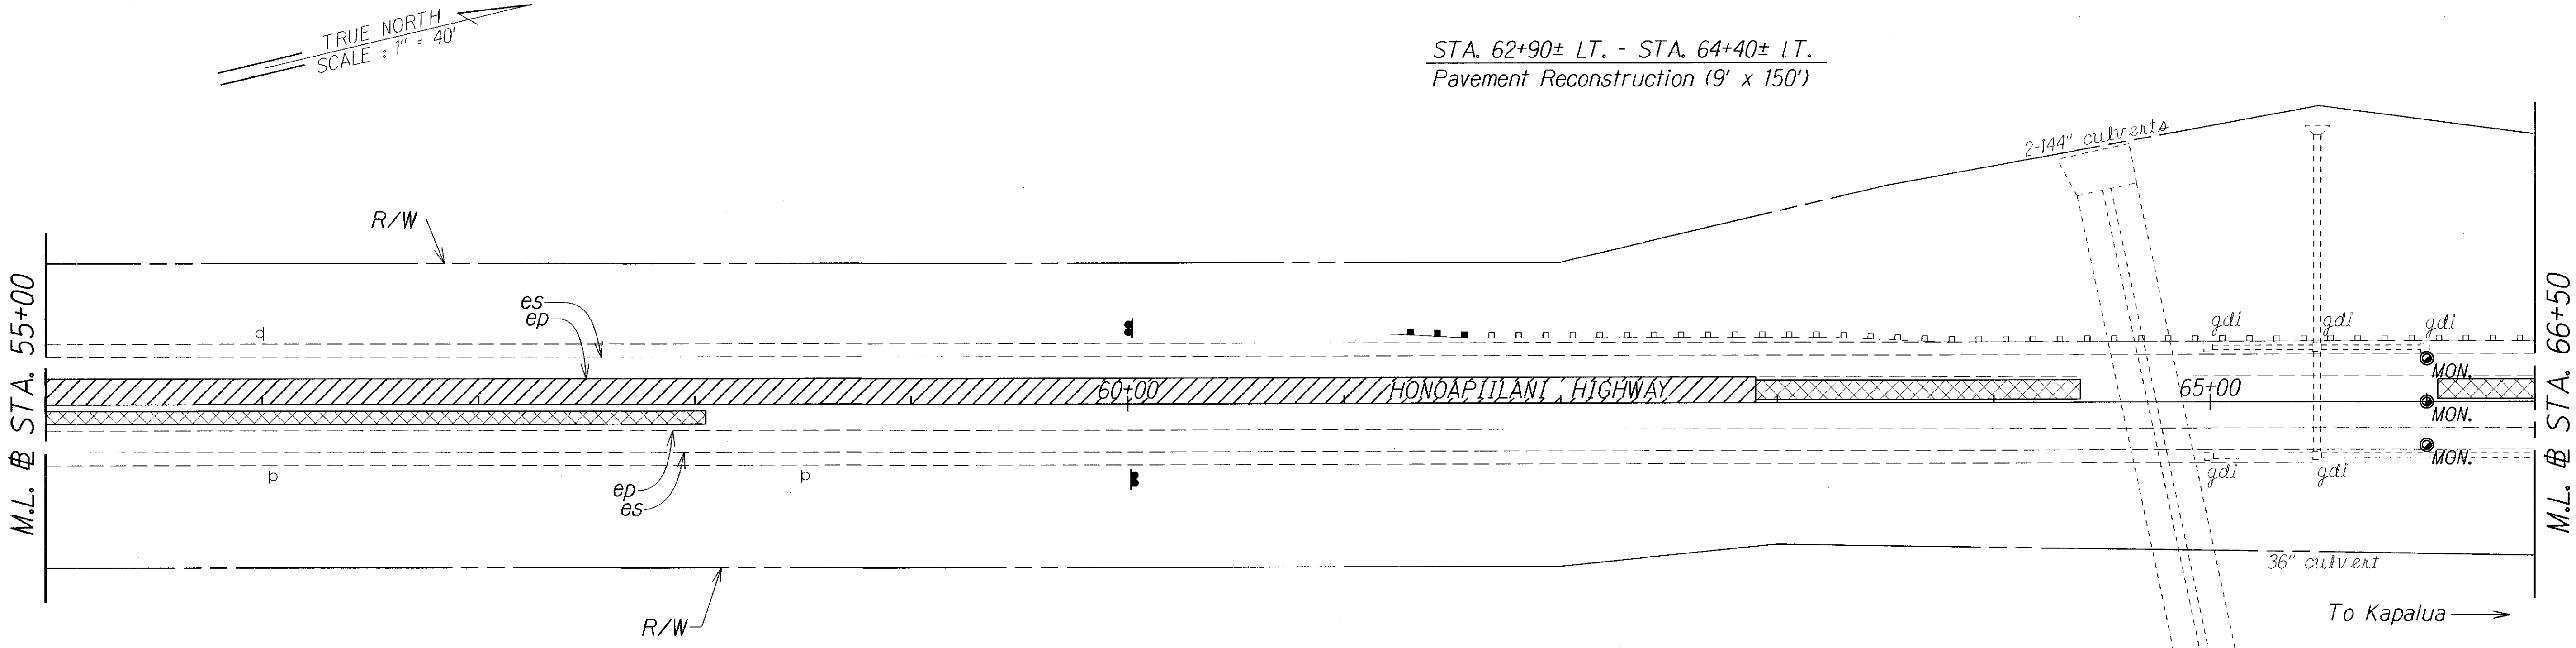

STA. 54+40± RT. - STA. 58+05± RT.
 Pavement Reconstruction (6' x 365')

ORIGINAL PLAN	DATE
SURVEY PLOTTED BY	
DRAWN BY	
DESIGNED BY	
CHECKED BY	

LEGEND FOR AS-BUILT POSTINGS	
	Squiggly line for as-built deletion
	Double line for as-built deletion
Roadway	Text for as-built posting


STATE OF HAWAII
DEPARTMENT OF TRANSPORTATION
HIGHWAYS DIVISION

ROADWAY PLAN
HONOAPIILANI HIGHWAY RESURFACING
Honokowai to Kahana
Federal-Aid Project No. STP-030-110461

Scale: 1" = 40'
Date: November, 2010

SHEET No. 2 OF 5 SHEETS

FED. ROAD DIST. NO.	STATE	FED. AID PROJ. NO.	FISCAL YEAR	SHEET NO.	TOTAL SHEETS
HAWAII	HAW.	STP-030-1(046)	2011	13	28

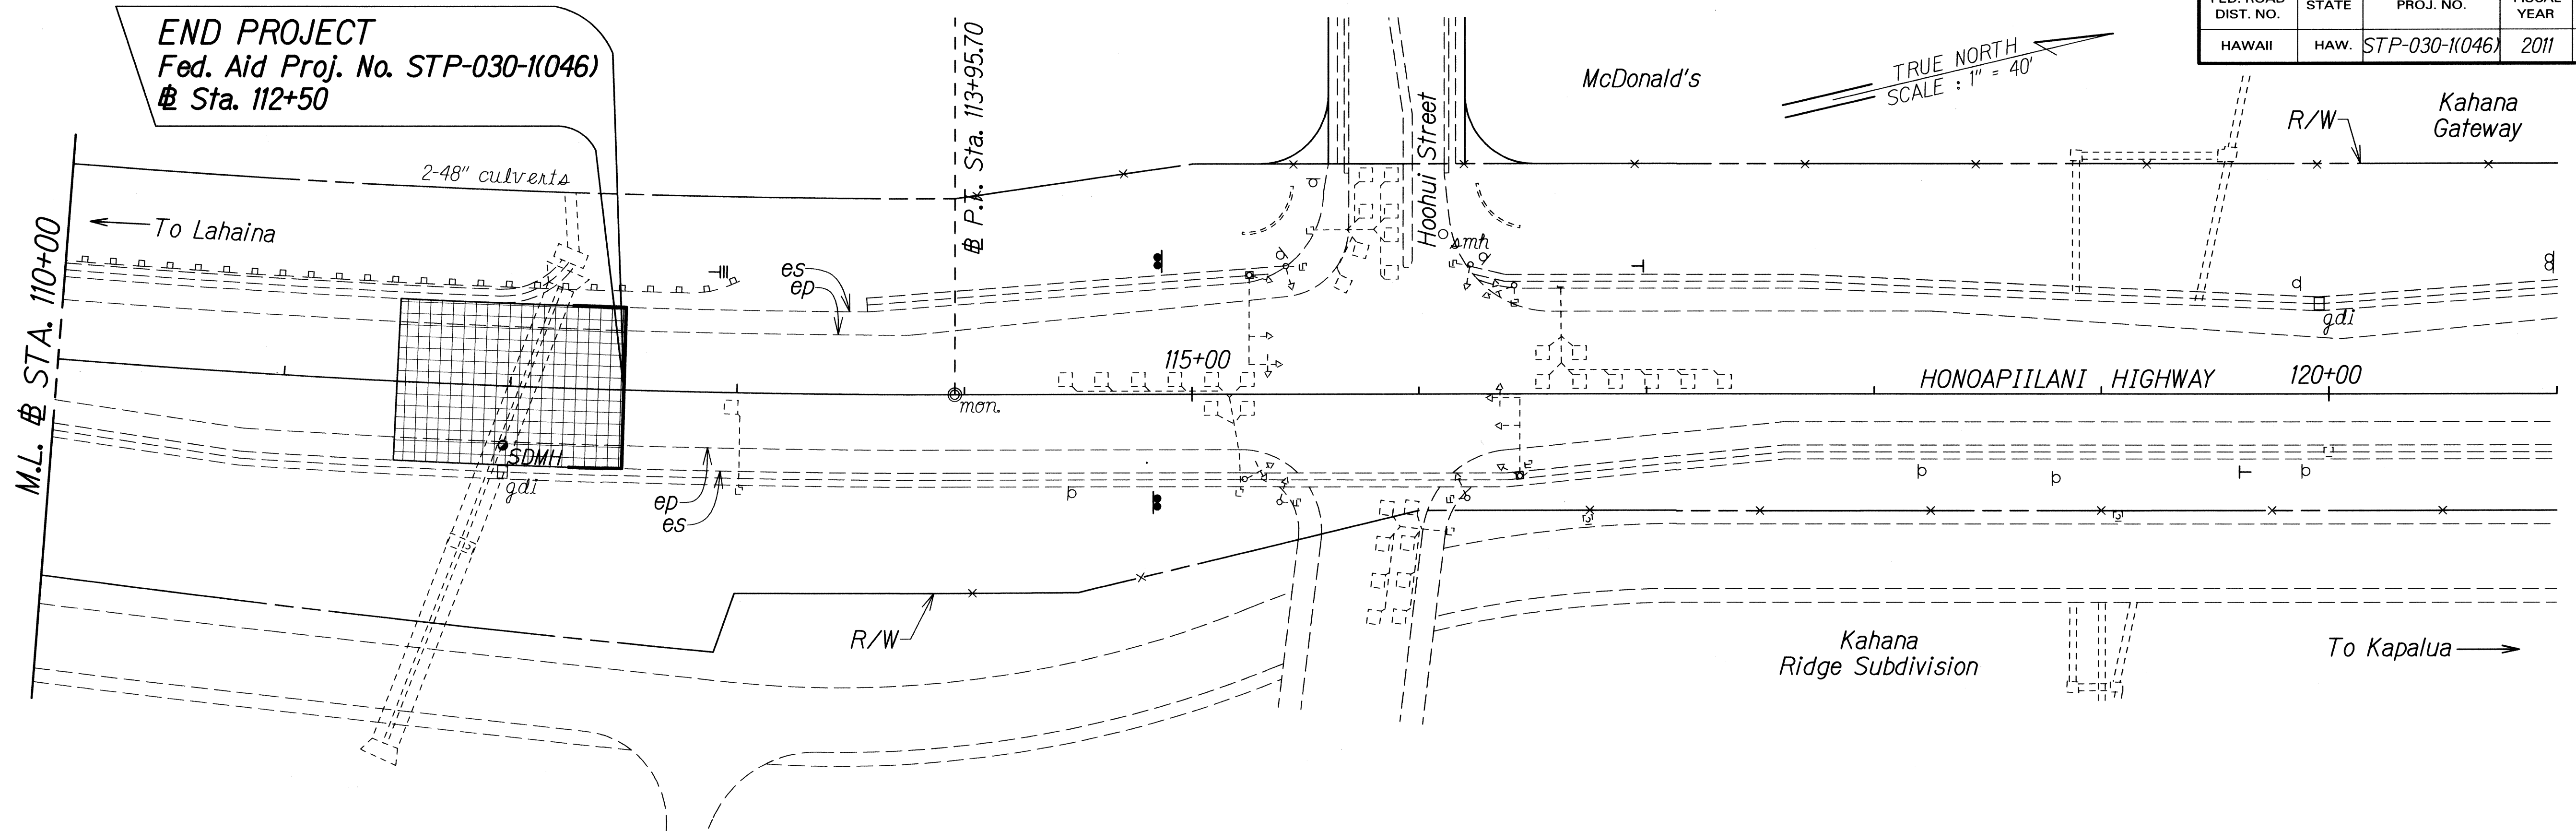

ORIGINAL PLAN	SURVEY PLOTTED BY	DATE
NOTE BOOK	DRAWN BY	11/10
revised	DESIGNED BY	ALEX REEDON
checked	CHECKED BY	

STATE OF HAWAII
DEPARTMENT OF TRANSPORTATION
HIGHWAYS DIVISION

ROADWAY PLAN

HONOAPIILANI HIGHWAY RESURFACING

Honokowai to Kahana

Federal-Aid Project No. STP-030-1(046)

Scale: 1" = 40' Date: November, 2010