

[illegible]

STATE OF HAWAII

DEPARTMENT OF TRANSPORTATION

HIGHWAYS DIVISION

HONOLULU, HAWAII

"AS-BUILT"
PLANS FOR




**HONOAPIILANI HIGHWAY PAVEMENT
PREVENTIVE MAINTENANCE**

VICINITY OF WIND FARM ACCESS ROAD TO OLOWALU

FEDERAL-AID PROJECT NO. NH-030-1(047)

DISTRICTS OF LAHAINA AND WAILUKU
ISLAND OF MAUI

FED. ROAD DIST. NO.	STATE	FED. AID PROJ. NO.	FISCAL YEAR	SHEET NO.	TOTAL SHEETS
HAWAII	HAW.	NH-030-1(047)	2012	1	45

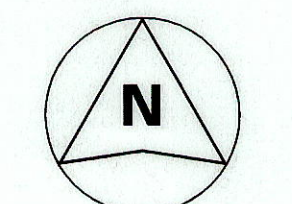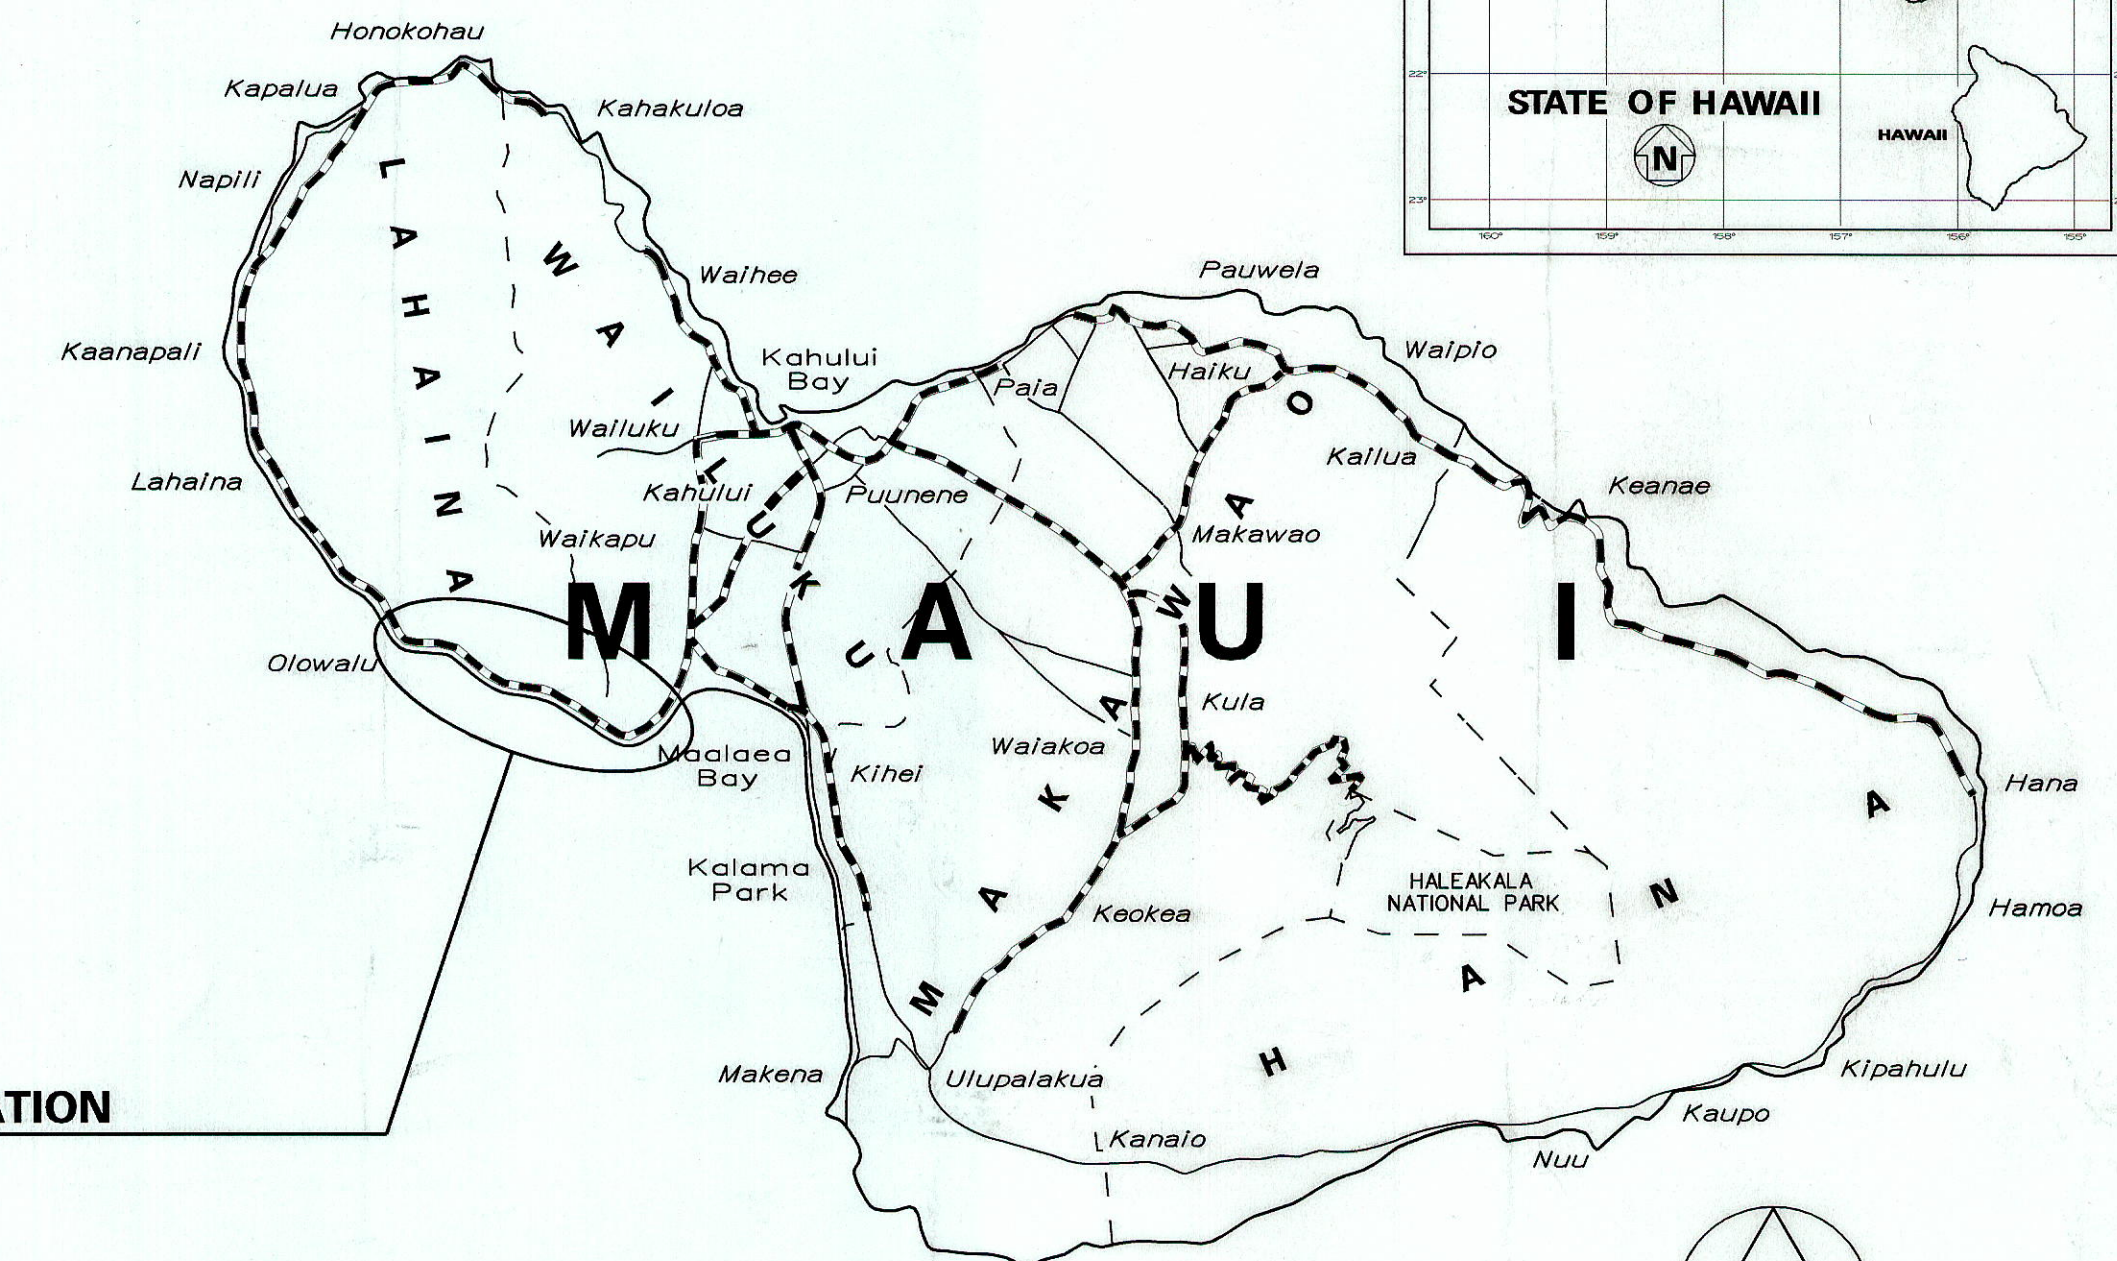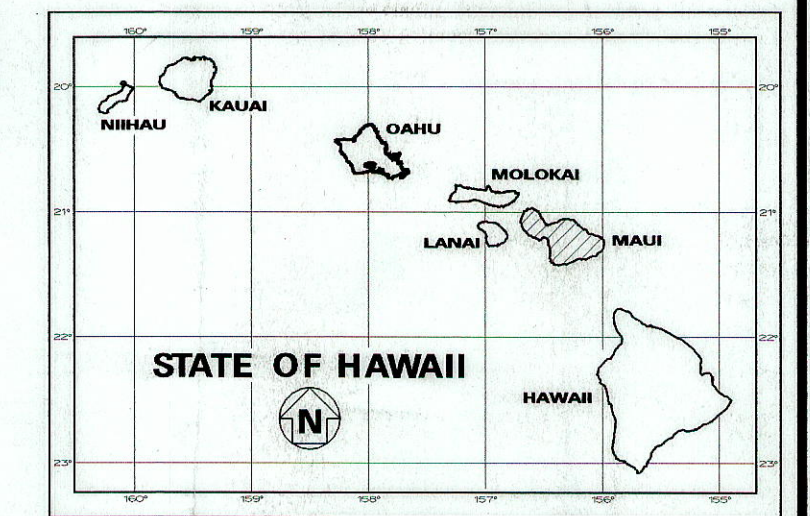

5 0 5 10

SCALE IN MILES



 FEDERAL AID PROJECTS PREVIOUSLY CONSTRUCTED
 OR UNDER CONSTRUCTION

MILE POST 7.67 TO MILE POST 14.62

DESIGN DESIGNATION

ADT (2011)	27,400
ADT (2021)	31,200
DHV (2021)	2,500
DESIGN K	8.0
DESIGN D	55/45
DESIGN T	3.5
T24	4.5

CHANGES MADE DURING CONSTRUCTION HAVE BEEN INCORPORATED ON THESE PLANS EXCEPT CHANGES IN THE ORIGINAL THEORETICAL QUANTITIES. FOR ACTUAL QUANTITIES, REFER TO PROJECT LEDGER AND/OR COMPUTATION BOOK.

RESIDENT ENGINEER 9/12/13
DATE

DEPARTMENT OF TRANSPORTATION STATE OF HAWAII	
APPROVED:  DIR. OF TRANSPORTATION 2-17-11 DATE	

1