

STATE OF HAWAII

DEPARTMENT OF TRANSPORTATION

HIGHWAYS DIVISION

HONOLULU, HAWAII
"AS-BUILT"

PLANS FOR

PROJECT LOCATION

FED. ROAD DIST. NO. STATE FED. AID PROJ. NO. FISCAL SHEET NO. SHEETS HAWAII HAW. STP-030-1(048) 2011 1 25

30




HONOAPIILANI HIGHWAY PAVEMENT PREVENTIVE MAINTENANCE

LAHAINALUNA ROAD TO KAANAPALI PARKWAY
FEDERAL-AID PROJECT NO. STP-030-1(048)

DISTRICT OF LAHAINA ISLAND OF MAUI

SCALE IN MILES

PROJECT LOCATION

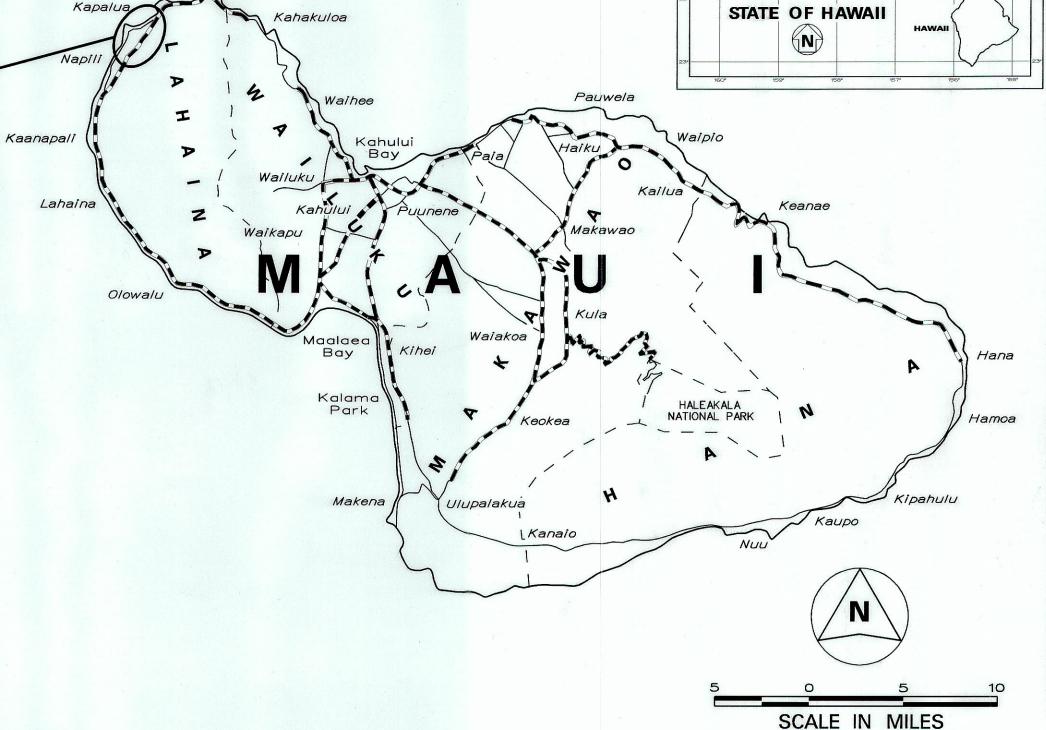

FEDERAL AID PROJECTS PREVIOUSLY CONSTRUCTED OR UNDER CONSTRUCTION

MILE POST 20.93 TO MILE POST 23.89

DESIGN DESIGNATION

	HONOAPIILANI HIGH	IWAY
TRAFFIC DATA	LAHAINALUNA RD. TO FRONT ST.	FRONT ST. TO KAANAPALI PARKWAY
ADT (2011)	34,800	39,500
ADT (2021)	38,200	43,300
DHV (2021)	3,060	3,680
DESIGN K	8.0	8.5
DESIGN D	55/45	55/45
DESIGN T	3.0	2.5
T24	3.5	3.0

CHANGES MADE DURING CONSTRUCTION HAVE BEEN INCORPORATED ON THESE PLANS EXCEPT CHANGES IN THE ORIGINAL THEORETICAL QUANTITIES. FOR ACTUAL QUANTITIES, REFER TO PROJECT LEDGER AND/OR COMPUTATION BOOK.

DEPARTMENT OF TRANSPORTATION STATE OF HAWAII

APPROVED:

DIR. OF TRANSPORTATION DATE

AND THE PROPERTY AND TH