


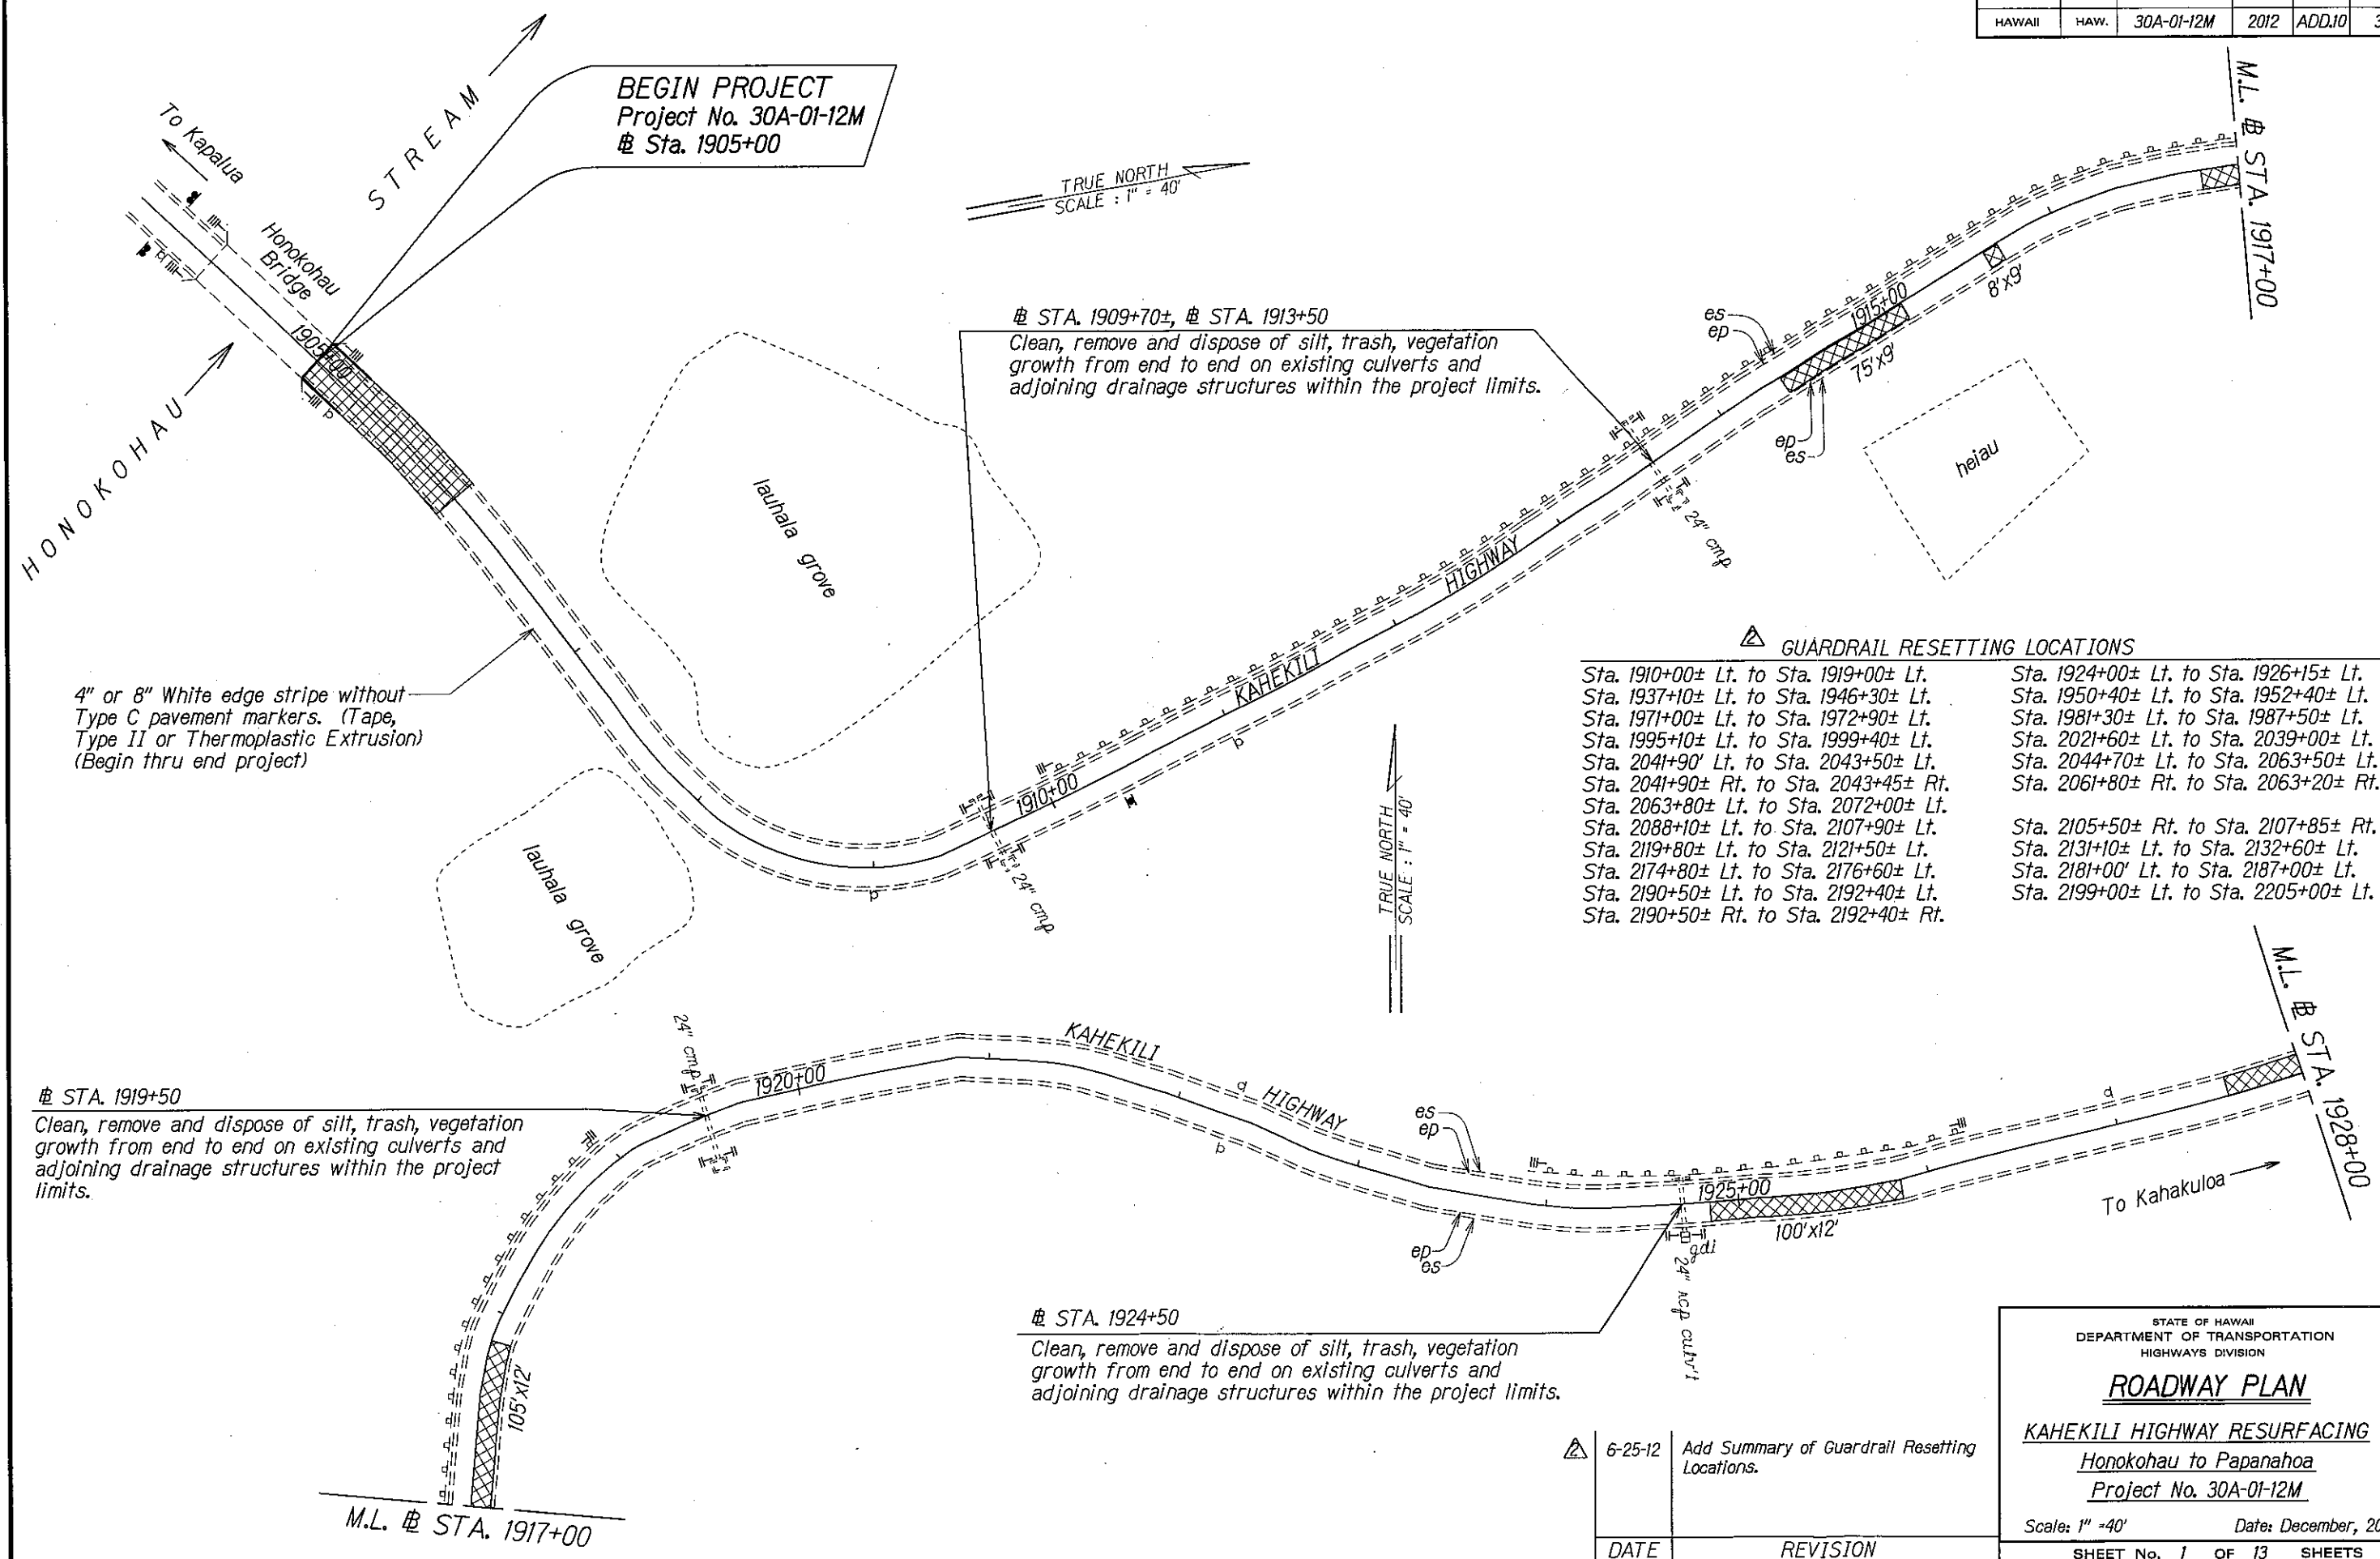

SURVEY PLOTTED BY	DATE
DRAWN BY	
DESIGNED BY	
CHECKED BY	
ORIGINAL PLAN	
NOTE BOOK	
DATE	
BY	

6-25-12	Add Summary of Guardrail Resetting Locations.
DATE	REVISION

STATE OF HAWAII DEPARTMENT OF TRANSPORTATION HIGHWAYS DIVISION
ROADWAY PLAN
KAHEKILI HIGHWAY RESURFACING
Honokohau to Papanahoa
Project No. 30A-01-12M
Scale: 1" = 40' Date: December, 2011
SHEET No. 1 OF 13 SHEETS