


FED. ROAD DIST. NO.	STATE	FED. AID PROJ. NO.	FISCAL YEAR	SHEET NO.	TOTAL SHEETS
HAWAII	HAW.	NH-030-110531	2015	ADD.15	28

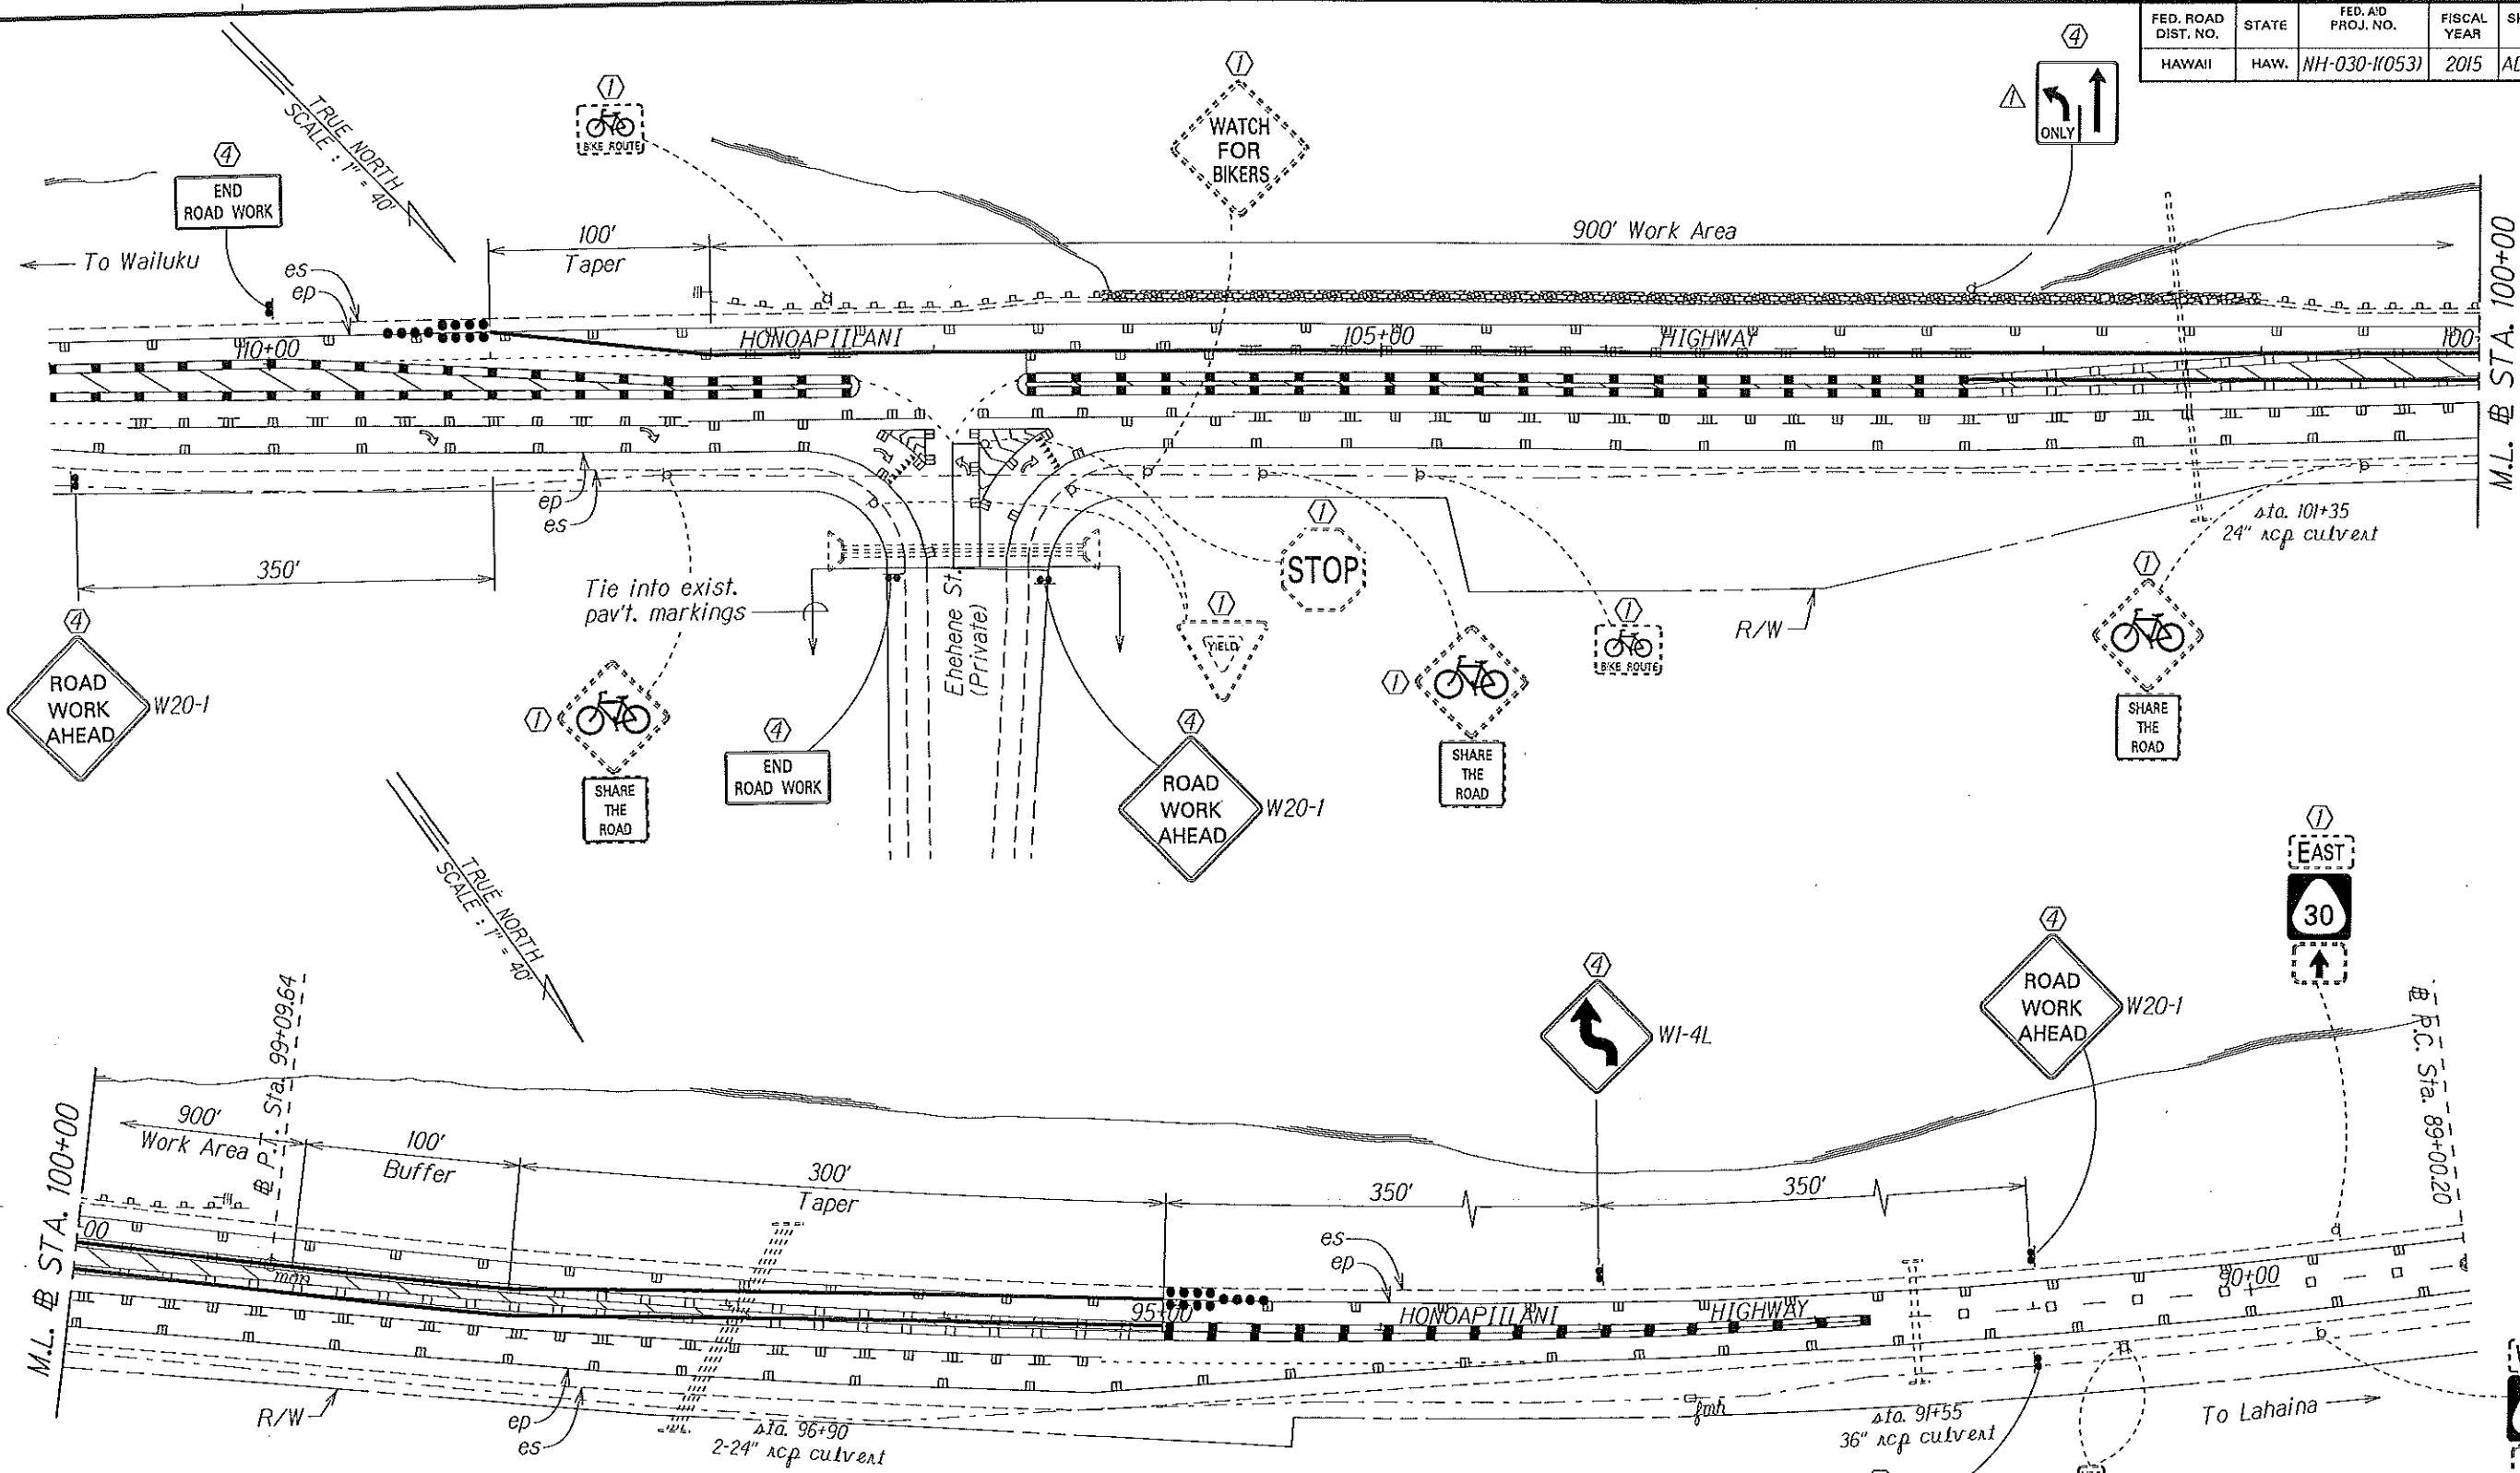

NOTES:

- Contractor shall submit to the Engineer Temporary Traffic Control Plans for the installation of Portable Concrete Barriers for the approval prior to the commencement of work. The work area shall be a minimum of fifteen feet (15) between the concrete wall and the Portable Concrete Barrier.
- Contractor shall install inertial Barrier System per Manufacturer's specifications for 55 MPH design speed.

KEY:

- Exist. Sign(s) & Post(s) to Remain
- Remove Exist. Sign(s) & Post(s)
- Remove Exist. & Install New Sign(s) & Post(s)
- Install New Sign(s) & Post(s)

10-20-14	Changed Key from 1 to 4. Replace Note 2 with Note 3.
DATE	REVISION

STATE OF HAWAII
DEPARTMENT OF TRANSPORTATION
HIGHWAYS DIVISION

SIGNING & TRAFFIC CONTROL PLAN
HONOAPIʻILANI HIGHWAY GUARDRAIL
& SHOULDER IMPROVEMENTS
Vicinity of Ukumehame M.P. 13.2 to M.P. 13.3
Federal-Aid Project No. NH-030-110531
Scale: 1" = 40' Date: June, 2014
SHEET No. 1 OF 1 SHEETS