




FED. ROAD DIST. NO.	STATE	FED. AID PROJ. NO.	FISCAL YEAR	SHEET NO.	TOTAL SHEETS
HAWAII	HAW.	NH-030-11053	2015	7	28

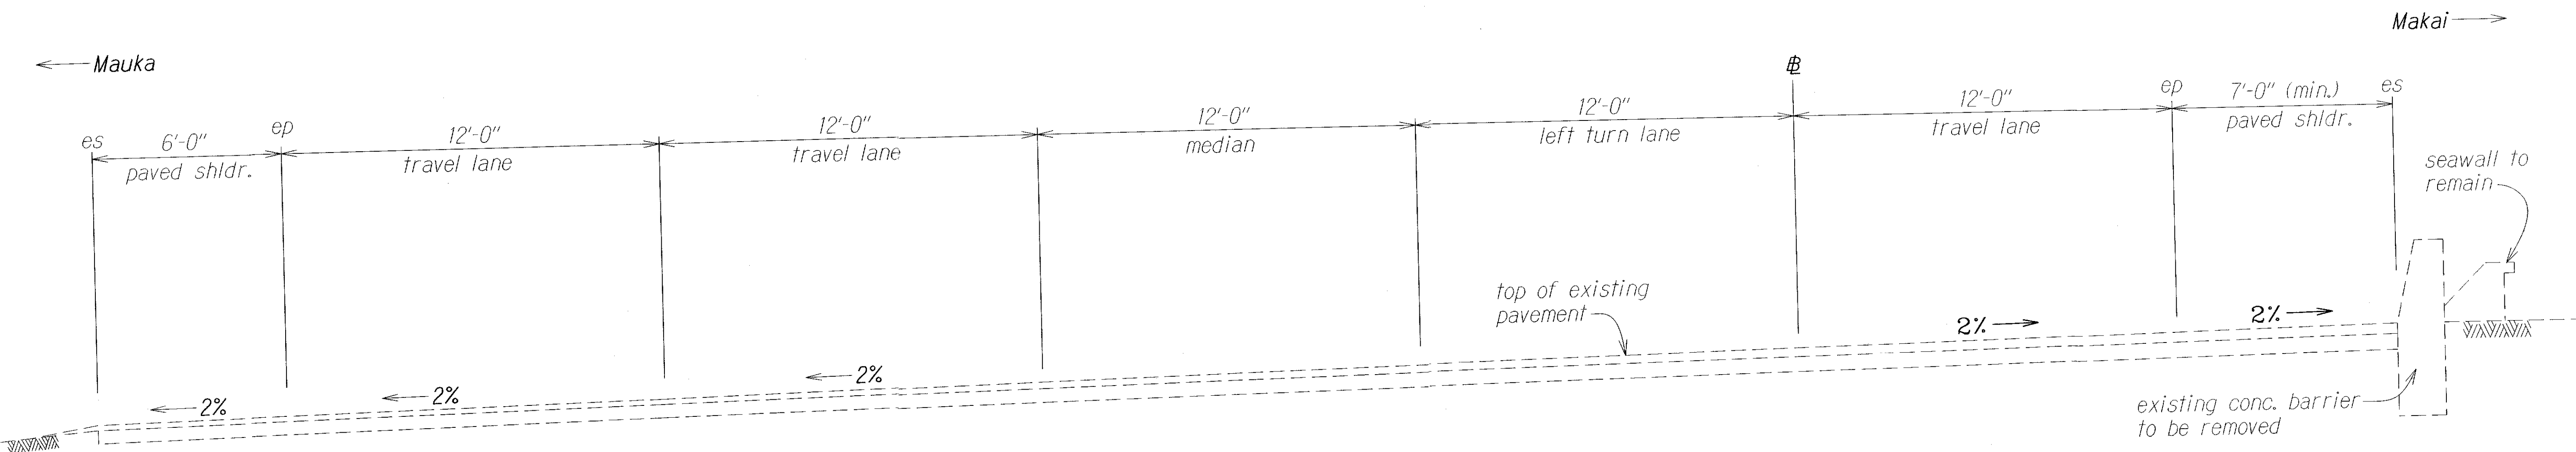

TYPICAL SECTION (STA. 109+00 - STA. 99+00)
 Scale: 3/8" = 1'-0"

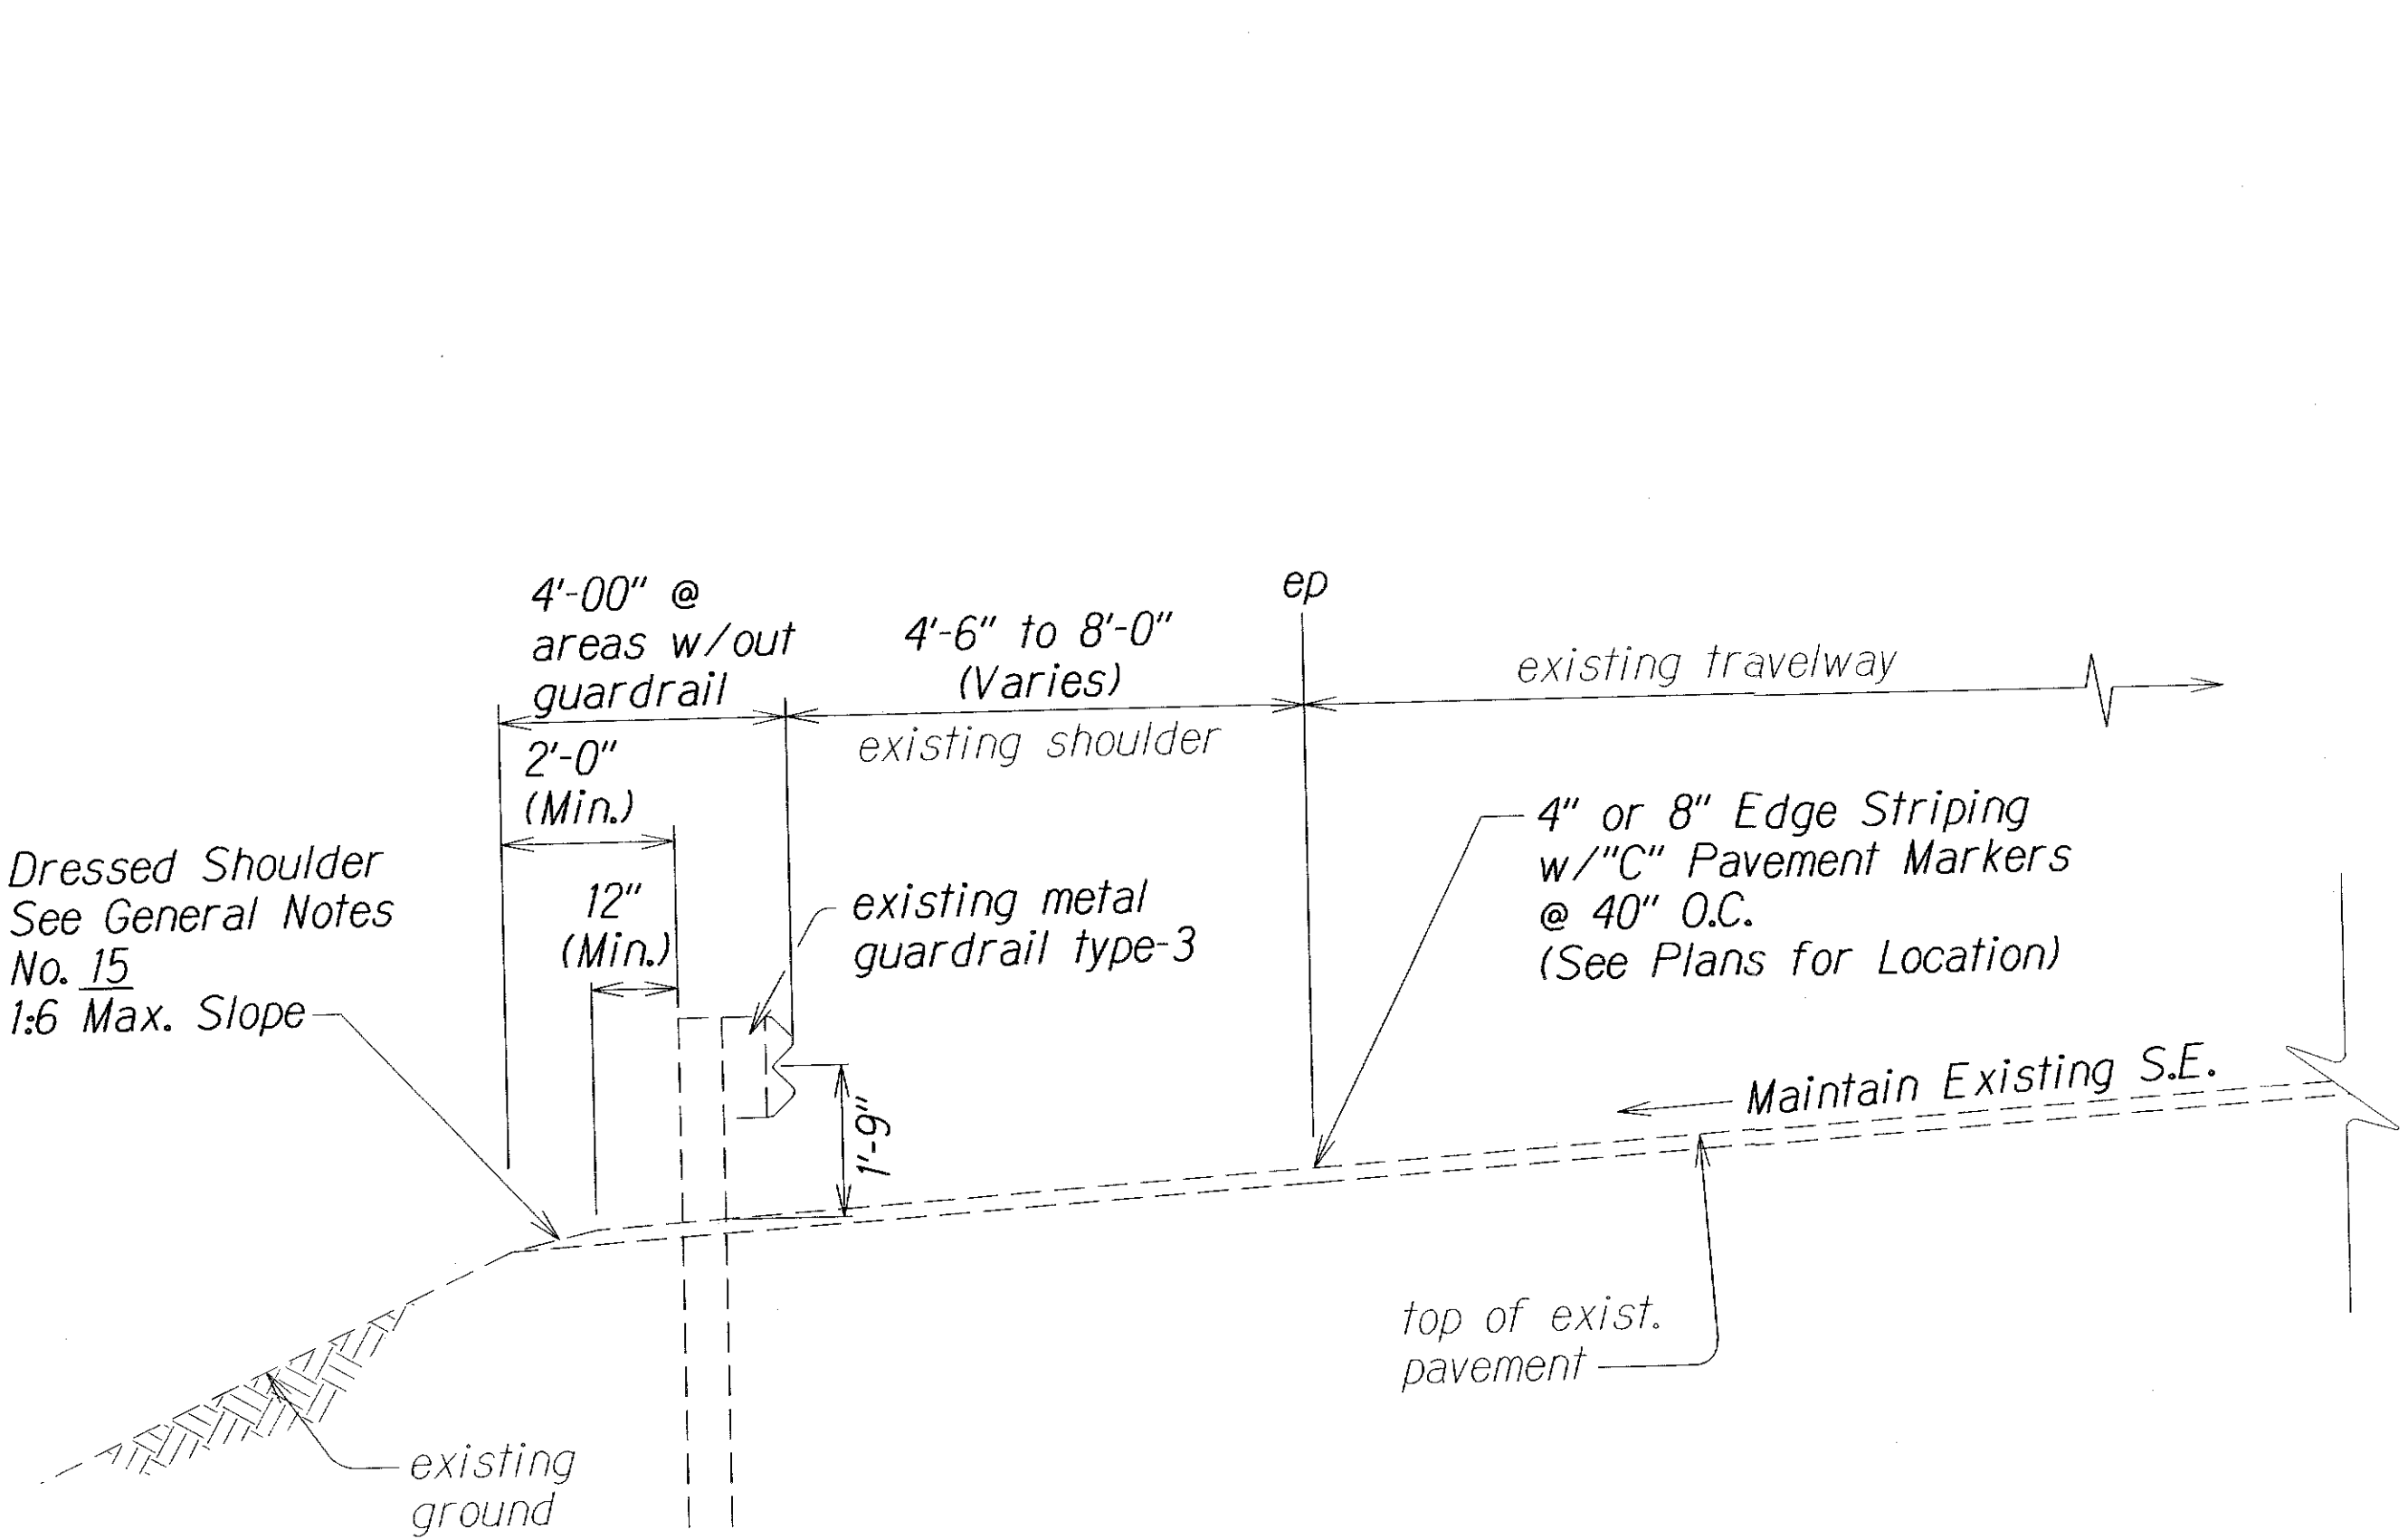

TYPICAL HALF SECTION ON GUARDRAILS
 Scale: 1/2" = 1'-0"

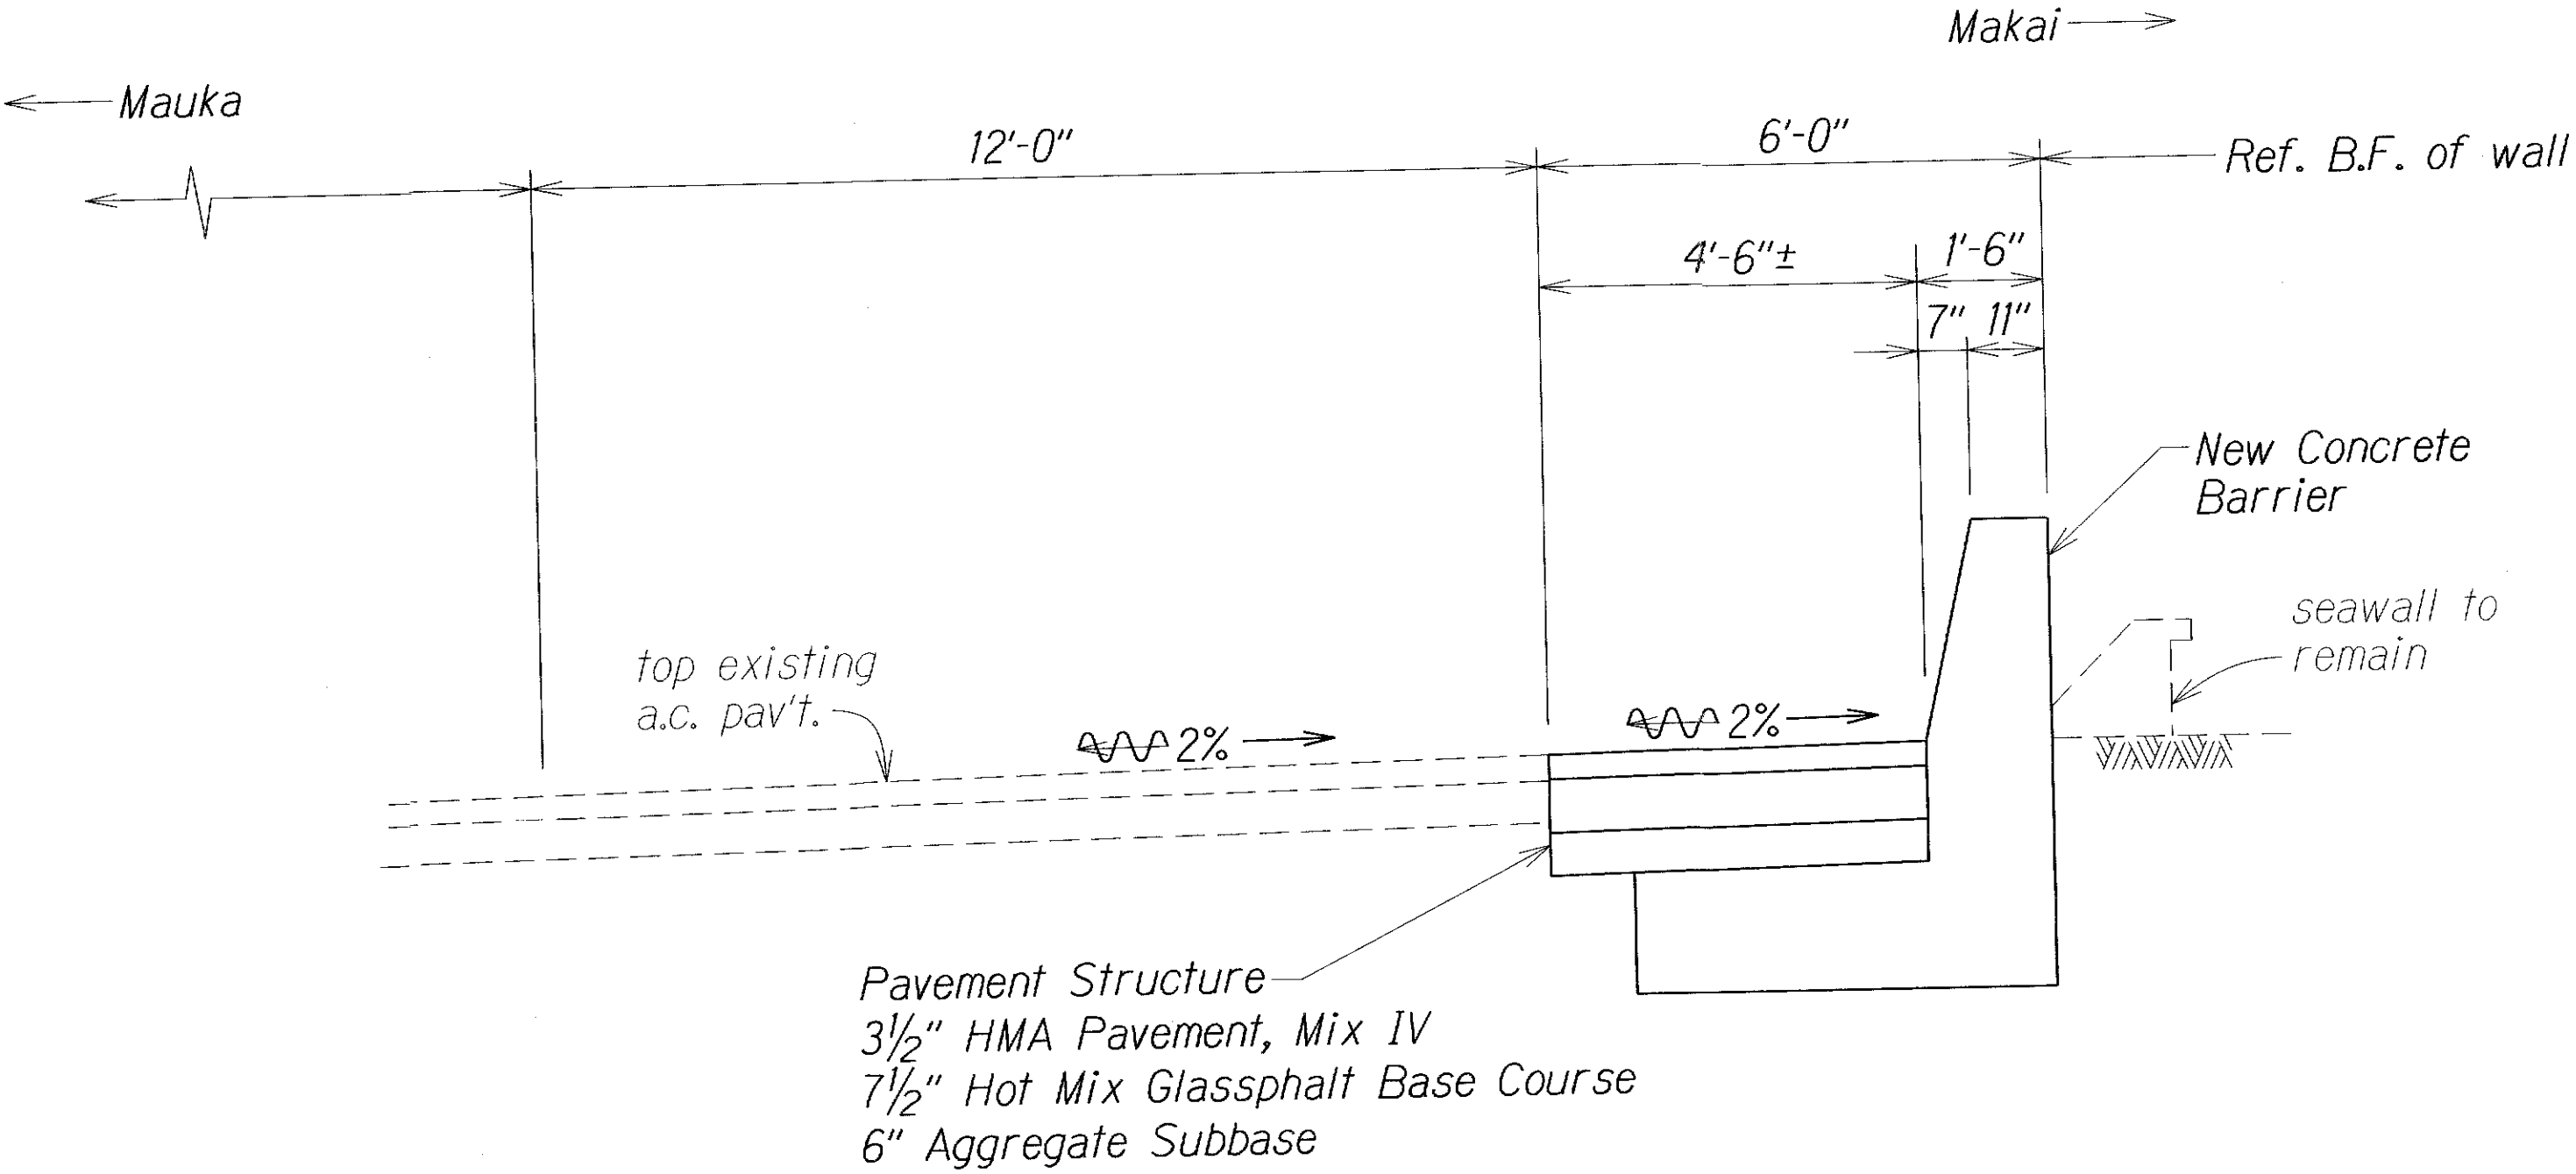

A.C. PAVEMENT RECONSTRUCTION DETAIL
 Scale: 3/8" = 1'-0"

LEGEND FOR AS-BUILT POSTINGS	
	Squiggly line for as-built deletion
	Double line for as-built deletion
Roadway	Text for as-built posting

STATE OF HAWAII DEPARTMENT OF TRANSPORTATION HIGHWAYS DIVISION	
TYPICAL SECTIONS & DETAILS	
HONOAPIILANI HIGHWAY GUARDRAIL & SHOULDER IMPROVEMENTS	
Vicinity of Ukumehame M.P. 13.2 to M.P. 13.3	
Federal-Aid Project No. NH-030-11053	
Scale: As Shown	Date: August, 2014
SHEET No. 1 OF 1 SHEETS	