


FED. ROAD DIST. NO.	STATE	PROJ. NO.	FISCAL YEAR	SHEET NO.	TOTAL SHEETS
HAWAII	HAW.	30A-01-16M	2016	ADD.17	38

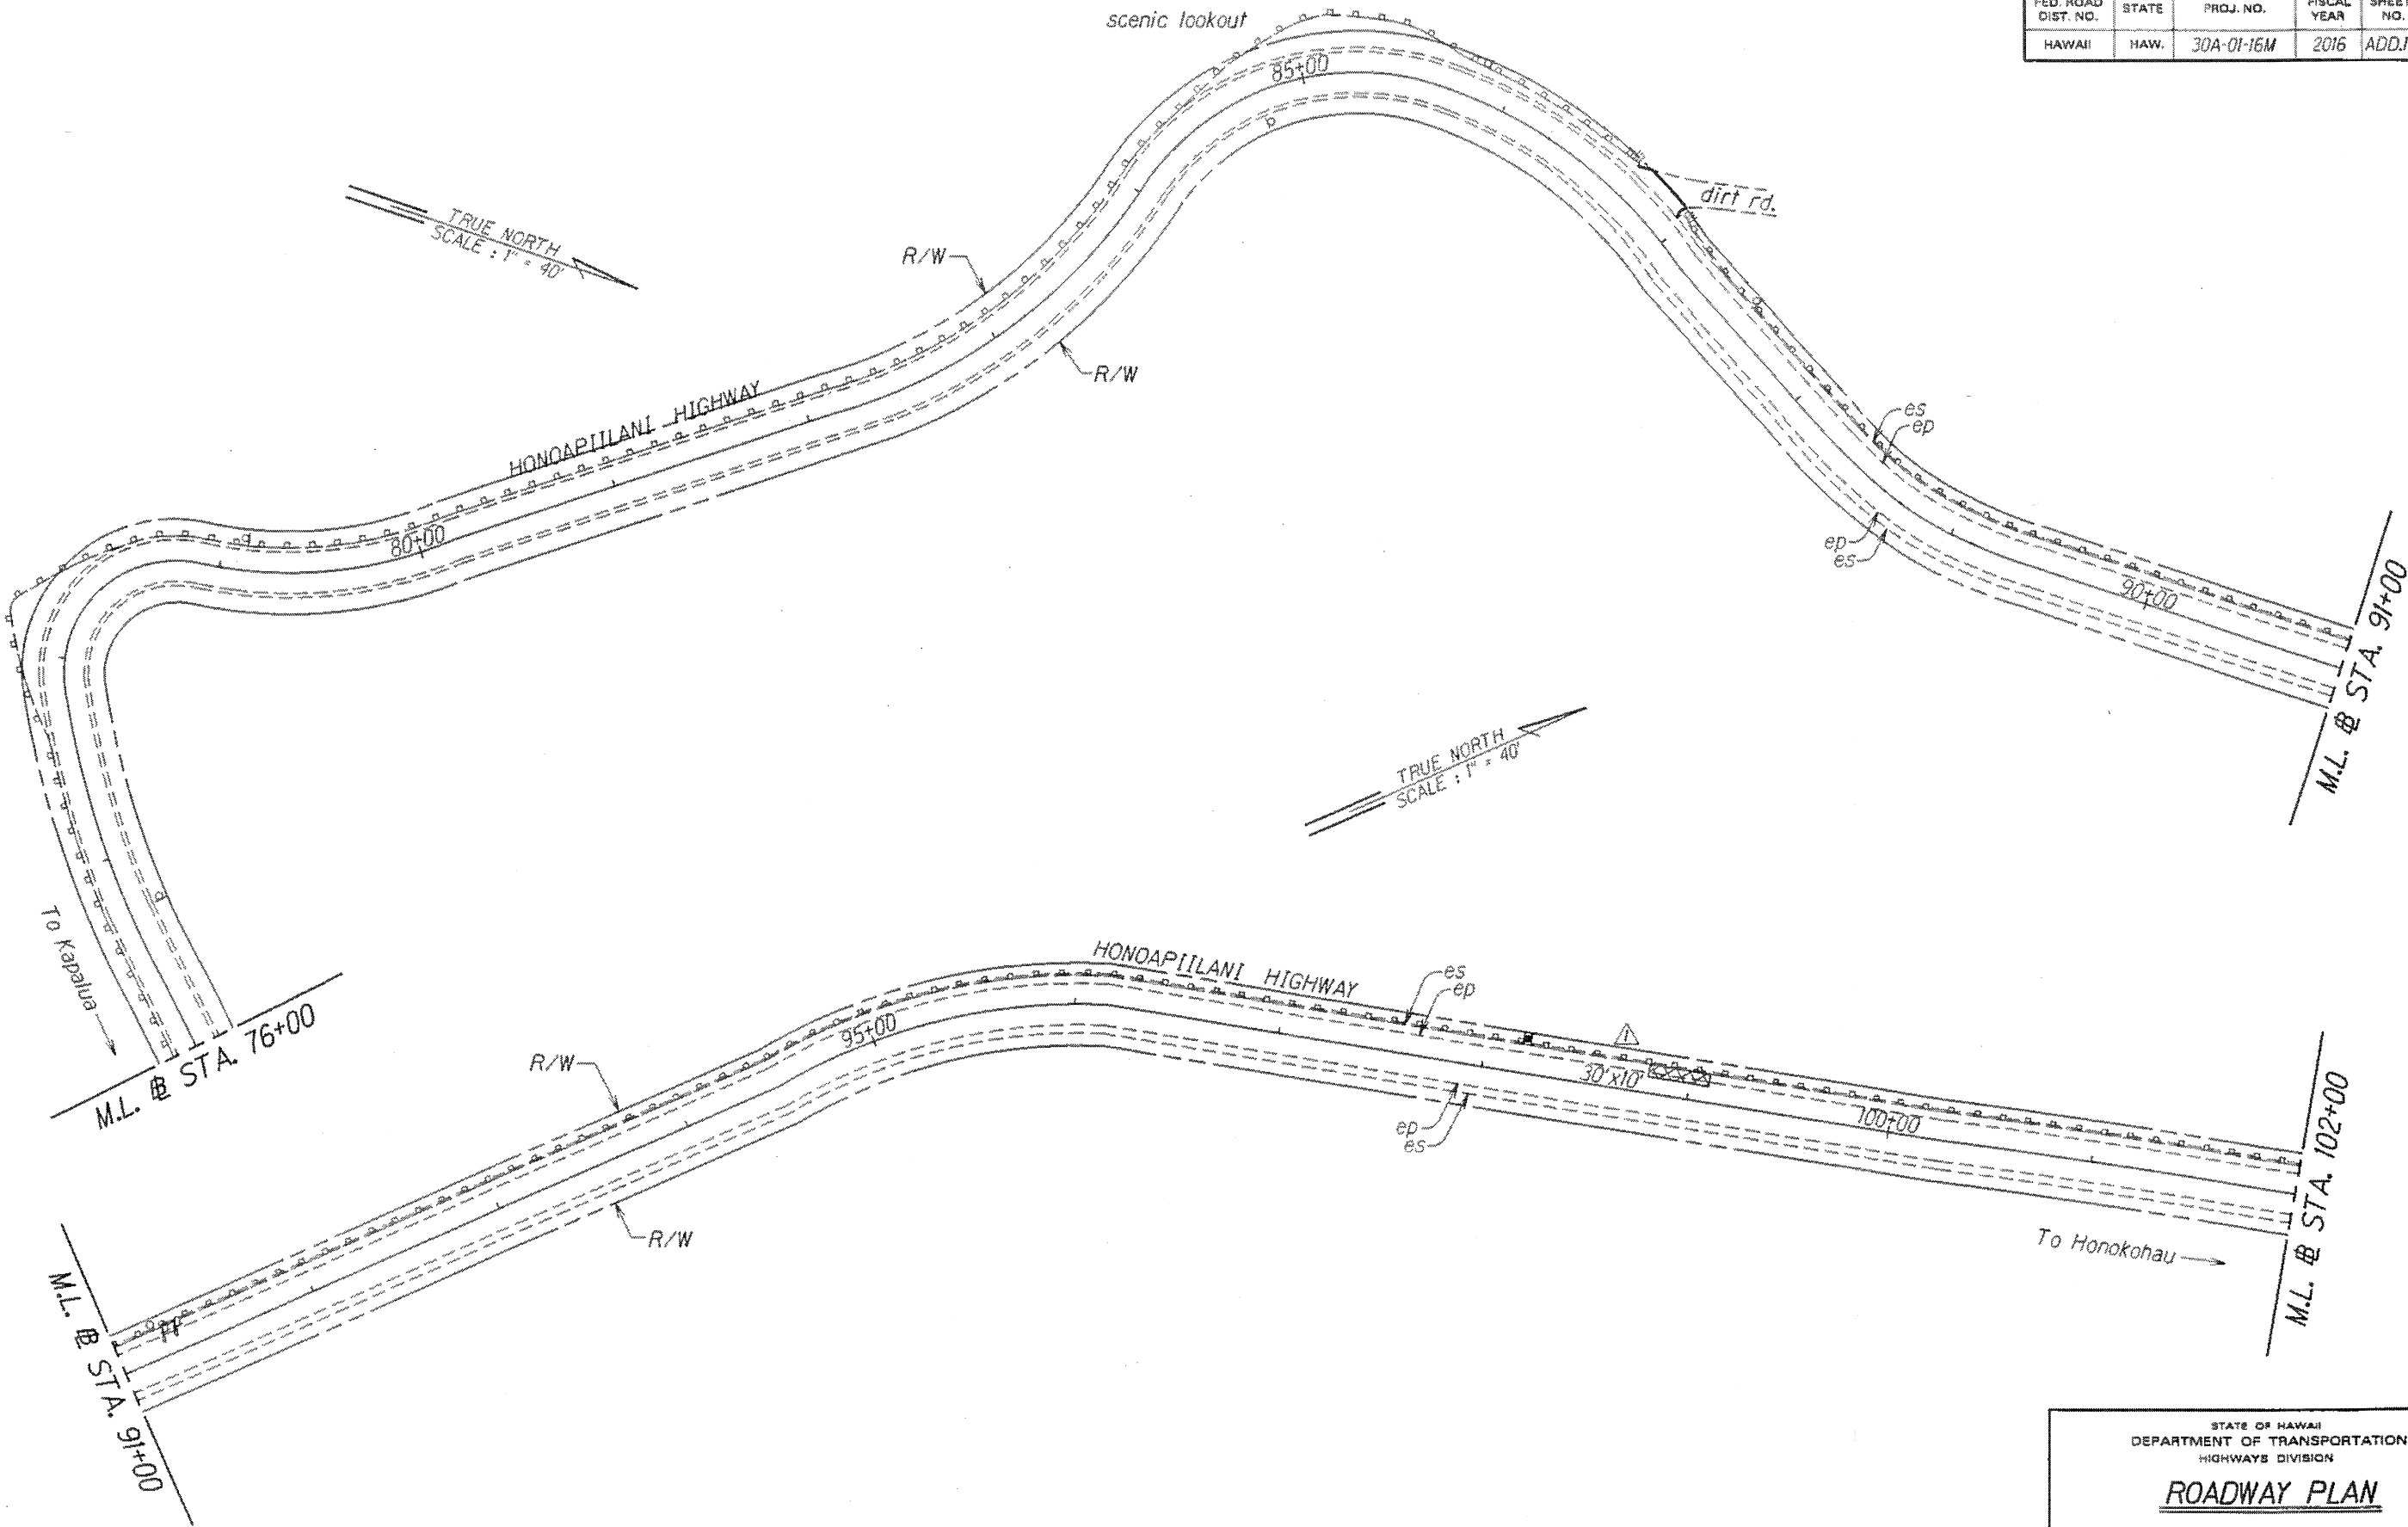

SURVEY PLOTTED BY	DATE
DRAWN BY	11/20
DESIGNED BY	
CHECKED BY	
ORIGINAL PLAN	
NOTE BOOK	
REVISION	

△ 2-23-16 Reconstruction Area.

DATE	REVISION
------	----------

STATE OF HAWAII
DEPARTMENT OF TRANSPORTATION
HIGHWAYS DIVISION

ROADWAY PLAN

HONAPIILANI HIGHWAY RESURFACING
Plantation Estates Golf Course to Honokohau Bridge
Project No. 30A-01-16M

Scale: 1" = 40' Date: August, 2015

SHEET No. 5 OF 12 SHEETS