


FED. ROAD DIST. NO.	STATE	PROJ. NO.	FISCAL YEAR	SHEET NO.	TOTAL SHEETS
HAWAII	HAW.	30A-01-16M	2016	13	38

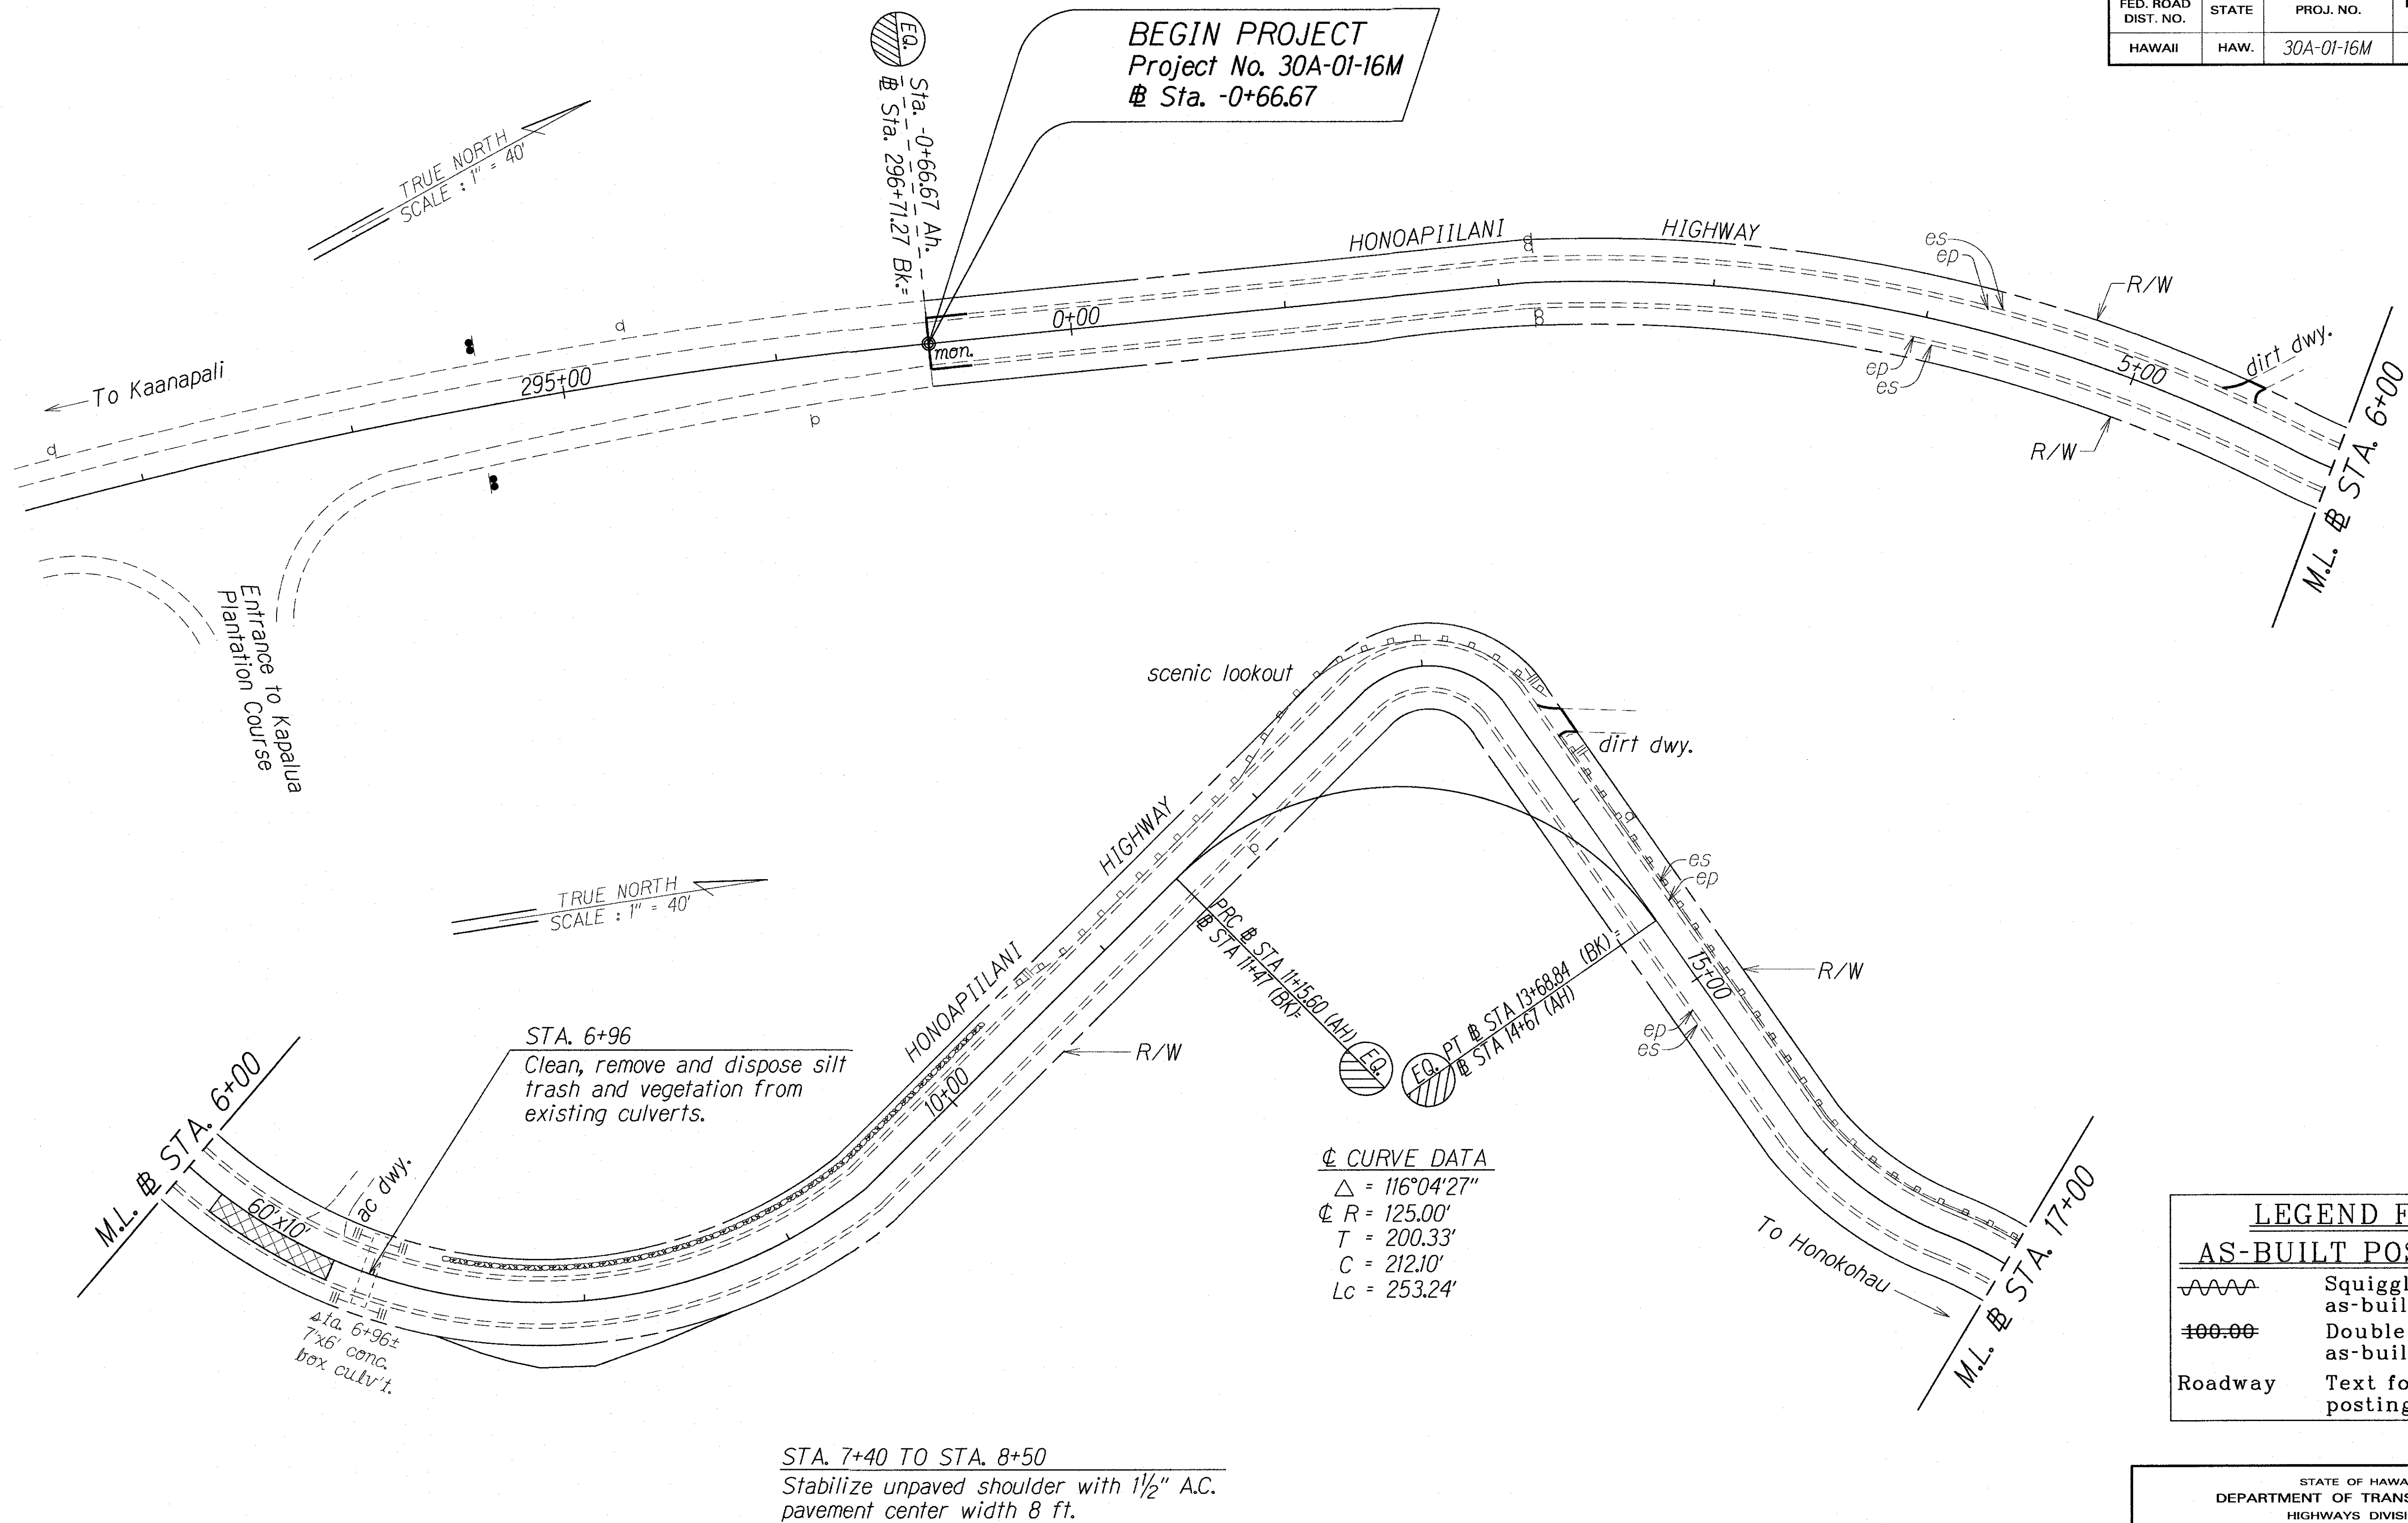

SURVEY PLOTTED BY	DATE
DRAWN BY	11/02
DESIGNED BY	
QUANTITIES BY	
CHECKED BY	
ORIGINAL PLAN	
NOTE BOOK	
MEETING	
NO. 10/10/10	

LEGEND FOR AS-BUILT POSTINGS	
	Squiggly line for as-built deletion
	Double line for as-built deletion
Roadway	Text for as-built posting

STATE OF HAWAII
DEPARTMENT OF TRANSPORTATION
HIGHWAYS DIVISION

ROADWAY PLAN


HONOAPIILANI HIGHWAY RESURFACING
Plantation Estates Golf Course to Honokohau Bridge
Project No. 30A-01-16M

Scale: 1" = 40' Date: August, 2015

SHEET No. 1 OF 12 SHEETS

"AS-BUILT"

FED. ROAD DIST. NO.	STATE	PROJ. NO.	FISCAL YEAR	SHEET NO.	TOTAL SHEETS
HAWAII	HAW.	30A-01-16M	2016	14	38

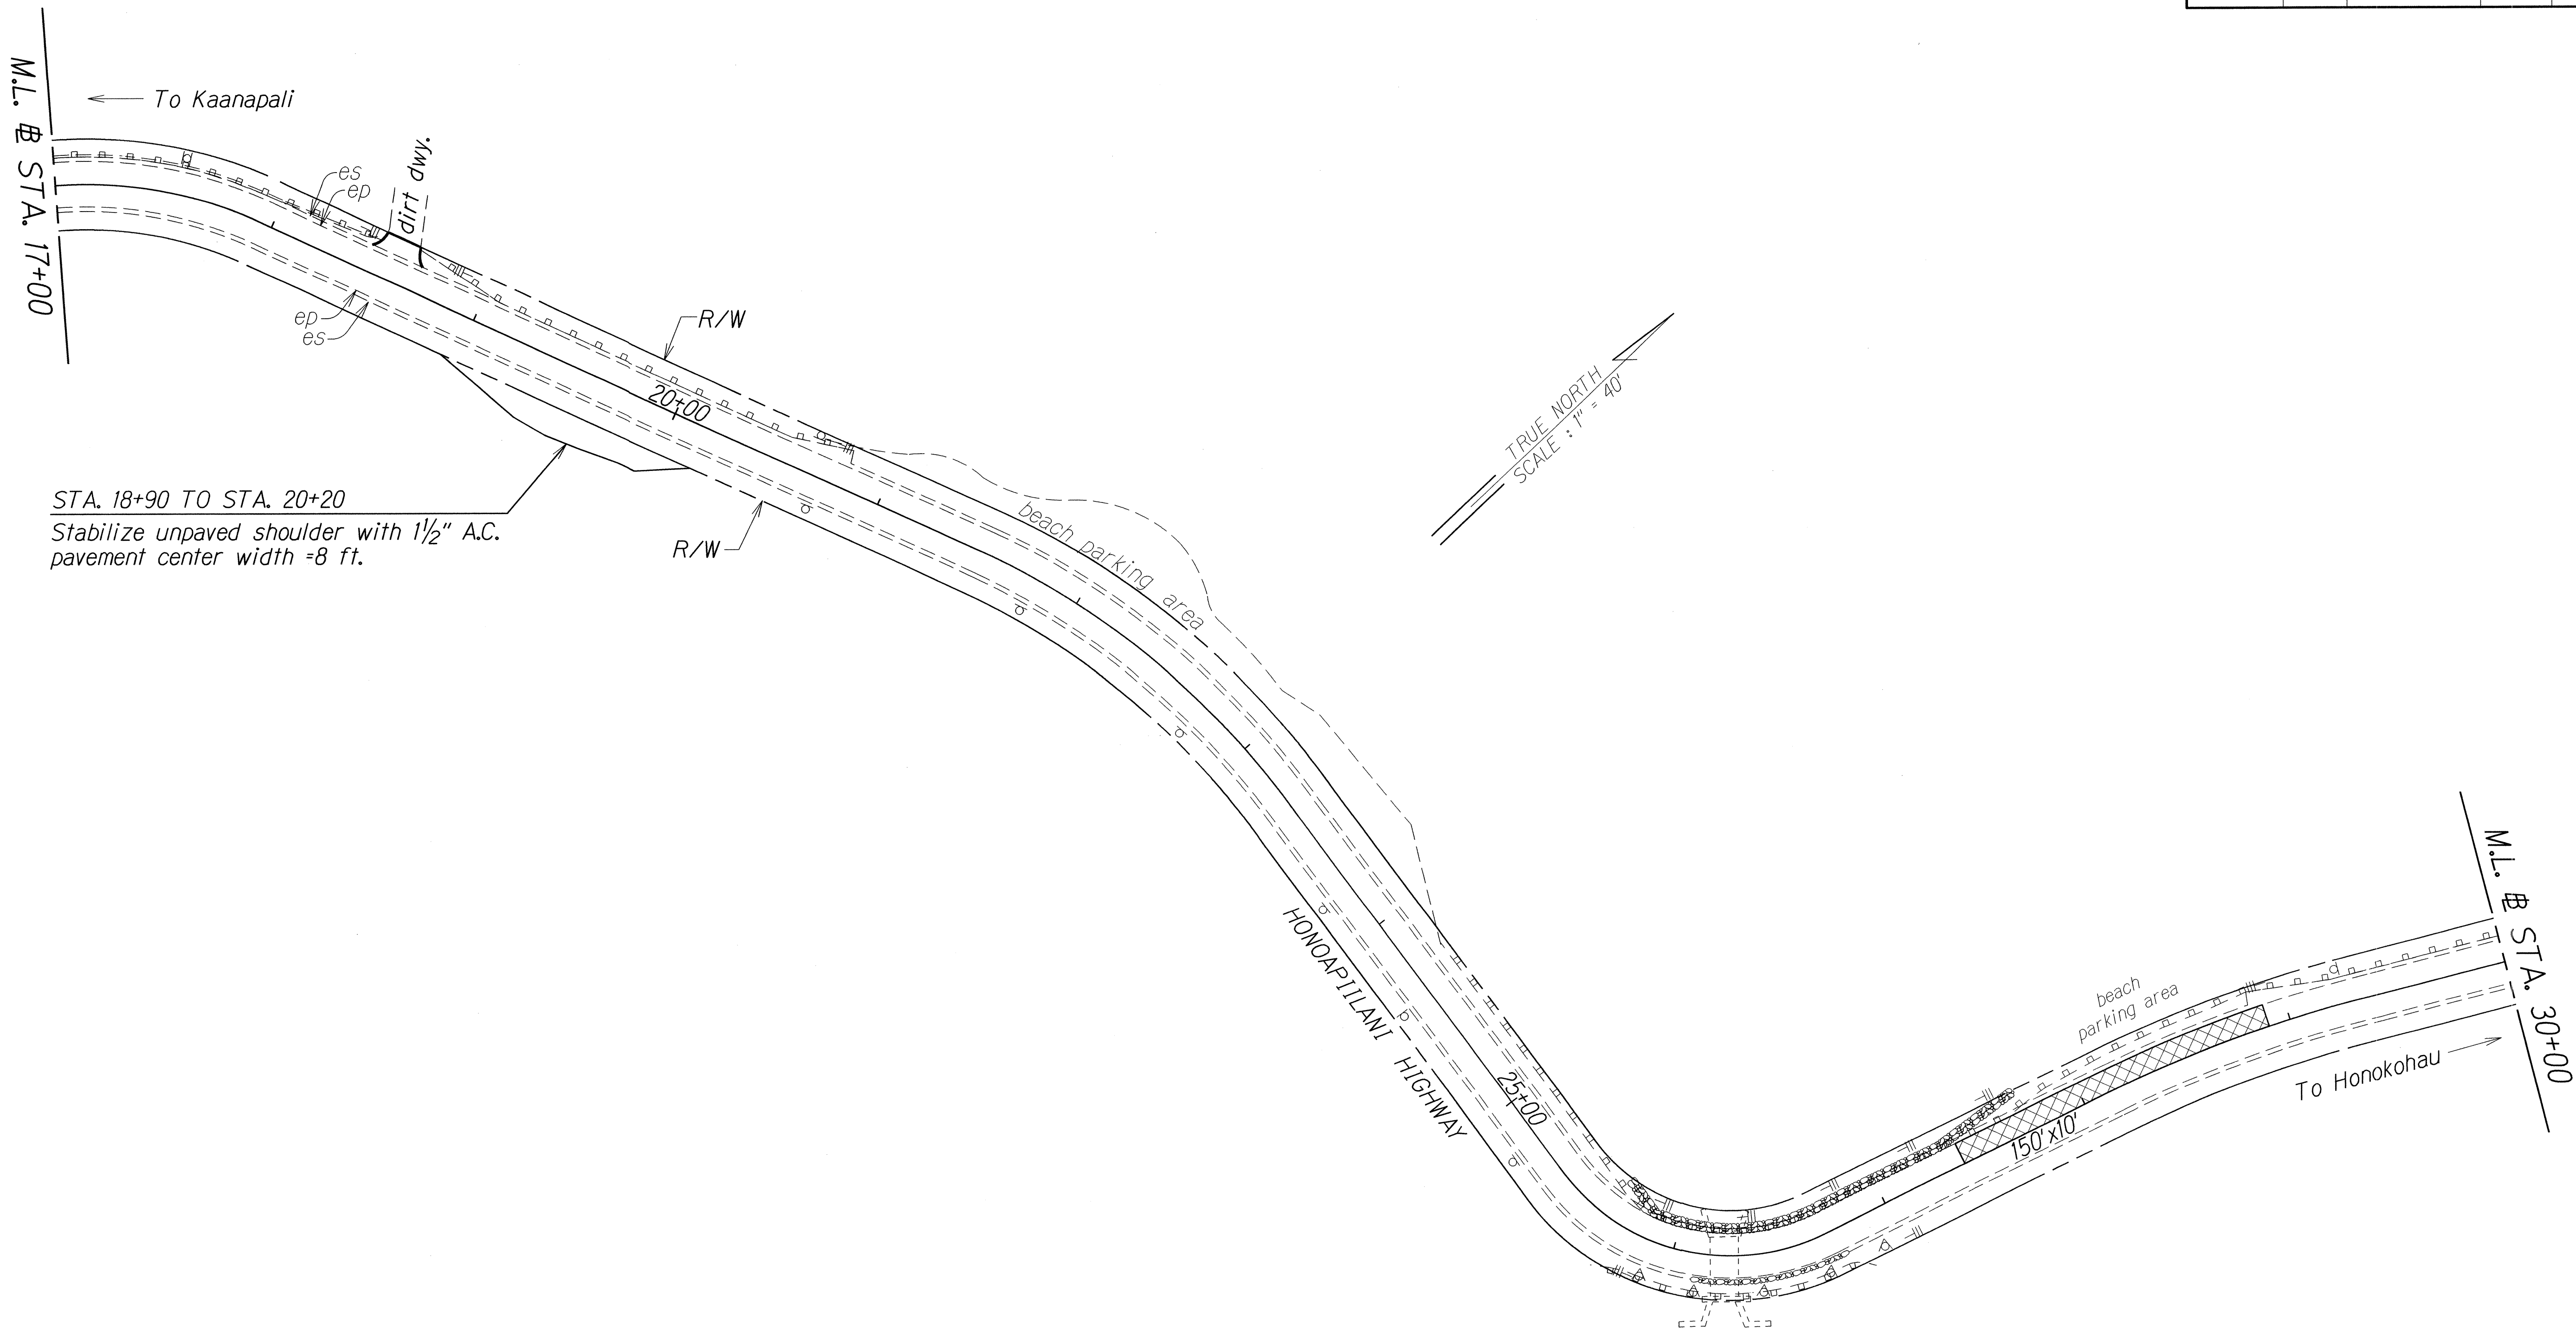


ORIGINAL PLAN	SURVEY PLOTTED BY	DATE
NOTE BOOK	DRAWN BY	1/1/02
me/lay	DESIGNED BY	
SA/rom/cdgn	QUANTITIES BY	
	CHECKED BY	

STATE OF HAWAII
DEPARTMENT OF TRANSPORTATION
HIGHWAYS DIVISION

ROADWAY PLAN
HONOAPIʻILANI HIGHWAY RESURFACING
Plantation Estates Golf Course to Honokohau Bridge
Project No. 30A-01-16M
Scale: 1" = 40' Date: August, 2015

SHEET No. 2 OF 12 SHEETS

FED. ROAD DIST. NO.	STATE	PROJ. NO.	FISCAL YEAR	SHEET NO.	TOTAL SHEETS
HAWAII	HAW.	30A-01-16M	2016	15	38

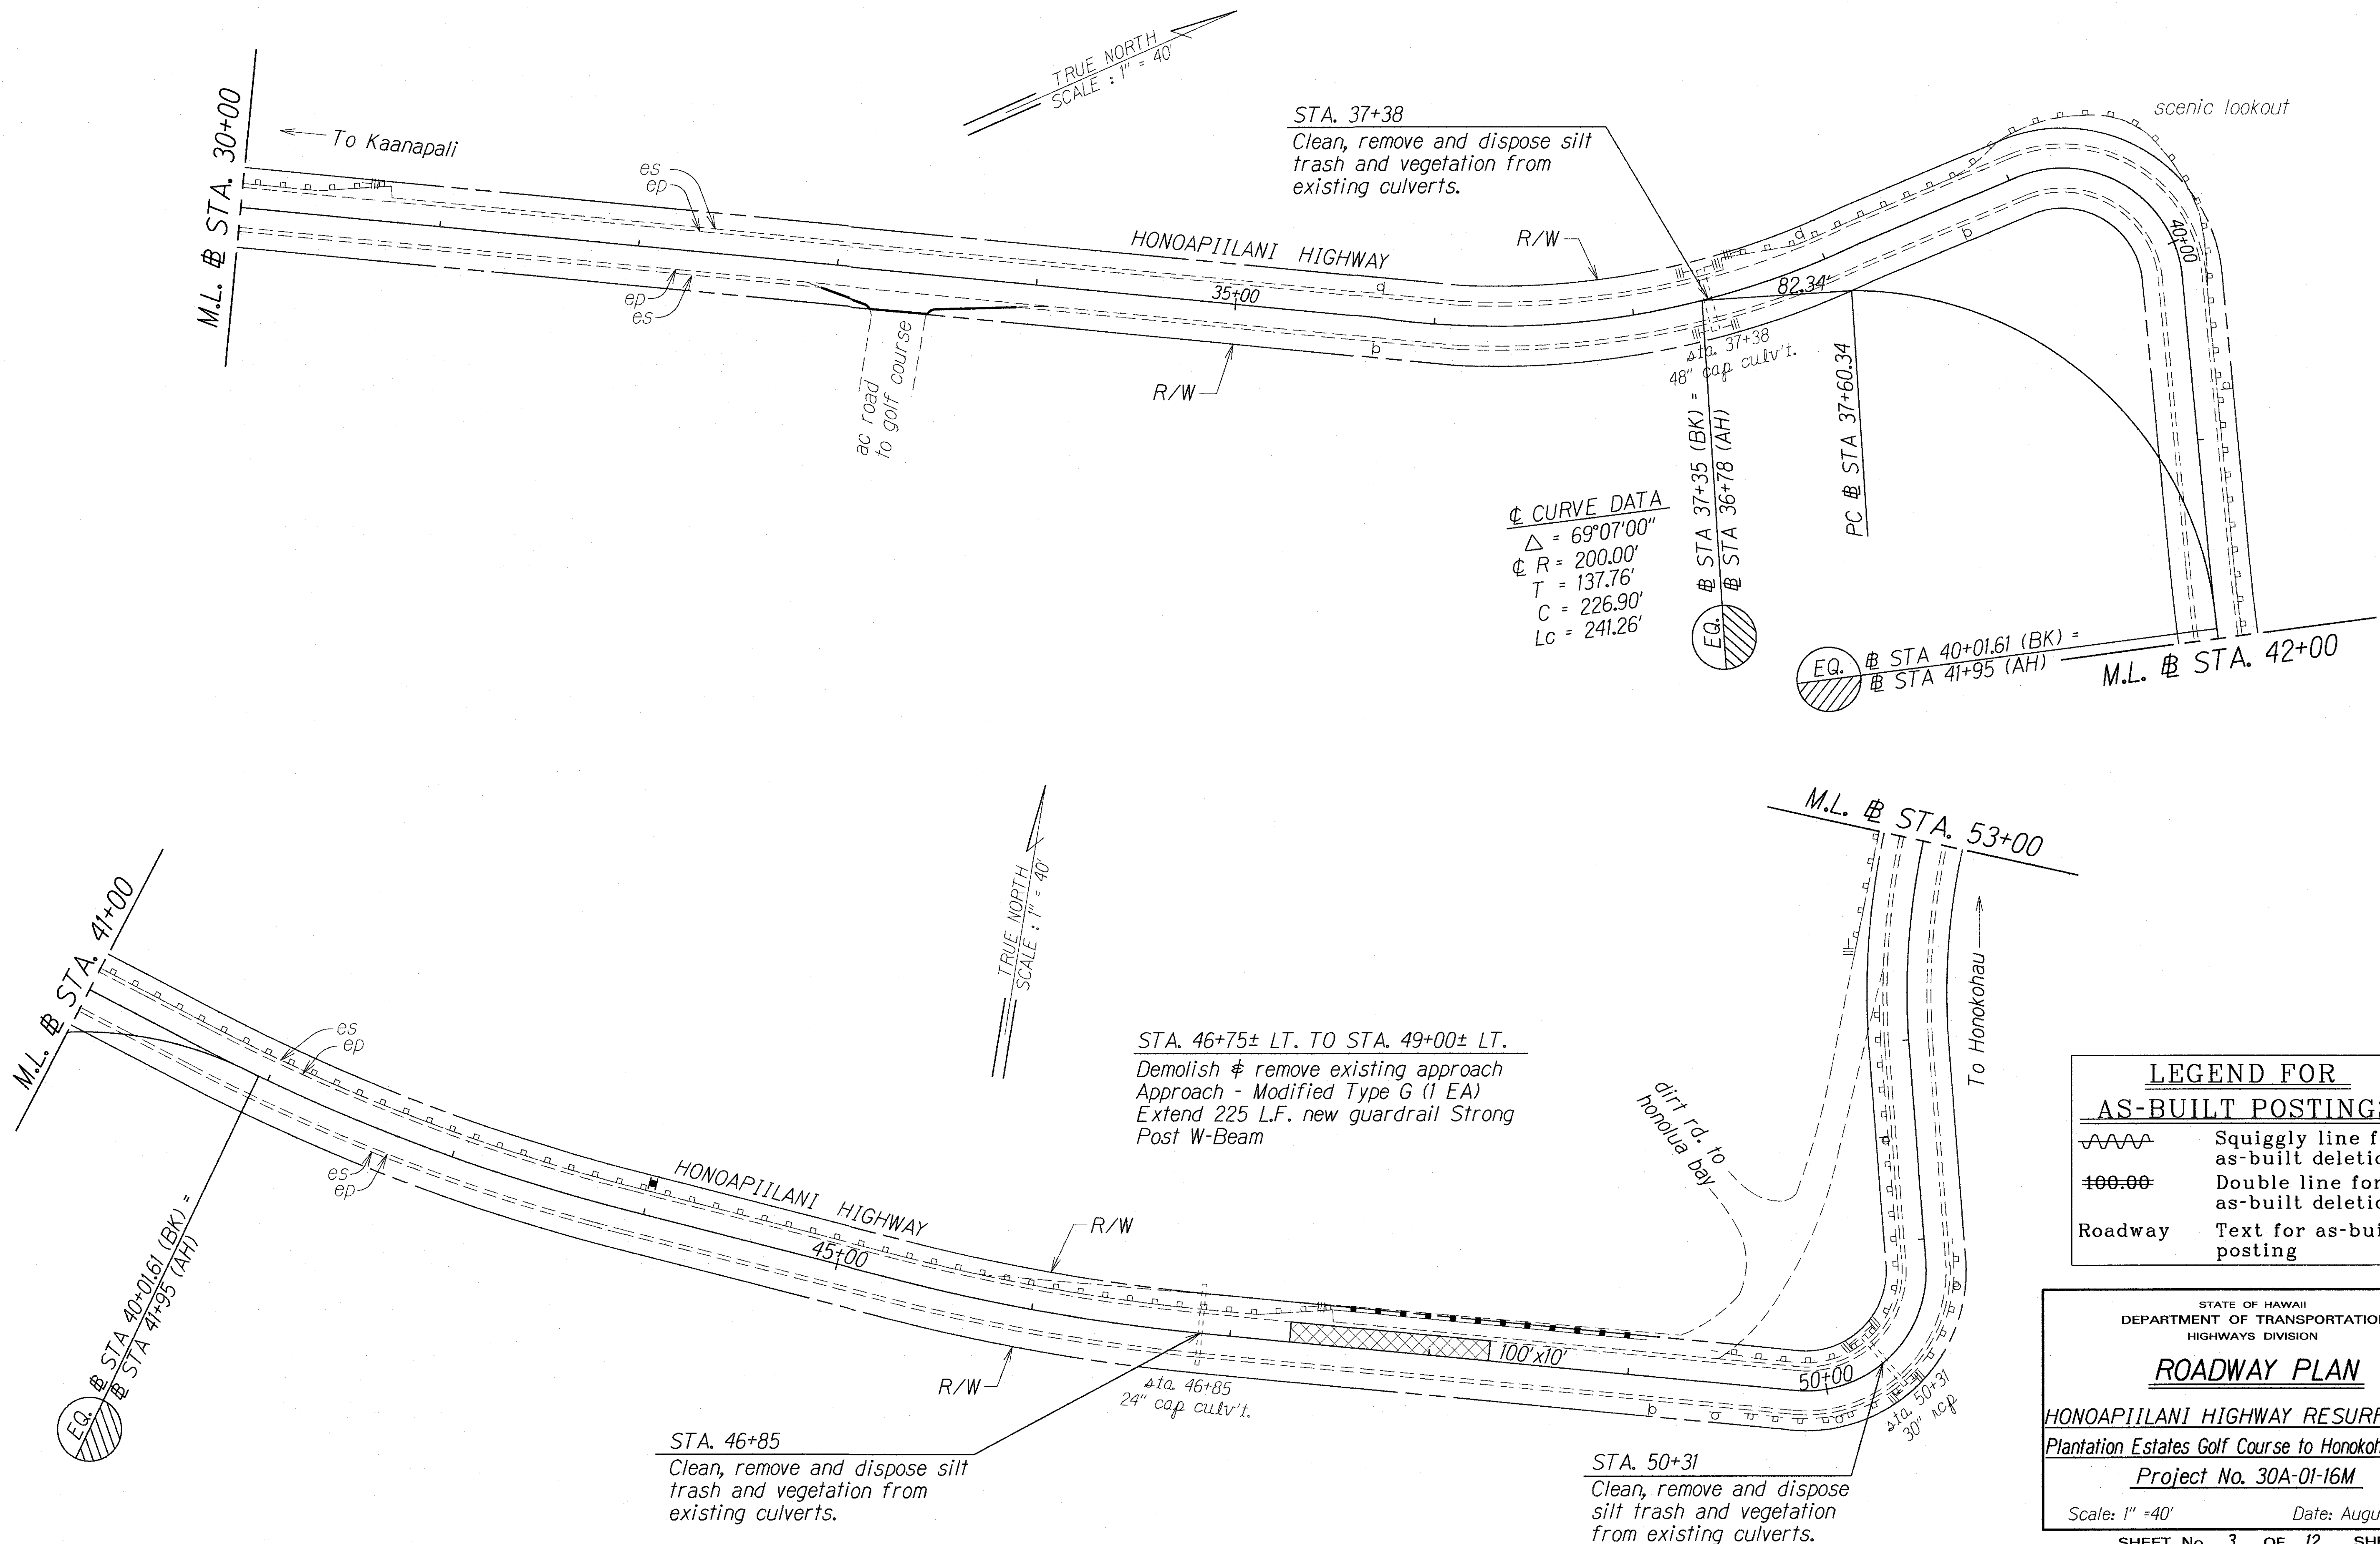

SURVEY PLOTTED BY	DATE
DRAWN BY	11/02
DESIGNED BY	
QUANTITIES BY	
CHECKED BY	

LEGEND FOR AS-BUILT POSTINGS	
	Squiggly line for as-built deletion
	Double line for as-built deletion
Roadway	Text for as-built posting

STATE OF HAWAII
DEPARTMENT OF TRANSPORTATION
HIGHWAYS DIVISION

ROADWAY PLAN


HONOAPIILANI HIGHWAY RESURFACING
Plantation Estates Golf Course to Honokohau Bridge
Project No. 30A-01-16M

Scale: 1" = 40' Date: August, 2015

SHEET No. 3 OF 12 SHEETS

"AS-BUILT"

FED. ROAD DIST. NO.	STATE	PROJ. NO.	FISCAL YEAR	SHEET NO.	TOTAL SHEETS
HAWAII	HAW.	30A-01-16M	2016	16	38

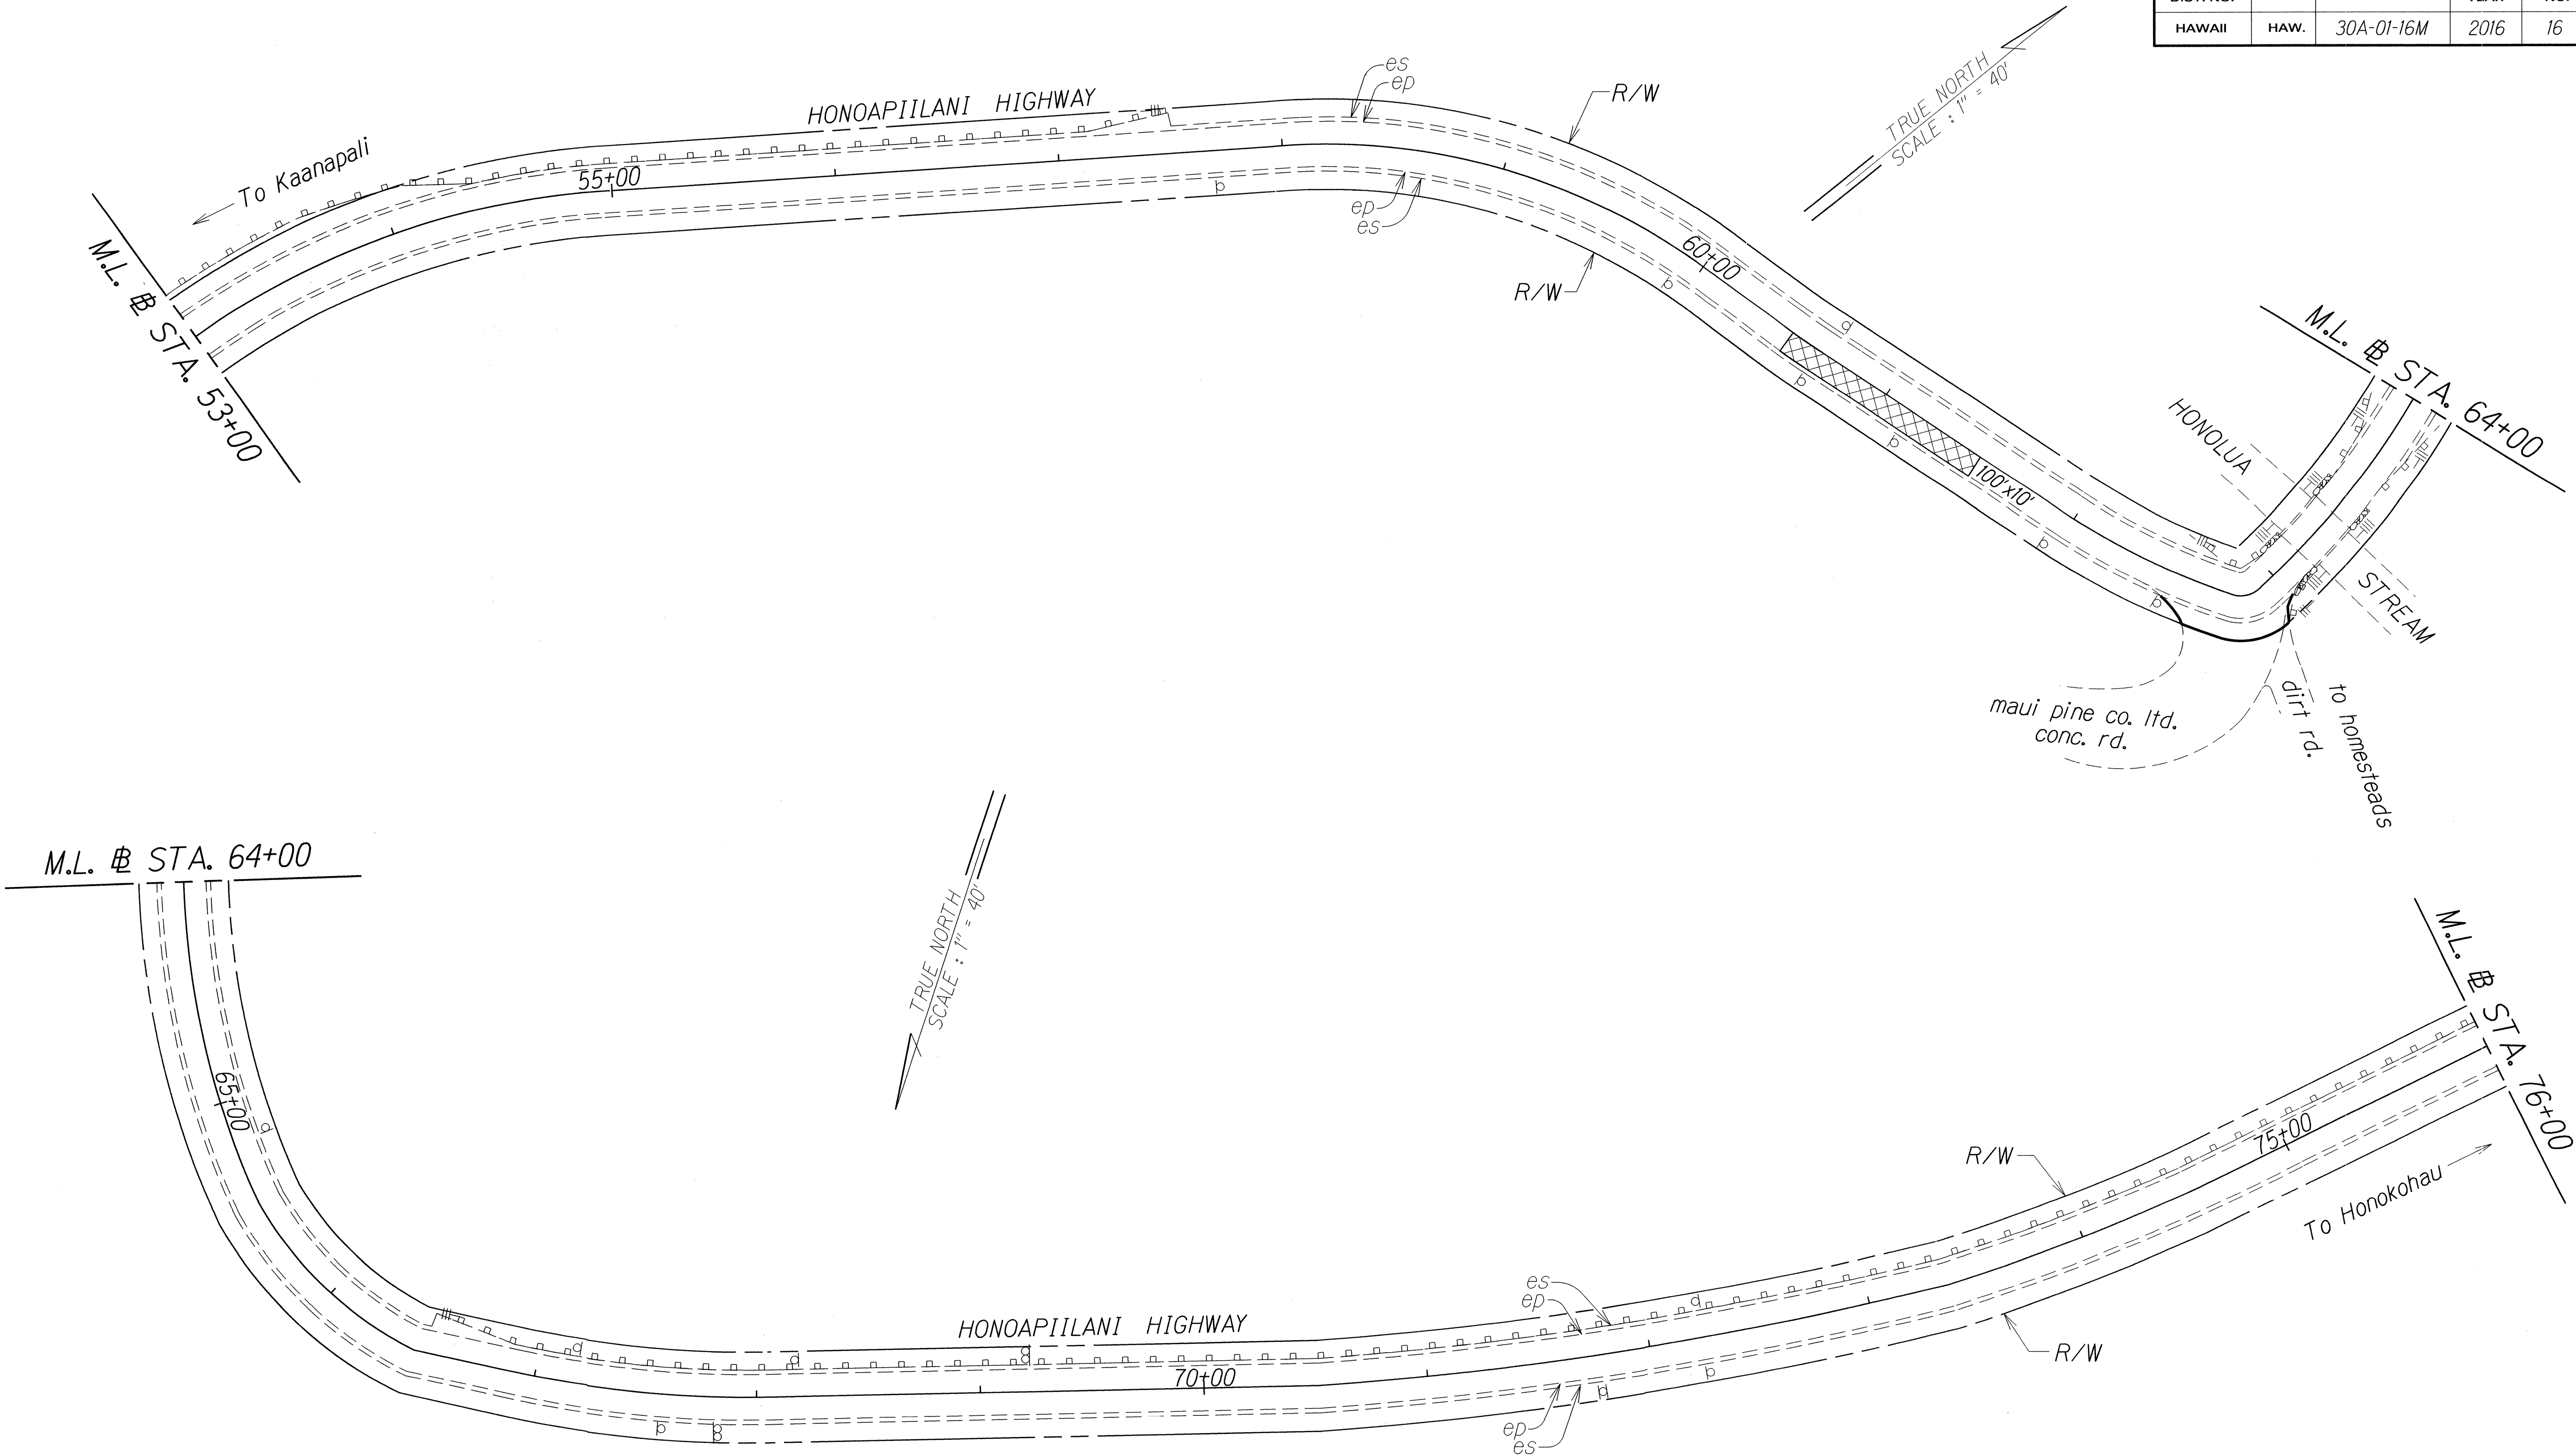

ORIGINAL PLAN	SURVEY PLOTTED BY	DATE
NOTE BOOK	DRAWN BY	11/02
QUANTITIES BY	DESIGNED BY	
CHECKED BY	NOTED BY	


STATE OF HAWAII
DEPARTMENT OF TRANSPORTATION
HIGHWAYS DIVISION

ROADWAY PLAN

HONOAPIILANI HIGHWAY RESURFACING
Plantation Estates Golf Course to Honokohau Bridge
Project No. 30A-01-16M

Scale: 1" = 40' Date: August, 2015

FED. ROAD DIST. NO.	STATE	PROJ. NO.	FISCAL YEAR	SHEET NO.	TOTAL SHEETS
HAWAII	HAW.	30A-01-16M	2016	ADD.17	38

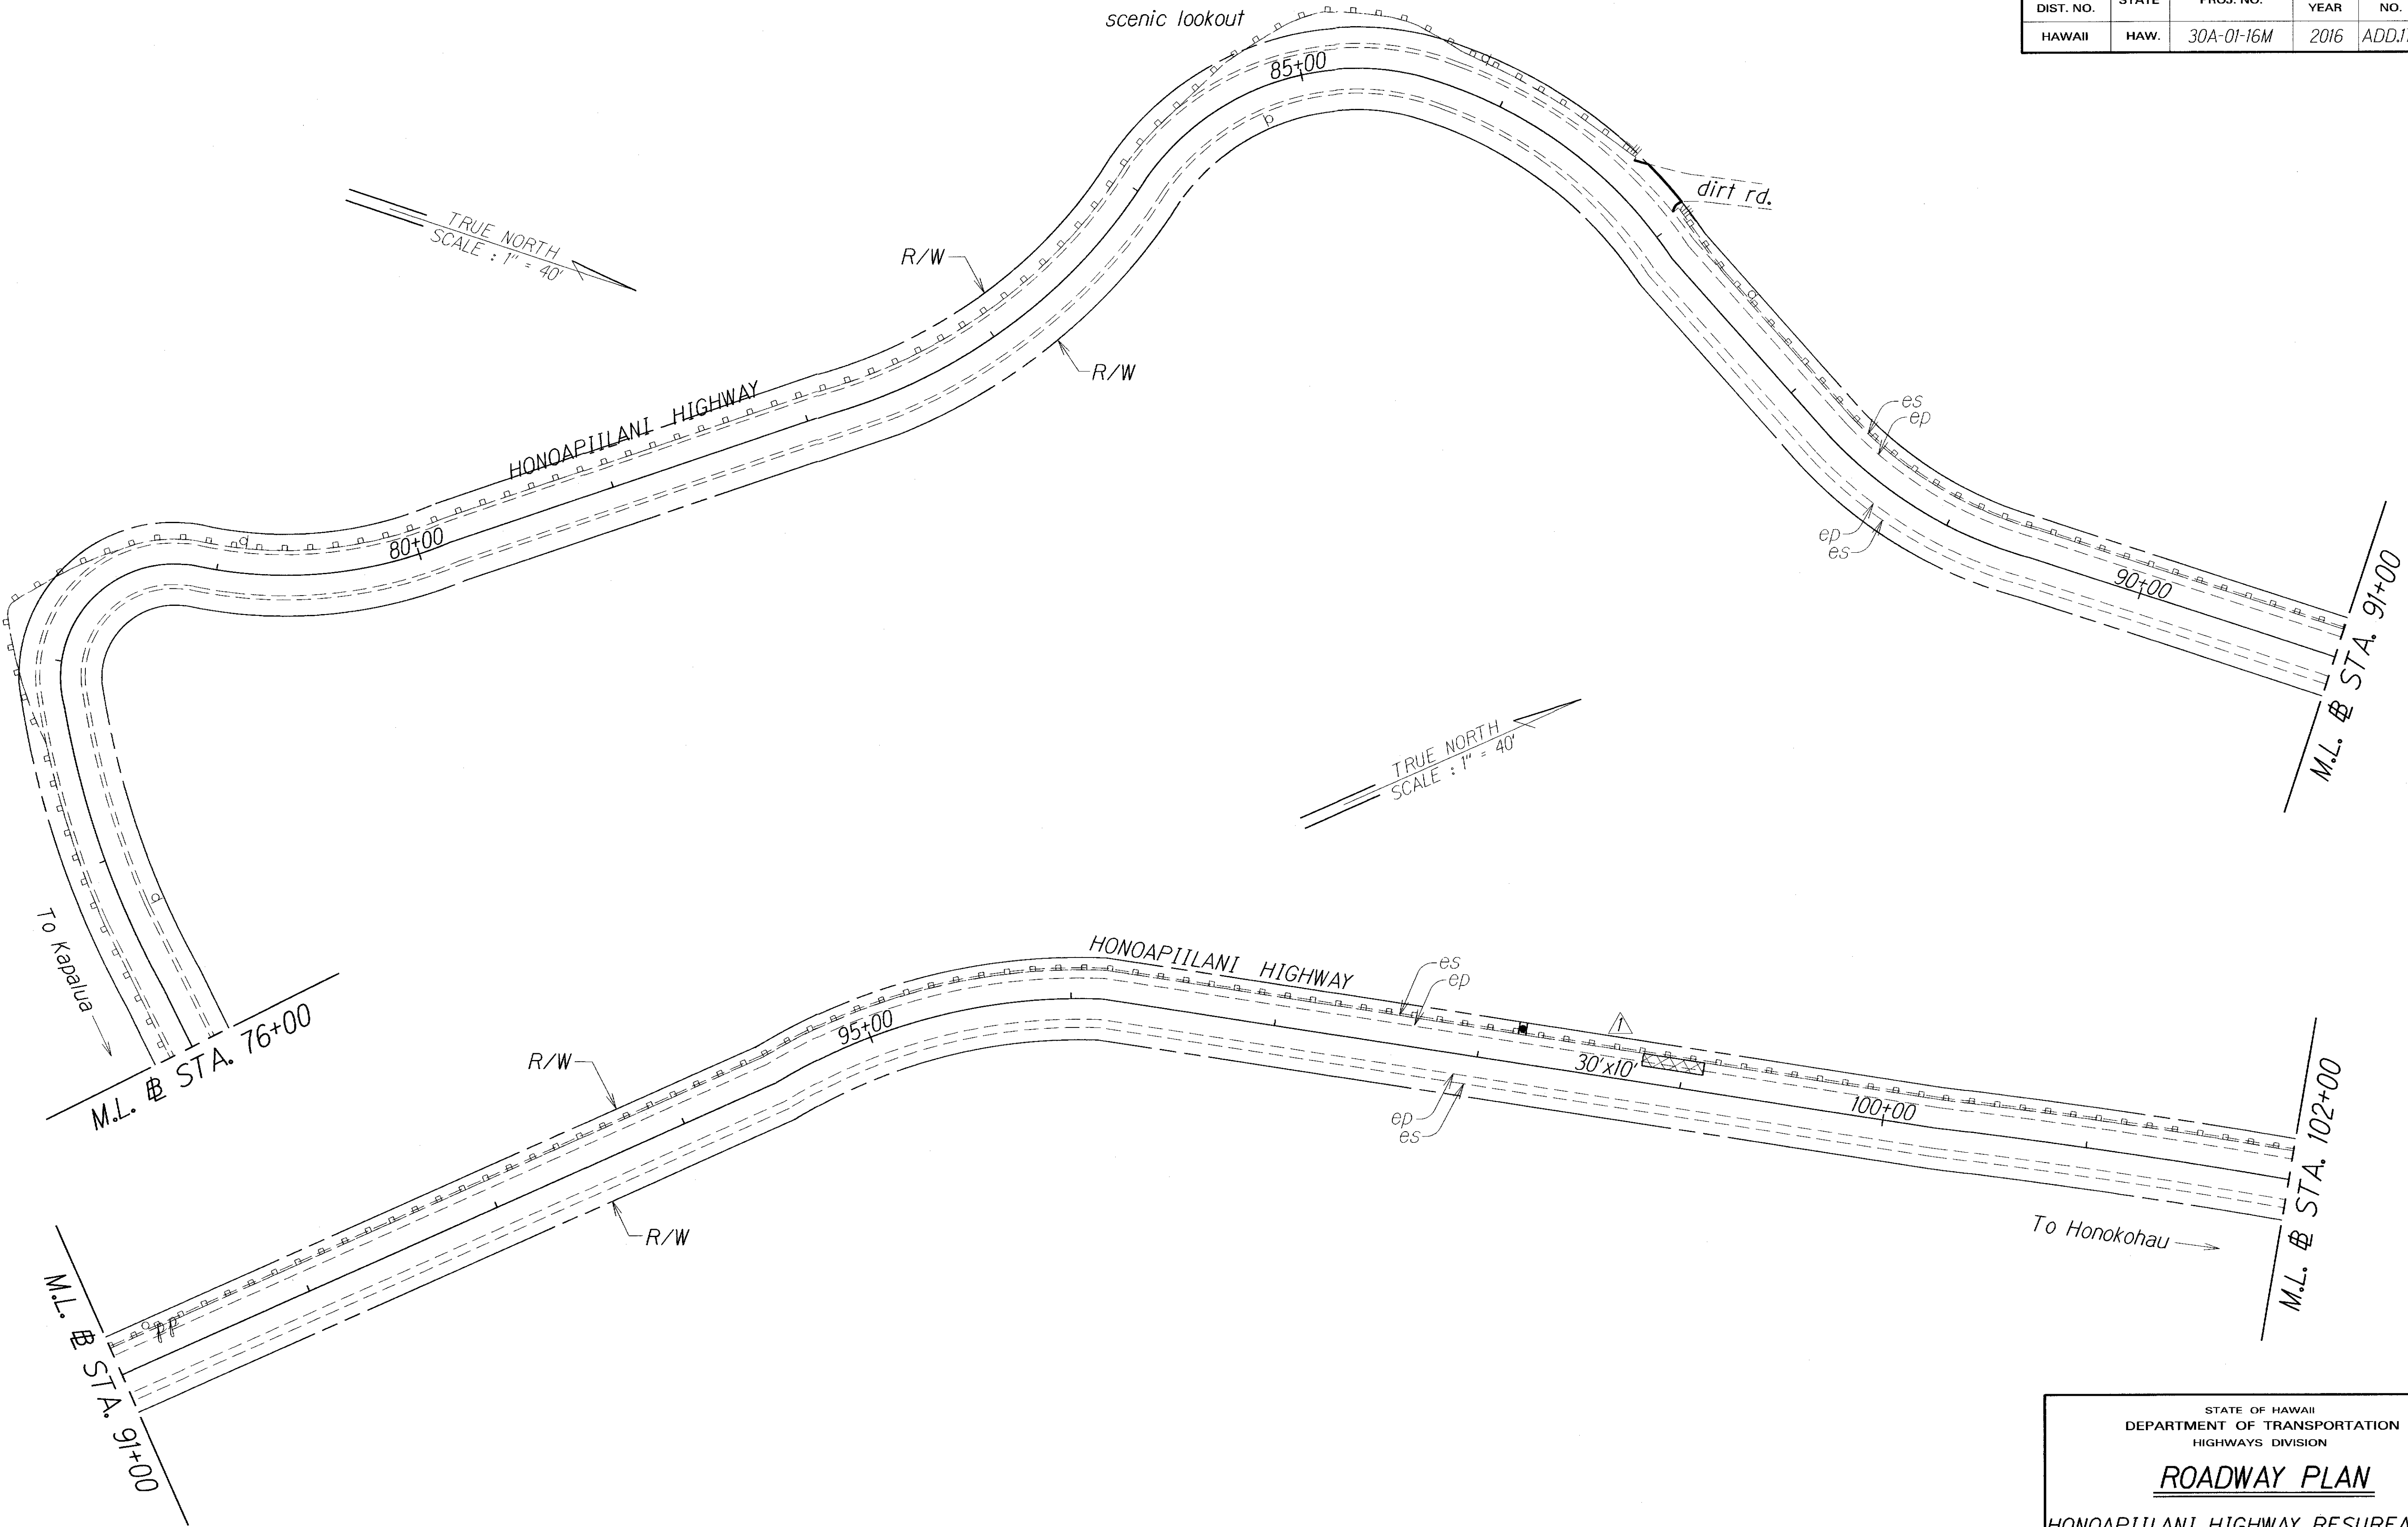

ORIGINAL	SURVEY PLOTTED BY	DATE
PLAN	DRAWN BY	
NOTE BOOK	TRACED BY	
	DESIGNED BY	
	QUANTITIES BY	
	CHECKED BY	

2-23-16 Reconstruction Area.


DATE REVISION

STATE OF HAWAII
DEPARTMENT OF TRANSPORTATION
HIGHWAYS DIVISION

ROADWAY PLAN
HONOAPIILANI HIGHWAY RESURFACING
Plantation Estates Golf Course to Honokohau Bridge
Project No. 30A-01-16M
Scale: 1" = 40' Date: August, 2015

SHEET No. 5 OF 12 SHEETS

FED. ROAD DIST. NO.	STATE	PROJ. NO.	FISCAL YEAR	SHEET NO.	TOTAL SHEETS
HAWAII	HAW.	30A-01-16M	2016	18	38

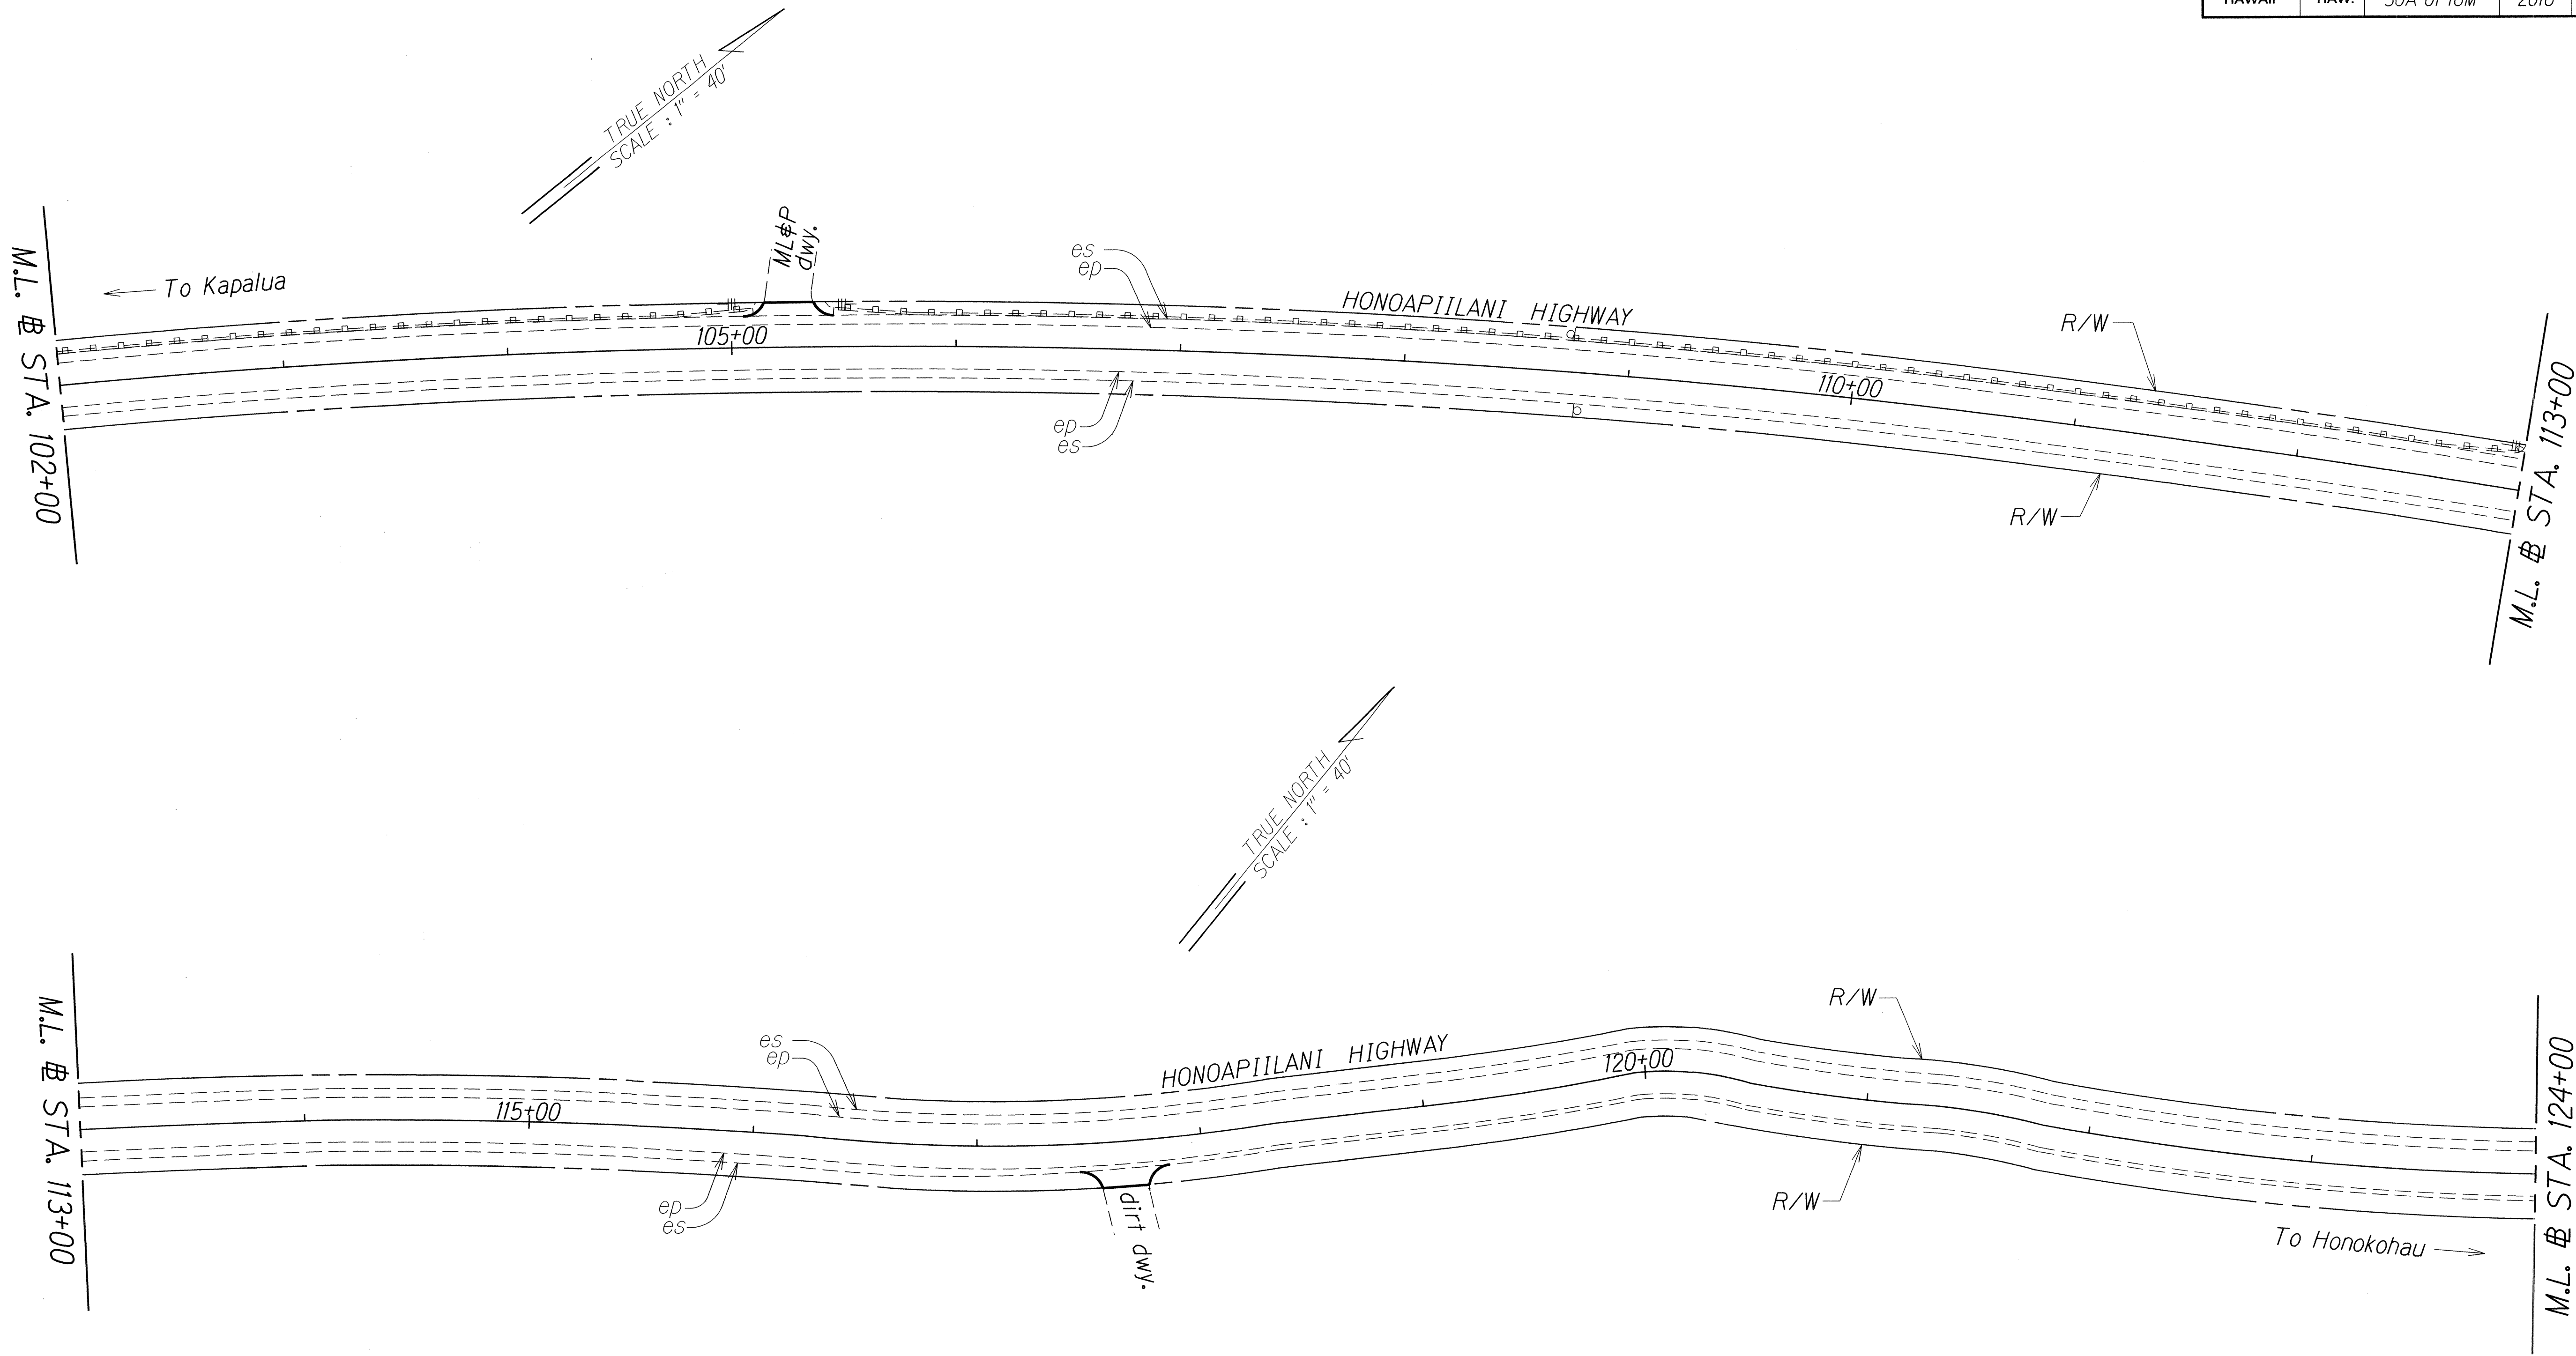

ORIGINAL PLAN	SURVEY PLOTTED BY	DATE
NOTE BOOK	DRAWN BY	11/02
DESIGNED BY	CHECKED BY	
QUANTITIES BY		
CHECKED BY		

STATE OF HAWAII
DEPARTMENT OF TRANSPORTATION
HIGHWAYS DIVISION

ROADWAY PLAN

HONOAPIILANI HIGHWAY RESURFACING
Plantation Estates Golf Course to Honokohau Bridge
Project No. 30A-01-16M


Scale: 1" = 40' Date: August, 2015

FED. ROAD DIST. NO.	STATE	PROJ. NO.	FISCAL YEAR	SHEET NO.	TOTAL SHEETS
HAWAII	HAW.	30A-01-16M	2016	19	38

STA. 126+32.5± LT. TO STA. 128+70± LT.

Demolish & remove existing trailing end
Install new Trailing End - Modified Type G (1 EA)
Extend 237.5 L.F. new guardrail Strong
Post W-Beam


STA. 128+70± LT. TO STA. 130+58± LT.
Demolish and remove existing guardrail
Install new guardrail Strong Post W-Beam

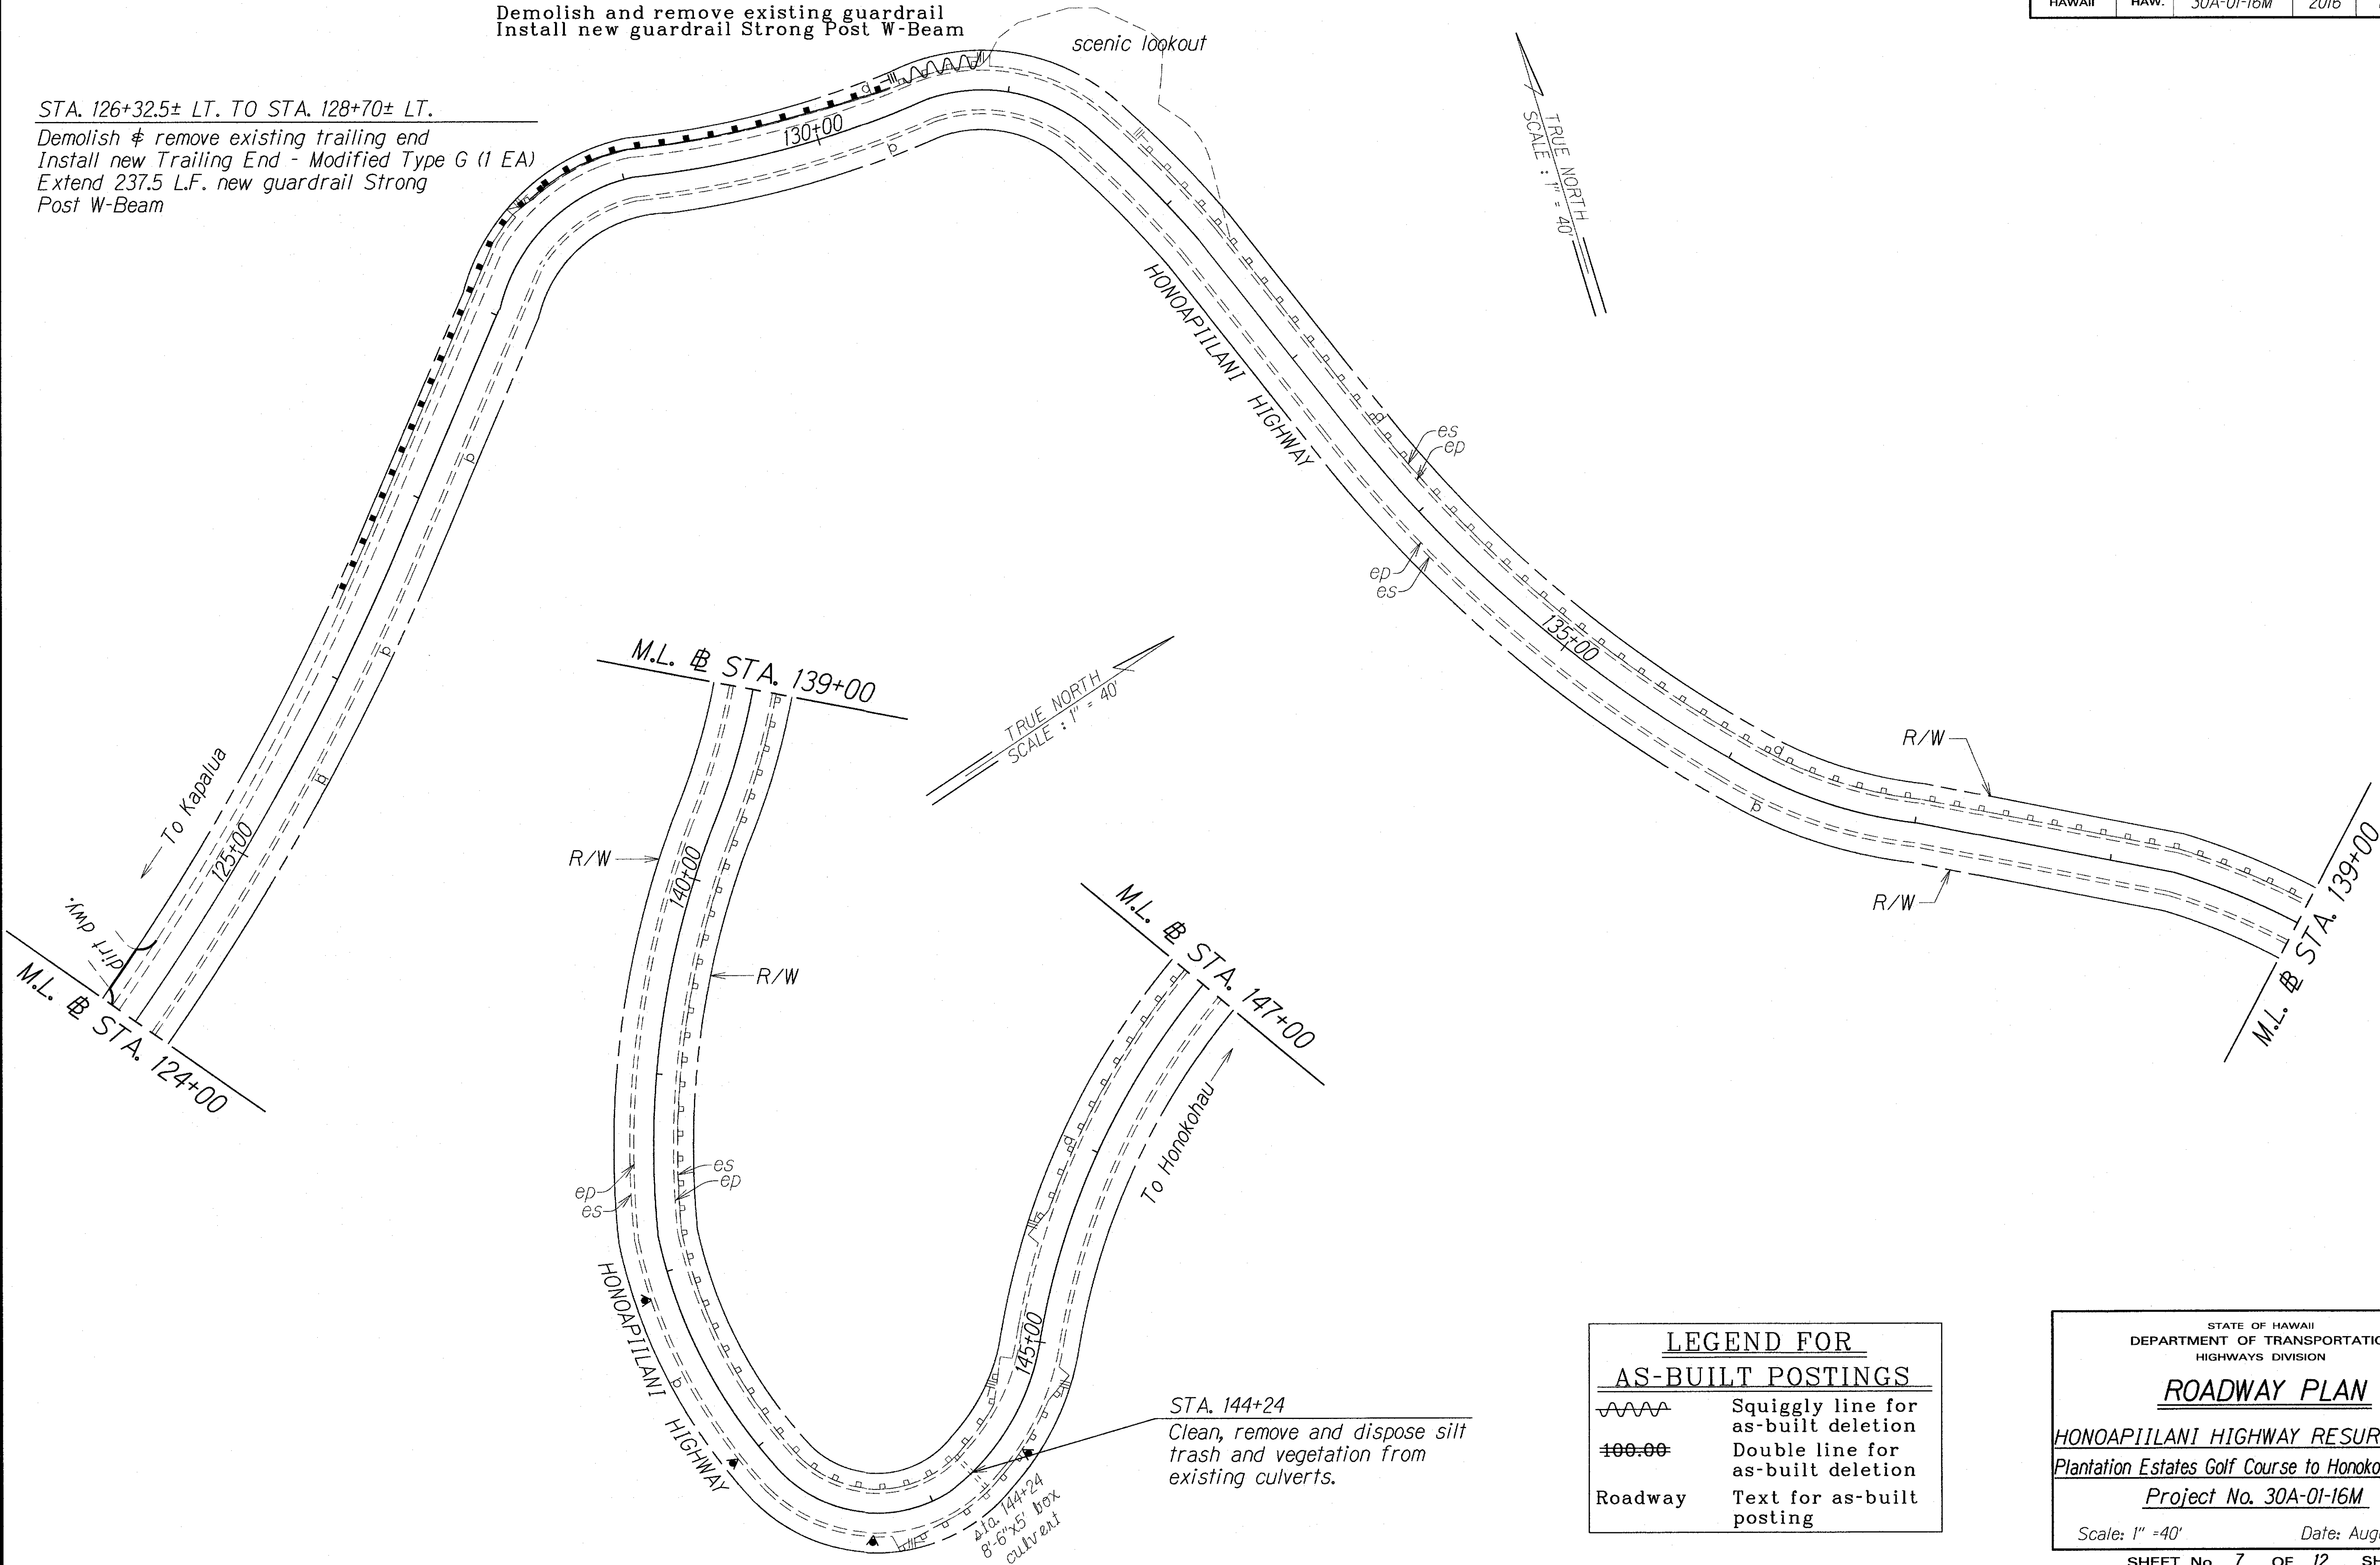



ORIGINAL PLAN	DATE
DRAWN BY	11/02
TRACED BY	
NOTE BOOK	
QUANTITIES BY	
CHECKED BY	

"AS-BUILT"

FED. ROAD DIST. NO.	STATE	PROJ. NO.	FISCAL YEAR	SHEET NO.	TOTAL SHEETS
HAWAII	HAW.	30A-01-16M	2016	20	38

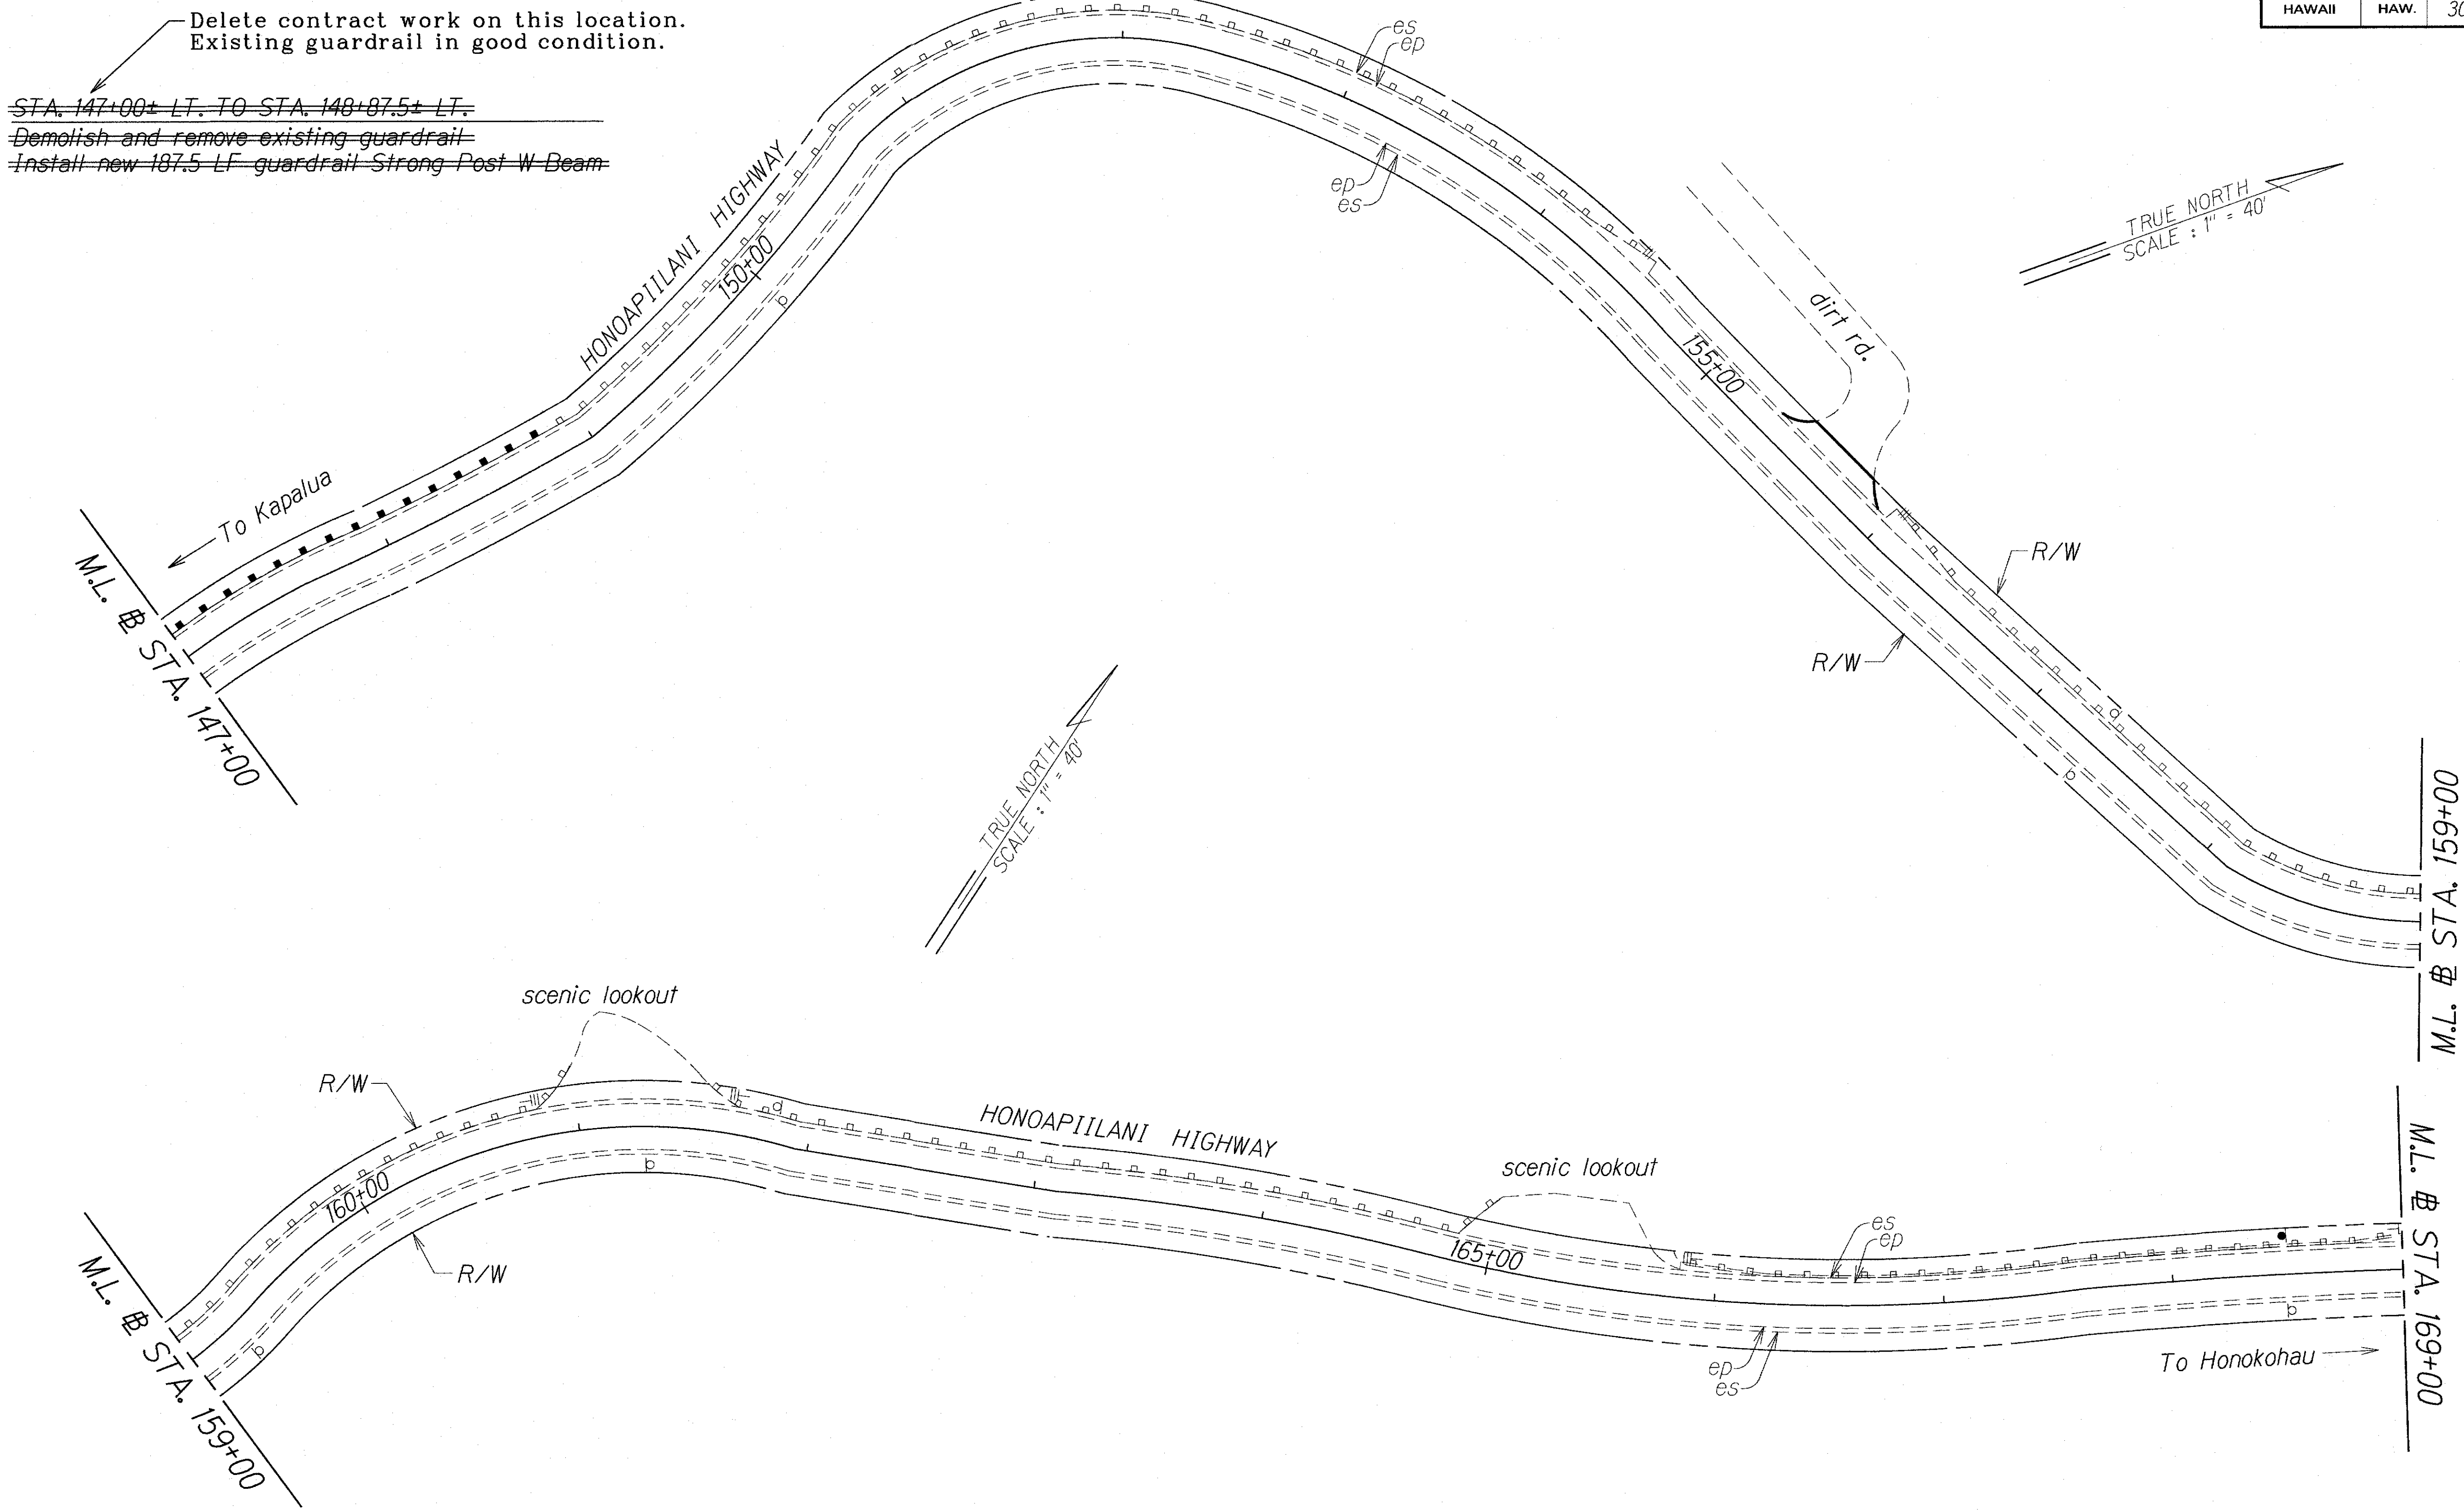

SURVEY PLOTTED BY	DATE
DRAWN BY	11/02
DESIGNED BY	
NOTED BY	
CHECKED BY	
ORIGINAL PLAN	
NOTE BOOK	
DESIGNED BY	
NOTED BY	
CHECKED BY	
DESIGNED BY	
NOTED BY	
CHECKED BY	

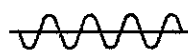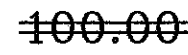
LEGEND FOR AS-BUILT POSTINGS	
	Squiggly line for as-built deletion
	Double line for as-built deletion
Roadway	Text for as-built posting

STATE OF HAWAII
DEPARTMENT OF TRANSPORTATION
HIGHWAYS DIVISION

ROADWAY PLAN
HONOAPIILANI HIGHWAY RESURFACING
Plantation Estates Golf Course to Honokohau Bridge
Project No. 30A-01-16M
Scale: 1" = 40' Date: August, 2015
SHEET No. 8 OF 12 SHEETS

"AS-BUILT"

FED. ROAD DIST. NO.	STATE	PROJ. NO.	FISCAL YEAR	SHEET NO.	TOTAL SHEETS
HAWAII	HAW.	30A-01-16M	2016	21	38

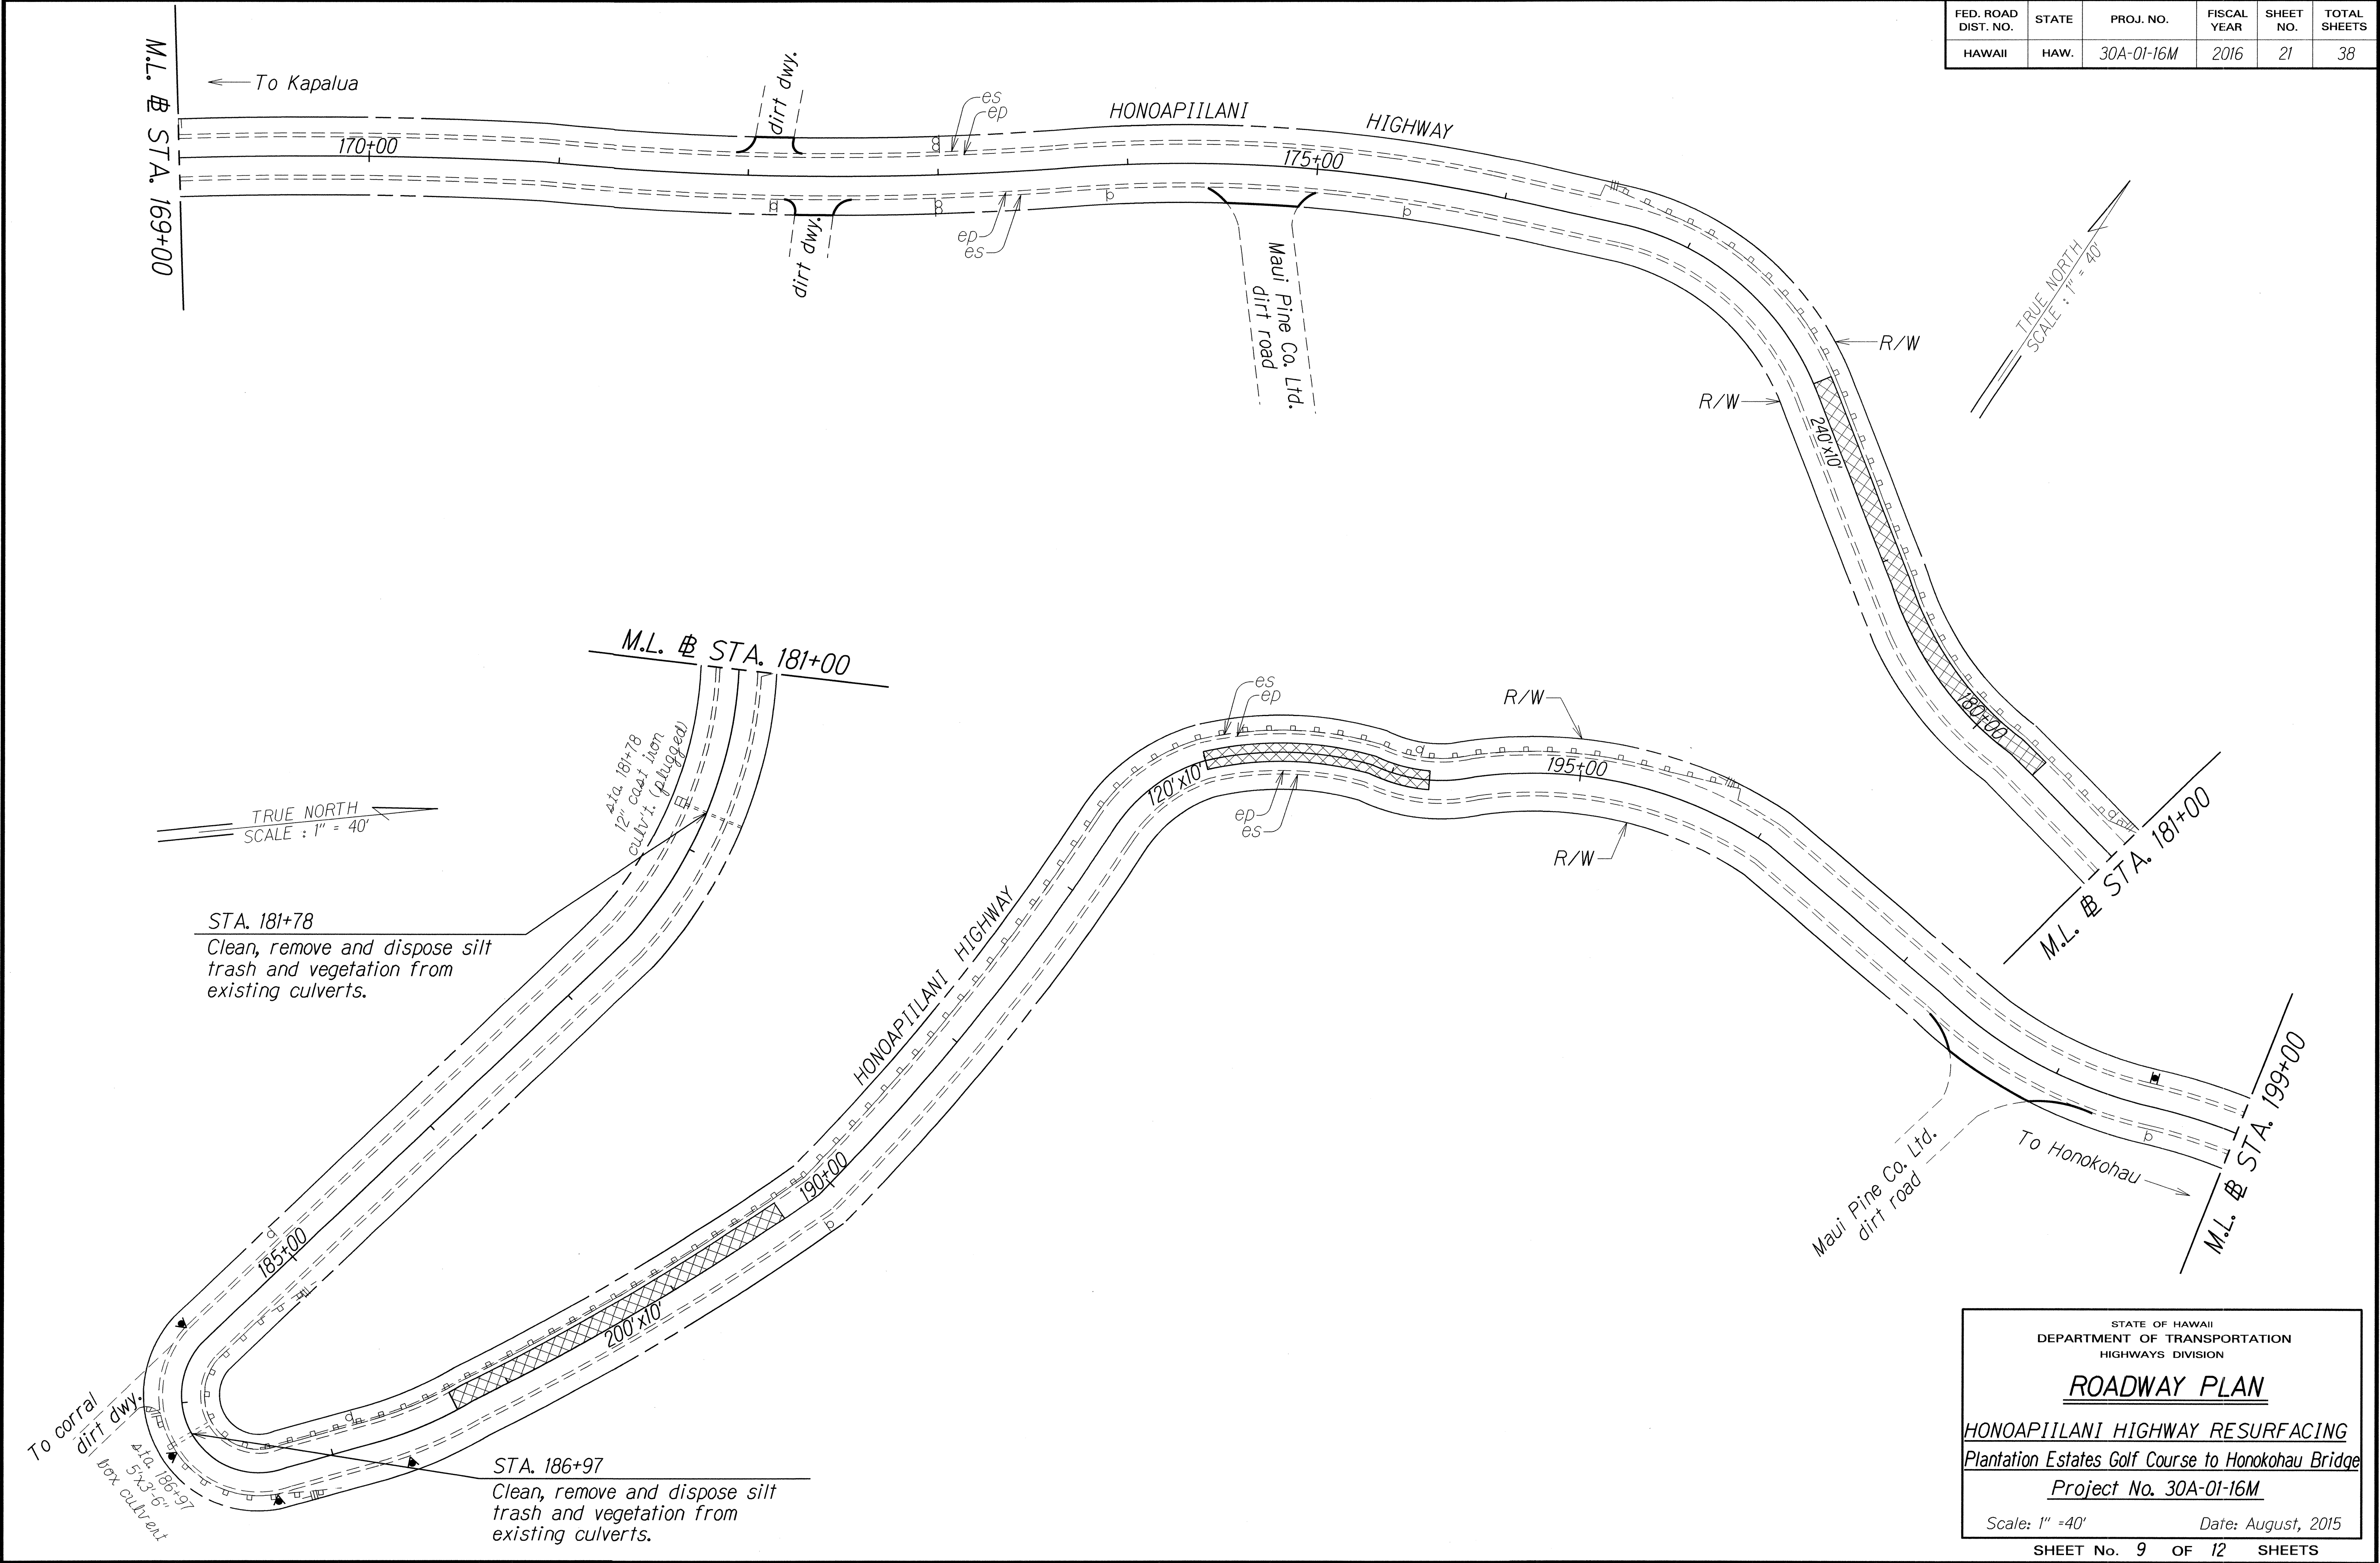

STATE OF HAWAII
DEPARTMENT OF TRANSPORTATION
HIGHWAYS DIVISION

ROADWAY PLAN


HONOAPIILANI HIGHWAY RESURFACING
Plantation Estates Golf Course to Honokohau Bridge
Project No. 30A-01-16M

Scale: 1" = 40' Date: August, 2015

SHEET No. 9 OF 12 SHEETS

ORIGINAL PLAN	DATE
NOTE BOOK	DESIGNED BY
QUANTITIES BY	CHECKED BY

FED. ROAD DIST. NO.	STATE	PROJ. NO.	FISCAL YEAR	SHEET NO.	TOTAL SHEETS
HAWAII	HAW.	30A-01-16M	2016	22	38

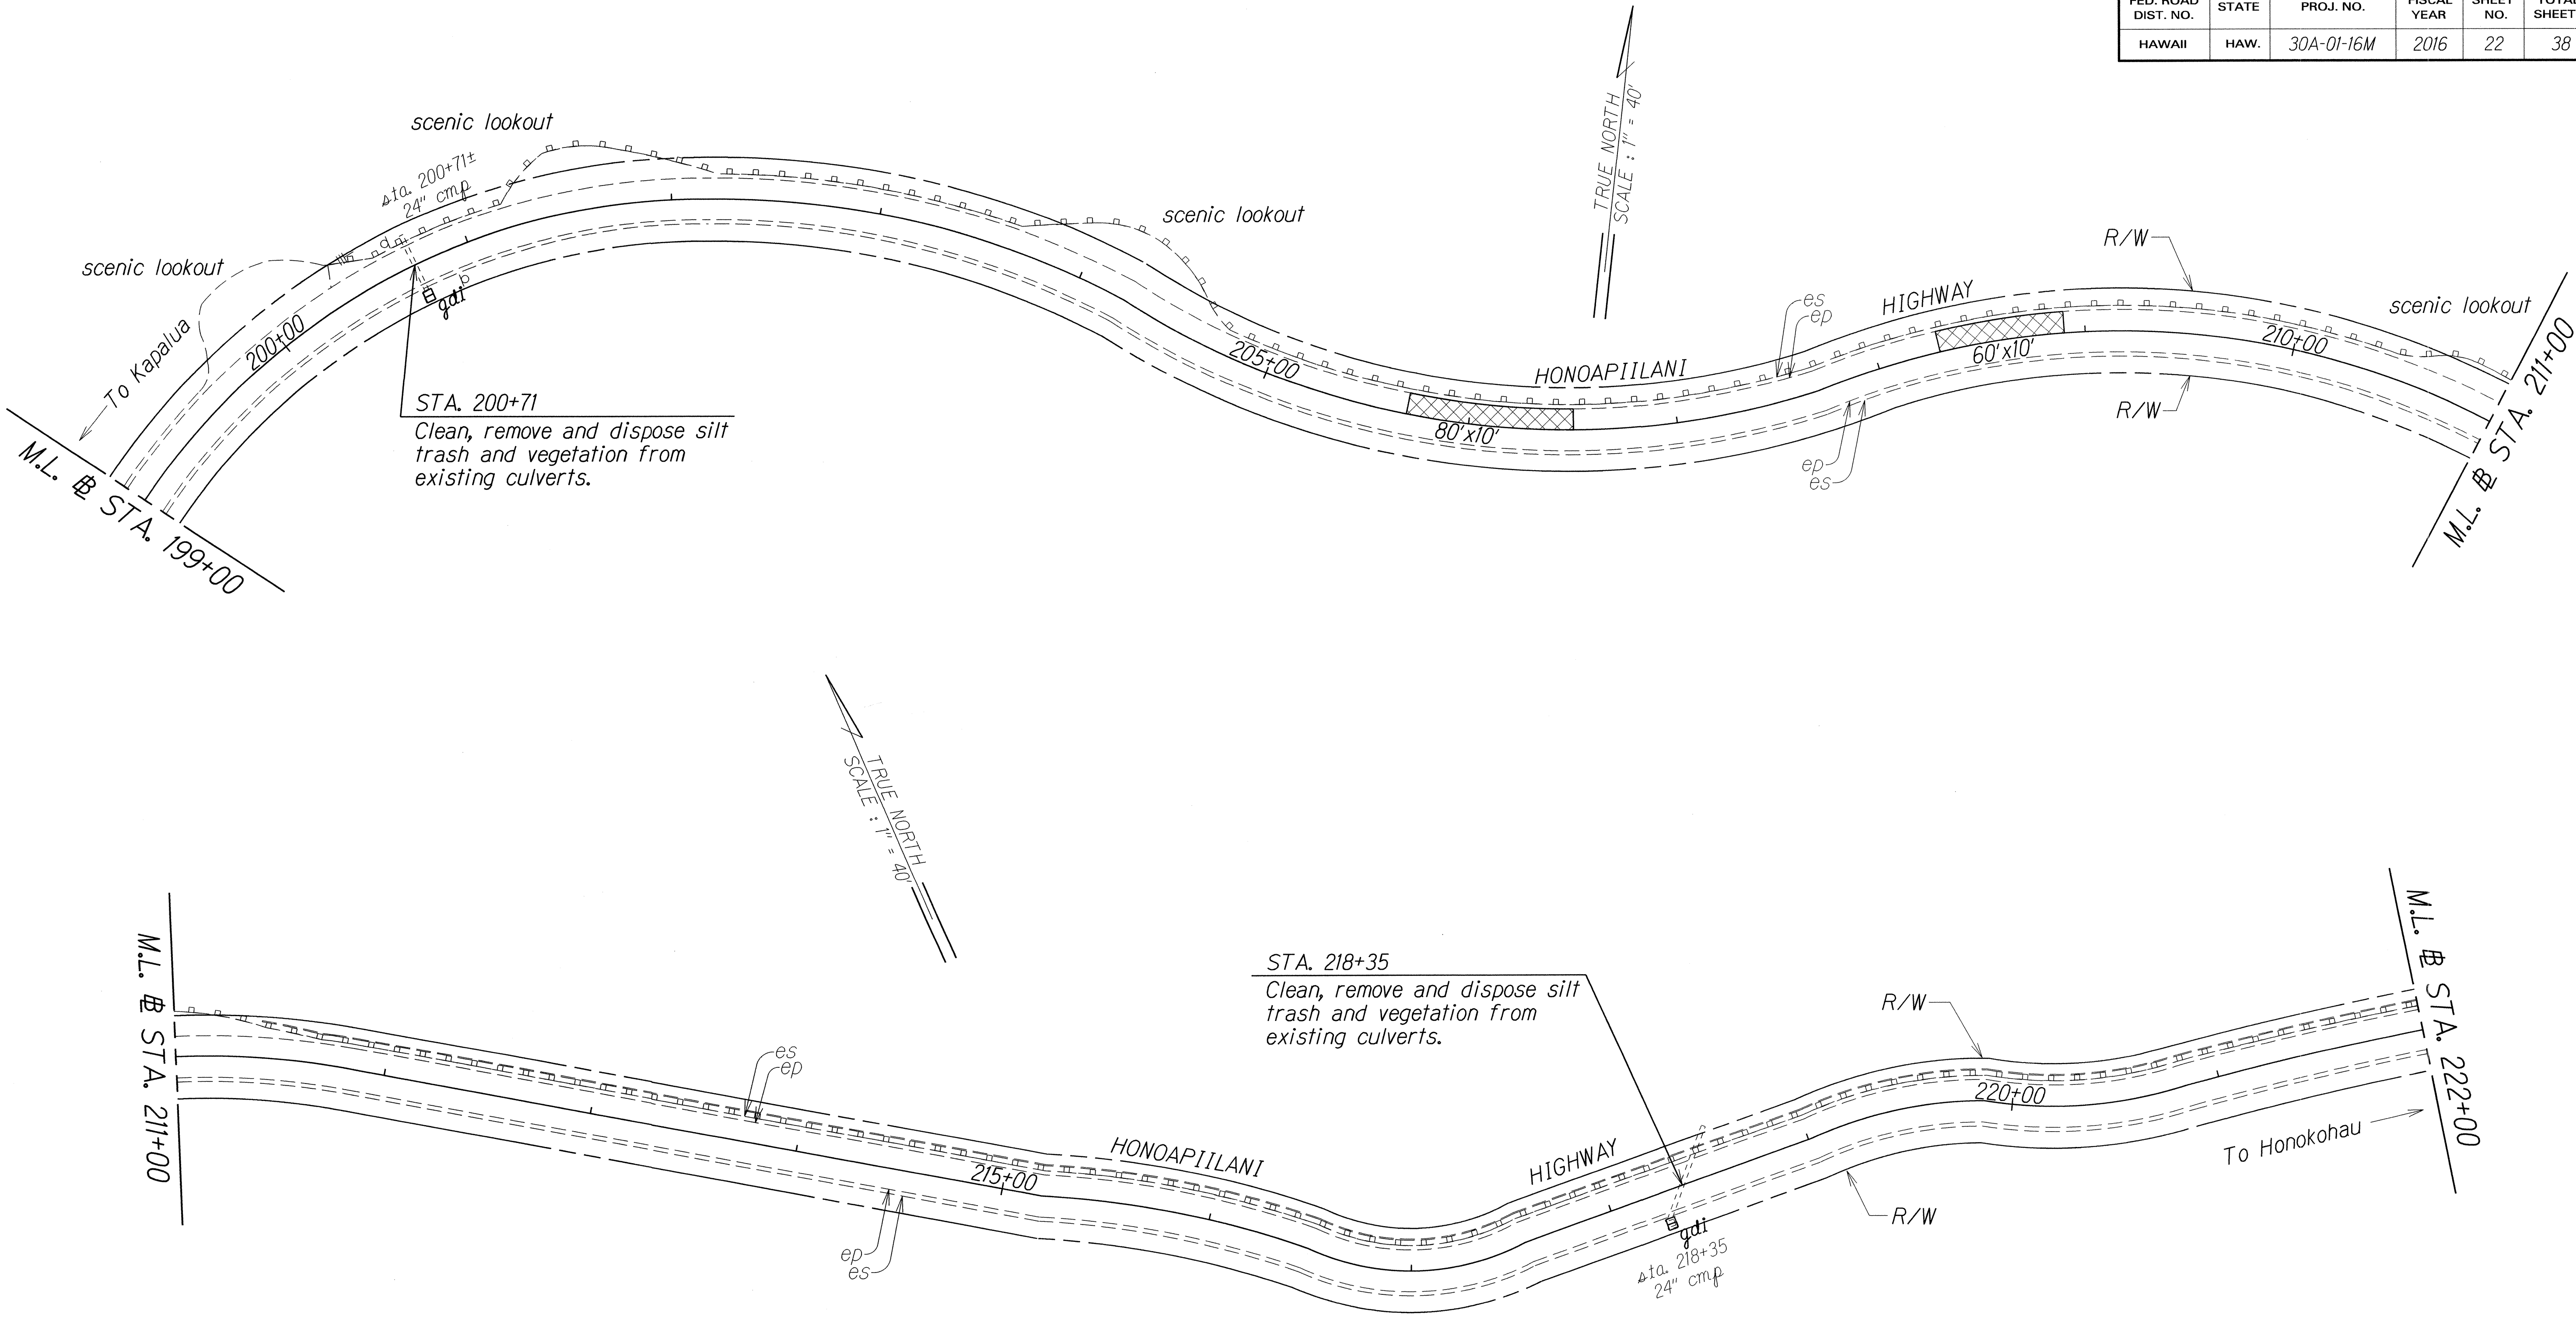

ORIGINAL PLAN	DATE
DESIGNED BY	11/02
NOTED BY	
CHECKED BY	

STATE OF HAWAII
DEPARTMENT OF TRANSPORTATION
HIGHWAYS DIVISION


ROADWAY PLAN

HONOAPIILANI HIGHWAY RESURFACING
Plantation Estates Golf Course to Honokohau Bridge
Project No. 30A-01-16M

Scale: 1" = 40' Date: August, 2015

SHEET No. 10 OF 12 SHEETS

FED. ROAD DIST. NO.	STATE	PROJ. NO.	FISCAL YEAR	SHEET NO.	TOTAL SHEETS
HAWAII	HAW.	30A-01-16M	2016	23	38

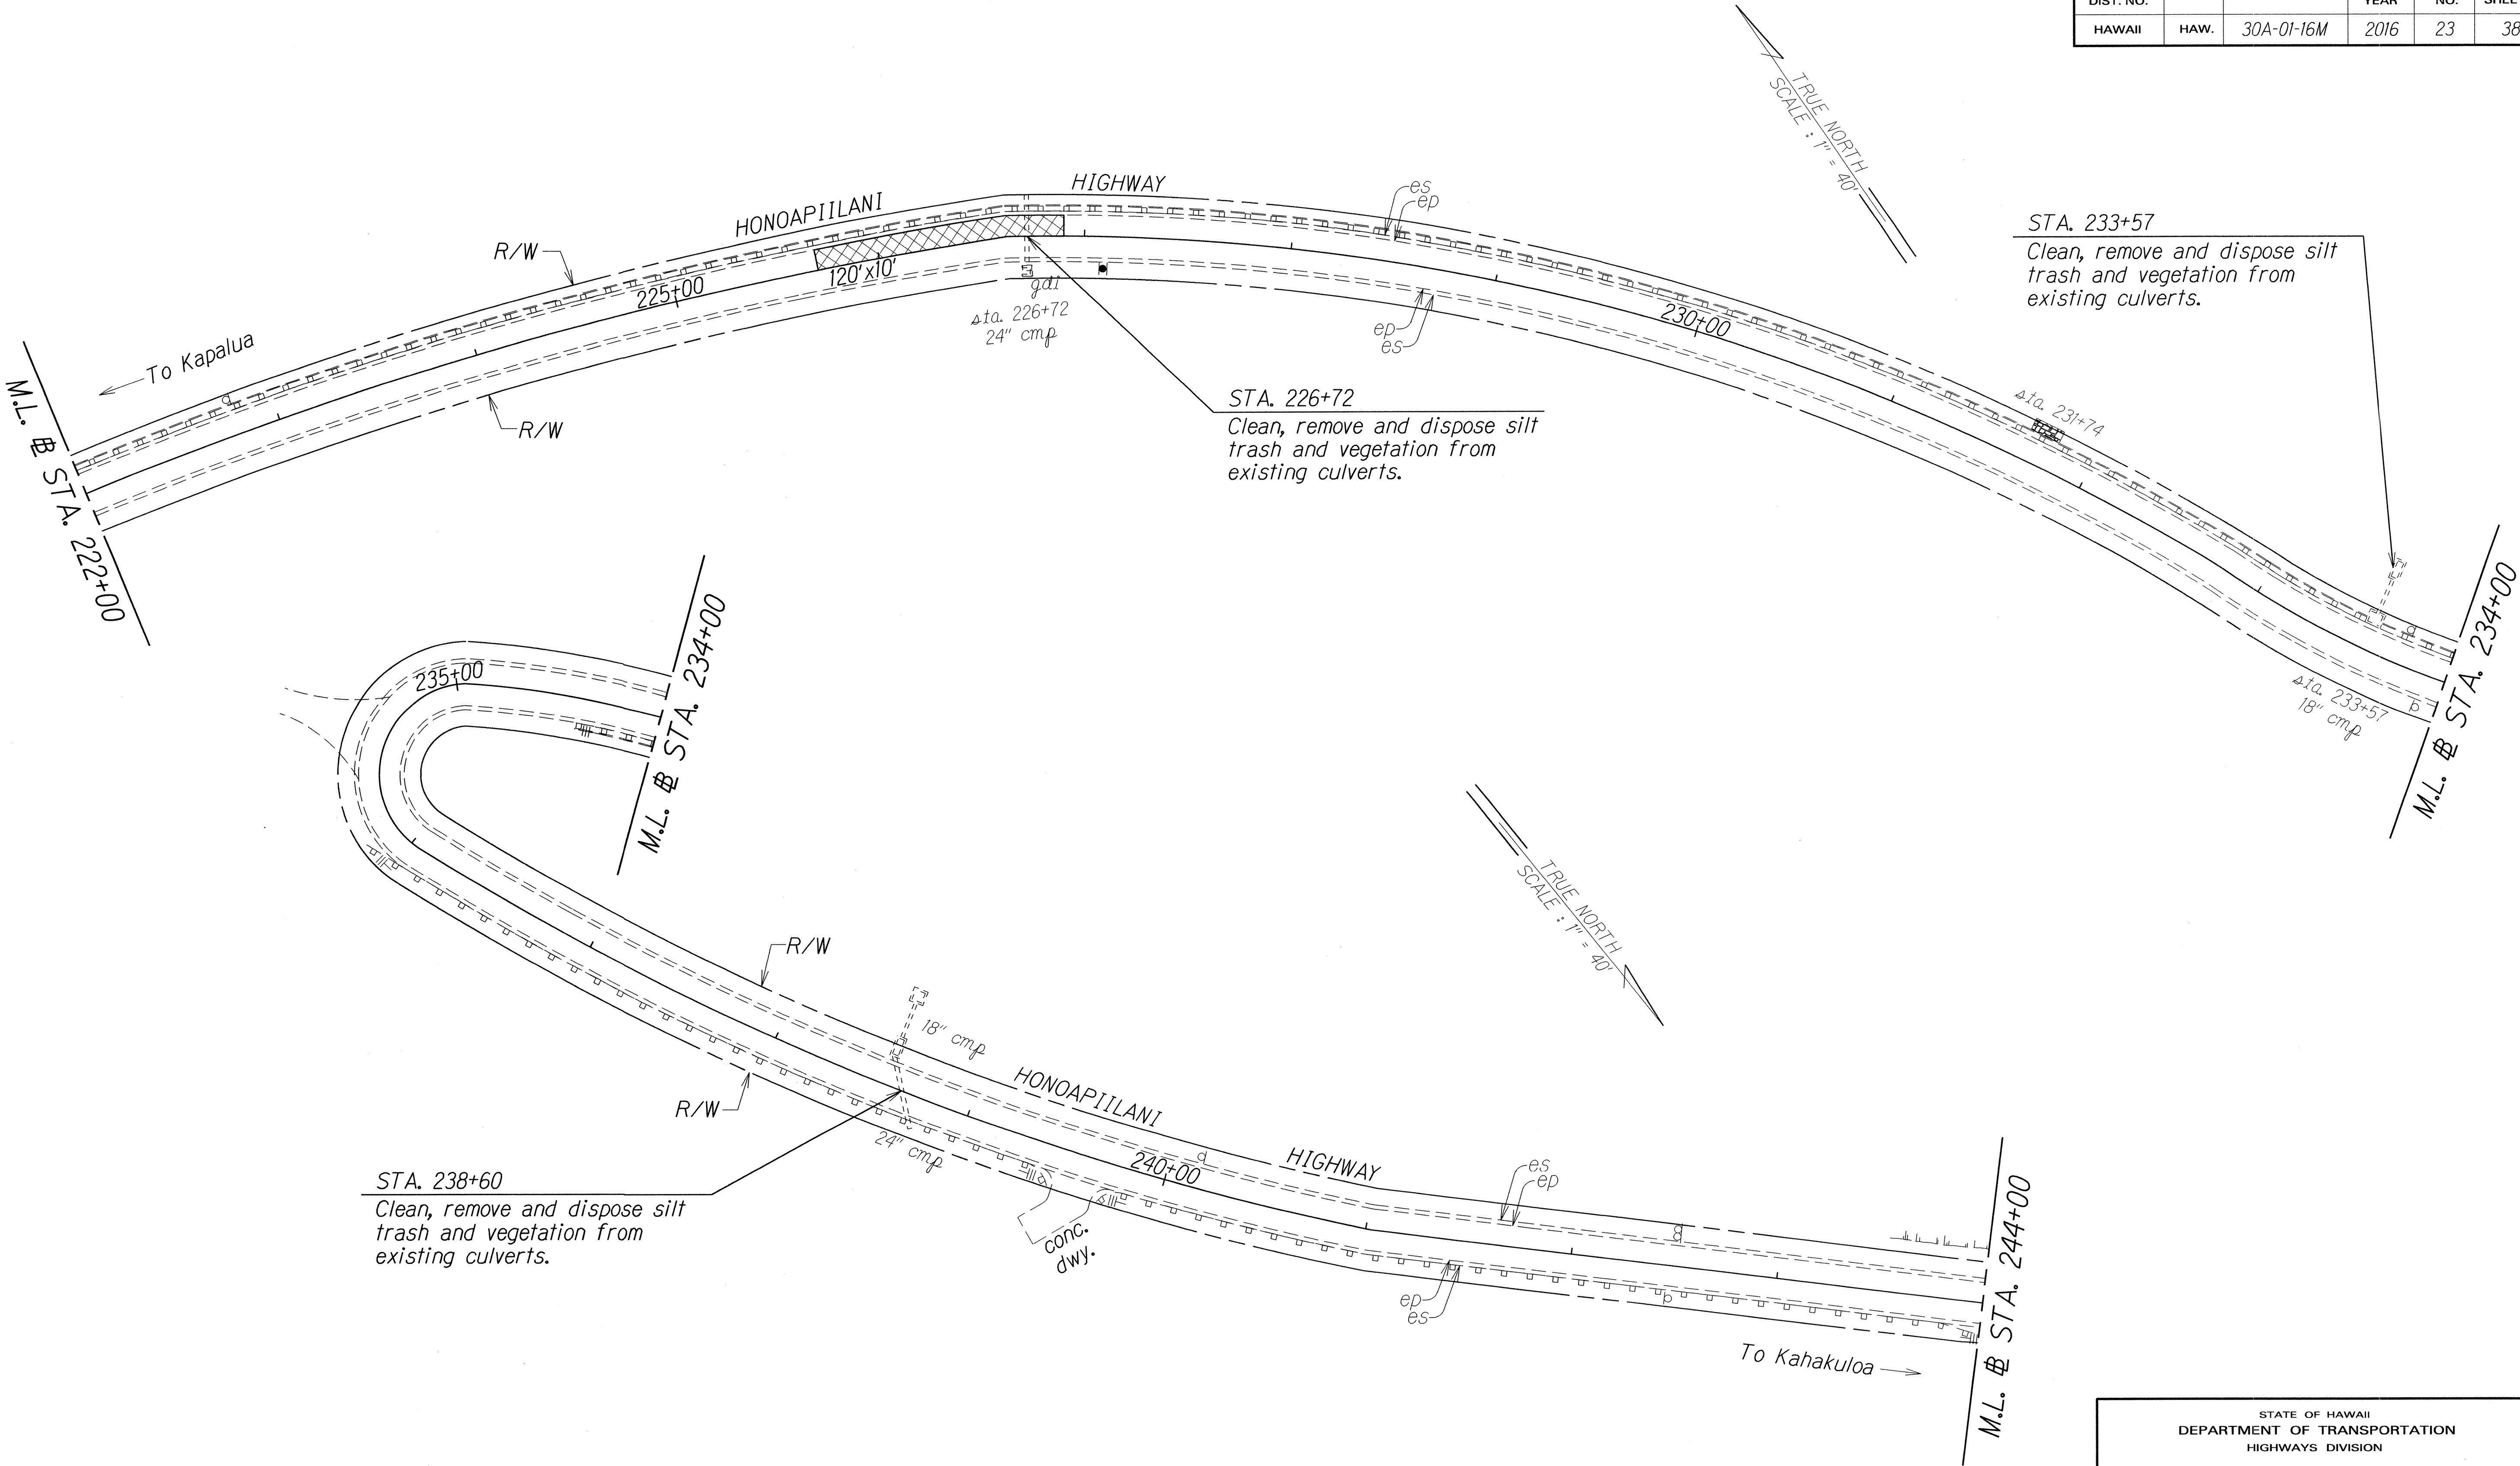

ORIGINAL PLAN	SURVEY PLOTTED BY	DATE
NOTE BOOK	DESIGNED BY	11/02
QUANTITIES BY	CHECKED BY	

STATE OF HAWAII
DEPARTMENT OF TRANSPORTATION
HIGHWAYS DIVISION


ROADWAY PLAN

HONOAPIILANI HIGHWAY RESURFACING
Plantation Estates Golf Course to Honokohau Bridge
Project No. 30A-01-16M

Scale: 1" = 40' Date: August, 2015

SHEET No. 11 OF 12 SHEETS

FED. ROAD DIST. NO.	STATE	PROJ. NO.	FISCAL YEAR	SHEET NO.	TOTAL SHEETS
HAWAII	HAW.	30A-01-16M	2016	24	38

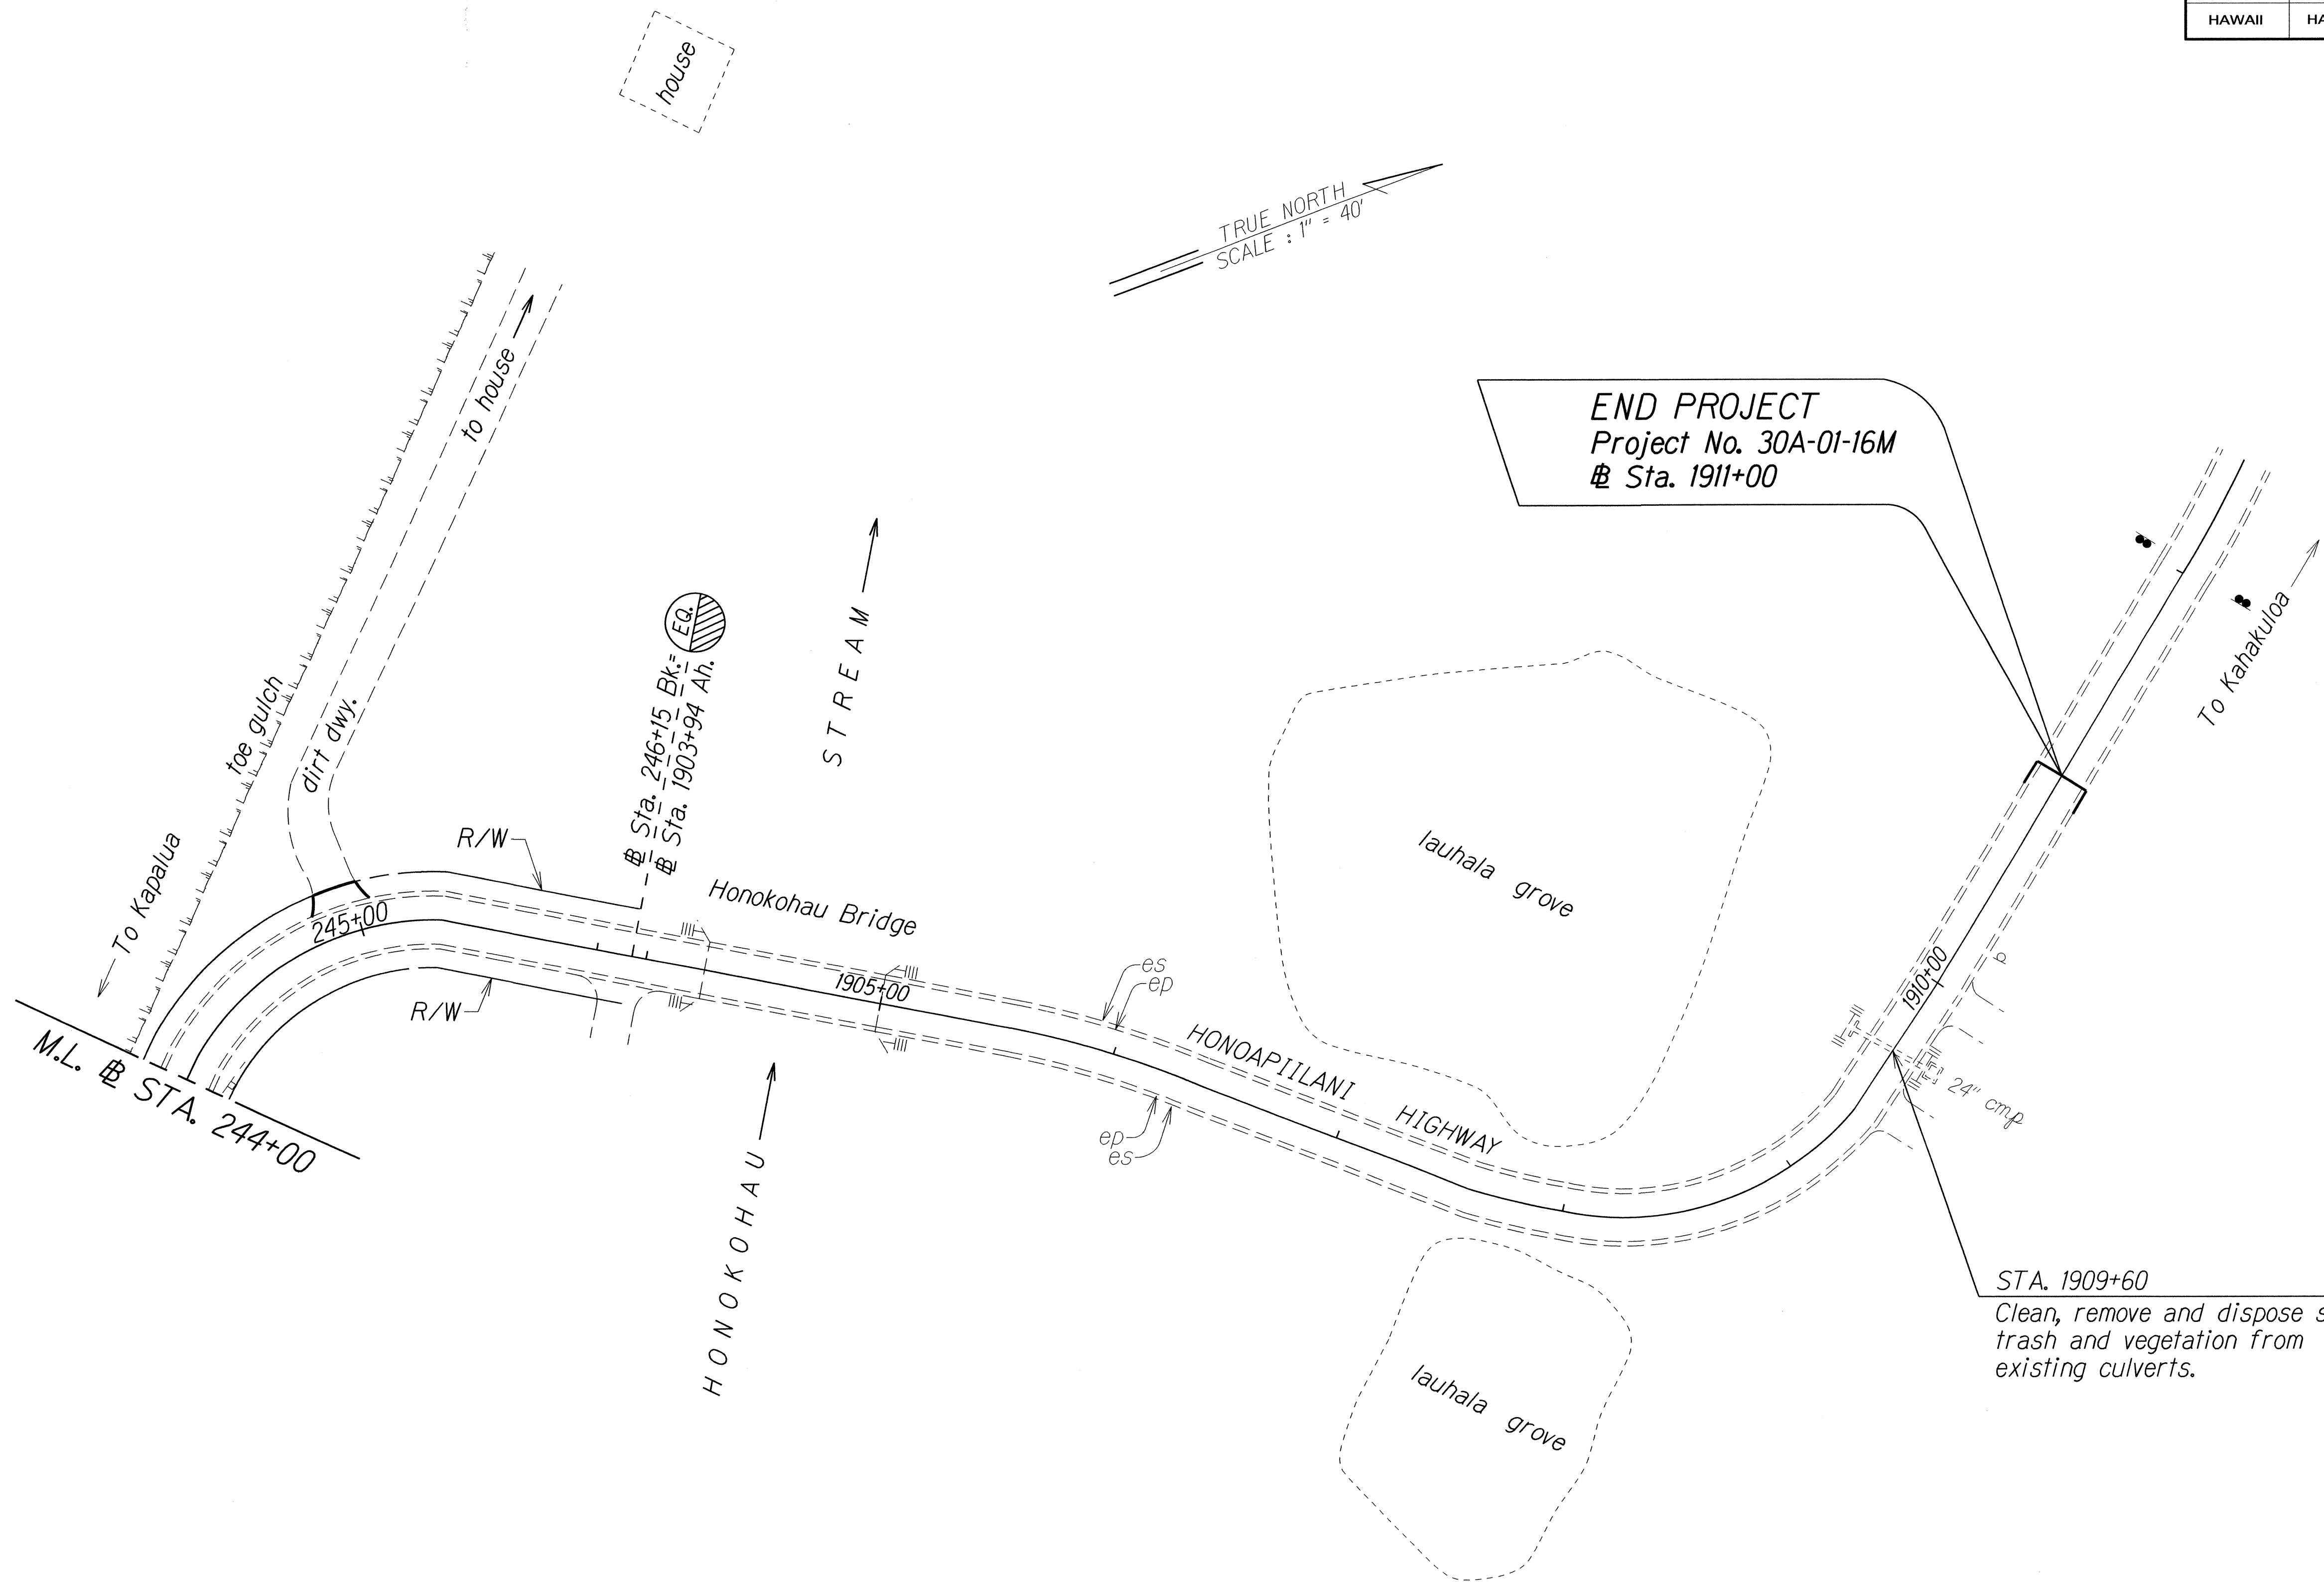

ORIGINAL PLAN	SURVEY PLOTTED BY	DATE
NOTE BOOK	DRAWN BY	11/02
DESIGNED BY	CHECKED BY	
QUANTITIES BY		
CHECKED BY		

STATE OF HAWAII
DEPARTMENT OF TRANSPORTATION
HIGHWAYS DIVISION

ROADWAY PLAN

HONOAPIILANI HIGHWAY RESURFACING
Plantation Estates Golf Course to Honokohau Bridge
Project No. 30A-01-16M

Scale: 1" = 40' Date: August, 2015

SHEET No. 12 OF 12 SHEETS