	INDEX TO DRAWINGS
SHEET NO.	DESCRIPTION
1	TITLE SHEET
2	STANDARD PLANS SUMMARY
3	GENERAL NOTES & LEGEND
4 - 6	WATER POLLUTION & EROSION CONTROL NOTES
7 – 8	TYPICAL SECTIONS & DETAILS
9 – 12	GUARDRAIL DETAILS
13 – 24	ROADWAY PLANS
25	PAVEMENT MARKING LEGEND, DETAILS, NOTES & SIGN PANEL LAYOUTS
26	RUMBLE STRIP DETAILS & NOTES
27 – 38	SIGNING & PAVEMENT MARKING PLANS

STATE OF HAWAII

DEPARTMENT OF TRANSPORTATION

HIGHWAYS DIVISION HONOLULU, HAWAII


"AS-DEMLT"

PLANS FOR

HONOAPIILANI HIGHWAY RESURFACING


PLANTATION ESTATES GOLF COURSE TO HONOKOHAU BRIDGE PROJECT NO. 30A-01-16M

DISTRICTS OF LAHAINA AND WAILUKU
ISLAND OF MAUI

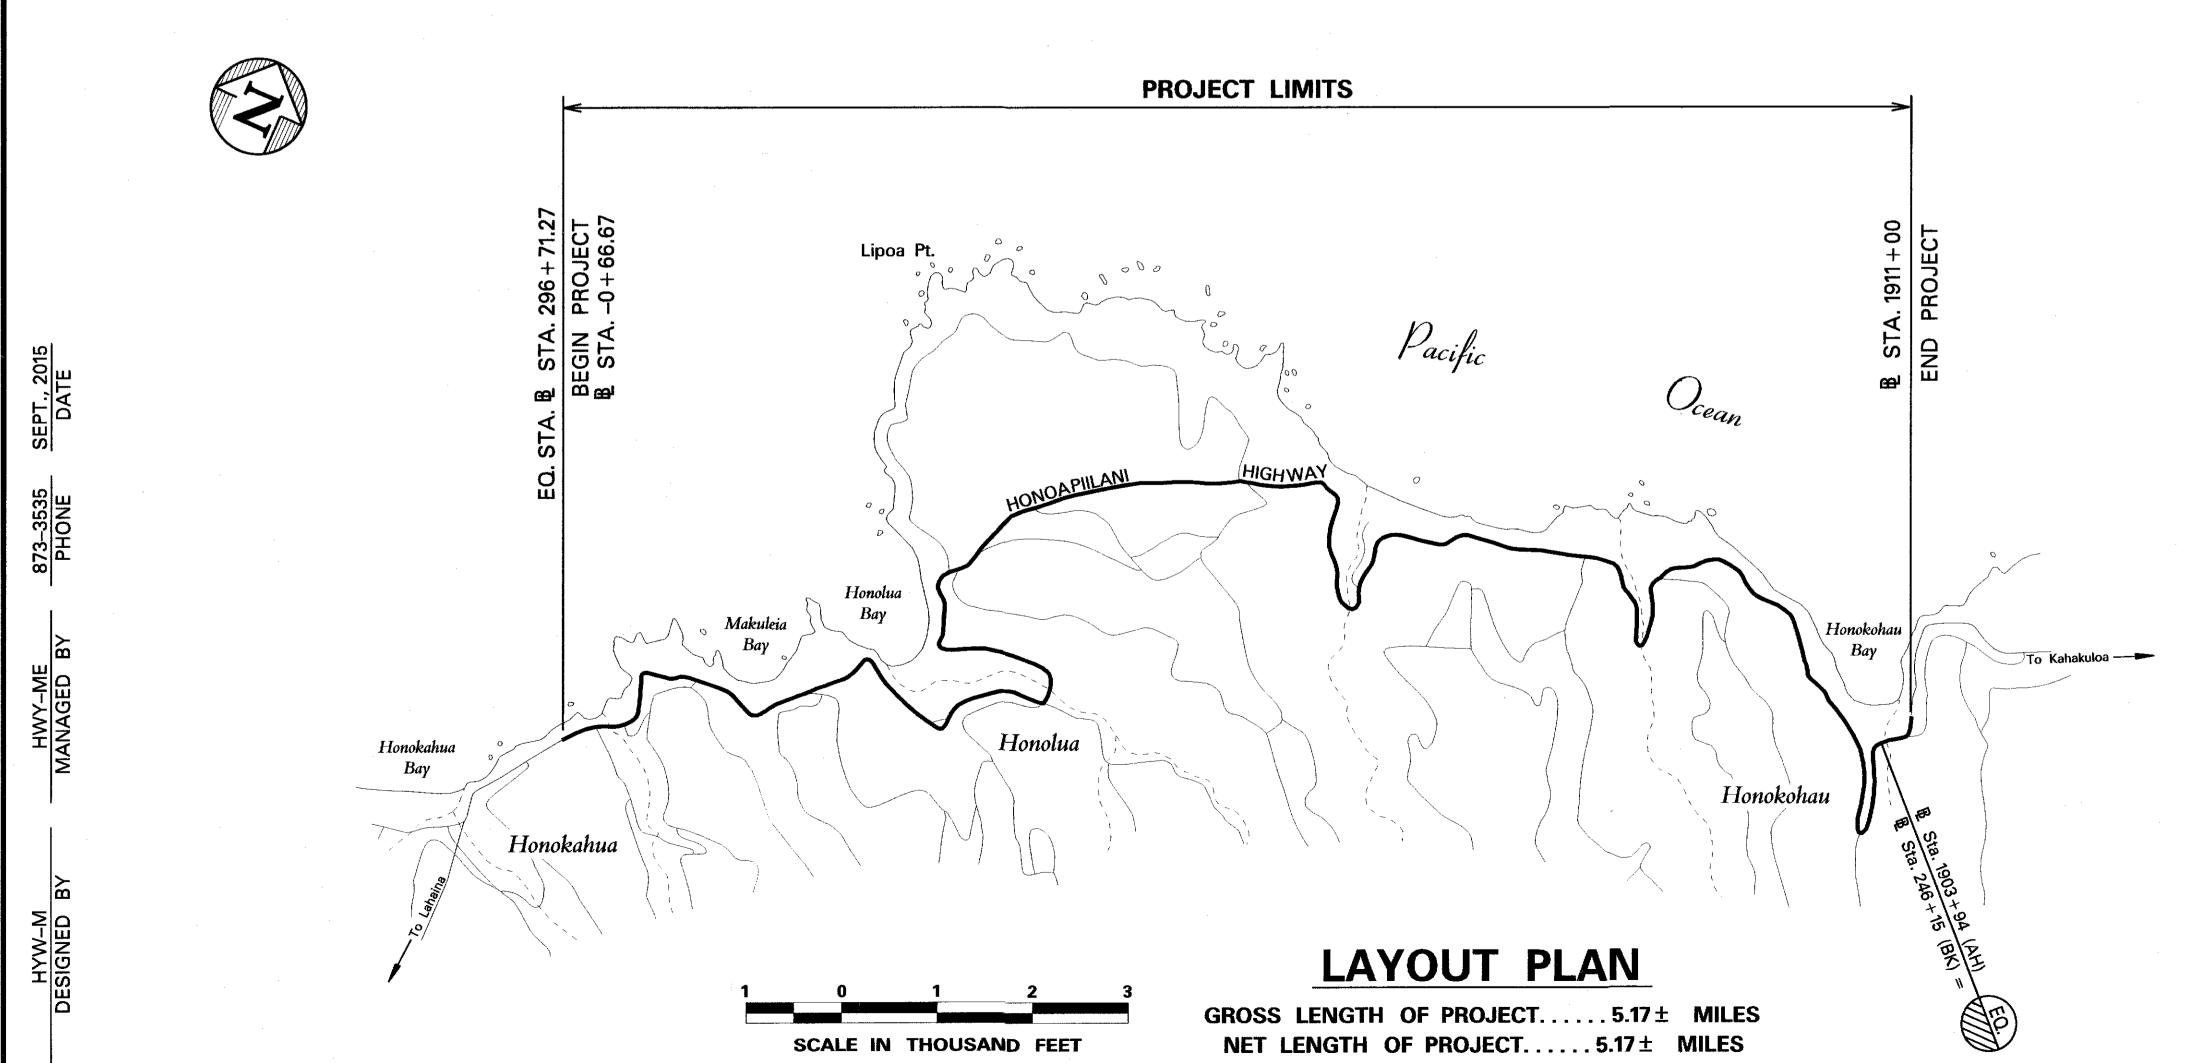

FED. ROAD DIST. NO. STATE PROJ. NO. FISCAL YEAR NO. SHEETS

HAWAII HAW. 30A-01-16M 2016 1 38

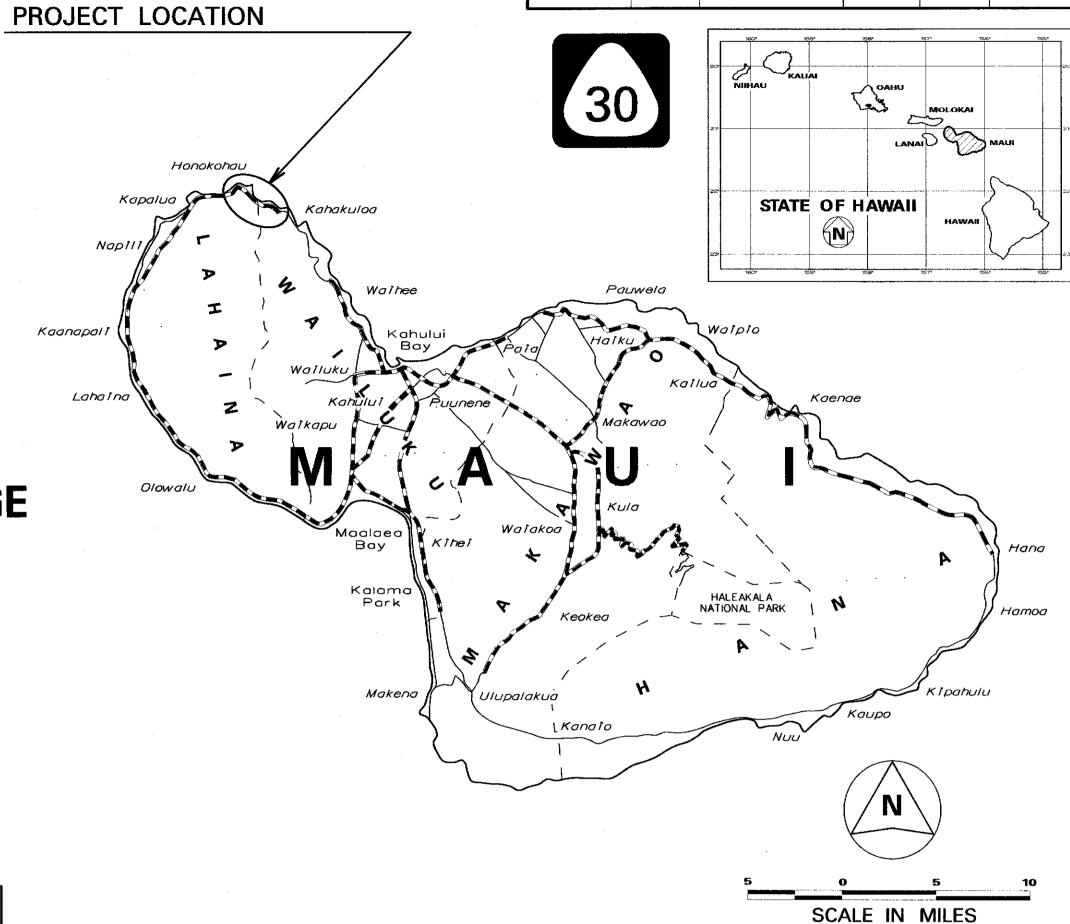

OR UNDER CONSTRUCTION

ROUTE 30 MILE POST 31.23 TO MILE POST 36.40

CHANGES MADE DURING CONSTRUCTION HAVE BEEN INCORPORATED ON THESE PLANS EXCEPT CHANGES IN THE ORIGINAL THEORETICAL QUANTITIES. FOR ACTUAL QUANTITIES, REFER TO PROJECT LEDGER AND/OR COMPUTATION BOOK.

RESIDENT ENGINEER 3/22/1

DEPARTMENT OF TRANSPORTATION STATE OF HAWAII		
APPROVED:		
Manual Major	1/22/10	
DIR. OF TRANSPORTATION	DATE	

•