
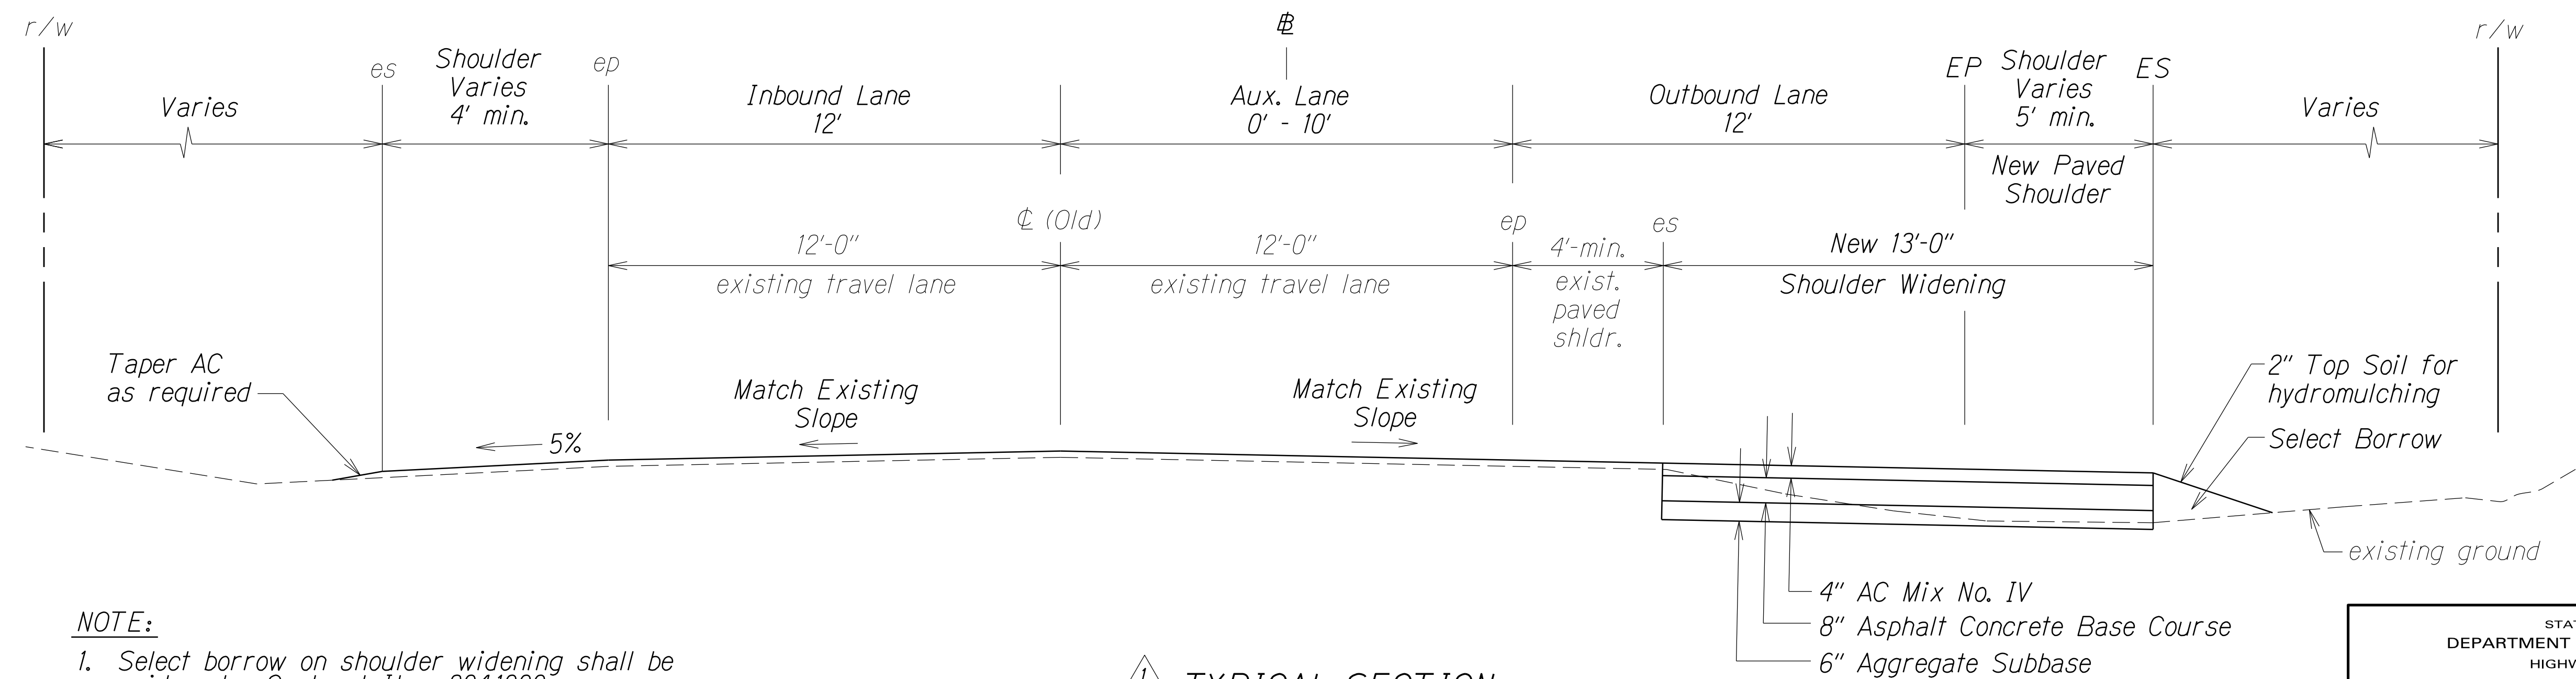


FED. ROAD DIST. NO.	STATE	FED. AID PROJ. NO.	FISCAL YEAR	SHEET NO.	TOTAL SHEETS
HAWAII	HAW.	NH-030-1(057)	2019	ADD.8	22

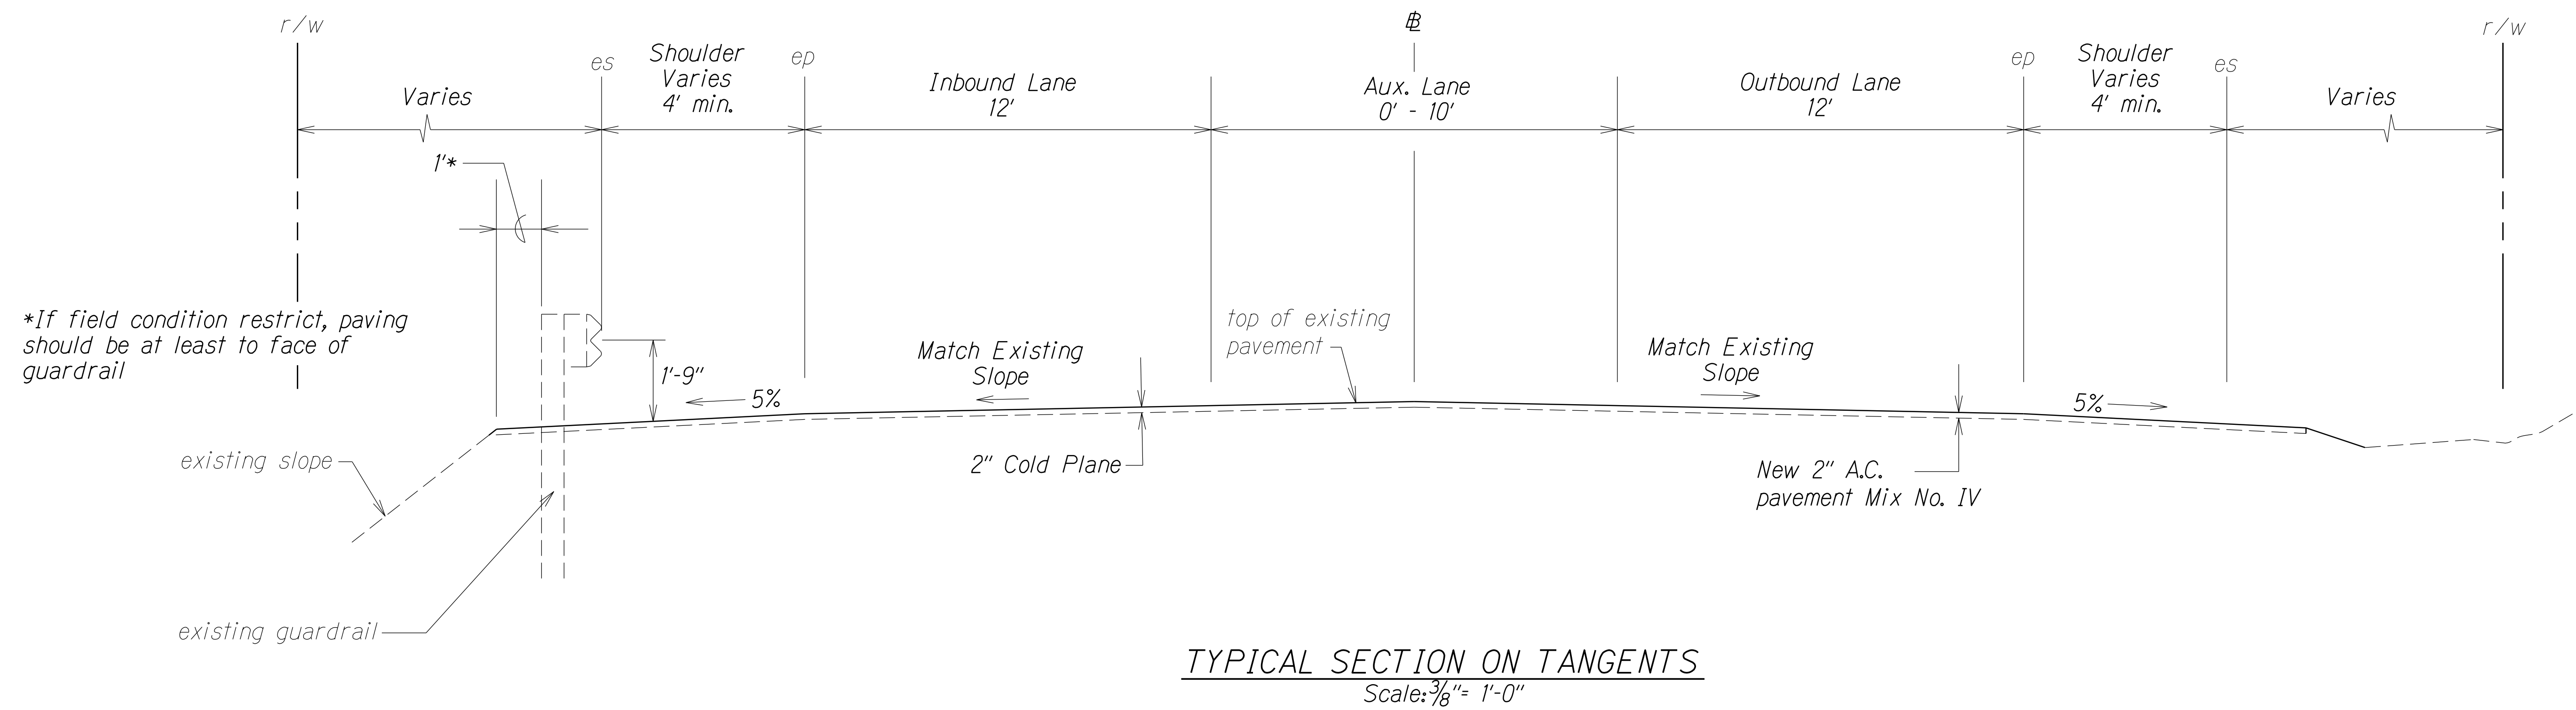

NOTE:
1. Select borrow on shoulder widening shall be paid under Contract Item 204.1000.


TYPICAL SECTION
STA. 166+00 TO # STA. 163+00
Scale: $\frac{3}{8}" = 1'-0"$

9/25/19	Delete Typical Section Sta. 166+00 to Sta. 163+00.
DATE	REVISION

STATE OF HAWAII DEPARTMENT OF TRANSPORTATION HIGHWAYS DIVISION
TYPICAL SECTIONS & DETAILS
HONOAPIILANI HIGHWAY RESURFACING Vicinity of Puamana Beach Park to Aholo Road Federal-Aid Project No. NH-030-1(057)
Scale: As Shown Date: October, 2017
SHEET No. 2 OF 3 SHEETS

DATE	2/18
SURVEY PLOTTED BY	AE
DRAWN BY	AE
DESIGNED BY	AE
CHECKED BY	AE
NOTE BOOK	me3.16600
PROJECT NO.	2000152.dgn

FED. ROAD DIST. NO.	STATE	FED. AID PROJ. NO.	FISCAL YEAR	SHEET NO.	TOTAL SHEETS
HAWAII	HAW.	NH-030-1(057)	2019	ADD.21	22

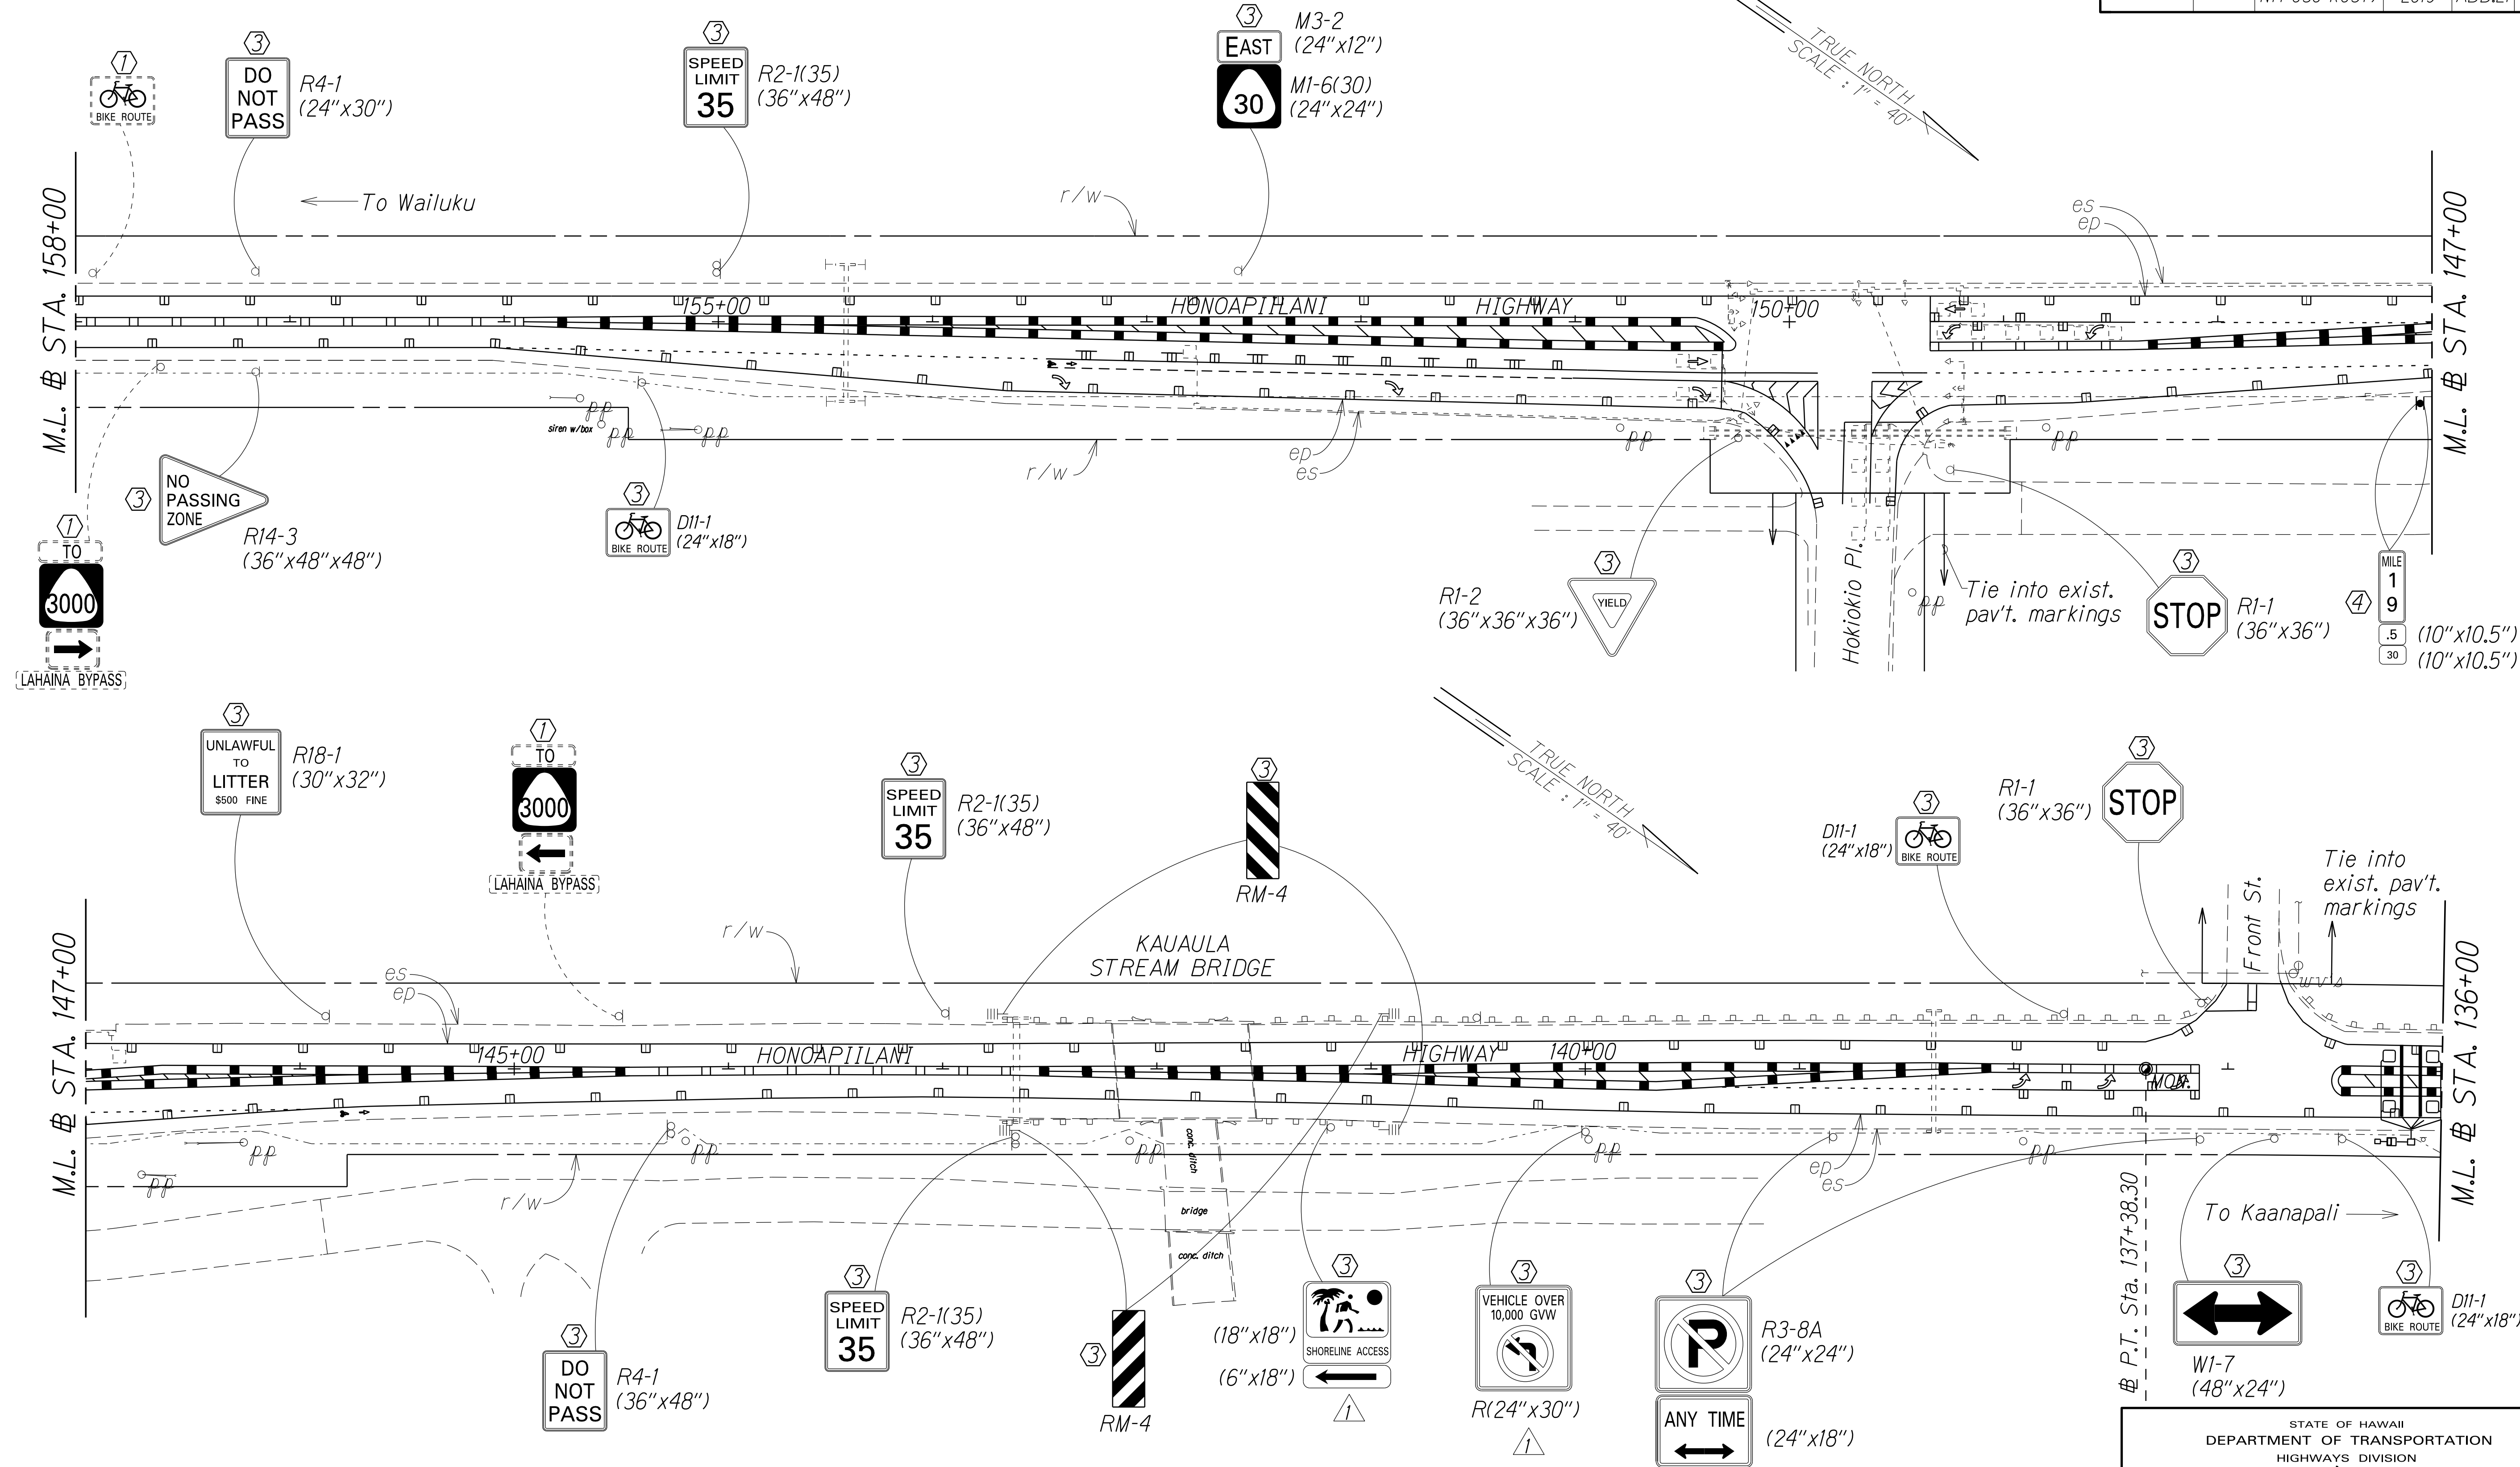

ORIGINAL PLAN	SURVEY PLOTTED BY	DATE
NOTE BOOK	DRAWN BY	2/18
DESIGNED BY	TRACED BY	
CHECKED BY	DESIGNED BY	
NO. 1000	CHECKED BY	

KEY:

- ① Exist. Sign(s) & Post(s) to Remain
- ② Remove Exist. Sign(s) & Post(s)
- ③ Remove Exist. & Install New Sign(s) & Post(s)
- ④ Install New Sign(s) & Post(s)

① 9/25/19 Add dimensions of signs.

DATE REVISION

STATE OF HAWAII
DEPARTMENT OF TRANSPORTATION
HIGHWAYS DIVISION

**SIGNING & PAVEMENT
MARKING PLAN**

HONOAPIILANI HIGHWAY RESURFACING
Vicinity of Puamana Beach Park to Aholo Road
Federal-Aid Project No. NH-030-1(057)
Scale: 1" = 40' Date: October, 2017

SHEET No. 2 OF 3 SHEETS