
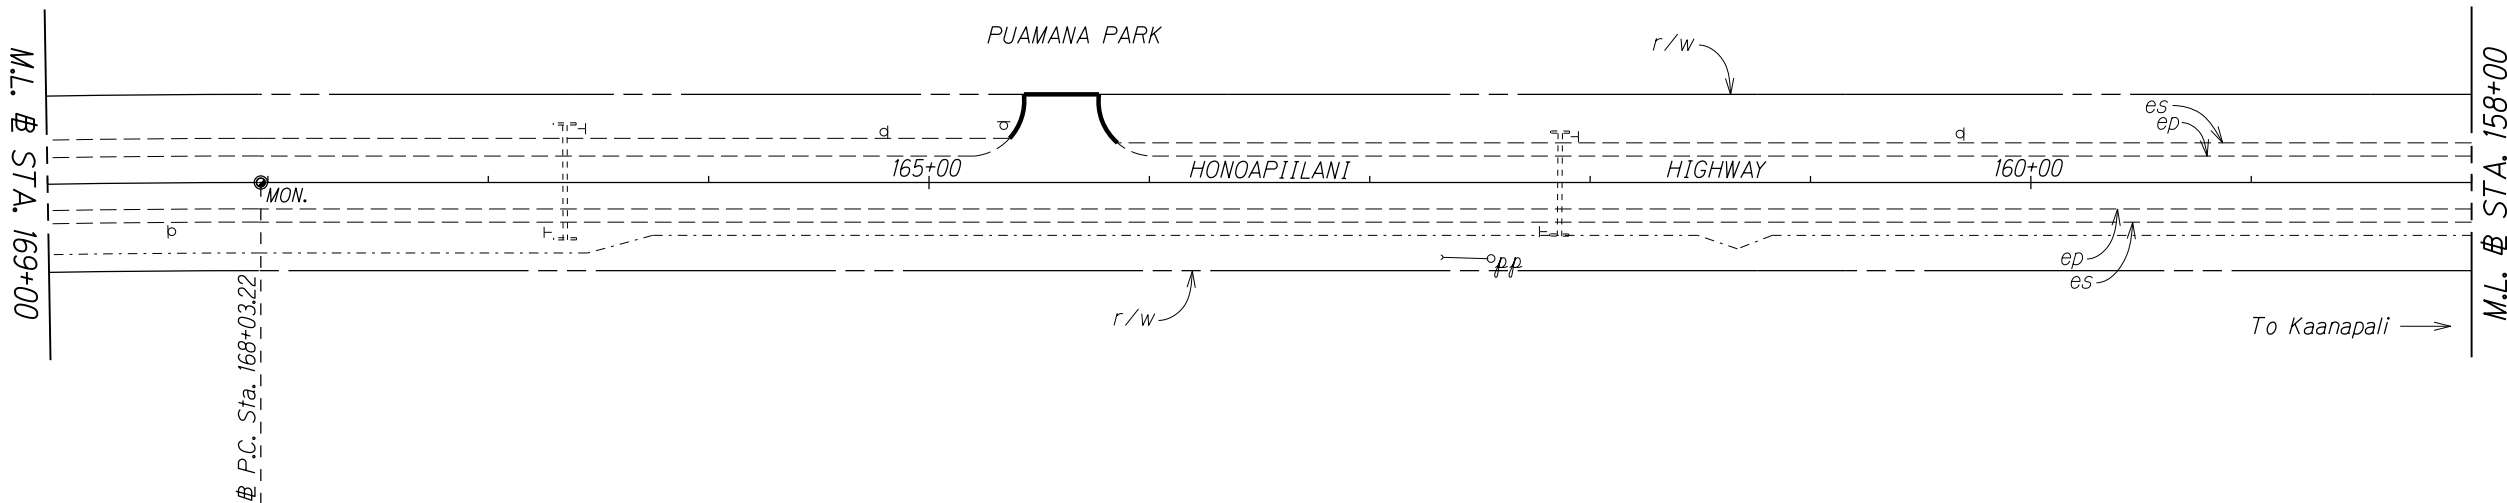


| FED. ROAD DIST. NO. | STATE | FED. AID PROJ. NO. | FISCAL YEAR | SHEET NO. | TOTAL SHEETS |
|---------------------|-------|--------------------|-------------|-----------|--------------|
| HAWAII              | HAW.  | NH-030-1(057)      | 2019        | 10        | 22           |

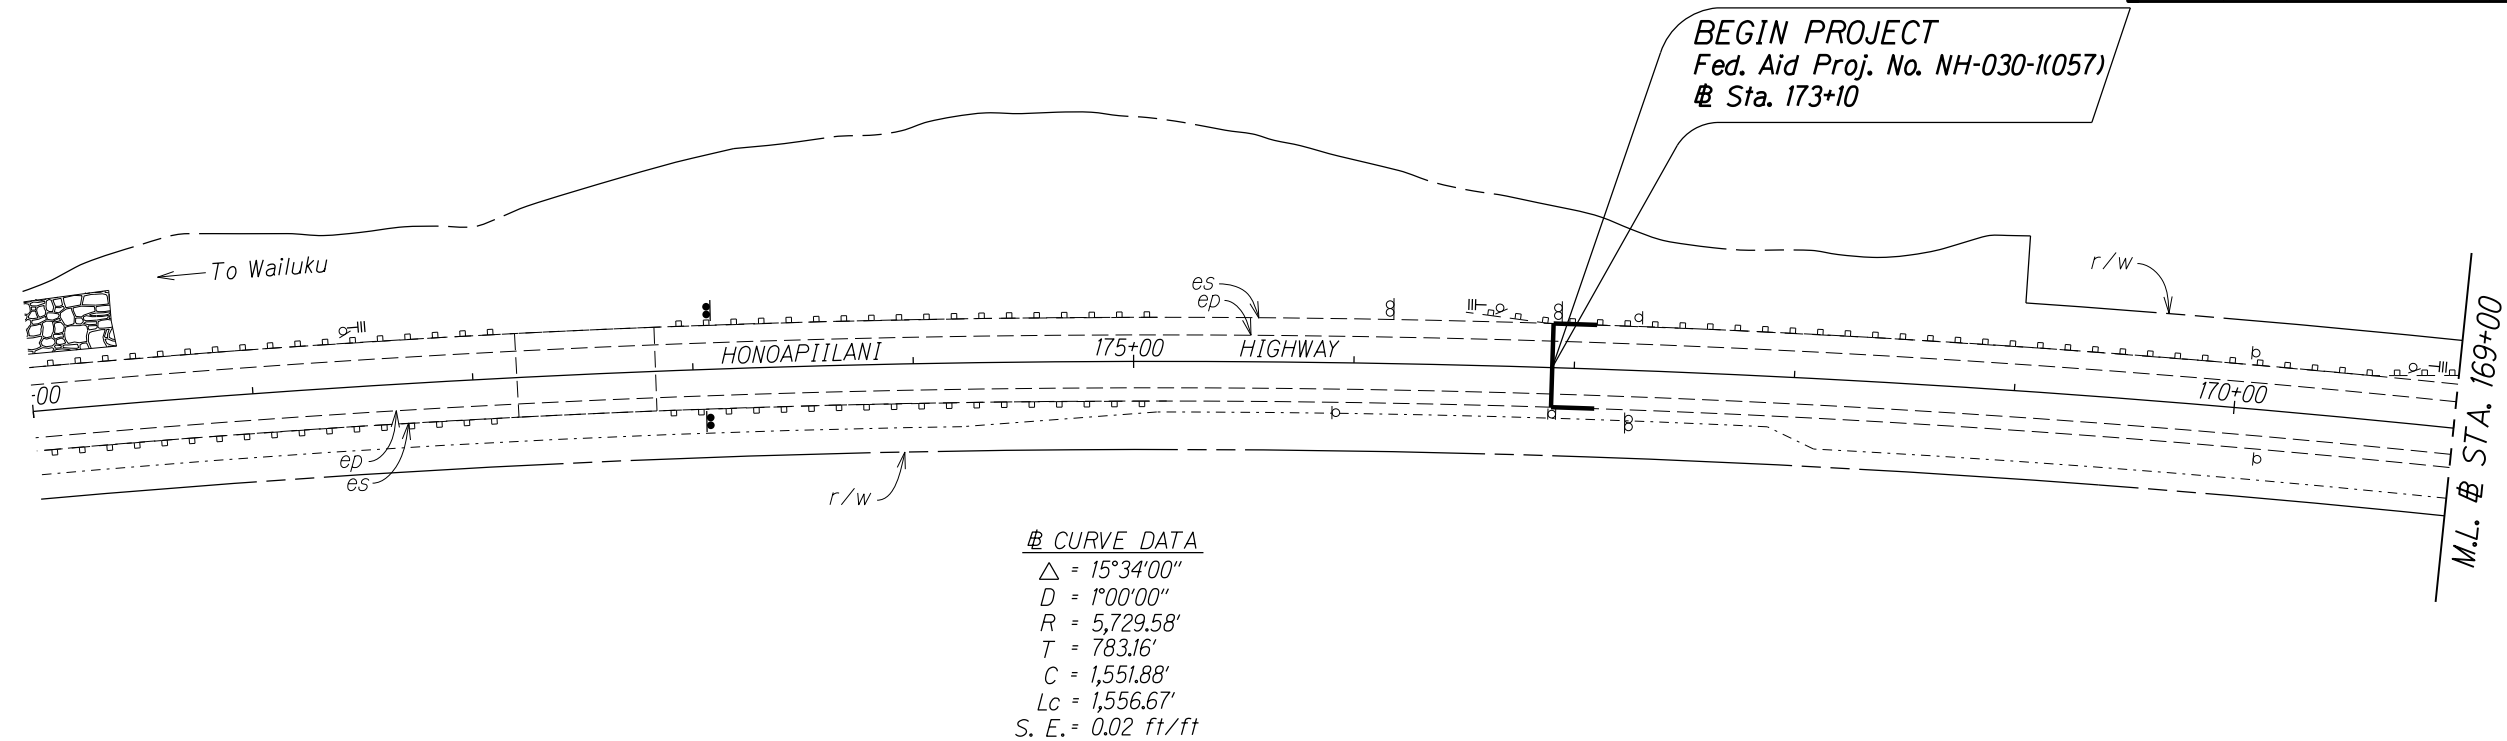

|               |             |
|---------------|-------------|
| ORIGINAL PLAN | DATE        |
| NOTE BOOK     | DESIGNED BY |
| N.            | CHECKED BY  |

STATE OF HAWAII  
DEPARTMENT OF TRANSPORTATION  
HIGHWAYS DIVISION


**ROADWAY PLAN**

HONOAPIILANI HIGHWAY RESURFACING  
Vicinity of Puamana Beach Park to Aholo Road  
Federal-Aid Project No. NH-030-1(057)

Scale: 1" = 40'      Date: October, 2017

SHEET No. 1 OF 3 SHEETS

| FED. ROAD DIST. NO. | STATE | FED. AID PROJ. NO. | FISCAL YEAR | SHEET NO. | TOTAL SHEETS |
|---------------------|-------|--------------------|-------------|-----------|--------------|
| HAWAII              | HAW.  | NH-030-1(057)      | 2019        | 11        | 22           |

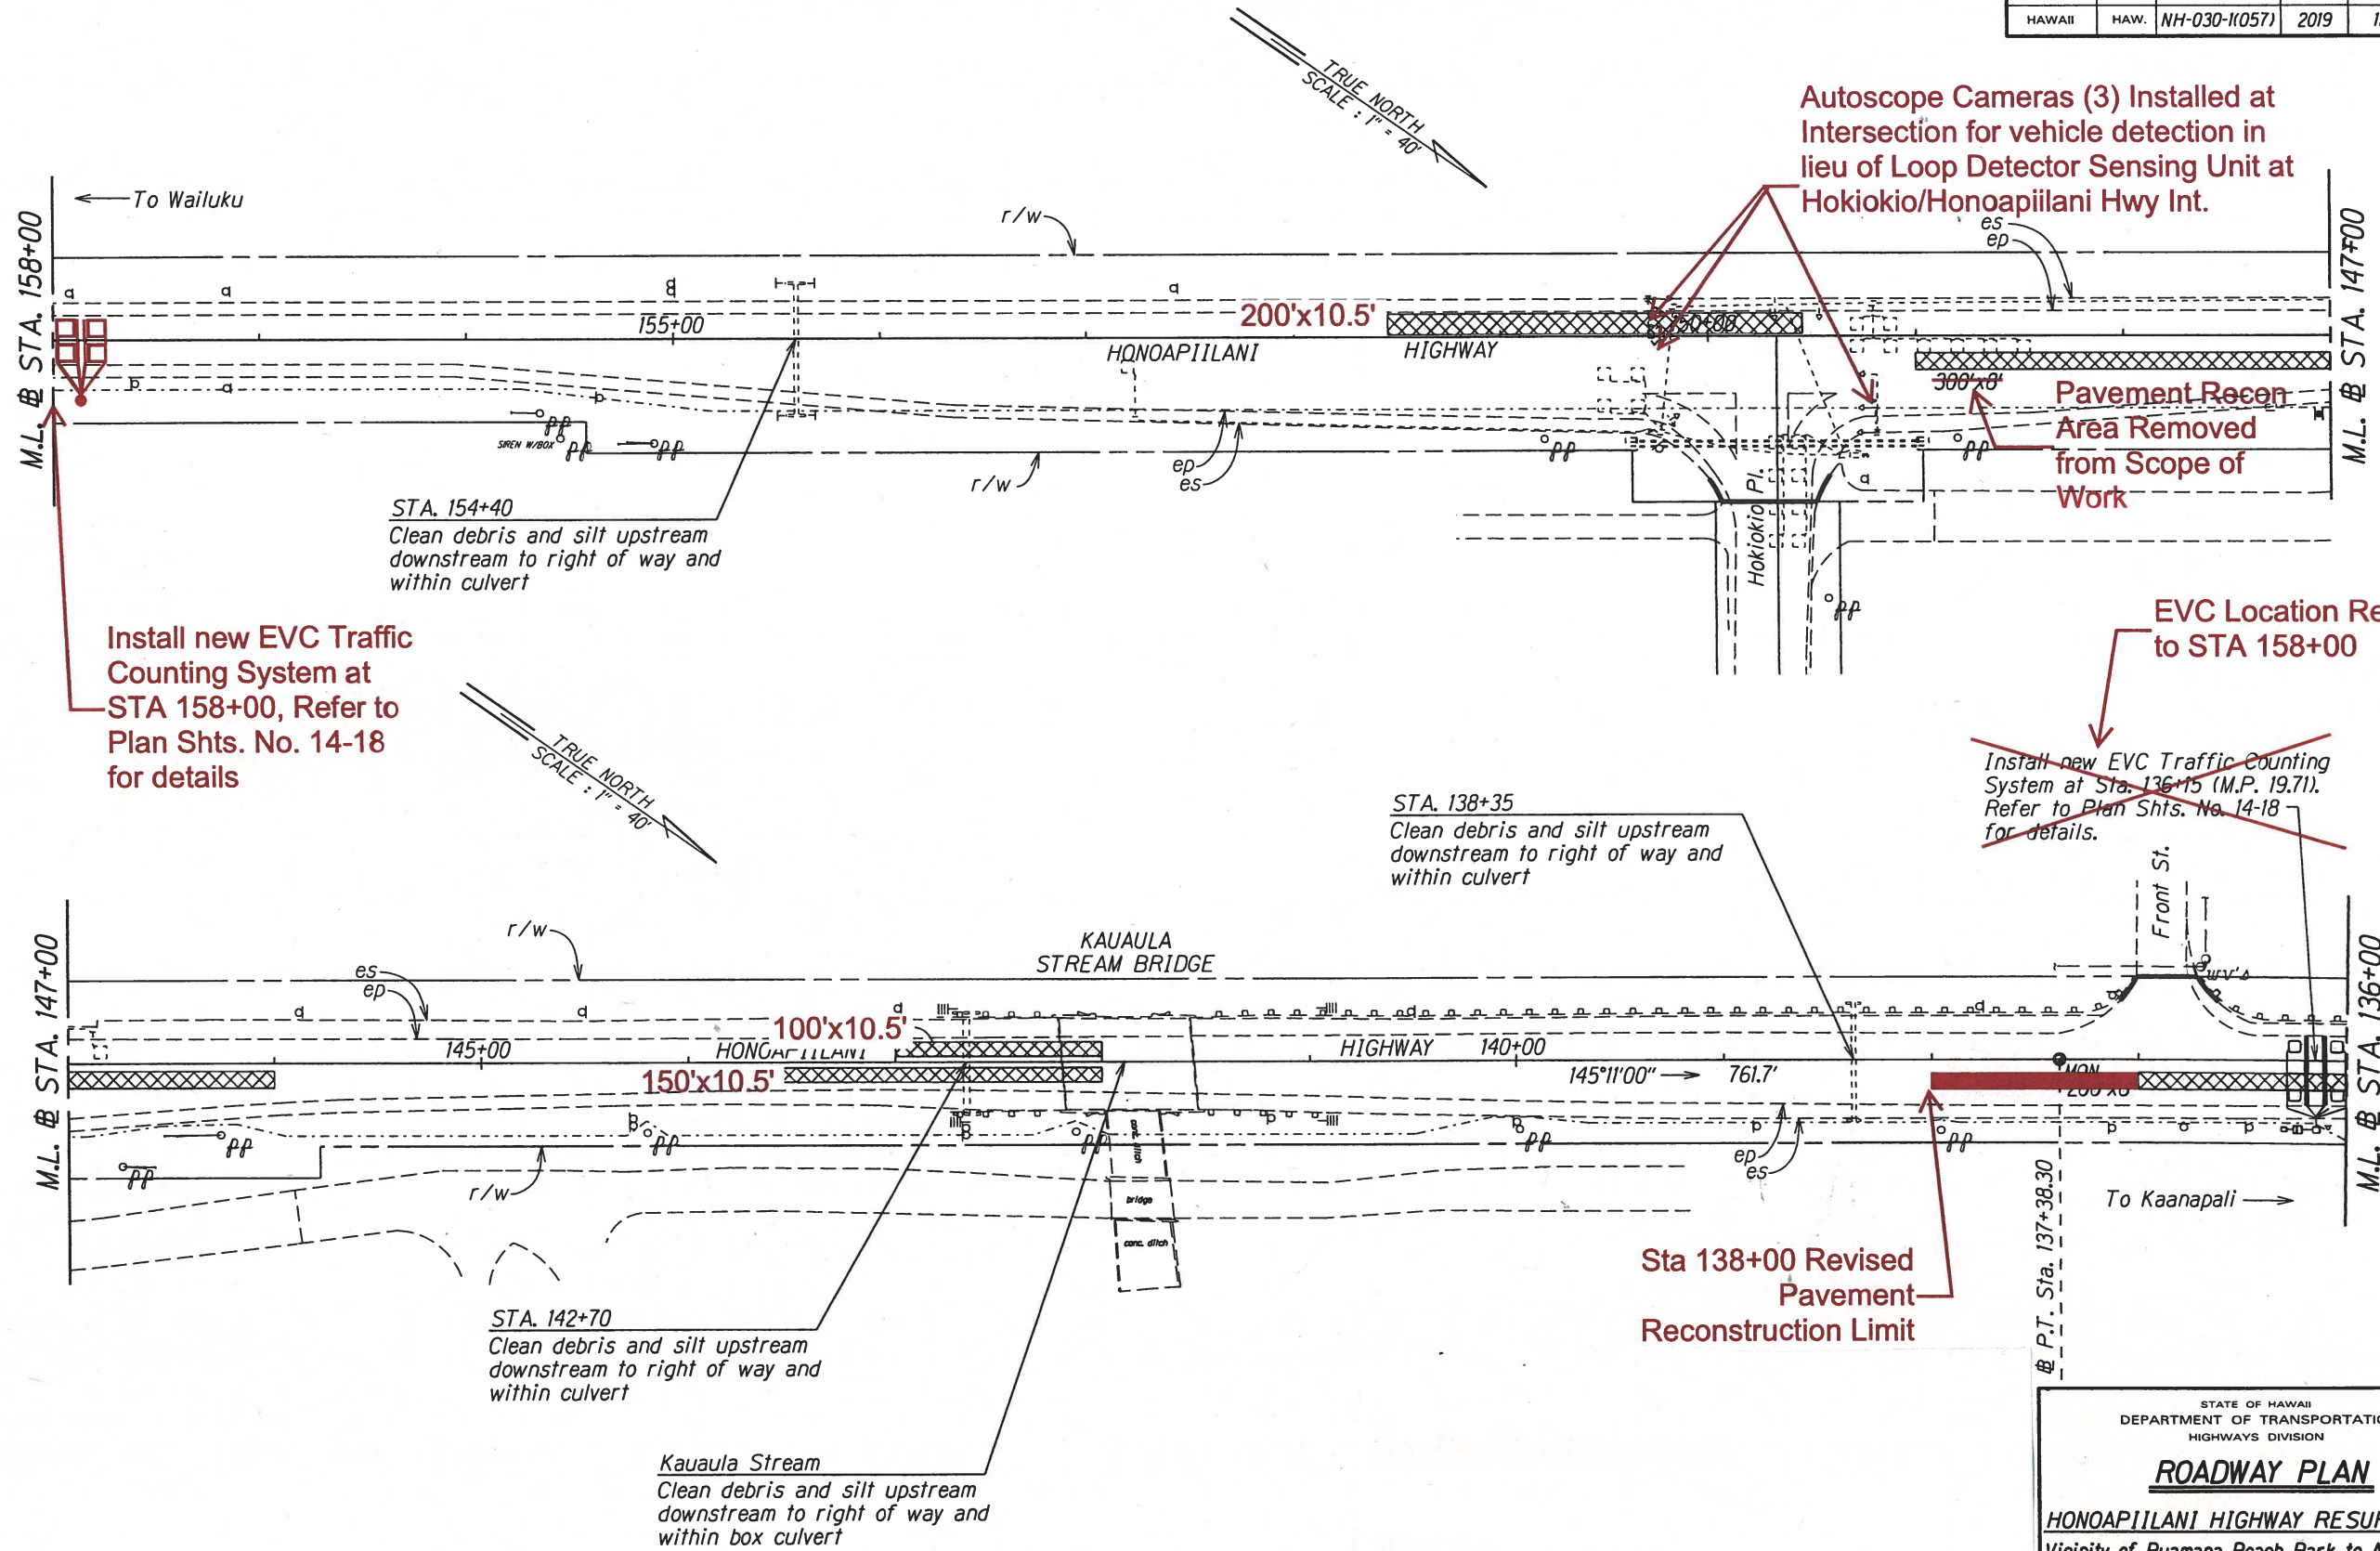

|                   |      |      |
|-------------------|------|------|
| SURVEY PLOTTED BY | DATE | 2/18 |
| DRAWN BY          |      |      |
| DESIGNED BY       |      |      |
| QUANTITIES BY     |      |      |
| CHECKED BY        |      |      |
| ORIGINAL PLAN     |      |      |
| NOTE BOOK         |      |      |
| NO. 1000          |      |      |

STATE OF HAWAII  
DEPARTMENT OF TRANSPORTATION  
HIGHWAYS DIVISION

**ROADWAY PLAN**


**HONOAPIILANI HIGHWAY RESURFACING**  
Vicinity of Puamana Beach Park to Aholo Road  
Federal-Aid Project No. NH-030-1(057)

Scale: 1" = 40'      Date: October, 2017

SHEET No. 2 OF 3 SHEETS

"AS-BUILT"

| FED. ROAD DIST. NO. | STATE | FED. AID PROJ. NO. | FISCAL YEAR | SHEET NO. | TOTAL SHEETS |
|---------------------|-------|--------------------|-------------|-----------|--------------|
| HAWAII              | HAW.  | NH-030-1(057)      | 2019        | 12        | 22           |

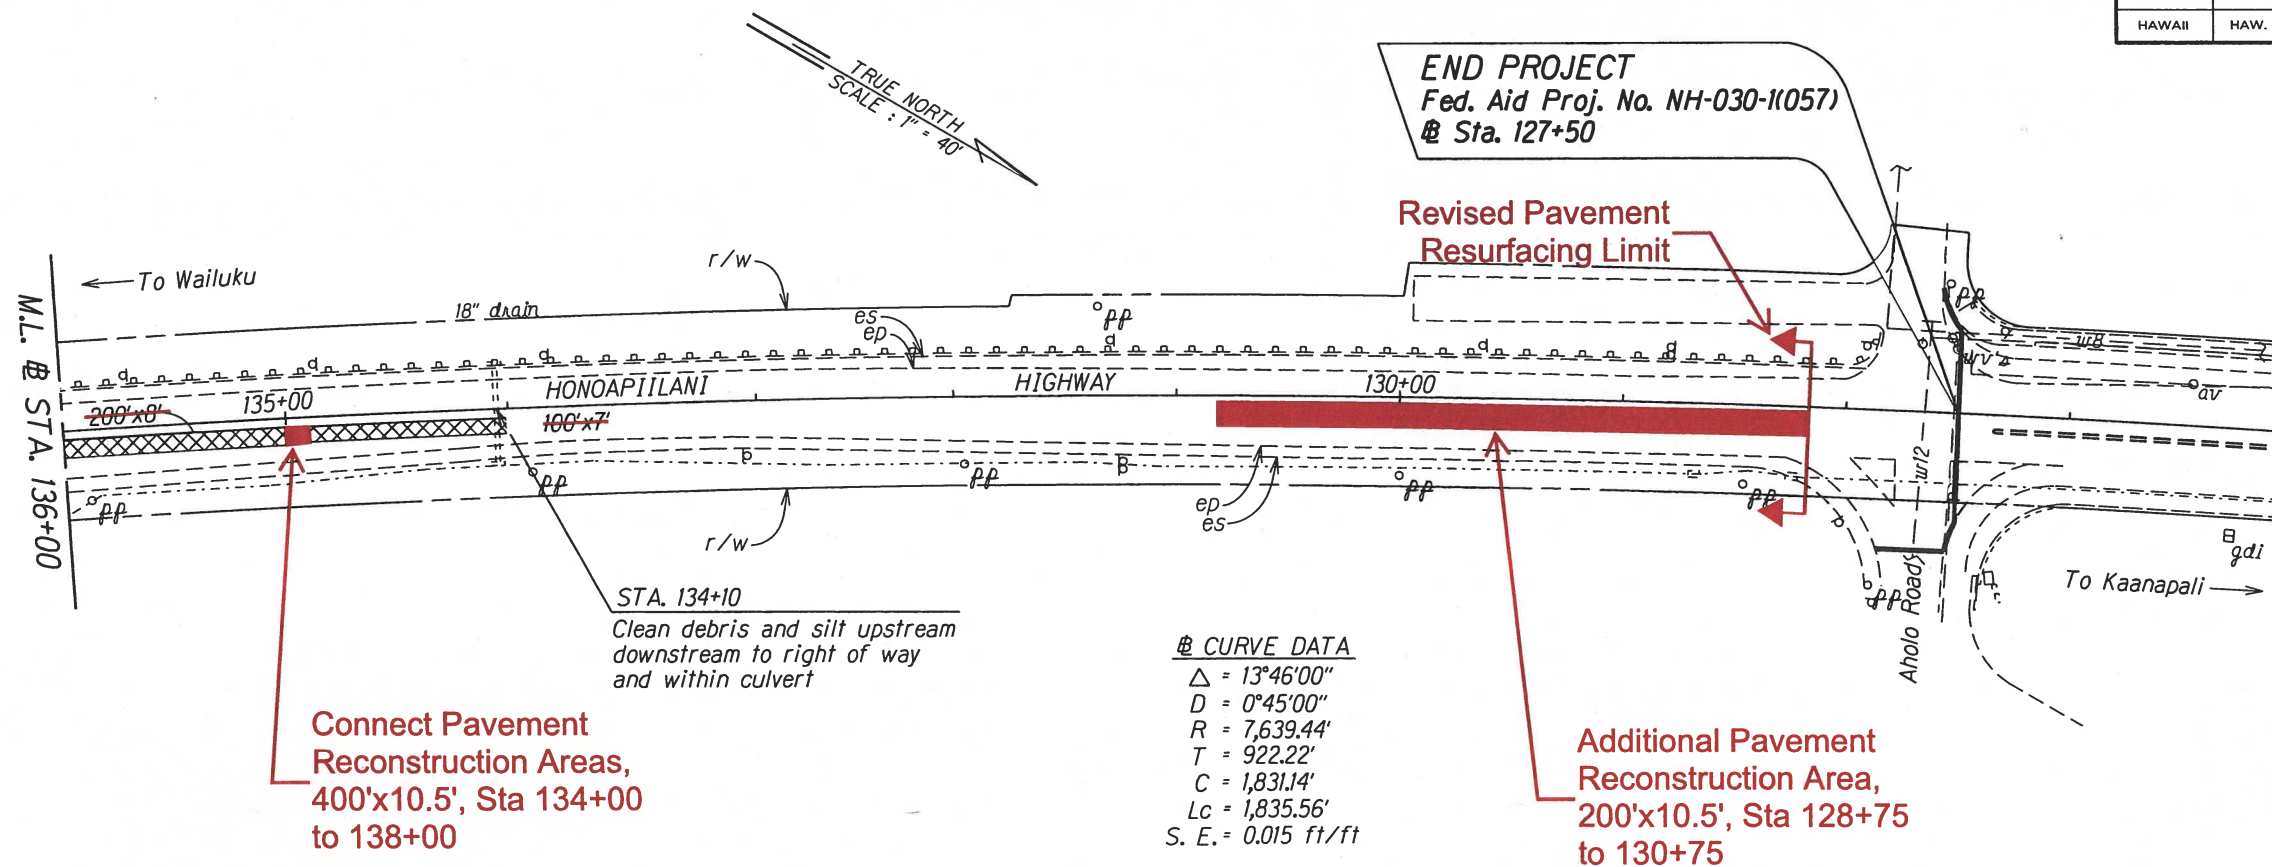

|                   |      |
|-------------------|------|
| SURVEY PLOTTED BY | DATE |
| DESIGNED BY       | 2/18 |
| DESIGNED BY       |      |
| QUANTITIES BY     |      |
| CHECKED BY        |      |
| ORIGINAL PLAN     |      |
| NOTE MADE         |      |
| DATE              |      |
| BY                |      |

STATE OF HAWAII  
DEPARTMENT OF TRANSPORTATION  
HIGHWAYS DIVISION

**ROADWAY PLAN**

HONOAPIʻILANI HIGHWAY RESURFACING  
Vicinity of Puamana Beach Park to Aholo Road  
Federal-Aid Project No. NH-030-1(057)

Scale: 1" = 40' Date: October, 2017

SHEET No. 3 OF 3 SHEETS

"AS-BUILT"