


FED. ROAD DIST. NO.	STATE	PROJ. NO.	FISCAL YEAR	SHEET NO.	TOTAL SHEETS
HAWAII	HAW.	HWY-M-06-19M	2020	6	14

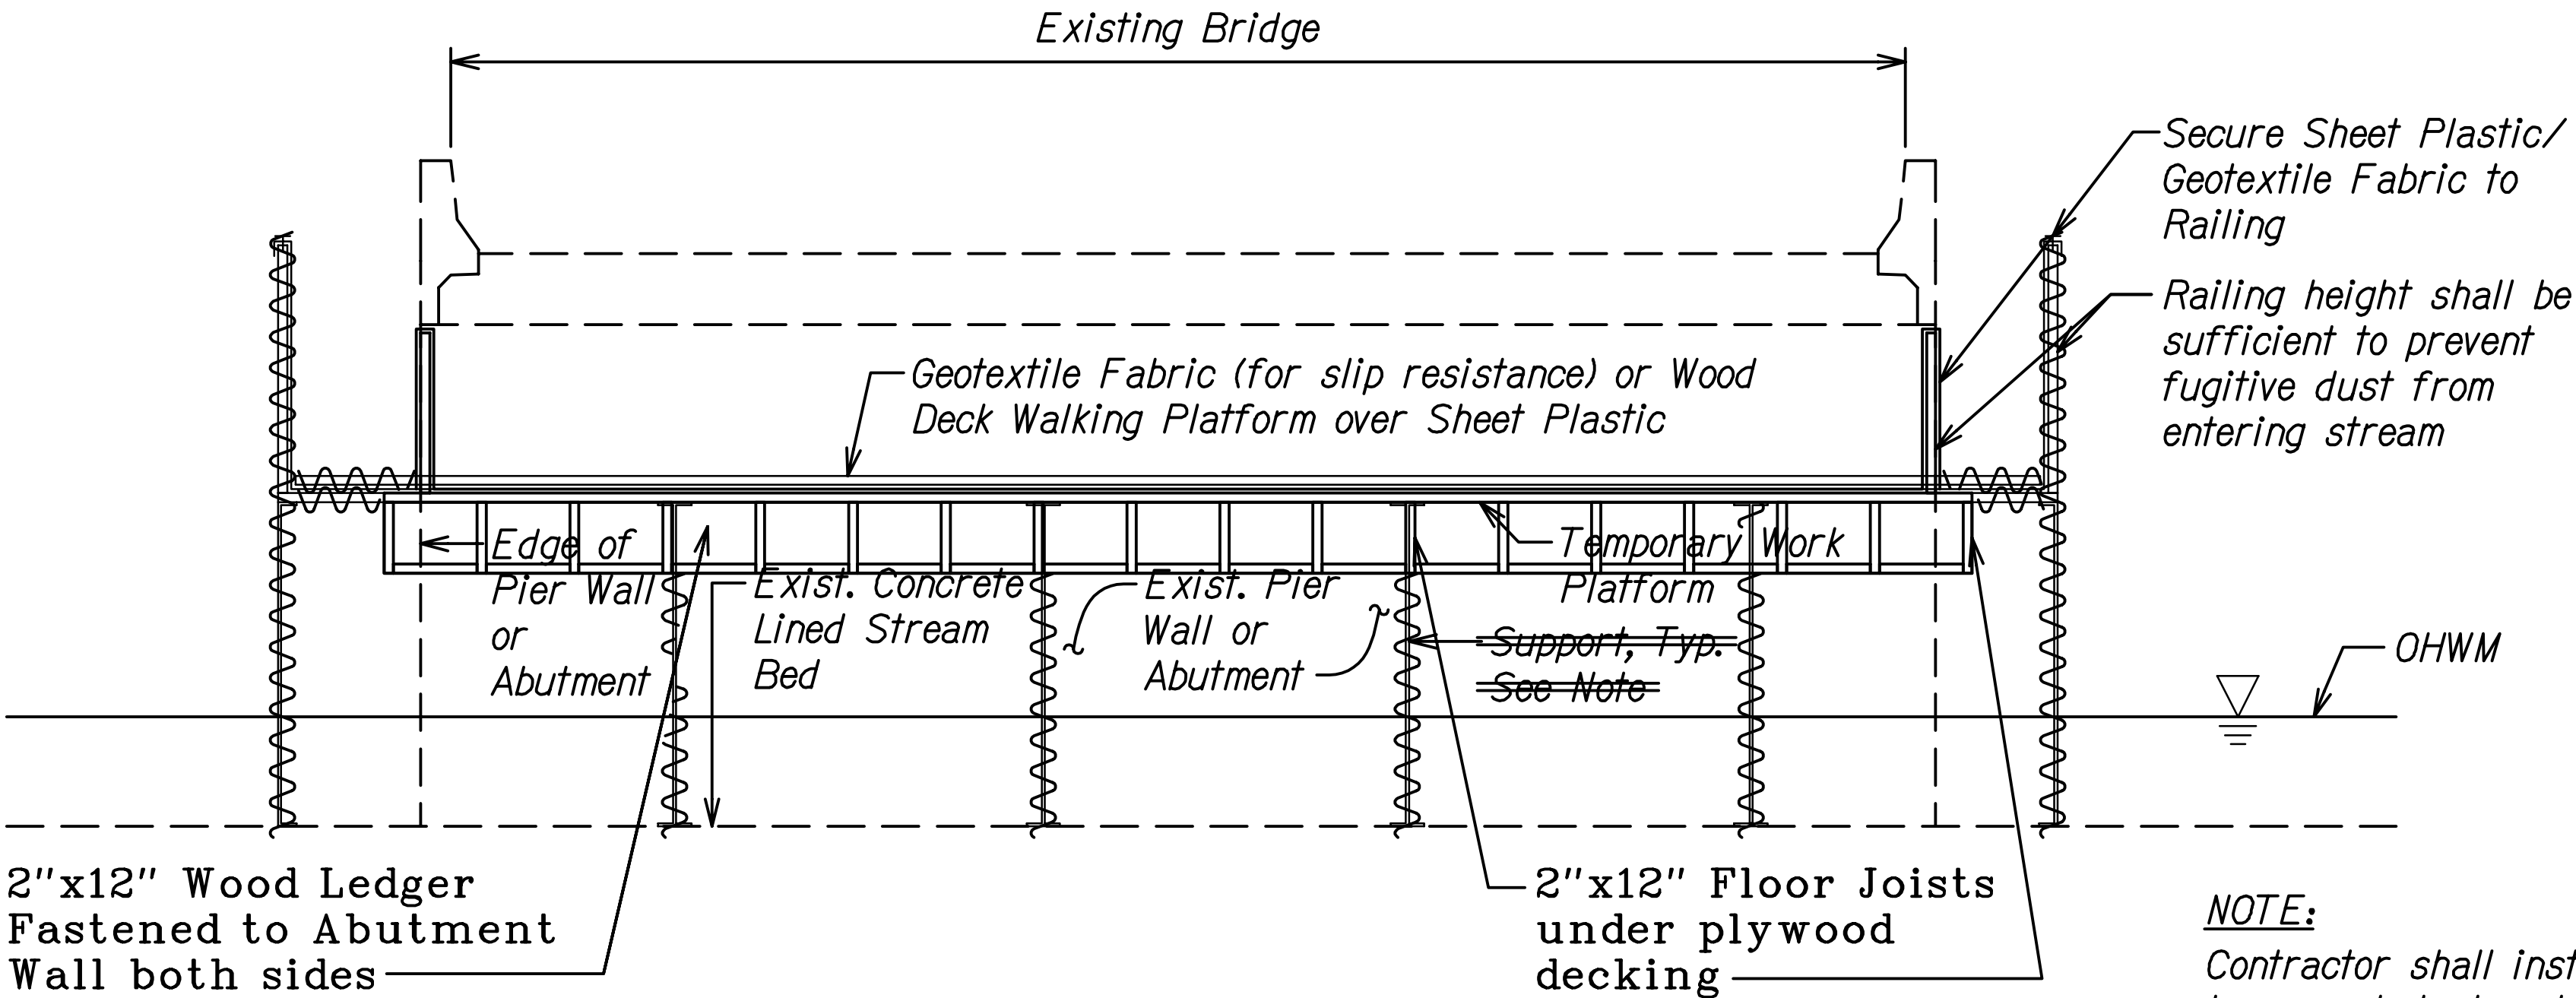


**PAPANAHOA STREAM BMP PLAN - SECTION VIEW**  
Scale: NTS

**NOTE:**  
Contractor shall install a debris containment device to prevent dust and construction debris from entering stream channel. Containment device and temporary work platform may be suspended by bridge structure above or by temporary supports in the stream bed. The work platform shall positioned above the ordinary high water mark of the stream. Payment for debris containment device and temporary work platform shall be included in Pay Item 209.0100.

LEGEND FOR AS-BUILT POSTINGS	
	Squiggly line for as-built deletion
	Double line for as-built deletion
Roadway	Text for as-built posting

DESIGNED BY	DATE
DRAWN BY	
CHECKED BY	
IN CHARGE BY	
NOTED BY	
REVISIONS	
1	
2	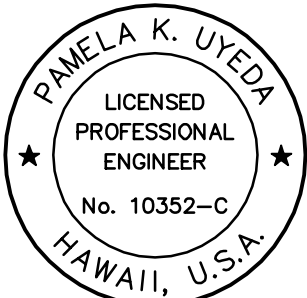
THIS WORK WAS PREPARED BY ME OR UNDER MY SUPERVISION.  
*Paul K. Uyeda* 04/30/20  
SIGNATURE EXPIRATION DATE OF THE LICENSE

STATE OF HAWAII  
DEPARTMENT OF TRANSPORTATION  
HIGHWAYS DIVISION

**PAPANAHOA STREAM  
BMP PLAN - SECTION VIEW**

**PAPANAHOA STREAM BRIDGE  
MAINTENANCE REPAIRS**  
Proj. No. HWY-M-06-19M

Scale: NTS Date: Dec. 2019

SHEET No. E-5 OF 5 SHEETS