	INDEX TO DRAWINGS
SHEET NO.	DESCRIPTION
1	TITLE SHEET
2	STANDARD PLANS SUMMARY
3	GENERAL NOTES AND LEGEND
4 – 5	TYPICAL SECTIONS AND DETAILS
6 – 23	ROADWAY PLANS
24	PAVEMENT MARKING LEGEND,
	DETAILS AND NOTES
25 – 42	SIGNING AND PAVEMENT
	MARKING PLANS
43 – 44	MISCELLANEOUS SUMMARIES
	·
	,
	·

STATE OF HAWAII

DEPARTMENT OF TRANSPORTATION

HIGHWAYS DIVISION HONOLULU, HAWAII

MAS-BURY


PLANS FOR

HONOAPIILANI HIGHWAY RESURFACING

VICINITY OF MCGREGOR POINT TO OLOWALU PROJECT NO. HWY-M-01-99M

DISTRICTS OF LAHAINA AND WAILUKU ISLAND OF MAUI

PROJECT LIMITS

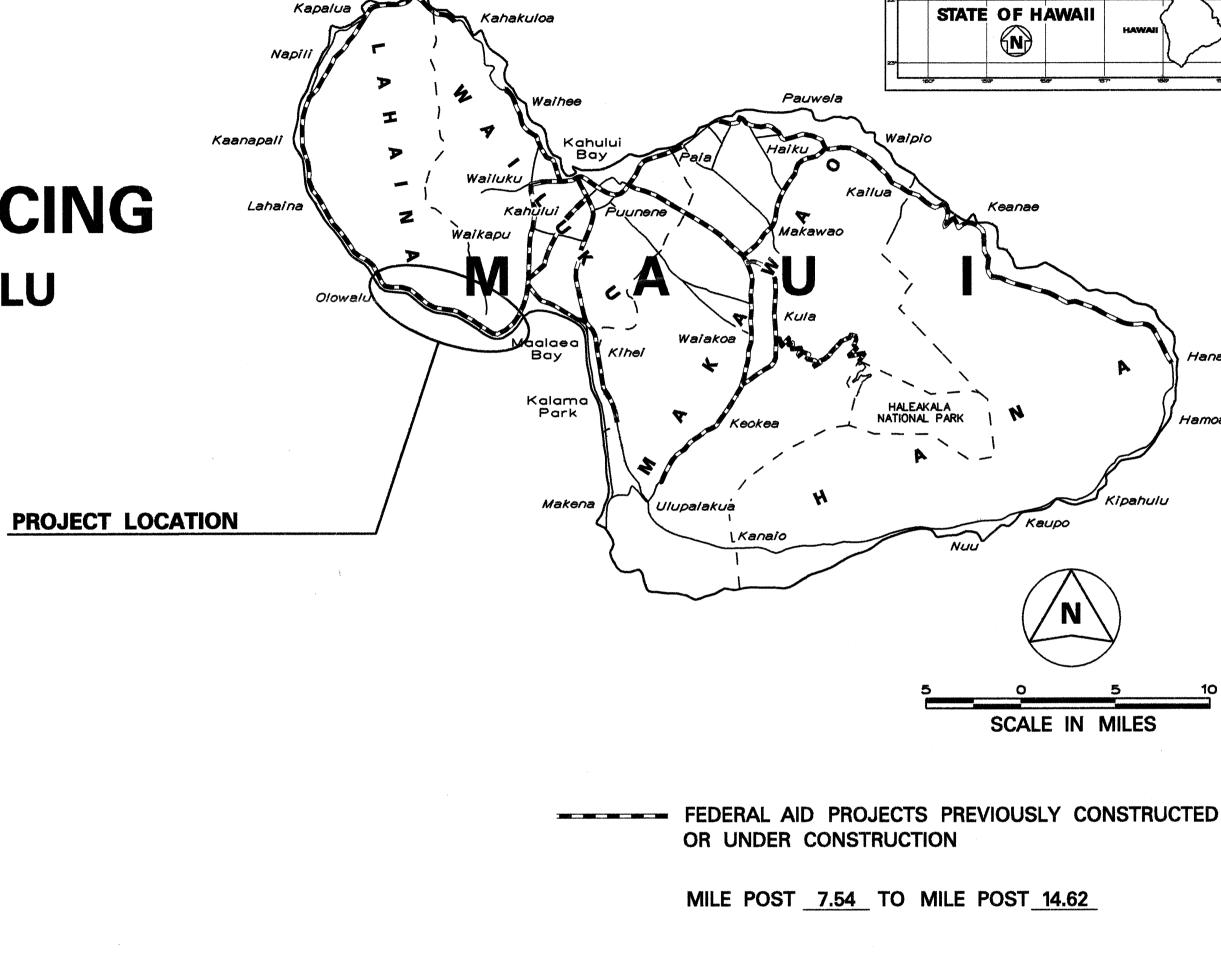

FED. ROAD DIST. NO.

STATE

HAW. HWY-M-01-99M 1999

Papawal Pt.

McGregor Point

Harbor
Small Boat
Maslace

A CE HUN IS GA - ON TOWN IN TO

SCALE IN MILES

NET LENGTH OF PROJECT..... 7.08 MILES

CHANGES MADE DURING CONSTRUCTION HAVE BEEN INCORPORATED ON THESE PLANS EXCEPT CHANGES IN THE ORIGINAL THEORETICAL QUANTITIES. FOR ACTUAL QUANTITIES, REFER TO PROJECT LEDGER AND/OR COMPUTATION BOOK.

DEPARTMENT OF TRANSPORTATION STATE OF HAWAII
APPROVED:

DIR. OF TRANSPORTATION

illilisiii.agiiz jay

DATE