



|               |                   |          |
|---------------|-------------------|----------|
| ORIGINAL PLAN | SURVEY PLOTTED BY | DATE     |
| NOTE BOOK     | DRAWN BY          | 11/15/01 |
| QUANTITIES BY | DESIGNED BY       |          |
| CHECKED BY    |                   |          |



|                     |       |                    |             |           |              |
|---------------------|-------|--------------------|-------------|-----------|--------------|
| FED. ROAD DIST. NO. | STATE | FED. AID PROJ. NO. | FISCAL YEAR | SHEET NO. | TOTAL SHEETS |
| HAWAII              | HAW.  | NH-030-1(128)      | 2002        | 50        | 72           |

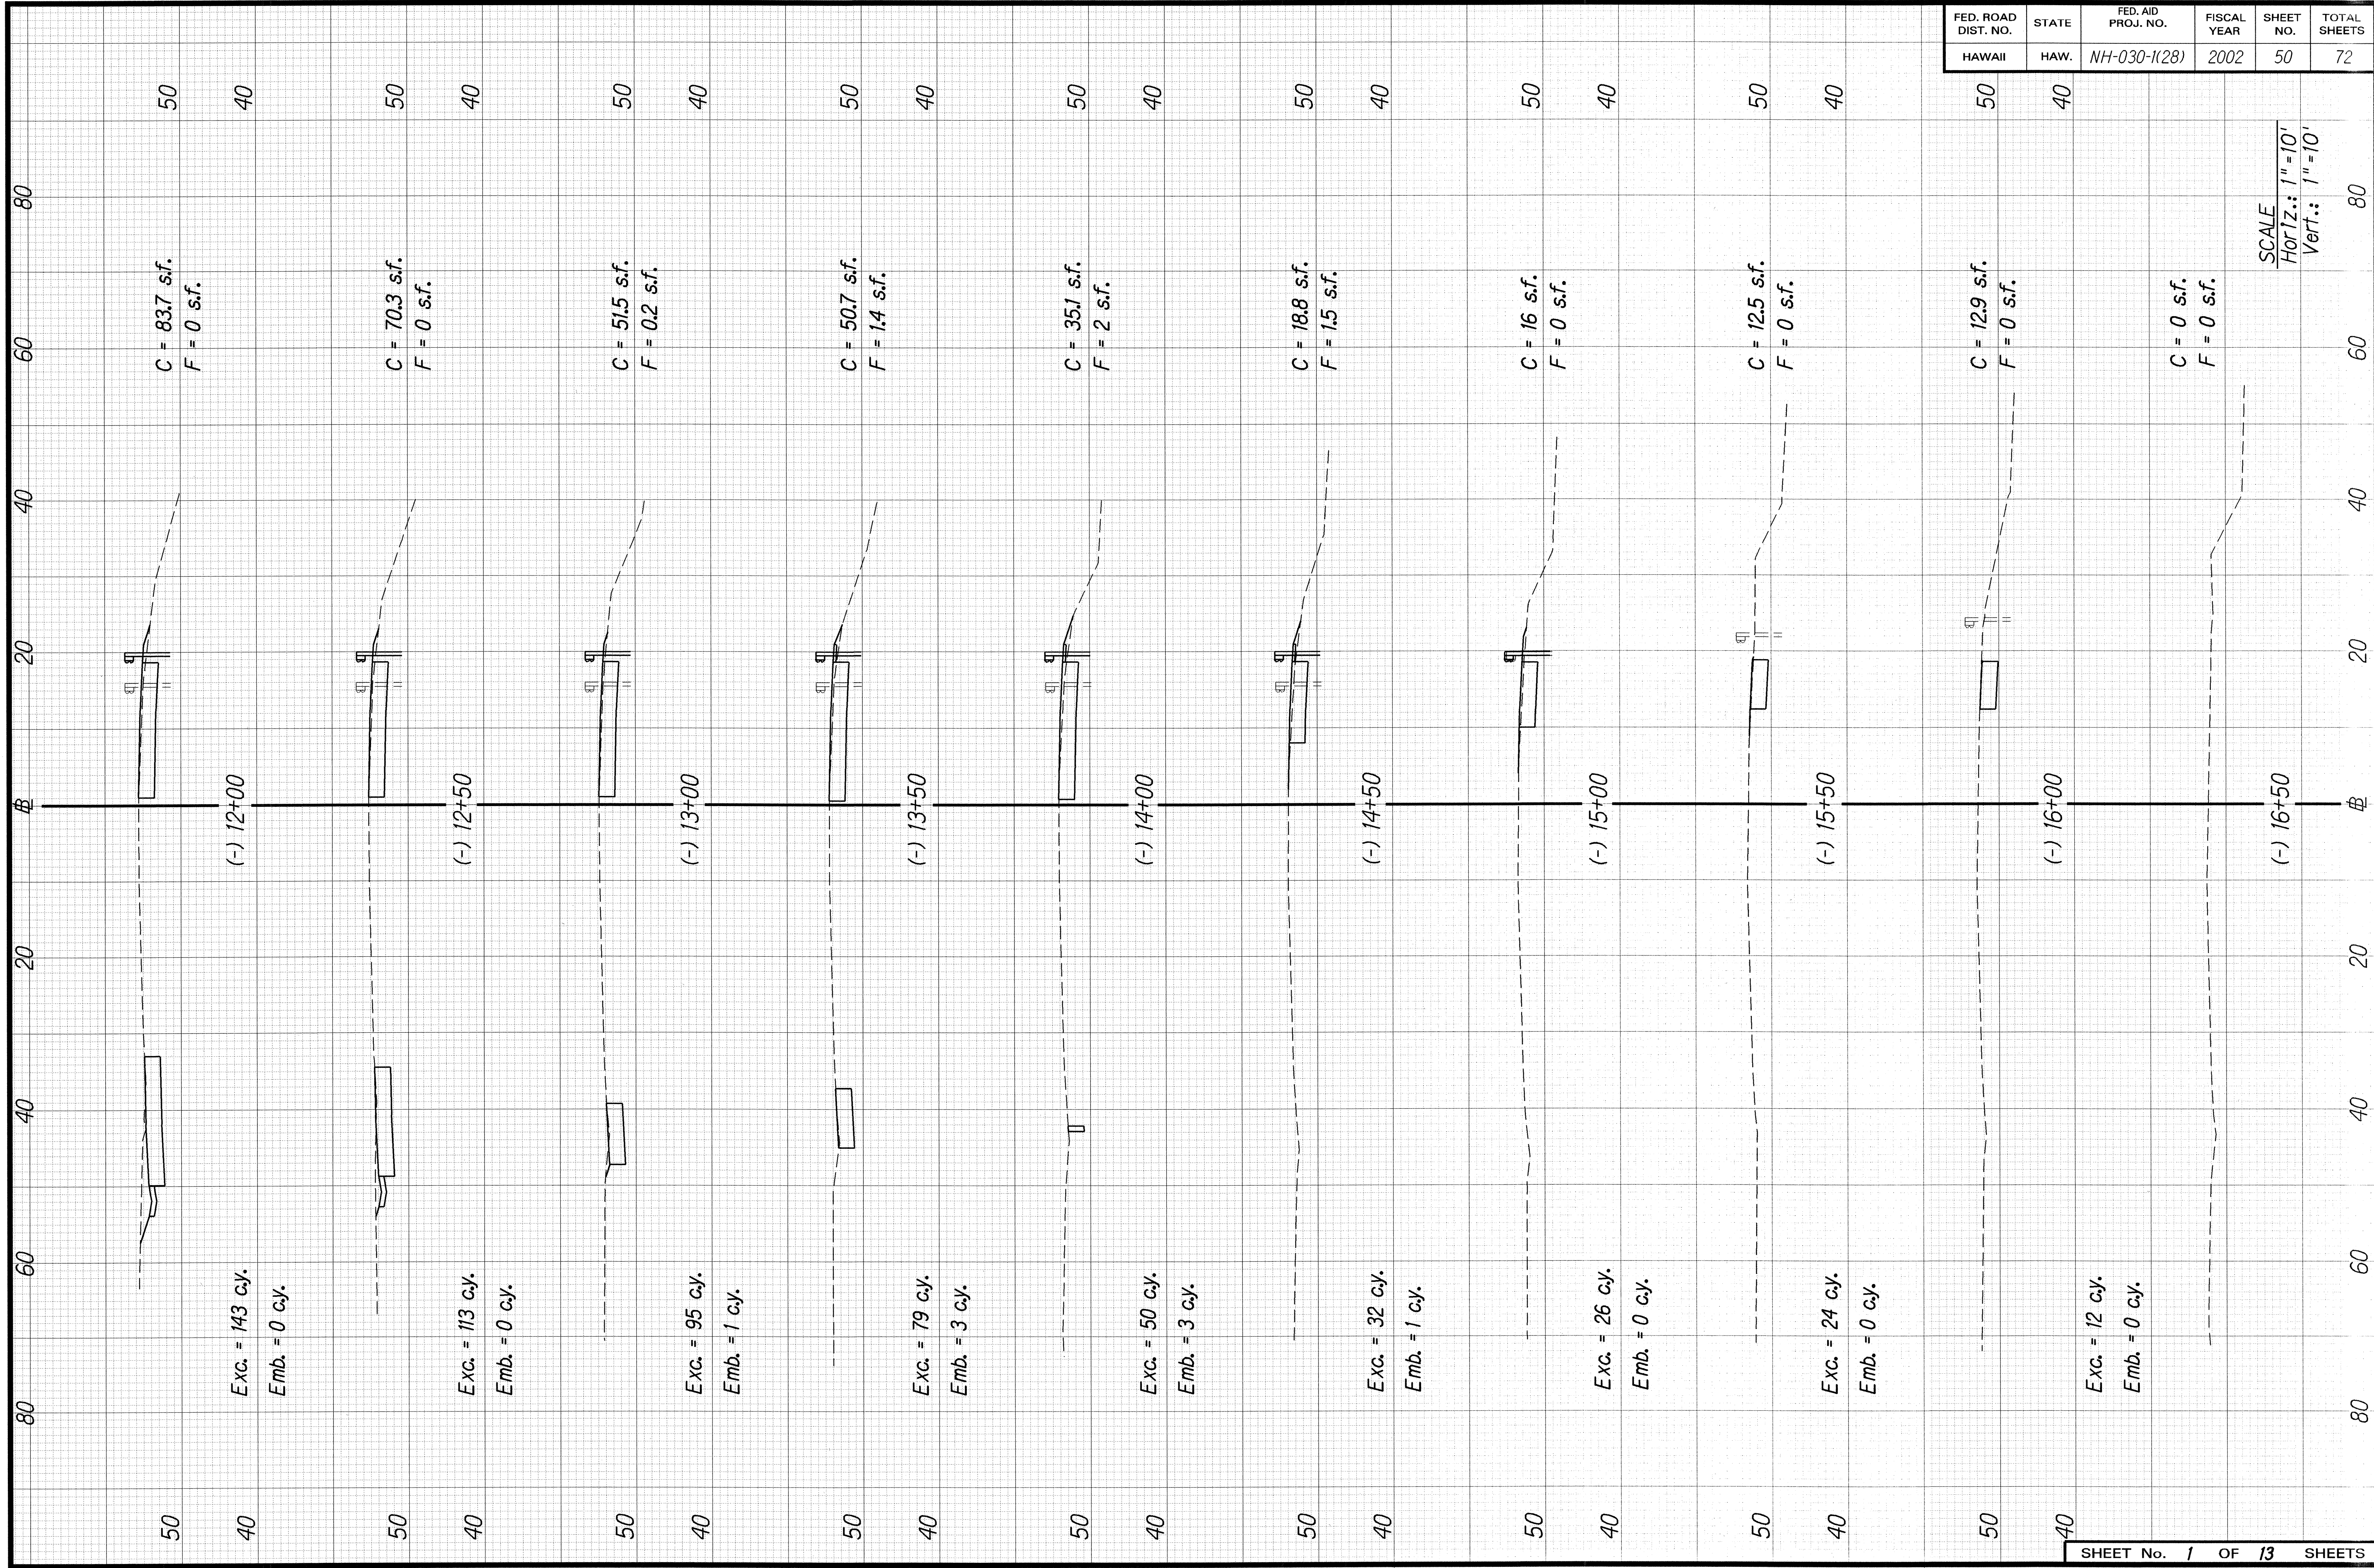


|               |                   |          |
|---------------|-------------------|----------|
| ORIGINAL PLAN | SURVEY PLOTTED BY | DATE     |
| NOTE BOOK     | DRAWN BY          | 11/15/50 |
| QUANTITIES BY | DESIGNED BY       |          |
| CHECKED BY    | CHECKED BY        |          |

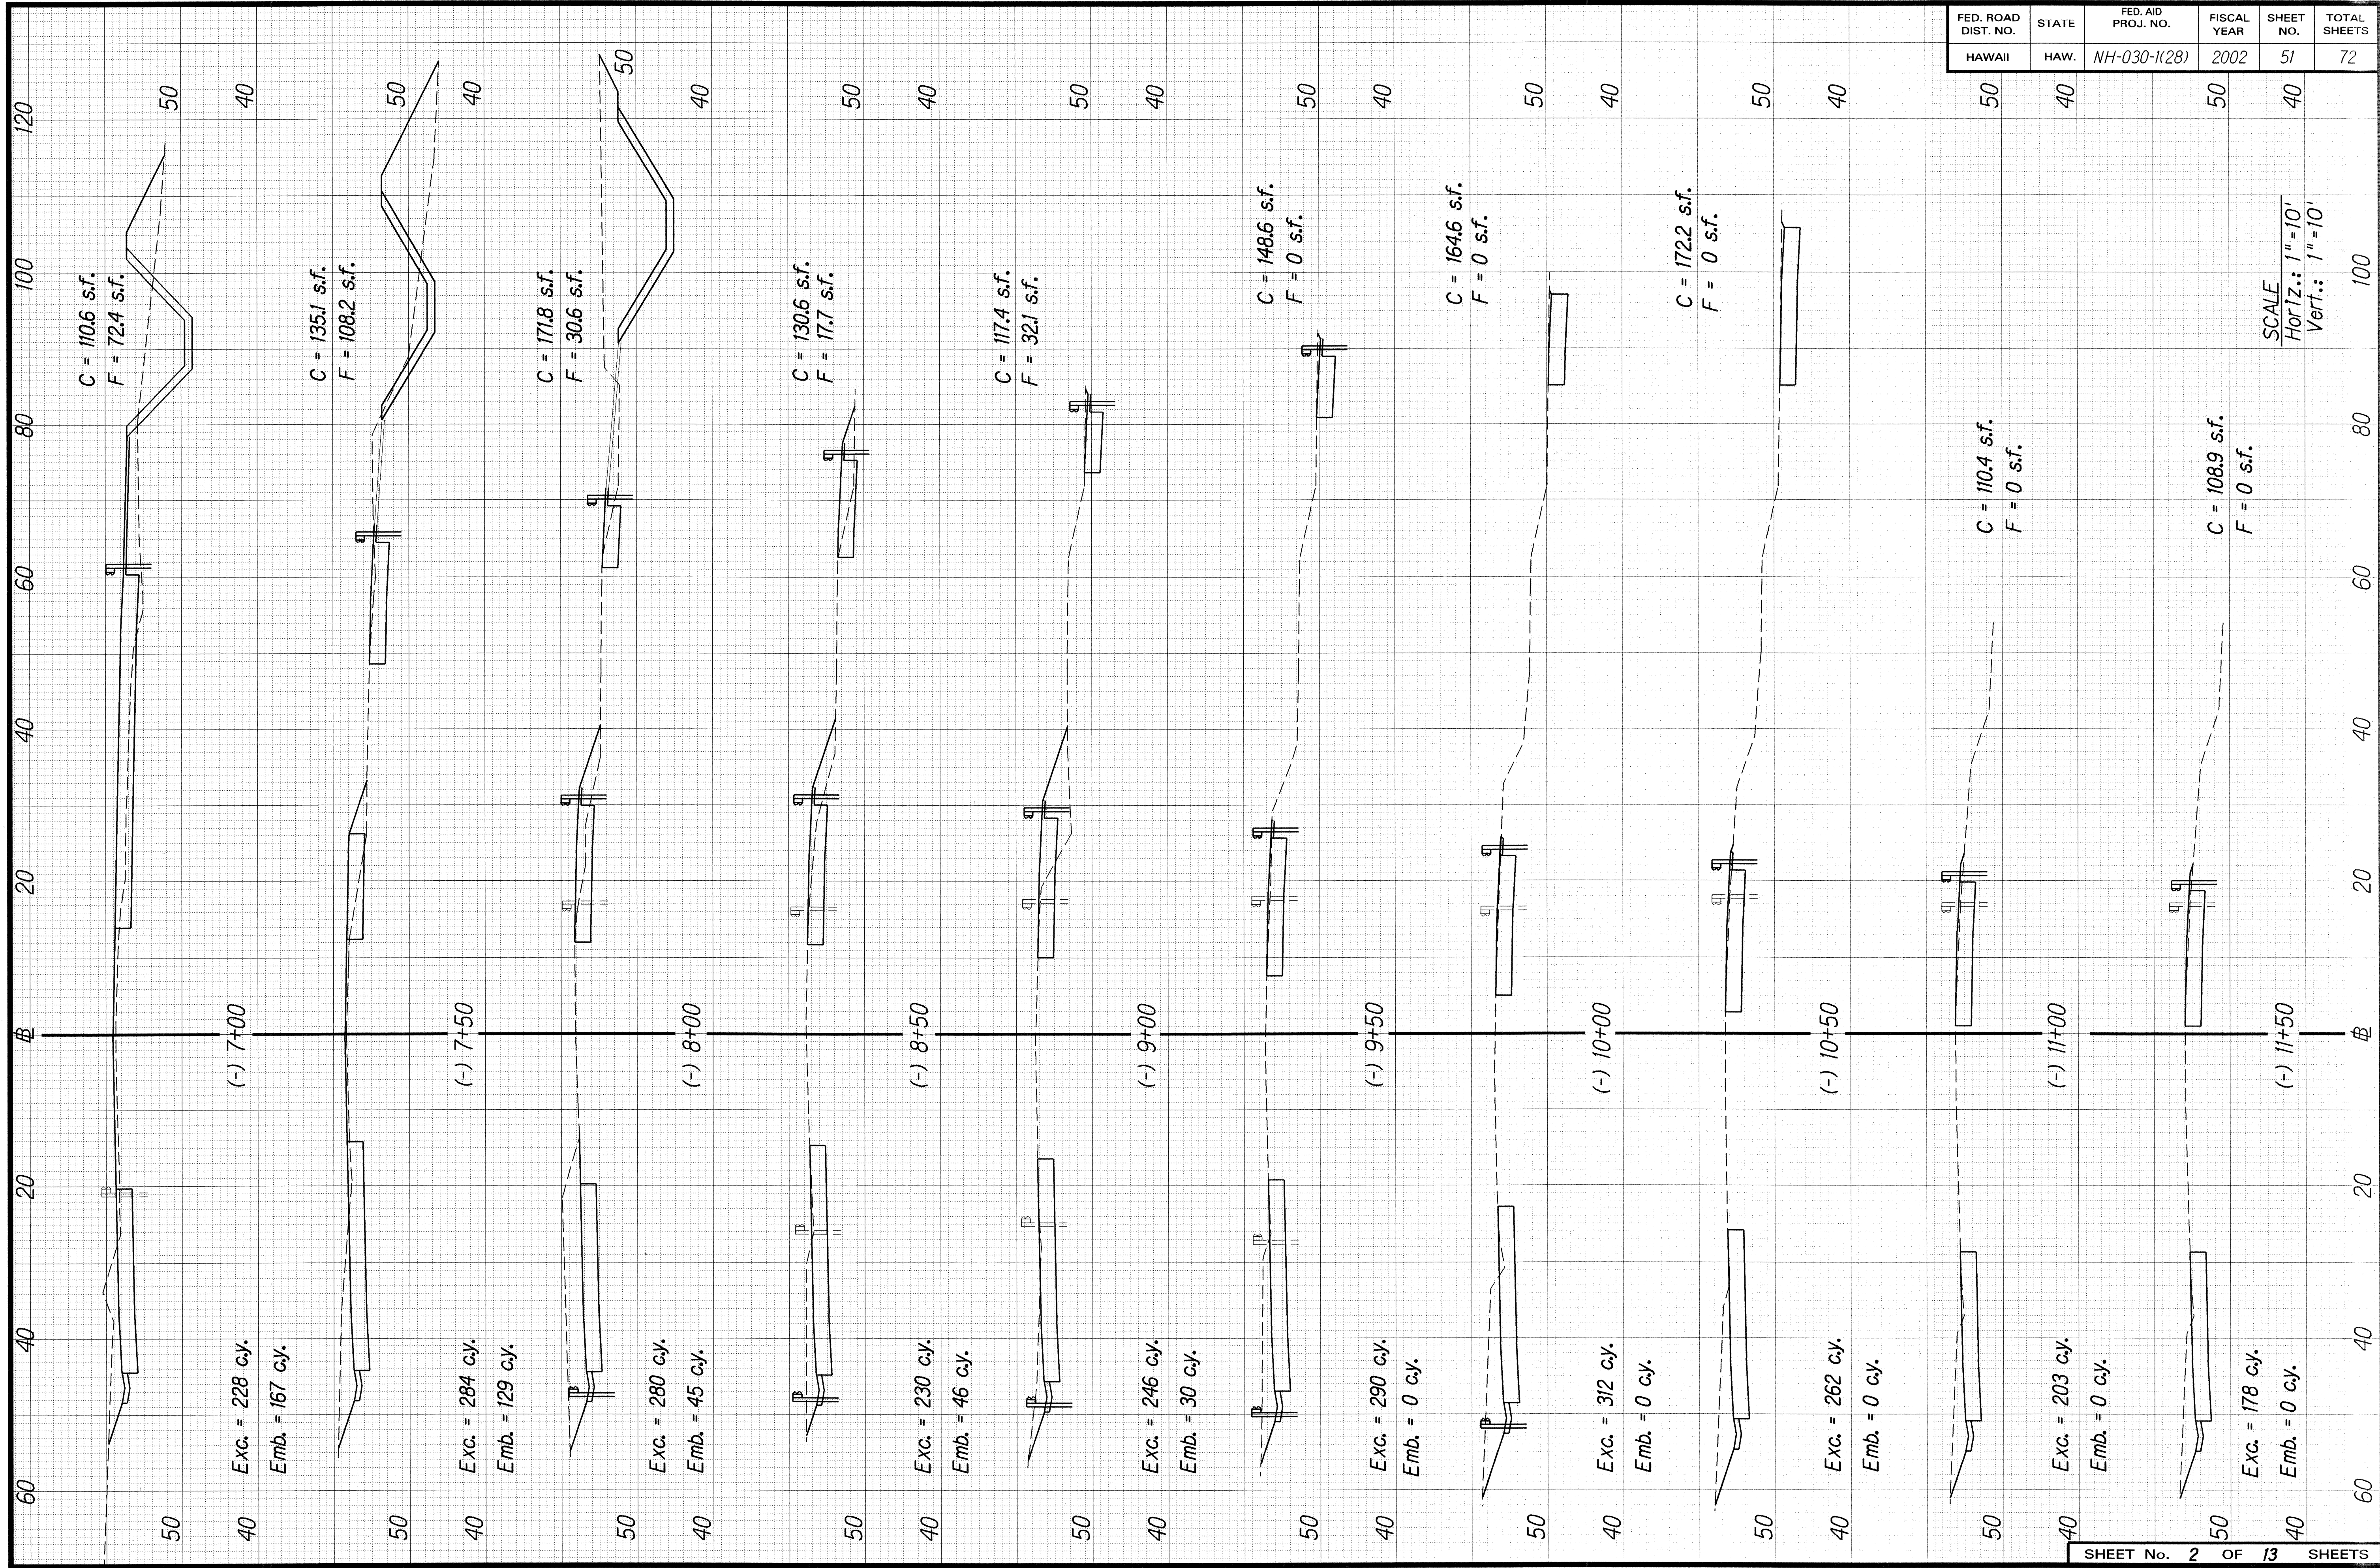




|                   |                         |            |
|-------------------|-------------------------|------------|
| ORIGINAL PLAN     | SURVEY PLOTTED BY _____ | DATE _____ |
|                   | DRAWN BY <u>GA</u>      |            |
|                   | TRACED BY _____         |            |
| NOTE BOOK         | DESIGNED BY <u>GA</u>   |            |
| <u>adfgorge</u>   | QUANTITIES BY _____     |            |
| <u>Napondrs03</u> | CHECKED BY _____        |            |

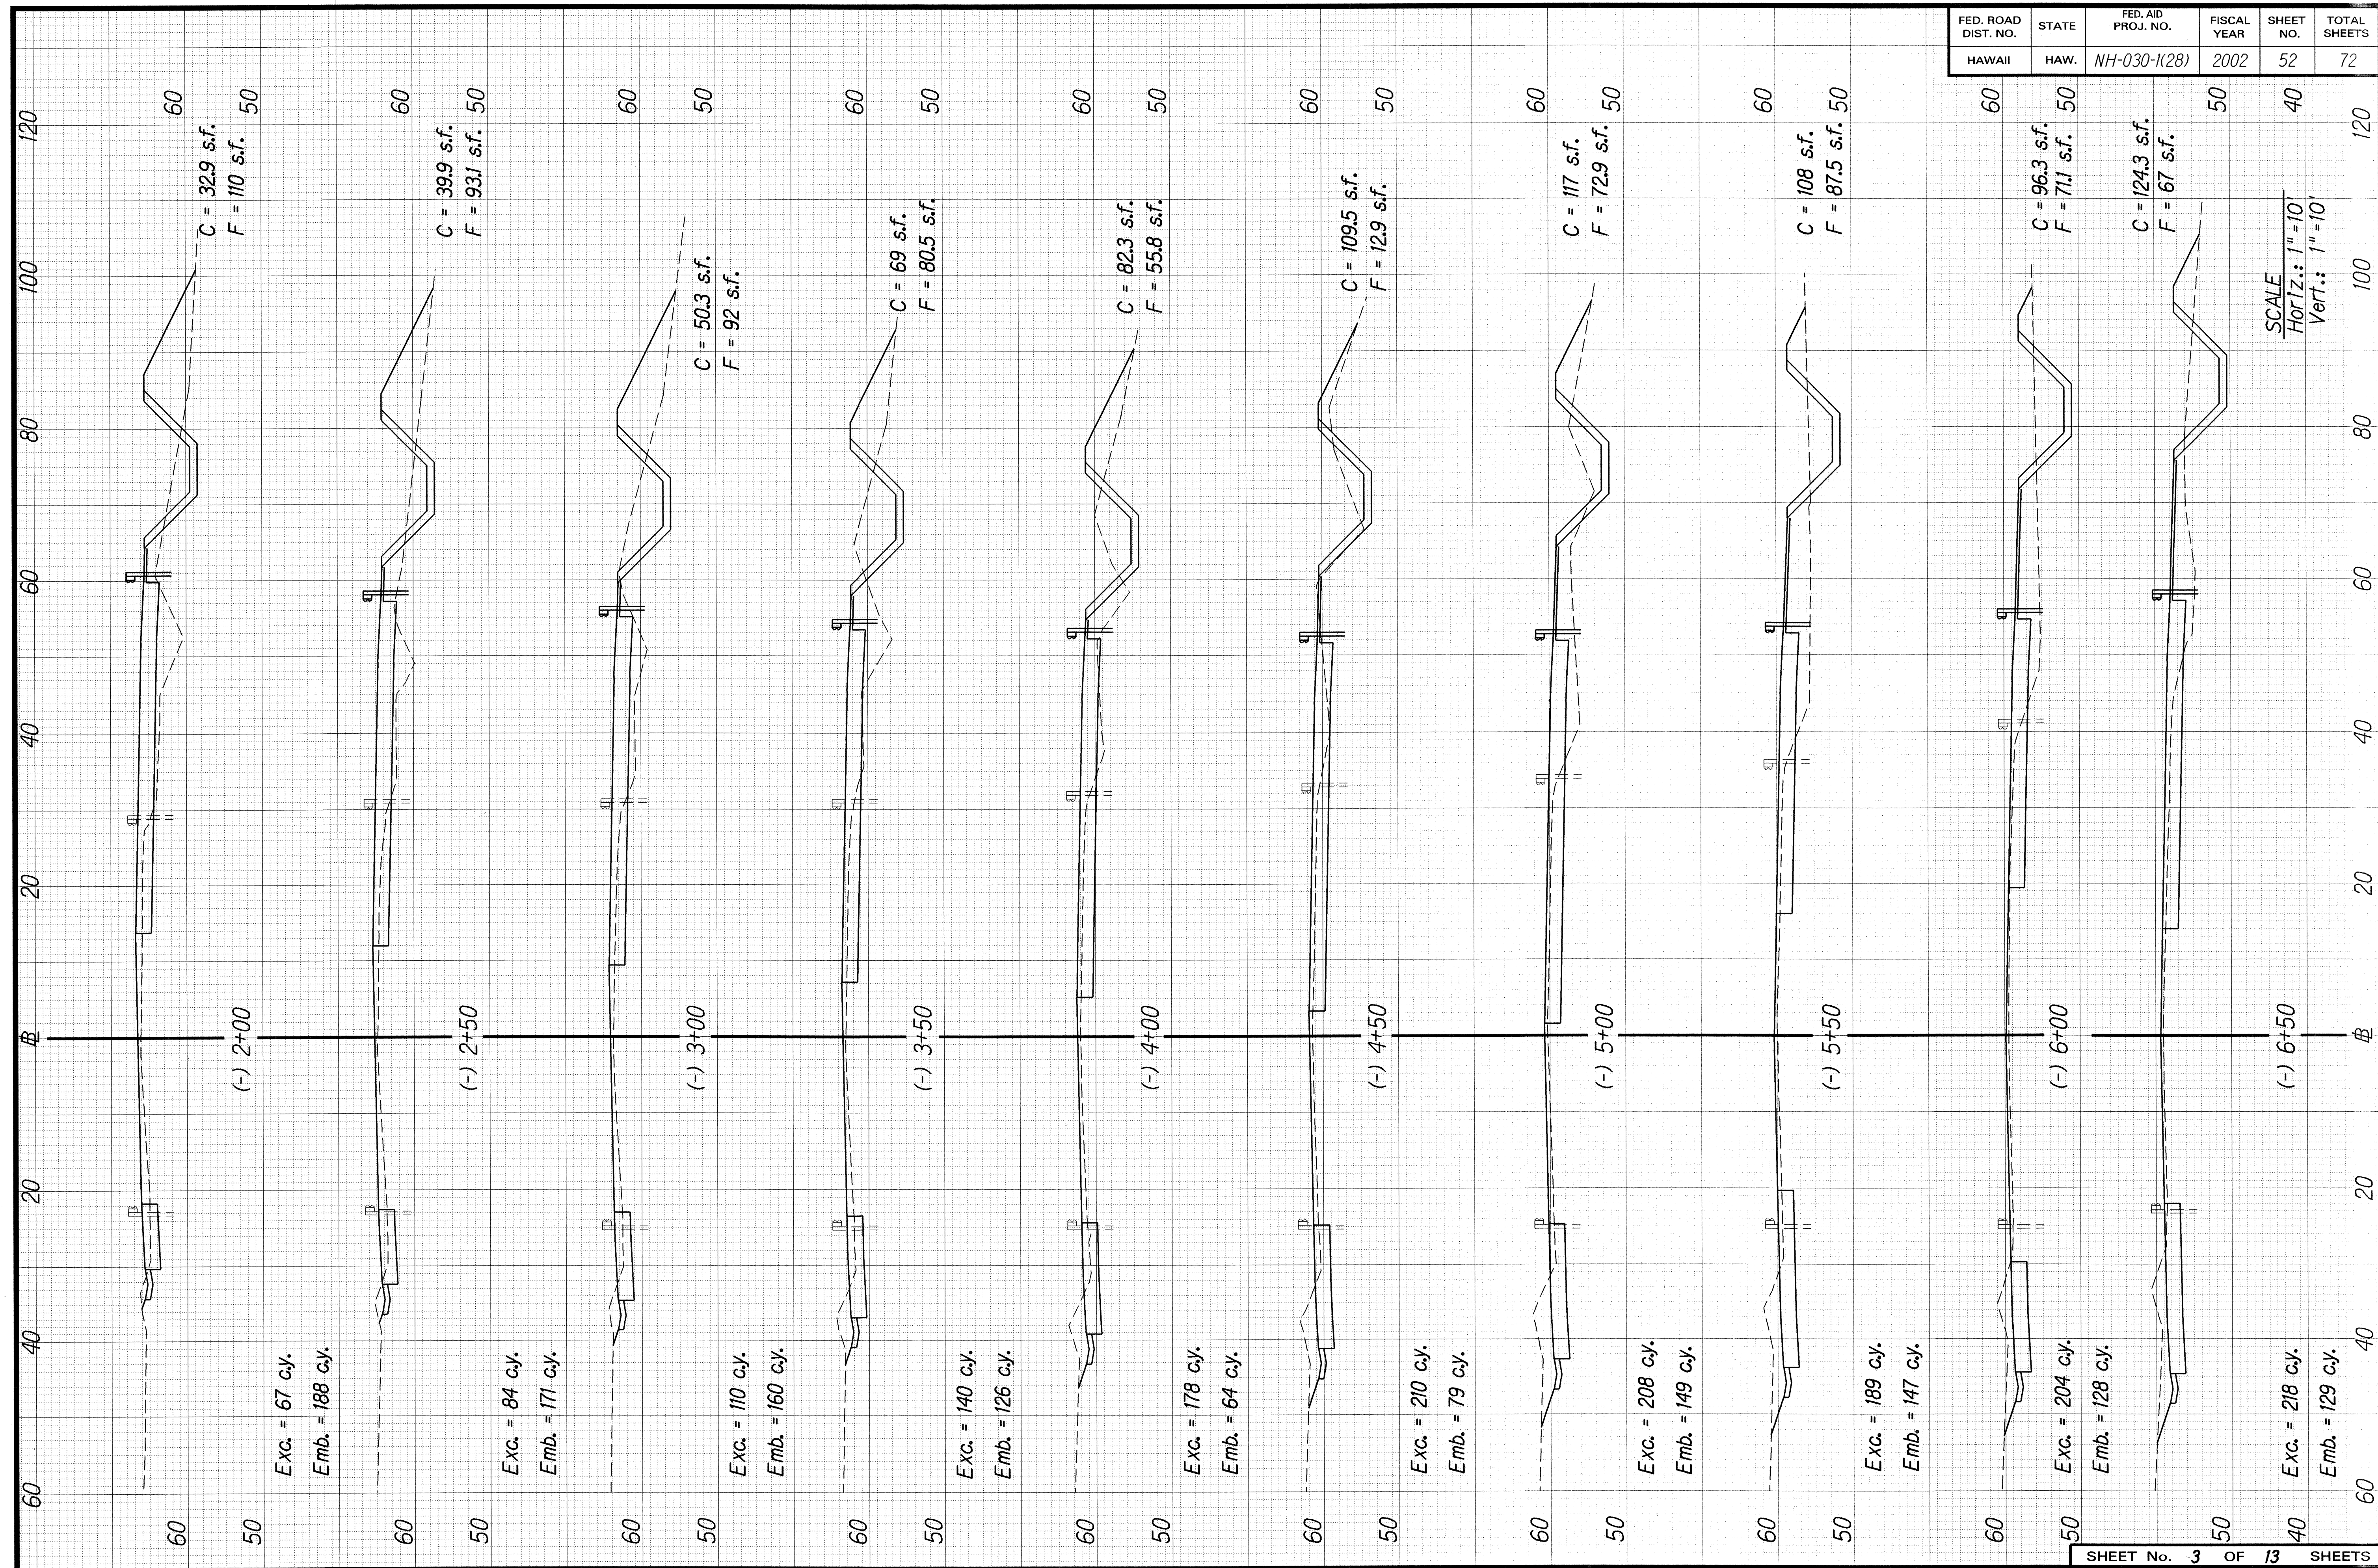



|               |                   |         |
|---------------|-------------------|---------|
| ORIGINAL PLAN | SURVEY PLOTTED BY | DATE    |
| NOTE BOOK     | DRAWN BY          | 4/10/57 |
| DESIGNED BY   | CHECKED BY        |         |
| QUANTITIES BY |                   |         |
| CHECKED BY    |                   |         |

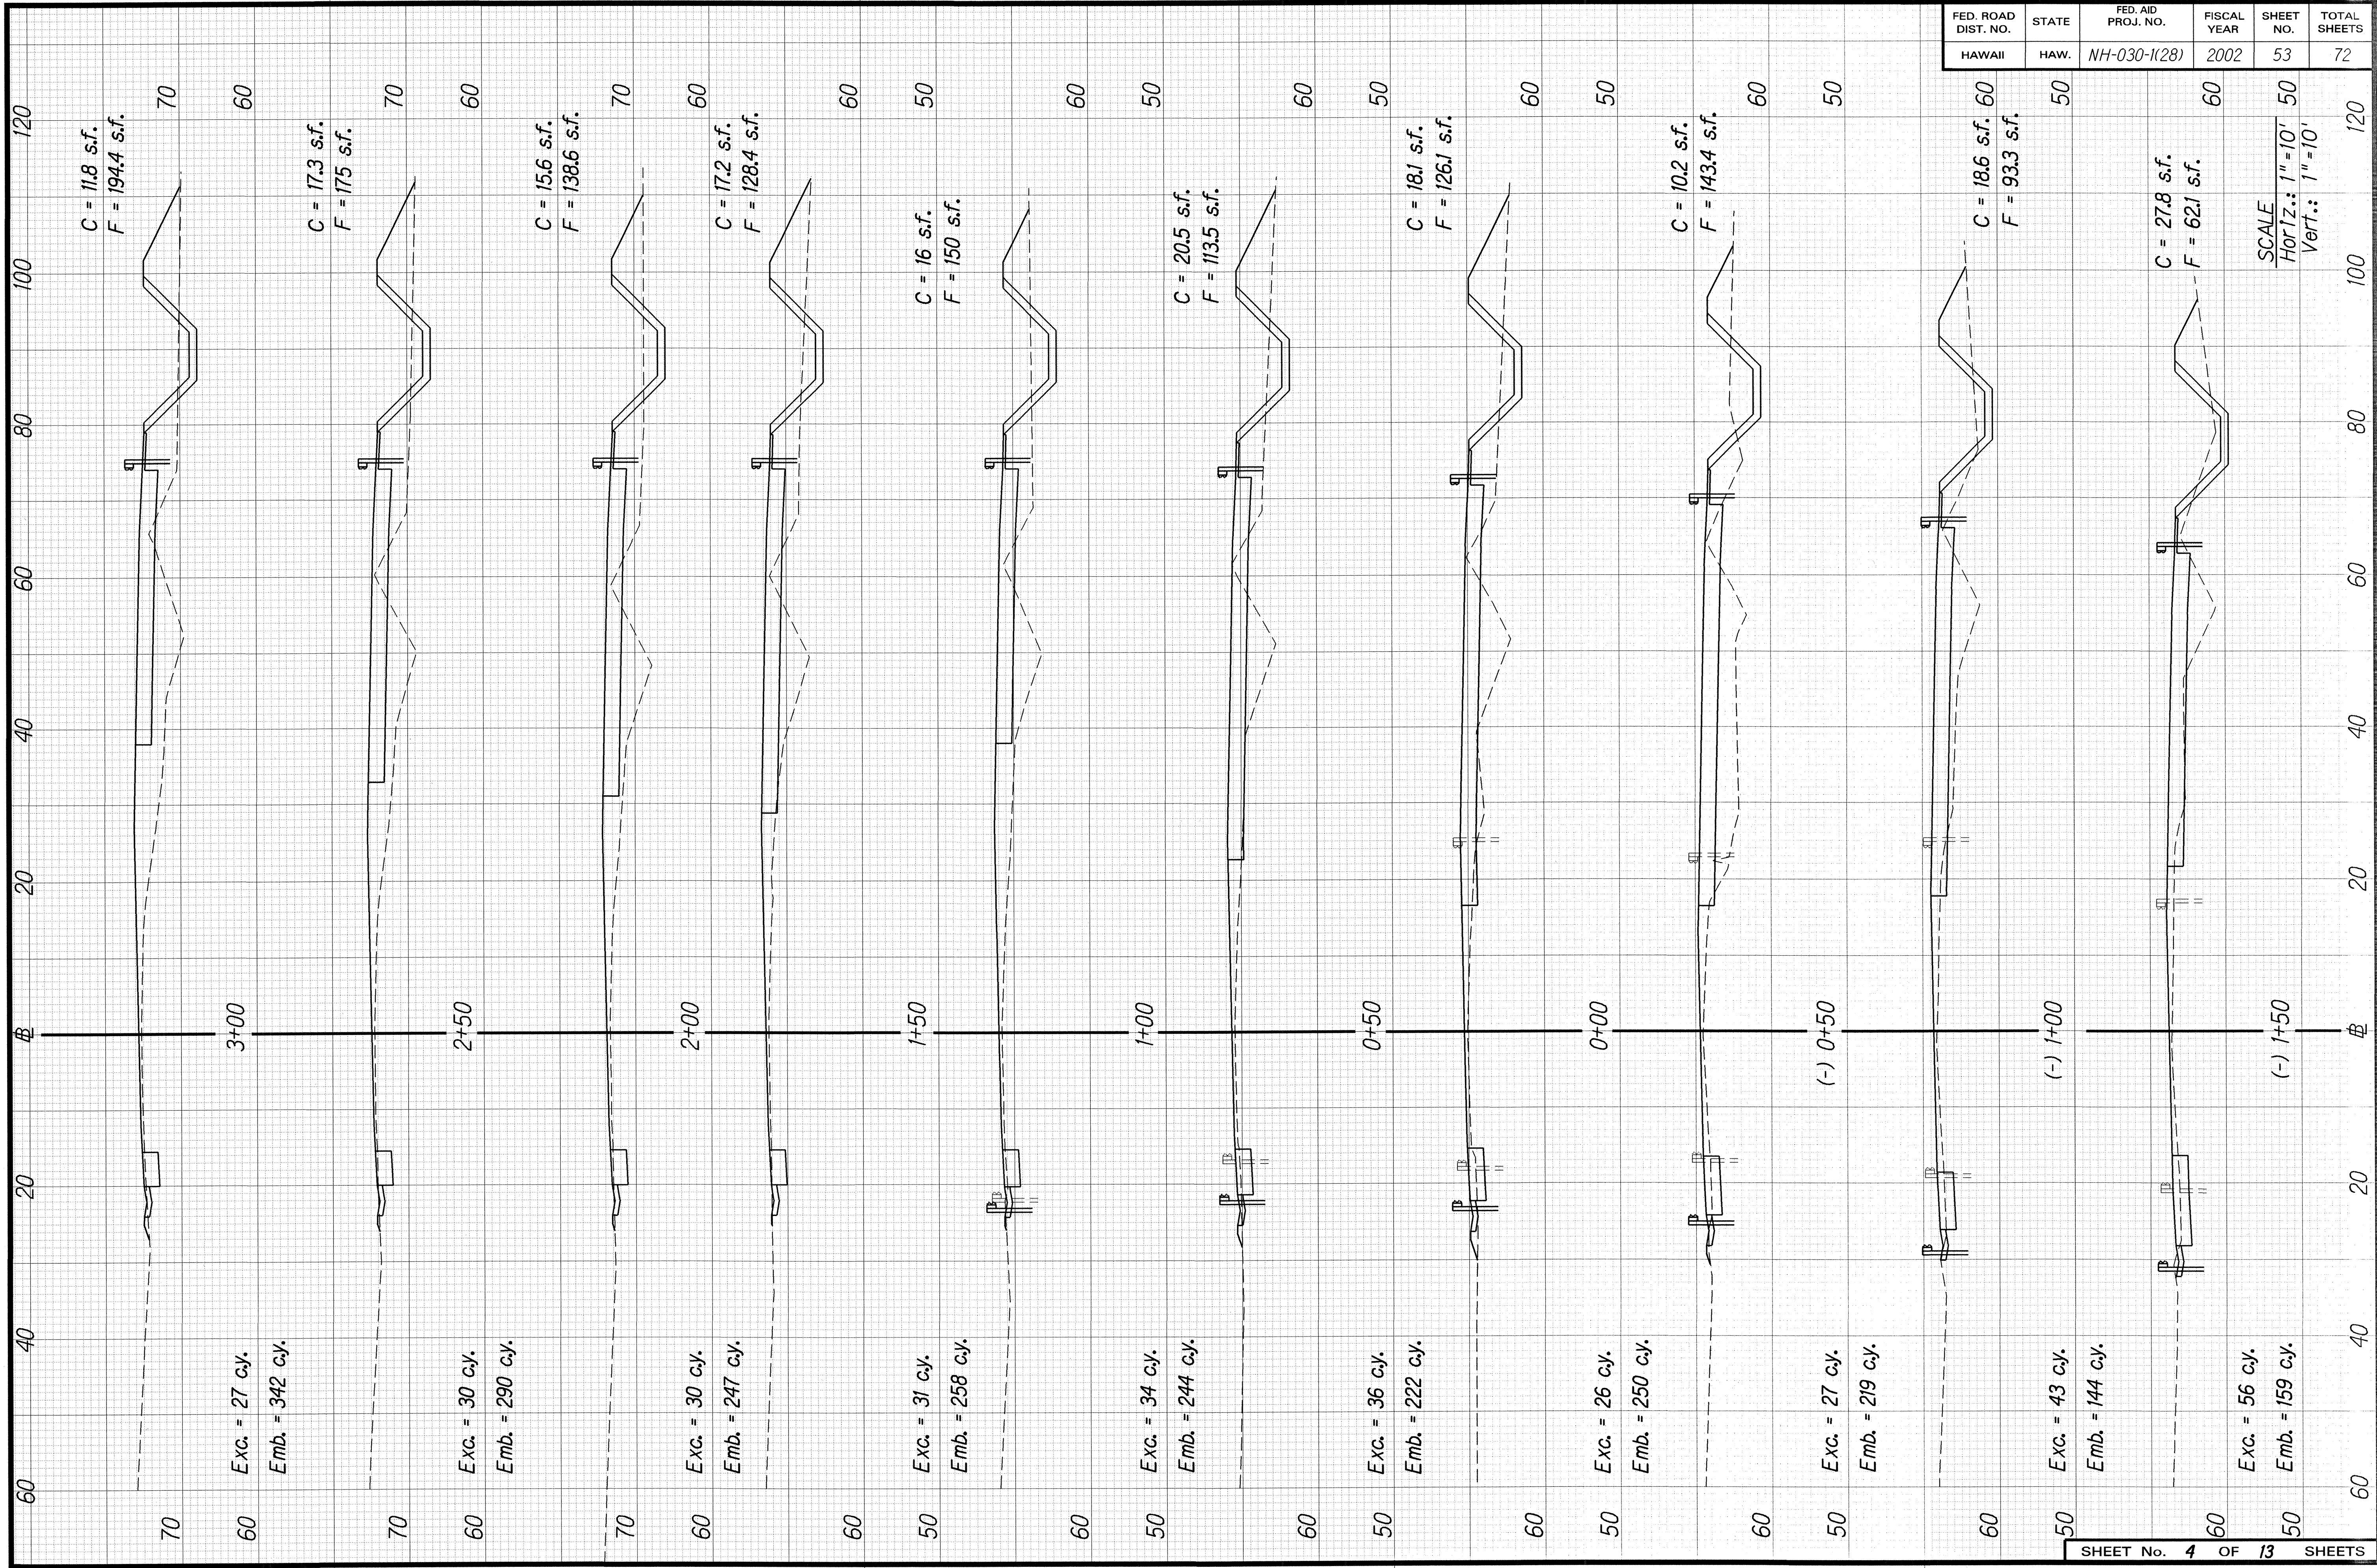


|                     |       |                    |             |           |              |
|---------------------|-------|--------------------|-------------|-----------|--------------|
| FED. ROAD DIST. NO. | STATE | FED. AID PROJ. NO. | FISCAL YEAR | SHEET NO. | TOTAL SHEETS |
| HAWAII              | HAW.  | NH-030-1(28)       | 2002        | 53        | 72           |

SCALE  
Horiz.: 1"=10'  
Vert.: 1"=10'



|               |                   |         |
|---------------|-------------------|---------|
| ORIGINAL PLAN | SURVEY PLOTTED BY | DATE    |
| NOTE BOOK     | DRAWN BY          | 4/10/50 |
| QUANTITIES BY | DESIGNED BY       |         |
| CHECKED BY    |                   |         |

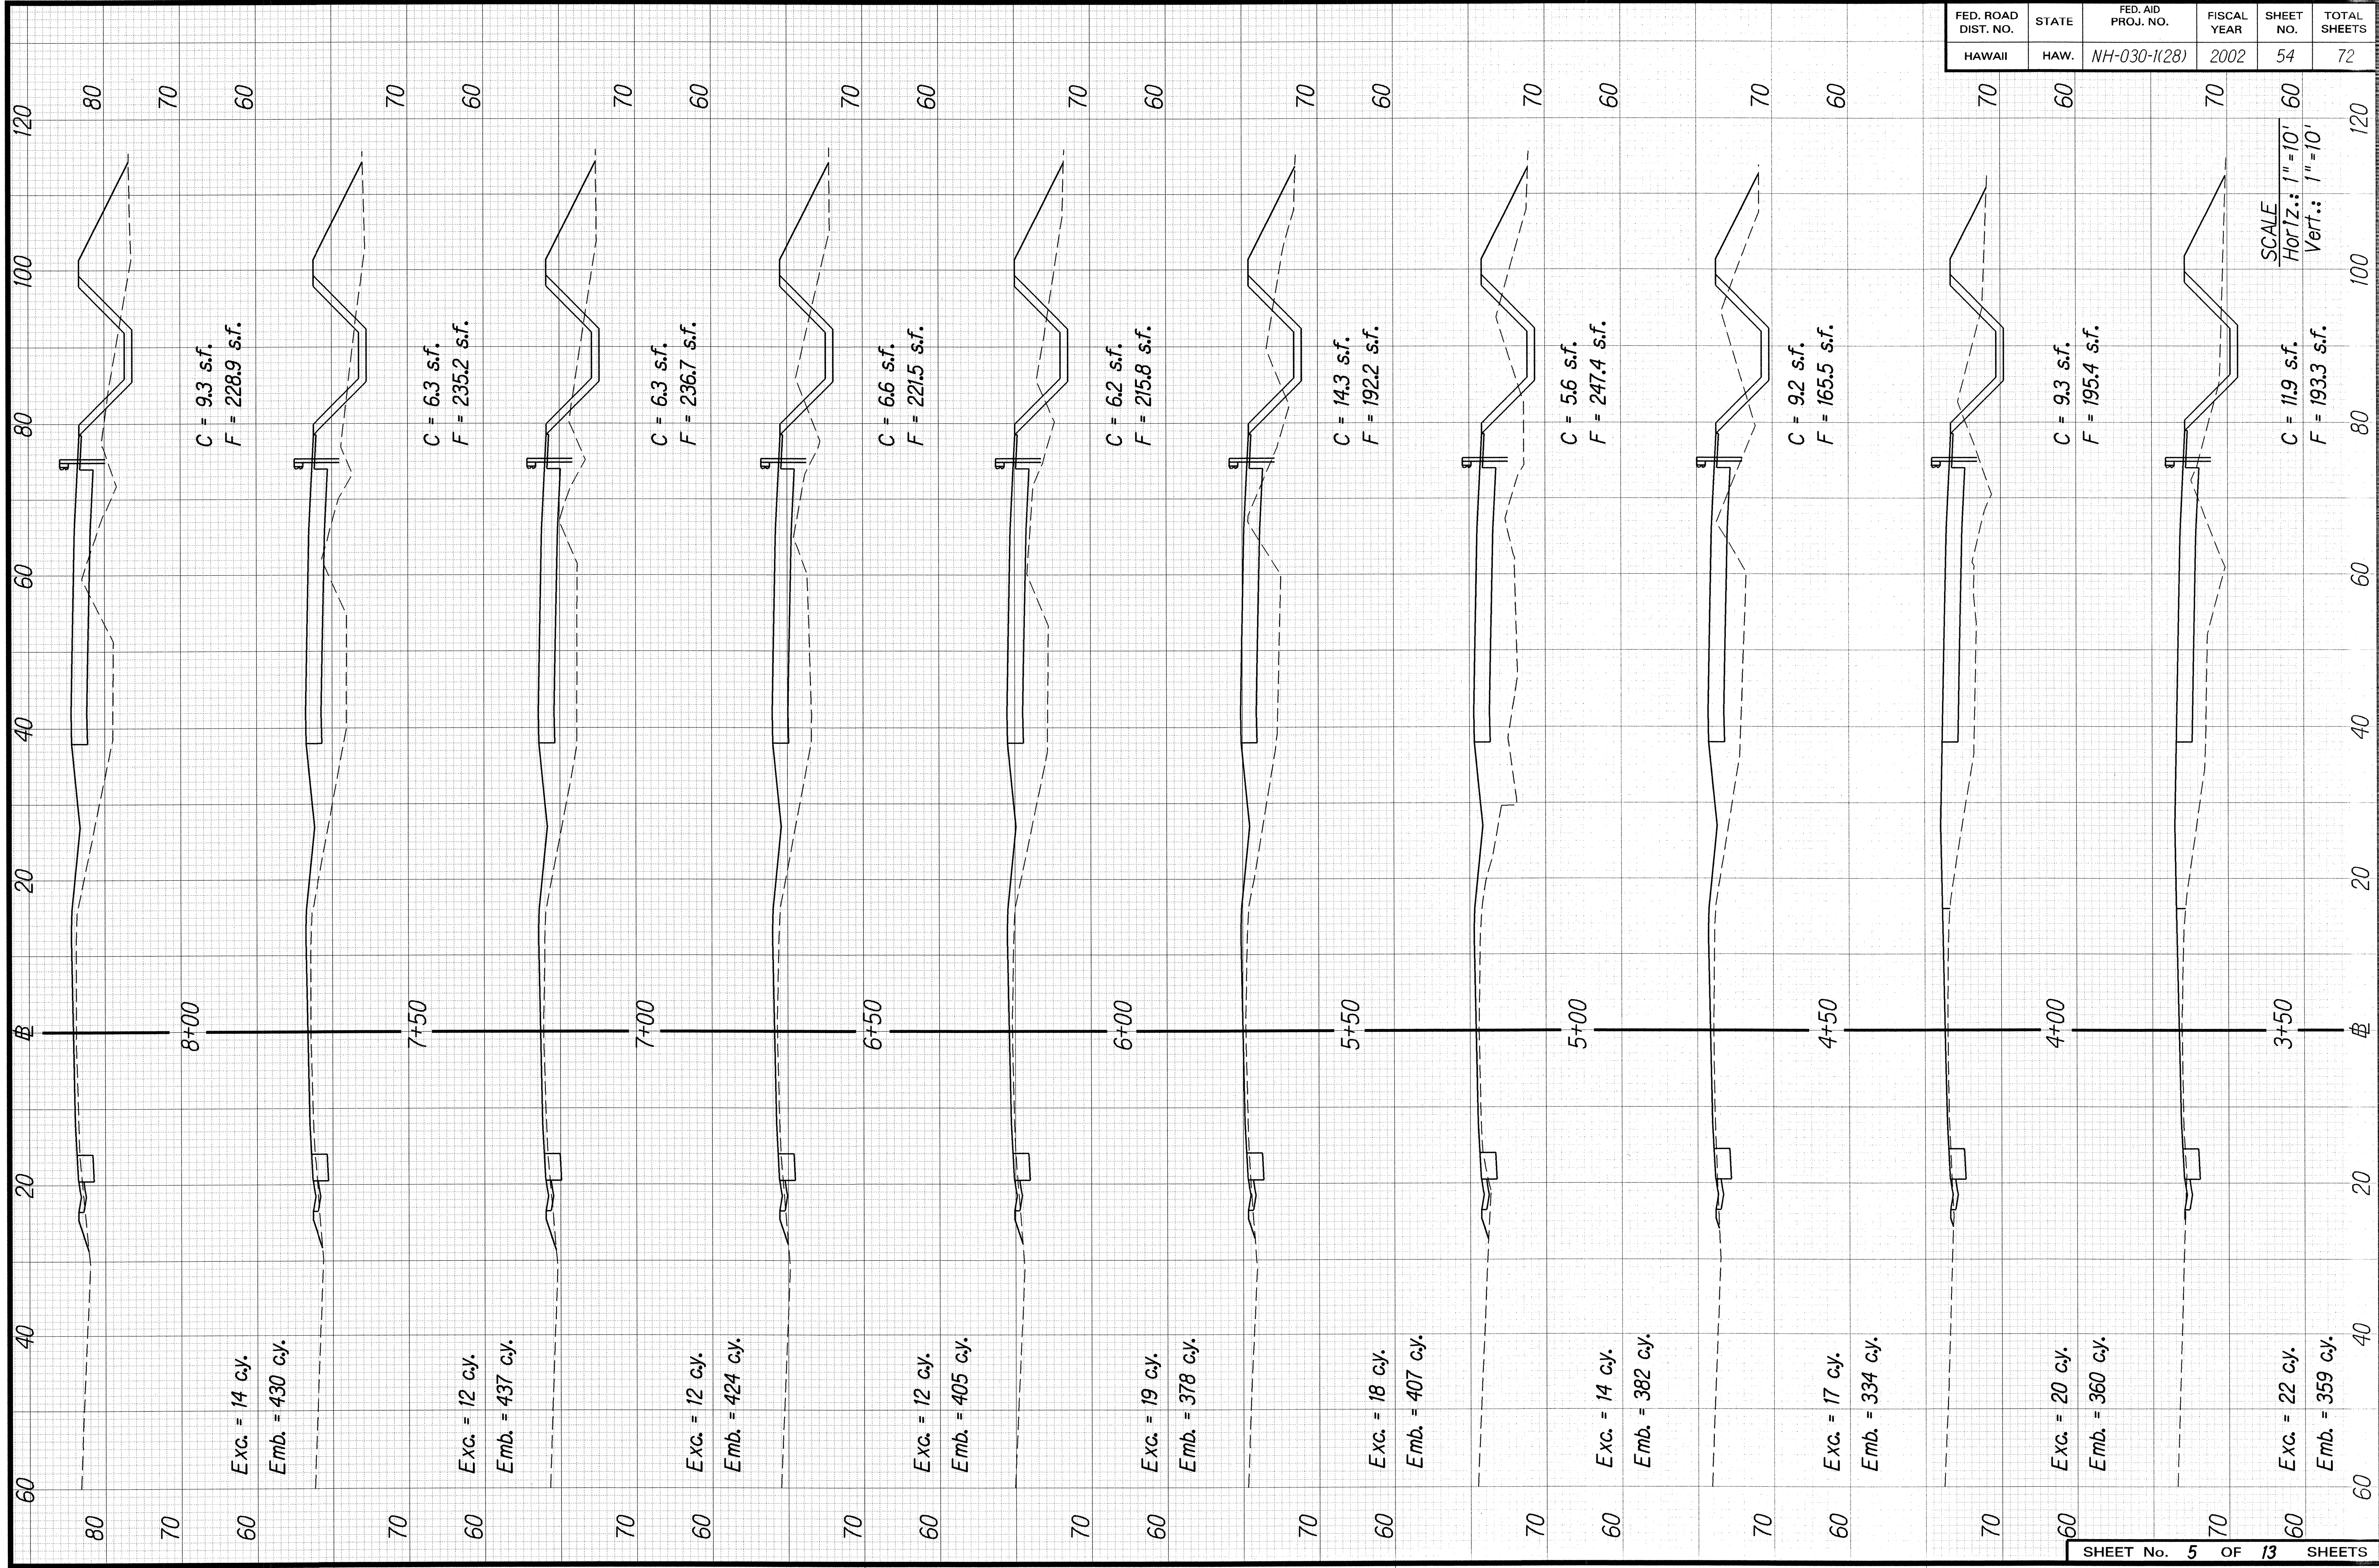


|                     |       |                    |             |           |              |
|---------------------|-------|--------------------|-------------|-----------|--------------|
| FED. ROAD DIST. NO. | STATE | FED. AID PROJ. NO. | FISCAL YEAR | SHEET NO. | TOTAL SHEETS |
| HAWAII              | HAW.  | NH-030-1(28)       | 2002        | 54        | 72           |

SCALE  
Hor'z.: 1"=10'  
Vert.: 1"=10'




|               |                   |          |
|---------------|-------------------|----------|
| ORIGINAL PLAN | SURVEY PLOTTED BY | DATE     |
| NOTE BOOK     | DRAWN BY          | 11/05/01 |
| 006,000 sq    | PROJECTED BY      |          |
| NA/1001506    | QUANTITIES BY     |          |
|               | CHECKED BY        |          |

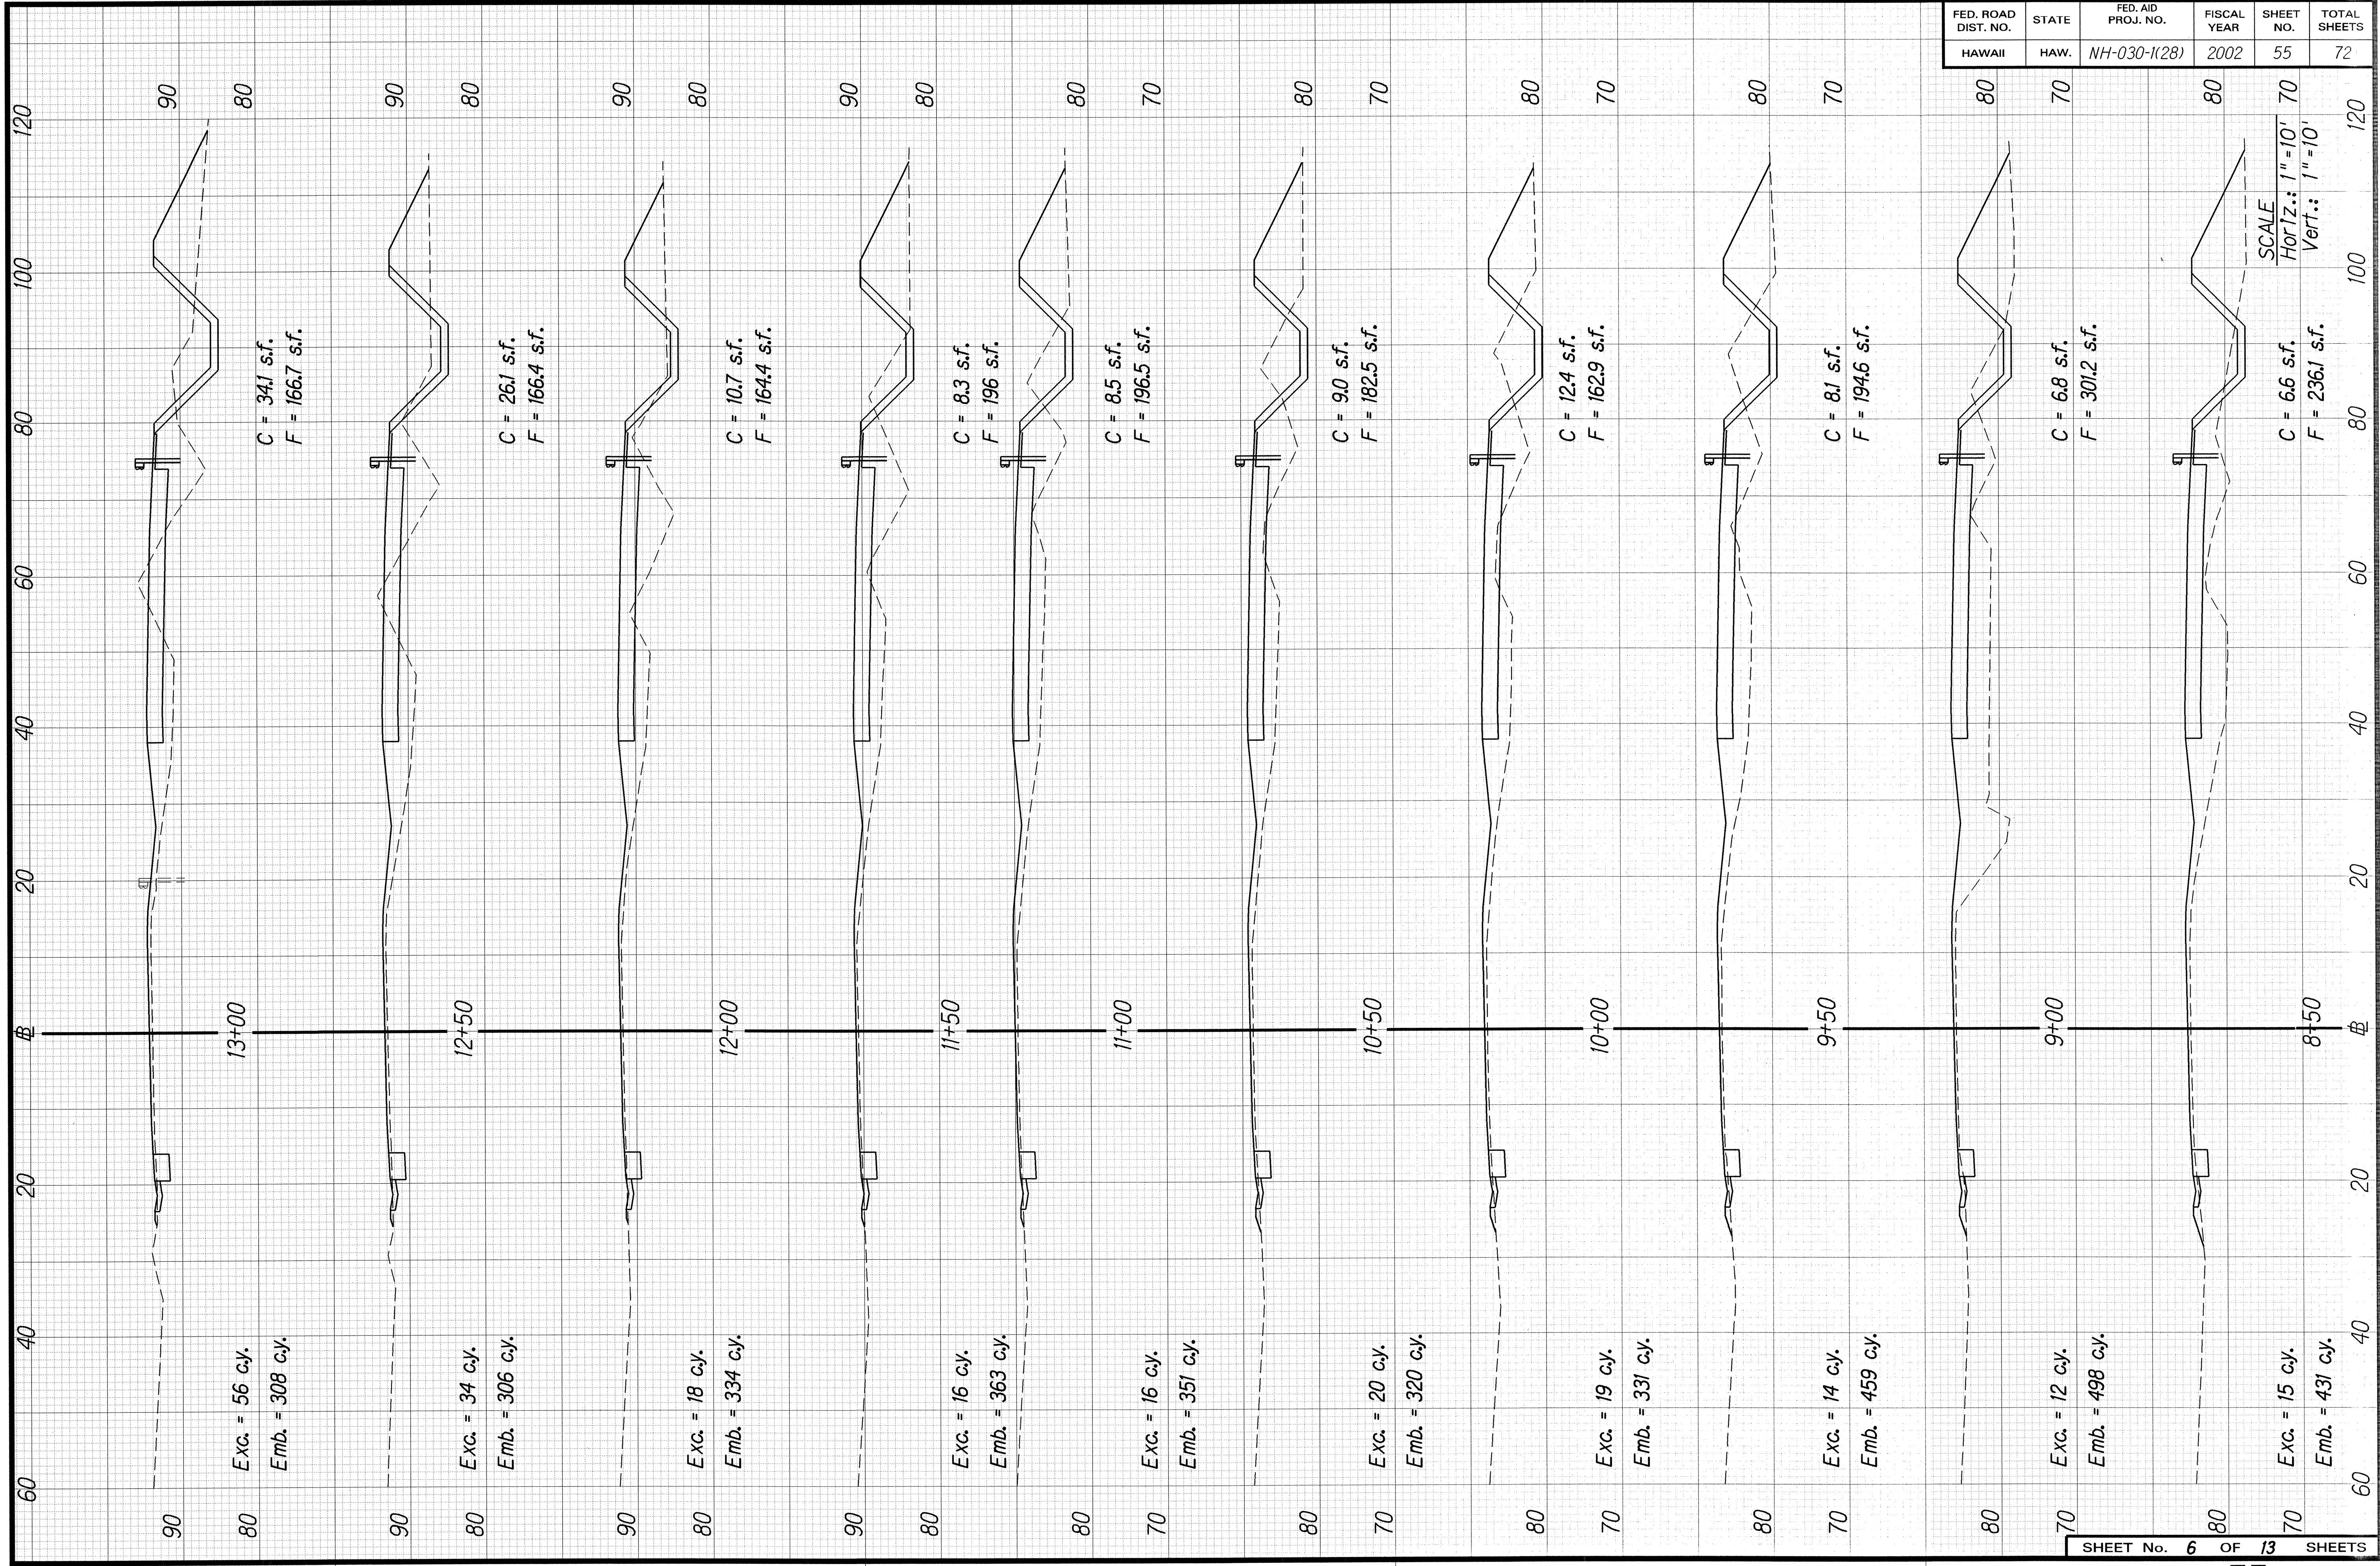

|                     |       |                    |             |           |              |
|---------------------|-------|--------------------|-------------|-----------|--------------|
| FED. ROAD DIST. NO. | STATE | FED. AID PROJ. NO. | FISCAL YEAR | SHEET NO. | TOTAL SHEETS |
| HAWAII              | HAW.  | NH-030-1(28)       | 2002        | 55        | 72           |




|               |                   |         |
|---------------|-------------------|---------|
| ORIGINAL PLAN | SURVEY PLOTTED BY | DATE    |
| NOTE BOOK     | DRAWN BY          | 4/10/50 |
| 006,000 sq    | DESIGNED BY       |         |
| sq/100,000    | QUANTITIES BY     |         |
|               | CHECKED BY        |         |

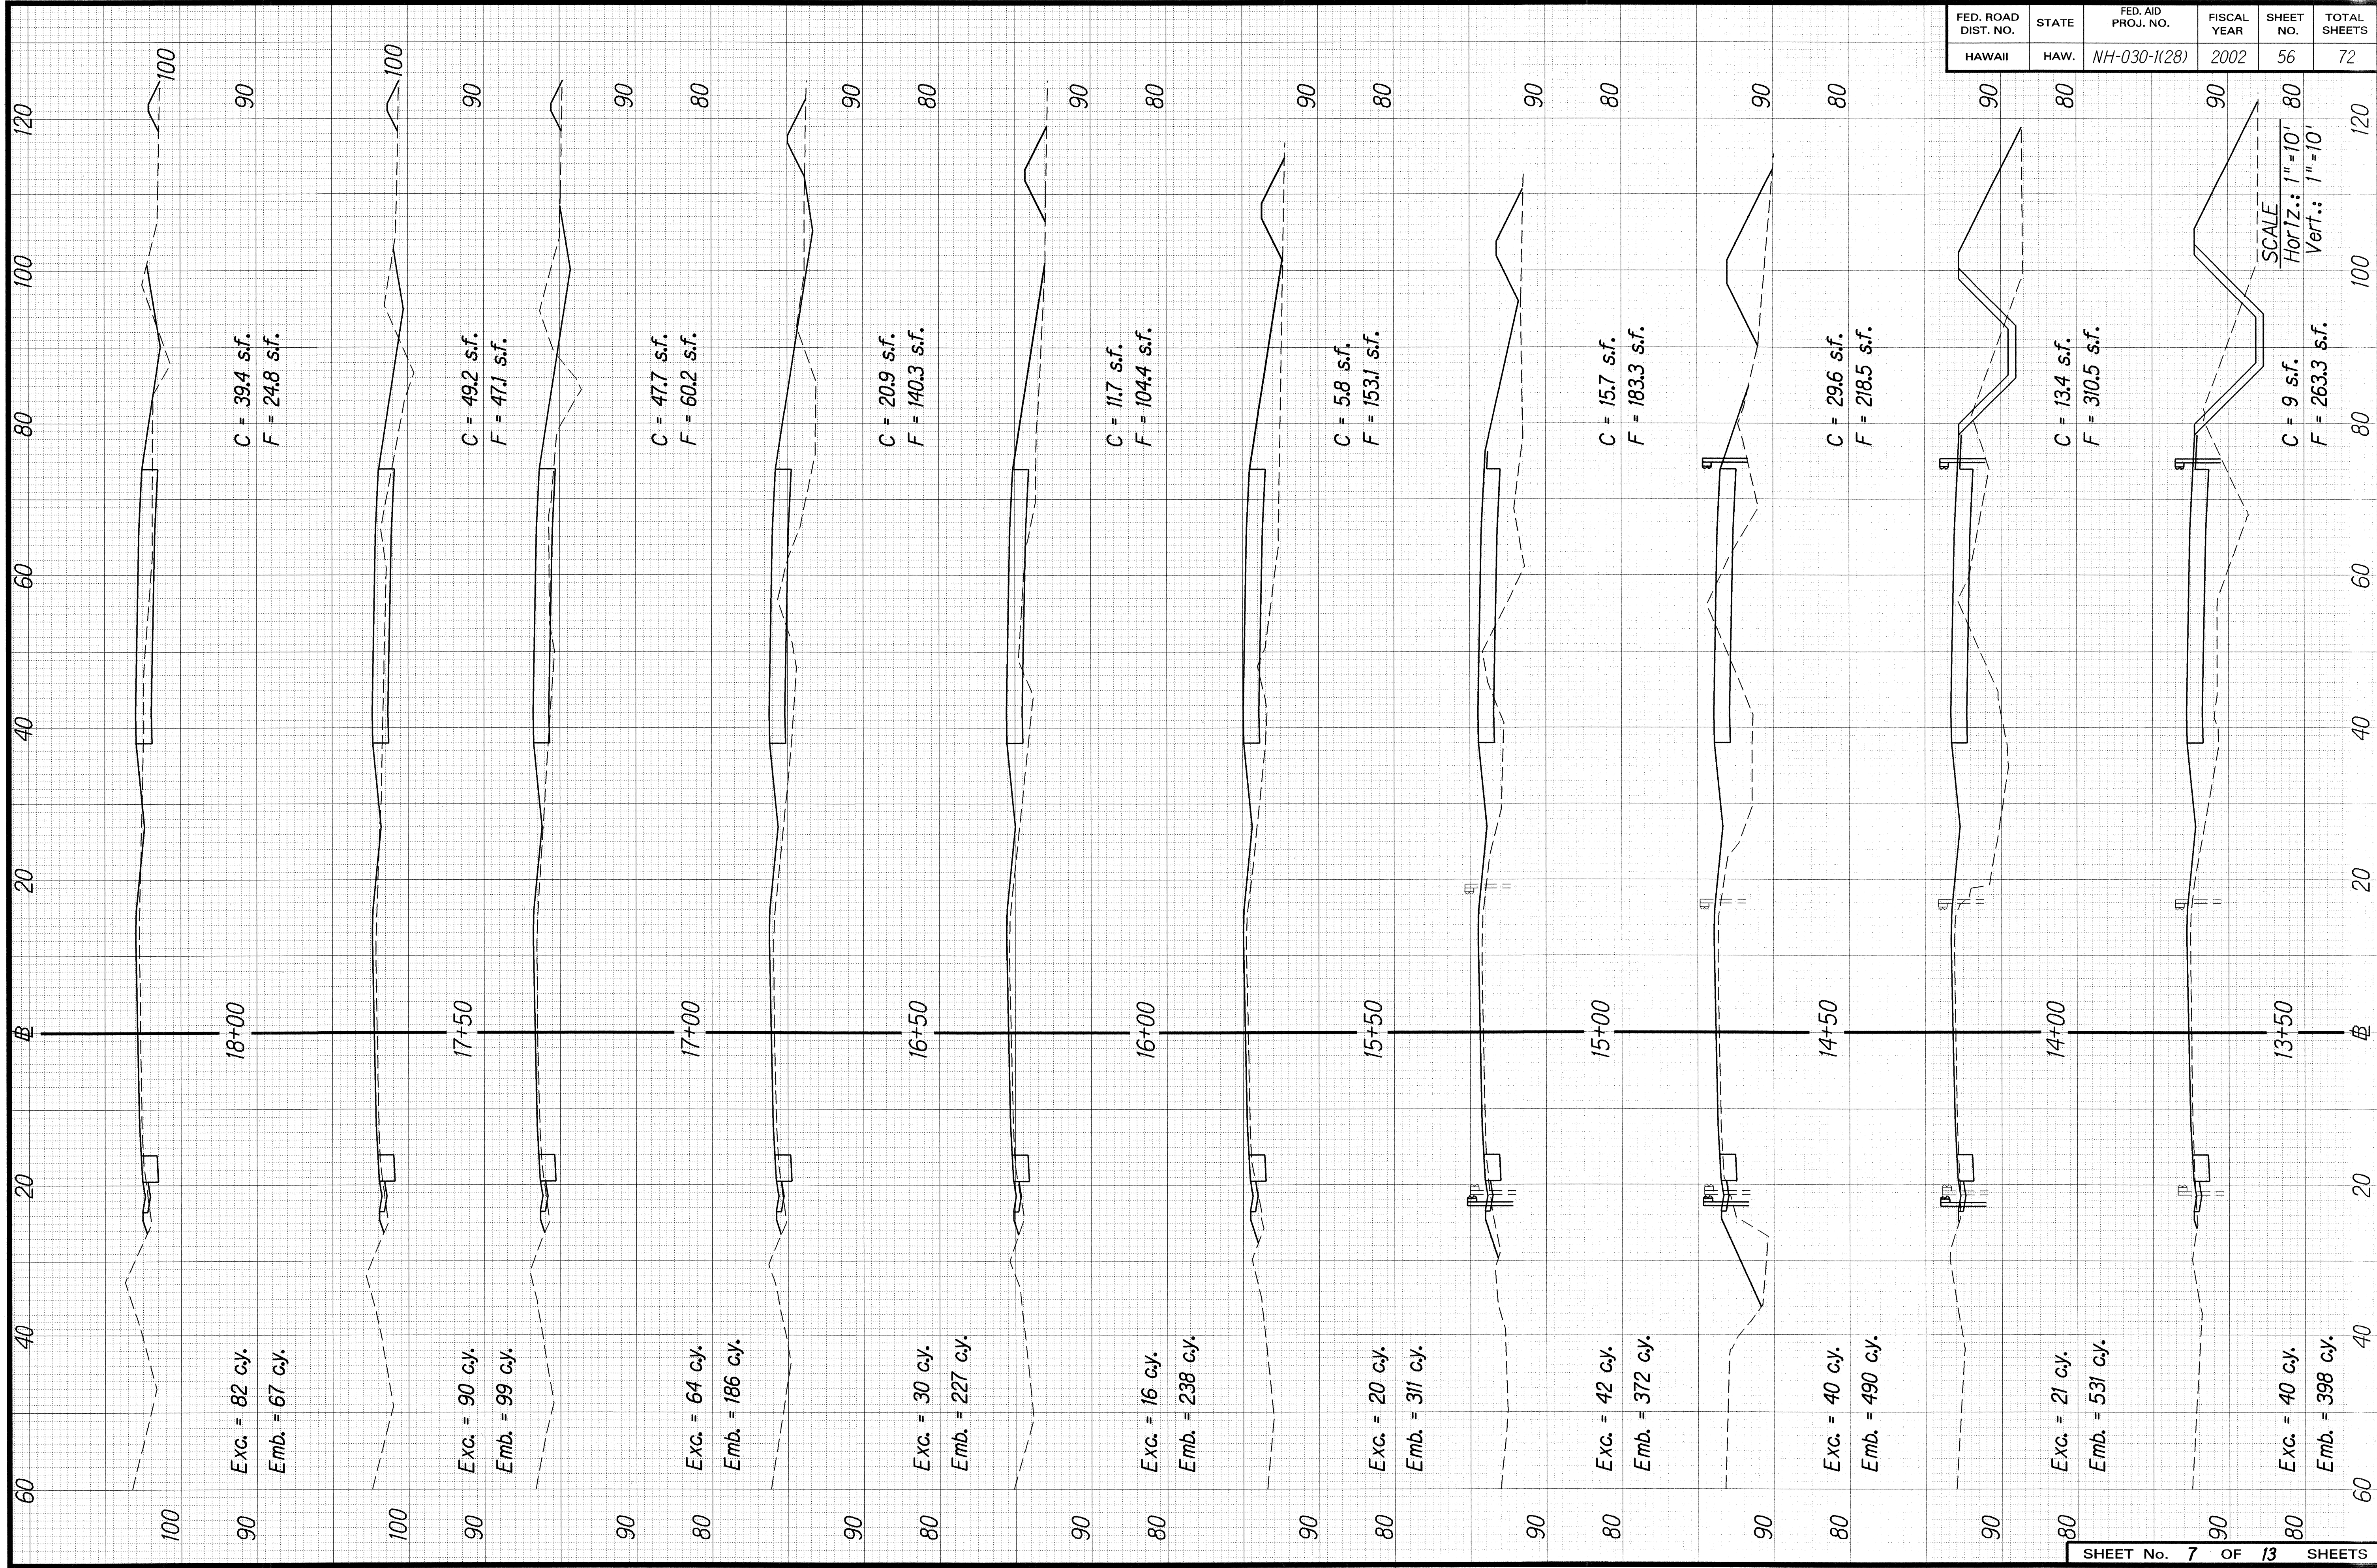

|                     |       |                    |             |           |              |
|---------------------|-------|--------------------|-------------|-----------|--------------|
| FED. ROAD DIST. NO. | STATE | FED. AID PROJ. NO. | FISCAL YEAR | SHEET NO. | TOTAL SHEETS |
| HAWAII              | HAW.  | NH-030-1(28)       | 2002        | 56        | 72           |




|               |                   |         |
|---------------|-------------------|---------|
| ORIGINAL PLAN | SURVEY PLOTTED BY | DATE    |
| NOTE BOOK     | DRAWN BY          | 4/10/02 |
| DESIGNED BY   | CHECKED BY        |         |
| QUANTITIES BY |                   |         |
| CHECKED BY    |                   |         |

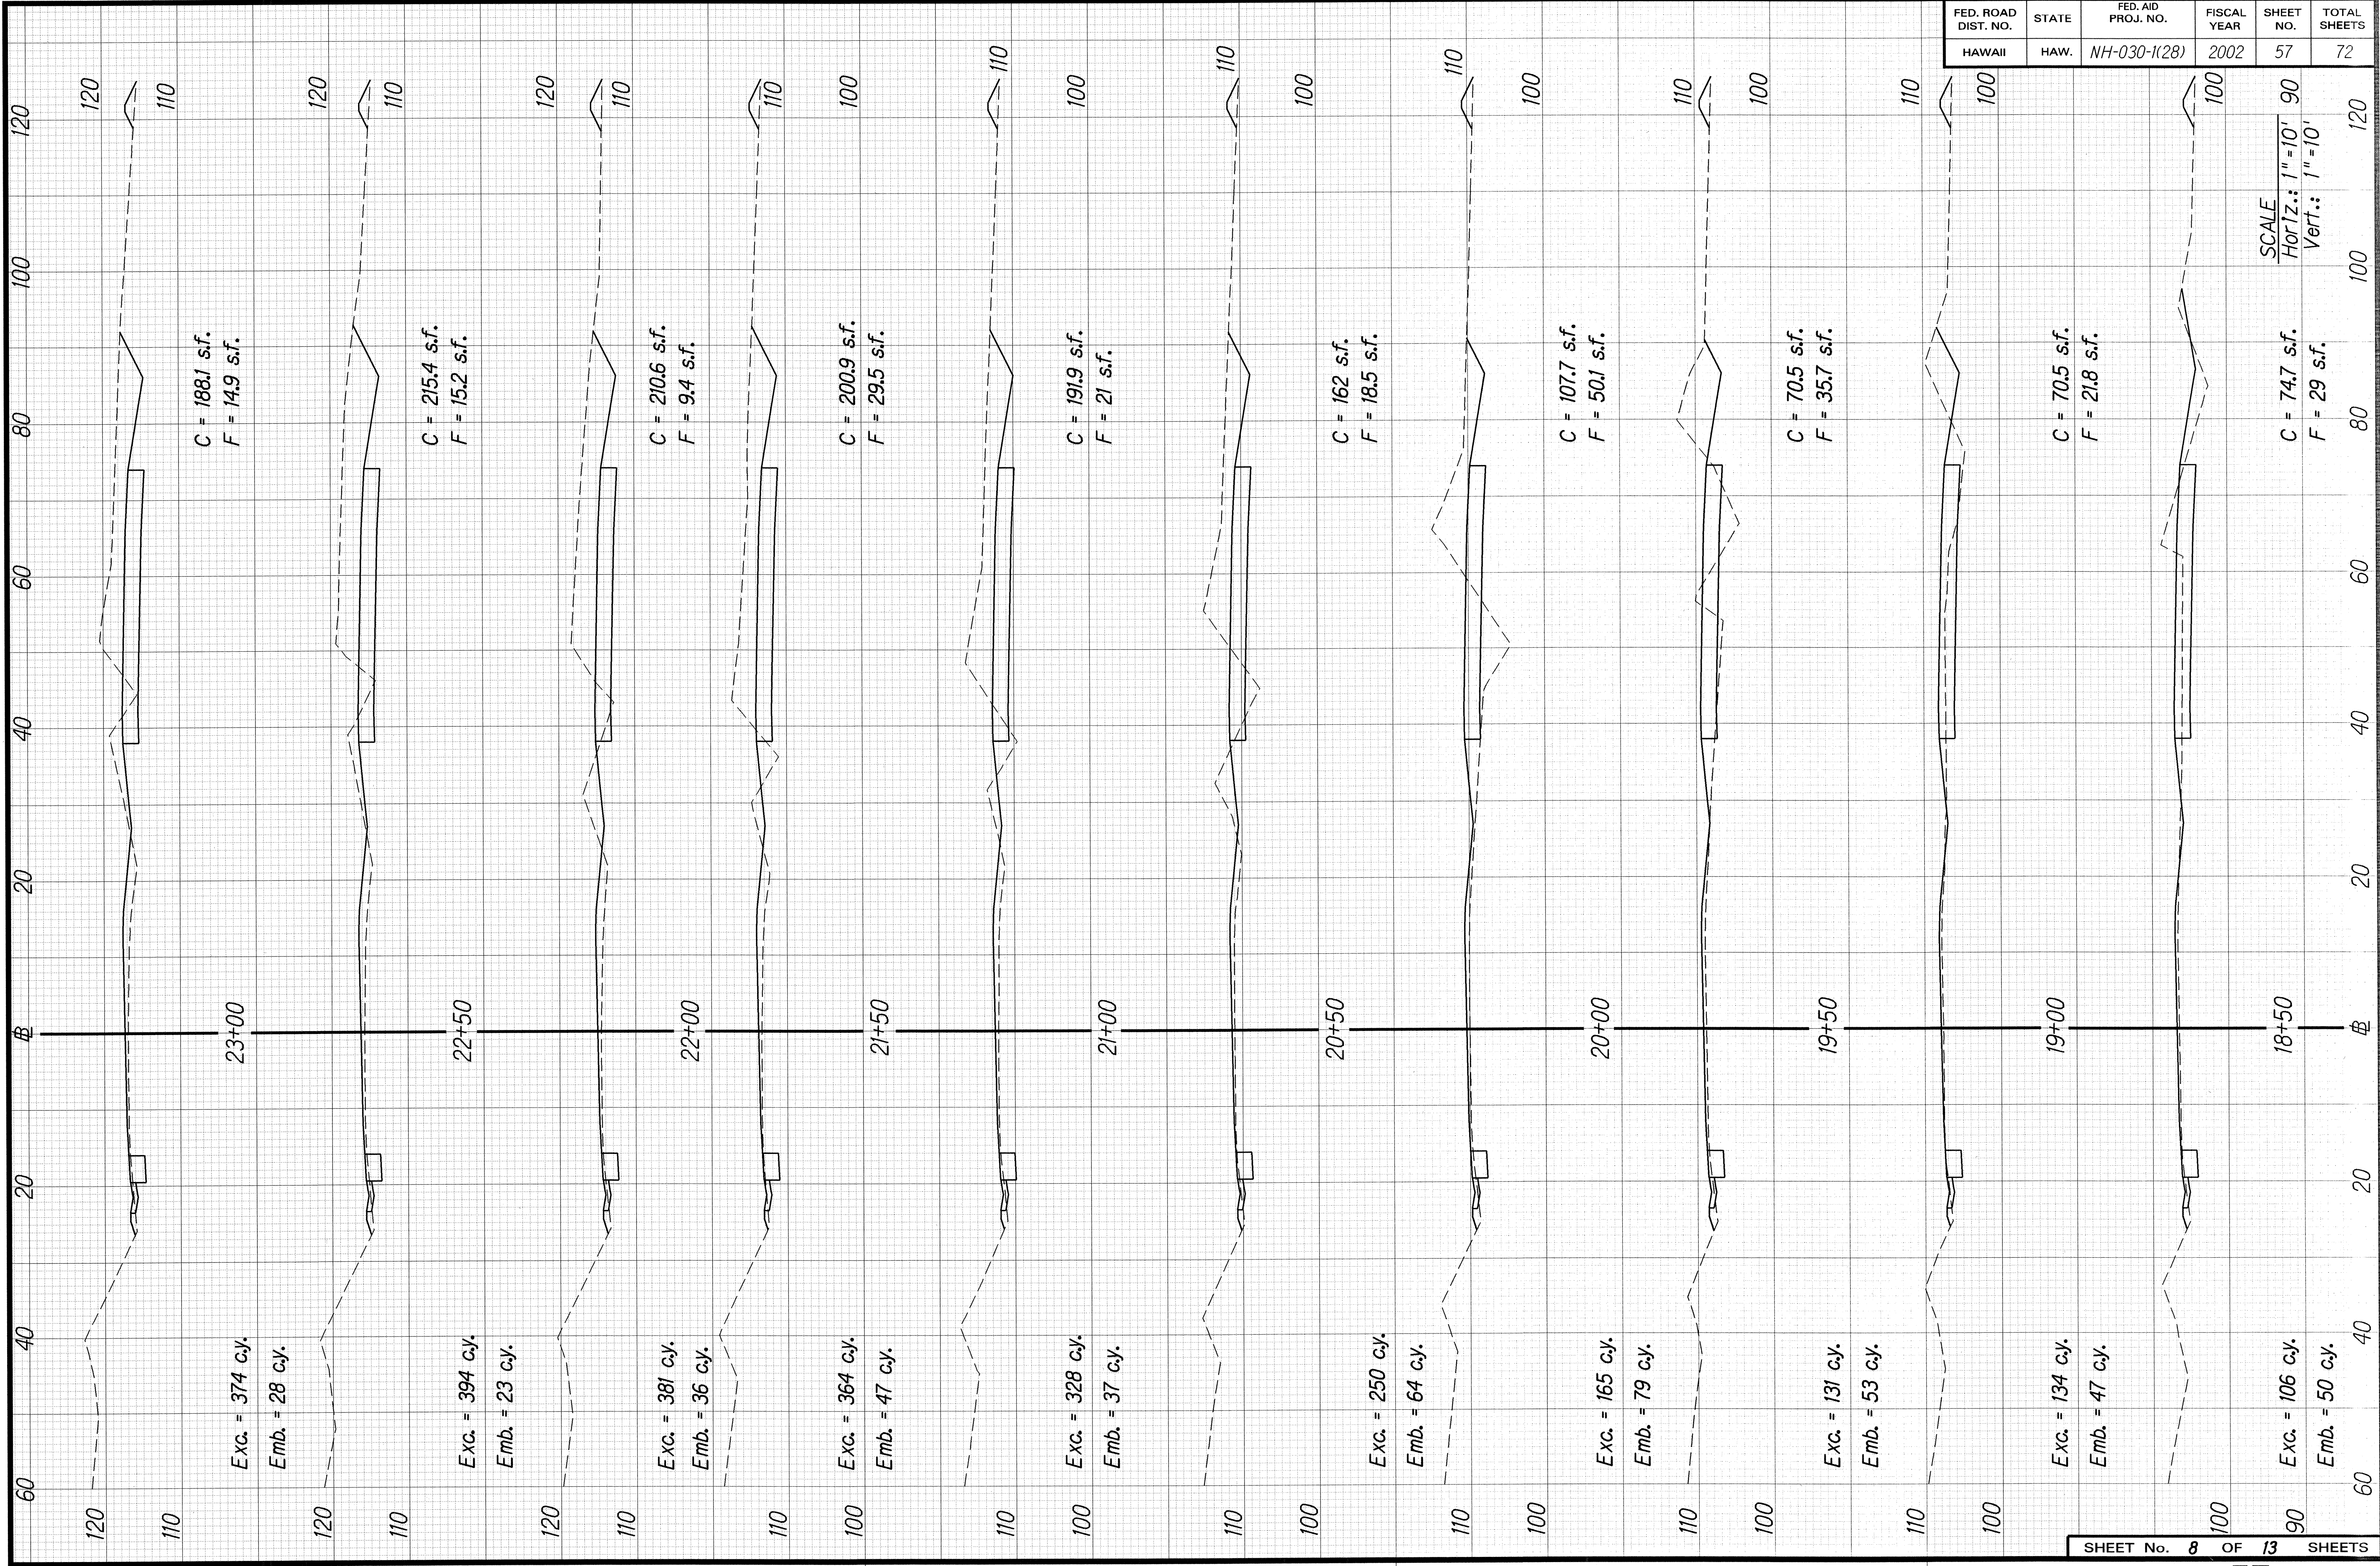

|                     |       |                    |             |           |              |
|---------------------|-------|--------------------|-------------|-----------|--------------|
| FED. ROAD DIST. NO. | STATE | FED. AID PROJ. NO. | FISCAL YEAR | SHEET NO. | TOTAL SHEETS |
| HAWAII              | HAW.  | NH-030-1(28)       | 2002        | 57        | 72           |



|               |                   |          |
|---------------|-------------------|----------|
| ORIGINAL PLAN | SURVEY PLOTTED BY | DATE     |
| NOTE BOOK     | DRAWN BY          | 11-05-01 |
| 006980798     | DESIGNED BY       |          |
| 04/20/2009    | QUANTITIES BY     |          |
|               | CHECKED BY        |          |

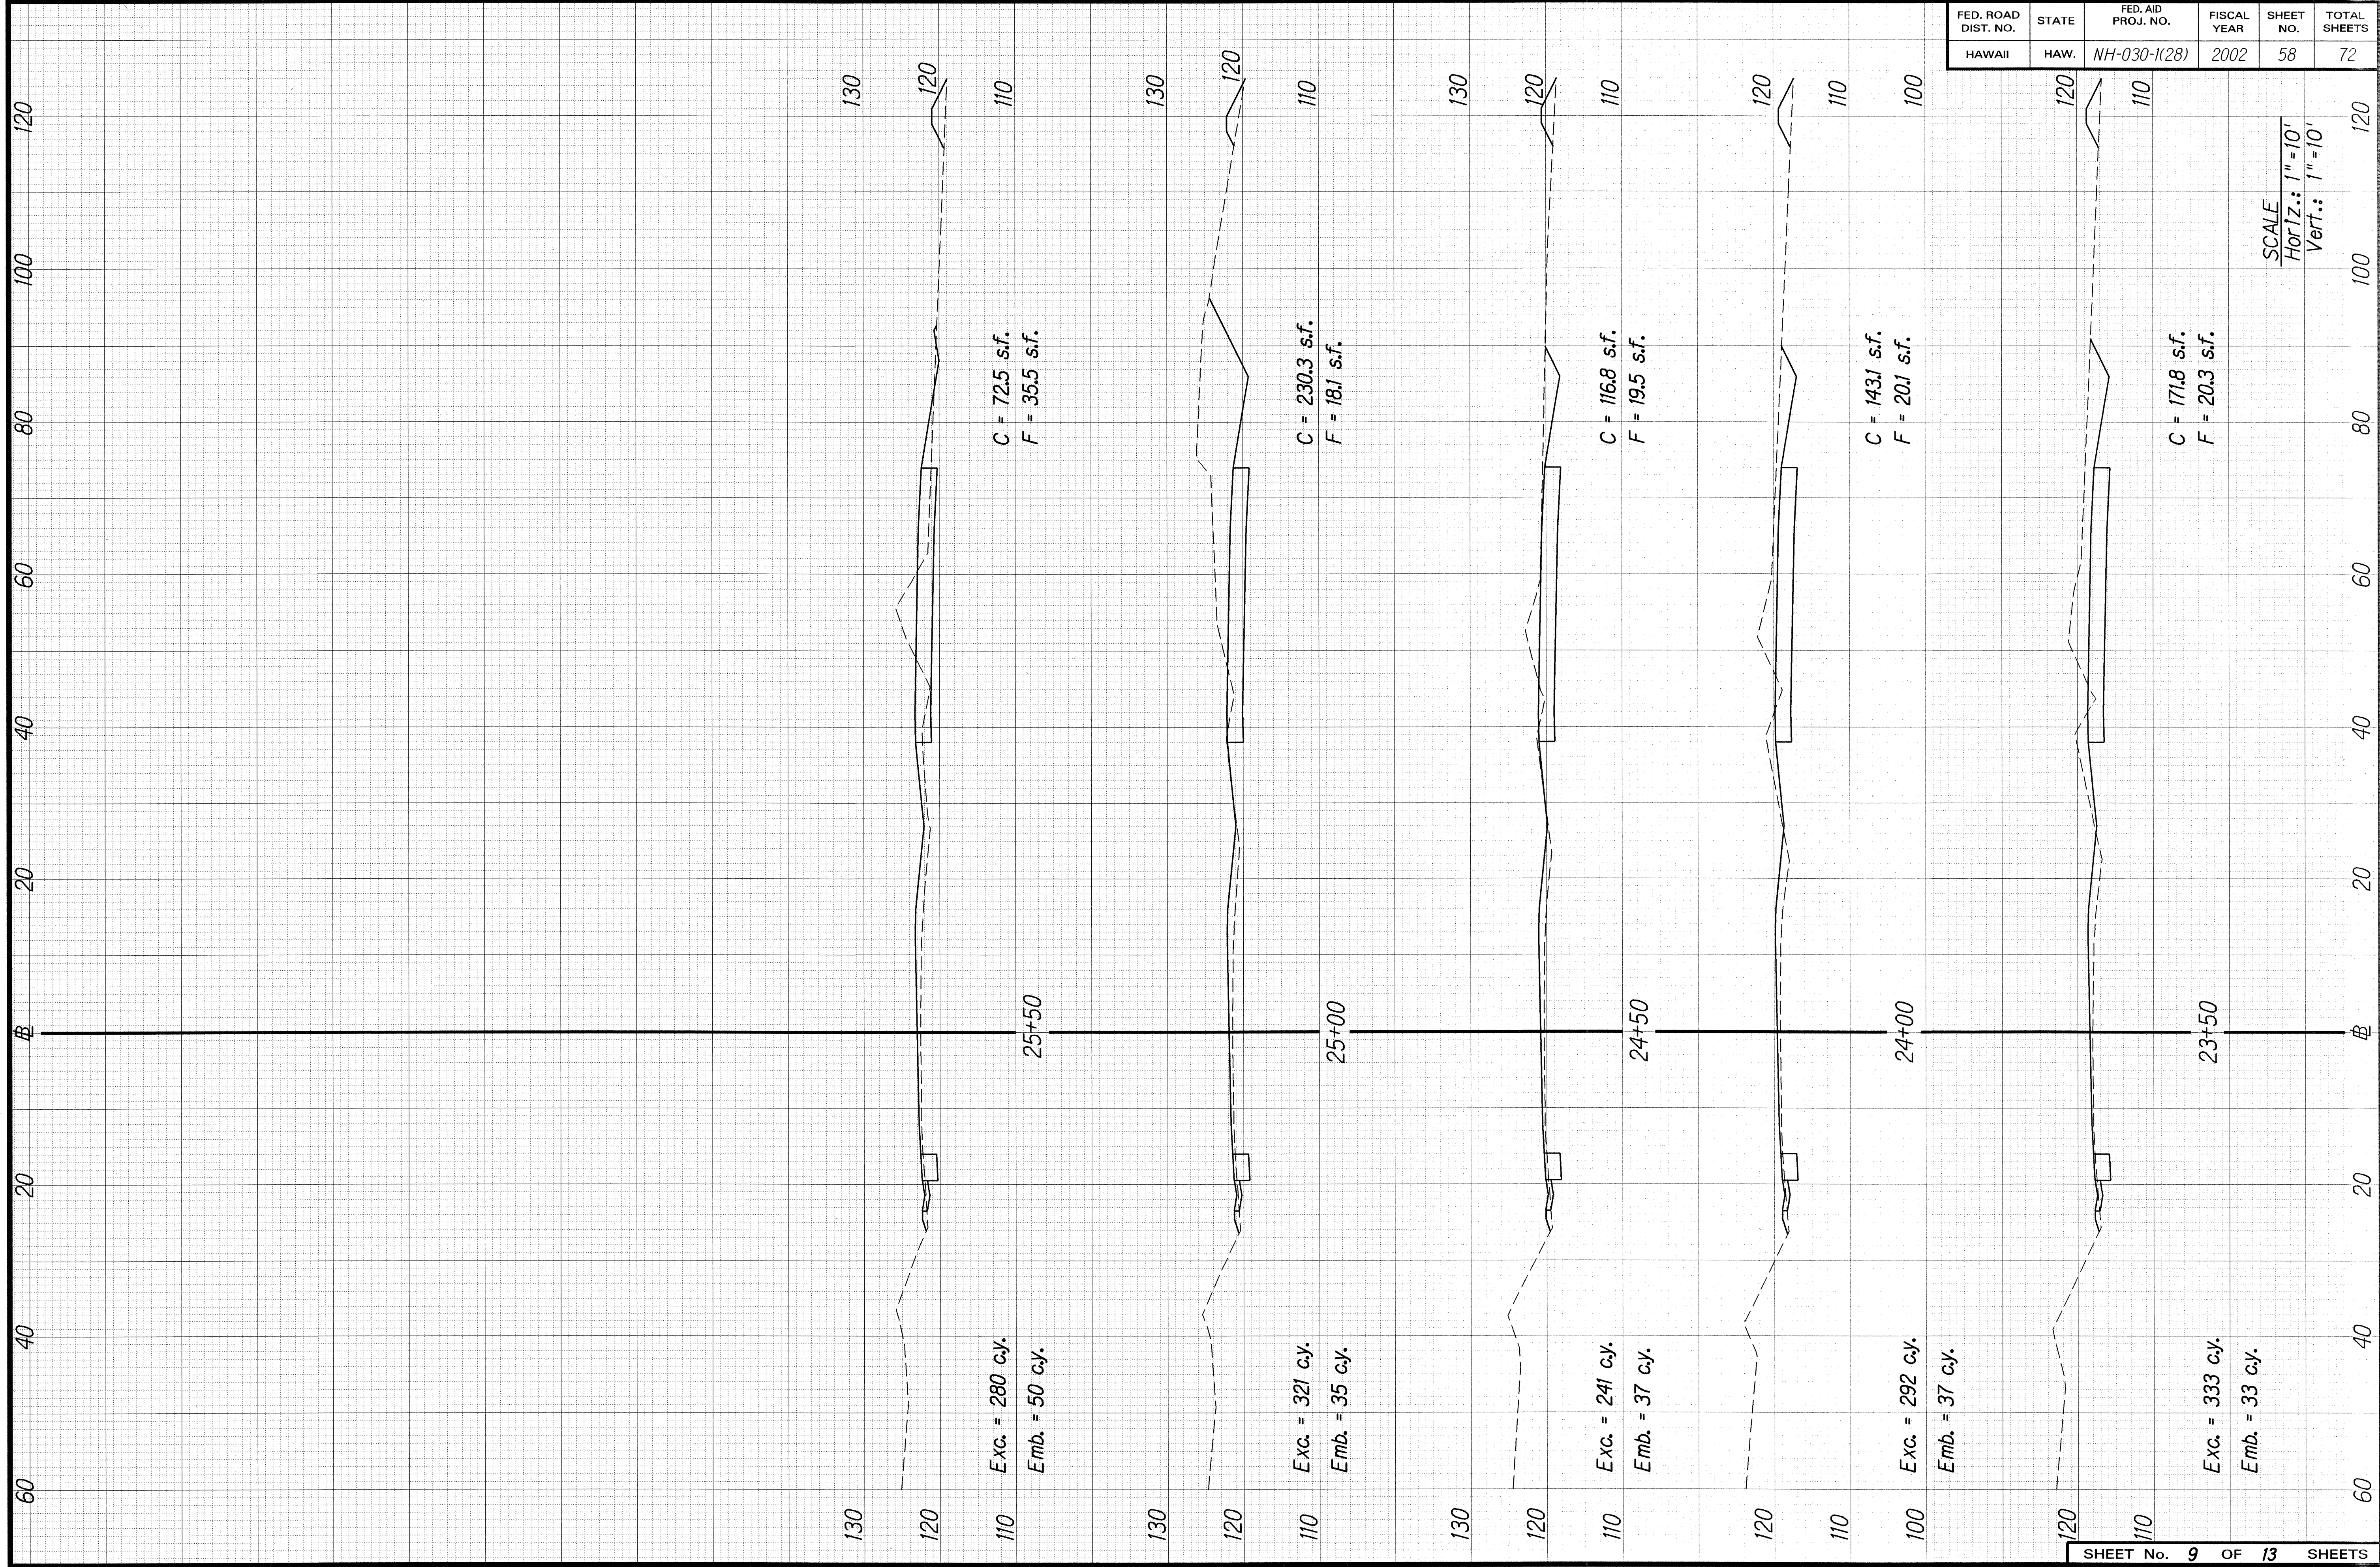


|                     |       |                    |             |           |              |
|---------------------|-------|--------------------|-------------|-----------|--------------|
| FED. ROAD DIST. NO. | STATE | FED. AID PROJ. NO. | FISCAL YEAR | SHEET NO. | TOTAL SHEETS |
| HAWAII              | HAW.  | NH-030-1(28)       | 2002        | 58        | 72           |

SCALE  
Horiz.: 1" = 10'  
Vert.: 1" = 10'




| FED. ROAD DIST. NO. | STATE | FED. AID PROJ. NO. | FISCAL YEAR | SHEET NO. | TOTAL SHEETS |
|---------------------|-------|--------------------|-------------|-----------|--------------|
| HAWAII              | HAW.  | NH-030-1(28)       | 2002        | 59        | 72           |

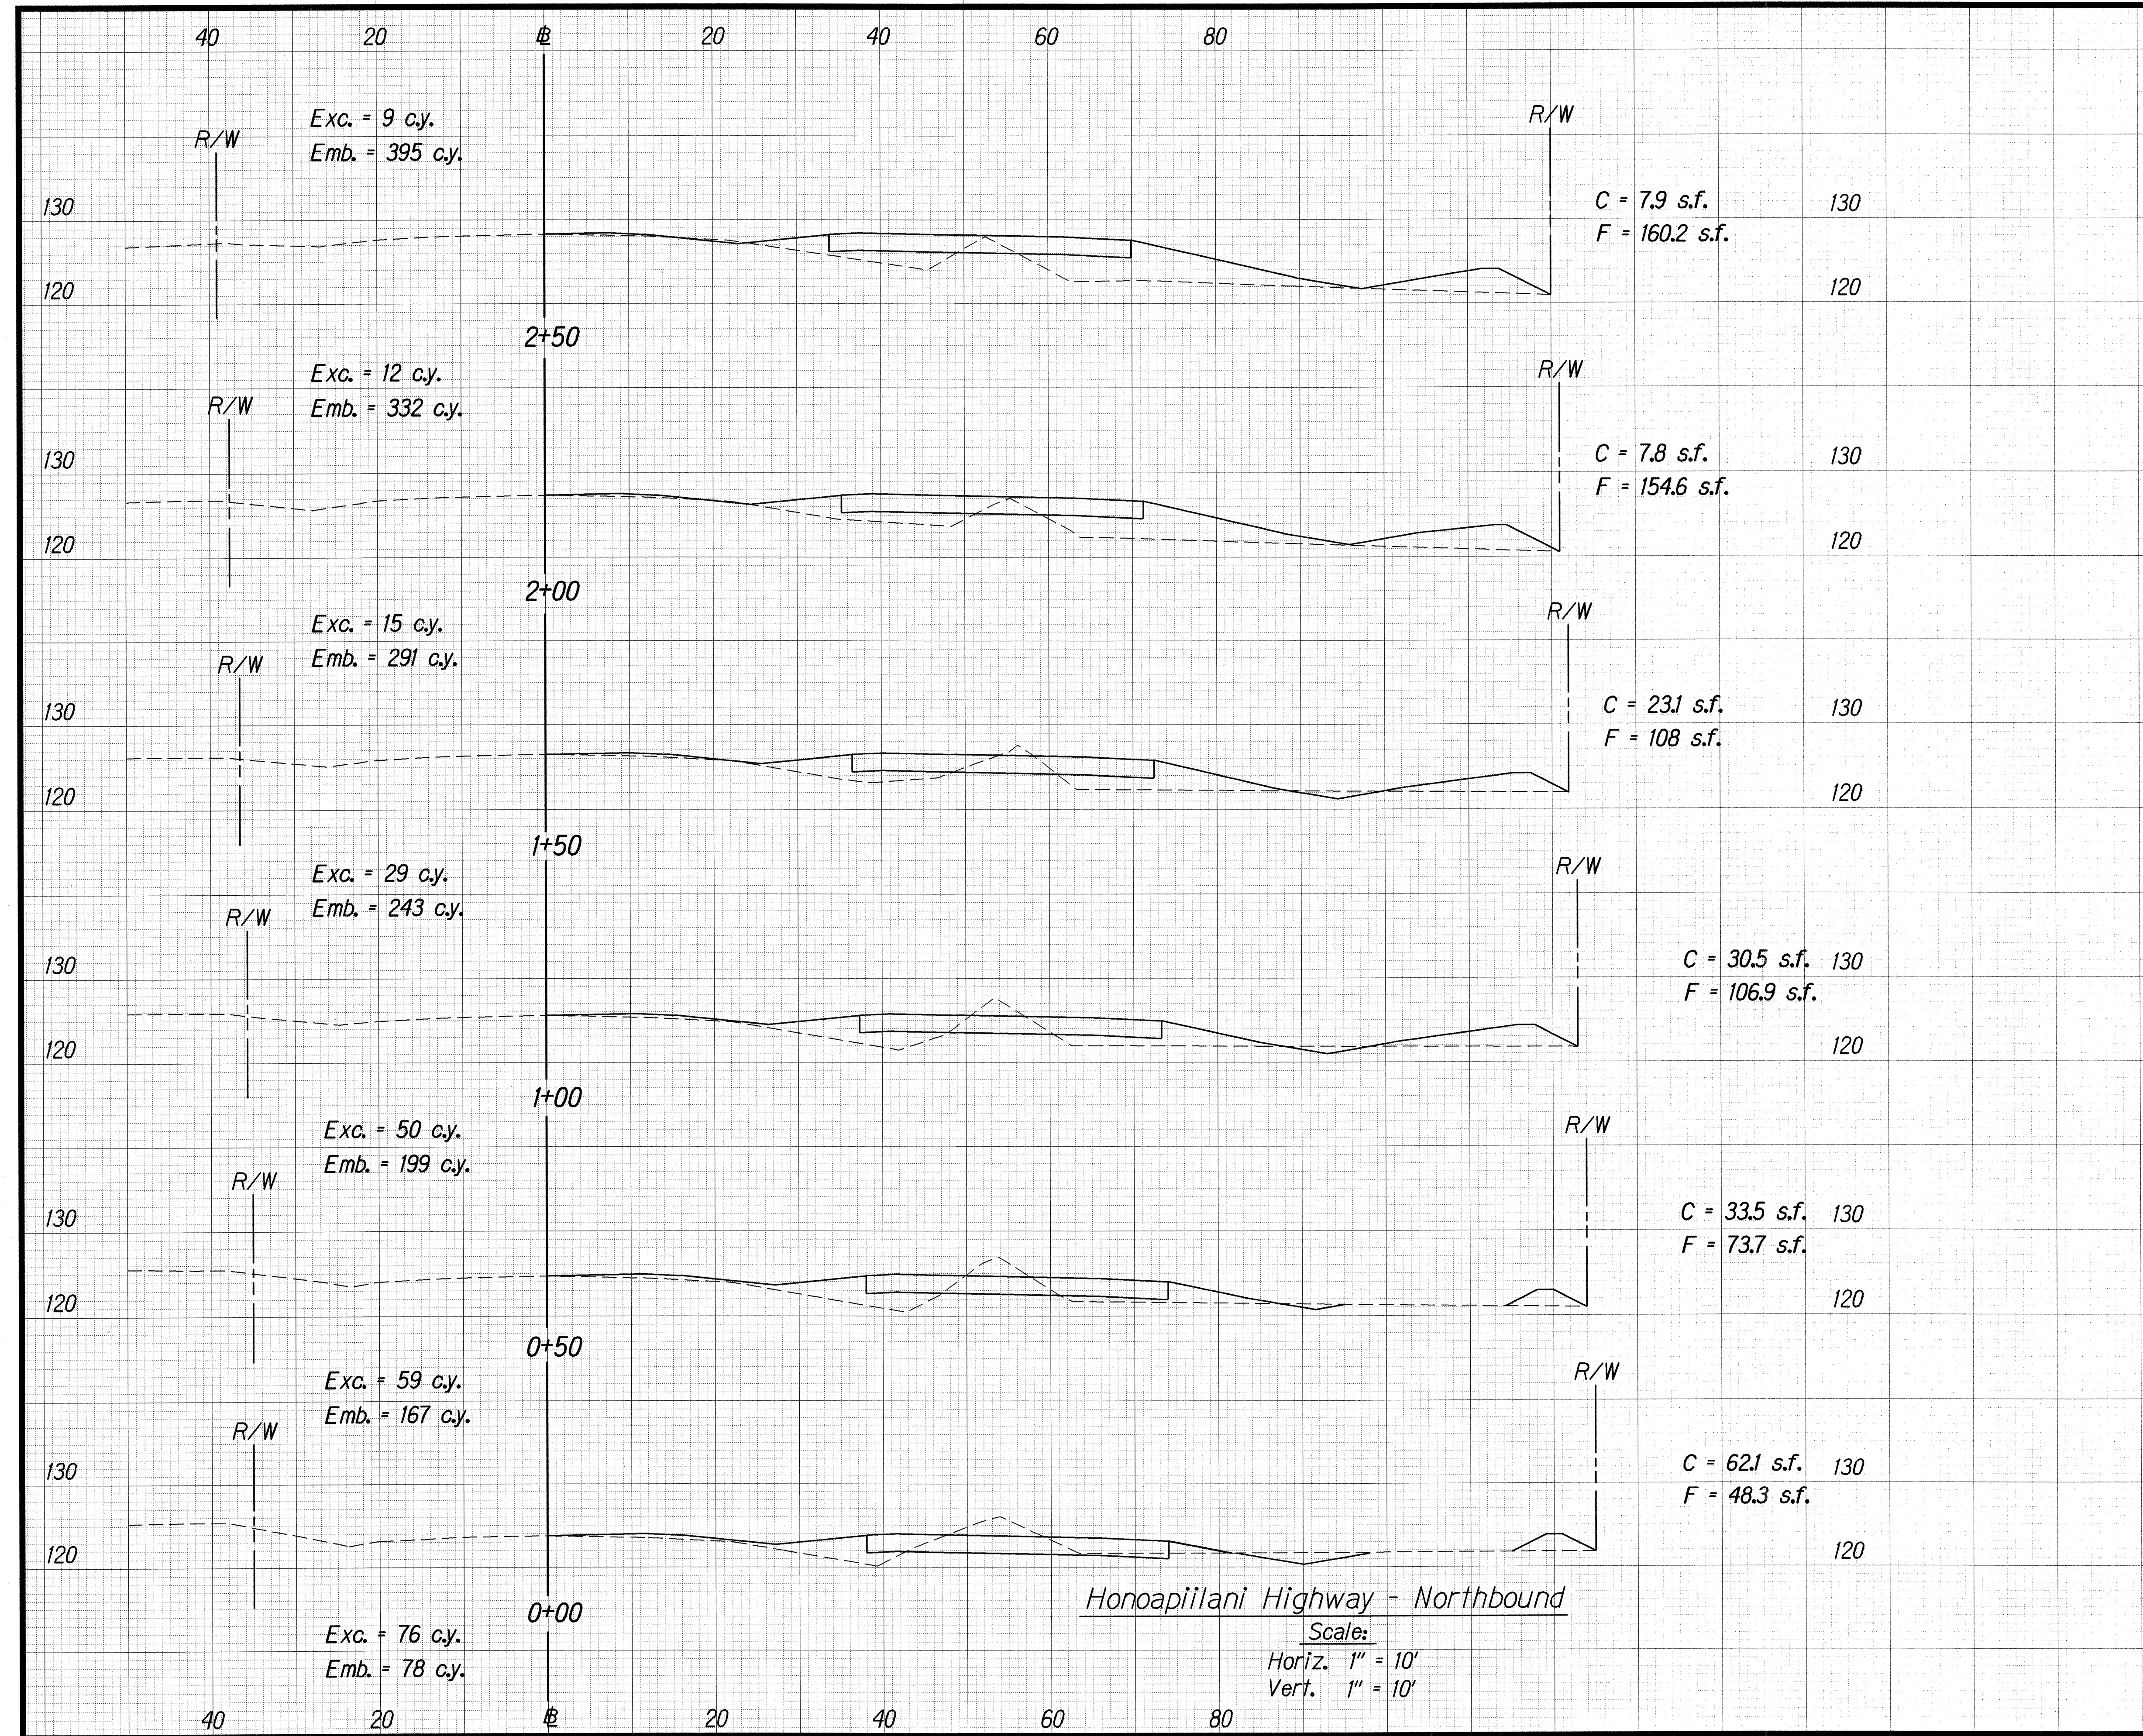

SURVEY PLOTTED BY: \_\_\_\_\_ DATE: 7/14/05  
 DRAWN BY: \_\_\_\_\_  
 DESIGNED BY: C. Yamashita  
 NOTE BOOK: 067, Jason  
 QUANTITIES BY: \_\_\_\_\_  
 CHECKED BY: N. GONZALES




| FED. ROAD DIST. NO. | STATE | FED. AID PROJ. NO. | FISCAL YEAR | SHEET NO. | TOTAL SHEETS |
|---------------------|-------|--------------------|-------------|-----------|--------------|
| HAWAII              | HAW.  | NH-030-1(28)       | 2002        | 60        | 72           |

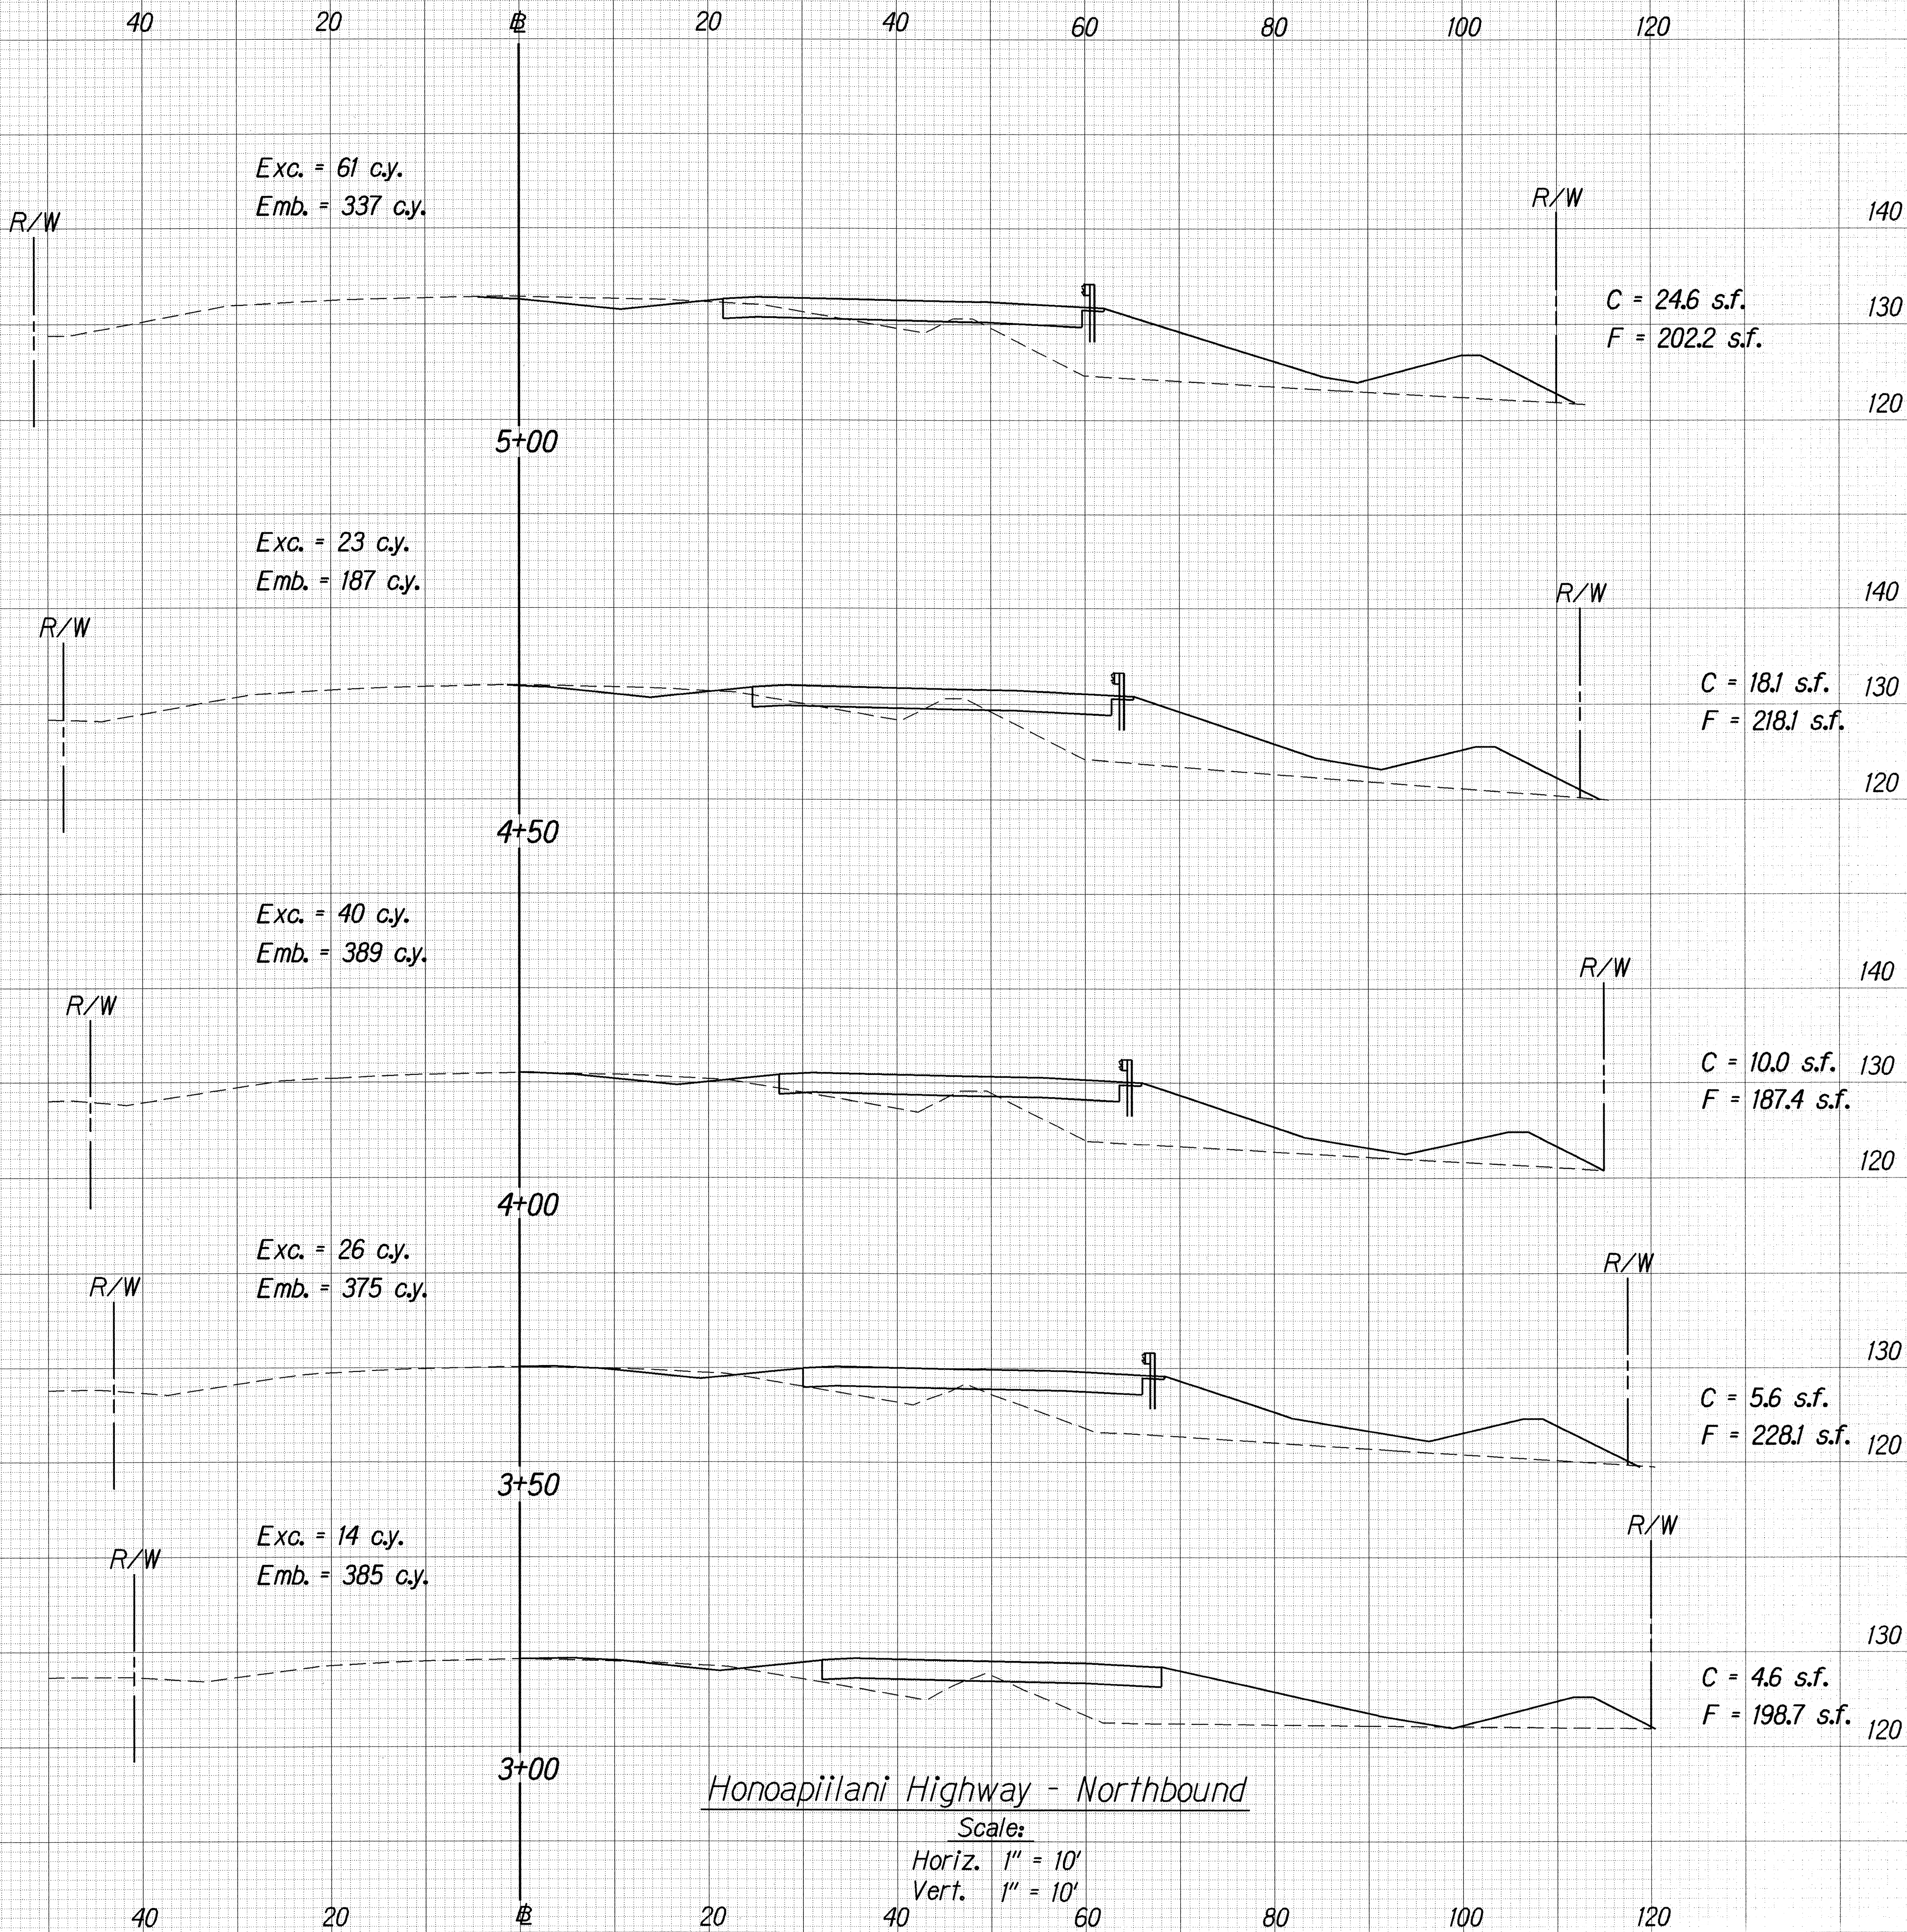

|                   |             |
|-------------------|-------------|
| SURVEY PLOTTED BY | DATE        |
| DRAWN BY          | 11/05/01    |
| DESIGNED BY       | C. T. T. T. |
| QUANTITIES BY     |             |
| CHECKED BY        |             |




| FED. ROAD DIST. NO. | STATE | FED. AID PROJ. NO. | FISCAL YEAR | SHEET NO. | TOTAL SHEETS |
|---------------------|-------|--------------------|-------------|-----------|--------------|
| HAWAII              | HAW.  | NH-030-1(28)       | 2002        | 61        | 72           |

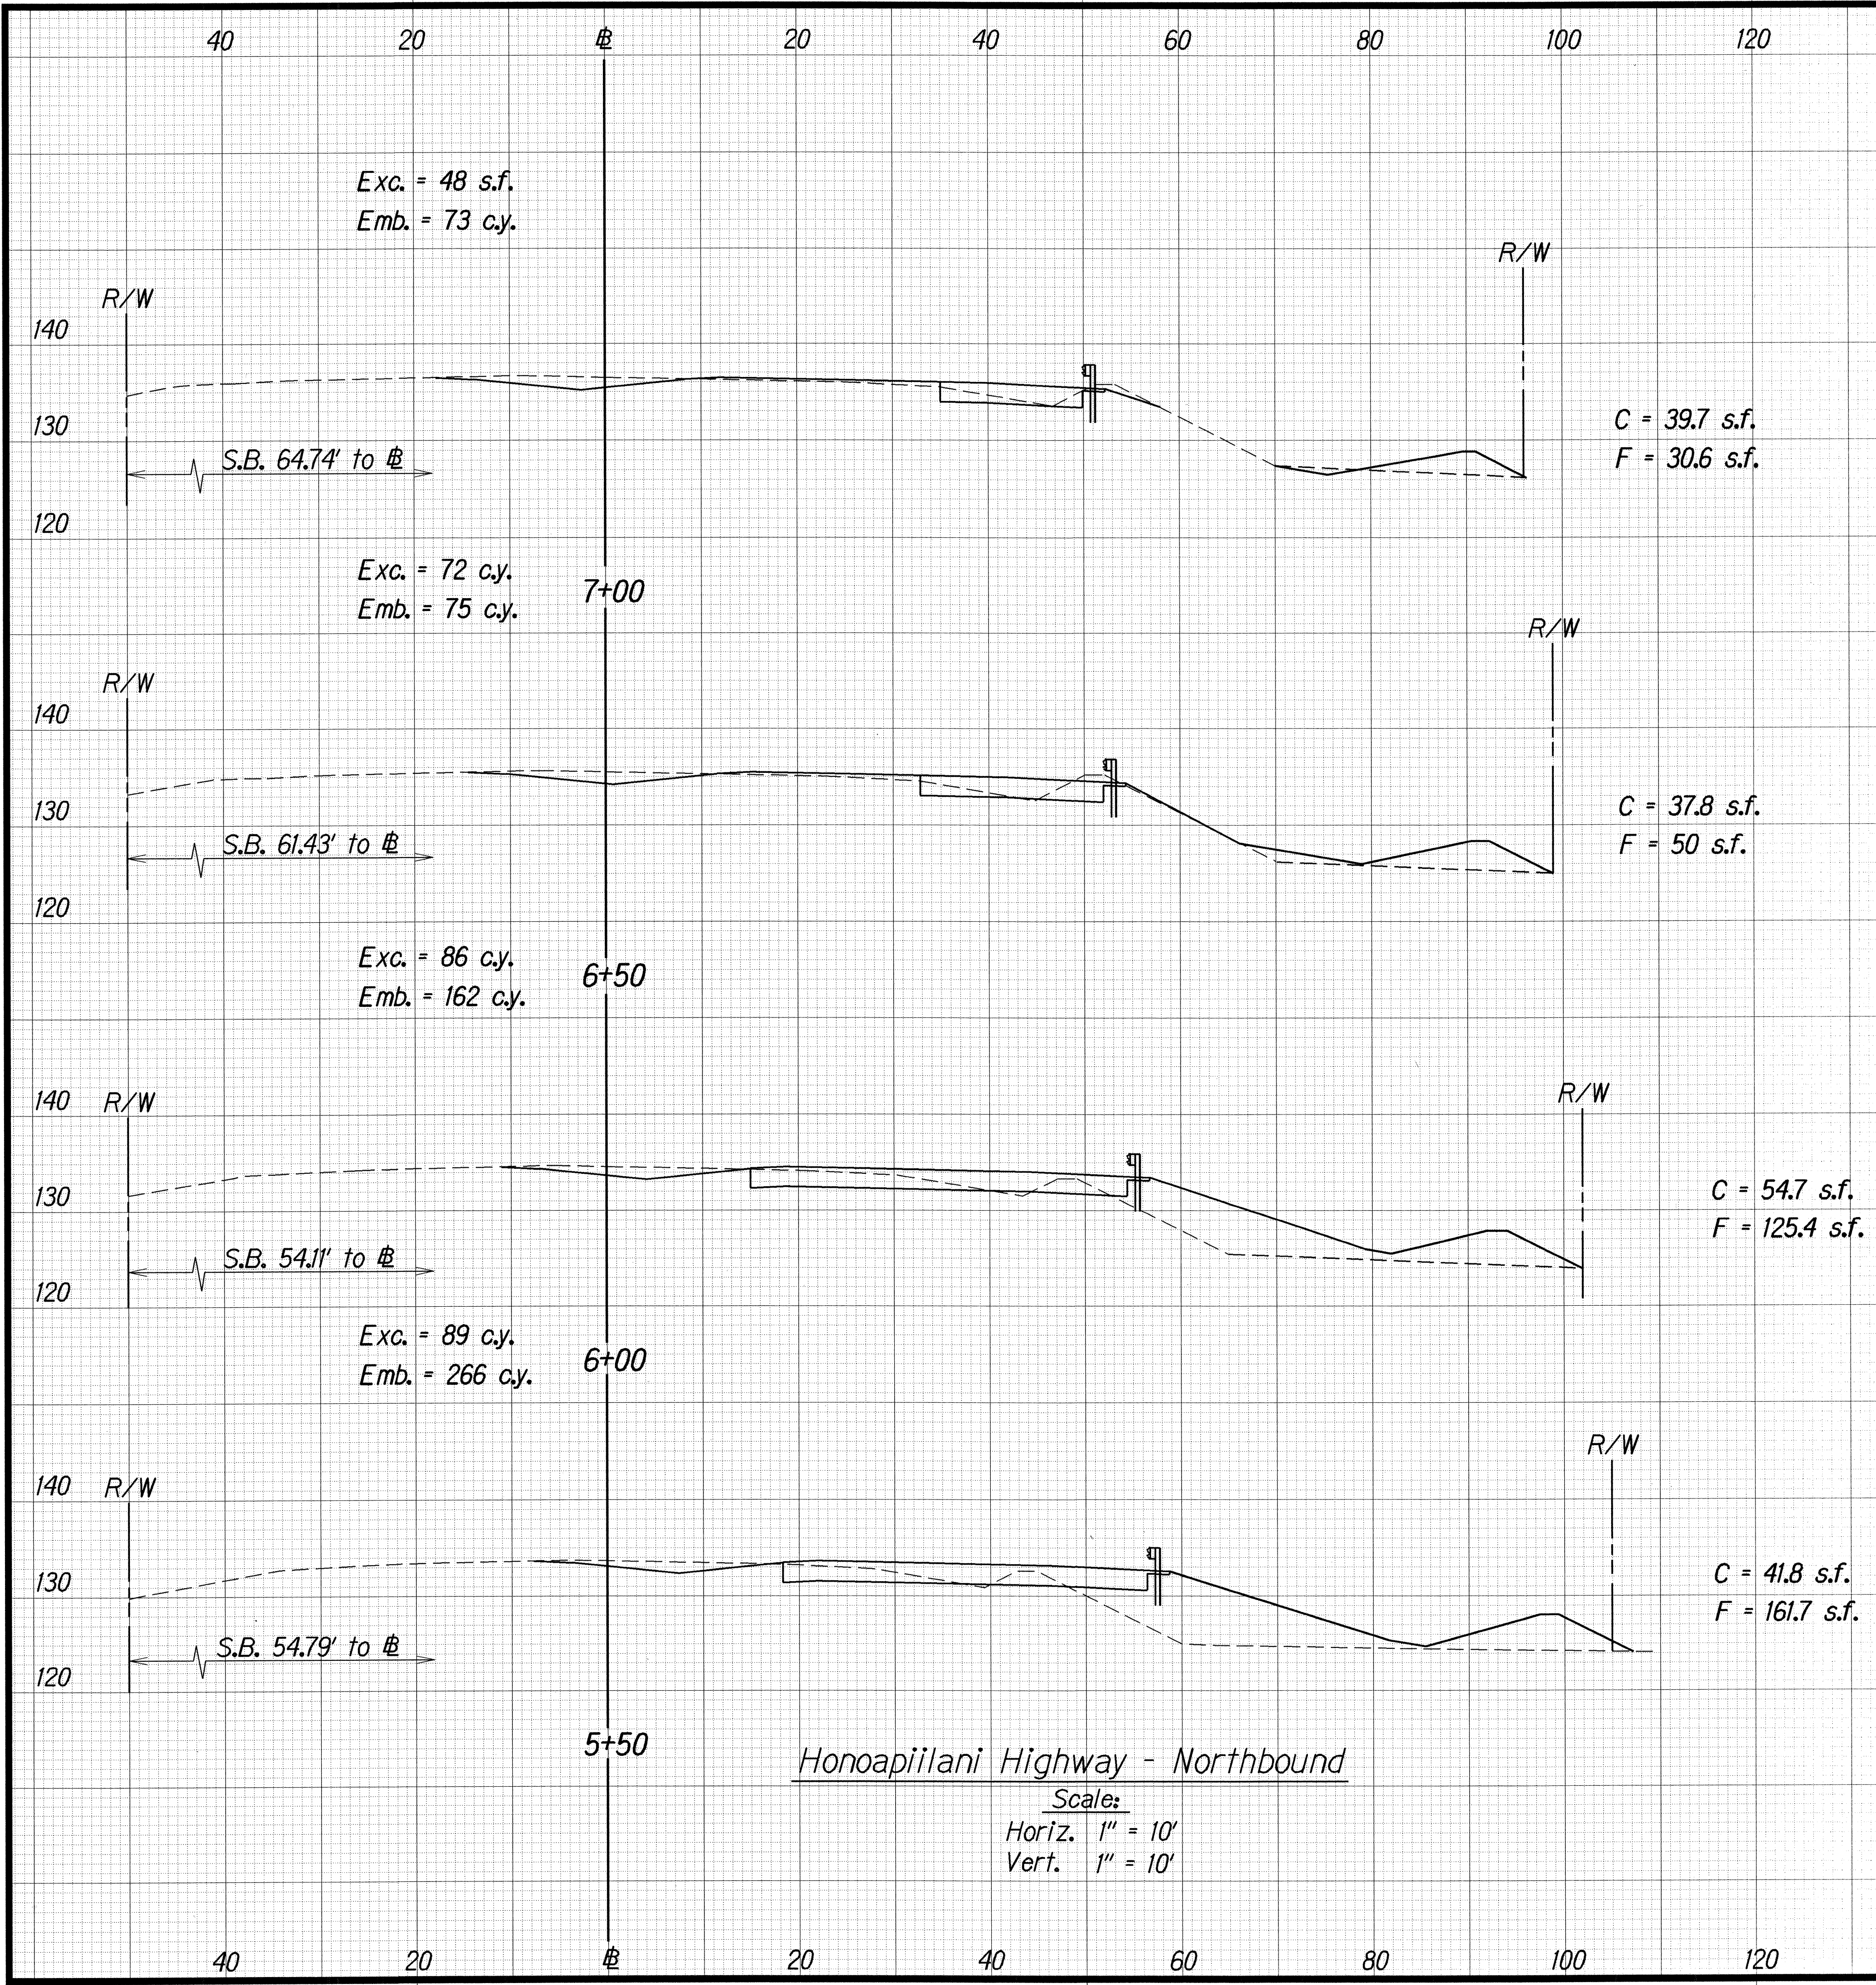

SURVEY PLOTTED BY \_\_\_\_\_ DATE 11/05/01  
 DRAWN BY \_\_\_\_\_  
 DESIGNED BY C. L. L. L.  
 NOTE BOOK 007,000  
 QUANTITIES BY 007,000  
 CHECKED BY 007,000



| FED. ROAD DIST. NO. | STATE | FED. AID PROJ. NO. | FISCAL YEAR | SHEET NO. | TOTAL SHEETS |
|---------------------|-------|--------------------|-------------|-----------|--------------|
| HAWAII              | HAW.  | NH-030-1(28)       | 2002        | 62        | 72           |

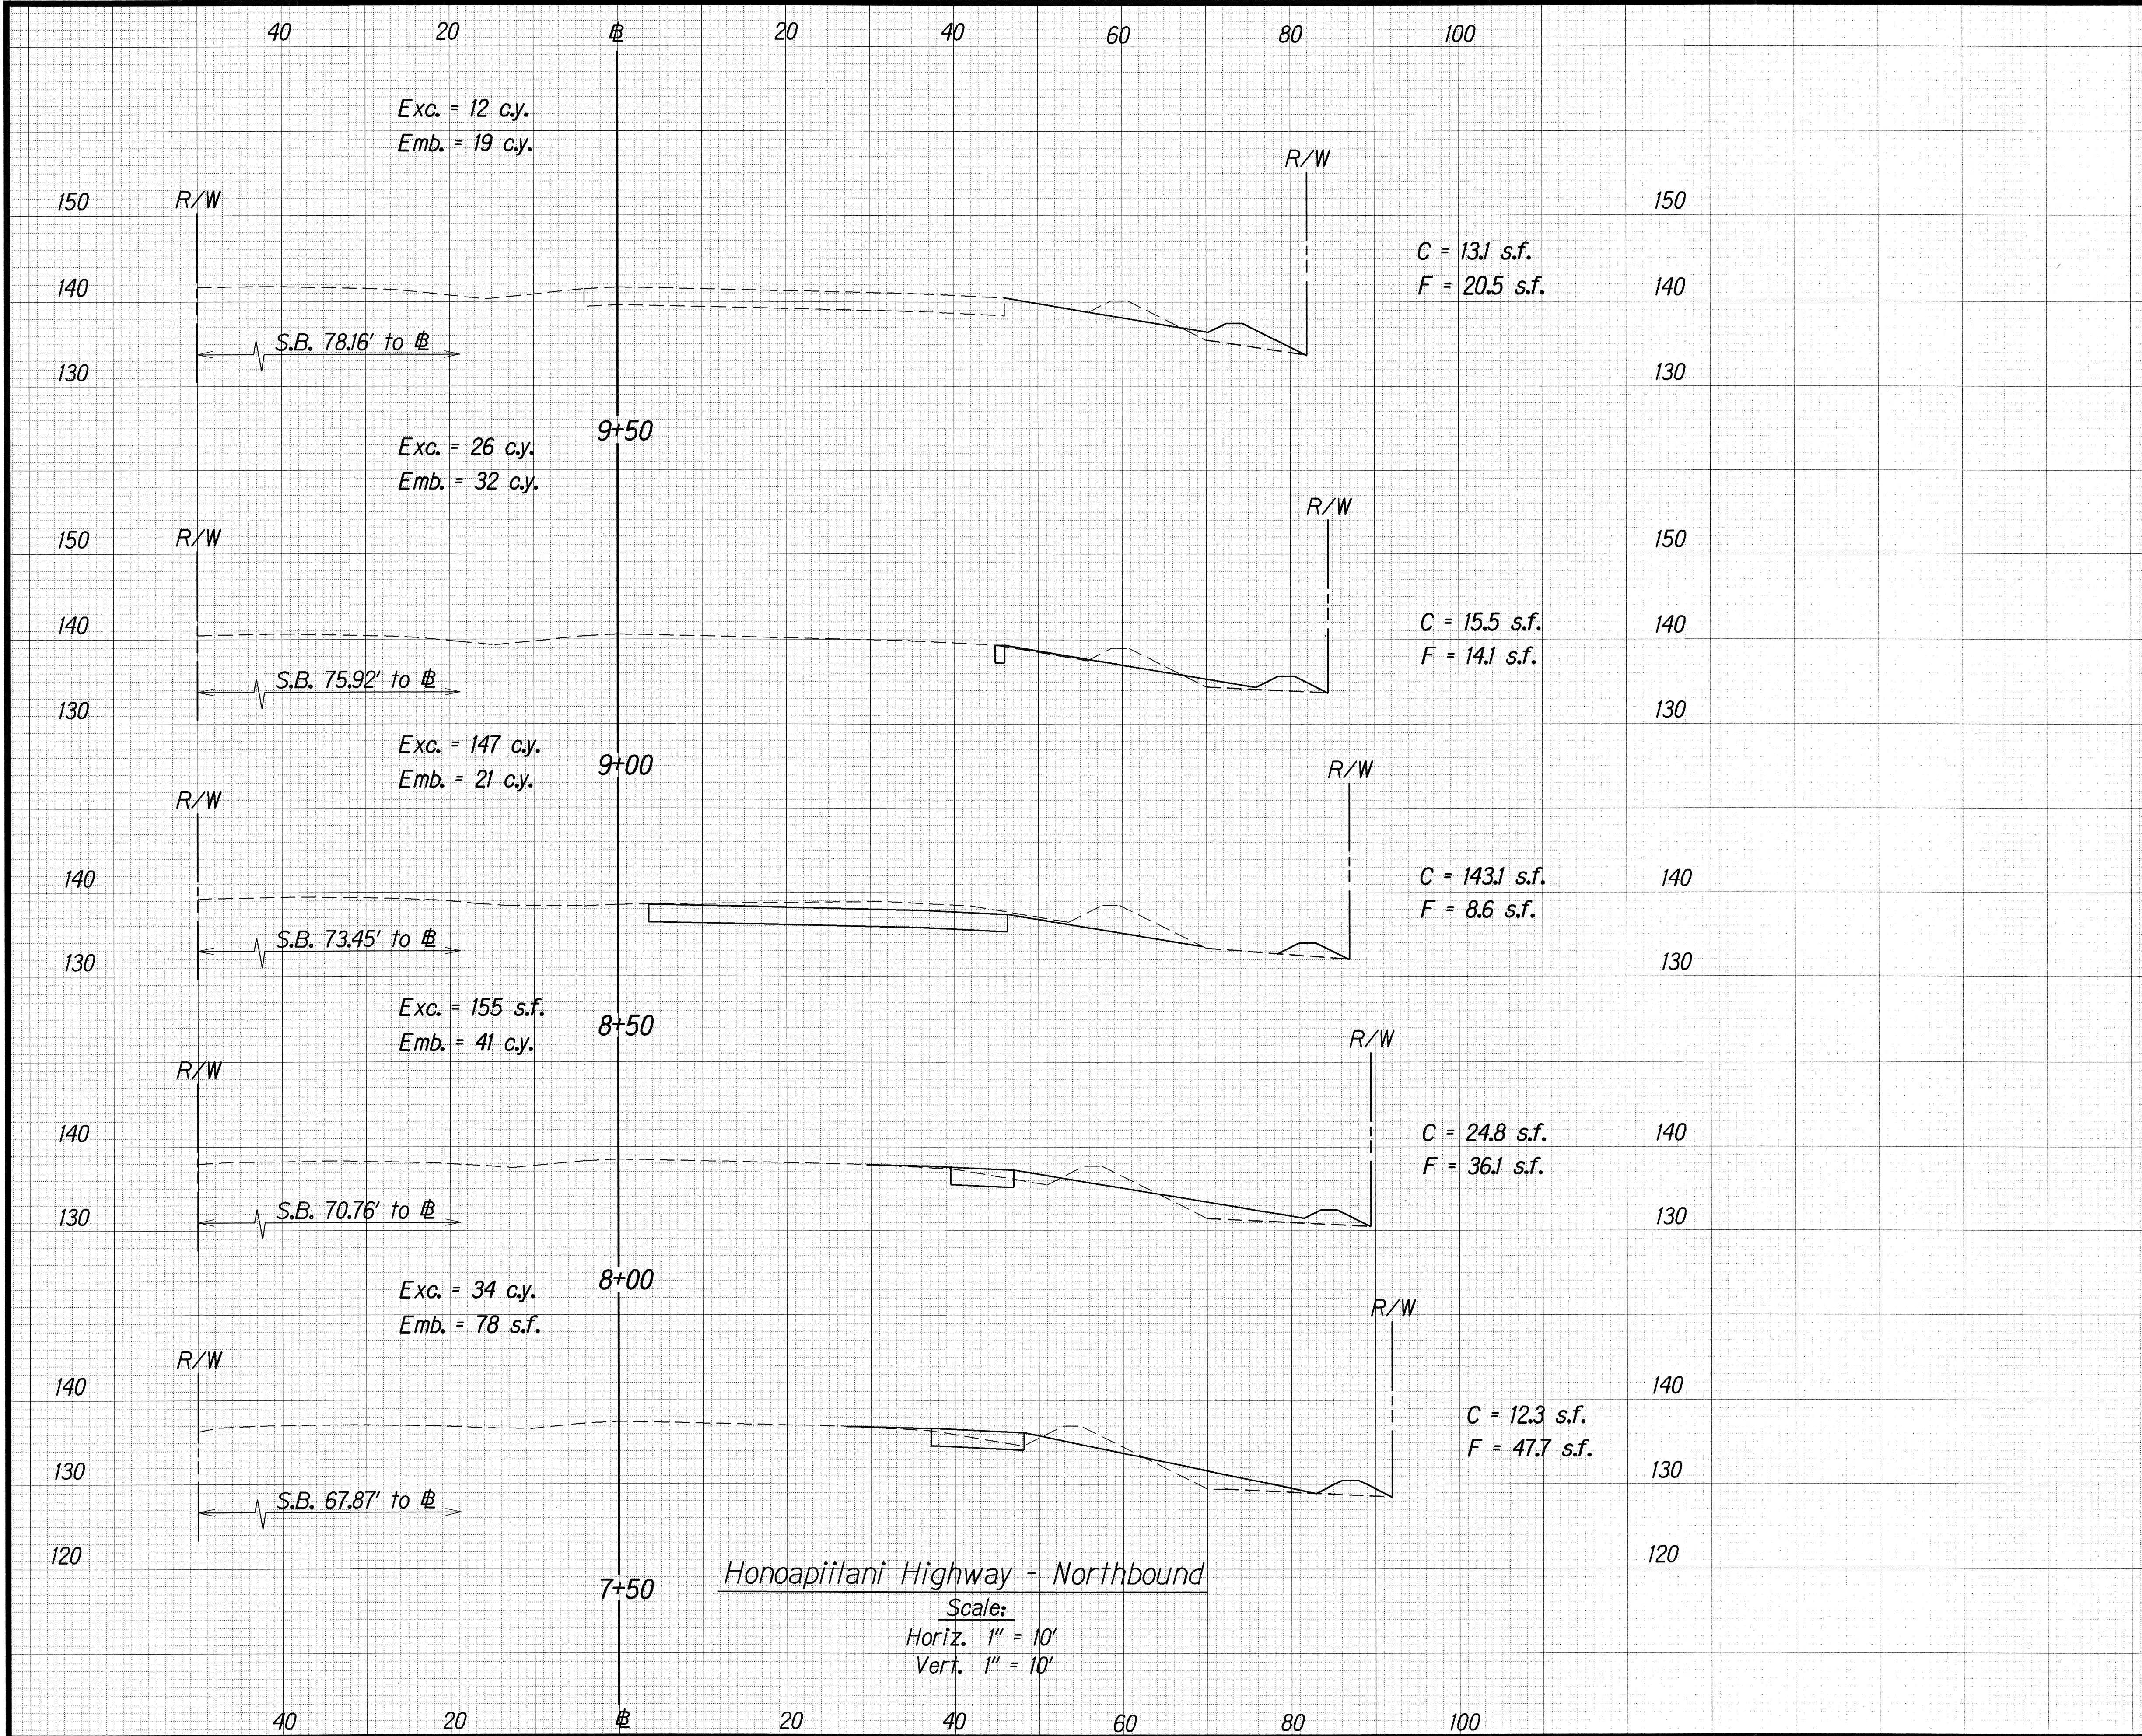

|                   |      |          |
|-------------------|------|----------|
| SURVEY PLOTTED BY | DATE | 11-05-01 |
| DRAWN BY          |      |          |
| DESIGNED BY       |      |          |
| NOTE BOOK         |      |          |
| QUANTITIES BY     |      |          |
| CHECKED BY        |      |          |