


FED. ROAD DIST. NO.	STATE	F.D. AID PROJ. NO.	FISCAL YEAR	SHEET NO.	TOTAL SHEETS
HAWAII	HAW.	NH-030-1(28)	2001	63	72

ELECTRICAL SYMBOLS

Symbol	Description
X	"X" ed Out Indicates Remove, See Demolition Notes this Sheet
/	"/" ed Out Indicates Relocate
⌋	existing utility pole to be removed by respective utility company
⊙ #50	existing utility pole, pole #50 indicated
⊙	Utility Pole, Provided by MECo
⊕	existing pole mounted transformer
⊕	Pole Mounted Transformer Provided by MECo
----->	existing anchor guy
----->	Anchor Guy Provided by Respective Utility Company
---*--->	existing anchor guy to be removed by respective utility company
⊕	KWH Meter
⊕	existing KWH Meter
■	MECo 2' x 4' Precast Concrete Pullbox with Precast Concrete Cover per MECo Standard Drawings, see Detail A/E9
■	HTCO 3' x 5" Reinforced Plastic Handhole with Two Piece "Non-Slip" Polymer "Parkway" rated Covers, Side Entry Knockouts, and Ground Rod, Provided in Accordance with HTCO Standard Drawing No. 34111
●	Street Light, 250 Watt HPS Single Luminaire, Metal Standard and Bracket Arm, Provided by MECo Conc. Foundation Provided by Contractor, see Detail A/E9
●	Street Light, 250 Watt HPS Single Luminaire and Bracket Arm, Mounted on Utility Pole, Provided by MECo, see Detail B/E8
○	existing street light
⊗	existing street light, removed by MECo
—E—	Electric Ductline
—e/ug—	existing u.g. elec ductline and wiring
—*e/ug*	remove existing wiring; cap ends of existing elec ducts and abandon in place
—T—	Tel Ductline
—t/ug—	existing u.g. tel ductline and wiring
—*t/ug*	remove existing wiring; cap ends of existing tel ducts and abandon in place
—SL—	Street Light Ductline
—s l—	existing u.g. street light ductline and wiring
—E/OH—	Overhead Elec Lines to be Provided by Respective Utility Company
—e/oh—	existing overhead elec lines
—T/OH—	Overhead Tel Lines to be Provided by Respective Utility Company
—t/oh—	existing tel overhead lines
—*e/oh*	existing overhead elec lines to be removed by respective utility co.
—*t/oh*	existing overhead tel lines to be removed by respective utility co.
⊕	Duct Section Designator, Type "A" Ductline and Type "2L" Duct Indicated, see Sheet E10 for Duct Sections and Conduit Schedule

General Electrical Notes

1. Electrical Work shall be New Unless Otherwise Noted.
2. "Wiring" Indicates Insulated Wires in Conduit.
3. Contractor shall Tune to Determine Exact Location of Existing Utilities & Adjust His Work Accordingly.
4. The Locations of the Various Existing Utilities Shown on the Contract Drawings were Determined on the Basis of Best Available Information. Therefore, No Assurance is Provided that the Actual Locations will be Precisely as Shown on the Contract Drawings. The Contractor shall verify the Locations and Depths of the Facilities and Exercise Proper Care in Excavating the Area. The Contractor shall be Held Responsible for any Damages to the Facilities.
5. In Performing All Work, the Contractor shall Exercise Due Care and Caution Necessary to Avoid any Damage to and Impairment in the use of any Existing Utility Line. Any Damage Inflicted on Existing Utility Lines Resulting from the Contractor's Operations shall be Immediately Repaired or Restored as Directed by the State at the Contractor's Expense.
6. All Electric/Signal Ducts shall have a Minimum Clearance of 1'-0" when Crossing Water/Sewer Lines.
7. All Dimensions are Nominal. Verify Exact Dimensions & Equipment Requirements with the Successful Supplier.
8. The Contractor shall be Liable for any Damage to Maui Electric Co. Facilities and shall Immediately Report such Damages to Maui Electric Co.'s Trouble Dispatcher at 871-7777.
9. All Maui Electric Co. Overhead Facilities shown on these Plans or whose Approximate Locations within the Project Boundaries have been made known by any Reasonable Means at any time to the Contractor shall be Protected at all Times by the Contractor during Construction. Costs for the Damages to Maui Electric Co. Facilities may be Borne by the Contractor. This Repair Work shall be done by Maui Electric Co. or by the Contractor under Maui Electric Co.'s Supervision.
10. Any Work Required to Remove/Relocate Maui Electric Co. Facilities shall be done by Maui Electric Co. The Contractor shall be Responsible for Coordination.
11. The Project Site Contains Various Maui Electric Co. Lines Operated at 69KV, 23KV, 12.47KV and Various other Secondary Voltages. These Lines must Remain Active. Therefore, the Contractor shall Utilize such Methods, Equipment, Etc., Necessary to Protect His Personnel, the Public, State Personnel, Property, Equipment, Etc.
12. Due to Ongoing Construction & Maintenance, Conditions Indicated in these Drawings may have Changed. Therefore, the Contractor shall verify all Existing Conditions prior to Work.
13. Verizon Hawaii is hereinafter referred to as Hawaiian Telephone Co

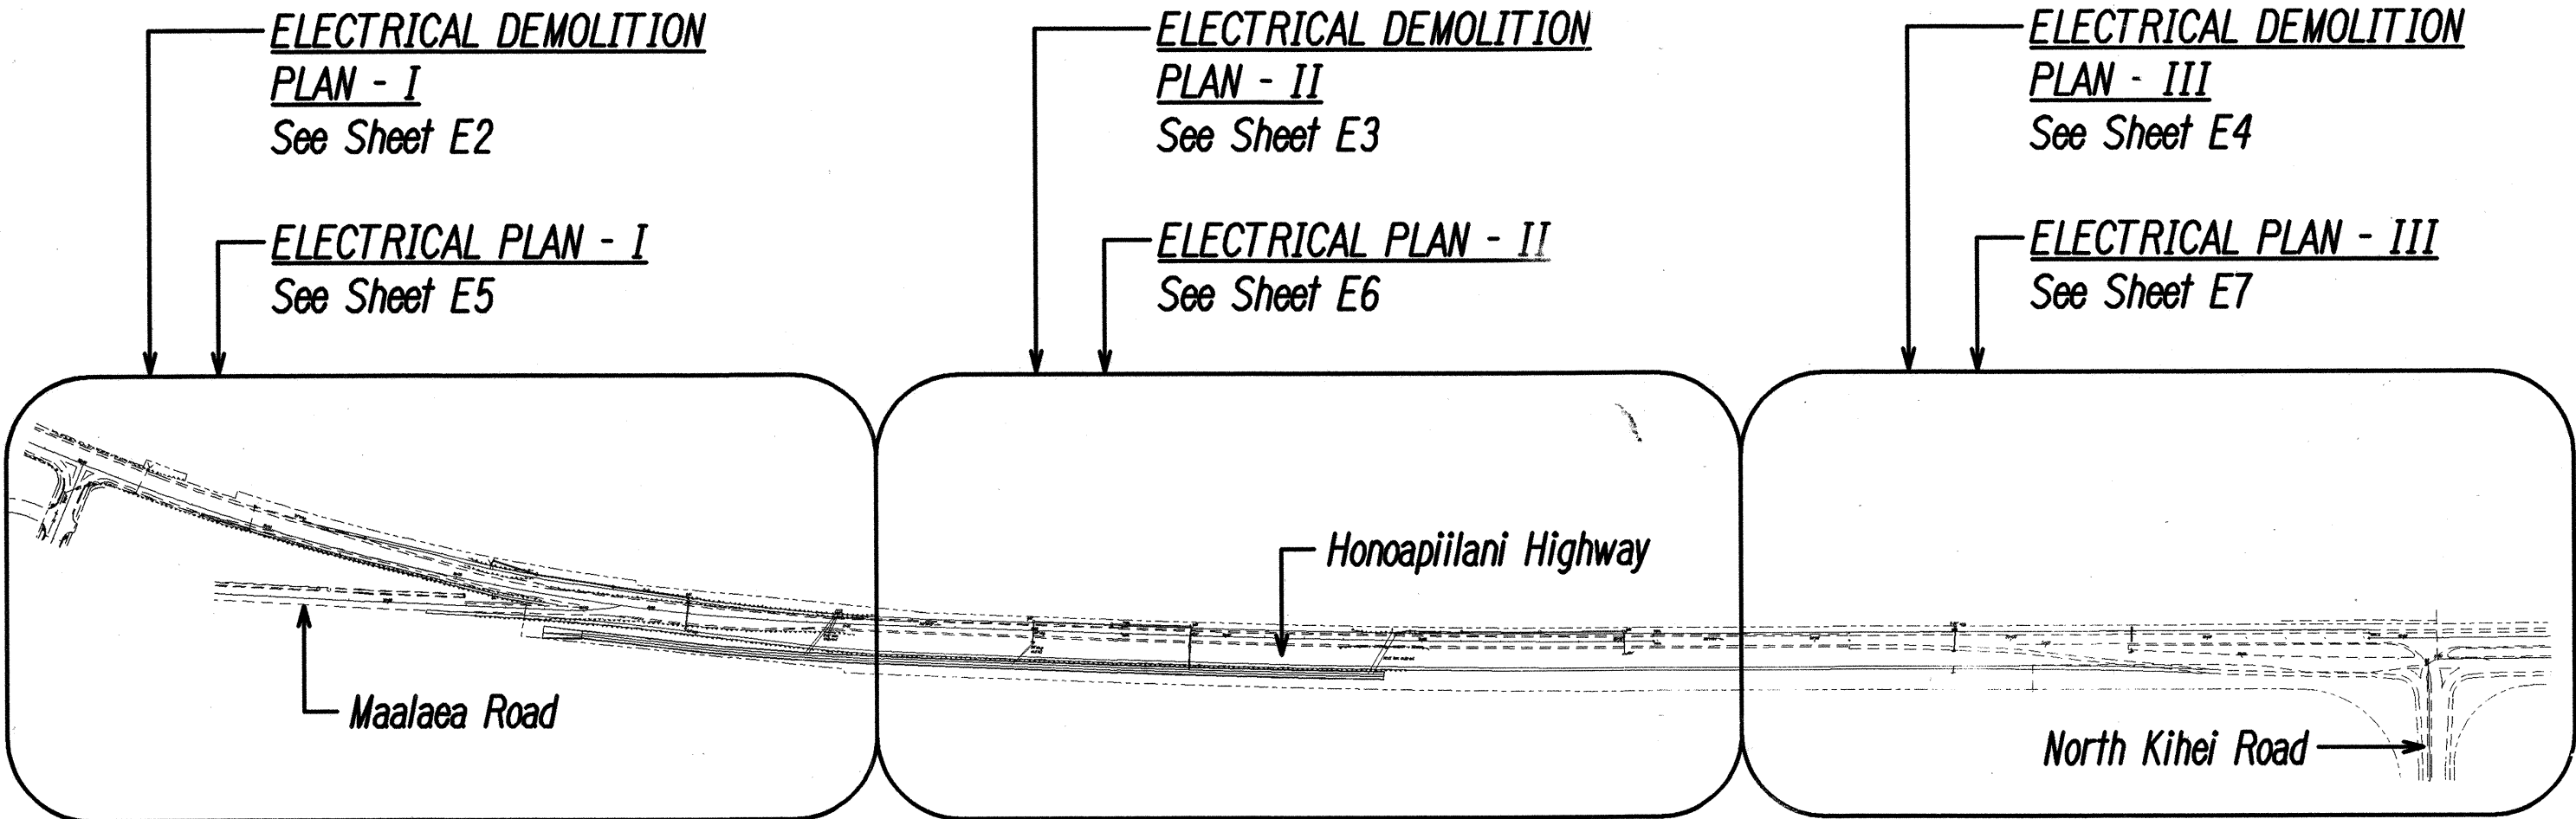

ELECTRICAL SITE PLAN
Not to Scale

Street Light Standard Identification Legend:

Legend	Description
1 121+93	Station Number
2 2	Street Light Pole Number
3 14'	Pole Clear Setback from Edge of Pavement, See Note No. 1 below
4 15'	Luminaire Arm Span in Feet
5 TB	Pole Base Mounting Typs, see Note No. 2 below
6 30'	Luminaire Mounting Height above Pavement

Symbol Notes:

1. "BG" indicates Pole Located behind Guardrail. Pole shall be Located Minimum 2'-0" Clear from Guardrail.
2. "TB" indicates Transformer Base Mounting. "PM" indicates Joint Pole Mounted.

Demolition Notes

1. Work shall be done in Phases. Verify with Engineer for Phasing Sequence. Provide all Wiring and Connections, per NEC, State, Utility Requirements, to Ensure Continuity of Service to Existing Equipment to Remain in use at No Additional Cost to the State.
2. The Contractor shall verify all Existing Circuit Wiring prior to any Demolition Work.
3. Remove all Abandoned Wires.
4. Where Contract Documents Indicate Wiring is to be Removed:
A. Remove Existing Cables In Conduit.
B. Remove Conduits that will Interfere with Work. Abandon Conduits that are Concealed below Finished Grade.
C. Break and Remove Pullboxes/Handholes. Fill Holes with Base Course and Repair to Match Adjacent Surfaces.
5. For Circuit(s) where Existing Electrical Equipment shall be Removed, The Contractor Shall Provide all Necessary Raceways, Wires, Boxes, Etc., per NEC Requirements, to Ensure Circuit Continuity to and Proper Operation of the Remaining Component(s).
6. Demolition and Removal Work shall be Considered Incidental to the Various Contract Items.

SURVEY PLOTTED BY	DATE
DRAWN BY	
DESIGNED BY	
NOTE BOOK	
CHECKED BY	
NO.	

STEVEN H. SAKAI
LICENSED PROFESSIONAL ENGINEER
No. 7637-E
HAWAII, U.S.A.

STATE OF HAWAII
DEPARTMENT OF TRANSPORTATION
HIGHWAYS DIVISION


ELECTRICAL SITE PLAN
ELECTRICAL SYMBOLS

HONOAPIILANI HIGHWAY WIDENING
Maalaea Road to North Kihei Road
E.A. Project No. NH-030-1(28)

Scale: As Noted Date: July 2001


SHEET N 61 OF 72 SHEETS

FED. ROAD DIST. NO.	STATE	FISCAL YEAR	SHEET NO.	TOTAL SHEETS
HAWAII	HAW.	2001	64	72

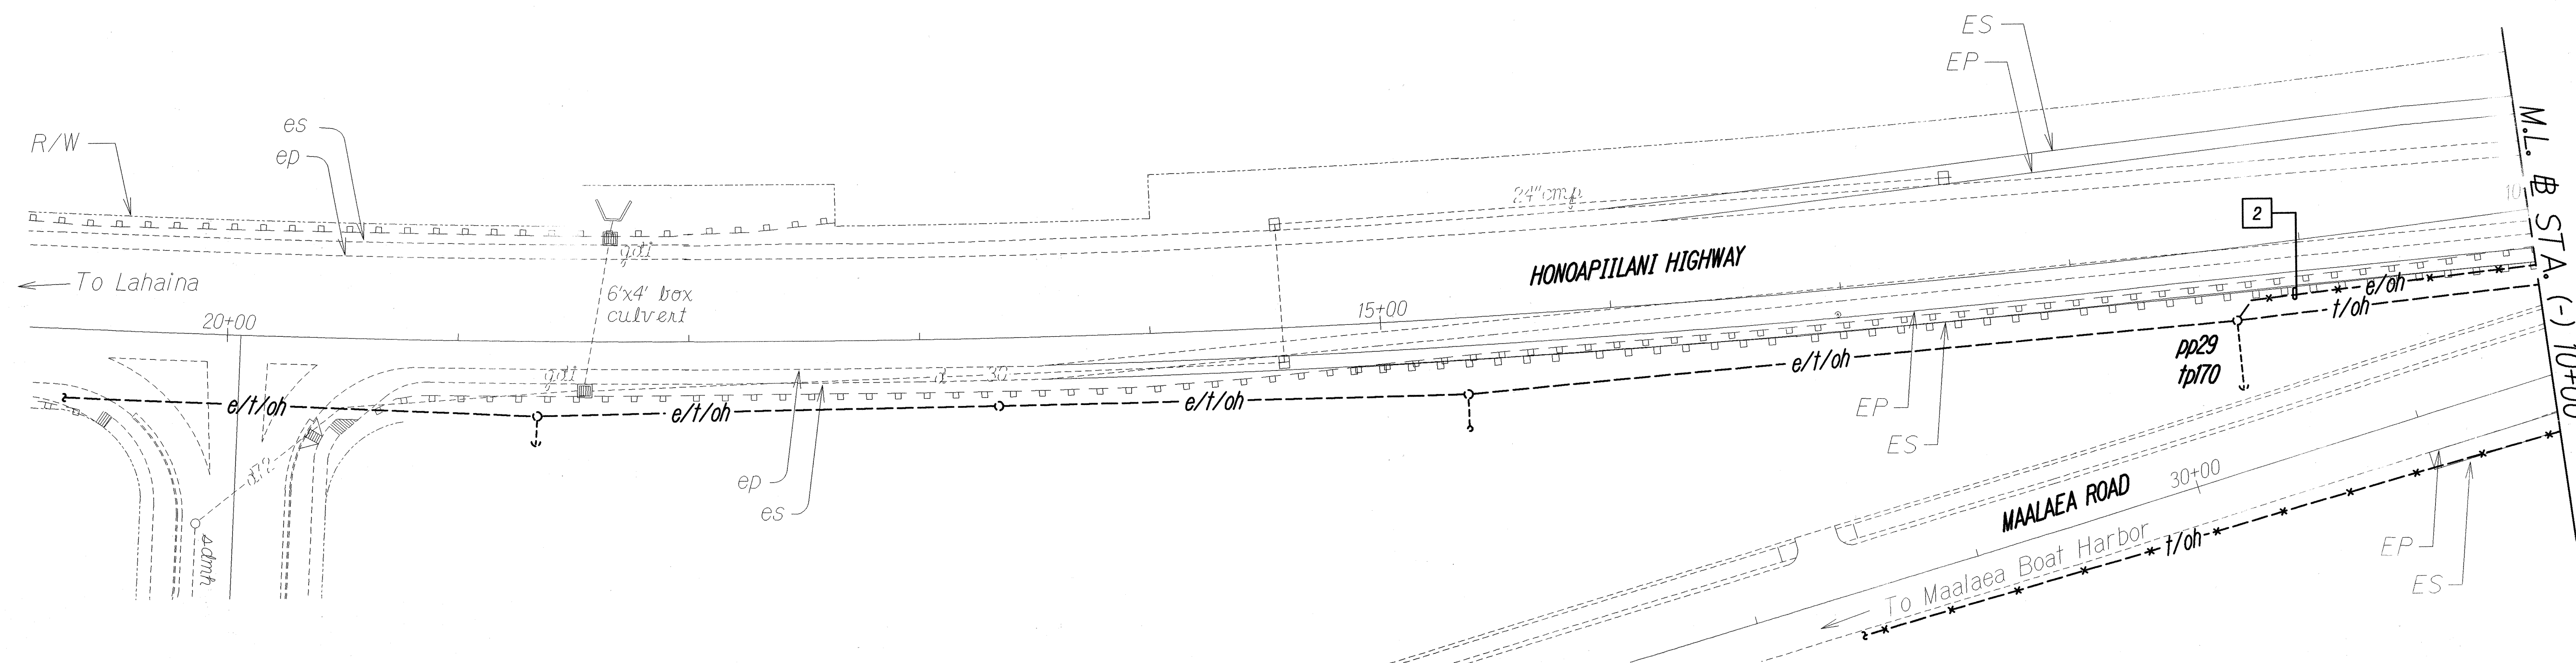


Notes:

- 1 Existing utility pole to be removed/relocated by respective utility company.
- 2 Existing utility overhead lines to be removed/relocated by respective utility company.


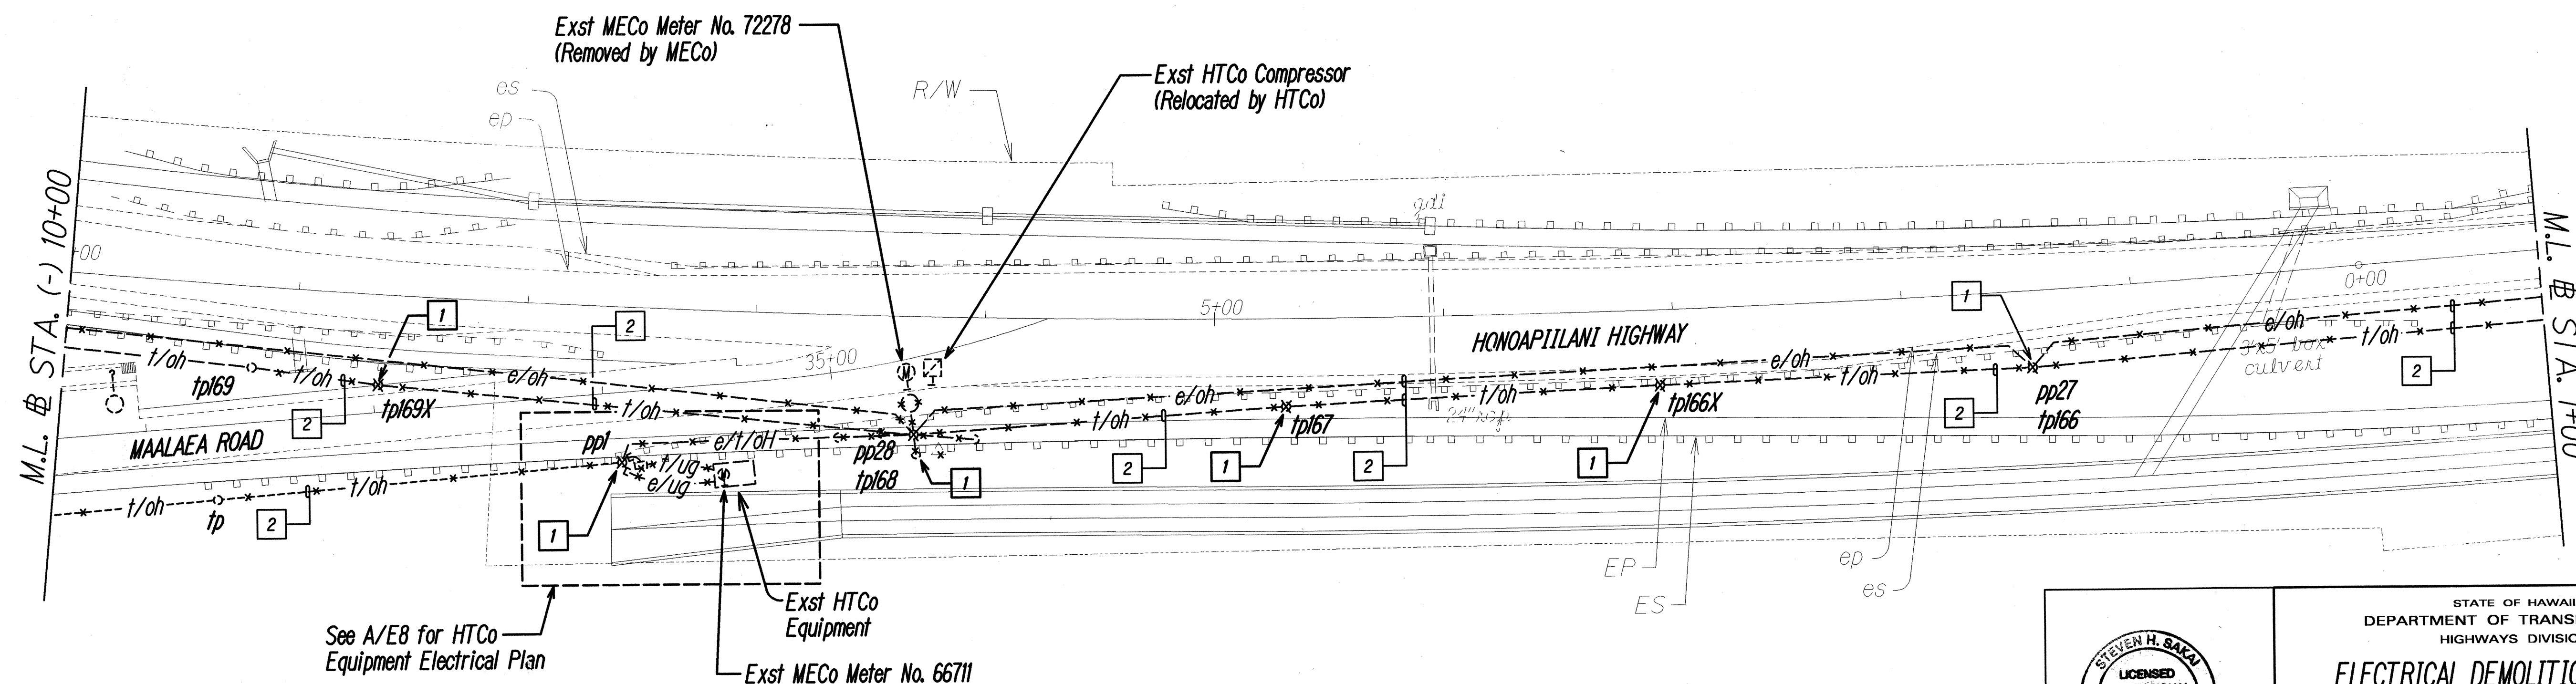


DATE	_____
SURVEY PLOTTED BY	_____
DESIGNED BY	_____
TRACED BY	_____
NOTE BOOK	_____
QUANTITIES BY	_____
CHECKED BY	_____

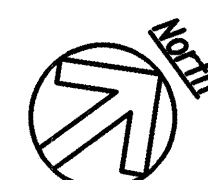

ELECTRICAL DEMOLITION PLAN - I

Scale: 1"=40'-0"

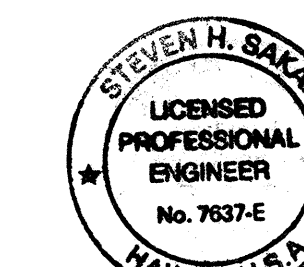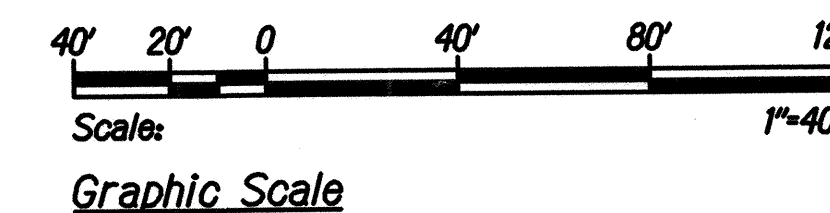

This Work was Prepared by Me or Under My Supervision

STATE OF HAWAII
DEPARTMENT OF TRANSPORTATION
HIGHWAYS DIVISION


ELECTRICAL DEMOLITION PLAN - I

HONOAPIILANI HIGHWAY WIDENING
Maalaea Road to North Kihel Road
F.A. Project No. NH-030-K(28)

Scale: 1"=40' Date: July 2001


SHEET NO. E2 OF 72 SHEETS

FED. ROAD DIST. NO.	STATE	FED. AID PROJ. NO.	FISCAL YEAR	SHEET NO.	TOTAL SHEETS
HAWAII	HAW.	NH-030-1(28)	2001	65	72

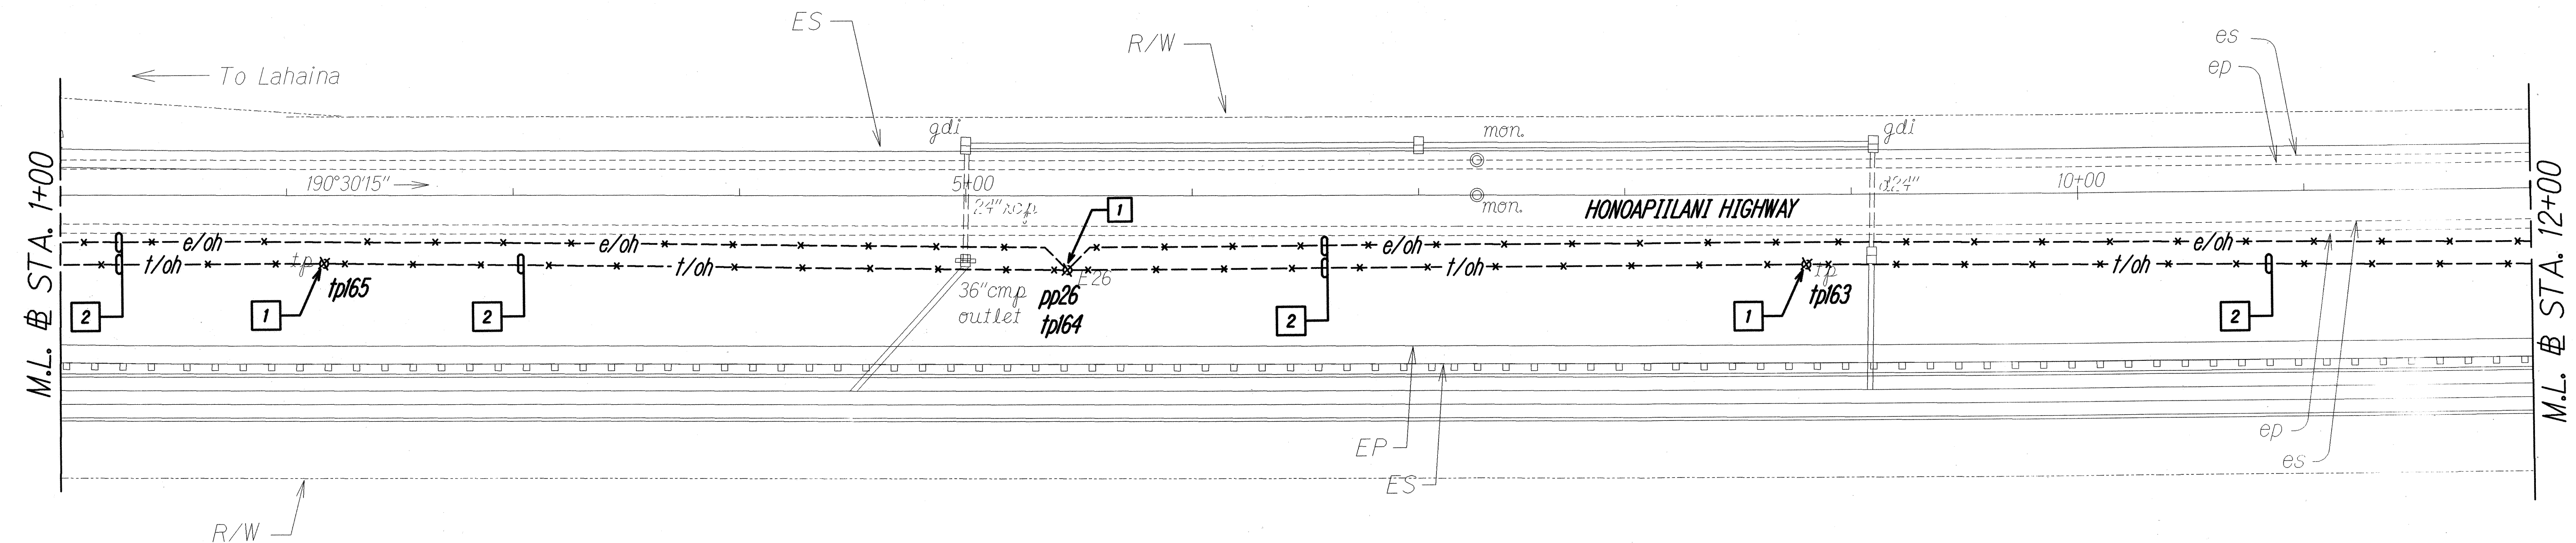


Notes:



- 1 Existing utility pole to be removed/relocated by respective utility company.
- 2 Existing utility overhead lines to be removed/relocated by respective utility company.

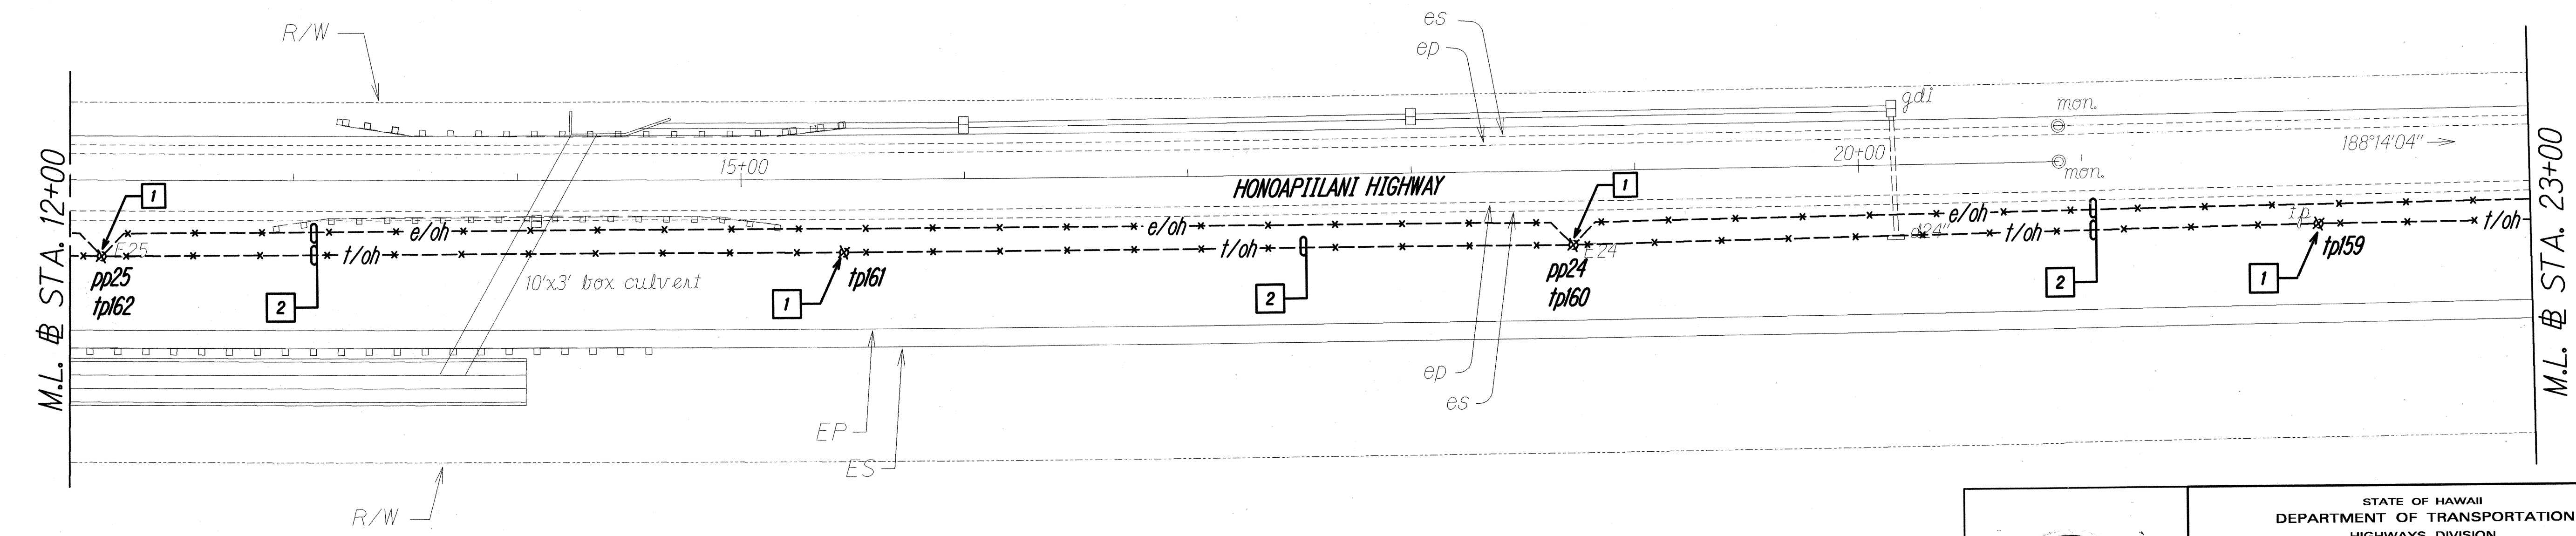

SURVEY PLOTTED BY	DATE
DRAWN BY	
DESIGNED BY	
NOTE BOOK	
QUANTITIES BY	
CHECKED BY	

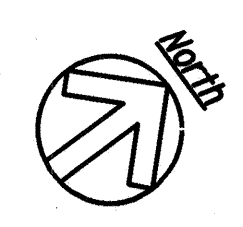

ELECTRICAL DEMOLITION PLAN - II
Scale: 1"=40'-0"

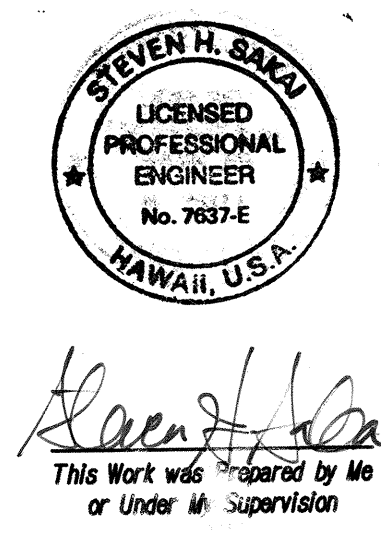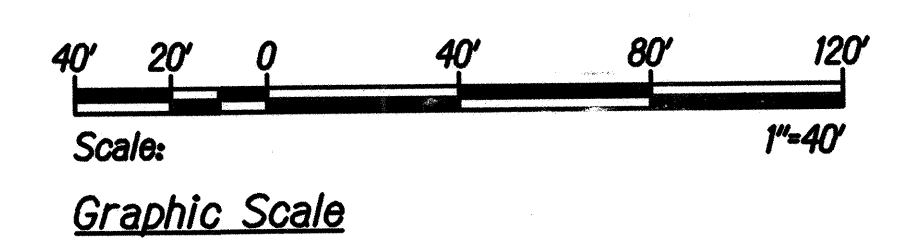

STATE OF HAWAII
DEPARTMENT OF TRANSPORTATION
HIGHWAYS DIVISION

ELECTRICAL DEMOLITION PLAN - II

HONOAPIʻILANI HIGHWAY WIDENING
Maalaea Road to North Kihei Road
F.A. Project No. NH-030-1(28)


Scale: 1"=40' Date: July 2001

SHEET No. 65 OF 72 SHEETS

FED. ROAD DIST. NO.	STATE	FED. AID PROJ. NO.	FISCAL YEAR	SHEET NO.	TOTAL SHEETS
HAWAII	HAW.	NH-030-K(28)	2001	67	72

Notes:

- 1 Ductline to Cross Under Drainline, See Typical Utility Crossing Detail.
- 2 Riser up Pole per Utility Company Requirements. See C/E9 and D/E9 for Typical Pole Riser Details.
- 3 Provide Meter Socket and Pole Riser for HTCO Compressor Equipment. Equipment Connection by HTCO.
- 4 Utility Pole Provided by MECO (Typ).
- 5 Overhead Utility Lines Provided by Respective Utility Company (Typ).

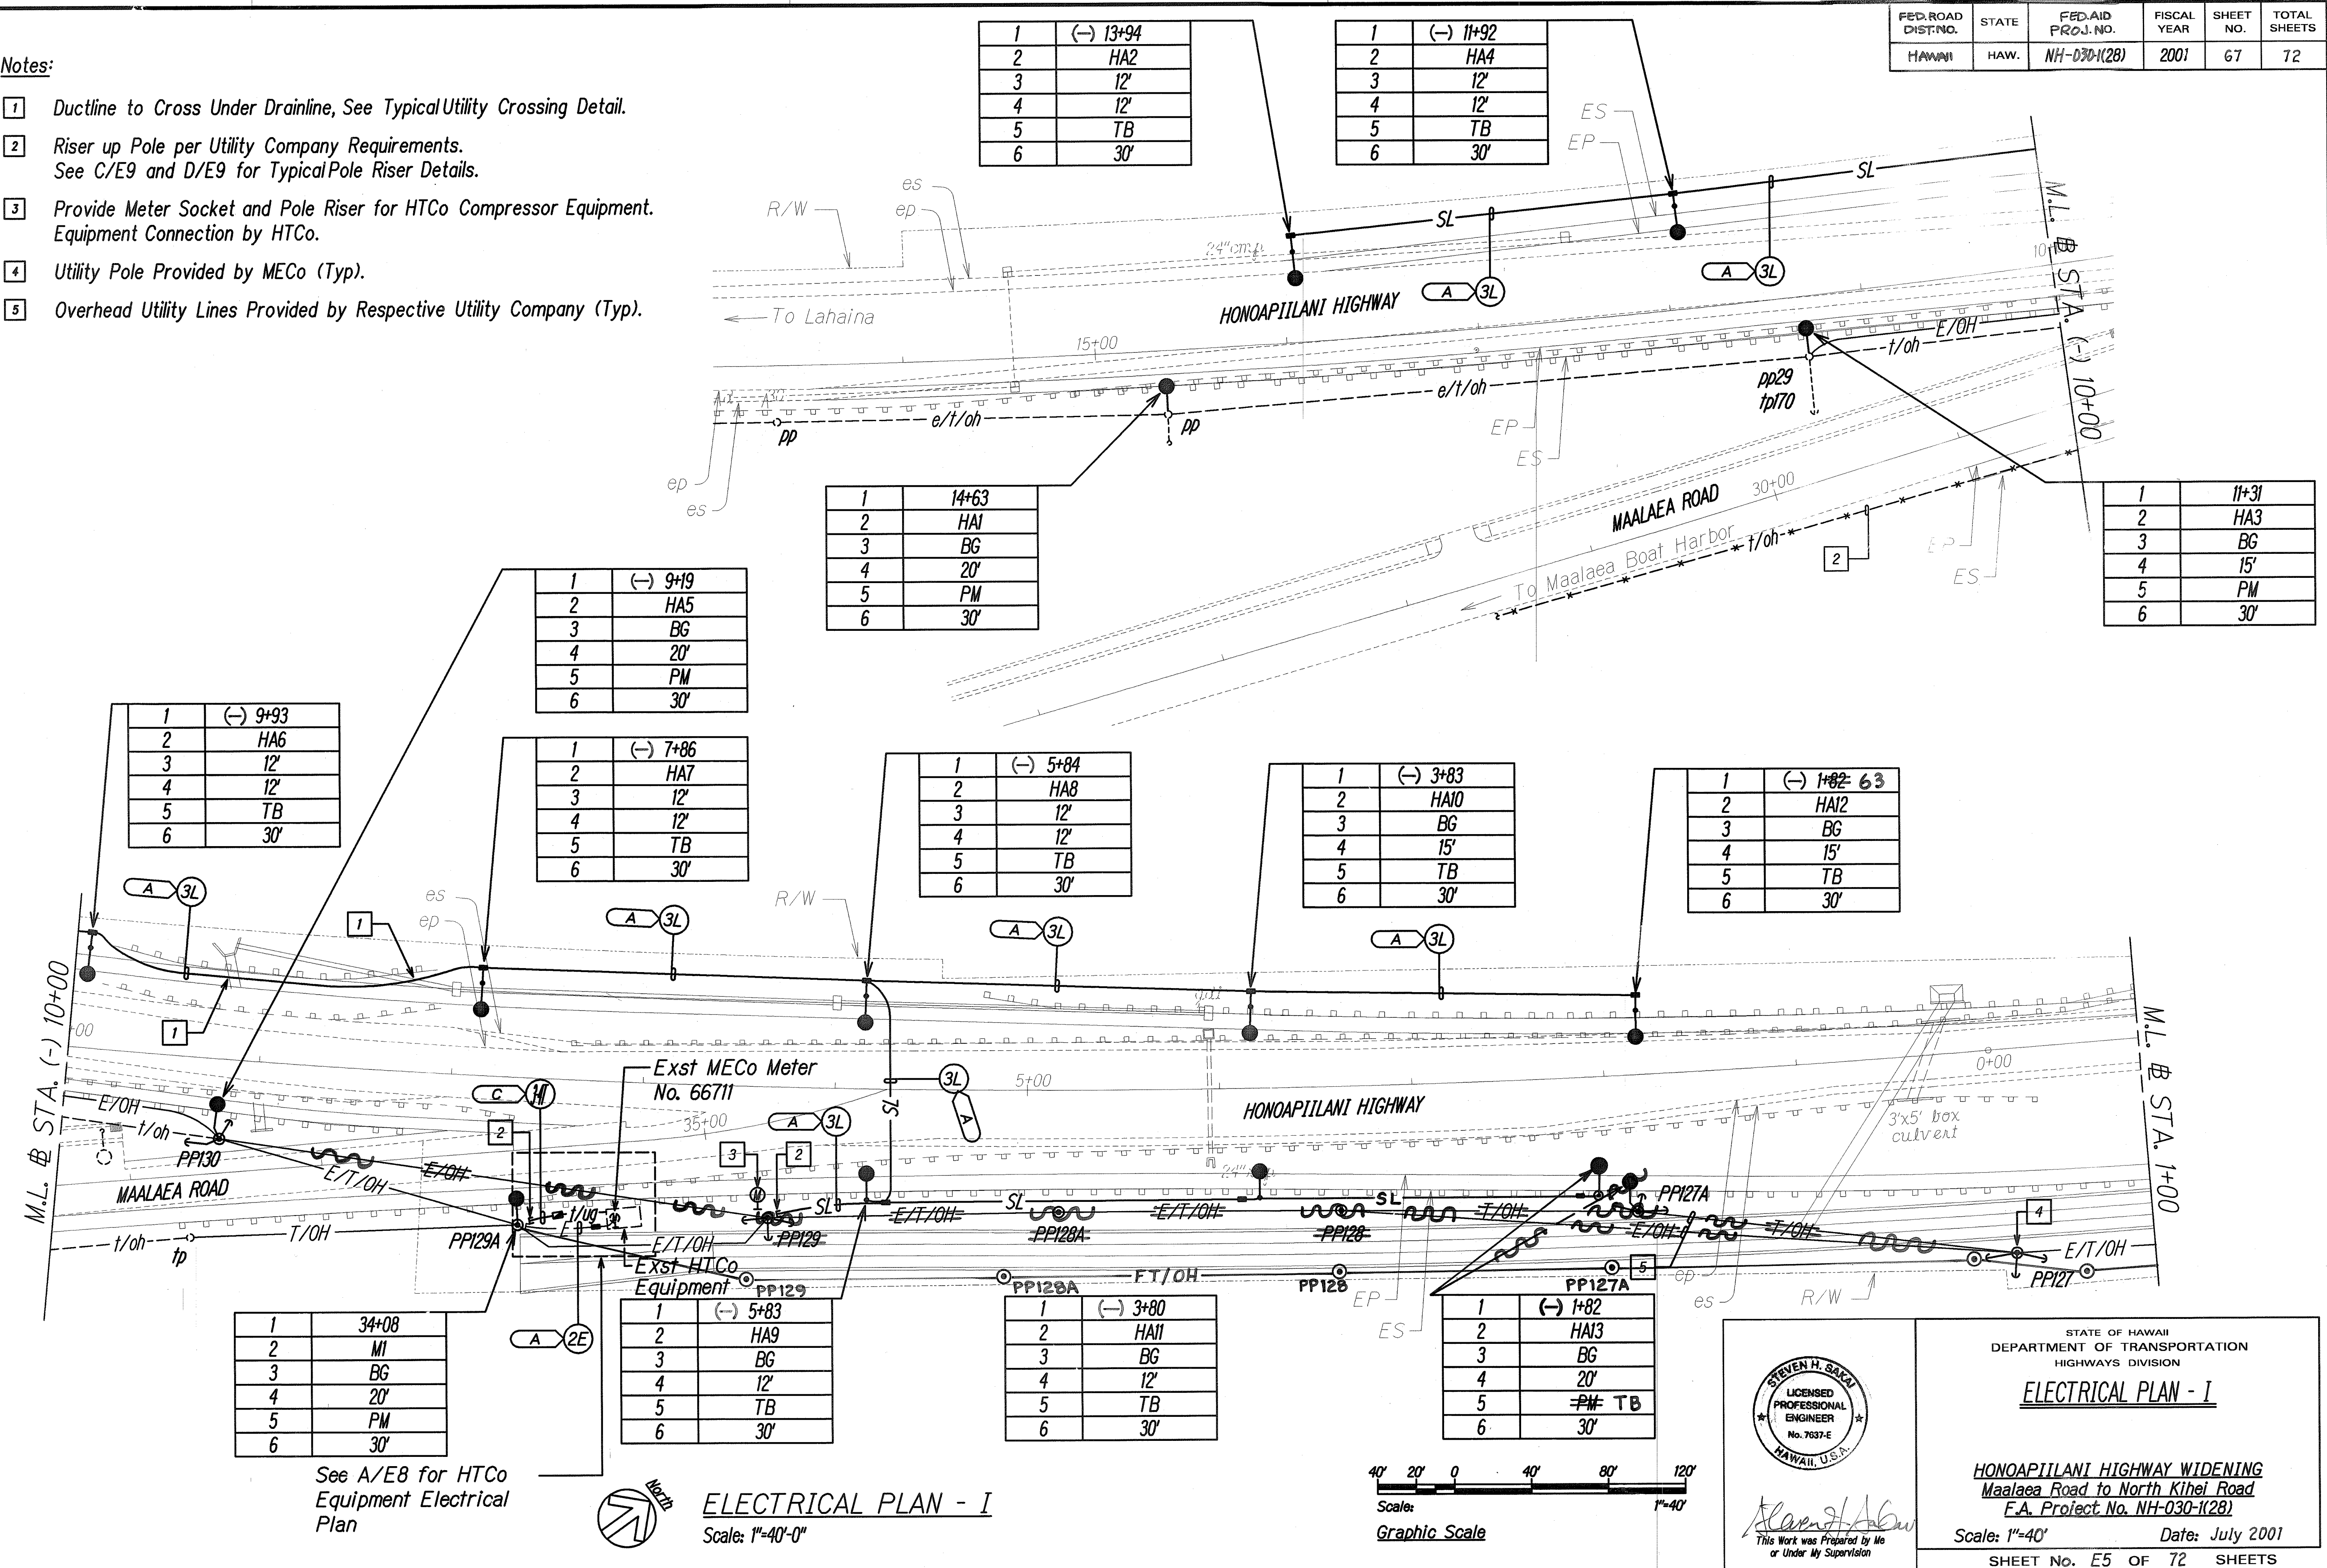

DATE	_____
SURVEY PLOTTED BY	_____
ORIGINAL PLAN	_____
TRACED BY	_____
NOTE BOOK	_____
QUANTITIES BY	_____
CHECKED BY	_____
No.	_____

STEVEN H. BAKAL
LICENSED PROFESSIONAL ENGINEER
No. 7637-E
HAWAII, U.S.A.

Steven H. Bakal
This Work was Prepared by Me or Under My Supervision

STATE OF HAWAII
DEPARTMENT OF TRANSPORTATION
HIGHWAYS DIVISION

ELECTRICAL PLAN - I


HONOAPIILANI HIGHWAY WIDENING
Maalaea Road to North Kihel Road
F.A. Project No. NH-030-K(28)

Scale: 1"=40' Date: July 2001

SHEET No. E5 OF 72 SHEETS


"AS-BUILT"

FED. ROAD DIST. NO.	STATE	FED. AID PROJ. NO.	FISCAL YEAR	SHEET NO.	TOTAL SHEETS
3WAI	HAW.	NH-030-1(28)	2001	68	72

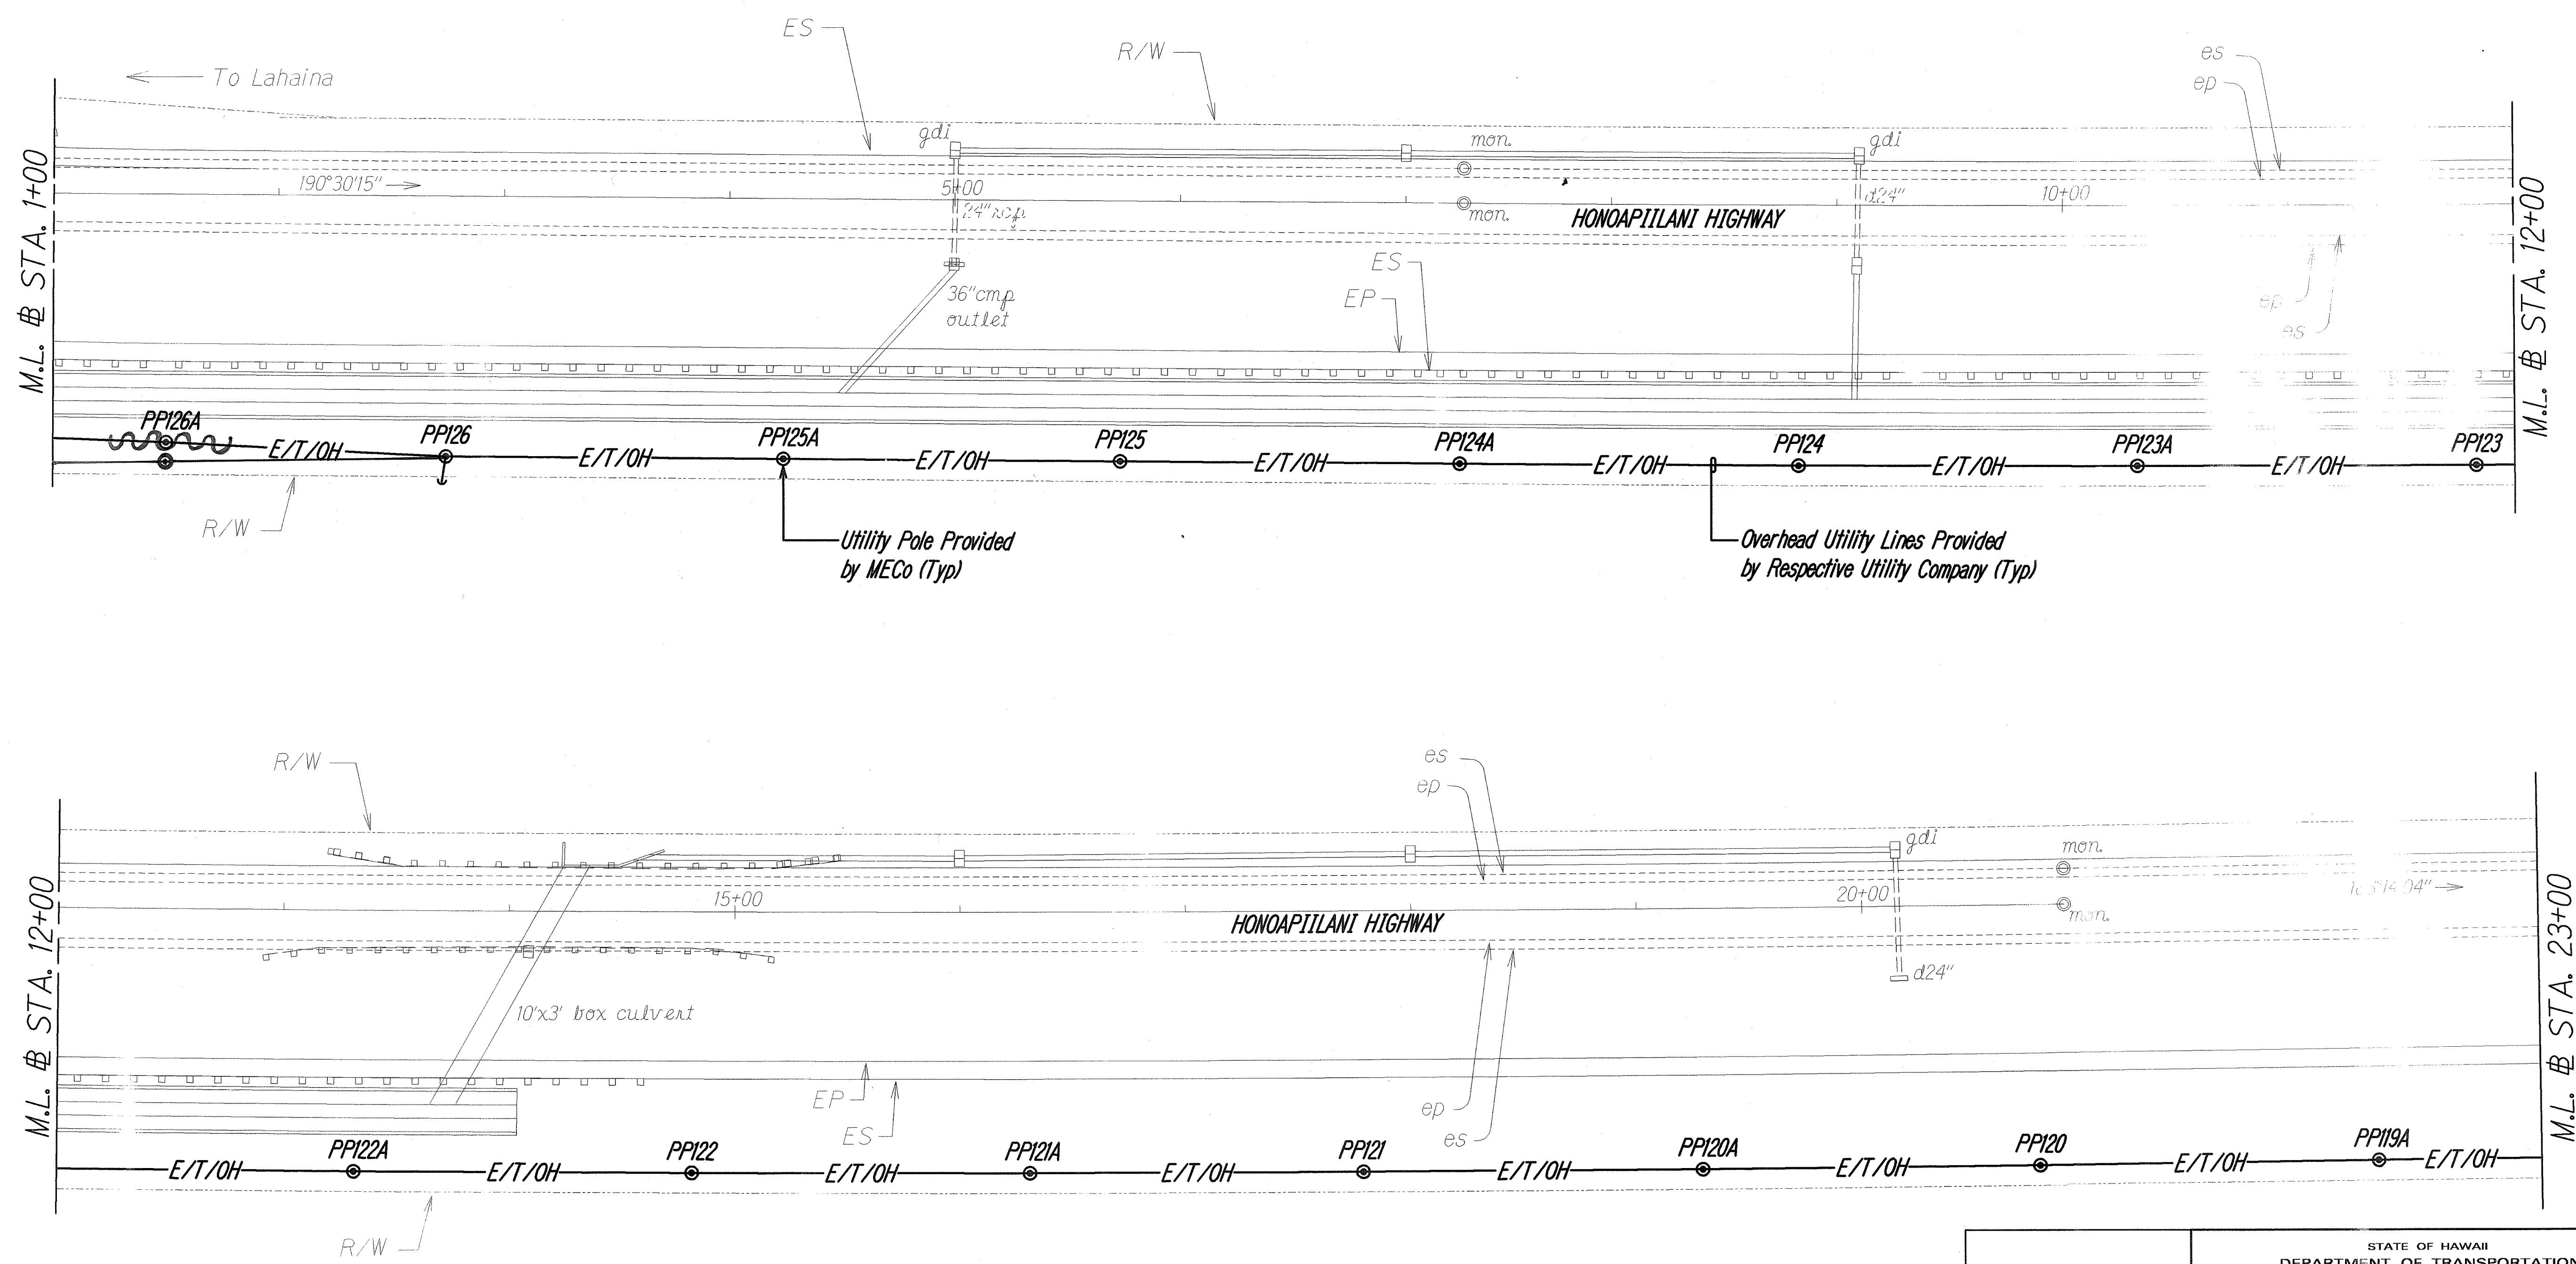

SURVEY PLOTTED BY	DATE
DRAWN BY	
TRACED BY	
QUANTITIES BY	
CHECKED BY	

ELECTRICAL PLAN - II
Scale: 1"=40'-0"

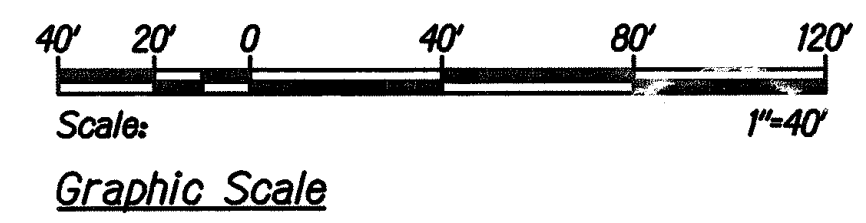

STEVEN H. SAKAI
LICENSED PROFESSIONAL ENGINEER
No. 7637-E
HAWAII, U.S.A.

Steven H. Sakai
This Work was Prepared by Me or Under My Supervision

STATE OF HAWAII
DEPARTMENT OF TRANSPORTATION
HIGHWAYS DIVISION

ELECTRICAL PLAN - II


HONOAPIʻILANI HIGHWAY WIDENING
Maalaea Road to North Kihei Road
F.A. Project No. NH-030-1(28)

Scale: 1"=40' Date: July 2001


SHEET No. E6 OF 72 SHEETS

"AS-BUILT"


FED. ROAD DIST. NO.	STATE	FED. AID PROJ. NO.	FISCAL YEAR	SHEET NO.	TOTAL SHEETS
HAWAII	HAW.	NH-030-K(28)	2001	69	72

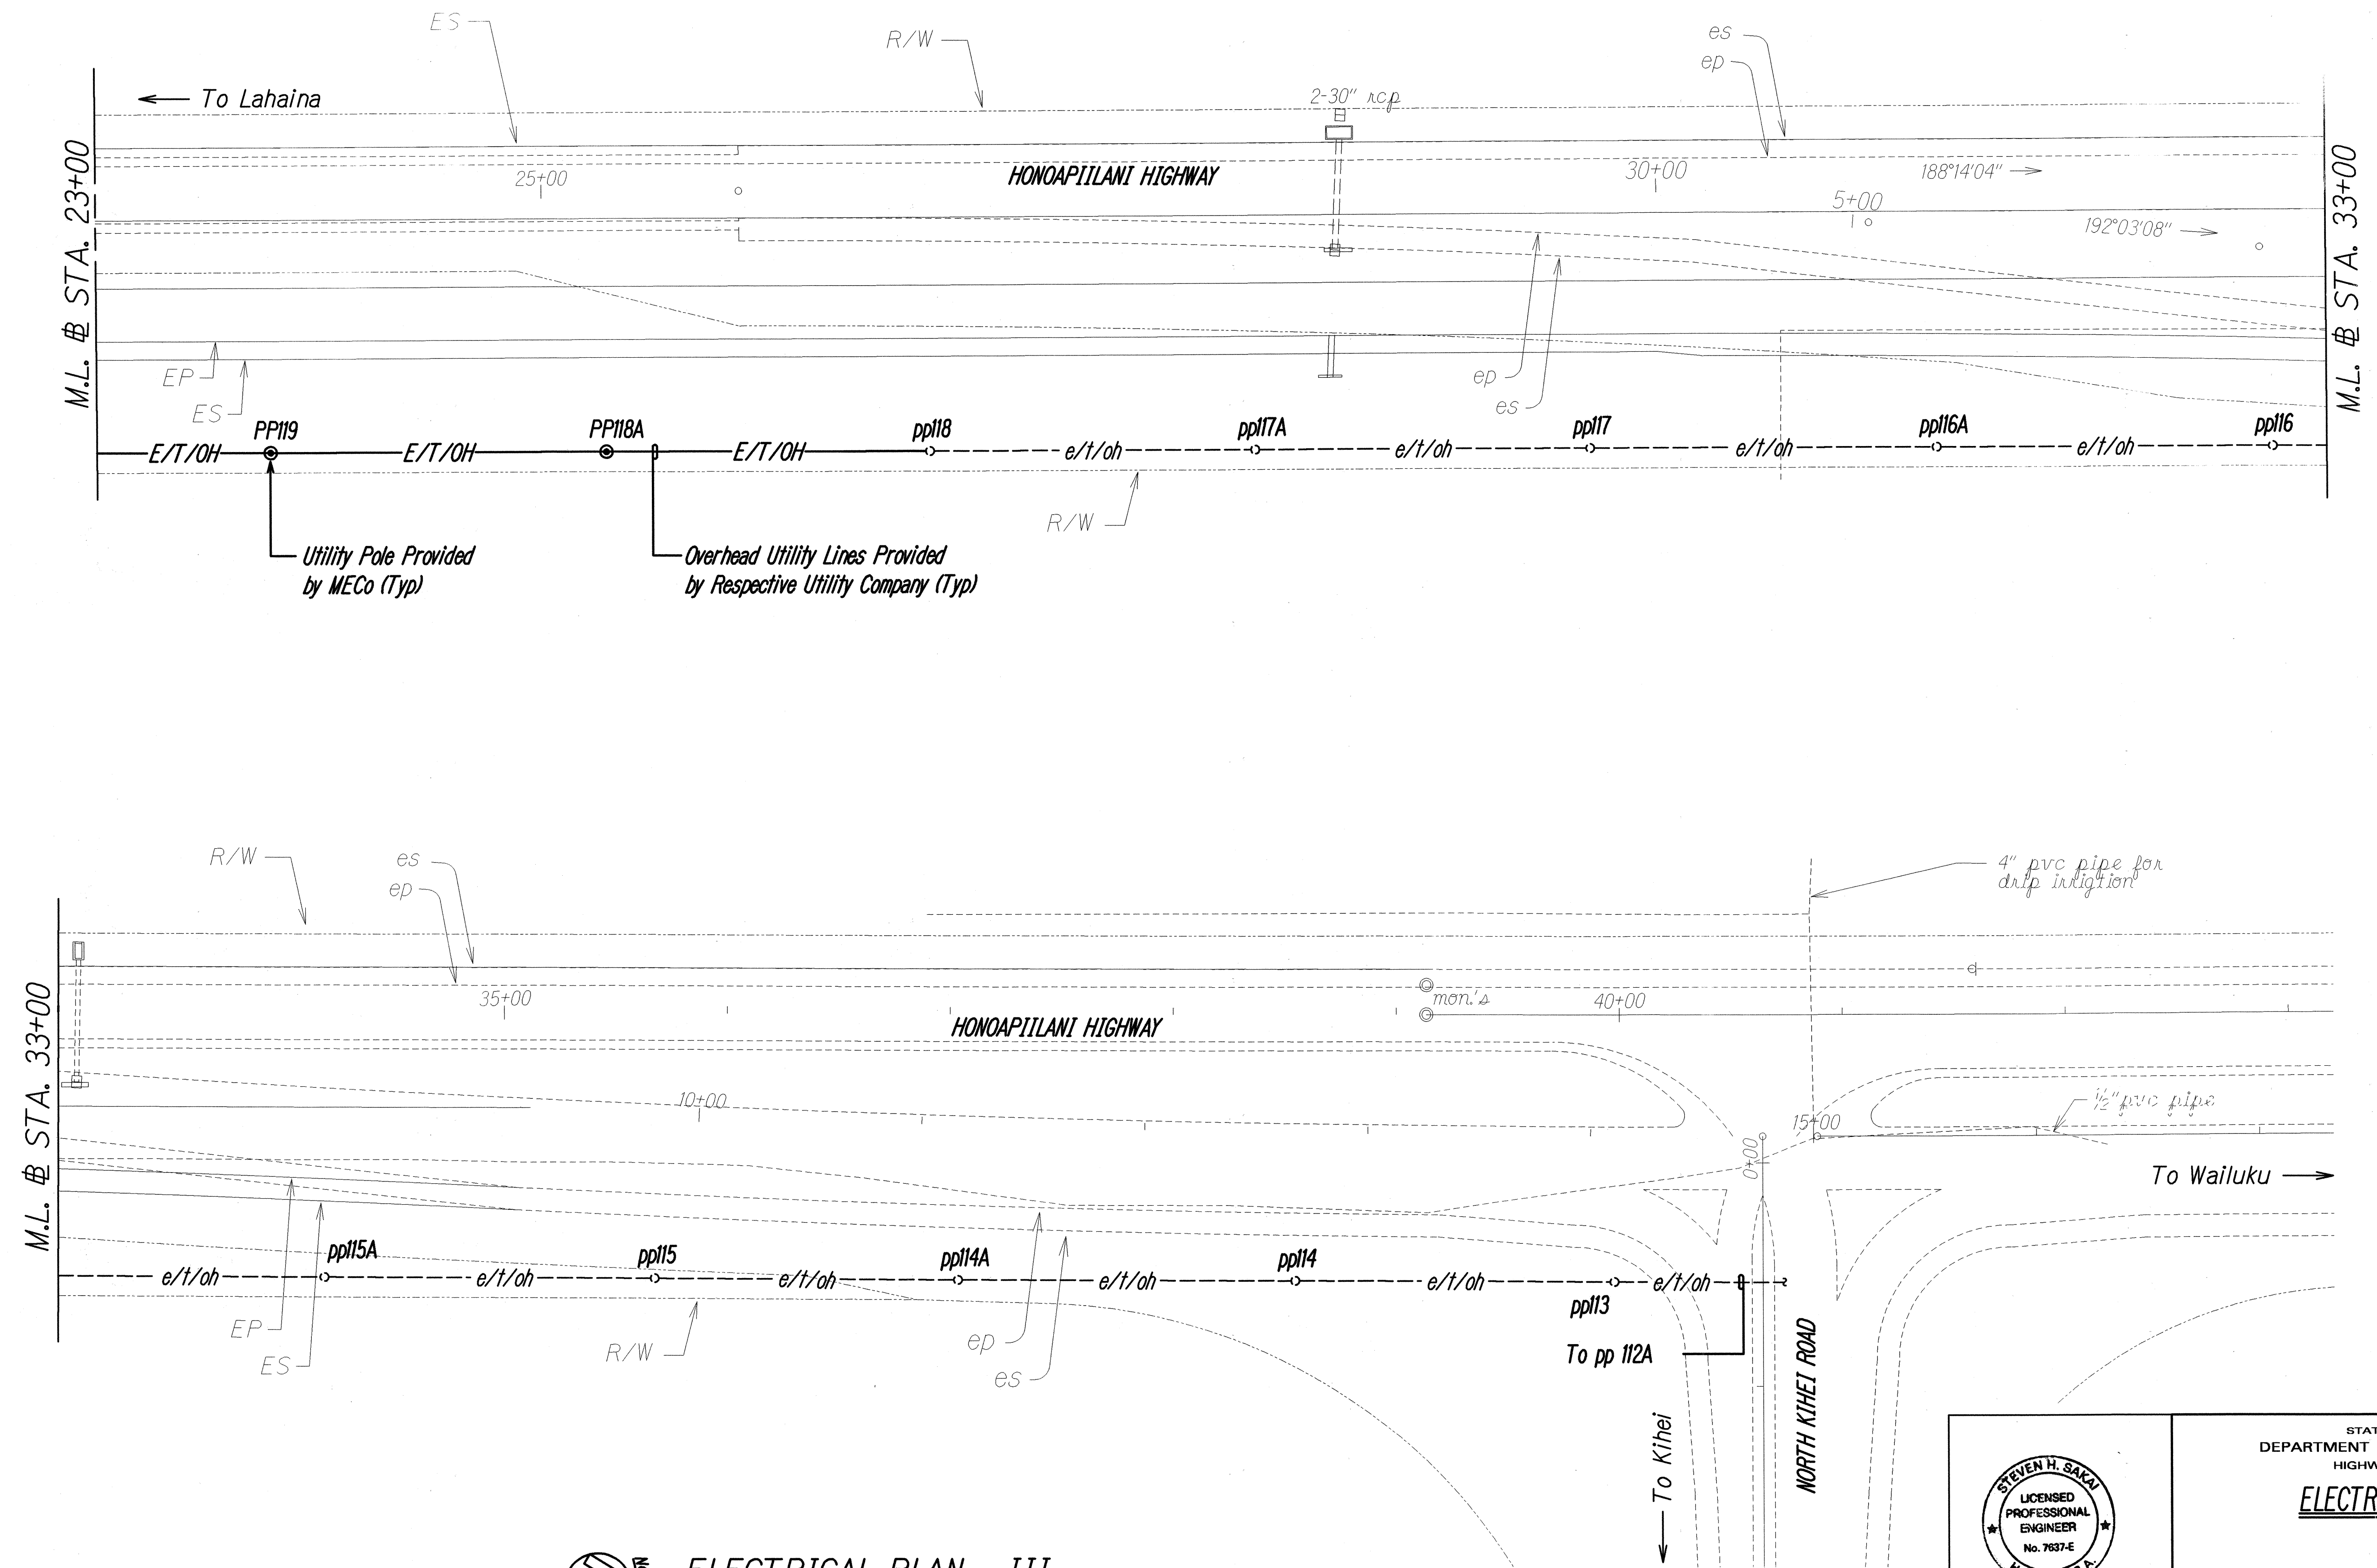

DATE	_____
SURVEY PLOTTED BY	_____
DRAWN BY	_____
DESIGNED BY	_____
CHECKED BY	_____
NOTED BY	_____
NO.	_____

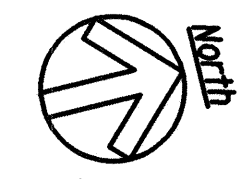

ELECTRICAL PLAN - III
 Scale: 1"=40'-0"

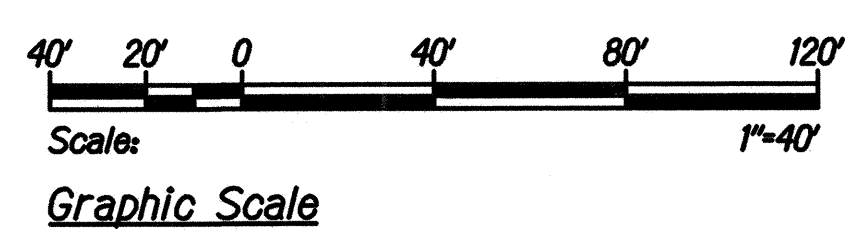

STEVEN H. SAKAI
 LICENSED PROFESSIONAL ENGINEER
 No. 7637-E
 HAWAII, U.S.A.

This Work was Prepared by Me or Under My Supervision

STATE OF HAWAII
 DEPARTMENT OF TRANSPORTATION
 HIGHWAYS DIVISION




ELECTRICAL PLAN - III

HONOAPIʻILANI HIGHWAY WIDENING
 Maalaea Road to North Kihei Road
 E.A. Project No. NH-030-K(28)

Scale: 1"=40' Date: July 2001


SHEET No. **E7** OF 72 SHEETS

FED. ROAD DIST. NO.	STATE	FISCAL YEAR	SHEET NO.	TOTAL SHEETS
HAWAII	HAW	28)	10	72

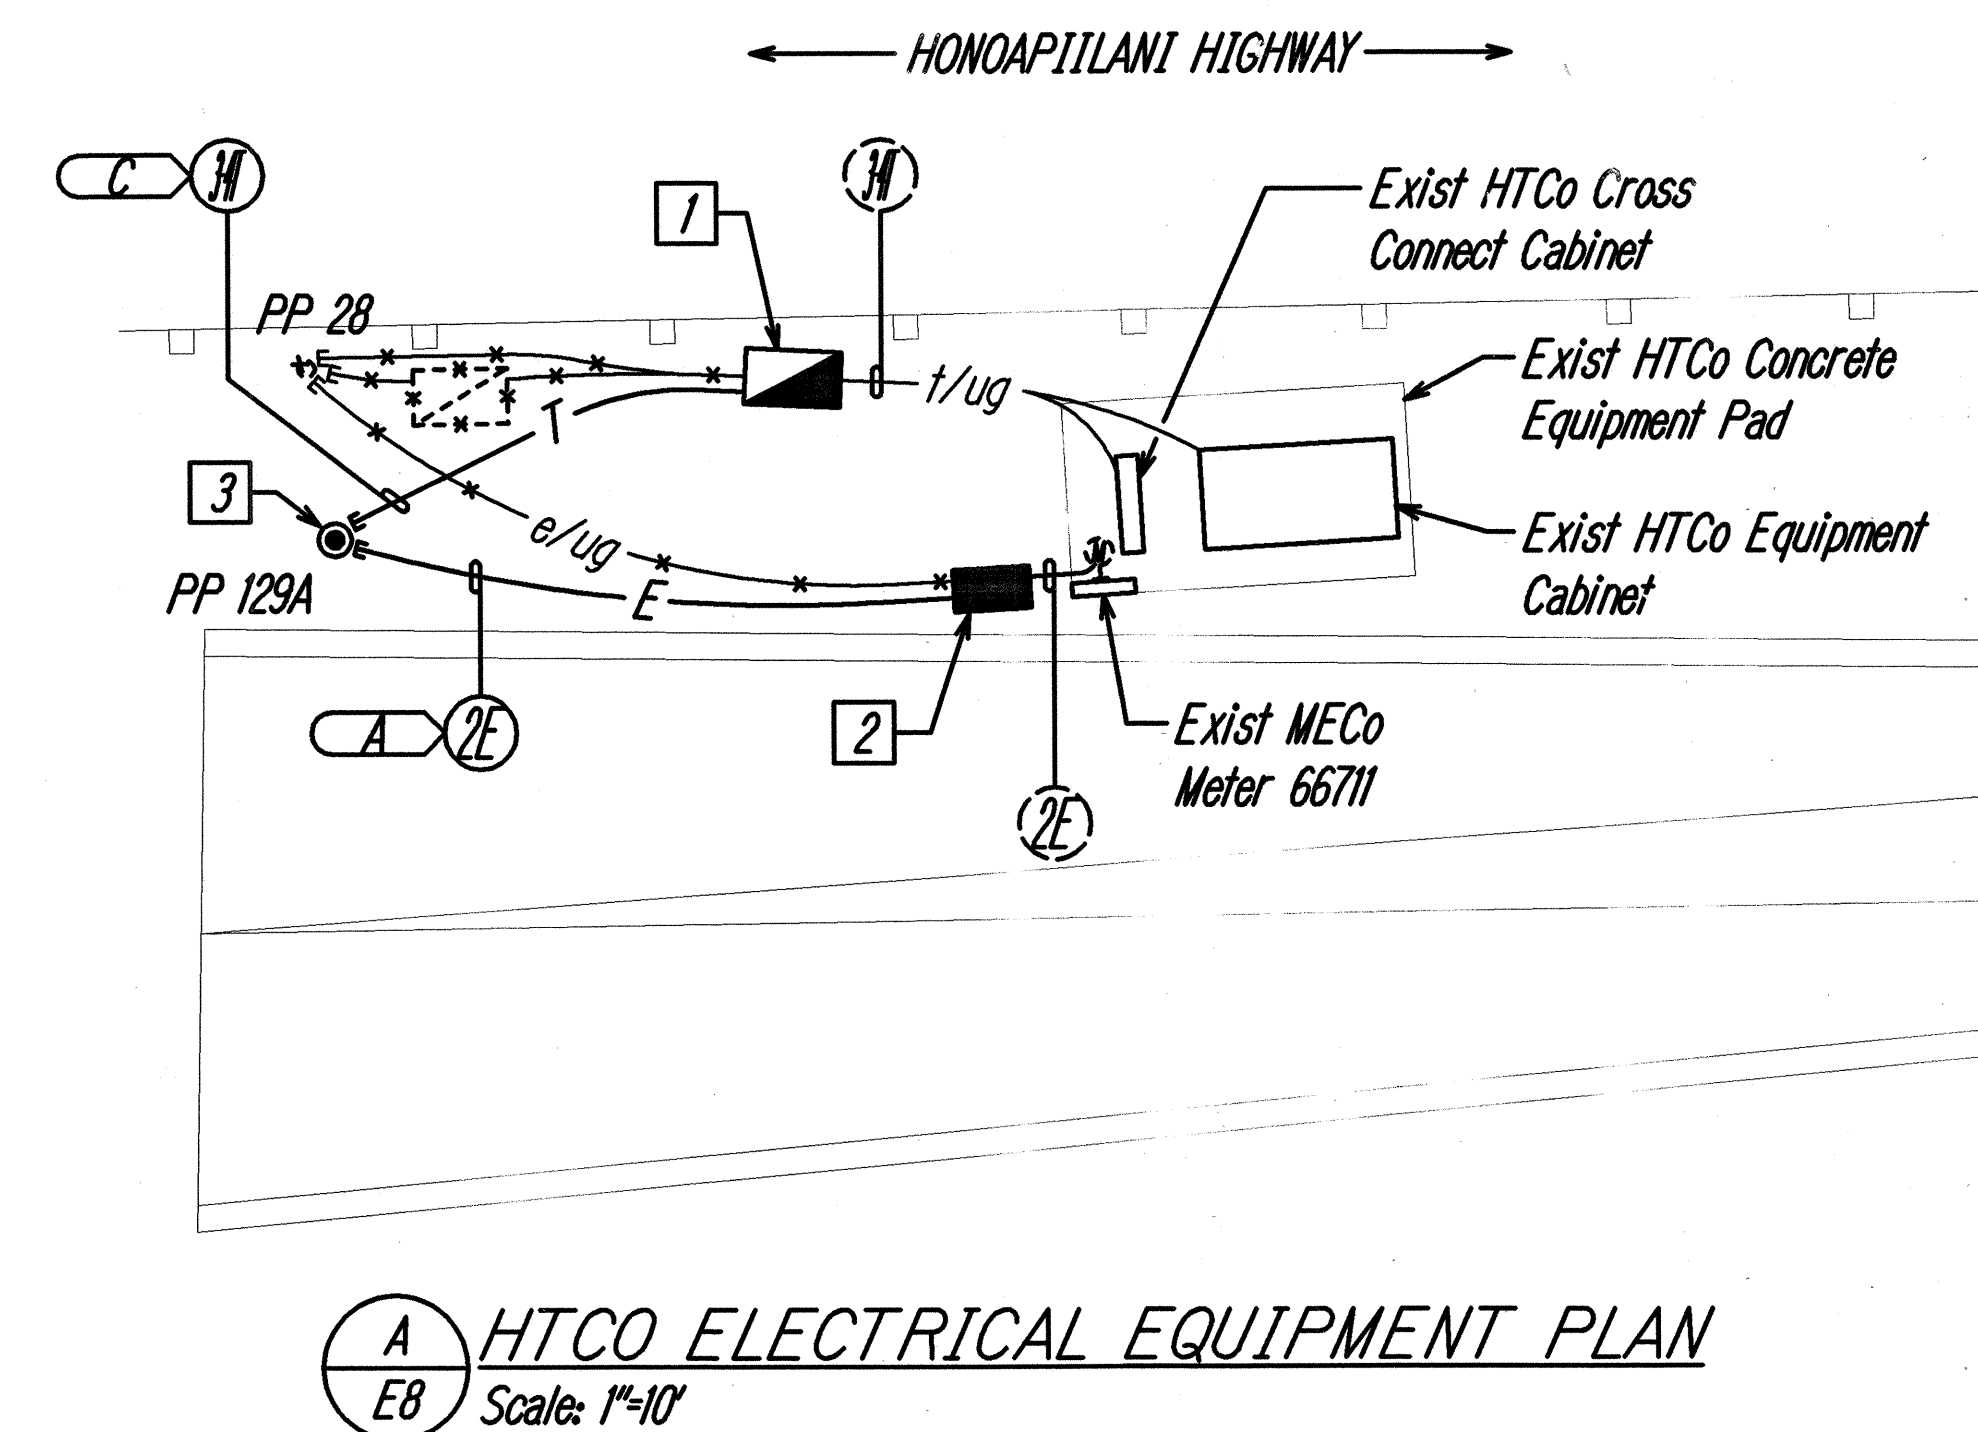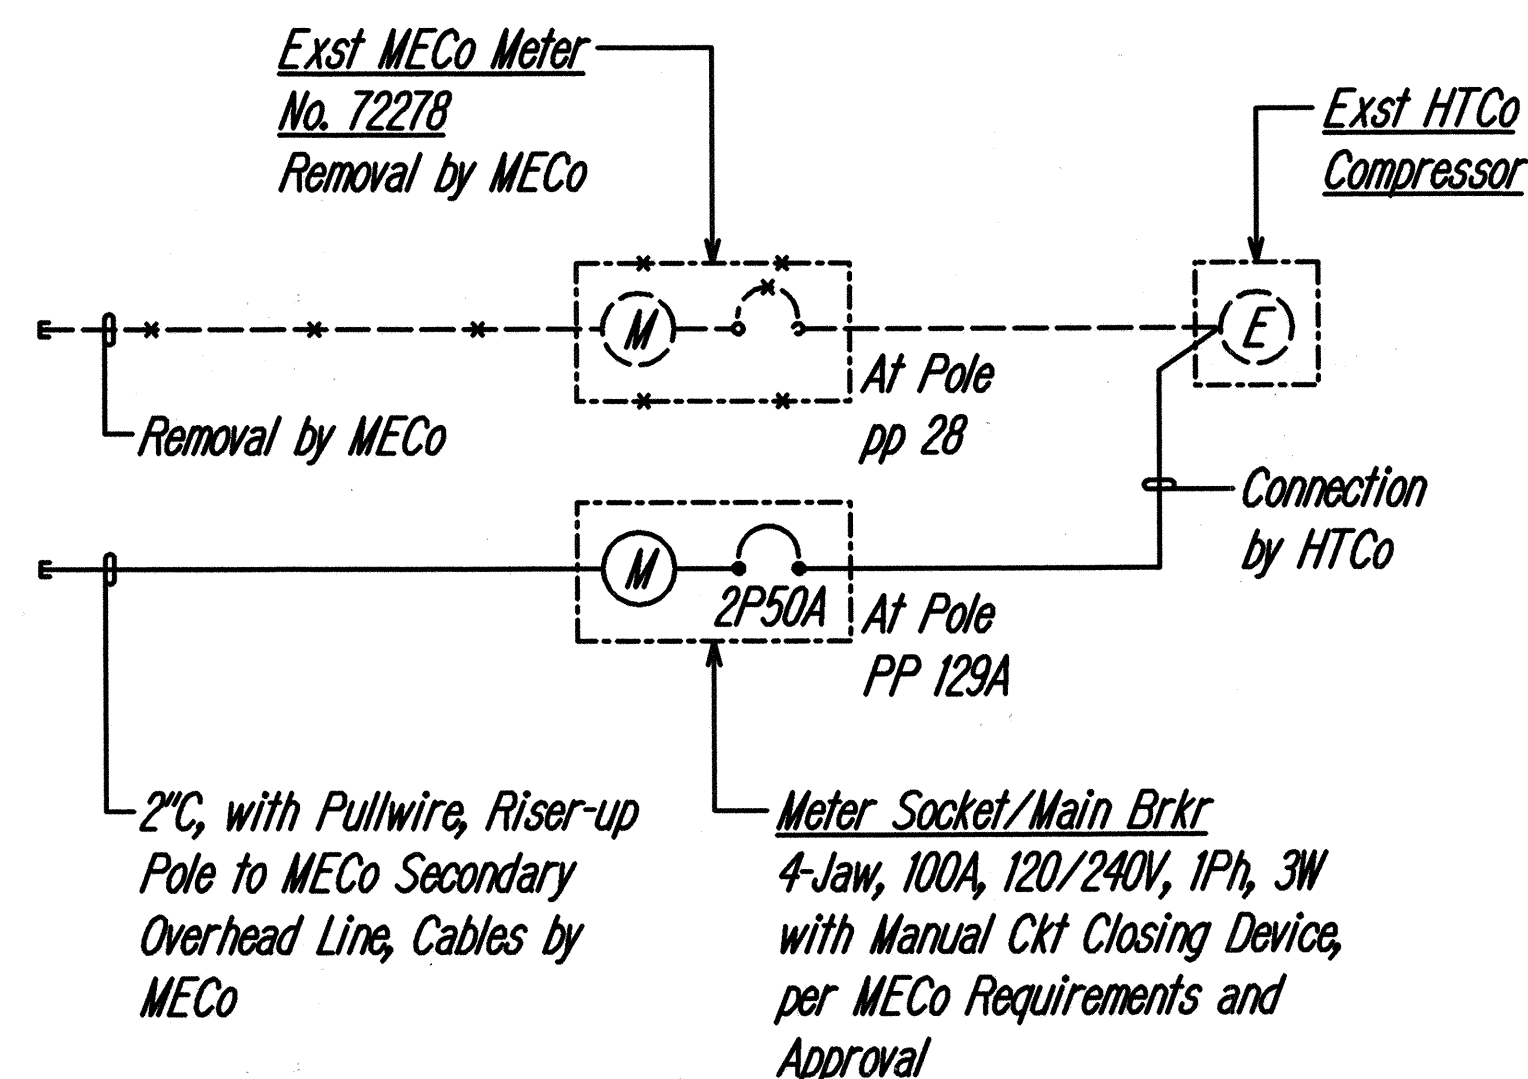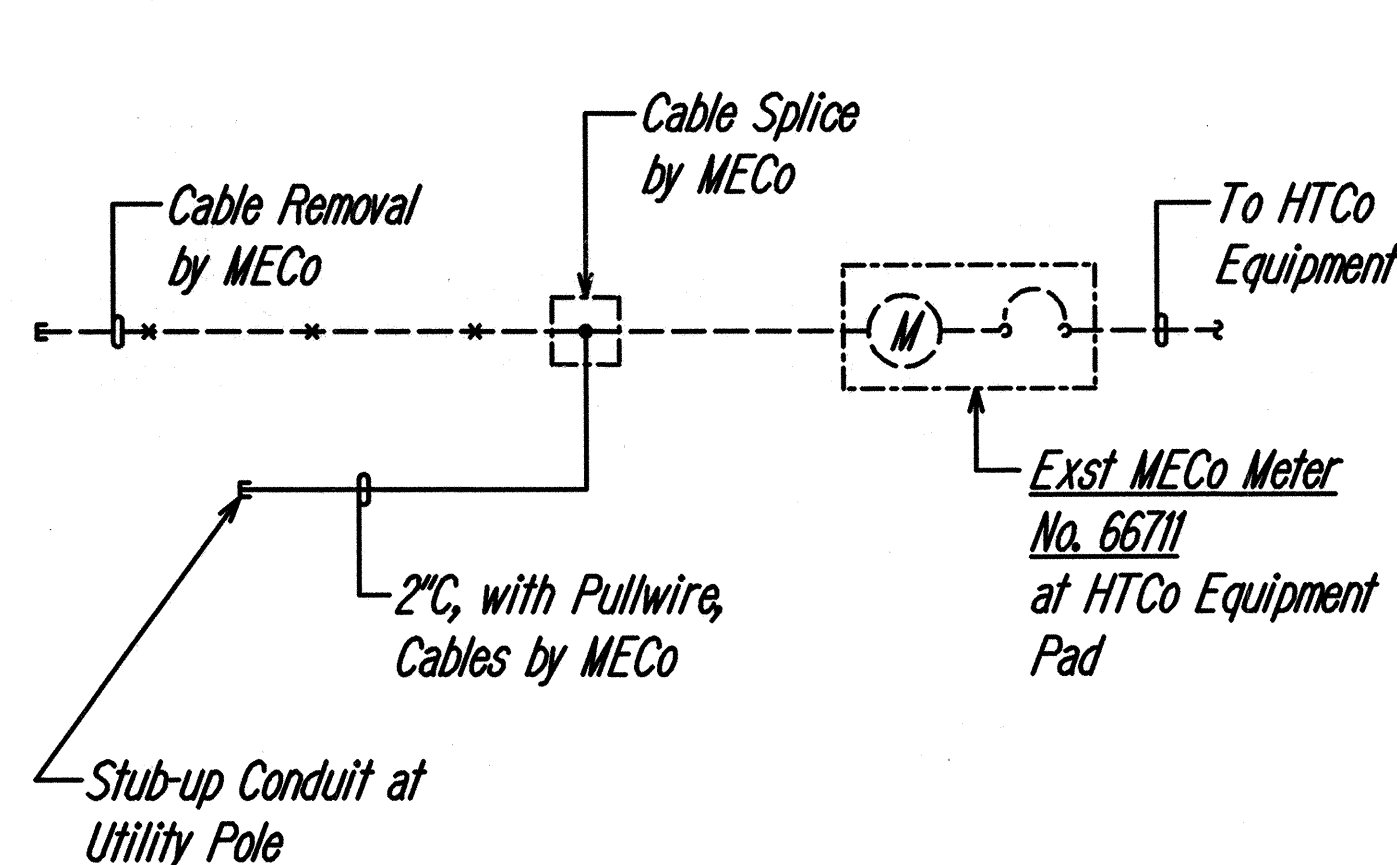

NOTES:

- 1 Intercept existing HTCo Ductline with HTCo 3' x 5' Handhole. Extend 3-4" to relocated Utility Pole location.
- 2 Intercept existing MECo Ductline with MECo 2' x 4' Handhole. Extend 2" to relocated Utility Pole location.
- 3 Riser-up Pole per Utility Company Requirements. See C/E9 and D/E9 for Typical Pole Riser Details.

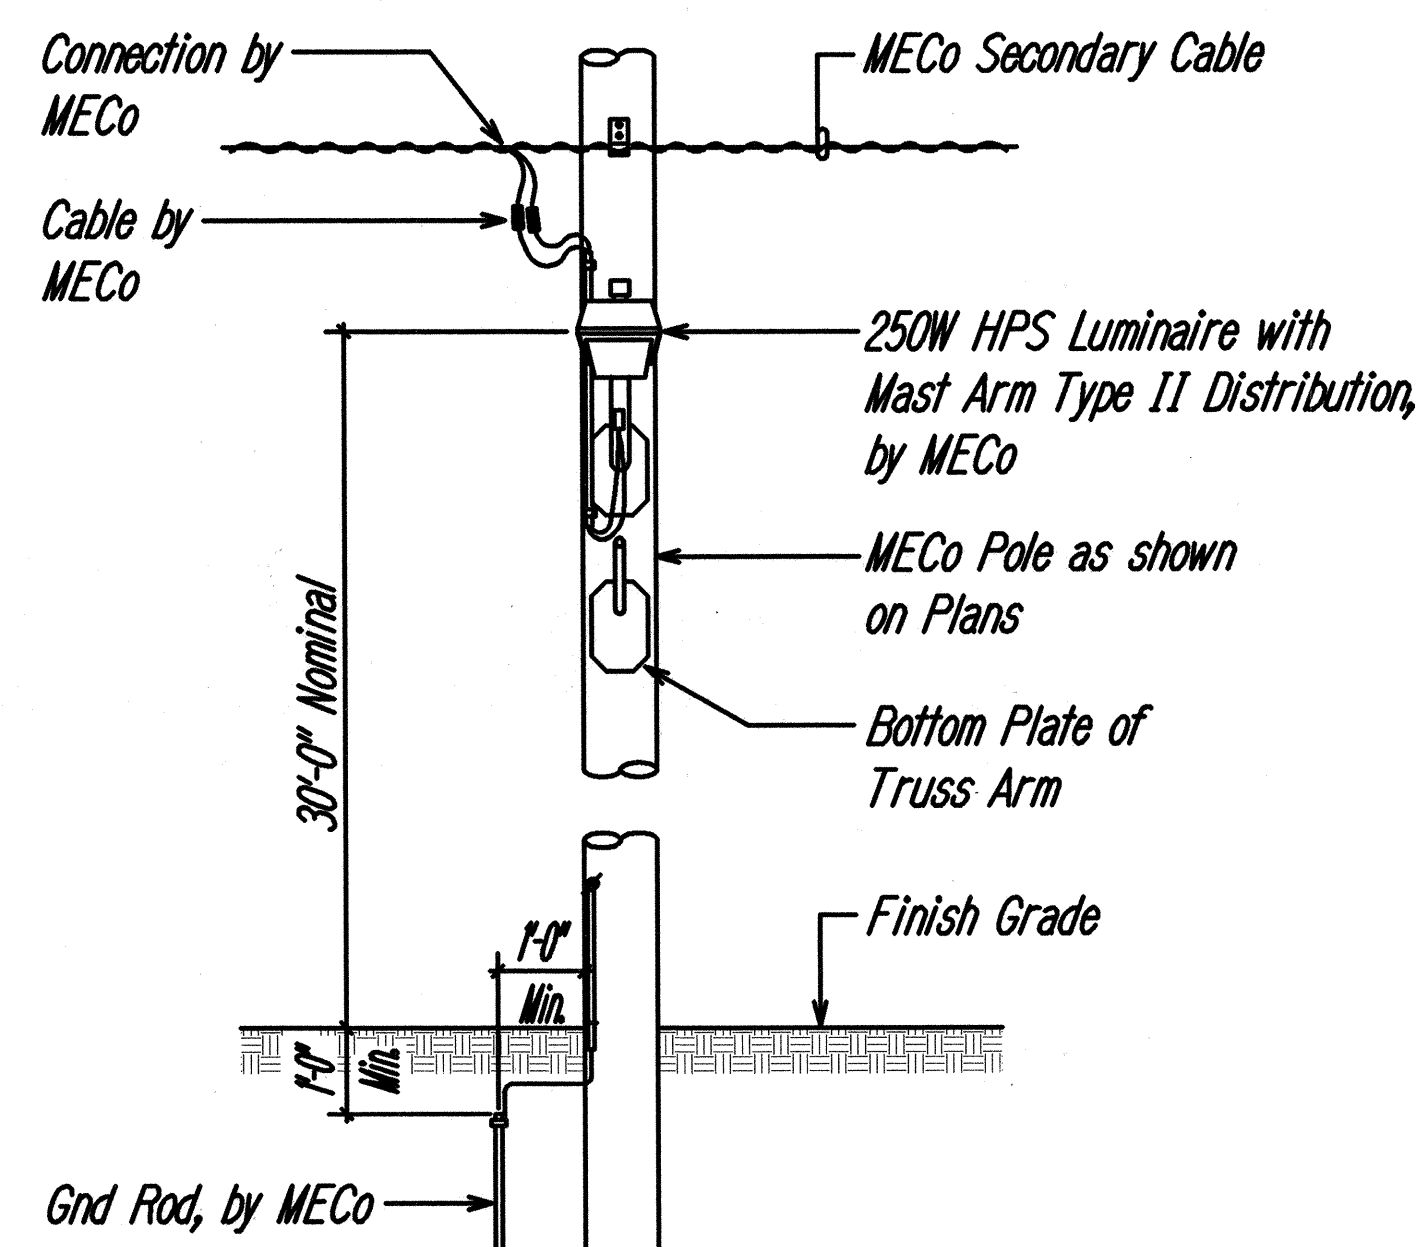

ORIGINAL PLAN	SURVEY PLOTTED BY	DATE
NOTE BOOK	DRAWN BY	
	DESIGNED BY	
	CHECKED BY	

STEVEN H. SALAS
LICENSED PROFESSIONAL ENGINEER
No. 7637-E
HAWAII, U.S.A.

This Work was Prepared by Me or Under My Supervision

STATE OF HAWAII
DEPARTMENT OF TRANSPORTATION
HIGHWAYS DIVISION

**ONE-LINE DIAGRAMS,
EQUIPMENT PLAN, ELEVATION**

HONOAPIILANI HIGHWAY WIDENING
Maalaea Road to North Kihel Road
F.A. Project No. NH-030-1(28)

Scale: As Noted Date: July 2001

SHEET No. E8 OF 72 SHEETS

Diagram illustrating the installation of a 3" PVC Sch. 80, 90° Conduit Elbow (36" Radius Bend) on a MECo Utility Pole. The diagram shows the conduit being installed vertically, with a stub-up of one length (3" PVC Sch. 80 Conduit) and a conduit coupling. The conduit is secured to the pole using Galvanized Pipe Strap (3 Per Length). The conduit is shown bending at a 90° angle, with a minimum bend radius of 3'-0" indicated. The conduit is encased in concrete encasement. Labels include: Facilities Beyond this Point by MECo, Stub-Up One Length 3" PVC Sch 80 Conduit, Conduit Coupling, 3" PVC Sch. 80, 90° Conduit Elbow (36" Radius Bend), Concrete Encasement, MECo Utility Pole, Galvanized Pipe Strap (3 Per Length), and Gnd Rod (By MECo).

Galvanized Pipe Strap (3 Per Length)


Riser 1-4" PVC Sch. 80 Up to Tel Overhead Line


Cap Unused Conduits

3-4" PVC Sch. 80, 90° Conduit Elbow (36" Radius Bend)

3'-0" min.

Concrete Encasement

	STATE OF HAWAII DEPARTMENT OF TRANSPORTATION HIGHWAYS DIVISION
	<u>CONCRETE BASE AND STREET</u> <u>LIGHT DETAILS, POLE RISER DETAIL</u>
	<u>HONOAPIILANI HIGHWAY WIDENING</u> <u>Maalaea Road to North Kihei Road</u> <u>F.A. Project No. NH-030-1K28)</u>
	Scale: As Noted Date: July 2001
SHEET No. E9 OF 72 SHEETS	

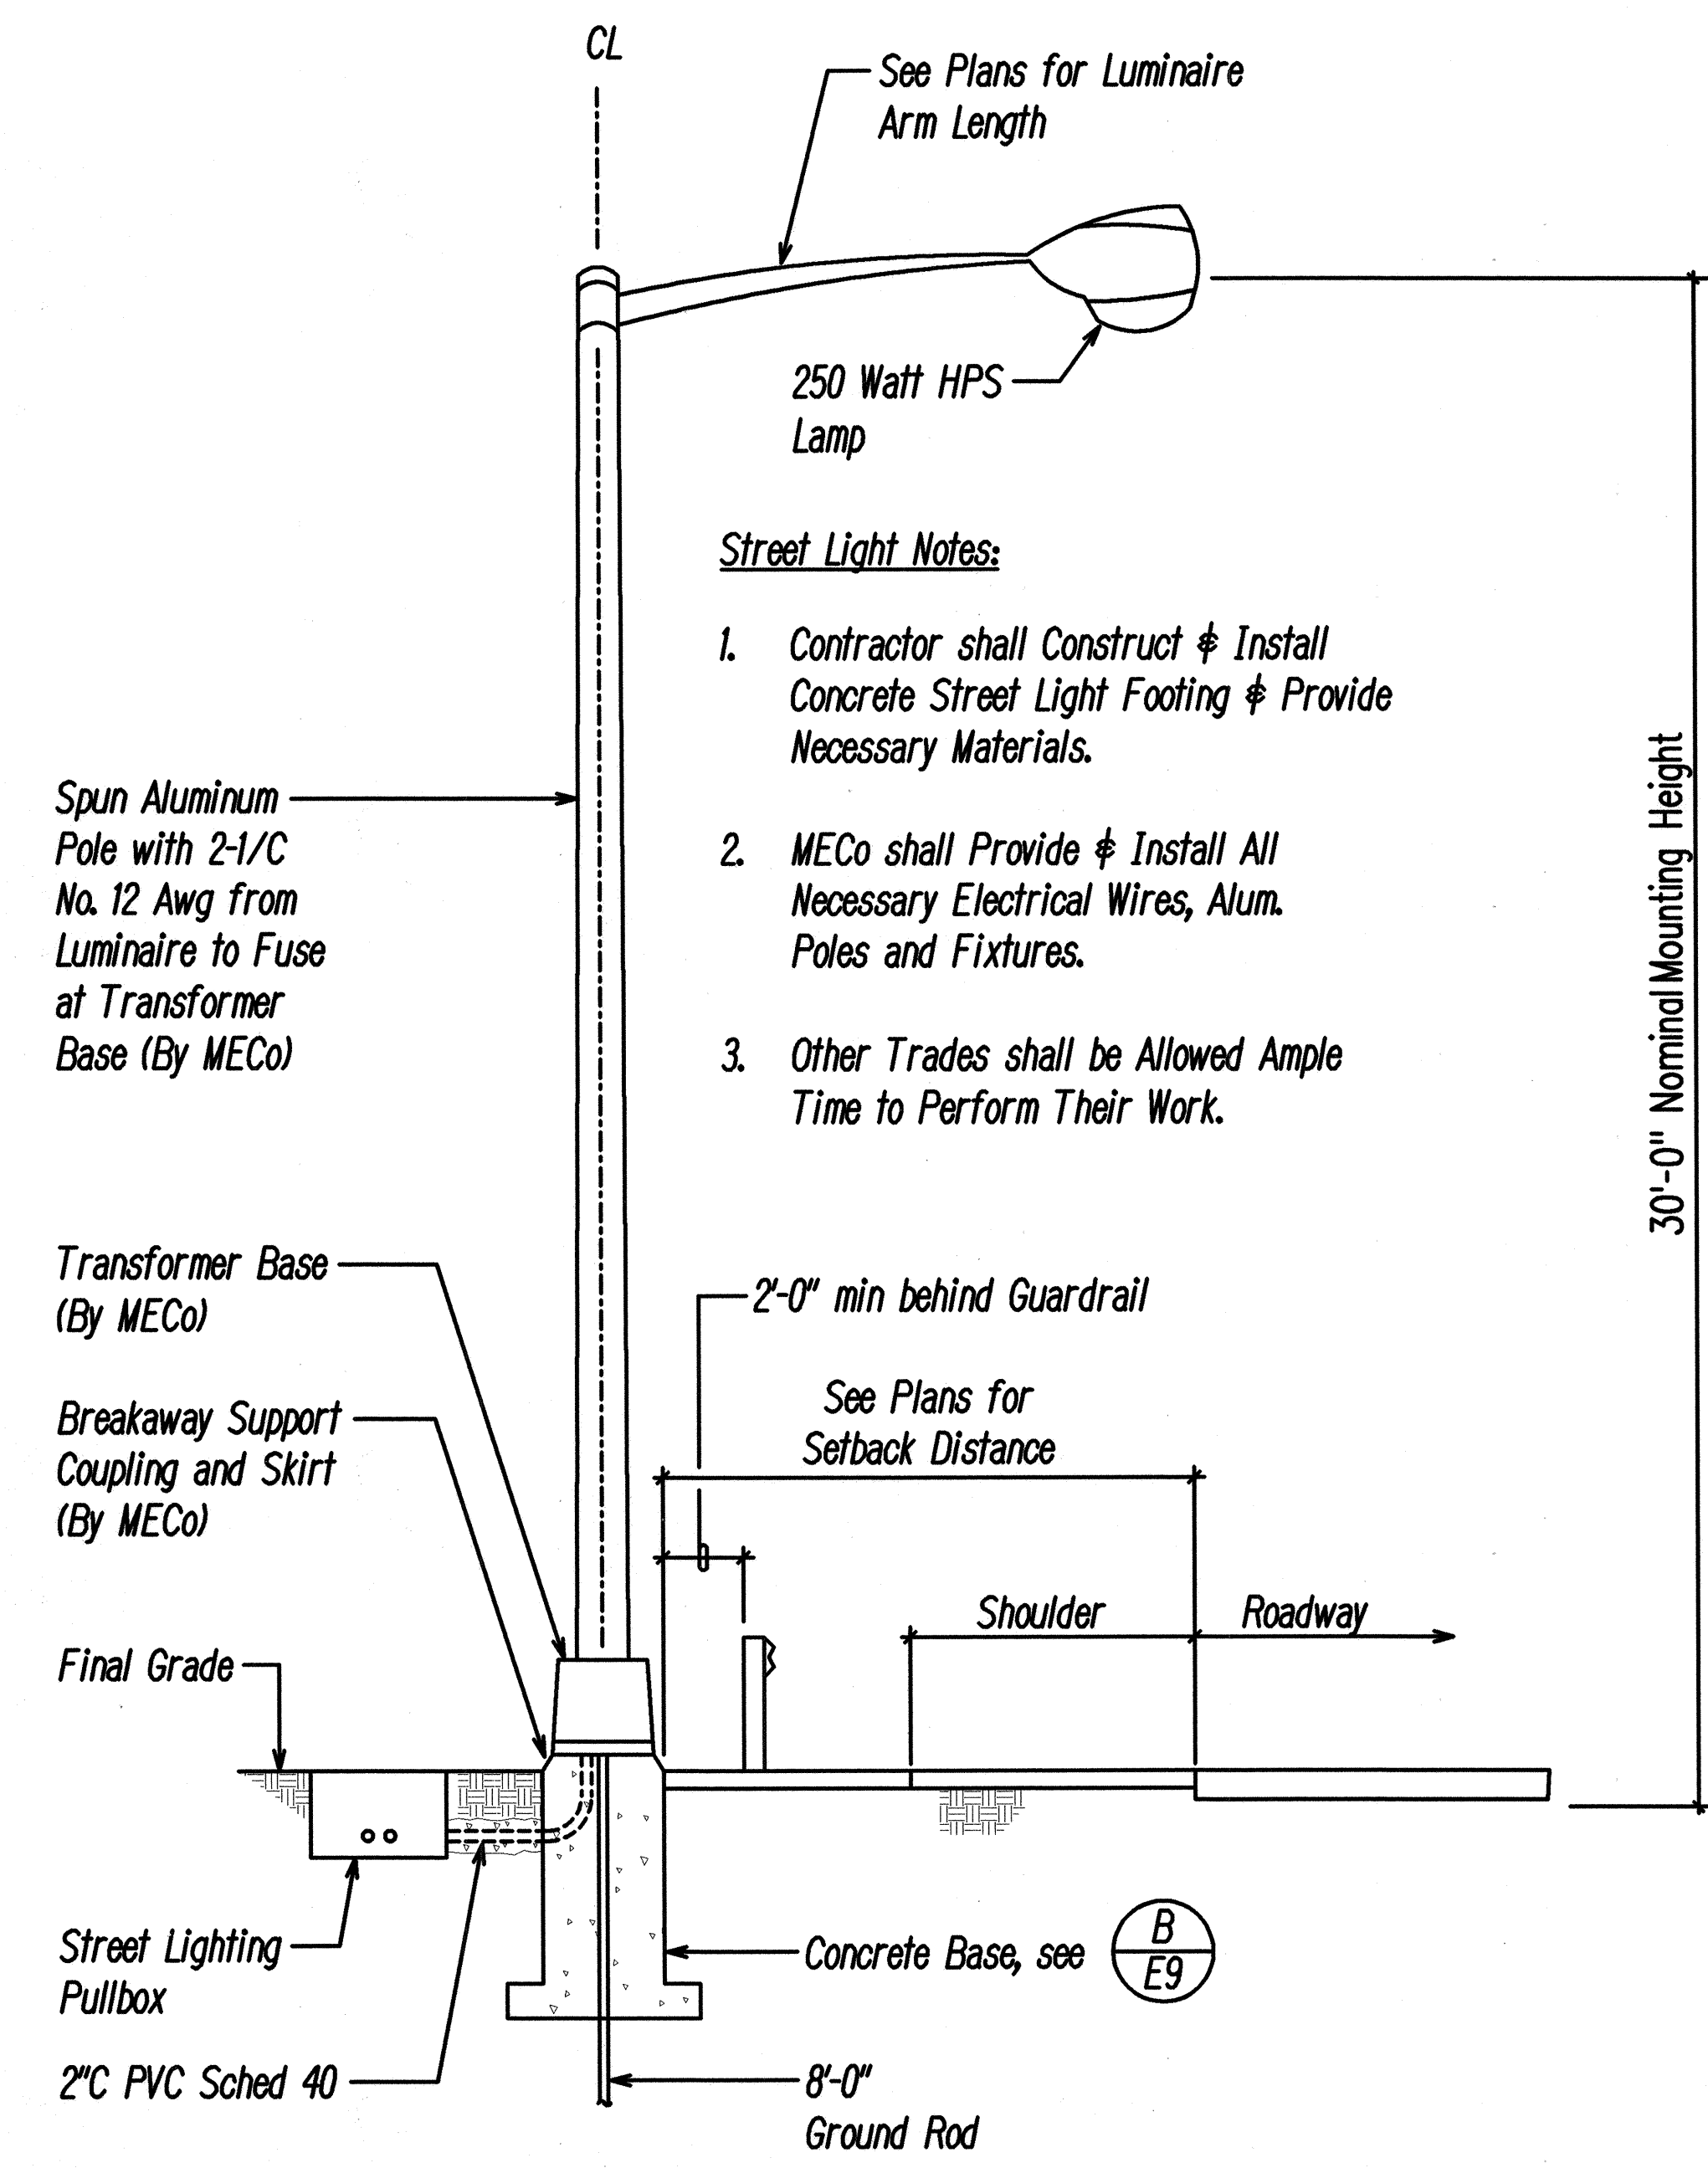

Labels:

- 24" #6BC Gnd Wire, Contractor to Coil Wire on Top of St. Light Pole Base, MECo to Connect to New Alum Pole
- Finished Grade
- Coil 24" of Gnd Wire on Side of Pole Base from Connection to Grd Rod at Project Site (see Plan View)
- Retaining Nut (Typical)
- 2 1/2" Bolt Projection
- 2" Max
- 5'-0"
- 36" Min
- 2" PVC Type - Sch 40, 24" Radius Bend Minimum
- 8-#4
- 9"-0"
- 4'-1" X 36" Galv. Anchor Bolts (Typical)
- Conc. 3000 PSI 28 Days Est. Weight: 3500 Lbs
- 42" Sq.
- 4'-6"
- (Limit of Excavation)
- 4-#4 Each Way
- #3 @ 12" O.C. Equally Spaced

42" Sq.

24" Sq.

4-1" dia. x 36" Galv. Anc. Bolts w/ retaining nuts

*6BC Gnd Wire by Customer

15" dia Bolt Circle

Coil 24" *6BC Gnd Wire

2" PVC-Type Sch. 40 24" Radius Bend (min)

12" min

5/8" dia. x 8'-0" Copper Gnd Rod and Clamp Furnished and Installed by Contractor Including Gnd Wire Connection at Project Site


PLAN

Notes:

1. *Precast Concrete Footing is Prefabricated by Walker Industries at Ameron Maui, Ph: 877-5068.*
2. *MECo shall Provide 1" dia. X 36" Anchor Bolts (4 each) as Furnished by Manufacturer. Pick-up by Contractor at MECo's Kahului Warehouse.*
3. *Inspection by MECO Inspector Required Prior to Fabrication of Footing. Contact MECO Inspector (Ph: 871-8461)*



B
E9 PRECAST CONCRETE FOOTING STREET LIGHT
POLE BASE TRANSFORMER TYPE-WITH
BREAKAWAY COUPLING (STATE HIGHWAY)
Not to Scale

FED. ROAD DIST. NO.	STATE	FED. AID PROJ. NO.	FISCAL YEAR	SHEET NO.	TOTAL SHEETS
HAWAII	HAW.	NH-030-1(28)	2001	72	72

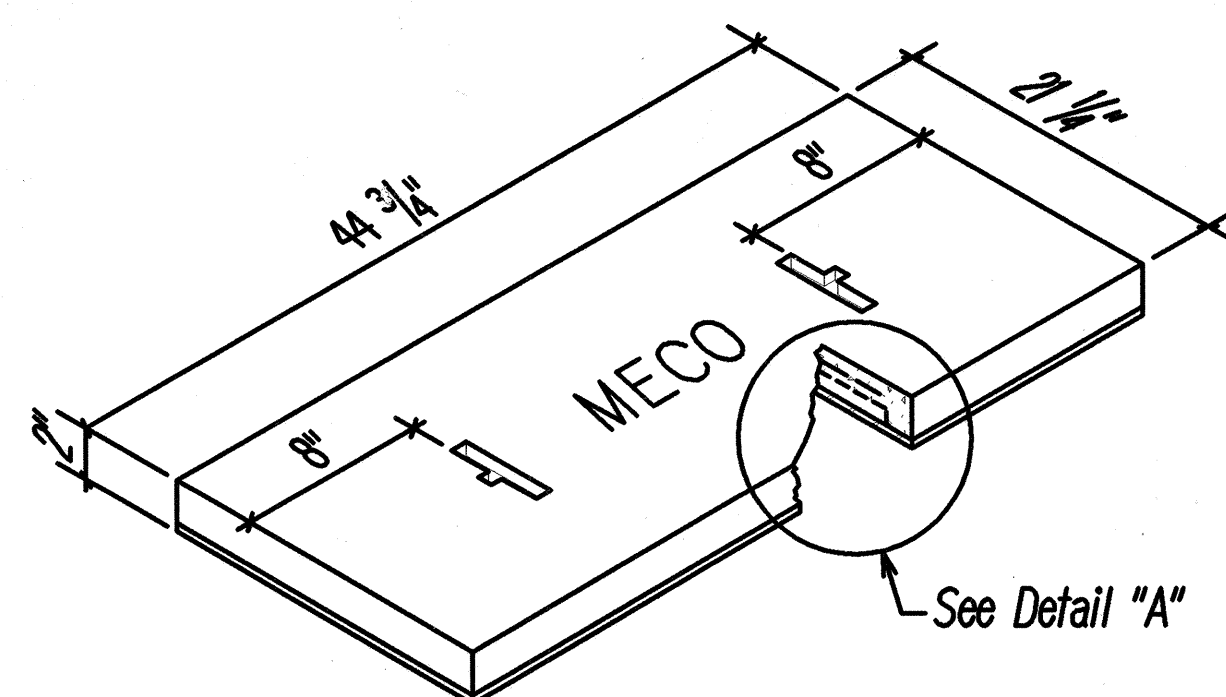


The Maui Electric Co., Inc. (MECO) Handholes shall be constructed by the Contractor as shown in these drawings & in accordance with the following standard drawings:

Type	Description
2' X 4' HECO Pullbox	2' X 4' Precast concrete pullbox with precast concrete cover, provided in accordance with HECO Standard Drawing No. 30-2005.

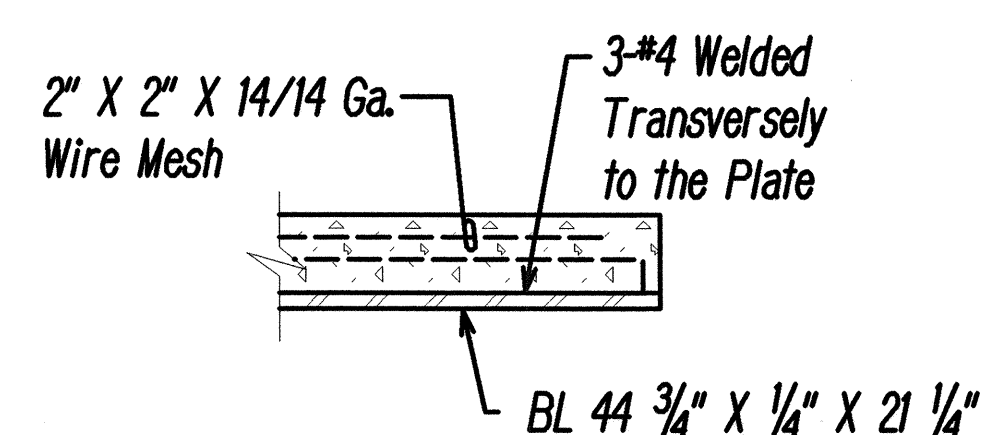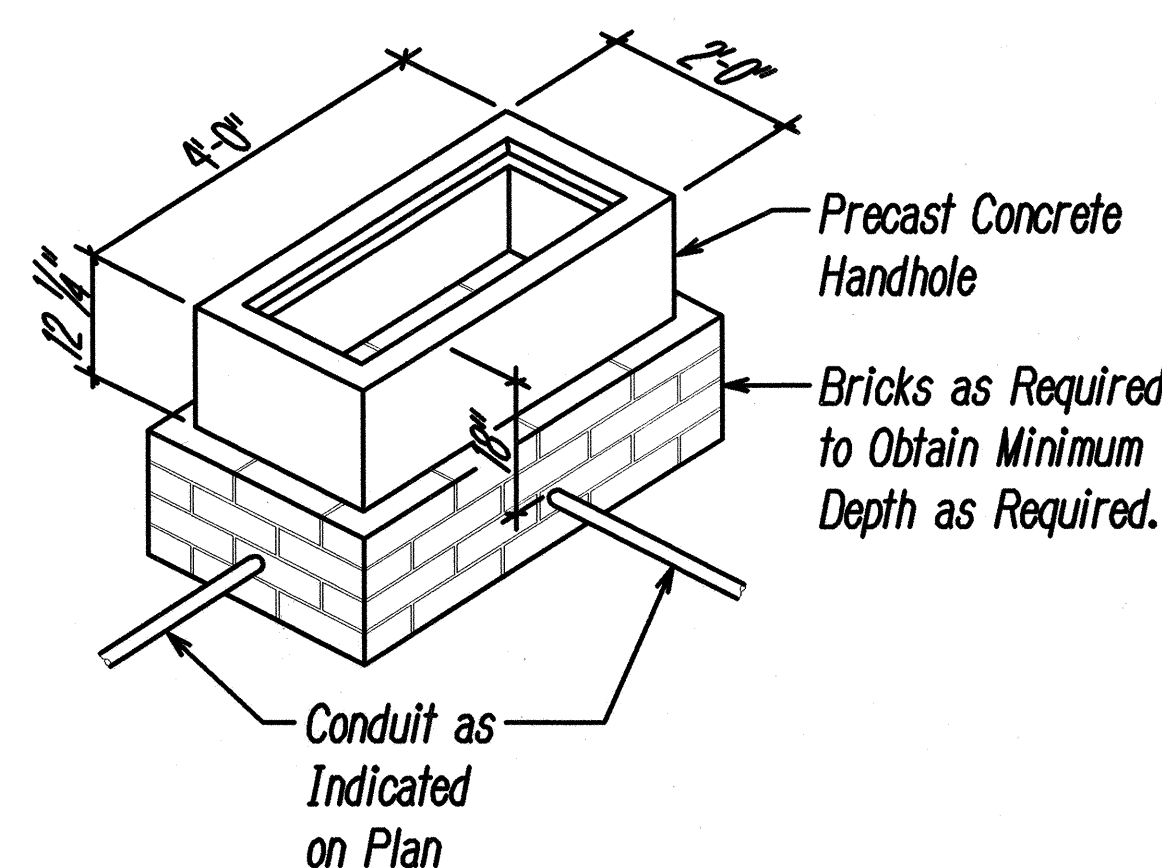


DETAIL "A"

A
E10 2' X 4' MECO HANDHOLE DETAIL
Not to Scale

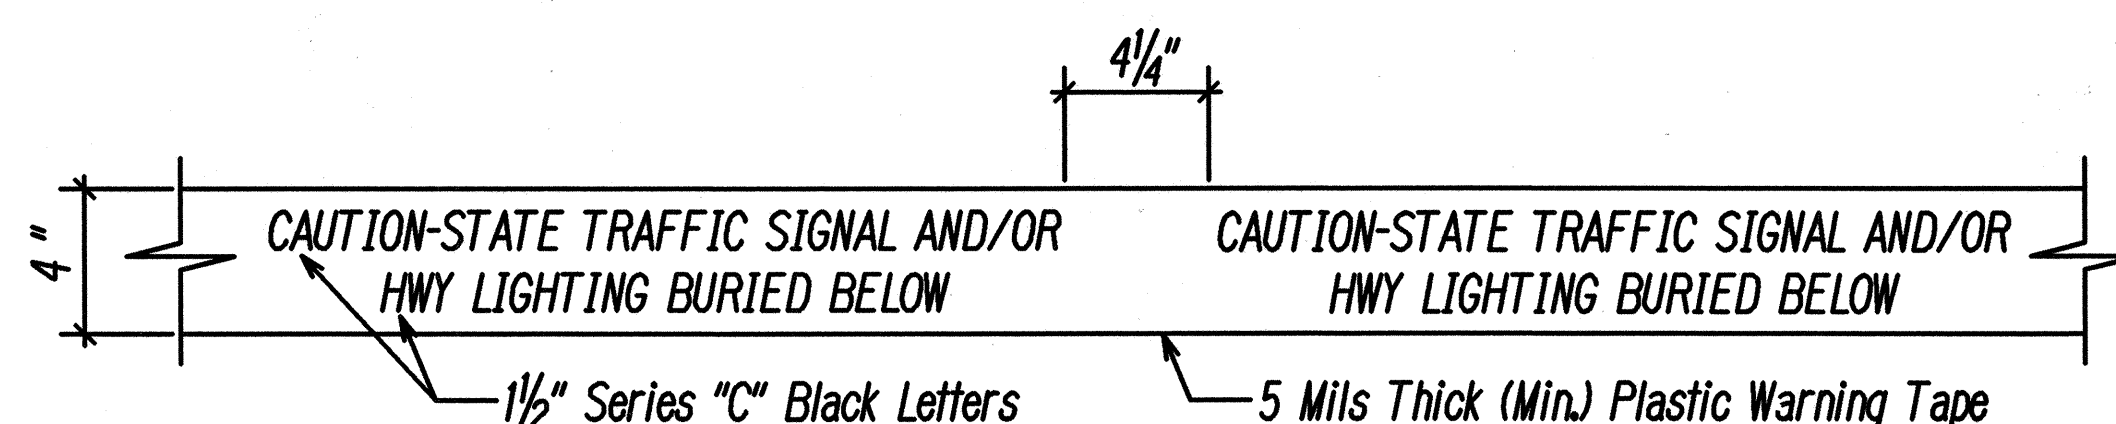


Note:
The Metal Detectable Red Plastic Warning Tape shall be a Minimum 5 Mils Thick and 4" Wide with a Continuous Metallic Backing and Corrosion Resistant \pm Mil Thick Foil Core. The Message on the Tape shall Read, "CAUTION - STATE TRAFFIC SIGNAL AND/OR HWY LIGHTING BURIED BELOW", Utilizing $\frac{1}{2}$ Inches Series "C" Black Lettering. The Message will be Repeated with a $\frac{1}{4}$ " Spacing Between Top Line of Message and Start of Next Repeat.


B
E10 METAL DETECTABLE YELLOW PLASTIC WARNING TAPE
Not to Scale

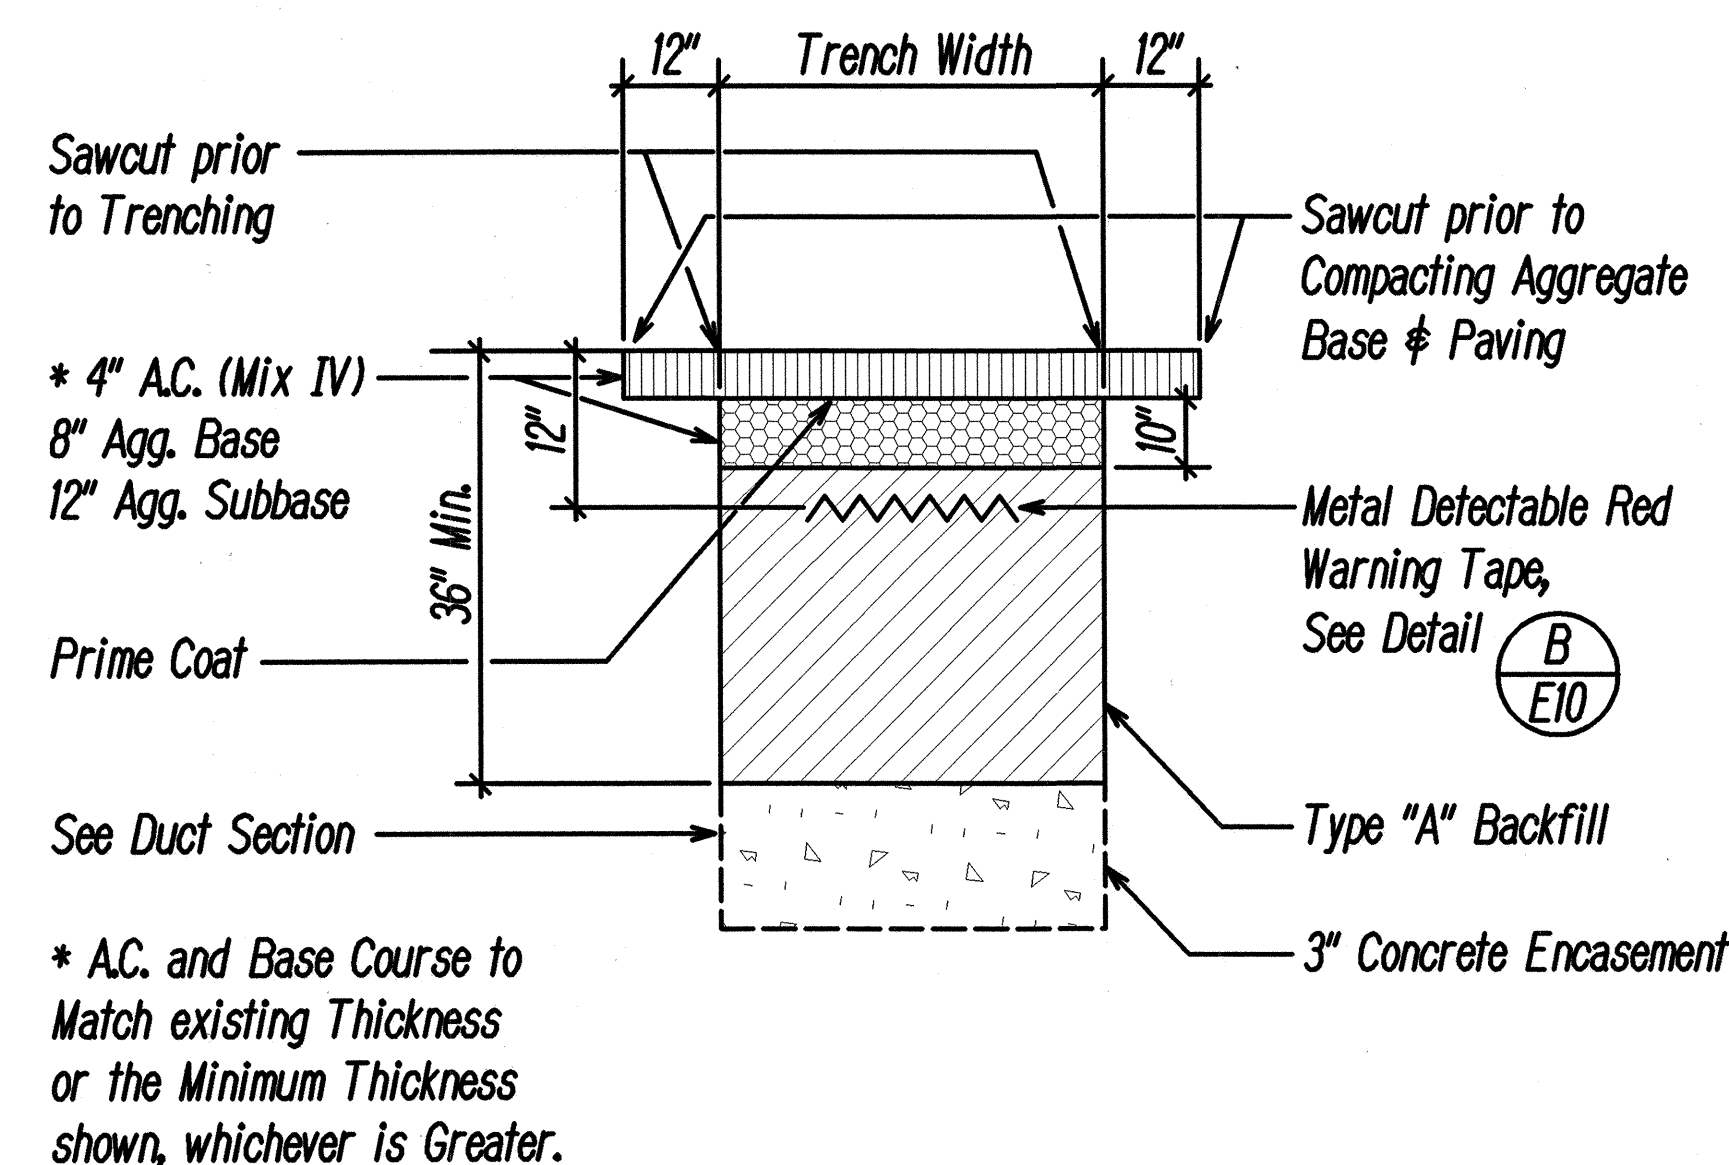


1 TYPICAL BACKFILL SECTION WITH
CONCRETE ENCASED DUCTS (STATE R.O.W.)
Not to Scale

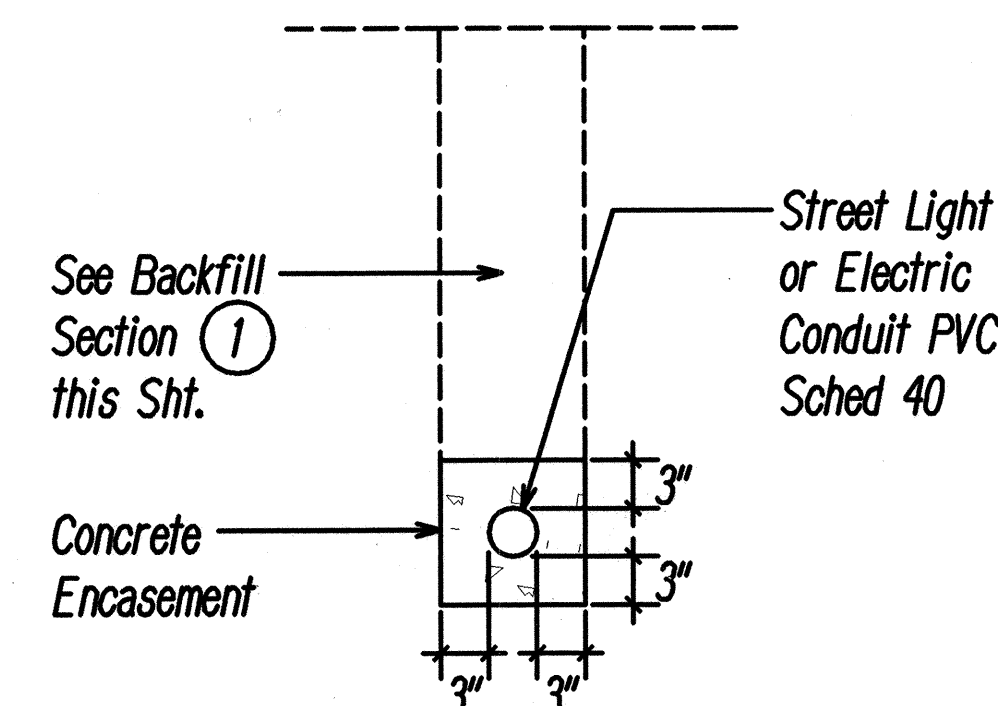

SECTION (A)

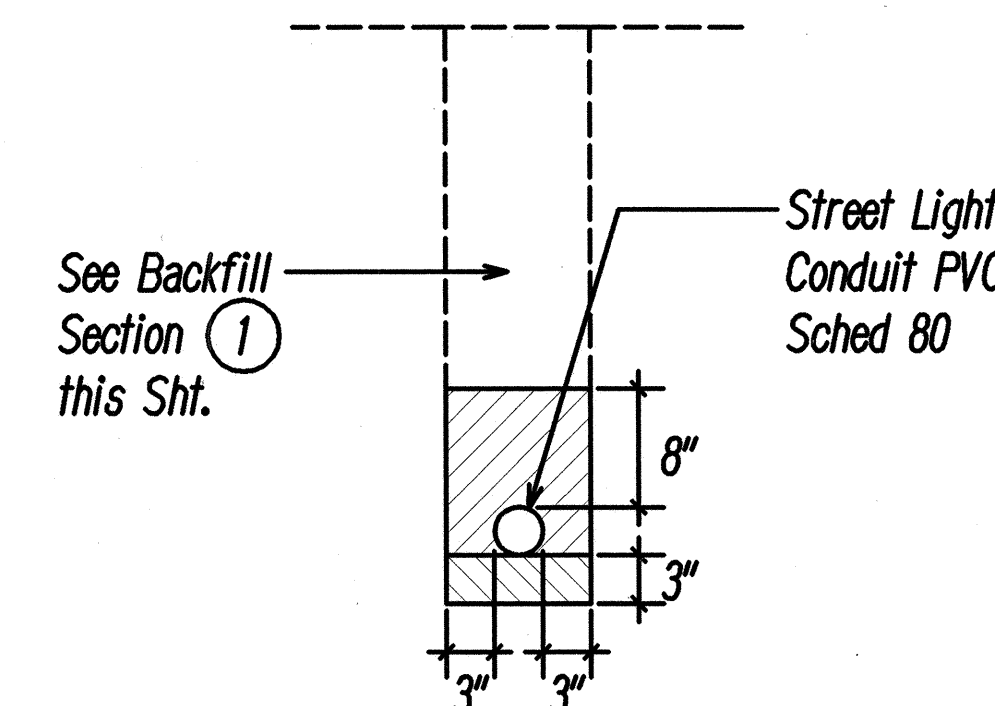

SECTION (B)

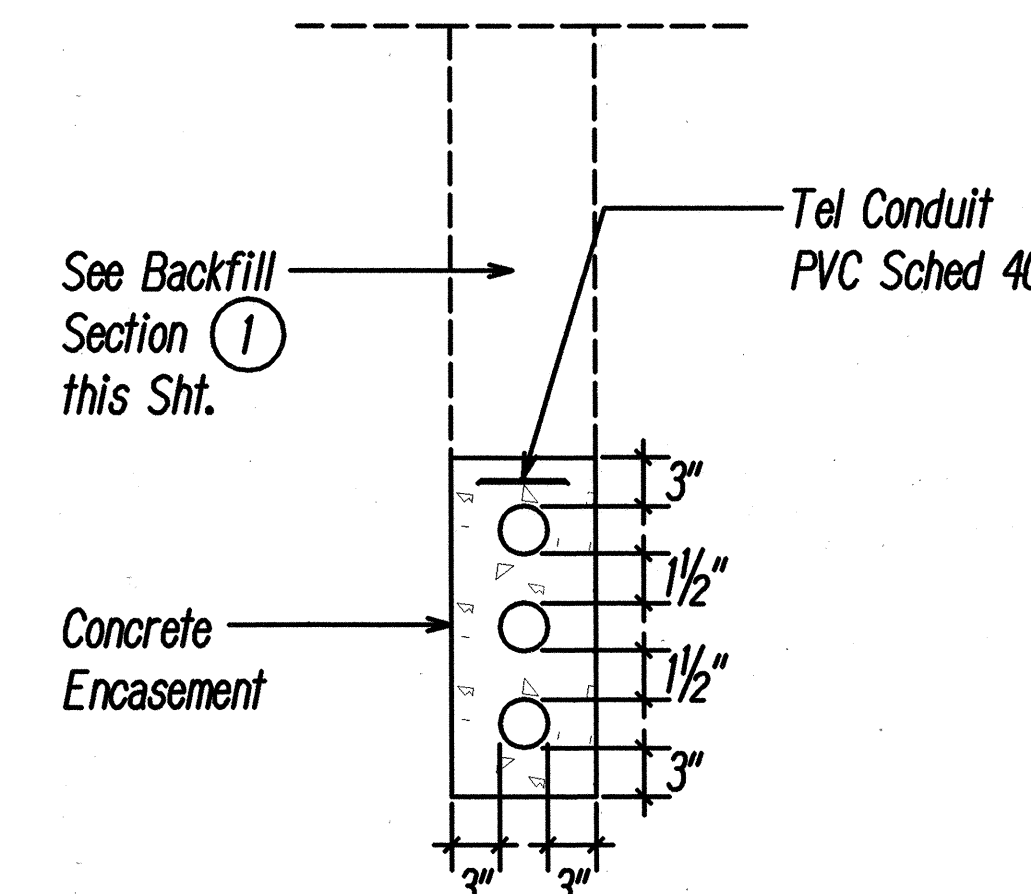

SECTION (C)

DUCT SECTION DETAILS
Not to Scale

BACKFILL NOTES

Not to Scale

Trench Backfill Material "A" Beach Sand, Earth, or Earth and Gravel. If Earth and Gravel used, the maximum shall contain not more than 50% by volume of rock particles. Maximum 8" loose fill per lift. Obtain 95% compaction for each lift.


If Material below Duct is Not Equivalent to Backfill Material "A", Excavate Material & Provide 3" Backfill Material "A". See above.

Concrete - 3" Encasement, 3000 PSI Compressive Strength @ 3 Days.

Note: Base Course & Sub-base Course per 1994 State Standard Specifications for Highway Construction.

TRENCHING NOTES:

- If trench is located on unpaved area, the Contractor shall replace 10" A.C. Base Course and 4" A.C. Pavement with Type "A" backfill material.
- The Contractor may begin backfilling the conduit trench when the concrete reaches 3000 psi compressive strength after 3 days.

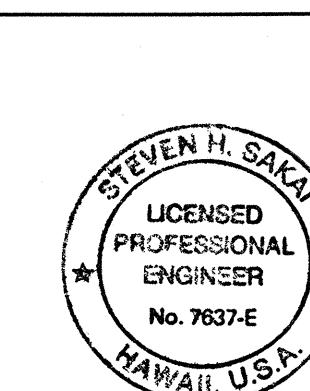

This Work was prepared by me or Under My Supervision

ELECTRICAL DETAILS DUCT SECTIONS

HONOAHIKANI HIGHWAY WIDENING
Maalaea Road to North Kihei Road
F.A. Project No. NH-030-1(28)

Scale: As Noted Date: July 2001

SHEET No. E10 OF 72 SHEETS