

INDEX TO DRAWINGS	
SHEET NO.	DESCRIPTION
1	TITLE SHEET
2	STANDARD PLANS SUMMARY
3	GENERAL NOTES AND LEGEND
4 - 5	WATER POLLUTION AND EROSION CONTROL NOTES
6 - 7	TYPICAL SECTIONS AND DETAILS
8 - 10	ROADWAY PLANS
11 - 36	DRAINAGE PLANS
37 - 42	TRAFFIC PLANS
43	GUARDRAIL SCHEDULE
44 - 49	GUARDRAIL DETAILS
50 - 62	CROSS SECTIONS
63 - 72	ELECTRICAL AND TELEPHONE PLANS

STATE OF HAWAII

DEPARTMENT OF TRANSPORTATION

HIGHWAYS DIVISION

HONOLULU, HAWAII

"AS-BUILT"

PLANS FOR

HONOAPIILANI HIGHWAY WIDENING




MAALAEA ROAD TO NORTH KIHEI ROAD

FEDERAL AID PROJECT NO. NH-030-1(28)

DISTRICT OF WAILUKU

ISLAND OF MAUI

FED. ROAD DIST. NO.	STATE	FED. AID PROJ. NO.	FISCAL YEAR	SHEET NO.	TOTAL SHEETS
HAWAII	HAW.	NH-030-1(28)	2002	1	72

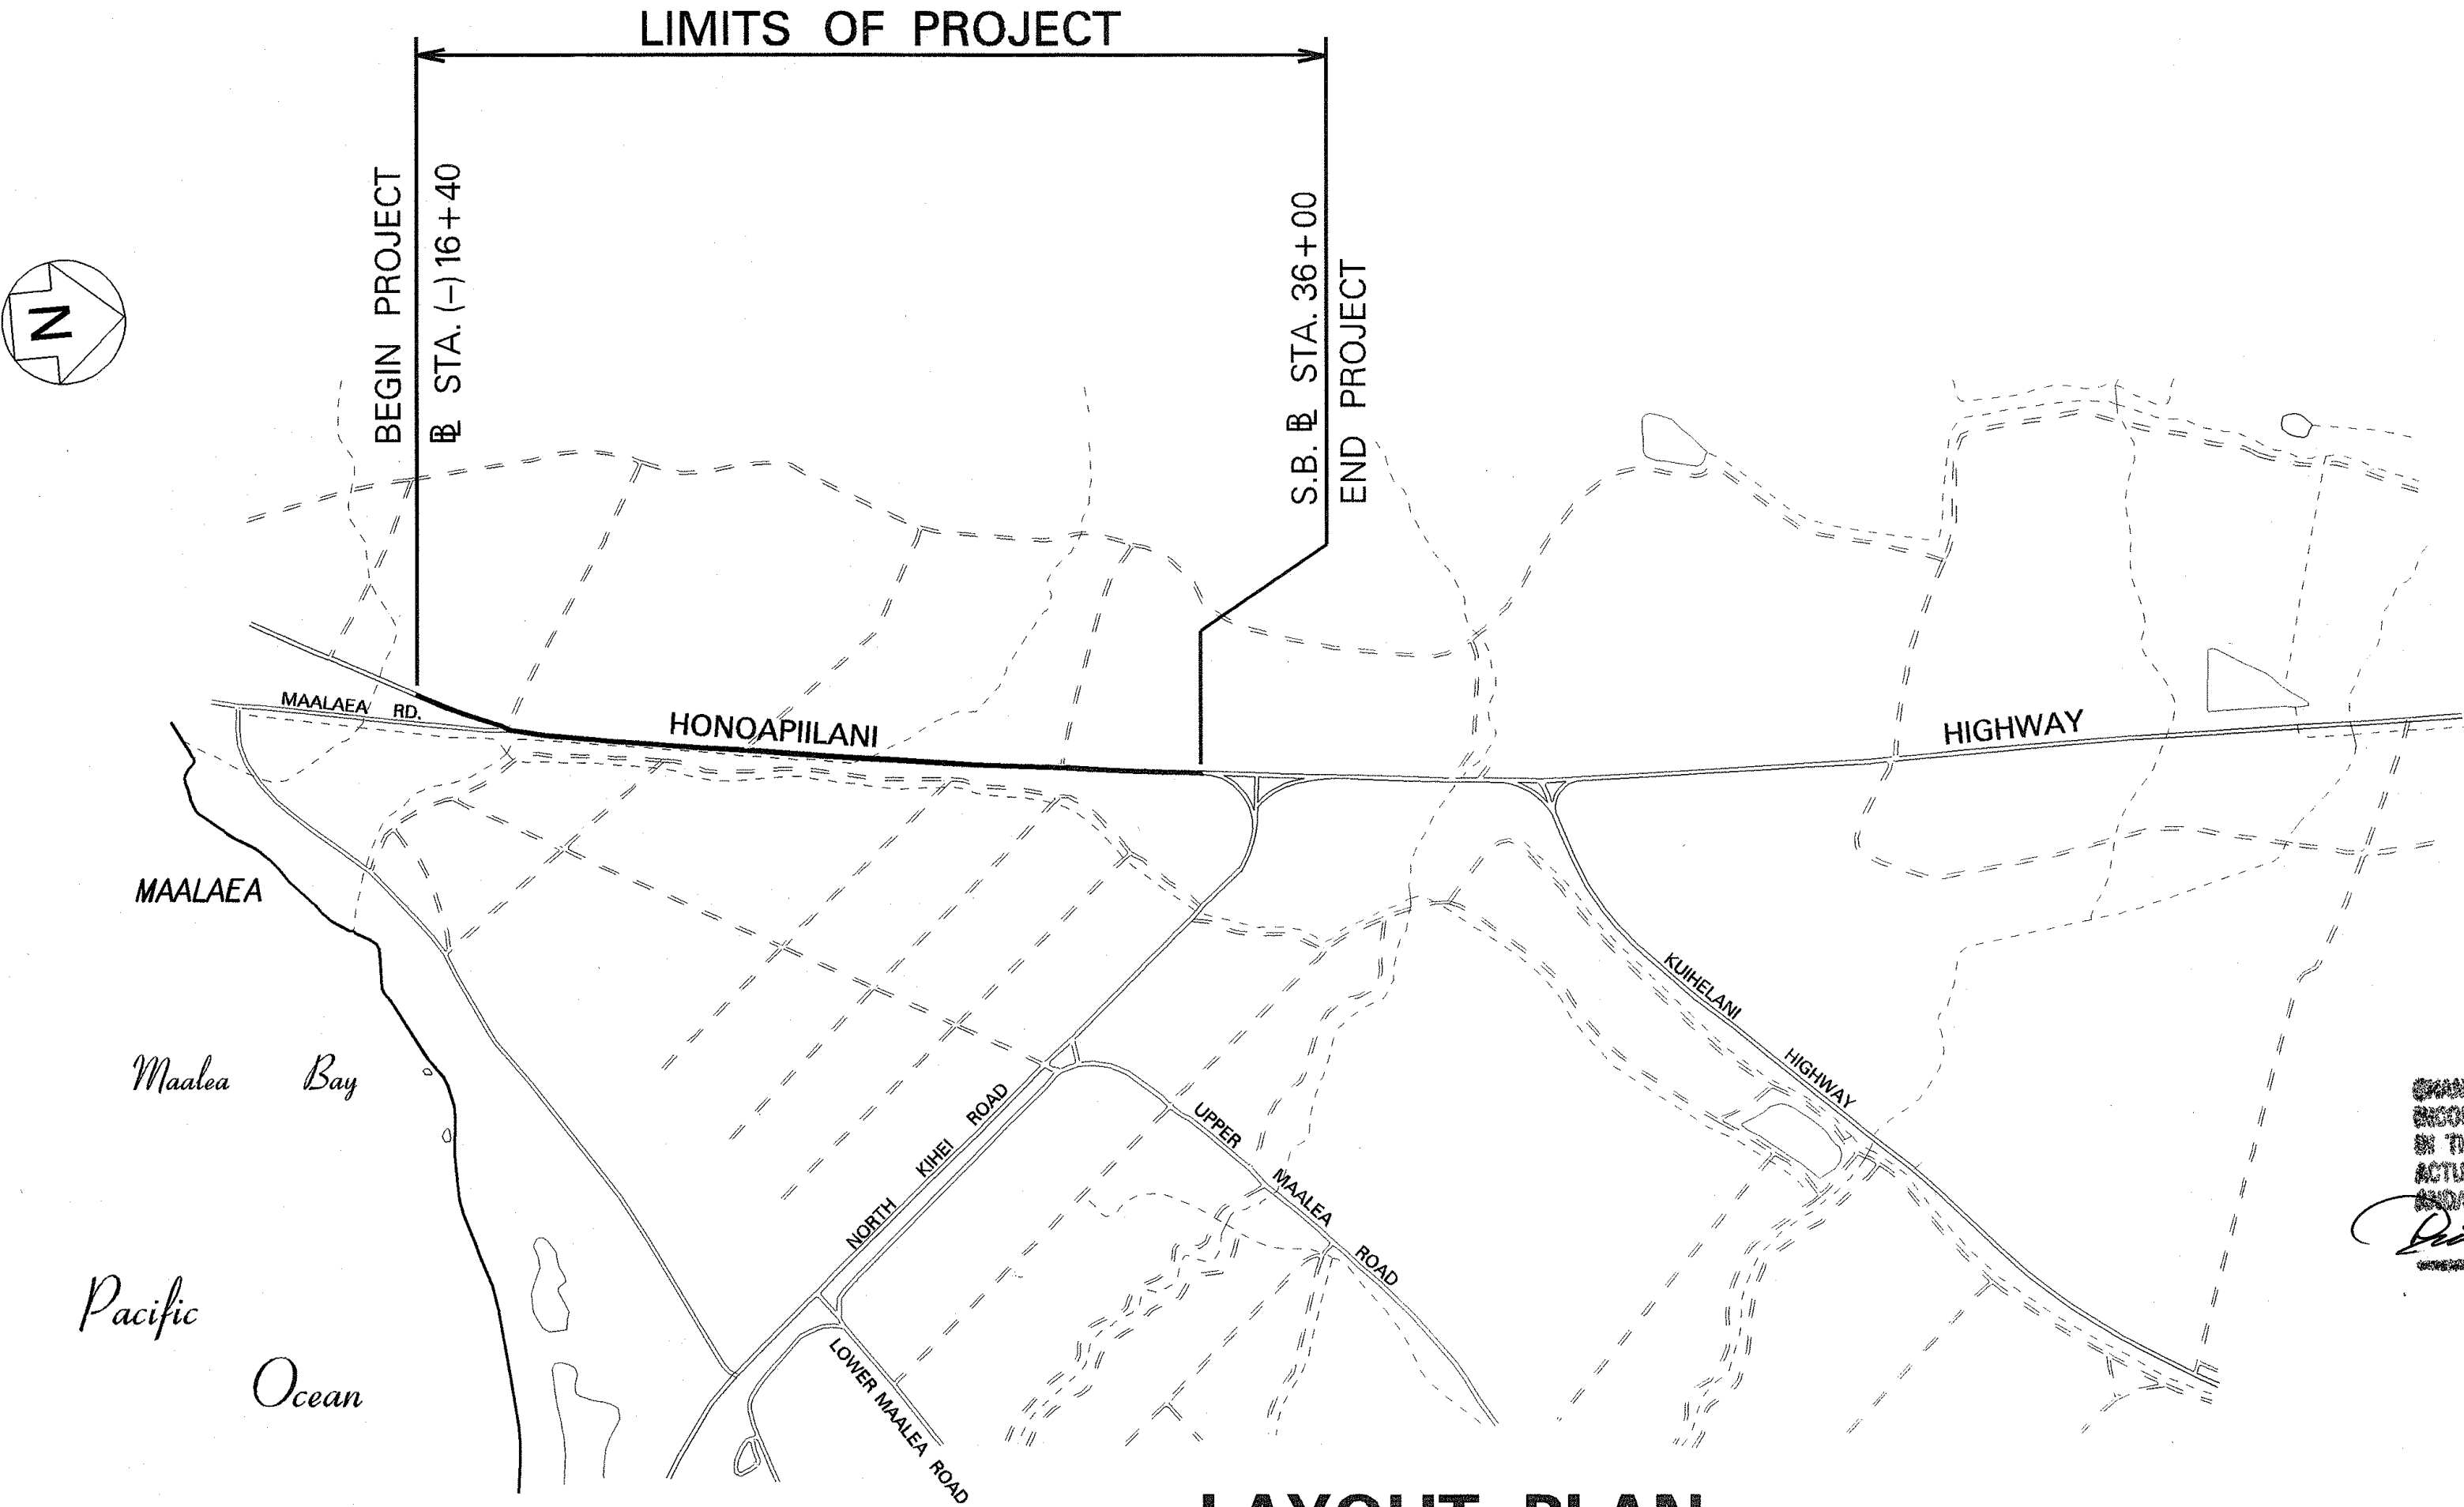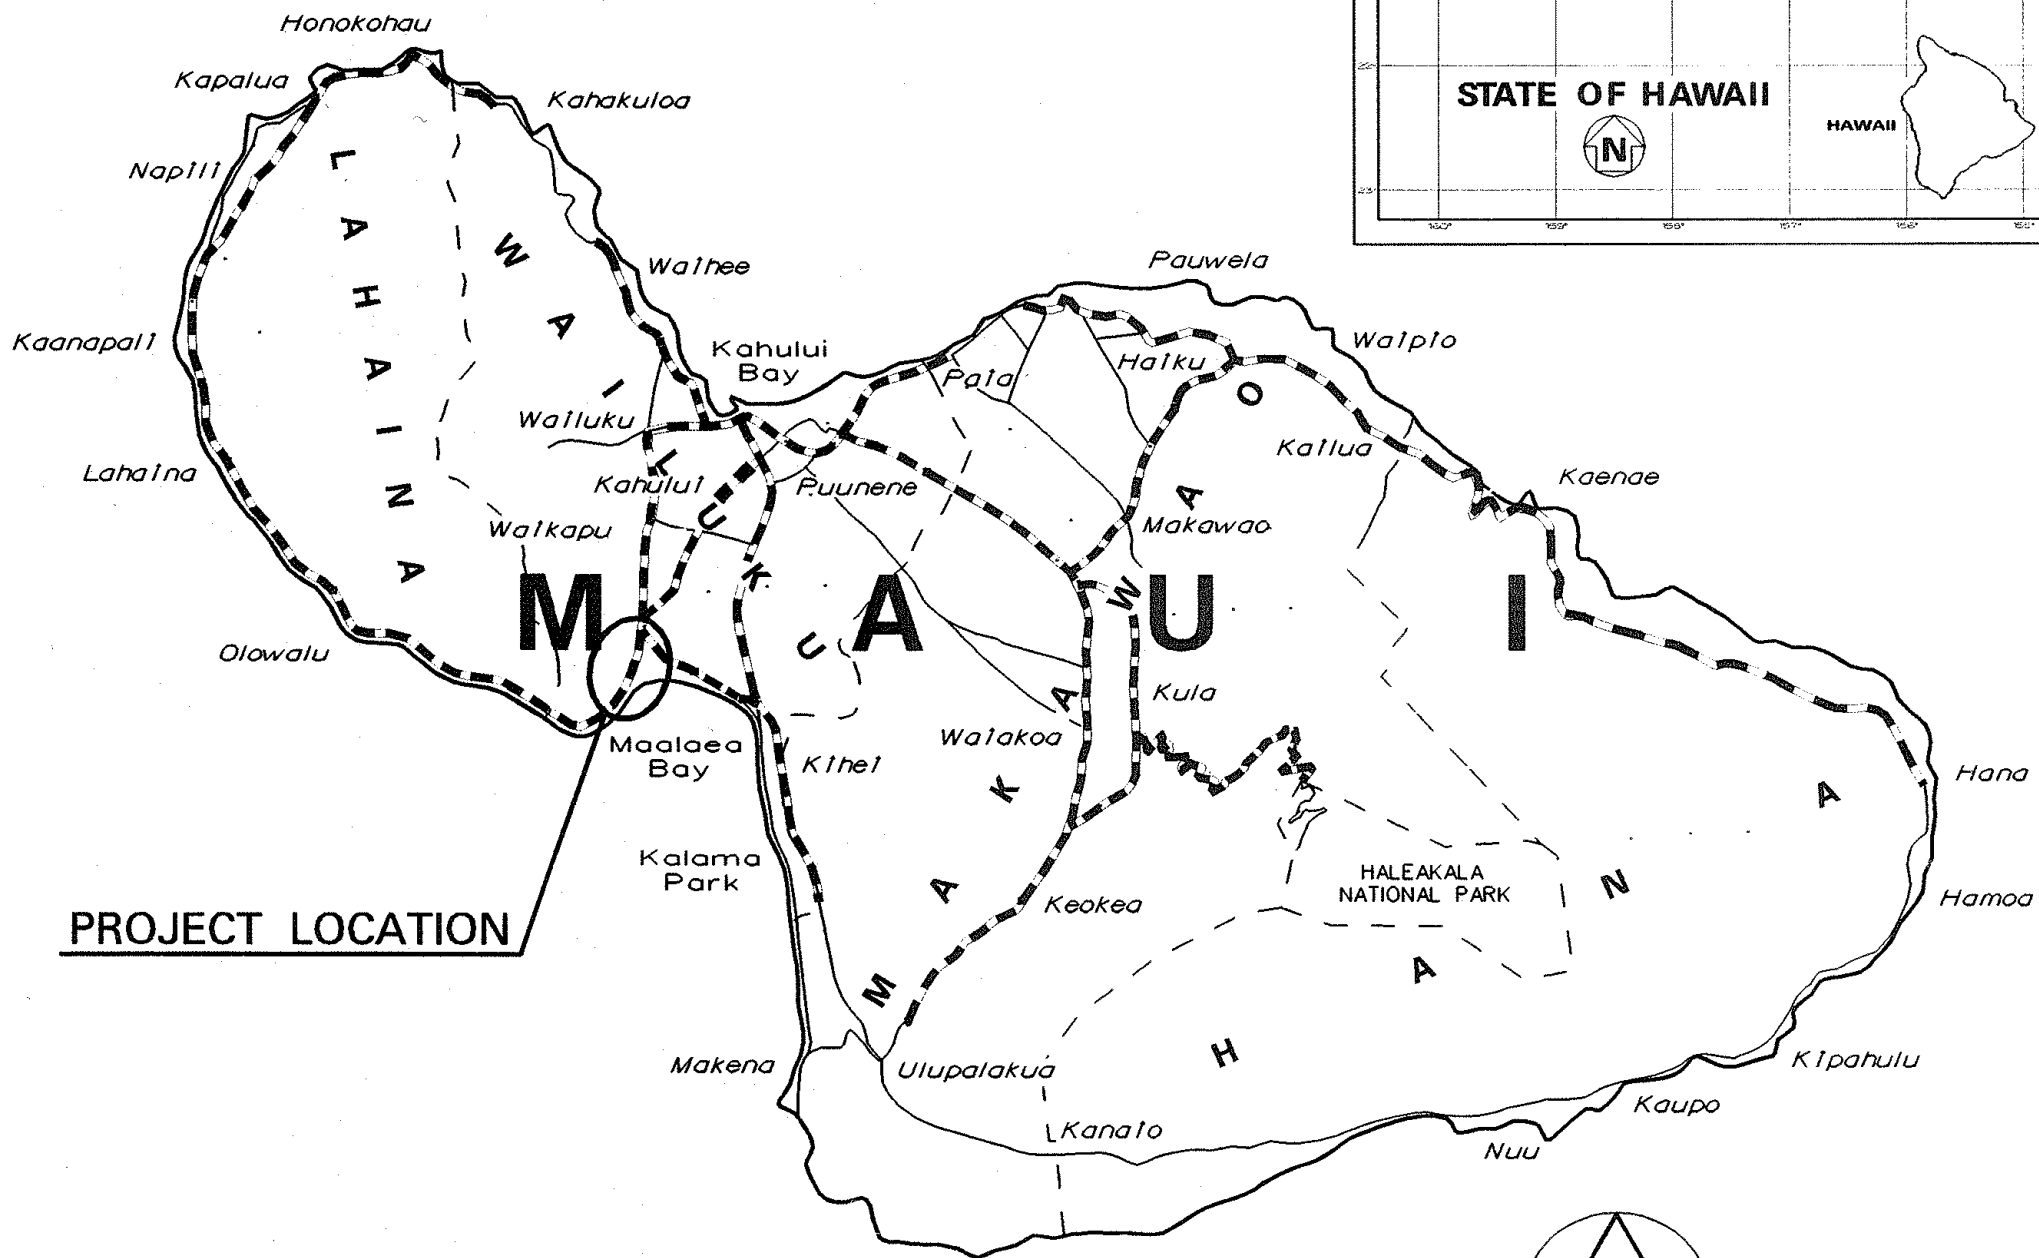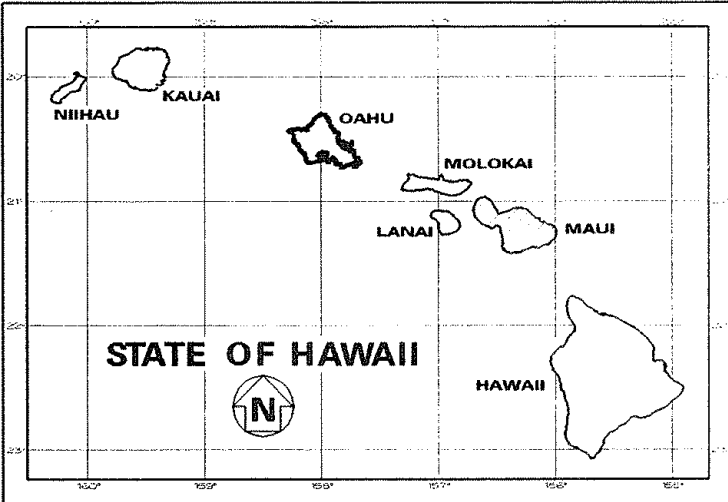

FEDERAL AID PROJECTS PREVIOUSLY CONSTRUCTED OR UNDER CONSTRUCTION

MILE POST 6.190 TO MILE POST 5.200

DESIGN DESIGNATION

ADT (1997).....23,175

ADT (2017).....37,340

DHV.....3,360

D.....60/40

T.....2.0 %


V.....55 M.P.H.

CHANGES MADE SINCE CONSTRUCTION MAY BE INCORPORATED ON THESE PLANS WITHOUT CHANGES IN THE ORIGINAL THEORETICAL QUANTITIES FOR ACTUAL QUANTITIES, SUCH AS PROJECT LENGTH AND/OR COMPLETION DATE.

[Signature] 7/14/06

LAYOUT PLAN

NET LENGTH OF PROJECT.....0.99 MILES

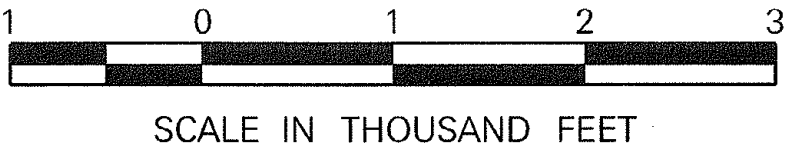

DEPARTMENT OF TRANSPORTATION STATE OF HAWAII	
APPROVED:	
<i>[Signature]</i> DIR. OF TRANSPORTATION	11-7-01 DATE