


FED. ROAD DIST. NO.	STATE	FED. AID PROJ. NO.	FISCAL YEAR	SHEET NO.	TOTAL SHEETS
HAWAII	HAW.	STP-030-1(22)	2001	8	8

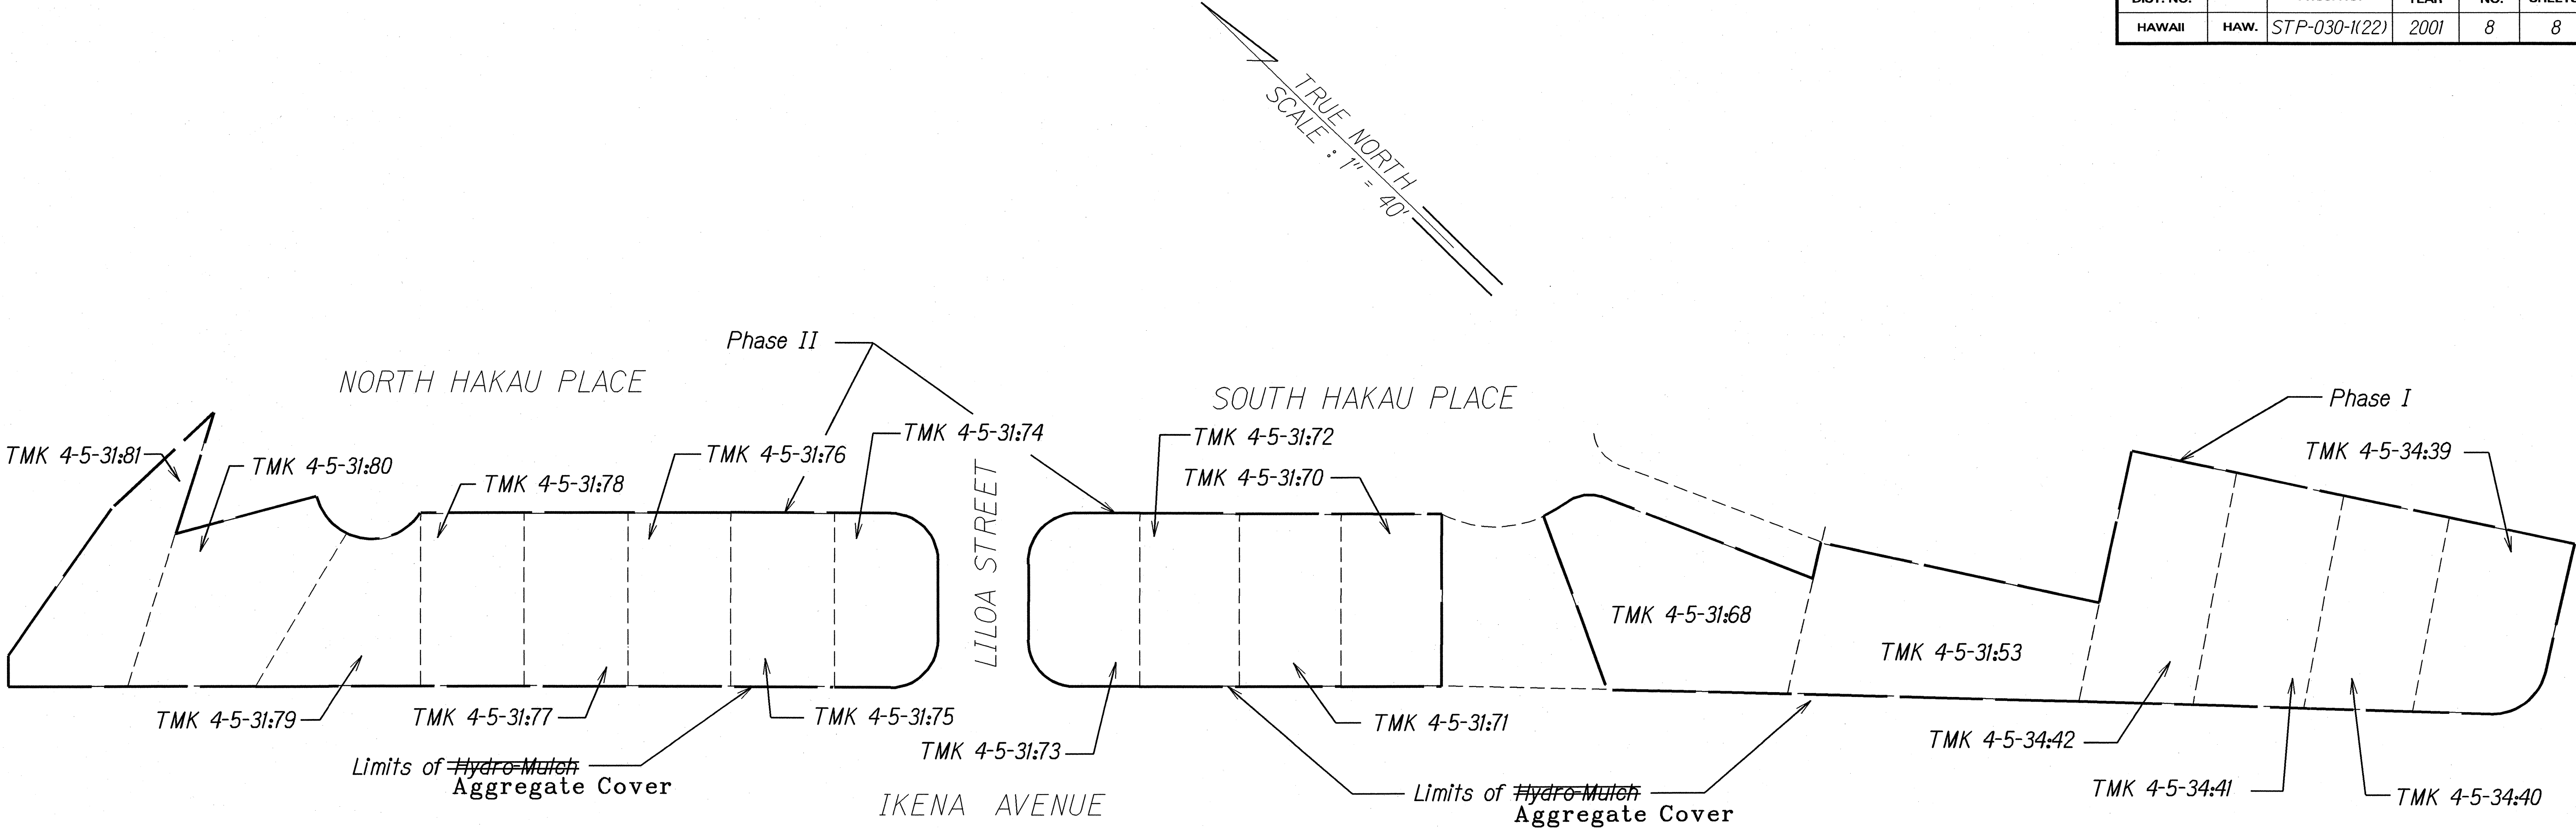

AGGREGATE APPLICATION

- NOTES: apply 3/4" Aggregate
- Contractor shall ~~Hydro-Mulch Areas with grass and dirt cover~~ as directed by the Engineer.
 - Contractor shall not remove any existing concrete slabs within ~~Hydro-Mulching~~ areas.
 - Clearing of rocks and debris within the ~~Hydro-Mulching~~ areas shall be considered incidental to the various contract items and will not be paid for separately.

ORIGINAL PLAN	SURVEY PLOTTED BY	DATE
NOTE BOOK	DRAWN BY G. Kawano	11/21/02
ddg/awen	CHECKED BY	
4490ms0209		

LEGEND FOR AS-BUILT POSTINGS	
	Squiggly line for as-built deletion
	Double line for as-built deletion
Roadway	Text for as-built posting

STATE OF HAWAII
DEPARTMENT OF TRANSPORTATION
HIGHWAYS DIVISION

AGGREGATE COVER
~~HYDRO-MULCH~~ PLAN
HONOAPIILANI HIGHWAY BYPASS
DEMOLITION OF IKEMA AVENUE (PHASE II)
FEDERAL-AID PROJECT NO. STP-030-1(22)

Scale: Not to Scale
Date: Nov., 2000

SHEET No. 1 OF 1 SHEETS