


FED. ROAD DIST. NO.	STATE	PROJ. NO.	FISCAL YEAR	SHEET NO.	TOTAL SHEETS
HAWAII	HAW.	STP-030-1(22)	2001	6	11

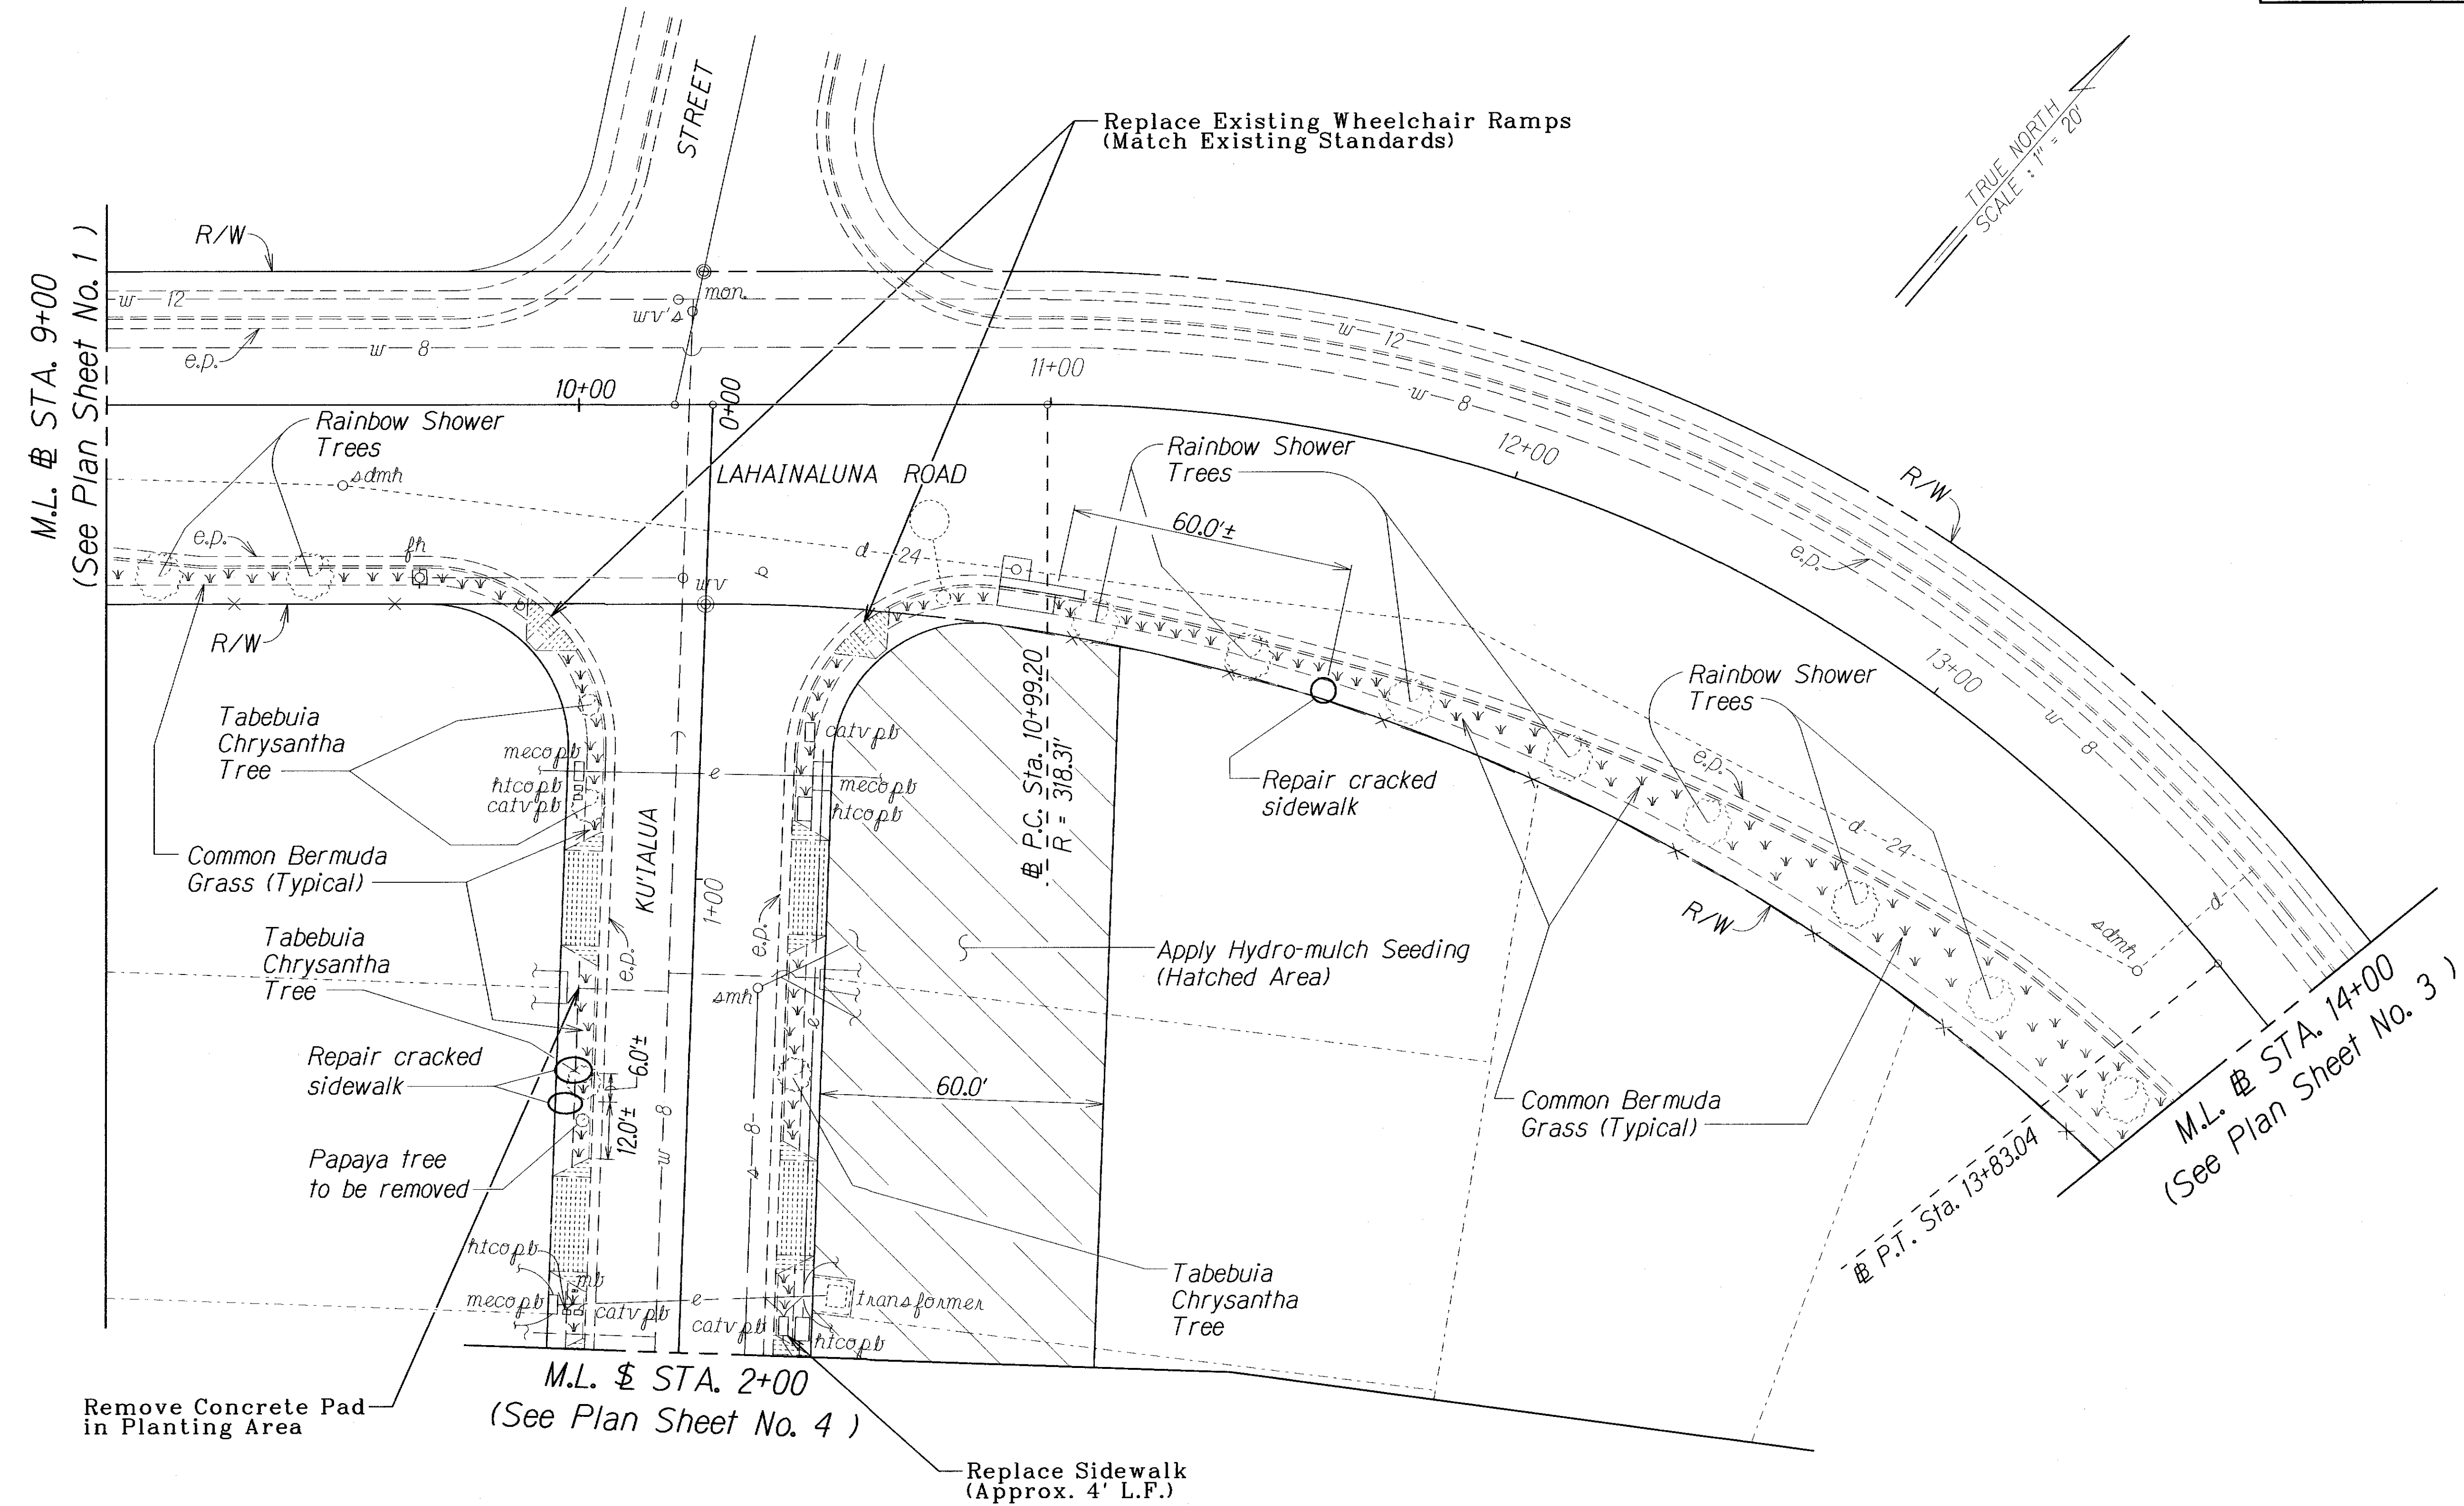

ORIGINAL PLAN	DATE
DESIGNED BY	
NOTED BY	
CHECKED BY	
DATE	

All Sewer and Storm Manholes, Water Valves, and Catch Basins are to be Removed, Cleaned, Painted (Where Applicable) and Replaced.
Totals this Sheet: 1-Sewer Manhole
1-Water Valve

LEGEND FOR AS-BUILT POSTINGS	
	Squiggly line for as-built deletion
	Double line for as-built deletion
Roadway	Text for as-built posting

STATE OF HAWAII
DEPARTMENT OF TRANSPORTATION
HIGHWAYS DIVISION

PLAN

HONOAPIILANI HIGHWAY BYPASS

LANDSCAPING

Kuialua Street and Hookahua Place (Phase III)


Project No. STP-030-1(22)

Scale: 1"=20' Date: Sept., 2000

SHEET No. 2 OF 5 SHEETS

"AS-BUILT"

FED. ROAD DIST. NO.	STATE	PROJ. NO.	FISCAL YEAR	SHEET NO.	TOTAL SHEETS
HAWAII	HAW.	STP-030-1(22)	2001	7	11

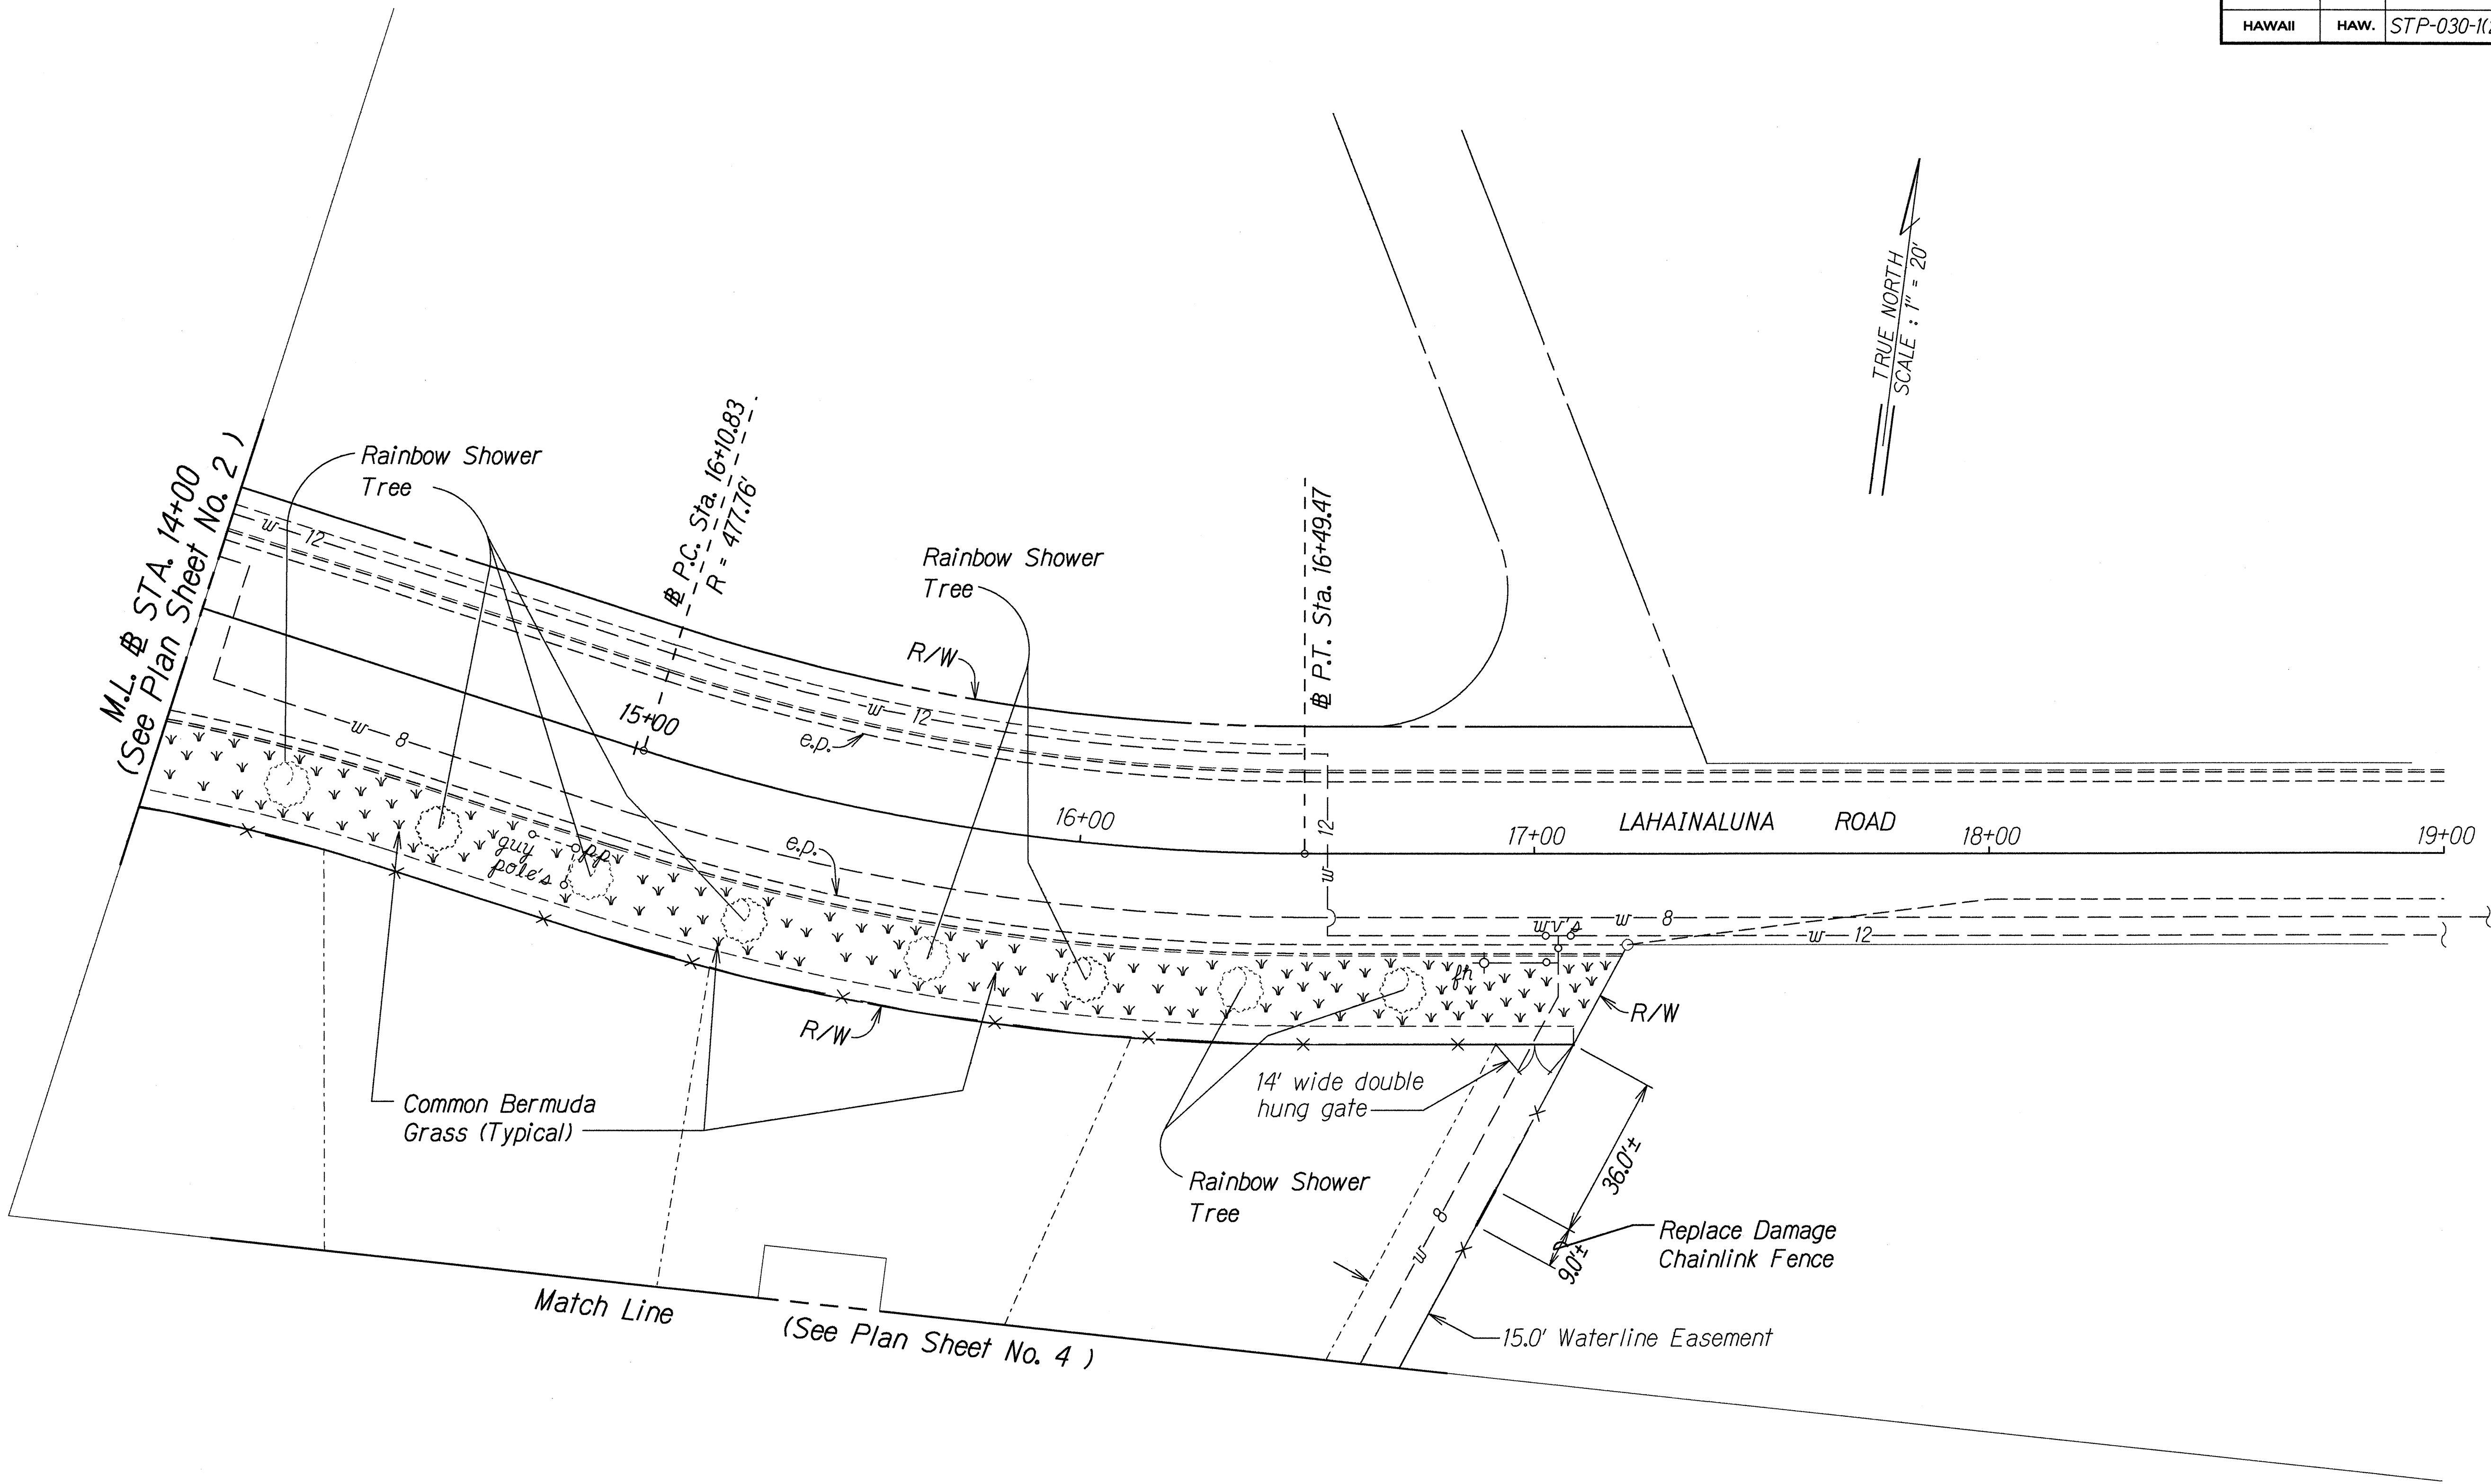

ORIGINAL PLAN	DATE
DRAWN BY	
DESIGNED BY	
CHECKED BY	
NOTED BY	
DATE	


STATE OF HAWAII
DEPARTMENT OF TRANSPORTATION
HIGHWAYS DIVISION

PLAN
HONOAPIILANI HIGHWAY BYPASS
LANDSCAPING
Kuialua Street and Hookahua Place (Phase III)
Project No. STP-030-1(22)
Scale: 1"=20' Date: Sept., 2000
SHEET No. 3 OF 5 SHEETS

FED. ROAD DIST. NO.	STATE	PROJ. NO.	FISCAL YEAR	SHEET NO.	TOTAL SHEETS
HAWAII	HAW.	STP-030-1122	2001	8	11

All Sewer and Storm Manholes, Water Valves, and Catch Basins are to be Removed, Cleaned, Painted (Where Applicable) and Replaced.
Totals this Sheet : 6-Sewer Manholes
6-Storm Drain Manholes
6-Water Valves
1-Catch Basin

TRUE NORTH
SCALE : 1" = 20'

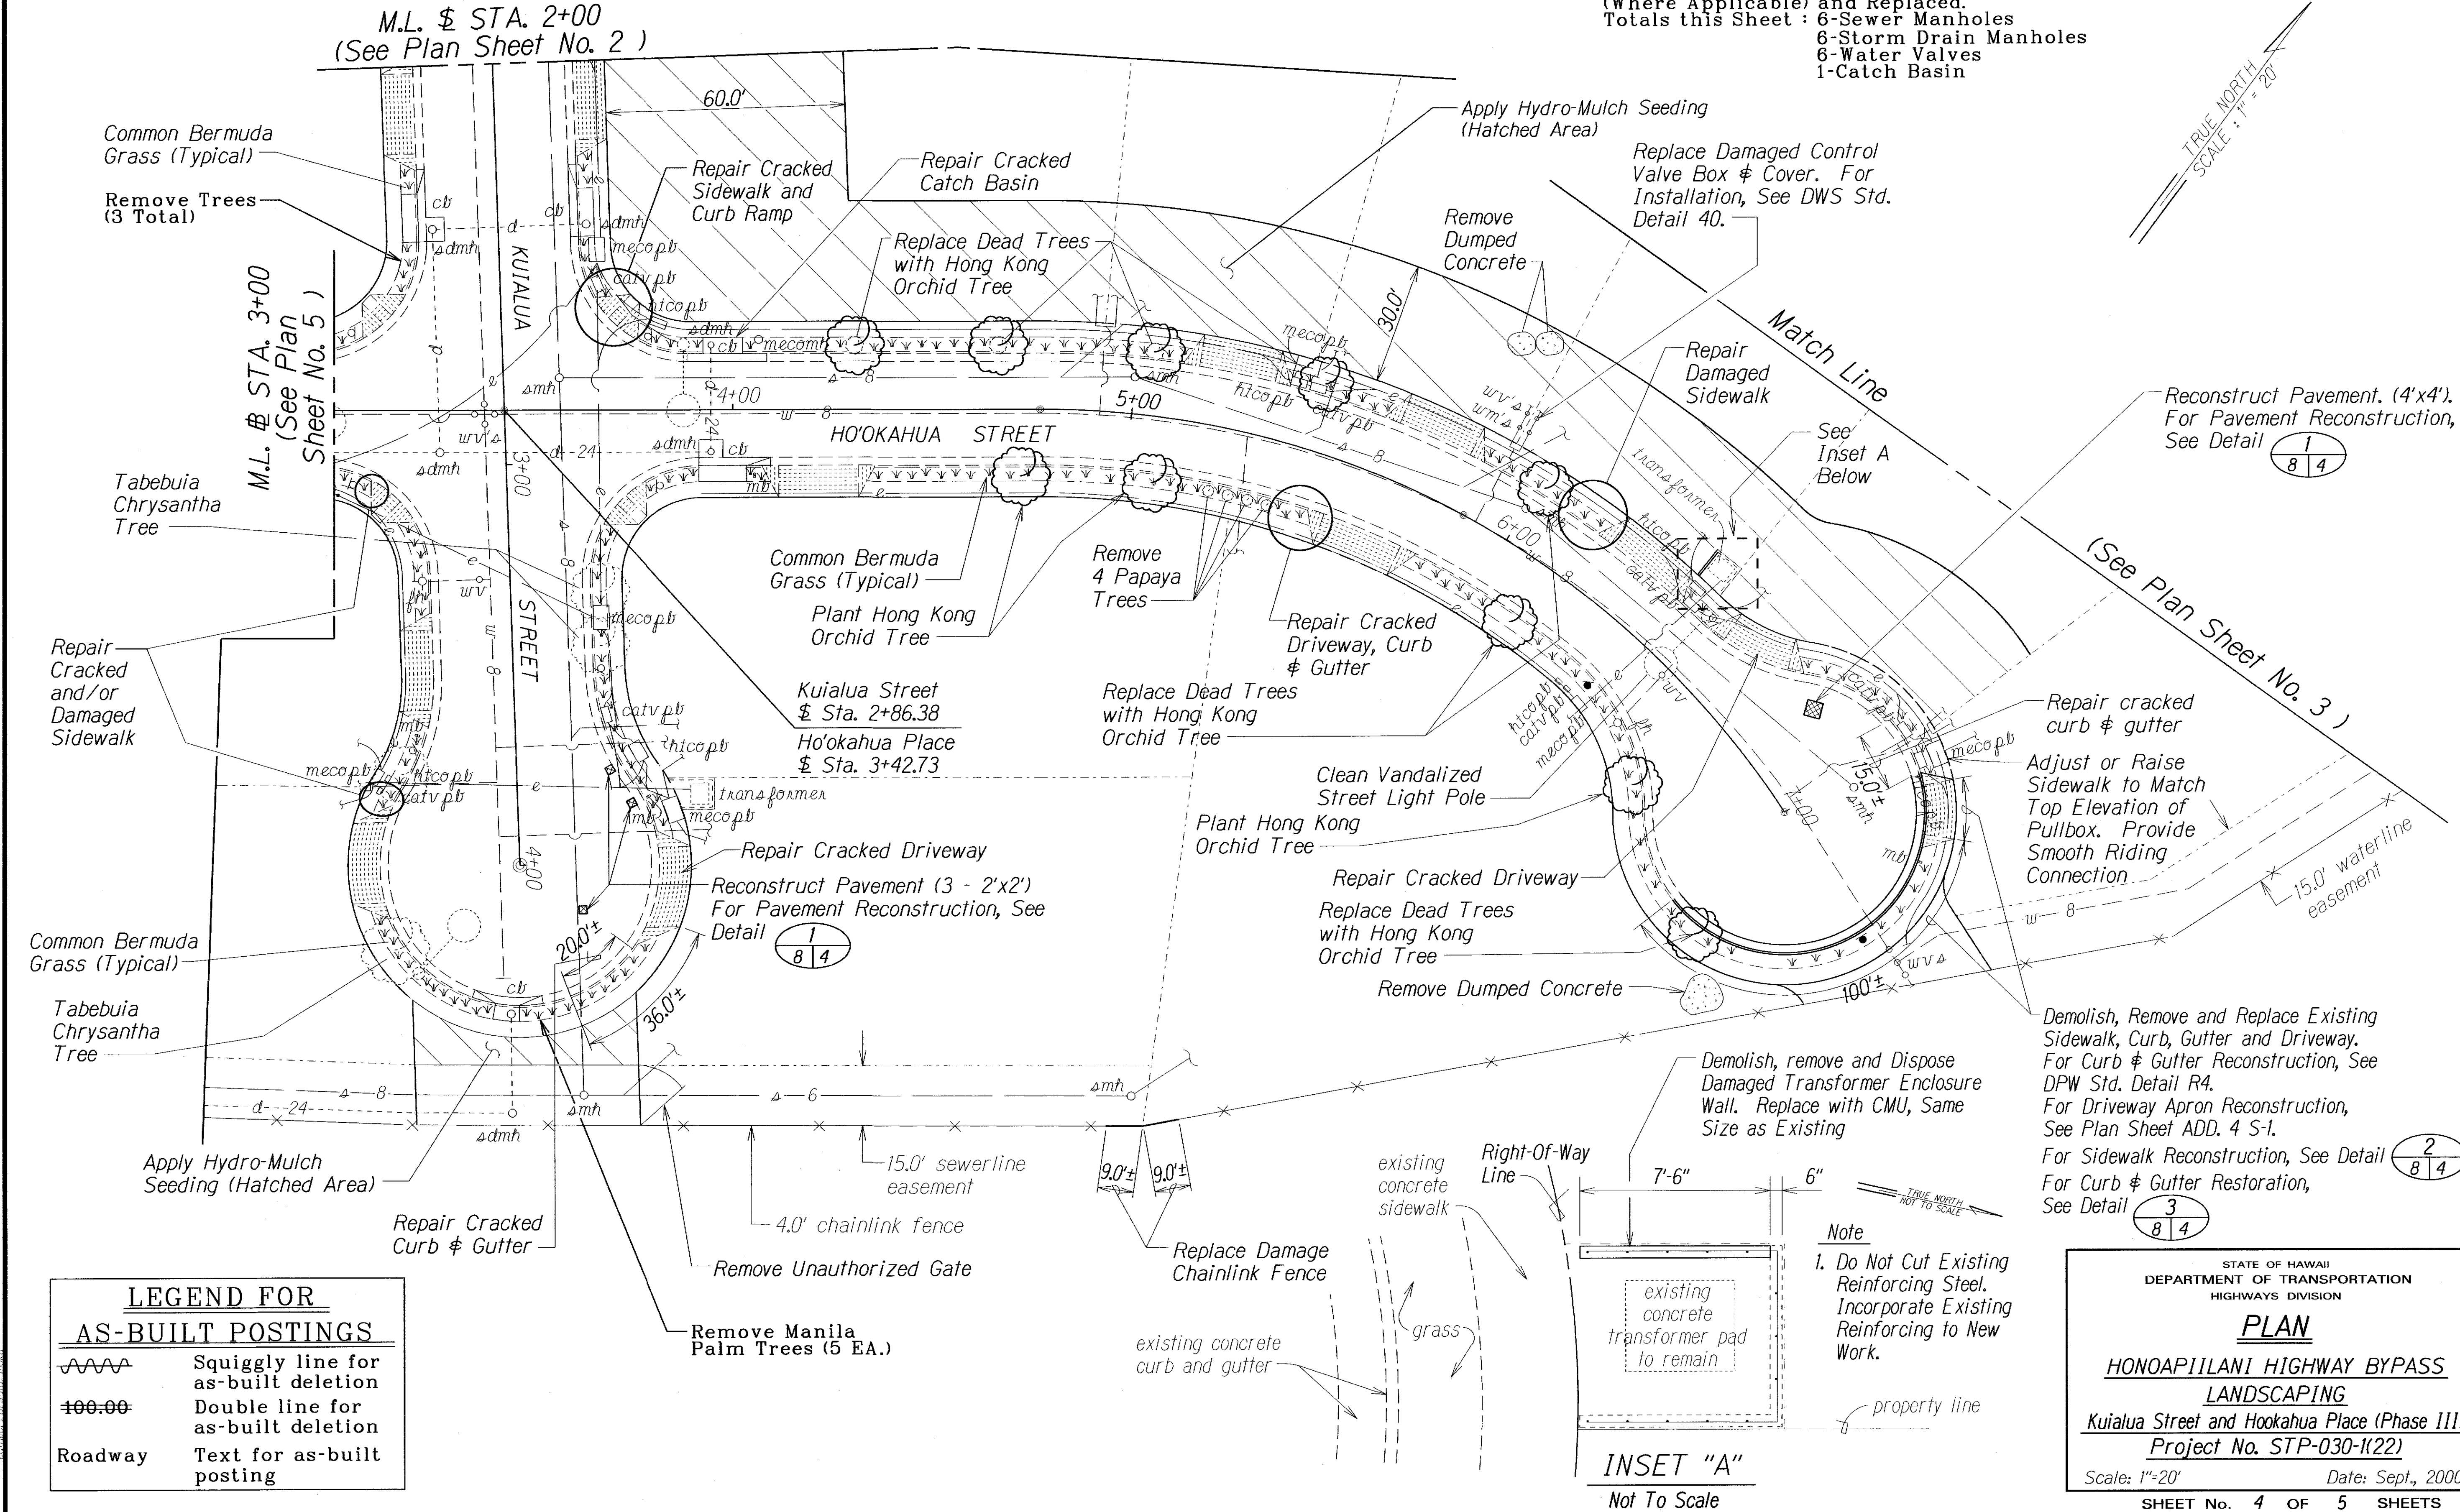

Reconstruct Pavement. (4'x4'). For Pavement Reconstruction, See Detail (1/8 4)

(See Plan Sheet No. 3)

Demolish, Remove and Replace Existing Sidewalk, Curb, Gutter and Driveway. For Curb & Gutter Reconstruction, See DPW Std. Detail R4. For Driveway Apron Reconstruction, See Plan Sheet ADD. 4 S-I. For Sidewalk Reconstruction, See Detail (2/8 4) For Curb & Gutter Restoration, See Detail (3/8 4)

Note
1. Do Not Cut Existing Reinforcing Steel. Incorporate Existing Reinforcing to New Work.

INSET "A"
Not To Scale

STATE OF HAWAII
DEPARTMENT OF TRANSPORTATION
HIGHWAYS DIVISION

PLAN
HONOAPIILANI HIGHWAY BYPASS
LANDSCAPING
Kuialua Street and Ho'okahua Place (Phase III)
Project No. STP-030-1122
Scale: 1"=20' Date: Sept., 2000
SHEET No. 4 OF 5 SHEETS

LEGEND FOR
AS-BUILT POSTINGS

Squiggly line for as-built deletion
 Double line for as-built deletion
Roadway Text for as-built posting

ORIGINAL PLAN	DATE
DRAWN BY	
DESIGNED BY	
CHECKED BY	
NOTED BY	

