

INDEX TO DRAWINGS	
SHEET NO.	DESCRIPTION
1	TITLE SHEET
2	GENERAL NOTES AND LEGEND
3	DEMOLITION PLAN
4	MISCELLANEOUS DETAILS

STATE OF HAWAII

DEPARTMENT OF TRANSPORTATION

HIGHWAYS DIVISION

HONOLULU, HAWAII

"AS-BUILT"

PLANS FOR



HONOAPIILANI HIGHWAY BYPASS

DEMOLITION OF IKENA AVENUE (PHASE I)

FEDERAL AID PROJECT NO. STP-030-1(22)

DISTRICT OF LAHAINA

ISLAND OF MAUI

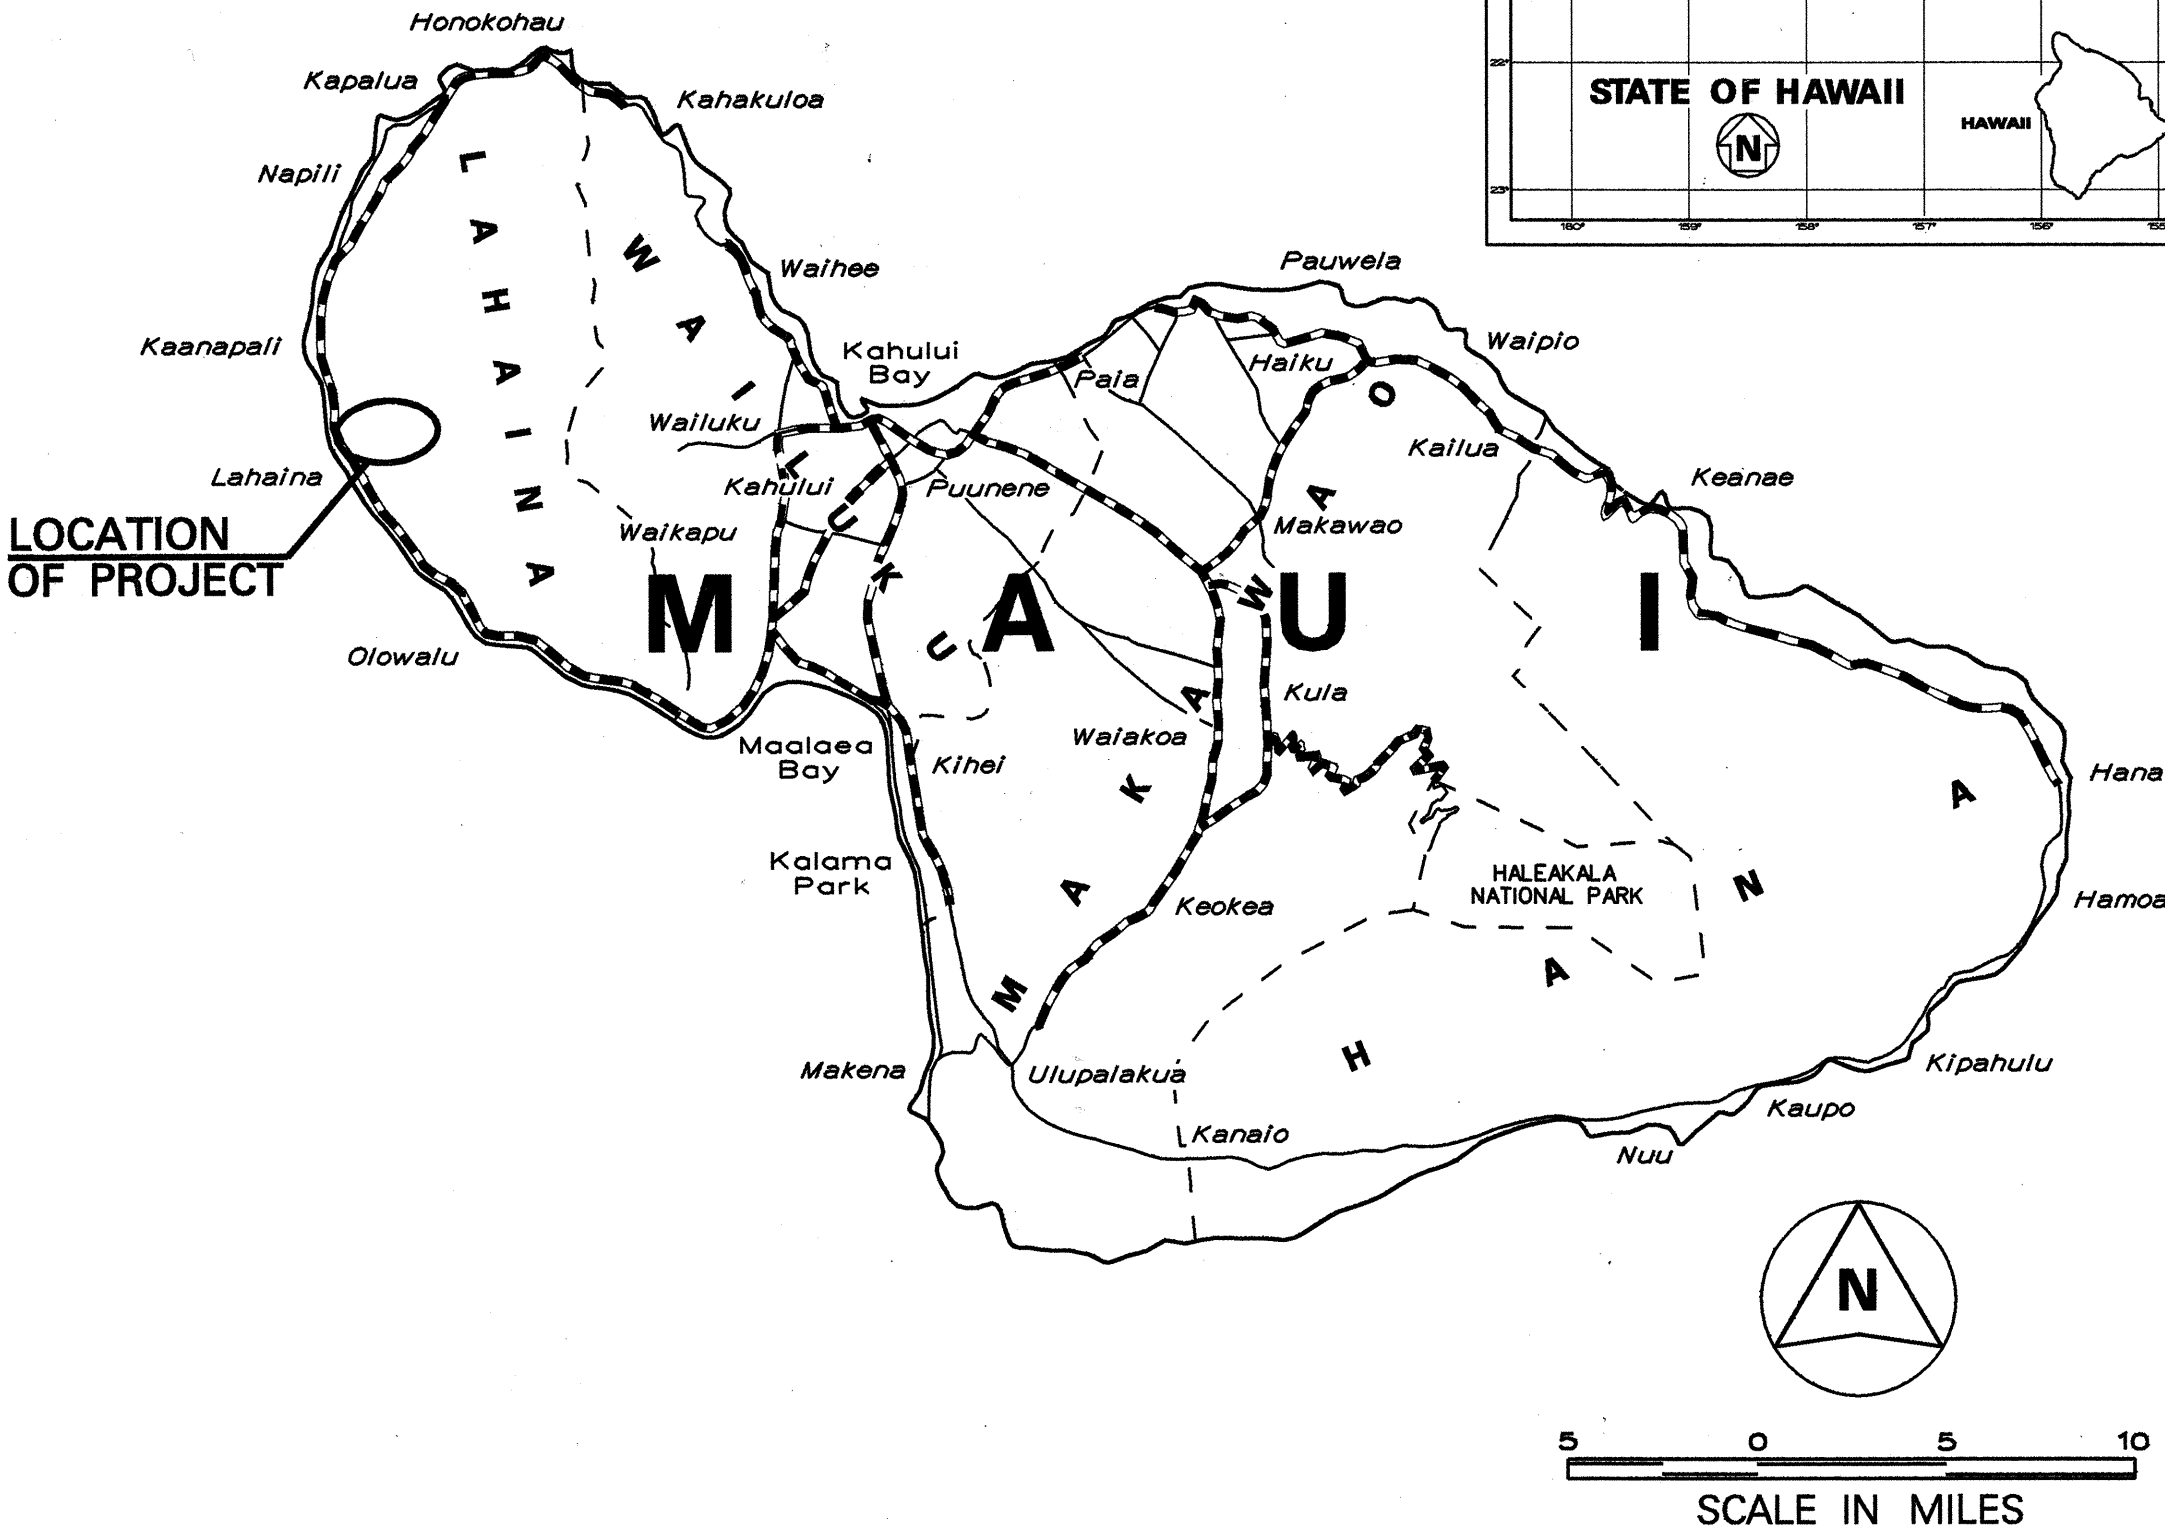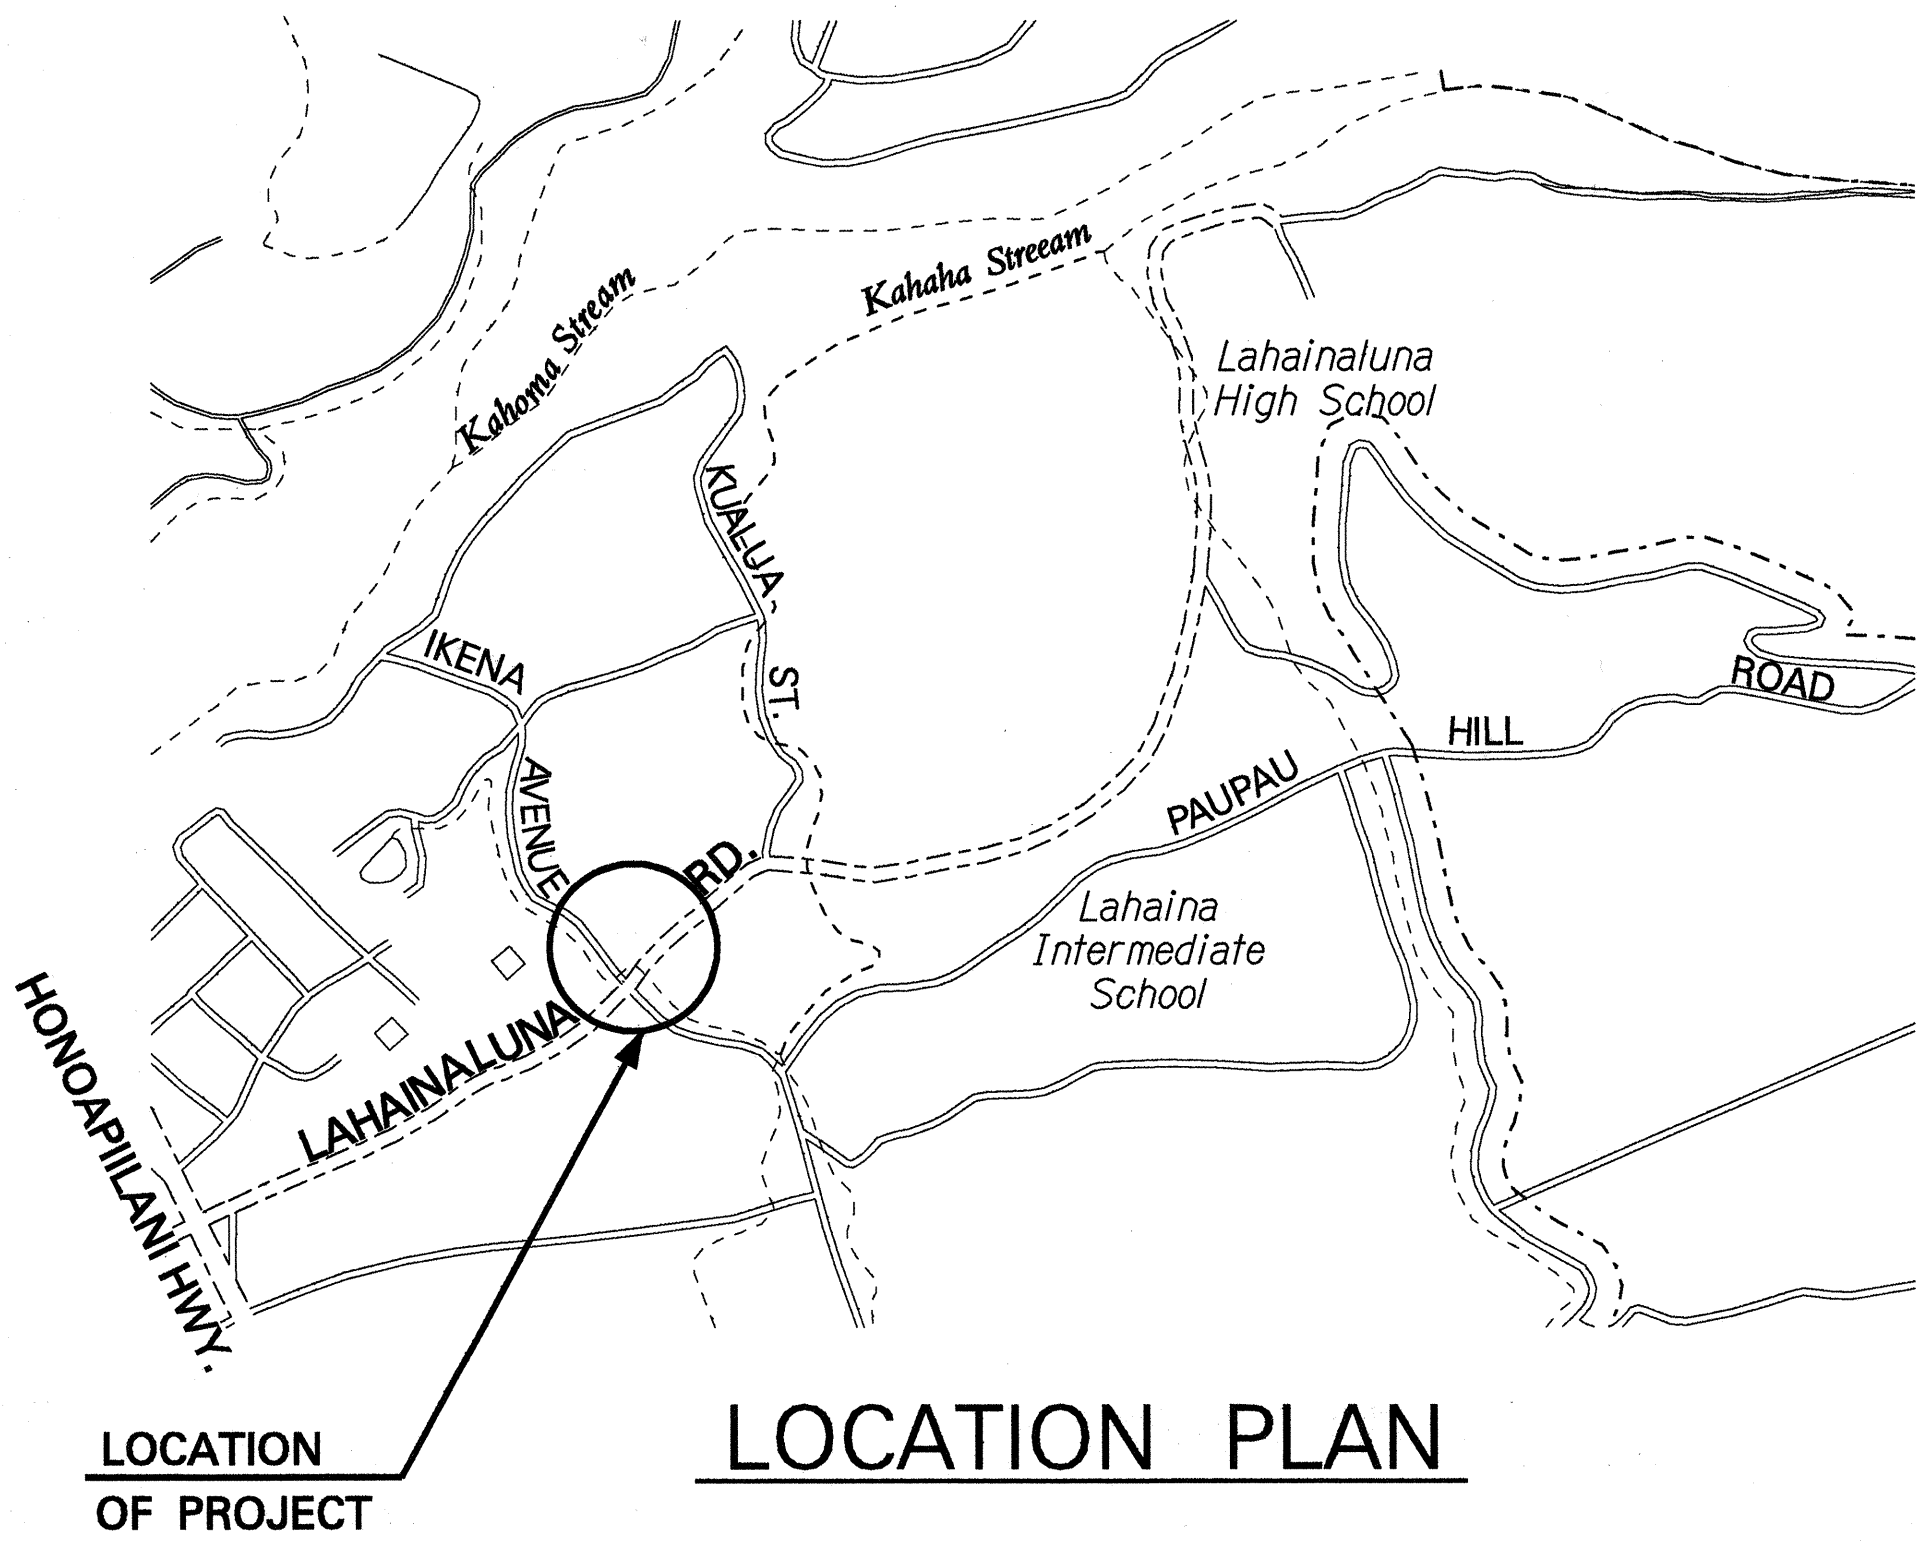

CHANGES MADE DURING CONSTRUCTION HAVE BEEN INCORPORATED ON THESE PLANS EXCEPT CHANGES IN THE ORIGINAL THEORETICAL QUANTITIES. FOR ACTUAL QUANTITIES, REFER TO PROJECT LEDGER AND/OR COMPUTATION BOOK.

*[Signature]*  
RESIDENT ENGINEER

8/15/01  
DATE

DEPARTMENT OF TRANSPORTATION STATE OF HAWAII	
APPROVED: <i>[Signature]</i> DIR. OF TRANSPORTATION	11/9/99 DATE

DESIGNED BY

HWY-DD

K. TATSUGUCHI

692-7578

PHONE

NOV. 1999

DATE