

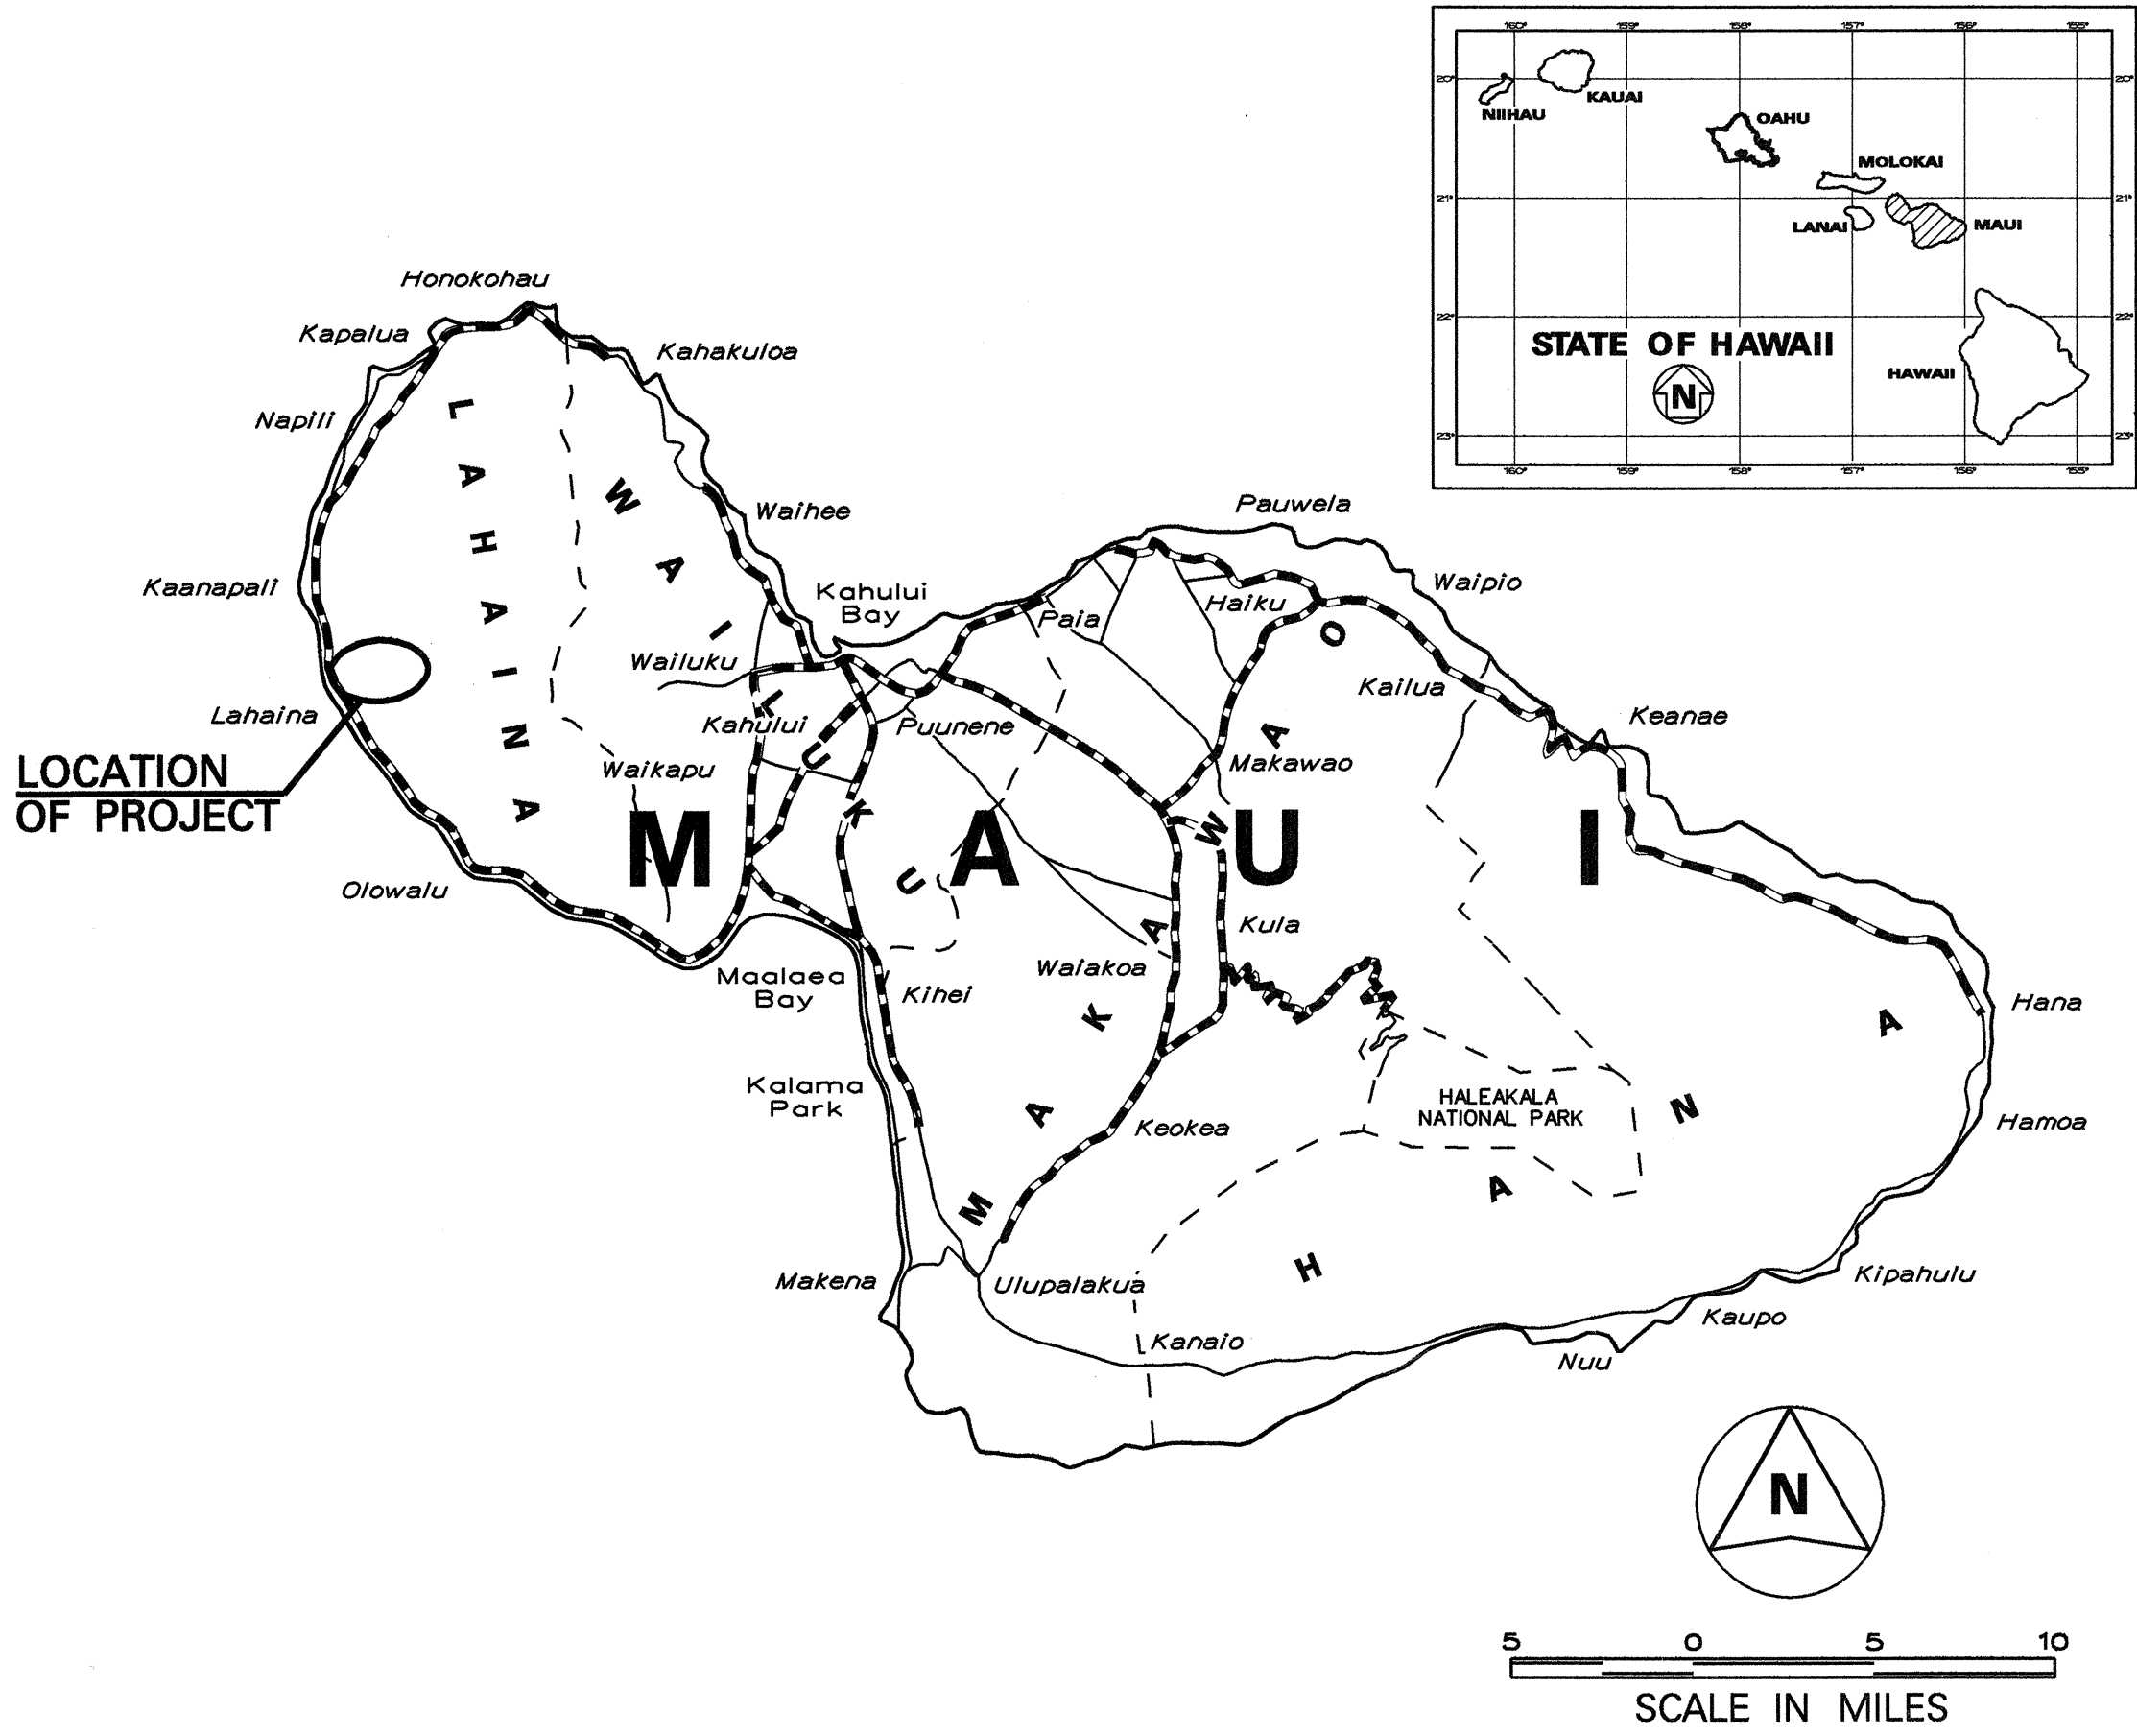


| INDEX TO DRAWINGS | |
|-------------------|--------------------------|
| SHEET NO. | DESCRIPTION |
| 1 | TITLE SHEET |
| 2 | GENERAL NOTES AND LEGEND |
| 3 - 6 | DEMOLITION PLAN |
| 7 | MISCELLANEOUS DETAILS |
| 8 | HYDRO-MULCH PLAN |

STATE OF HAWAII
DEPARTMENT OF TRANSPORTATION
HIGHWAYS DIVISION
HONOLULU, HAWAII
"AS-BUILT"
PLANS FOR
HONOAPIILANI HIGHWAY BYPASS
DEMOLITION OF IKENA AVENUE (PHASE II)
FEDERAL AID PROJECT NO. STP-030-1(22)
DISTRICT OF LAHAINA
ISLAND OF MAUI

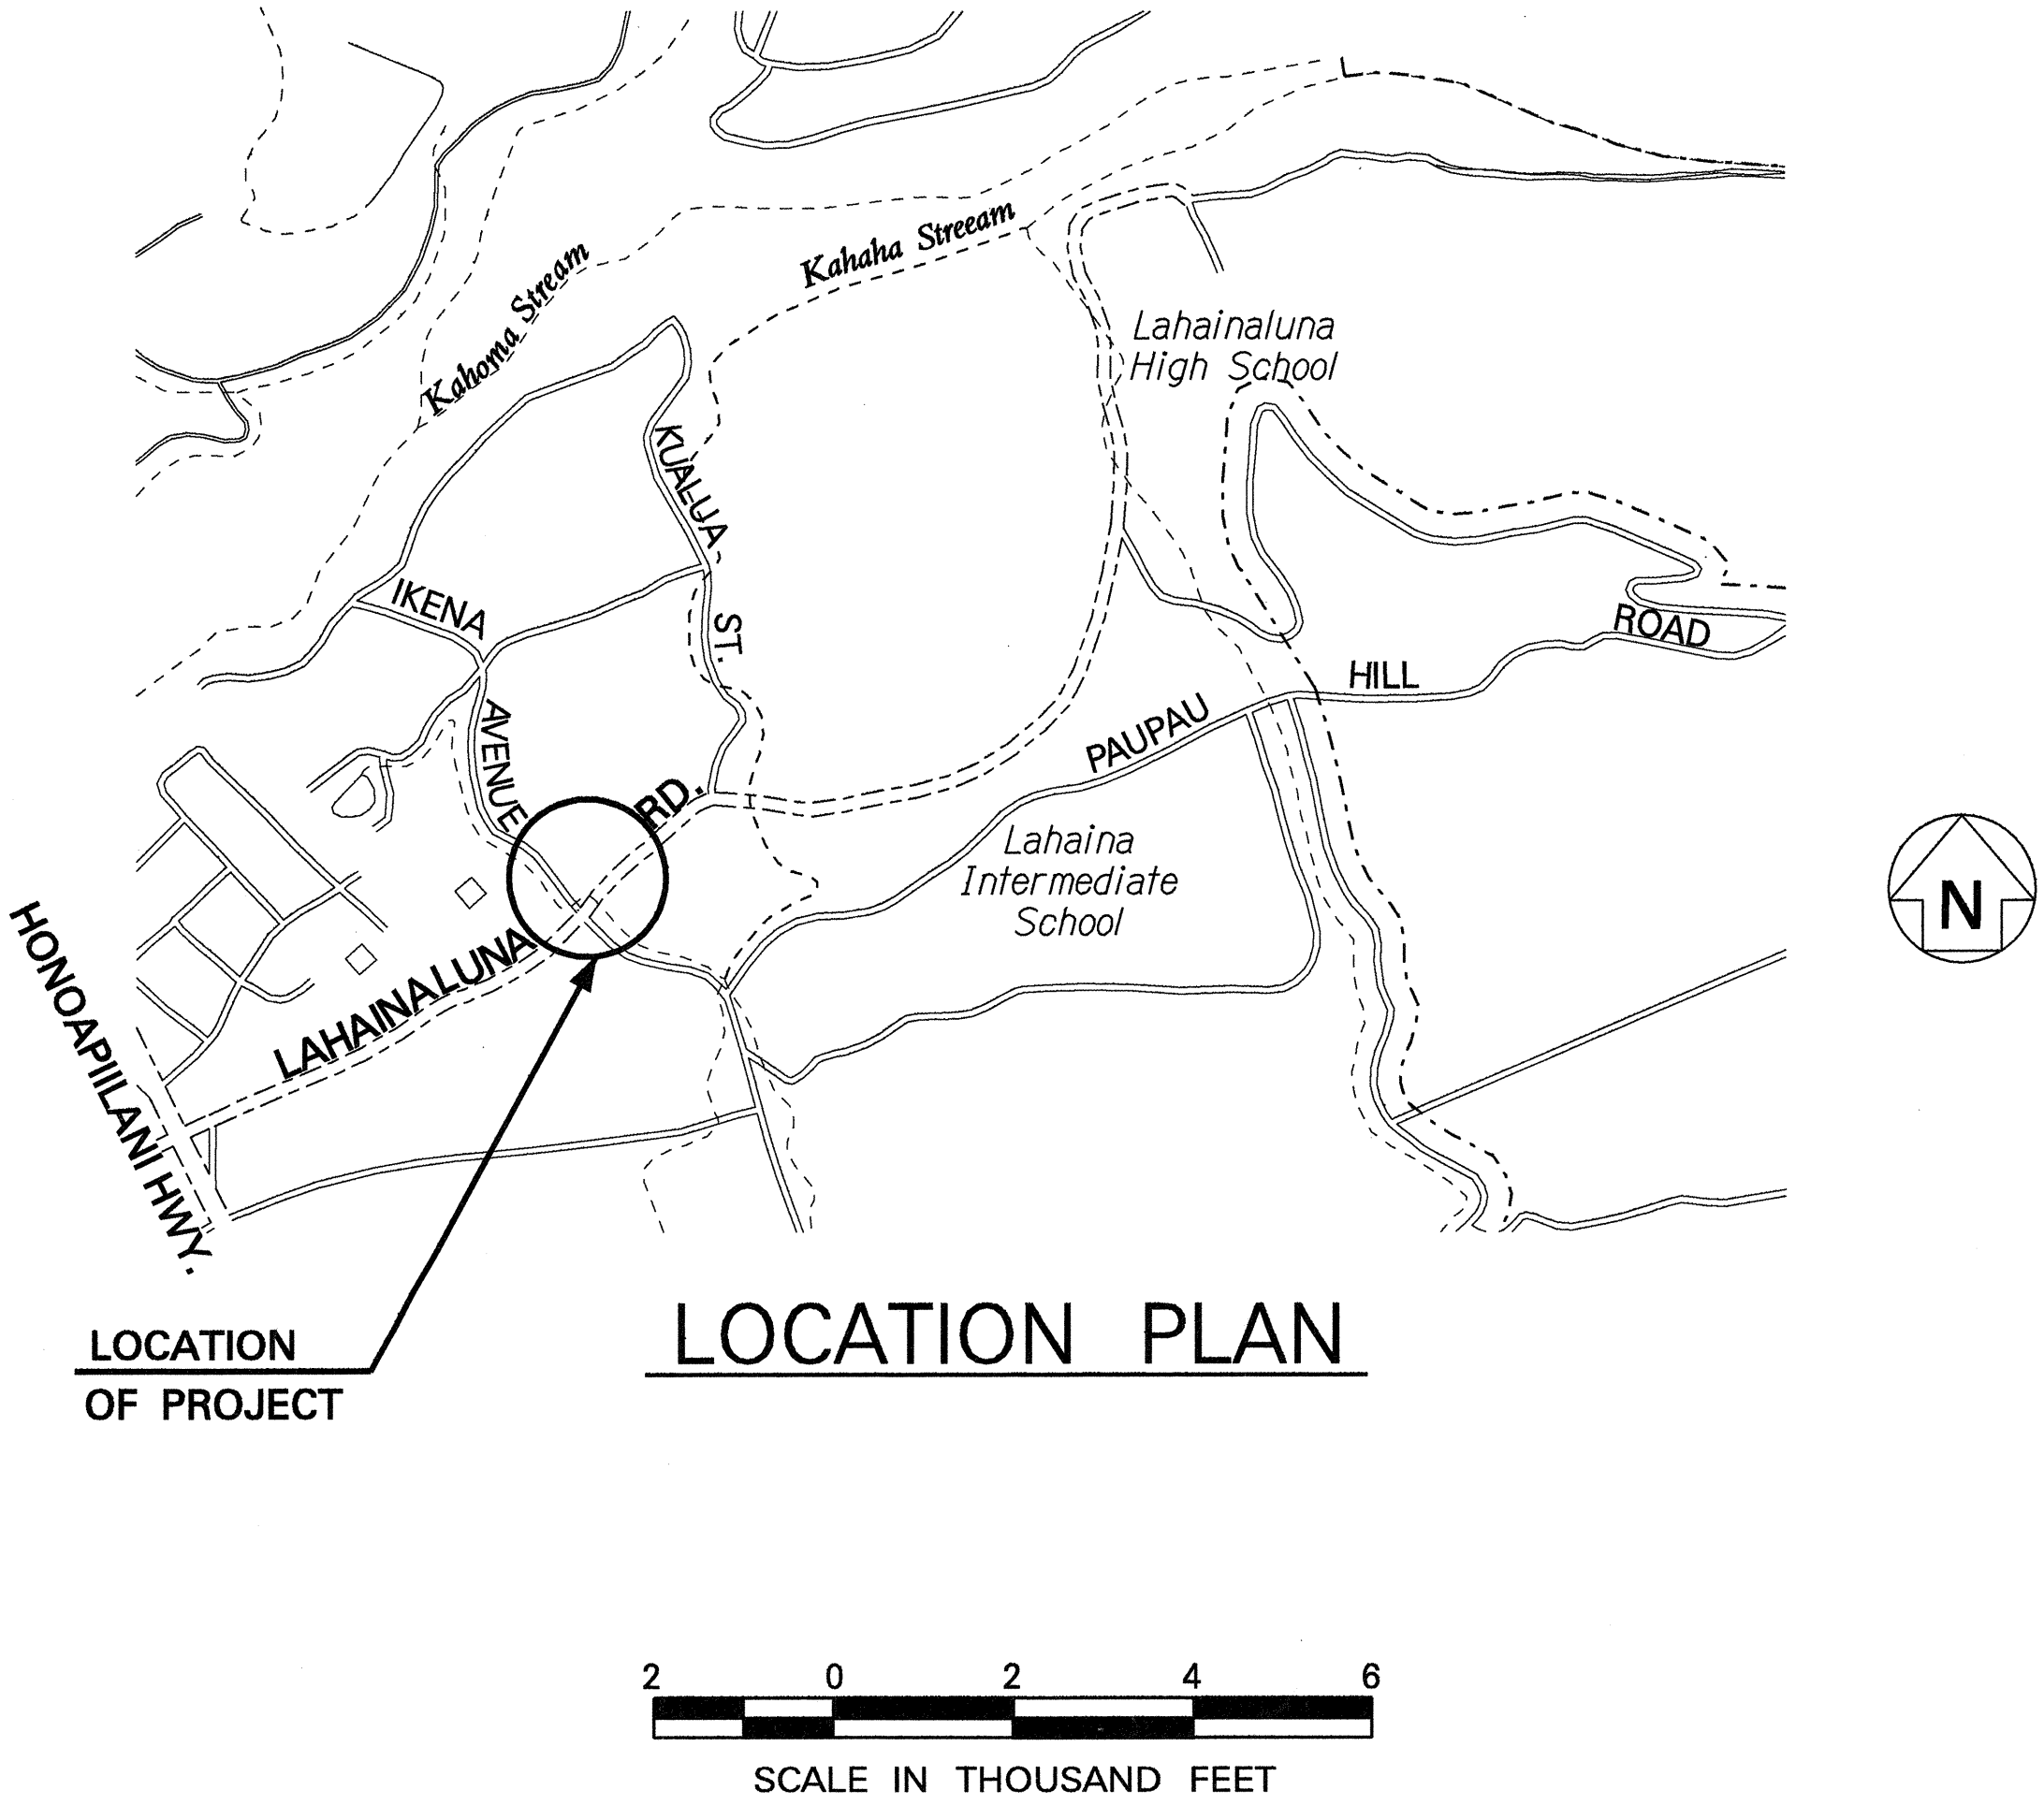

| FED. ROAD DIST. NO. | STATE | FED. AID PROJ. NO. | FISCAL YEAR | SHEET NO. | TOTAL SHEETS |
|---------------------|-------|--------------------|-------------|-----------|--------------|
| HAWAII | HAW. | STP-030-1(22) | 2001 | 1 | 8 |

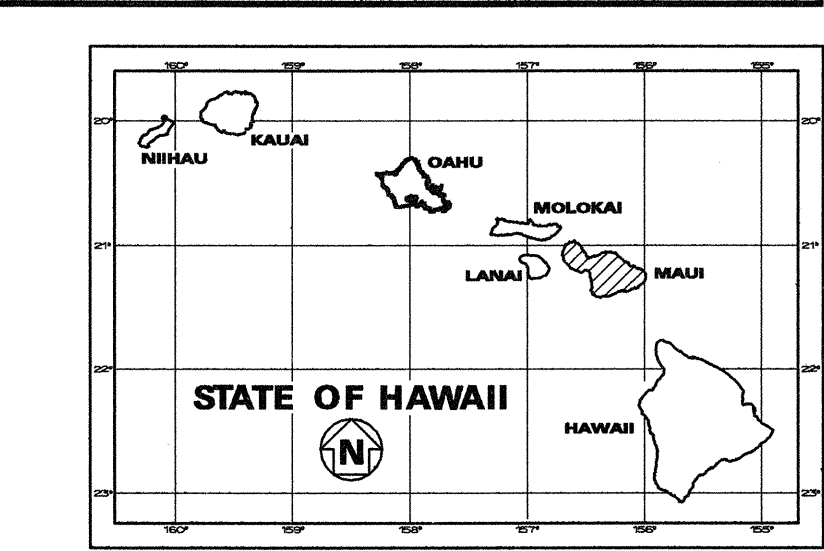

----- FEDERAL AID PROJECTS PREVIOUSLY CONSTRUCTED OR UNDER CONSTRUCTION

CHANGES MADE DURING CONSTRUCTION HAVE BEEN INCORPORATED ON THESE PLANS EXCEPT CHANGES IN THE ORIGINAL THEORETICAL QUANTITIES. FOR ACTUAL QUANTITIES, REFER TO PROJECT LEDGER AND/OR COMPUTATION BOOK.

L. Pato 11/19/02
RESIDENT ENGINEER DATE

| DEPARTMENT OF TRANSPORTATION STATE OF HAWAII | |
|---|---------|
| APPROVED: | |
| <i>Paul Milani</i> | 3-12-01 |
| for DIR. OF TRANSPORTATION | DATE |

DESIGNED BY
HWY-DD
K. TATSUGUCHI
P. S. & E. BY
692-7578
PHONE
DEC. 2000
DATE