	INDEX TO DRAWINGS
SHEET NO.	DESCRIPTION
1	TITLE SHEET
2	STANDARD PLANS SUMMARY
3	GENERAL NOTES AND LEGEND
4 – 5	WATER POLLUTION & EROSION
	CONTROL NOTES
6 – 8	DRAINAGE PLAN & DETAILS

STATE OF HAWAII

DEPARTMENT OF TRANSPORTATION


HIGHWAYS DIVISION HONOLULU, HAWAII

PLANS FOR

HONOAPIILANI HIGHWAY

REPAIRS TO KAHANA KAI BRIDGE SYSTEM BED PROJECT NO. 30A-01-00

DISTRICT OF LAHAINA
ISLAND OF MAUI

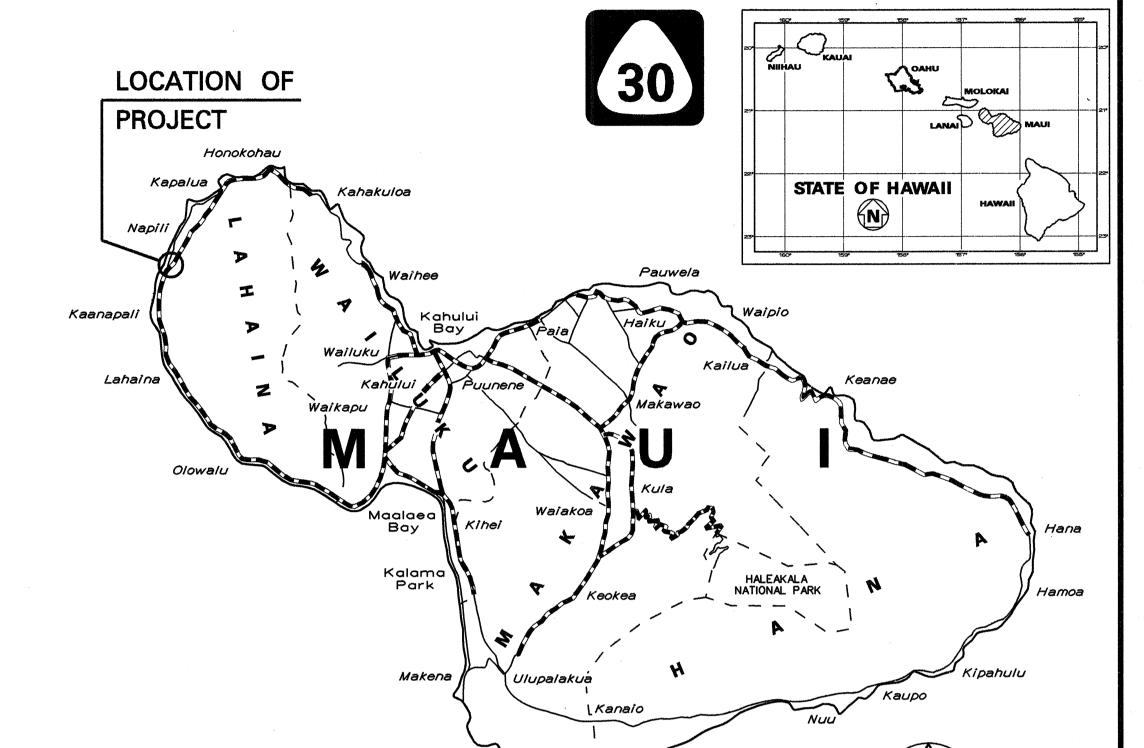

FED. ROAD DIST. NO.

PROJ. NO.

30A-01-00

2001

FEDERAL AID PROJECTS PREVIOUSLY CONSTRUCTED OR UNDER CONSTRUCTION

MILE POST 28.16

Ocean PROJECT LOCATION KAHANA KAI **BRIDGE** Honoapiilani **NAPILI** Lower Puamana Pl. Kahana HIGHWAY Napili Napilih Fire Station Napili Plaza KAHANA Kohi St. SCALE IN HUNDRED FEET

CHANGES MADE DURING CONSTRUCTION HAVE BEEN INCORPORATED ON THESE PLANS EXCEPT CHANGES IN THE ORIGINAL THEORETICAL QUANTITIES. FOR ACTUAL QUANTITIES, REFER TO PROJECT LEDGER AND/OR COMPUTATION BOOK.



DEPARTMENT OF TRANSPORTATION
STATE OF HAWAII

APPROVED:

Water Millian 3-5-01

OF TRANSPORTATION DATE