

LEGEND FOR AS-BUILT POSTINGS

~~~~~ Squiggly line for as-built deletion

~~###.##~~ Double line for as-built deletion

Roadway Text for as-built posting

**LEGEND**

———— Limit of Grading

——— Existing Ground Contour

——— Finished Grade Contour

• 150.00 Finished Grade Elevation at Point

• 150.00 Finished Grade at Top of Curb

• 149.50 Finished Grade at Bot. of Curb


| FED. ROAD DIST. NO. | STATE | FED. AID PROJ. NO. | FISCAL YEAR | SHEET NO. | TOTAL SHEETS |
|---------------------|-------|--------------------|-------------|-----------|--------------|
| HAWAII              | HAW.  | STP-030-1(33)      | 2000        | 6         | 29           |

**LEGEND**

~~~~~ New Swale or Ditch


===== New Paved Area

===== New Concrete Surface

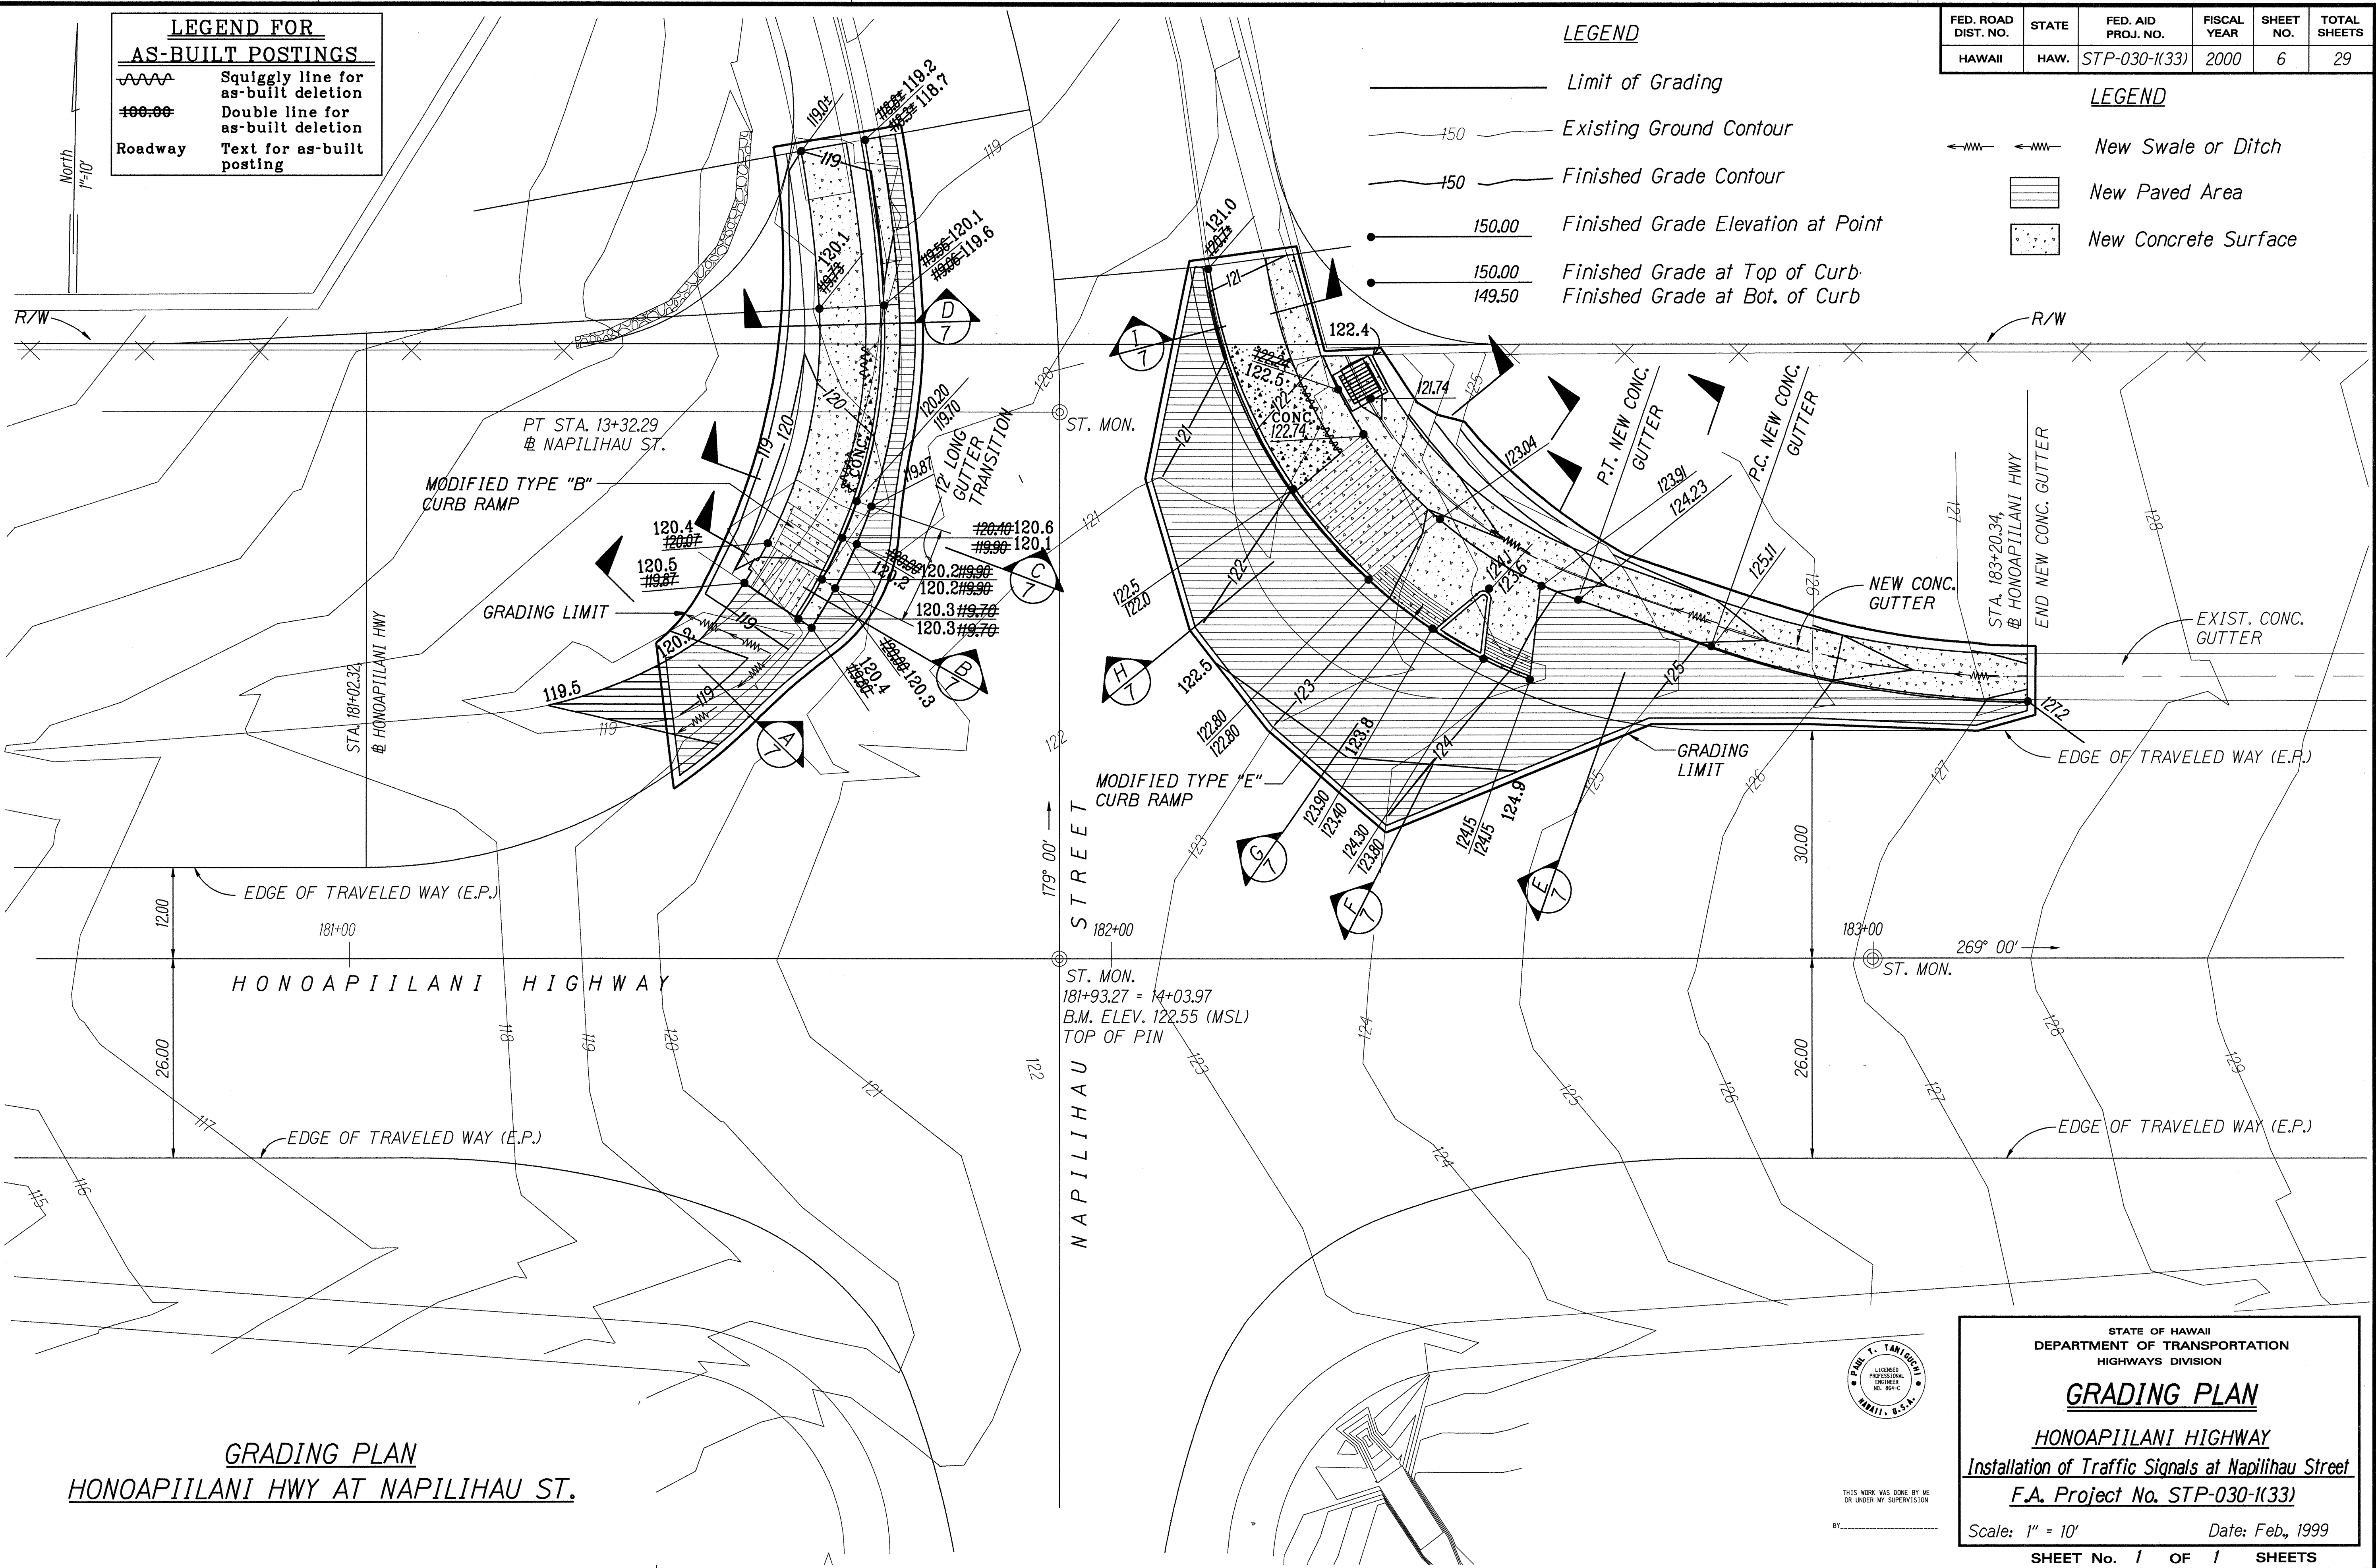

| | | |
|---------------|-------------------|-------|
| ORIGINAL PLAN | SURVEY PLOTTED BY | DATE |
| NOTE BOOK | DRAWN BY | 02/99 |
| | DESIGNED BY | 02/99 |
| | QUANTITIES BY | |
| | CHECKED BY | |

GRADING PLAN
HONOAPIILANI HWY AT NAPILIHAW ST.

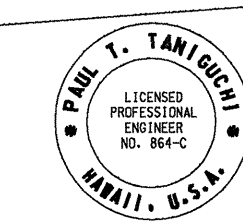

STATE OF HAWAII
DEPARTMENT OF TRANSPORTATION
HIGHWAYS DIVISION

GRADING PLAN

HONOAPIILANI HIGHWAY

Installation of Traffic Signals at Napili Hau Street


F.A. Project No. STP-030-1(33)

Scale: 1" = 10' Date: Feb., 1999


SHEET No. 1 OF 1 SHEETS

AS-BUILT


| FED. ROAD DIST. NO. | STATE | FED. AID PROJ. NO. | FISCAL YEAR | SHEET NO. | TOTAL SHEETS |
|---------------------|-------|--------------------|-------------|-----------|--------------|
| HAWAII | HAW. | STP-030-1(33) | 2000 | 7 | 29 |

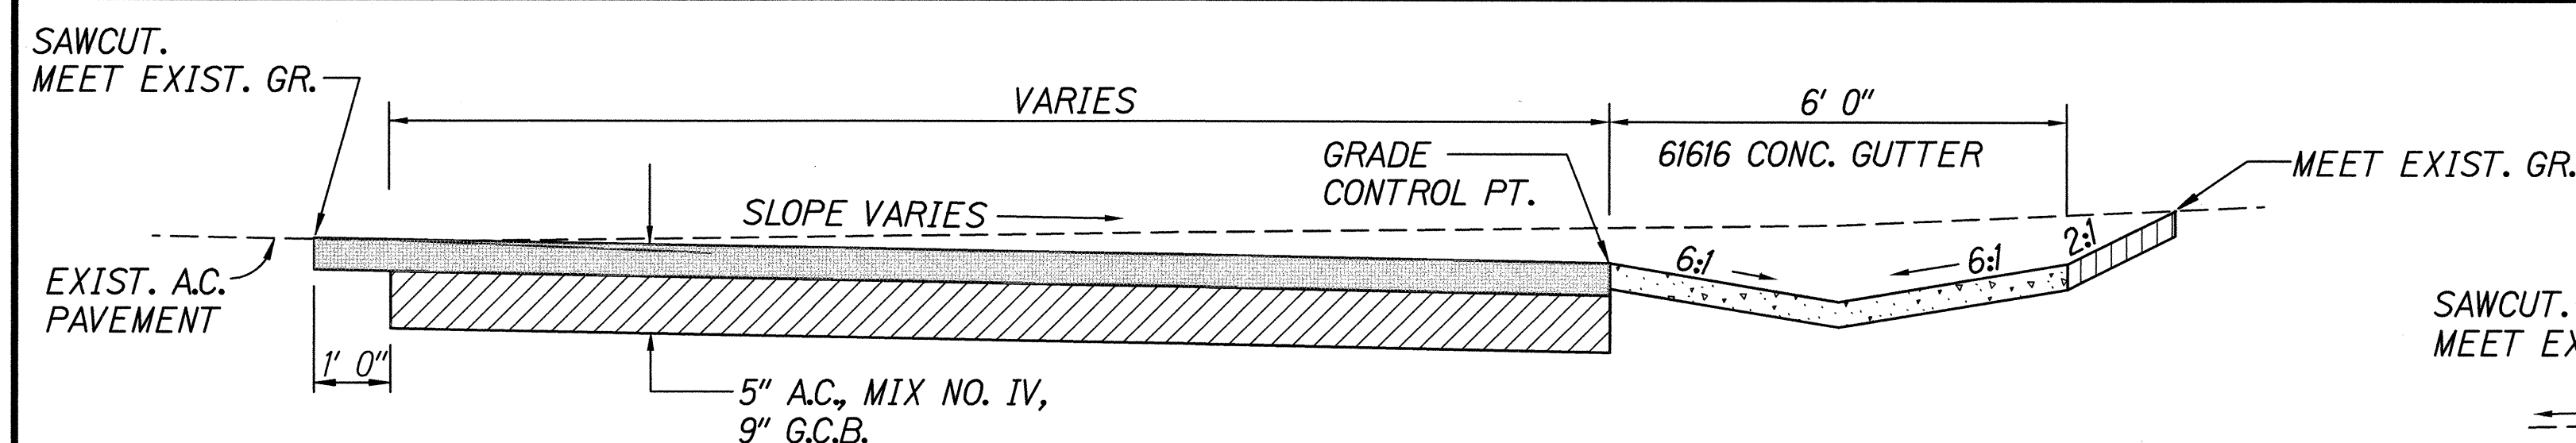


SECTION E
SCALE: 1/2" = 1' 0"

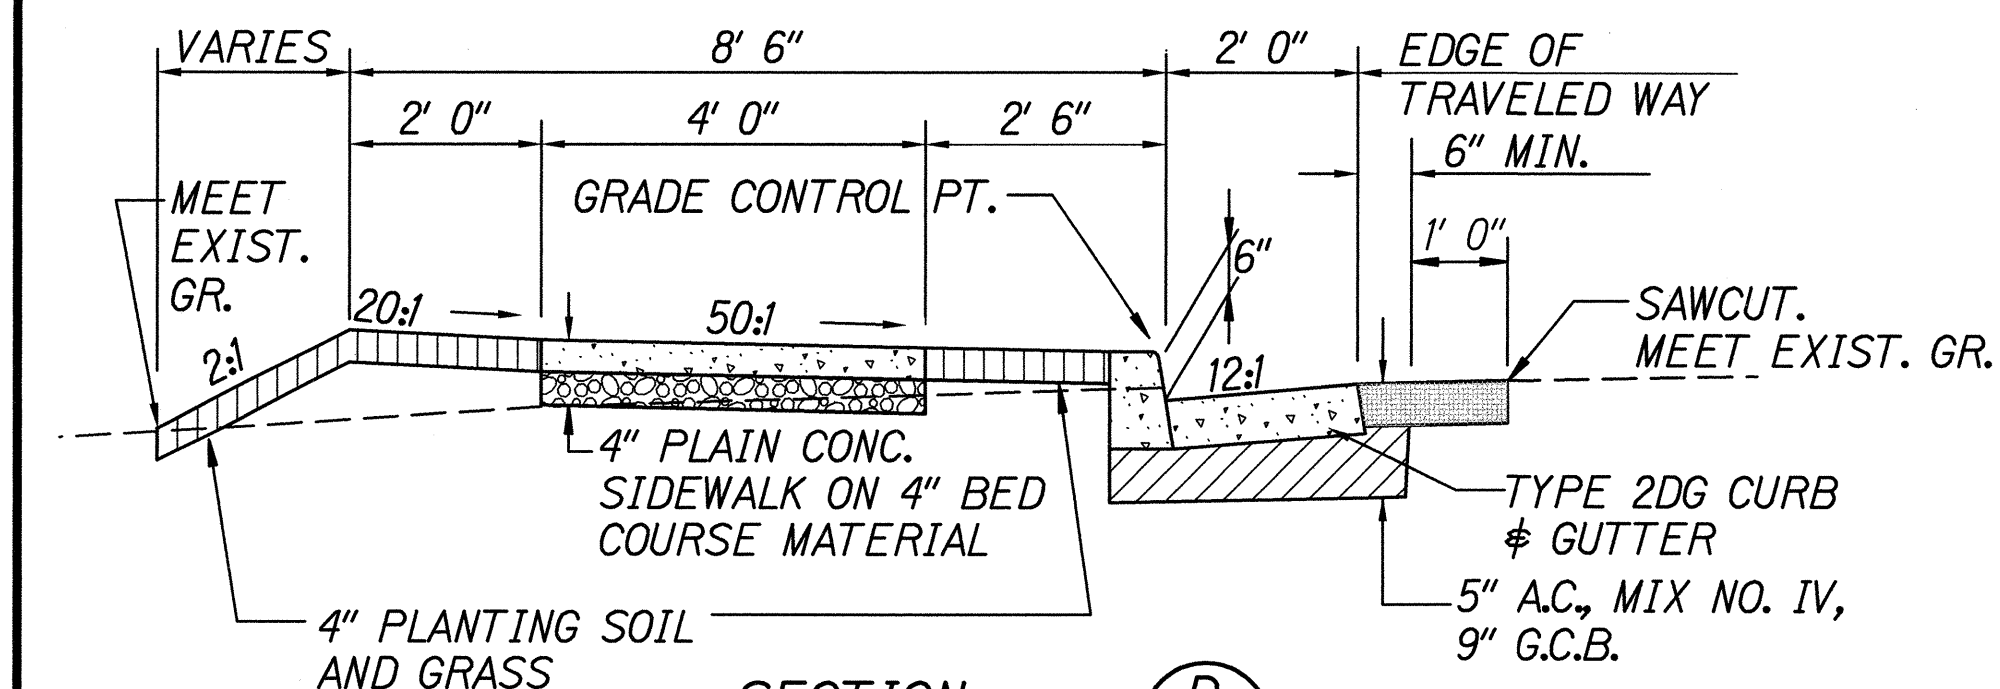


SECTION D
SCALE: 1/2" = 1' 0"

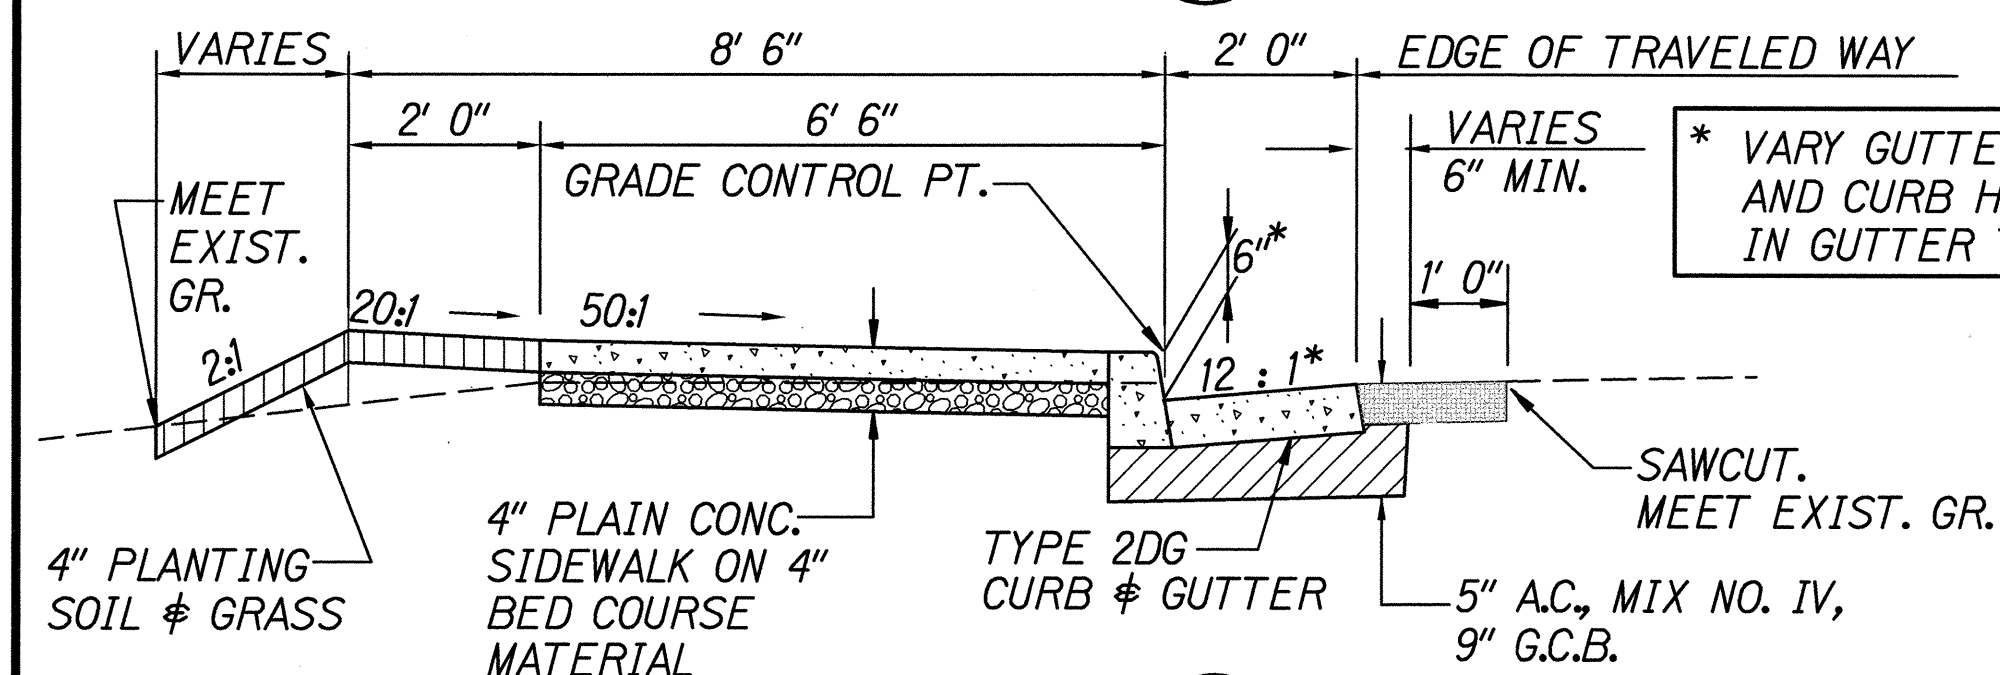


SECTION C
SCALE: 1/2" = 1' 0"

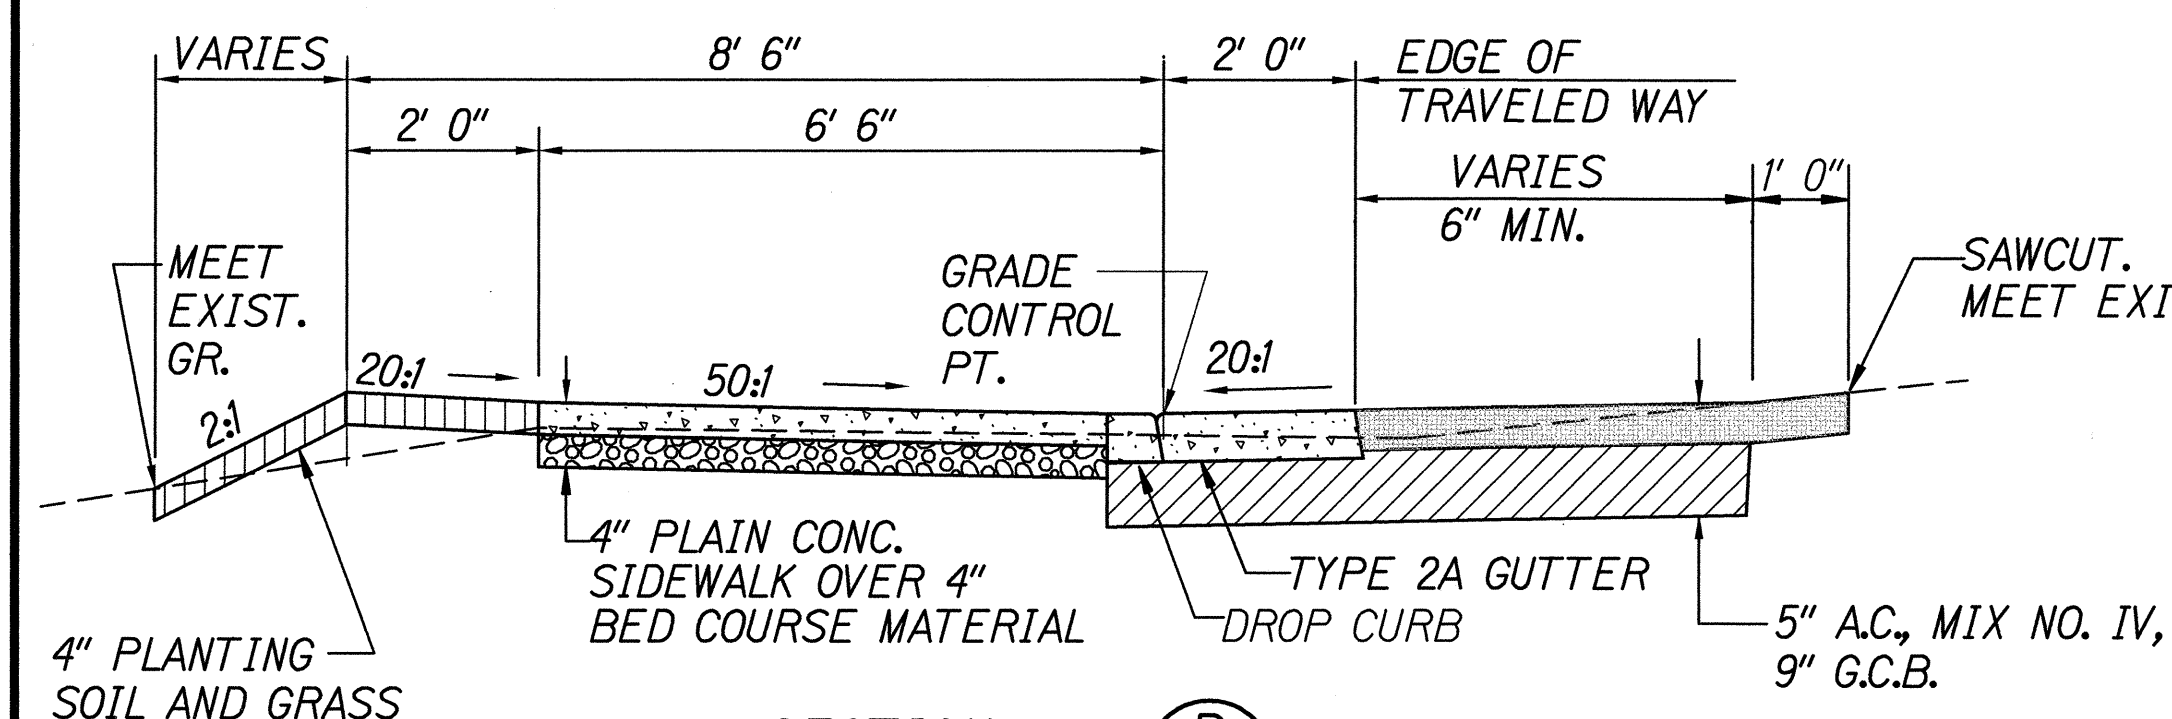


SECTION B
SCALE: 1/2" = 1' 0"

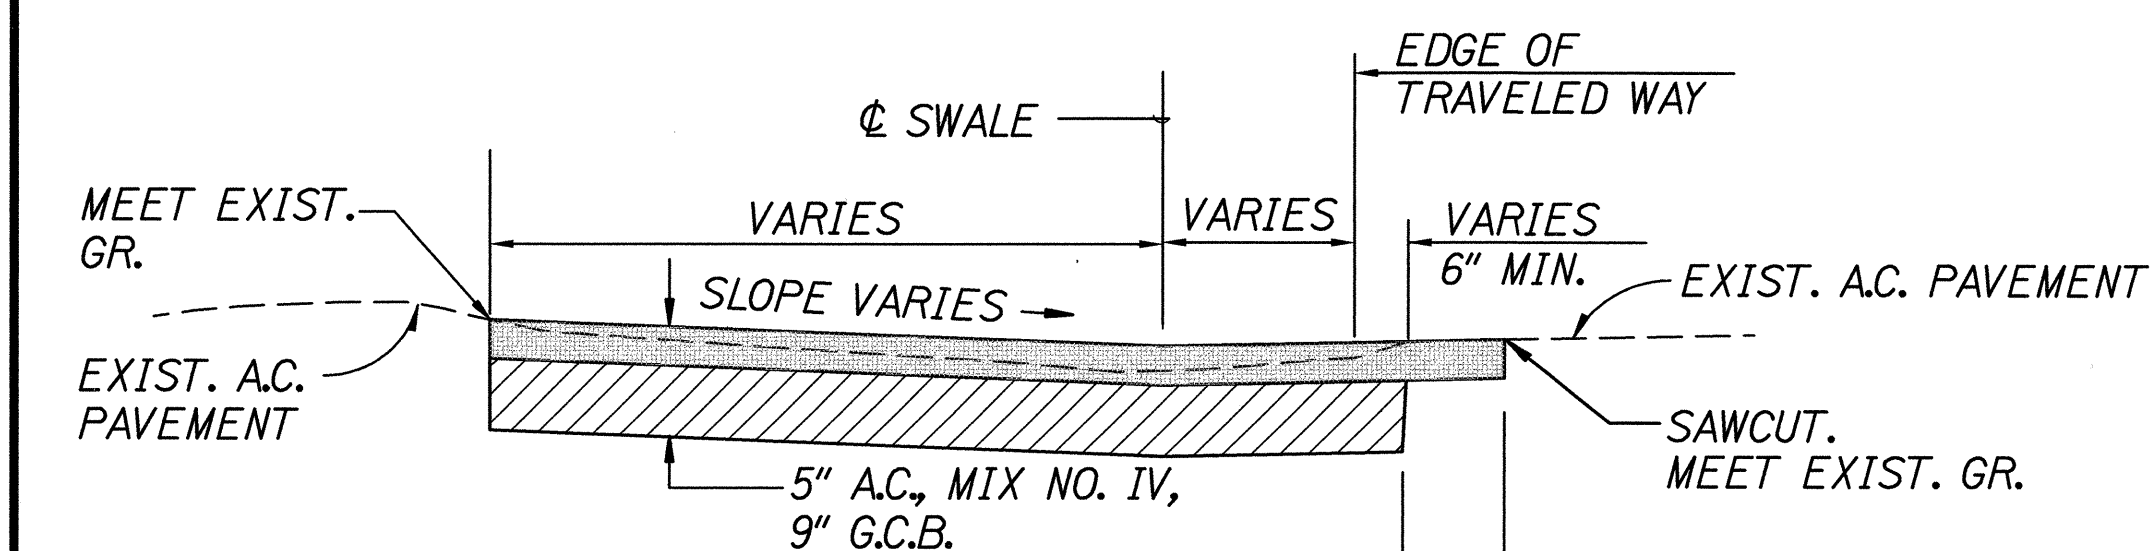


SECTION A
SCALE: 1/2" = 1' 0"

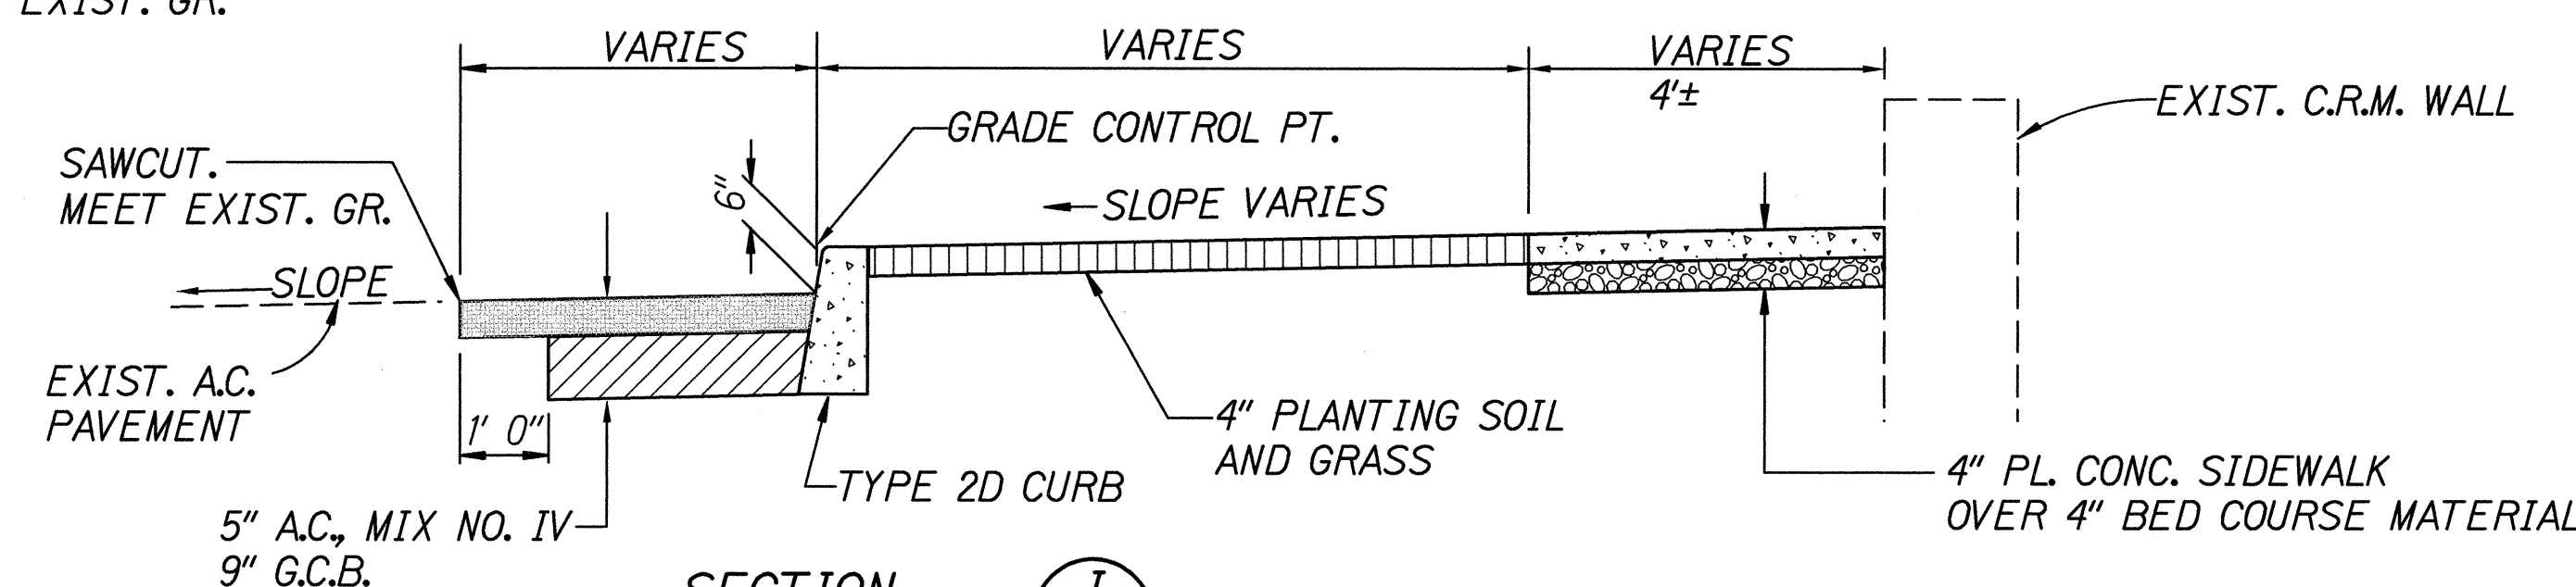


SECTION I
SCALE: 1/2" = 1' 0"

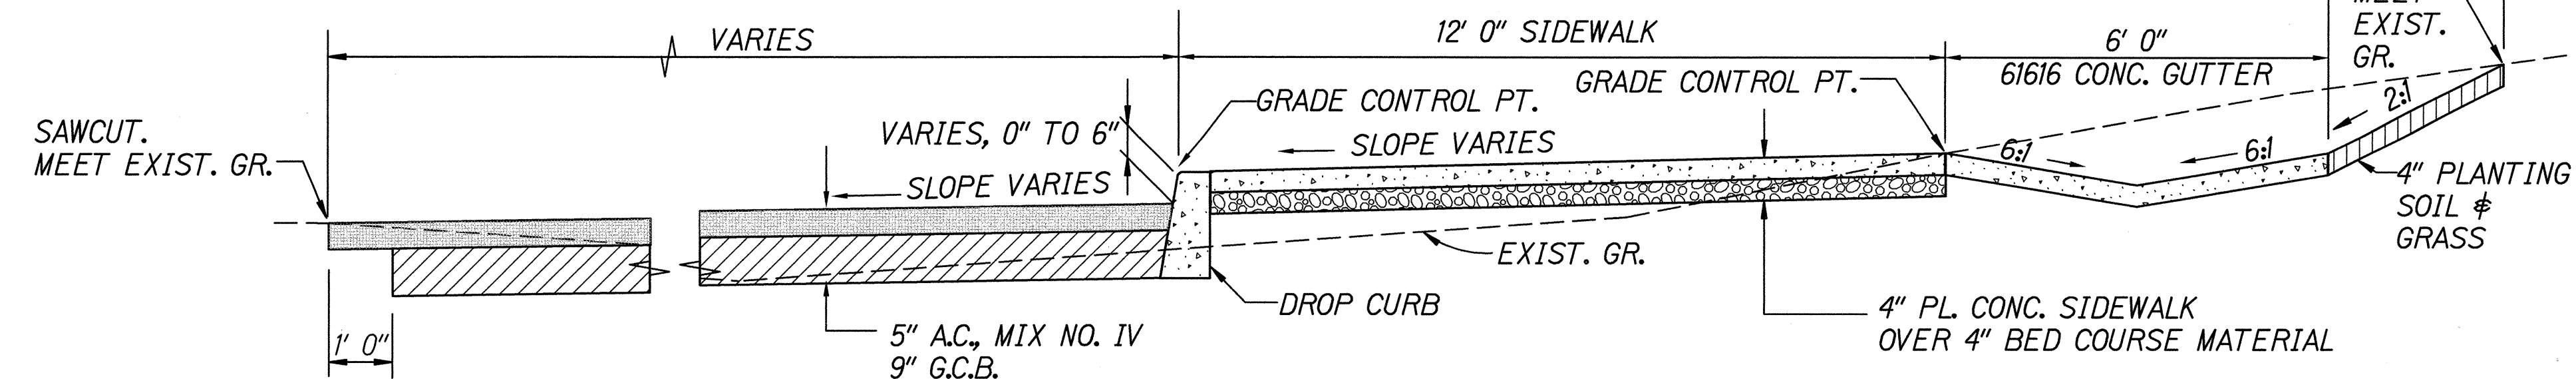

SECTION H
SCALE: 1/2" = 1' 0"

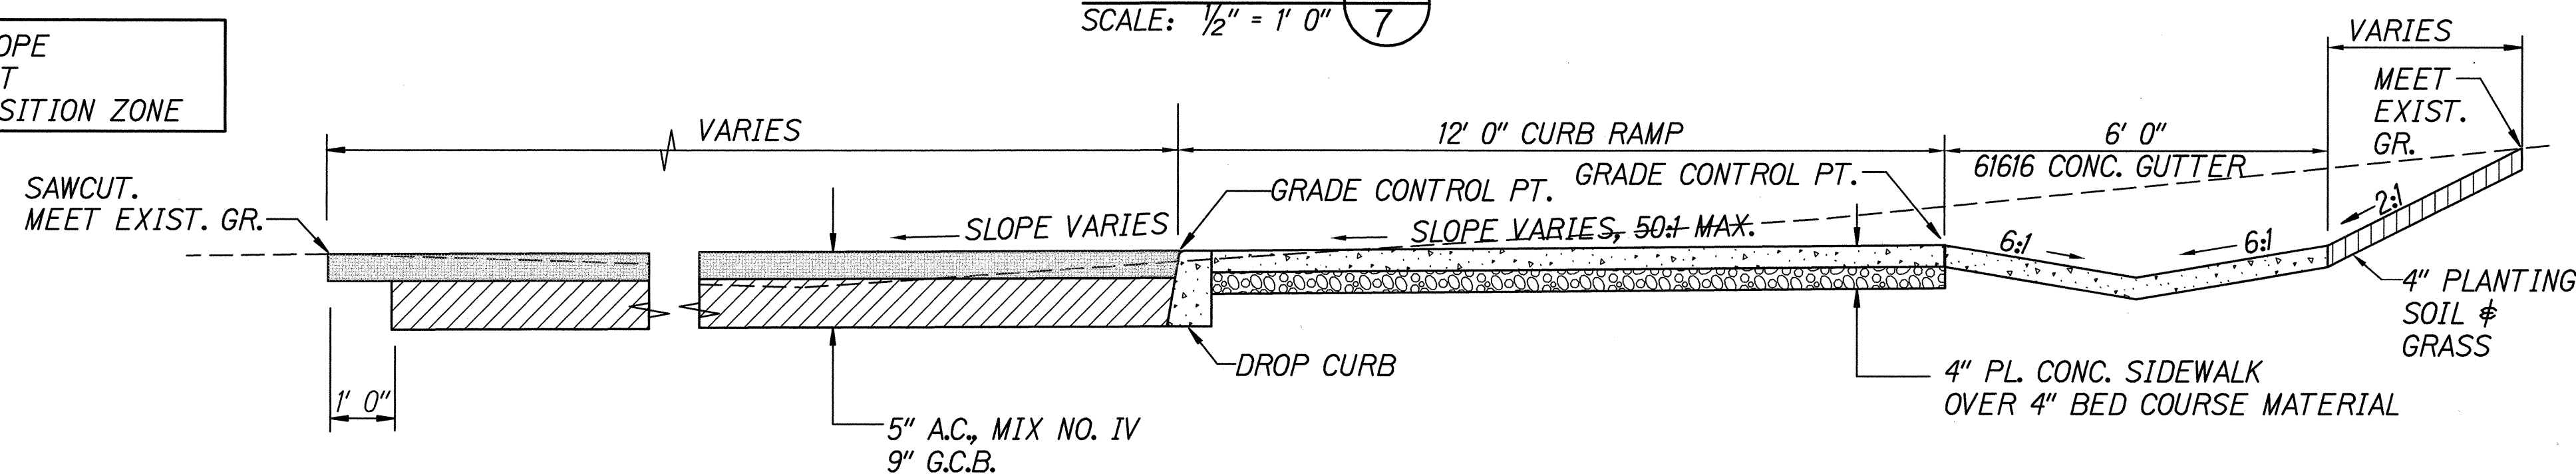

SECTION G
SCALE: 1/2" = 1' 0"

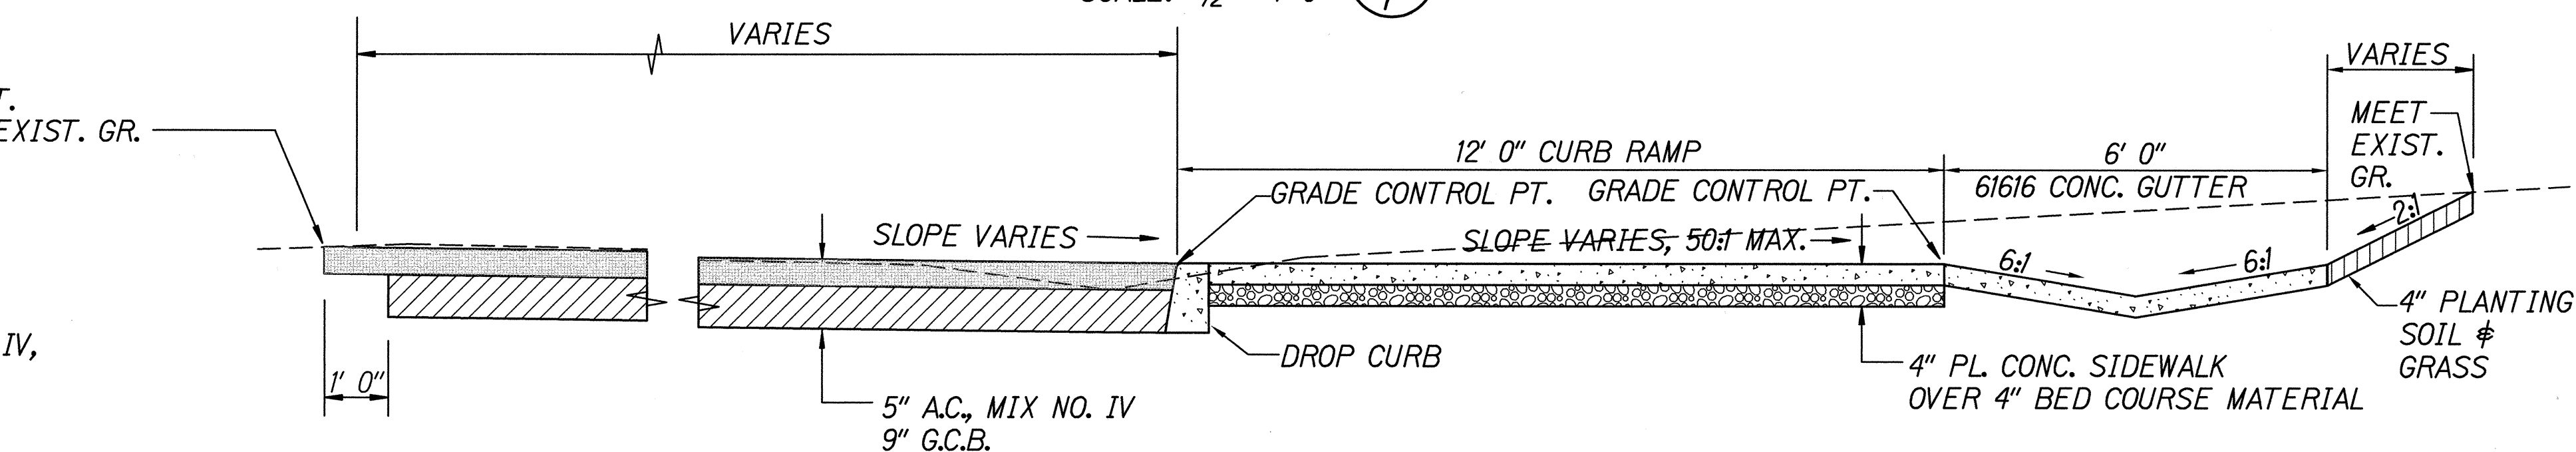

SECTION F
SCALE: 1/2" = 1' 0"

| | |
|---------------|-------------------------|
| DATE | 10/29 |
| DESIGNED BY | Paul T. Taniguchi, Inc. |
| CHECKED BY | Paul T. Taniguchi, Inc. |
| NOTED BY | |
| ORIGINAL PLAN | |



THIS WORK WAS DONE BY ME OR UNDER MY SUPERVISION
BY: Paul T. Taniguchi

STATE OF HAWAII
DEPARTMENT OF TRANSPORTATION
HIGHWAYS DIVISION

CROSS SECTIONS

HONOAPIILANI HIGHWAY
Installation of Traffic Signals at Napiliha Street
F. A. Project No. STP-030-1(33)

Scale: 1/2" = 1' 0" Date: Feb., 1999

SHEET No. 1 OF 1 SHEETS