


FED. ROAD DIST. NO.	STATE	FED. AID PROJ. NO.	FISCAL YEAR	SHEET NO.	TOTAL SHEETS
HAWAII	HAW.	STP-030-1(33)	2000	5	29



SURVEY PLOTTED BY	DATE
DRAWN BY	
TRACED BY	
CHECKED BY	
QUANTITIES BY	
NOTED BY	
ORIGINAL PLAN	
NOTE BOOK	
NO.	

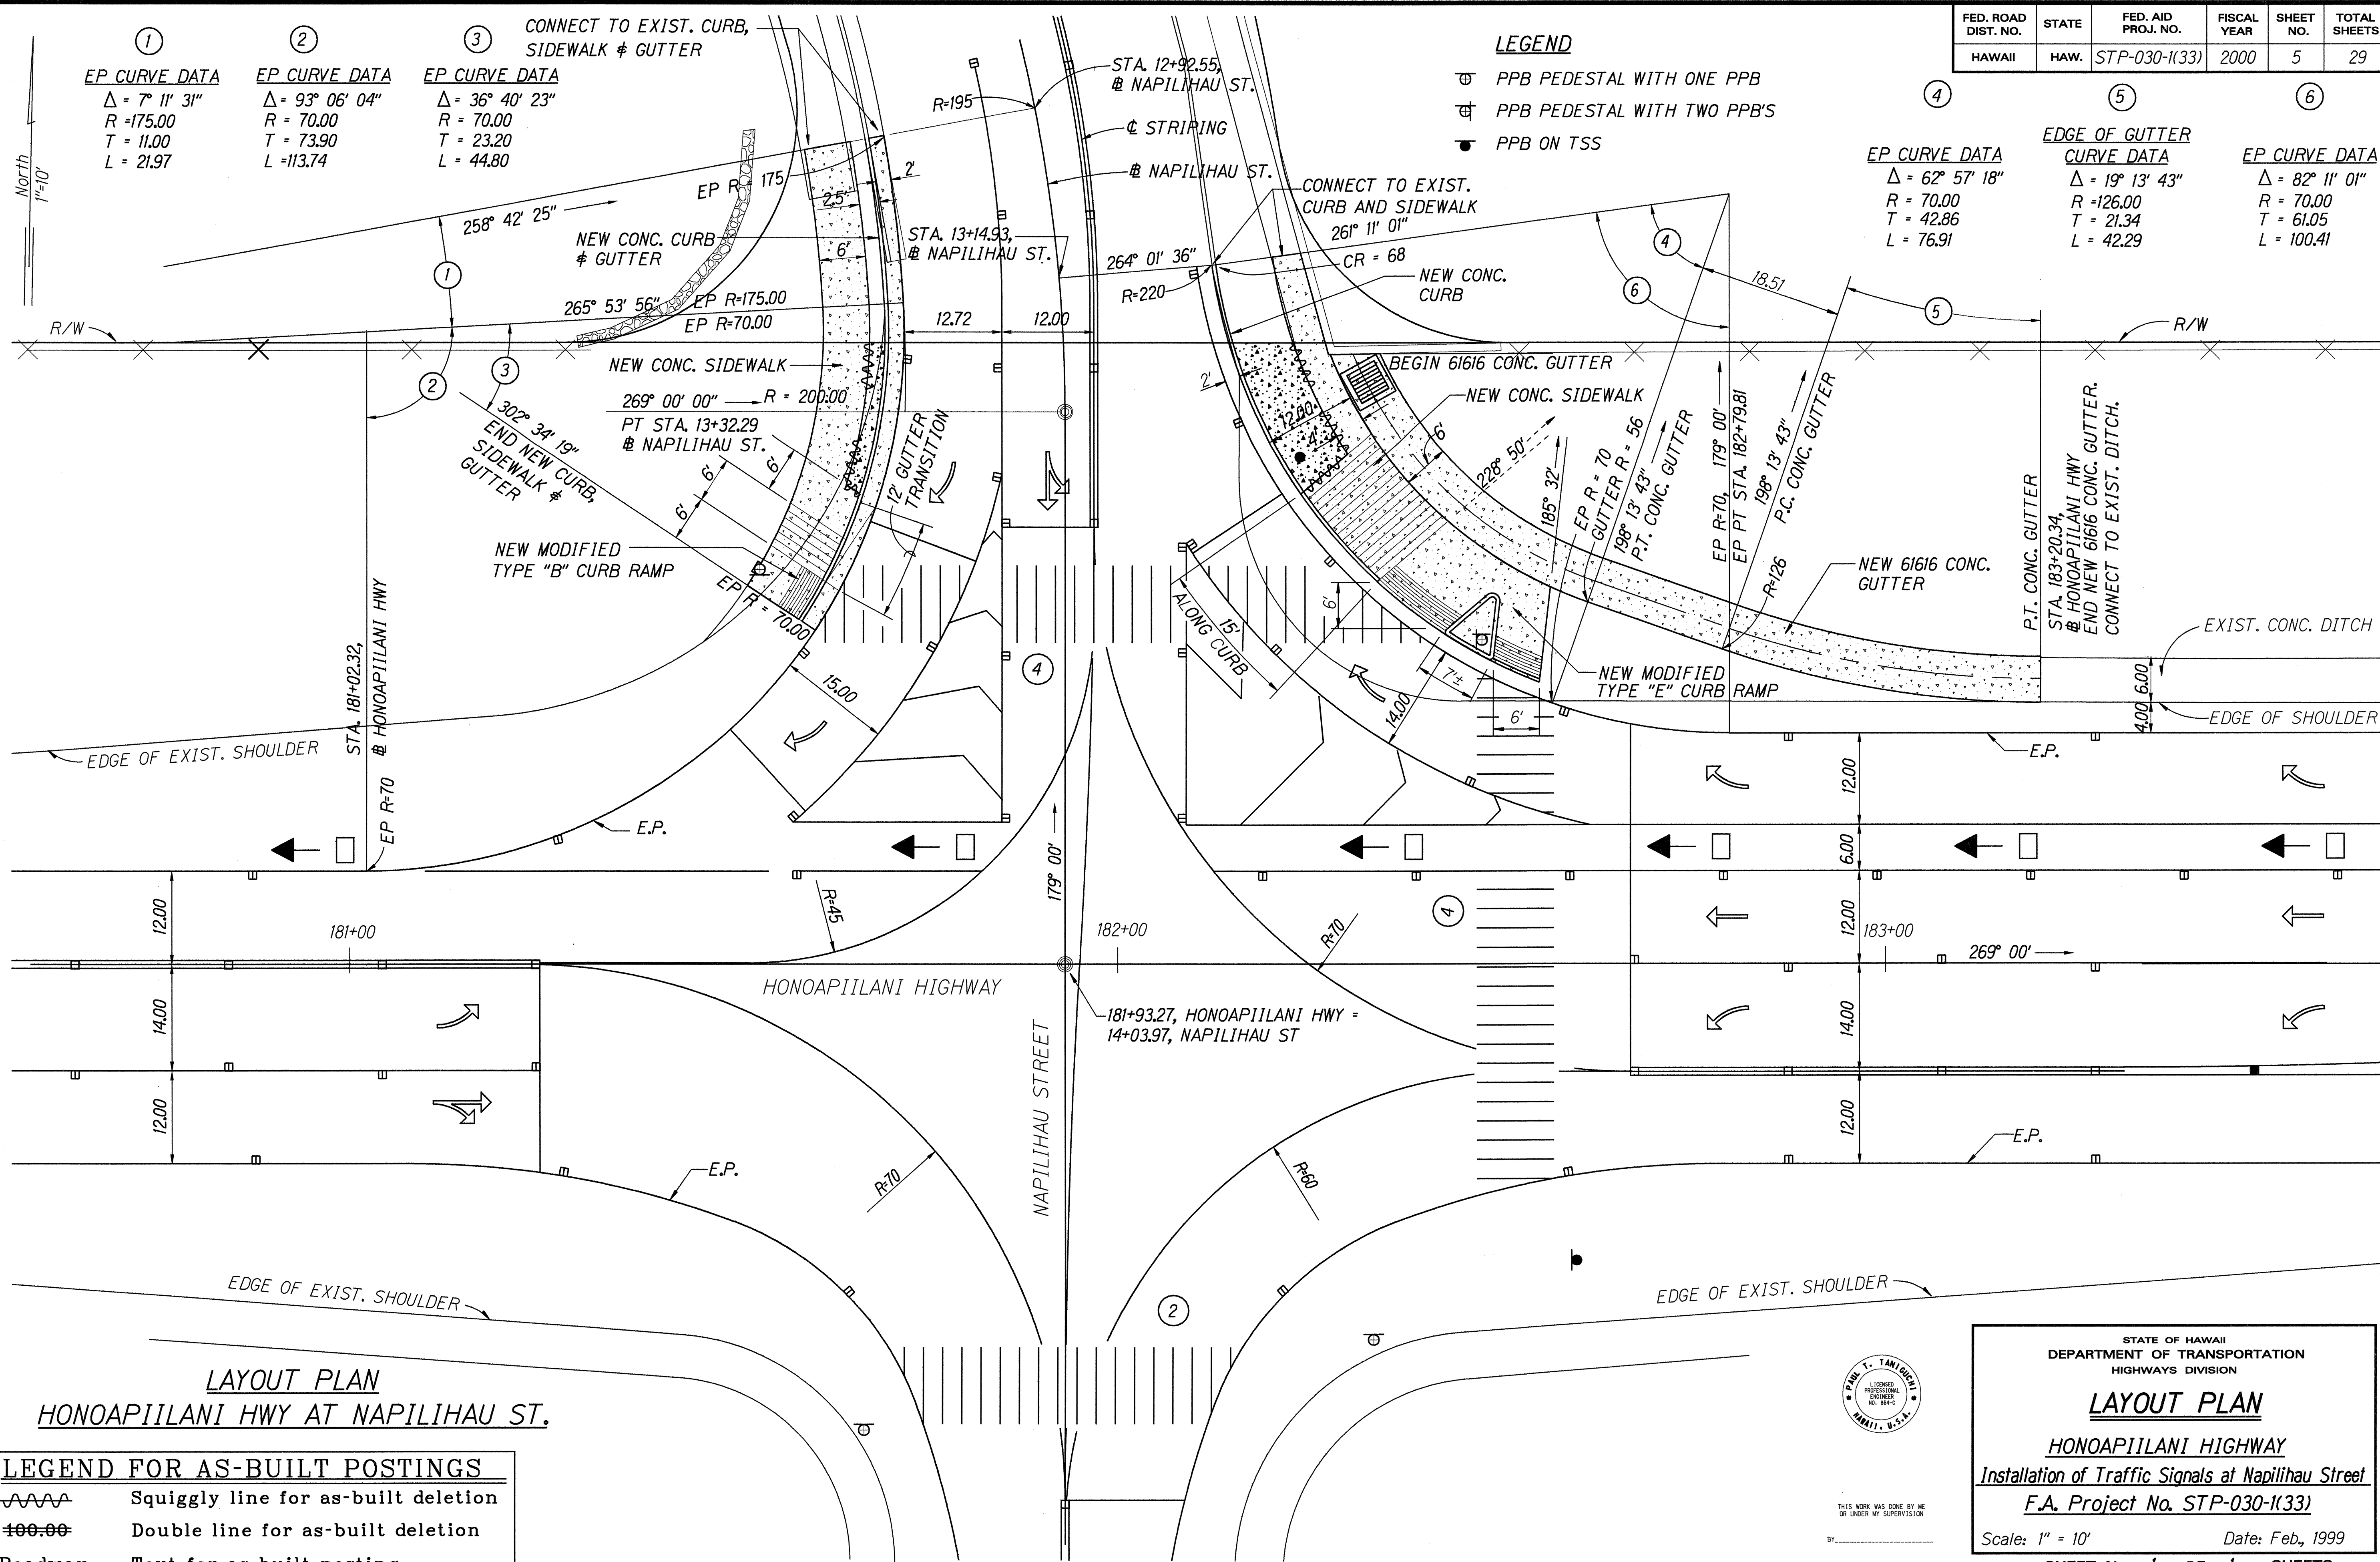

STATE OF HAWAII
DEPARTMENT OF TRANSPORTATION
HIGHWAYS DIVISION

LAYOUT PLAN
HONOAPIILANI HIGHWAY
Installation of Traffic Signals at Napili Hau Street
F.A. Project No. STP-030-1(33)

Scale: 1" = 10' Date: Feb., 1999

SHEET No. 1 OF 1 SHEETS

AS-BUILT