de anno anticologica de la companya	
	INDEX TO DRAWINGS
SHEET NO.	DESCRIPTION
1	TITLE SHEET
2	STANDARD PLANS SUMMARY
3	GENERAL NOTES & LEGEND
4	TYPICAL SECTIONS & DETAILS
5 - 6	WATER POLLUTION & EROSION CONTROL NOTES
7 – 15	GUARDRAIL DETAILS
16 – 27	ROADWAY PLANS
28	DRAINAGE DETAILS
29	PAVEMENT MARKING LEGEND, DETAILS, NOTES & SIGN PANEL LAYOUTS
30 – 41	SIGNING & PAVEMENT MARKING PLANS
42	MISCELLANEOUS SUMMARIES

STATE OF HAWAII

DEPARTMENT OF TRANSPORTATION

HIGHWAYS DIVISION HONOLULU, HAWAII


"AS-BUILT"

PLANS FOR

HONOAPIILANI HIGHWAY RESURFACING

HONOKAHUA TO HONOKOHAU PROJECT NO. 30A-01-03M

DISTRICTS OF LAHAINA AND WAILUKU ISLAND OF MAUI

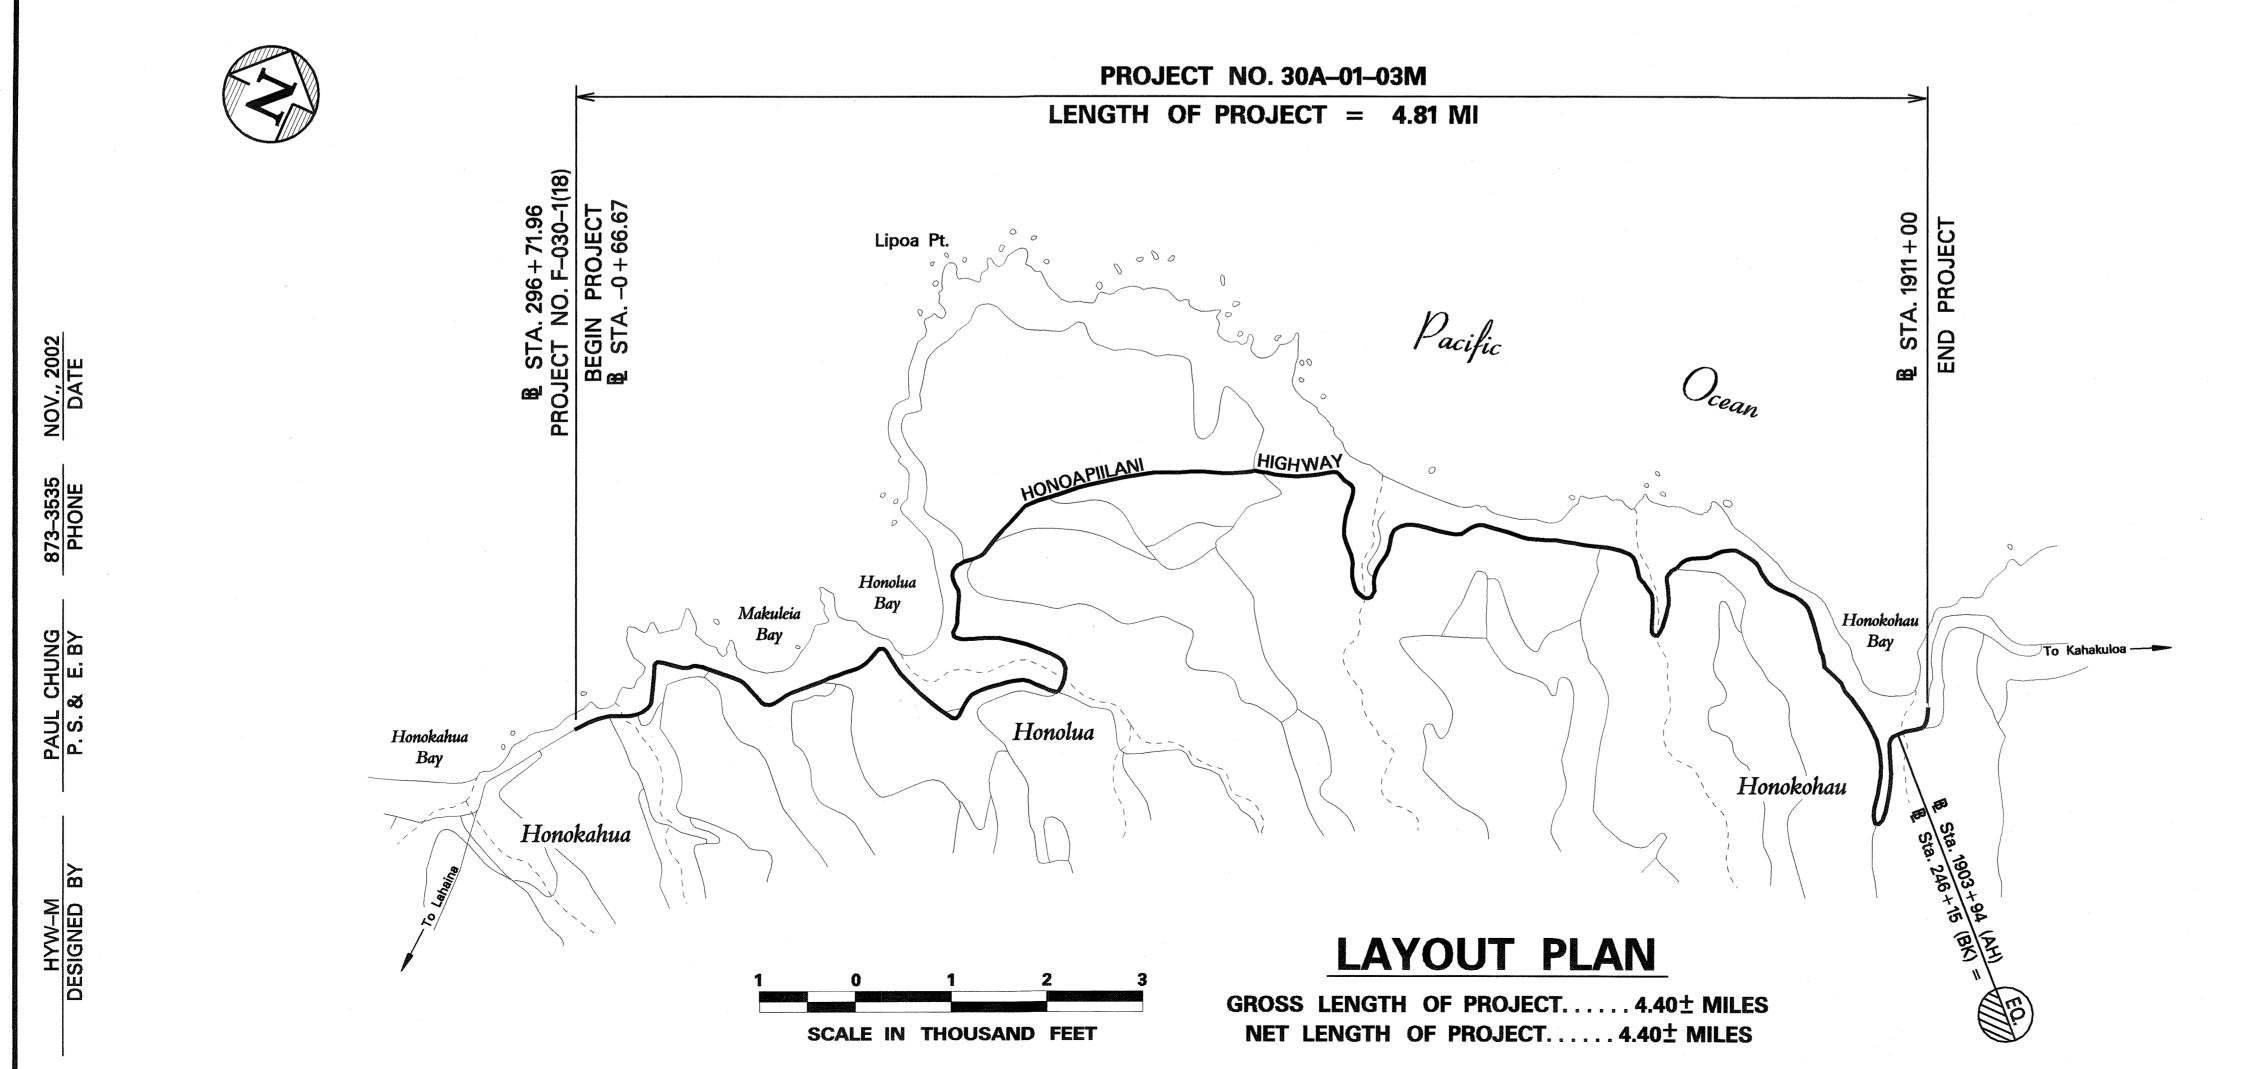

HAW. 30A-01-03M 2003 PROJECT LOCATION Project No. 30A-01-03M (30)STATE OF HAWAII Kaanapali SCALE IN MILES

FED. ROAD DIST. NO.

FEDERAL AID PROJECTS PREVIOUSLY CONSTRUCTED OR UNDER CONSTRUCTION

ROUTE 30 MILE POST 31.19 TO MILE POST 36.00

DEPARTMENT OF TRANSPORTATION STATE OF HAWAII

FOR DIR. OF TRANSPORTATION

5/15/03

DATE