

INDEX TO BRIDGE DRAWINGS

FED. ROAD DIST. NO.	STATE	FED. AID PROJ. NO.	FISCAL YEAR	SHEET NO.	TOTAL SHEETS
HAWAII	HAW.	NH-030-1(35)R	2009	133	286

SHEET NO.	DESCRIPTION
SG0.1	INDEX TO BRIDGE DRAWINGS
SG0.2	BRIDGE GENERAL NOTES
SG0.3	BRIDGE GENERAL NOTES
SG1.1	LAHAINALUNA ROAD GRADE SEPARATION STRUCTURE – LAYOUT PLAN
SG1.2	LAHAINALUNA ROAD GRADE SEPARATION STRUCTURE – FOUNDATION PLAN
SG1.3	LAHAINALUNA ROAD GRADE SEPARATION STRUCTURE – DECK FRAMING AND REINFORCING PLAN
SG1.4	LAHAINALUNA ROAD GRADE SEPARATION STRUCTURE – ELEVATION
SG2.1	TYPICAL NORMAL DECK SECTION & SIDEWALK
SG2.2	DECK SECTIONS
SG2.3	SEWERLINE SUPPORT DETAILS
SG2.4	CURB RAMP SECTIONS
SG2.5	4 INCH DIA. DUCT SUPPORT DETAILS
SG3.1	BEAM POST-TENSIONING
SG3.2	BEAM PLAN AND ELEVATION
SG3.3	BEAM ELEVATION
SG3.4	BEAM SECTIONS
SG3.5	BEAM SECTION
SG3.6	BEAM SECTIONS
SG3.7	BEAM SECTIONS
SG3.8	BEAM CLOSURE DETAILS
SG4.1	TYPICAL MIDSPAN DIAPHRAGM
SG5.1	ABUTMENT 1 ELEVATION
SG5.2	ABUTMENT 1 SECTIONS
SG5.3	ABUTMENT 1 SECTION AND DETAIL
SG5.4	ABUTMENT 1 SECTION AND DETAIL

[illegible]

THIS WORK WAS PREPARED BY ME
OR UNDER MY SUPERVISION.

David L. Foye
KSF, INC. APRIL 30, 2010
LIC. EXP. DATE

STATE OF HAWAII
DEPARTMENT OF TRANSPORTATION
HIGHWAYS DIVISION

INDEX TO BRIDGE DRAWINGS

HONOAPIILANI HIGHWAY REALIGNMENT, PHASE 1A
Future Keawe St Extension to Lahainaluna Rd

Part A: Off Ramp Mass Grading
Fed. Aid Proj. No. NH-030-1(35)R

Scale: None Date: April, 2009

SHEET No. SG0.1 OF 3 SHEETS

FED. ROAD DIST. NO.	STATE	FED. AID PROJ. NO.	FISCAL YEAR	SHEET NO.	TOTAL SHEETS
HAWAII	HAW.	NH-030-1(35)R	2009	134	379

BRIDGE GENERAL NOTES

1. General Specifications: Hawaii Department of Transportation, Standard Specifications for Road and Bridge Construction, 1994, together with Special Provisions prepared for this contract.
2. Design Specifications:
- (A) AASHTO 2004 LRFD Bridge Design Specifications (Third Edition) and its subsequent interim specifications with interim supplements and modifications by the Highways Division, Department of Transportation, State of Hawaii.
- (B) HDOT "Design Criteria for Bridges and Structures" dated February 14, 2005.

3. Loads:

- (A) Dead Load: An allowance of 25 PSF for future wearing surface of asphalt concrete has been provided for in the design.
- (B) Live Load: AASHTO HL-93 Truck Loading
- (C) Seismic Loads: Acceleration coefficient..... 0.24
Seismic Performance Zone..... 3
Importance Category..... Critical
Soil Profile..... Type I
- (D) Utility Load: An allowance of 150 PLF on each side of the bridge for Utility Loads has been provided for in the design.

4. Materials:

- (A) All concrete strengths for Lahainaluna Road Grade Separation Structure shall be as noted below:

Item No.	Structural Parts	Classes of Concrete	Specified Compressive Strength, f'c (28 Days)	Maximum W/C Ratio
(1)	Abutment walls (See Note 4.(B))	-	8,000 psi	.4
(2)	Beams (Girders), including closure joint and midspan diaphragm. (See Notes 4.(B) and 4.(H))	-	8,000 psi	.4
(3)	Deck, Sidewalk, End Beams, and Approach Slabs (See Note 4.(I))	-	7,000 psi	.38
(4)	Railings (See Notes 4.(B) and 4.(H))	-	4,000 psi	.45
(5)	End posts (See Note 4.(H))	-	4,000 psi	.45
(6)	Except as noted otherwise, all others	A	3,000 psi	0.55

- (B) A shrinkage reducing admixture (Tetraguard AS20 by BASF) shall be added to the concrete mix for Item No.'s (1), (2), (3), and (4) under Note 4.(A). The minimum dosage requirement shall be 128 ounces per cubic yard of concrete.
- (C) All reinforcing steel shall be ASTM A615 Grade 60 unless otherwise noted.
- (D) All structural steel shall be ASTM A36 hot-dip galvanized after fabrication, unless otherwise noted.
- (E) All anchor bolts, washers and nuts shall be ASTM A325 hot-dip galvanized after fabrication, unless otherwise specified.

4. Materials:(Cont.)

- (F) For materials of post-tensioned concrete see applicable post-tensioned concrete notes.
- (G) Steel tubes shall conform to ASTM A500, Grade B.
- (H) A migrating corrosion inhibitor amine carboxylate water-based admixture (CORTEC MCI-2005 NS) shall be added to the concrete mix for Item No.'s (2), (3), (4), and (5) under Note 4.(A). The minimum dosage shall be 1.5 pints per cubic yards of concrete.
- (I) The concrete for Item No. (3) shall be Type SBD as described in Special Provisions Section 601.04.

- (J) The Contractor shall use curing compound SINAK LITHIUM for bridge structures and approach slabs. Six copies of the manufacturer's brochure and certificates of test result shall be submitted. All work shall conform with the manufacturer's recommendations. Coverage rate shall be 500 square feet per gallon. After the curing compound is applied the deck surface shall be covered by burlene for seven days.
- (K) Stainless steel bolts, rods, nuts and washers shall be ASTM A193, UNS S31600 Class I. Stainless steel and dissimilar metals, such as reinforcing steel, shall be separated with teflon tape at contact area.

- (L) Asphalt roll roofing shall be ASTM D6380 Class S, Type III.

5. Reinforcement:

- (A) The minimum covering measured from the surface of the concrete to the face of any reinforcing bars shall be as follows, except as otherwise shown:
- (1) Deck topping
- A. Top bars = 2 1/2"
- B. Bottom bars = 1 1/2" except as otherwise noted
- (2) Abutment Walls = 2" to outermost reinforcing except as otherwise noted
- = 3" when concrete cast against and permanently exposed to earth
- (3) Approach slab top bars = 2 1/2"
- Approach slab bottom bars = 3"
- (4) Concrete cast against and permanently exposed to earth = 3"
- (5) All others unless otherwise noted = 2"

- (B) Reinforcing bars shall be detailed in accordance with the latest edition of the design specification in note 2 unless otherwise noted.
- (C) Minimum clear spacing between parallel bars shall be 1 1/2 times the diameter of bars (for non bundled bars). In no case shall the clear distance between the bars be less than 1 1/2 times the maximum size of the coarse aggregate or 1 1/2" (except at approach slab dowel).

5. Reinforcement (Cont.):

- (D) All dimensions relating to reinforcing bars are to centers of bars unless otherwise noted.
- (E) Reinforcing bars shall be securely tied at all intersections and lap splices except where the spacing of intersections is less than one foot in each direction, in which case alternate intersections shall be tied.
- (F) Reinforcing steel bar supports for the prestressed beams shall be precast concrete having 8,000 psi compressive strength. Wire bar supports and all plastic supports shall not be allowed in precast concrete beams.

6. Glass Fiber Reinforced Polymer Rebar:

- (A) Glass Fiber Reinforced Polymer (GFRP) rebar shall have a tensile strength of 110 ksi for #3 bars, 100 ksi for #4 bars, 95 ksi for #5 bars, and 90 ksi for #6 bars. The allowable tensile stress is equal to 20% of the minimum ultimate tensile strength.
- (B) The modulus of elasticity of the GFRP bar shall be 5,900,000 psi.
- (C) Minimum concrete cover for the GFRP bars shall be 3/4" unless otherwise noted.
- (D) Minimum lap splice lengths for the GFRP bars shall be 42 bar diameters unless otherwise noted.
- (E) All GFRP bars shall be securely tied in place.
- (F) The GFRP bars may be cut in the field with a masonry or diamond blade.
- (G) All work including materials and bends shall follow manufacturer's recommendations.

SURVEY PLOTTED BY	DATE
DRAWN BY	
TRACED BY	
CHECKED BY	
ORIGINAL PLAN	
NOTE BOOK	
No.	

DRAWING NAME: Z:\2004\40019\0-HONOAIPILANI LAHAINA BYPASS-KAHOMA WD\02-09-10 COMBINE LAHAINA GEN NOTES\HH-S002 VC CHANGE 02-08-10.DWG PLOT TIME: 02-09-10, 11:35 AM



THIS WORK WAS PREPARED BY ME OR UNDER MY SUPERVISION.
KSF, INC. APRIL 30, 2010 LIC. EXP. DATE

STATE OF HAWAII
DEPARTMENT OF TRANSPORTATION
HIGHWAYS DIVISION

BRIDGE GENERAL NOTES

HONOAIPILANI HIGHWAY REALIGNMENT, PHASE 1A
Future Keawe St Extension to Lahainaluna Rd, Part B
Fed. Aid Proj. No. NH-030-1(35)R

Scale: None

SHEET No. 502 OF 3 SHEETS

△	2-8-10 Revised Notes 4(A)(3) and 4(I)
△	12-14-09 Revised GFRP Note
DATE	REVISION

FED. ROAD DIST. NO.	STATE	FED. AID PROJ. NO.	FISCAL YEAR	SHEET NO.	TOTAL SHEETS
HAWAII	HAW.	NH-030-1(35)R	2009	134	379

BRIDGE GENERAL NOTES

1. General Specifications: Hawaii Department of Transportation, Standard Specifications for Road and Bridge Construction, 1994, together with Special Provisions prepared for this contract.
2. Design Specifications:
- (A) AASHTO 2004 LRFD Bridge Design Specifications (Third Edition) and its subsequent interim specifications with interim supplements and modifications by the Highways Division, Department of Transportation, State of Hawaii.
- (B) HDOT "Design Criteria for Bridges and Structures" dated February 14, 2005.
3. Loads:
- (A) Dead Load: An allowance of 25 PSF for future wearing surface of asphalt concrete has been provided for in the design.
- (B) Live Load: AASHTO HL-93 Truck Loading
- (C) Seismic Loads: Acceleration coefficient..... 0.24
Seismic Performance Zone..... 3
Importance Category..... Critical
Soil Profile..... Type I
- (D) Utility Load: An allowance of 150 PLF on each side of the bridge for Utility Loads has been provided for in the design.

4. Materials:
- (A) All concrete strengths for Lahainaluna Road Grade Separation Structure shall be as noted below:

Item No.	Structural Parts	Classes of Concrete	Specified Compressive Strength, f'c (28 Days)	Maximum W/C Ratio
(1)	Abutment walls (See Note 4.(B))	—	8,000 psi	.4
(2)	Beams (Girders), including closure joint and midspan diaphragm. (See Notes 4.(B) and 4.(H))	—	8,000 psi	.4
(3)	Deck, Sidewalk, End Beams, and Approach Slabs (See Note 4.(I))	—	8,000 psi	.35
(4)	Railings (See Notes 4.(B) and 4.(H))	—	4,000 psi	.45
(5)	End posts (See Note 4.(H))	—	4,000 psi	.45
(6)	Except as noted otherwise, all others	A	3,000 psi	0.55

- (B) A shrinkage reducing admixture (Tetraguard AS20 by BASF) shall be added to the concrete mix for Item No.'s (1), (2), (3), and (4) under Note 4.(A). The minimum dosage requirement shall be 128 ounces per cubic yard of concrete.
- (C) All reinforcing steel shall be ASTM A615 Grade 60 unless otherwise noted.
- (D) All structural steel shall be ASTM A36 hot-dip galvanized after fabrication, unless otherwise noted.
- (E) All anchor bolts, washers and nuts shall be ASTM A325 hot-dip galvanized after fabrication, unless otherwise specified.

4. Materials:(Cont.)
- (F) For materials of post-tensioned concrete see applicable post-tensioned concrete notes.
- (G) Steel tubes shall conform to ASTM A500, Grade B.
- (H) A migrating corrosion inhibitor amine carboxylate water-based admixture (CORTEC MCI-2005 NS) shall be added to the concrete mix for Item No.'s (2), (3), (4), and (5) under Note 4.(A). The minimum dosage shall be 1.5 pints per cubic yards of concrete.
- (I) The concrete mix for Item No. (3) shall have a maximum shrinkage strain of .00006 at 28 days and .000145 at 56 days according to ASTM C512.
- (J) The Contractor shall use curing compound SINAK LITHIUM for bridge structures and approach slabs. Six copies of the manufacturer's brochure and certificates of test result shall be submitted. All work shall conform with the manufacturer's recommendations. Coverage rate shall be 500 square feet per gallon. After the curing compound is applied the deck surface shall be covered by burlene for seven days.
- (K) Stainless steel bolts, rods, nuts and washers shall be ASTM A193, UNS S31600 Class I. Stainless steel and dissimilar metals, such as reinforcing steel, shall be separated with teflon tape at contact area.
- (L) Asphalt roll roofing shall be ASTM D6380 Class 5, Type III.

5. Reinforcement:
- (A) The minimum covering measured from the surface of the concrete to the face of any reinforcing bars shall be as follows, except as otherwise shown:
- (1) Deck topping
- A. Top bars = 2 1/2"
- B. Bottom bars = 1 1/2" except as otherwise noted
- (2) Abutment Walls = 2" to outermost reinforcing except as otherwise noted
- = 3" when concrete cast against and permanently exposed to earth
- (3) Approach slab top bars = 2 1/2"
- Approach slab bottom bars = 3"
- (4) Concrete cast against and permanently exposed to earth = 3"
- (5) All others unless otherwise noted = 2"
- (B) Reinforcing bars shall be detailed in accordance with the latest edition of the design specification in note 2 unless otherwise noted.
- (C) Minimum clear spacing between parallel bars shall be 1 1/2 times the diameter of bars (for non bundled bars). In no case shall the clear distance between the bars be less than 1 1/2 times the maximum size of the coarse aggregate or 1 1/2" (except at approach slab dowel).

5. Reinforcement (Cont.):
- (D) All dimensions relating to reinforcing bars are to centers of bars unless otherwise noted.
- (E) Reinforcing bars shall be securely tied at all intersections and lap splices except where the spacing of intersections is less than one foot in each direction, in which case alternate intersections shall be tied.
- (F) Reinforcing steel bar supports for the prestressed beams shall be precast concrete having 8,000 psi compressive strength. Wire bar supports and all plastic supports shall not be allowed in precast concrete beams.
6. Glass Fiber Reinforced Polymer Rebar:
- (A) Glass Fiber Reinforced Polymer (GFRP) rebar shall have a tensile strength of 110 ksi for #3 bars, 100 ksi for #4 bars, 95 ksi for #5 bars, and 90 ksi for #6 bars. The allowable tensile stress is equal to 20% of the minimum ultimate tensile strength.
- (B) The modulus of elasticity of the GFRP bar shall be 5,900,000 psi.
- (C) Minimum concrete cover for the GFRP bars shall be 3/4" unless otherwise noted.
- (D) Minimum lap splice lengths for the GFRP bars shall be 42 bar diameters unless otherwise noted.
- (E) All GFRP bars shall be securely tied in place.
- (F) The GFRP bars may be cut in the field with a masonry or diamond blade.
- (G) All work including materials and bends shall follow manufacturer's recommendations.

(A) Glass Fiber Reinforced Polymer (GFRP) rebar shall have a tensile strength of 110 ksi for #3 bars, 100 ksi for #4 bars, 95 ksi for #5 bars, and 90 ksi for #6 bars. The allowable tensile stress is equal to 20% of the minimum ultimate tensile strength.



THIS WORK WAS PREPARED BY ME OR UNDER MY SUPERVISION.
KSF, INC. APRIL 30, 2010
LIC. EXP. DATE



12-14-09 Revised GFRP Note

DATE	REVISION	SHEET No. SG0.2 OF 3 SHEETS
------	----------	-----------------------------

STATE OF HAWAII
DEPARTMENT OF TRANSPORTATION
HIGHWAYS DIVISION

BRIDGE GENERAL NOTES

HONOAPILANI HIGHWAY REALIGNMENT, PHASE 1A
Future Keawe St Extension to Lahainaluna Rd, Part B
Fed. Aid Proj. No. NH-030-1(35)R

Scale: None

ORIGINAL PLAN	SURVEY PLOTTED BY	DATE
NOTE BOOK	DRAWN BY	
	DESIGNED BY	
	CHECKED BY	

DRAWING NAME: Z:\2004\40019.0-HONOAPILANI LAHAINA BYPASS-KAHOMA WY12-14-09 COMBINE KAHOMA FIELD CHANGE\1H-SG002 FIELD CHANGE 12-14-09.DWG PLOT TIME: 12-14-09 4:54 PM

BRIDGE GENERAL NOTES

1. General Specifications: Hawaii Department of Transportation, Standard Specifications for Road and Bridge Construction, 1994, together with Special Provisions prepared for this contract.
2. Design Specifications:
- (A) AASHTO 2004 LRFD Bridge Design Specifications (Third Edition) and its subsequent interim specifications with interim supplements and modifications by the Highways Division, Department of Transportation, State of Hawaii.
- (B) HDOT "Design Criteria for Bridges and Structures" dated February 14, 2005.

3. Loads:
- (A) Dead Load: An allowance of 25 PSF for future wearing surface of asphalt concrete has been provided for in the design.
- (B) Live Load: AASHTO HL-93 Truck Loading
- (C) Seismic Loads: Acceleration coefficient..... 0.24
Seismic Performance Zone..... 3
Importance Category..... Critical
Soil Profile..... Type I
- (D) Utility Load: An allowance of 150 PLF on each side of the bridge for Utility Loads has been provided for in the design.

4. Materials:
- (A) All concrete strengths for Lahainaluna Road Grade Separation Structure shall be as noted below:

Item No.	Structural Parts	Classes of Concrete	Specified Compressive Strength, f'c (28 Days)	Maximum W/C Ratio
(1)	Abutment walls (See Note 4.(B))	-	8,000 psi	.4
(2)	Beams (Girders), including closure joint and midspan diaphragm. (See Notes 4.(B) and 4.(H))	-	8,000 psi	.4
(3)	Deck, Sidewalk, End Beams, and Approach Slabs (See Note 4.(I))	-	8,000 psi	.35
(4)	Railings (See Notes 4.(B) and 4.(H))	-	4,000 psi	.45
(5)	End posts (See Note 4.(H))	-	4,000 psi	.45
(6)	Except as noted otherwise, all others	A	3,000 psi	0.55


- (B) A shrinkage reducing admixture (Tetraguard AS20 by BASF) shall be added to the concrete mix for Item No.'s (1), (2), (3), and (4) under Note 4.(A). The minimum dosage requirement shall be 128 ounces per cubic yard of concrete.
- (C) All reinforcing steel shall be ASTM A615 Grade 60 unless otherwise noted.
- (D) All structural steel shall be ASTM A36 hot-dip galvanized after fabrication, unless otherwise noted.
- (E) All anchor bolts, washers and nuts shall be ASTM A325 hot-dip galvanized after fabrication, unless otherwise specified.

4. Materials:(Cont.):
- (F) For materials of post-tensioned concrete see applicable post-tensioned concrete notes.
- (G) Steel tubes shall conform to ASTM A500, Grade B.
- (H) A migrating corrosion inhibitor amine carboxylate water-based admixture (CORTEC MCI-2005 NS) shall be added to the concrete mix for Item No.'s (2), (3), (4), and (5) under Note 4.(A). The minimum dosage shall be 1.5 pints per cubic yards of concrete.
- (I) The concrete mix for Item No. (3) shall have a maximum shrinkage strain of .00006 at 28 days and .000145 at 56 days according to ASTM C512.
- (J) The Contractor shall use curing compound SINAK LITHIUM for bridge structures and approach slabs. Six copies of the manufacturer's brochure and certificates of test result shall be submitted. All work shall conform with the manufacturer's recommendations. Coverage rate shall be 500 square feet per gallon. After the curing compound is applied the deck surface shall be covered by burlene for seven days.
- (K) Stainless steel bolts, rods, nuts and washers shall be ASTM A193, UNS S31600 Class I. Stainless steel and dissimilar metals, such as reinforcing steel, shall be separated with teflon tape at contact area.
- (L) Asphalt roll roofing shall be ASTM D6380 Class 5, Type III.

5. Reinforcement:
- (A) The minimum covering measured from the surface of the concrete to the face of any reinforcing bars shall be as follows, except as otherwise shown:
- (1) Deck topping
- A. Top bars = 2 1/2"
- B. Bottom bars = 1 1/2" except as otherwise noted
- (2) Abutment Walls = 2" to outermost reinforcing except as otherwise noted
- = 3" when concrete cast against and permanently exposed to earth
- (3) Approach slab top bars = 2 1/2"
- Approach slab bottom bars = 3"
- (4) Concrete cast against and permanently exposed to earth = 3"
- (5) All others unless otherwise noted = 2"
- (B) Reinforcing bars shall be detailed in accordance with the latest edition of the design specification in note 2 unless otherwise noted.
- (C) Minimum clear spacing between parallel bars shall be 1 1/2 times the diameter of bars (for non bundled bars). In no case shall the clear distance between the bars be less than 1 1/2 times the maximum size of the coarse aggregate or 1 1/2" (except at approach slab dowel).

5. Reinforcement (Cont.):
- (D) All dimensions relating to reinforcing bars are to centers of bars unless otherwise noted.
- (E) Reinforcing bars shall be securely tied at all intersections and lap splices except where the spacing of intersections is less than one foot in each direction, in which case alternate intersections shall be tied.
- (F) Reinforcing steel bar supports for the prestressed beams shall be precast concrete having 8,000 psi compressive strength. Wire bar supports and all plastic supports shall not be allowed in precast concrete beams.
6. Glass Fiber Reinforced Polymer Rebar:
- (A) Glass Fiber Reinforced Polymer (GFRP) rebar shall have a tensile strength of 100 ksi for #4 bars, 95 ksi for #5 bars and 90 ksi for #6 bars. The allowable tensile stress is equal to 20% of the minimum ultimate tensile strength.
- (B) The modulus of elasticity of the GFRP bar shall be 5,900,000 psi.
- (C) Minimum concrete cover for the GFRP bars shall be 3/4" unless otherwise noted.
- (D) Minimum lap splice lengths for the GFRP bars shall be 42 bar diameters unless otherwise noted.
- (E) All GFRP bars shall be securely tied in place.
- (F) The GFRP bars may be cut in the field with a masonry or diamond blade.
- (G) All work including materials and bends shall follow manufacturer's recommendations.

DATE	_____
SURVEY PLOTTED BY	_____
DRAWN BY	_____
TRACED BY	_____
DESIGNED BY	_____
QUANTITIES BY	_____
CHECKED BY	_____
ORIGINAL PLAN	_____
NOTE BOOK	_____
No.	_____

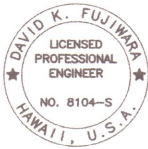

THIS WORK WAS PREPARED BY ME OR UNDER MY SUPERVISION.
David K. Fujiwara
KSF, INC. APRIL 30, 2010 LIC. EXP. DATE

STATE OF HAWAII DEPARTMENT OF TRANSPORTATION HIGHWAYS DIVISION	
BRIDGE GENERAL NOTES	
HONOAPIILANI HIGHWAY REALIGNMENT, PHASE 1A	
Future Keawe St Extension to Lahainaluna Rd	
Part A: Off Ramp Mass Grading	
Fed. Aid Proj. No. NH-030-1(35)R	
Scale: None	Date: April, 2009
SHEET No. SG0.2 OF 3 SHEETS	

BRIDGE GENERAL NOTES

FED. ROAD DIST. NO.	STATE	FED. AID PROJ. NO.	FISCAL YEAR	SHEET NO.	TOTAL SHEETS
HAWAII	HAW.	NH-030-1(35)R	2009	135	286

7. Foundation:

(A) Lahainaluna Road Grade Separation Structure

- (1) Bearing Value (service) = 20,000 psf
- (2) Bearing Value (strength) = 36,000 psf
- (3) Bearing Value (extreme event) = 60,000 psf
- (4) At-rest pressure (Top 8 feet of abutment) = 56 pcf
- (5) At-rest pressure (Abutment wall retaining basalt) = 5 pcf
- (6) Earthquake load (abutment walls) = $14.5^2 H$ (Restraint)
(H = height of retained soil or backfill in feet)
- (7) Passive pressure (Extreme Event) = 1,000 psi.
Passive pressure (Strength) = 500 psi.
Horizontal spring (in contact with rock) = 5,000 psi.
Horizontal spring (in contact with soil) = 4 ksf/in.
- (8) Friction Factor: Extreme Event : μ = 0.70
Strength : μ = 0.60

Other Notes:

8. (A) Reference Drawings:

- (1) For Construction Sequence of Lahainaluna Road Grade Separation Structure, See sheet SG9.1.
- (B) Except as otherwise noted, all vertical dimensions are measured plumb.
- (C) Unless otherwise noted, all exposed concrete edges shall be chamfered $3/4" \times 3/4"$.

ORIGINAL PLAN	SURVEY PLOTTED BY	DATE
NOTE BOOK	DRAWN BY	
No.	TRACED BY	
	DESIGNED BY	
	QUANTITIES BY	
	CHECKED BY	



THIS WORK WAS PREPARED BY ME
OR UNDER MY SUPERVISION.

David K. Fujiwara
KSF, INC. APRIL 30, 2010
LIC. EXP. DATE

STATE OF HAWAII
DEPARTMENT OF TRANSPORTATION
HIGHWAYS DIVISION

BRIDGE GENERAL NOTES

HONOAPIILANI HIGHWAY REALIGNMENT, PHASE 1A
Future Keawe St Extension to Lahainaluna Rd


Part A: Off Ramp Mass Grading

Fed. Aid Proj. No. NH-030-1(35)R


Scale: None

Date: April, 2009

SHEET No. SG0.3 OF 3 SHEETS

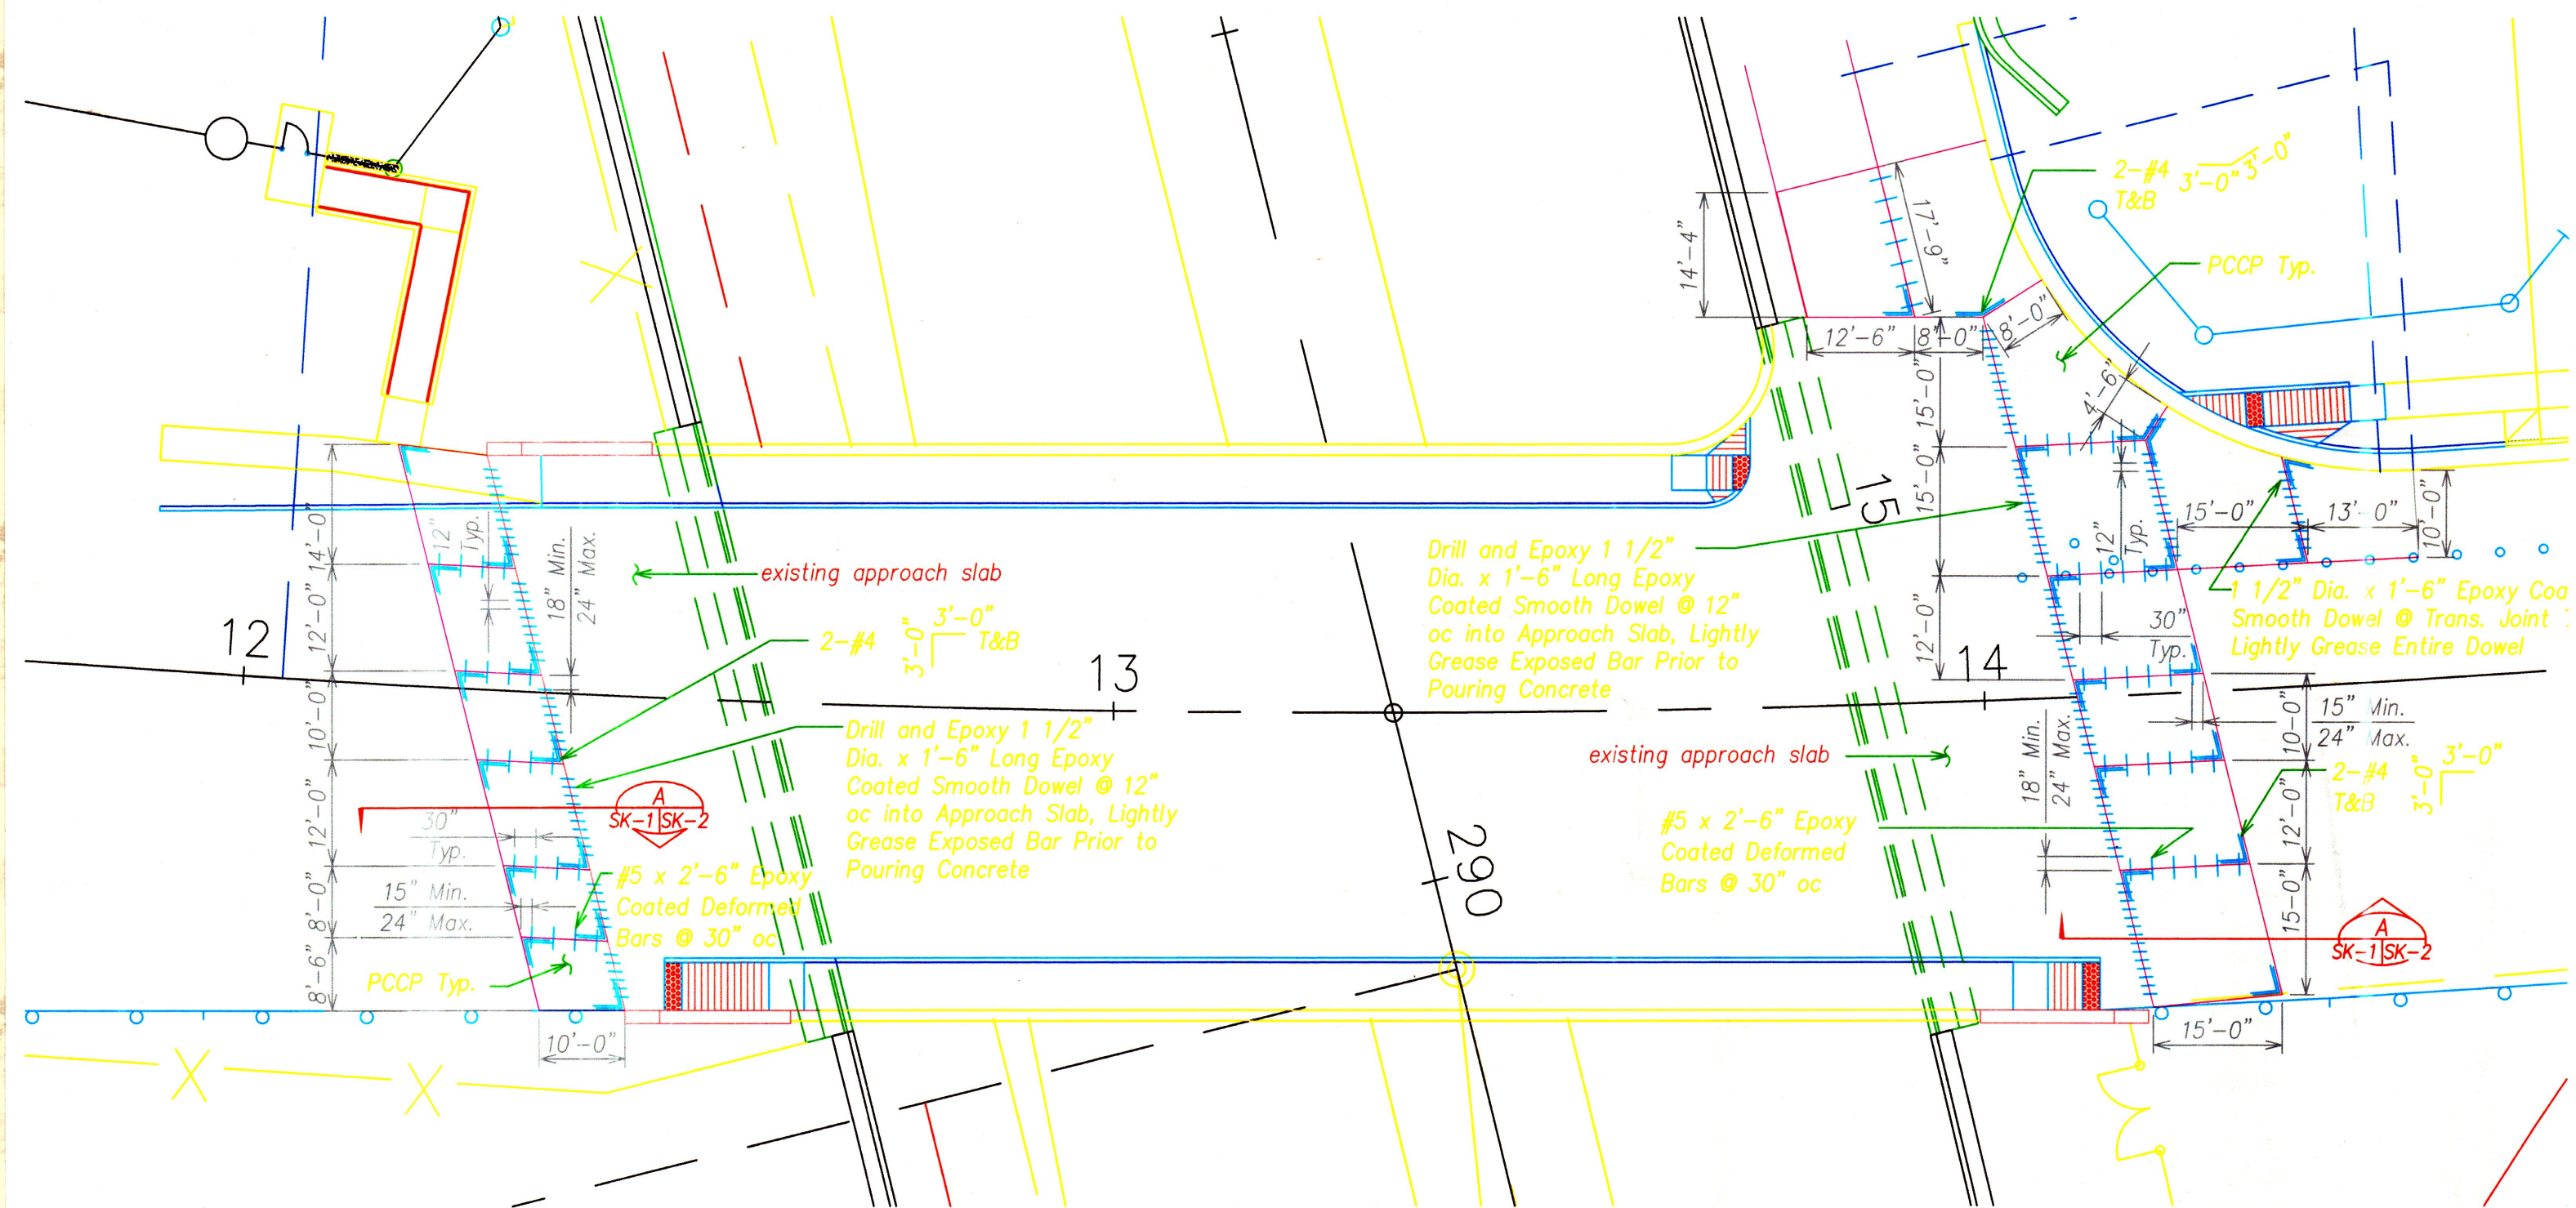

FED. ROAD DIST. NO.	STATE	FED. AID PROJ. NO.	FISCAL YEAR	SHEET NO.	TOTAL SHEETS
HAWAII	HAW.	NH-030-1(35)R	2009	136	286

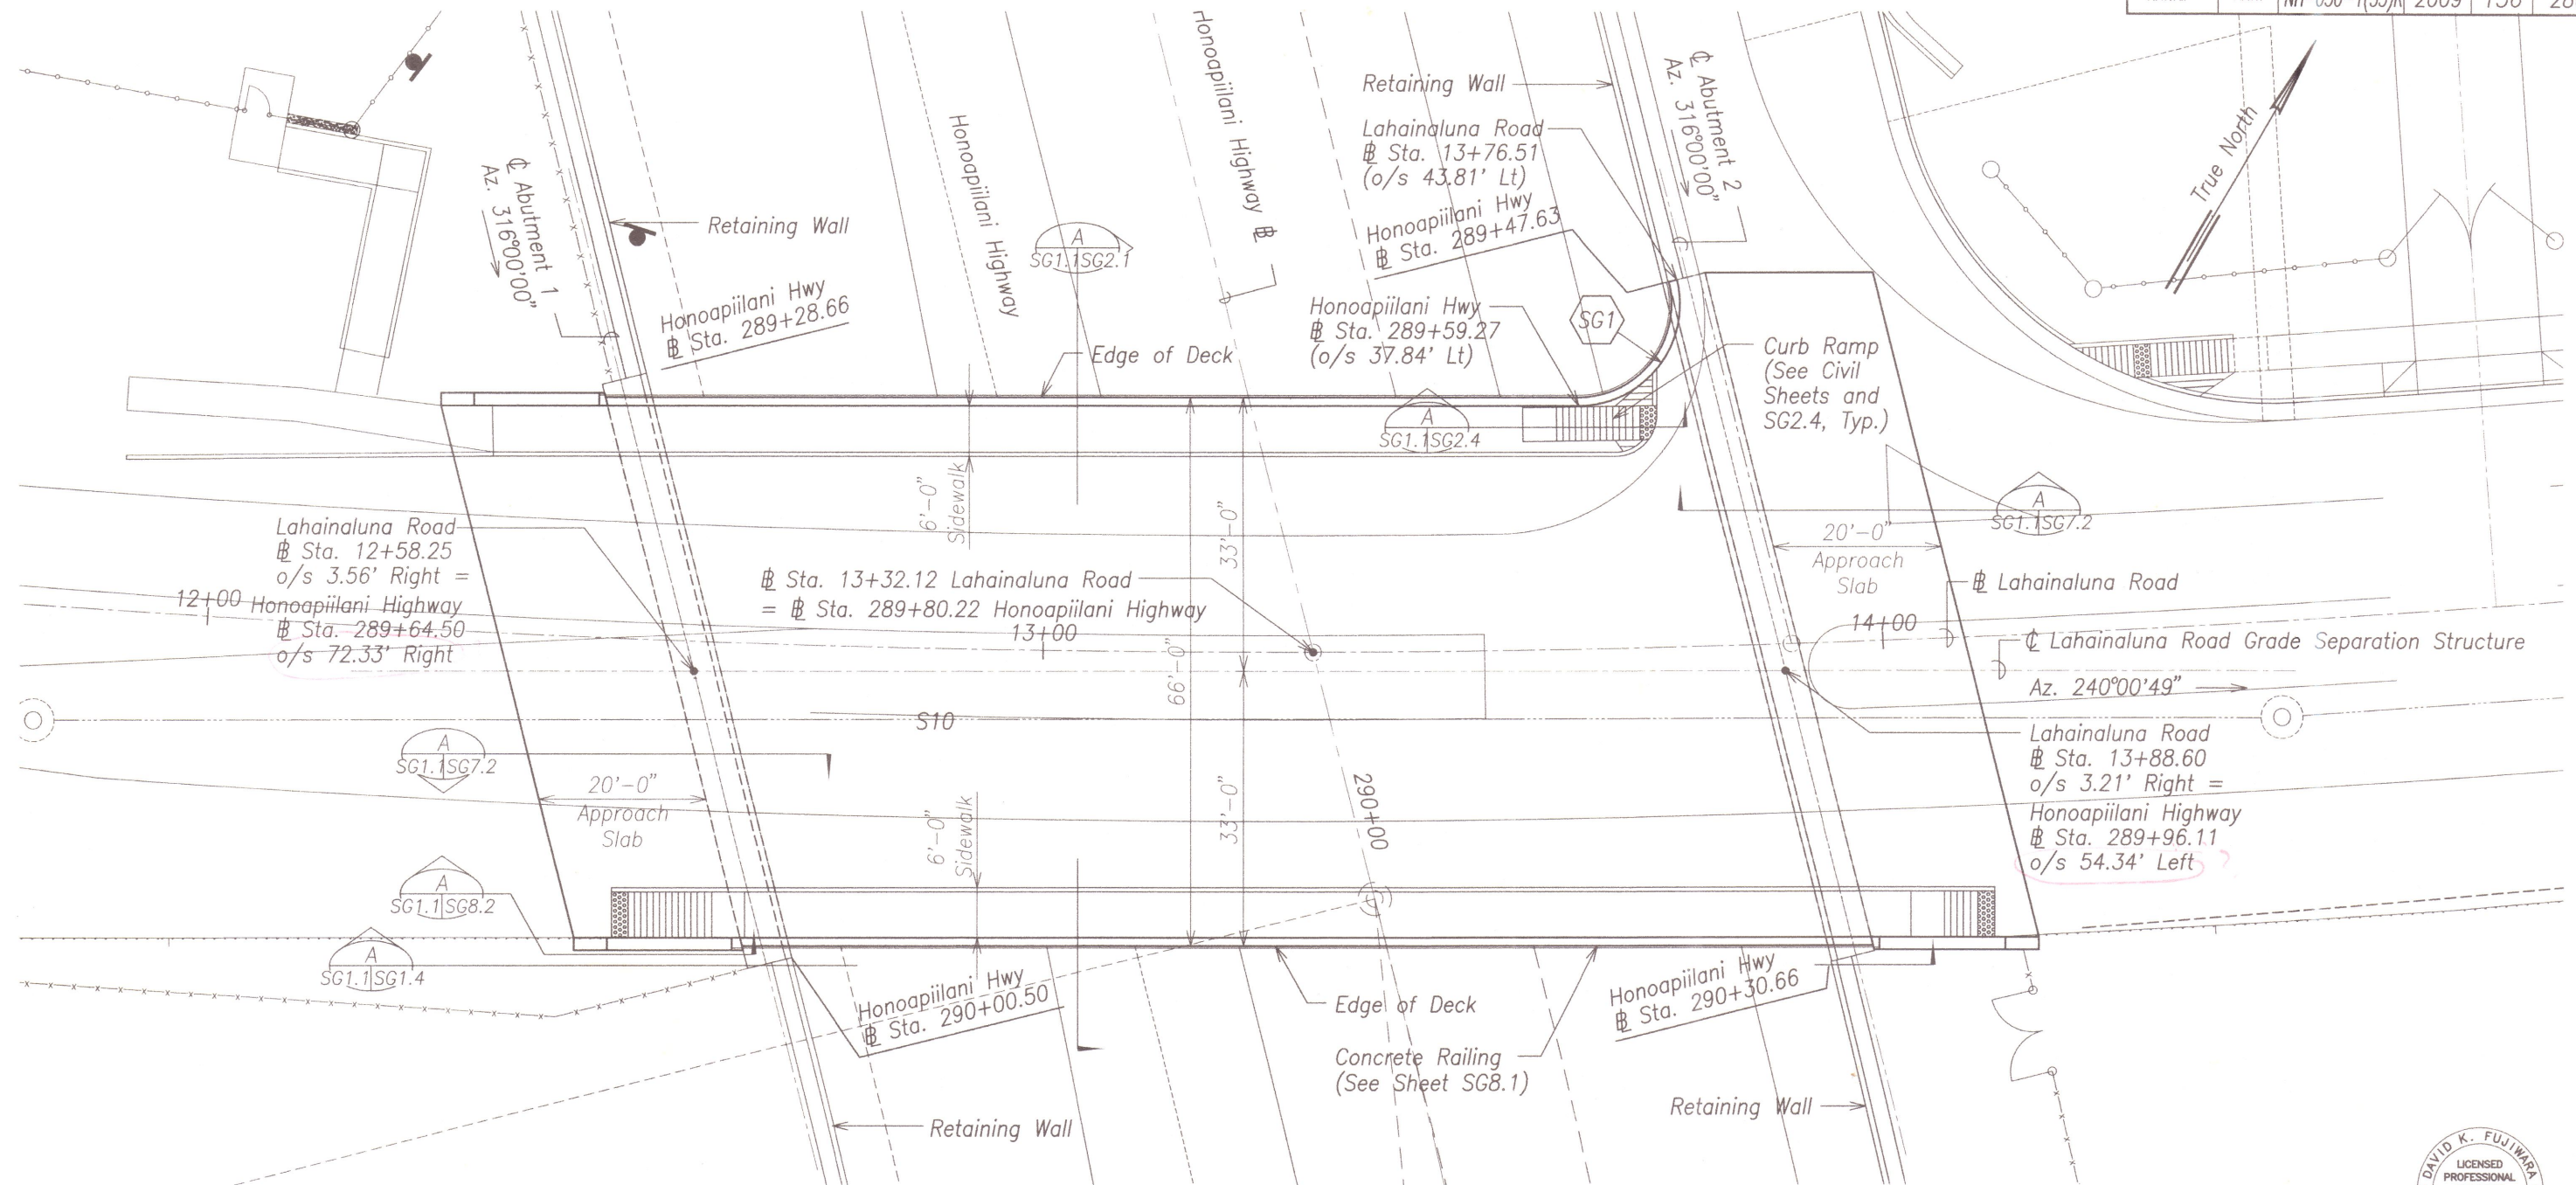

SG1 CURVE DATA

Δ	=	104° 00' 49"
$\Delta/2$	=	52° 00' 25"
R	=	12
T	=	15.36
Ch	=	18.91
Lc	=	21.79

LAHAINALUNA ROAD GRADE SEPARATION STRUCTURE – LAYOUT PLAN

Scale: 1" = 10'-0"

Notes:

1. See Civil Plans for Retaining Wall details.
2. See Civil Plans for Sewer Line (S10) details.
3. See Civil Plans for further geometric details.
4. See Civil Plans and SG2.4 for Curb Ramp details.




THIS WORK WAS PREPARED BY ME
OR UNDER MY SUPERVISION.

David K. Fujiwara
KSF, INC. APRIL 30, 2010
LIC. EXP. DATE

STATE OF HAWAII
DEPARTMENT OF TRANSPORTATION
HIGHWAYS DIVISION
**LAHAINALUNA ROAD GRADE SEPARATION STRUCTURE –
LAYOUT PLAN**
HONOAPIILANI HIGHWAY REALIGNMENT, PHASE 1A
Future Keawe St Extension to Lahainaluna Rd
Part A: Off Ramp Mass Grading
Fed. Aid Proj. No. NH-030-1(35)R
Scale: As Noted Date: April, 2009

SHEET NO. SG1.1 OF 4 SHEETS

FED. ROAD DIST. NO.	STATE	FED. AID PROJ. NO.	FISCAL YEAR	SHEET NO.	TOTAL SHEETS
HAWAII	HAW.	NH-030-1(35)R	2009	137	286

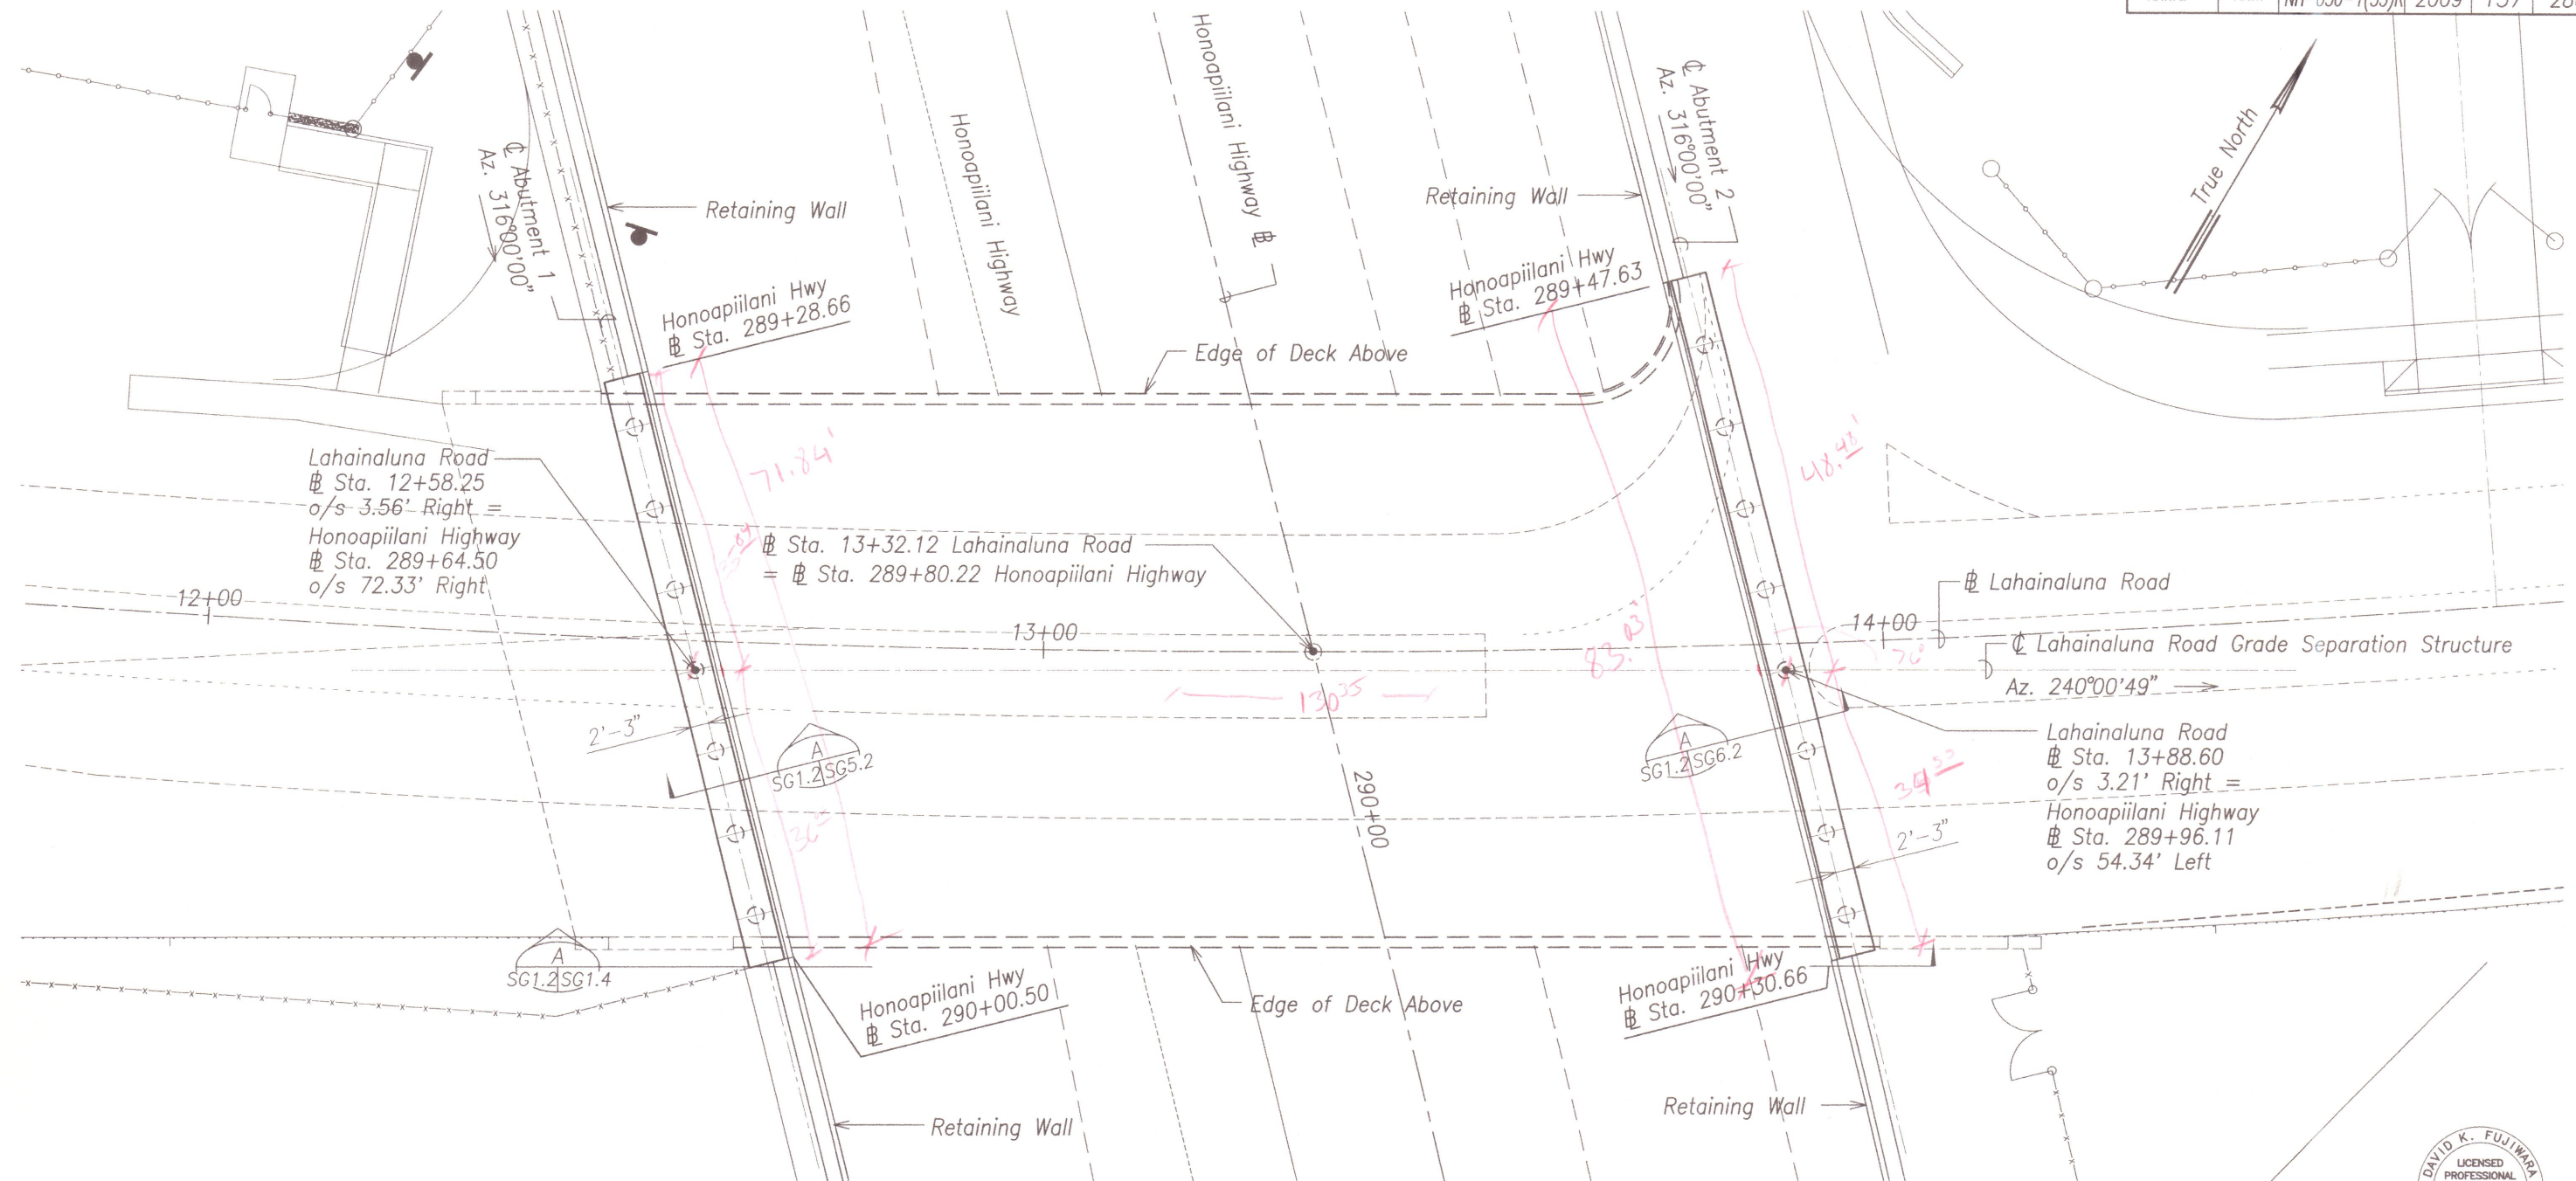

Legend:


- Probe hole locations @ 10'-0" oc along abutment wall footing
- Probe hole depth = 15'-0"± from bottom of footing.
- See Special Provisions Section 660.

Note:

See Civil Plans for retaining wall details.

LAHAINALUNA ROAD GRADE SEPARATION STRUCTURE – FOUNDATION PLAN

Scale: 1" = 10'-0"

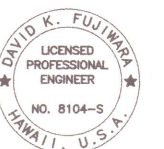


THIS WORK WAS PREPARED BY ME OR UNDER MY SUPERVISION.

David K. Fujiwara
KSF, INC. APRIL 30, 2010
LIC. EXP. DATE

STATE OF HAWAII
DEPARTMENT OF TRANSPORTATION
HIGHWAYS DIVISION
**LAHAINALUNA ROAD GRADE SEPARATION STRUCTURE –
FOUNDATION PLAN**
HONOAPIILANI HIGHWAY REALIGNMENT, PHASE 1A
Future Keawe St Extension to Lahainaluna Rd
Part A: Off Ramp Mass Grading
Fed. Aid Proj. No. NH-030-1(35)R
Scale: As Noted Date: April, 2009


SHEET No. SG1.2 OF 4 SHEETS

FED. ROAD DIST. NO.	STATE	FED. AID PROJ. NO.	FISCAL YEAR	SHEET NO.	TOTAL SHEETS
HAWAII	HAW.	NH-030-1(35)R	2009	138	286

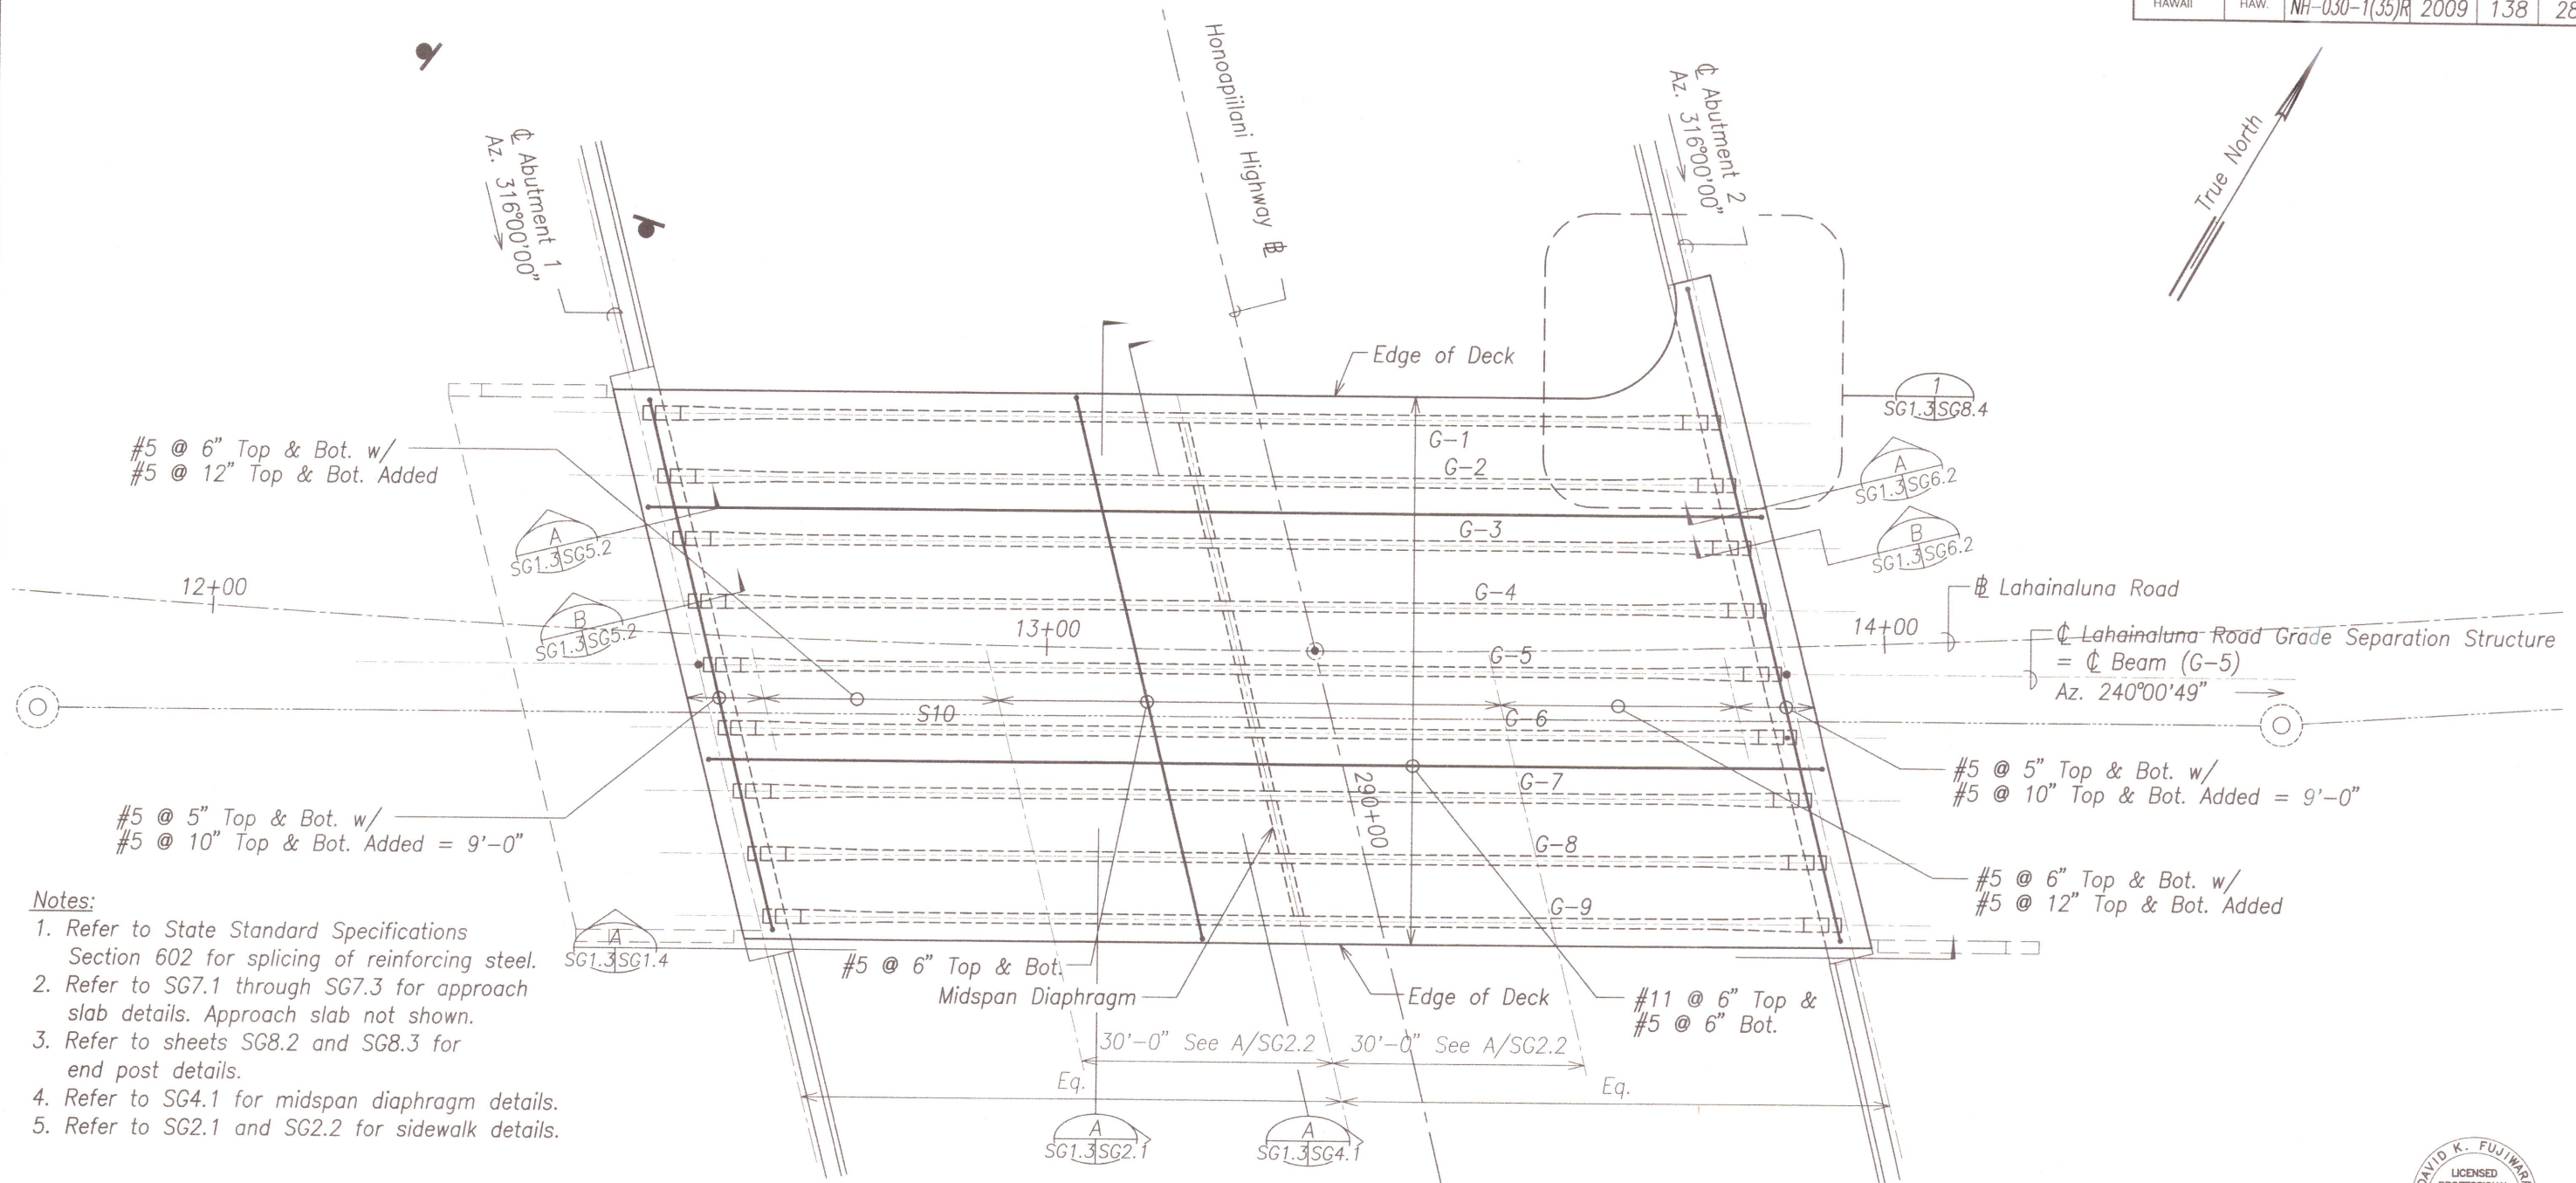

LAHAINALUNA ROAD GRADE SEPARATION STRUCTURE - DECK FRAMING AND REINFORCING PLAN

Scale: 1" = 10'-0"

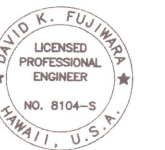


THIS WORK WAS PREPARED BY ME
OR UNDER MY SUPERVISION.

David K. Fujimura
KSF, INC. APRIL 30, 2010
LIC. EXP. DATE

STATE OF HAWAII
DEPARTMENT OF TRANSPORTATION
HIGHWAYS DIVISION
**LAHAINALUNA ROAD GRADE SEPARATION STRUCTURE -
DECK FRAMING AND REINFORCING PLAN**
HONOAPIILANI HIGHWAY REALIGNMENT, PHASE 1A
Future Keawe St Extension to Lahainaluna Rd
Part A: Off Ramp Mass Grading
Fed. Aid Proj. No. NH-030-1(35)R
Scale: As Noted Date: April, 2009
SHEET No. SG1.3 OF 4 SHEETS

FED. ROAD DIST. NO.	STATE	FED. AID PROJ. NO.	FISCAL YEAR	SHEET NO.	TOTAL SHEETS
HAWAII	HAW.	NH-030-1(35)R	2009	139	286

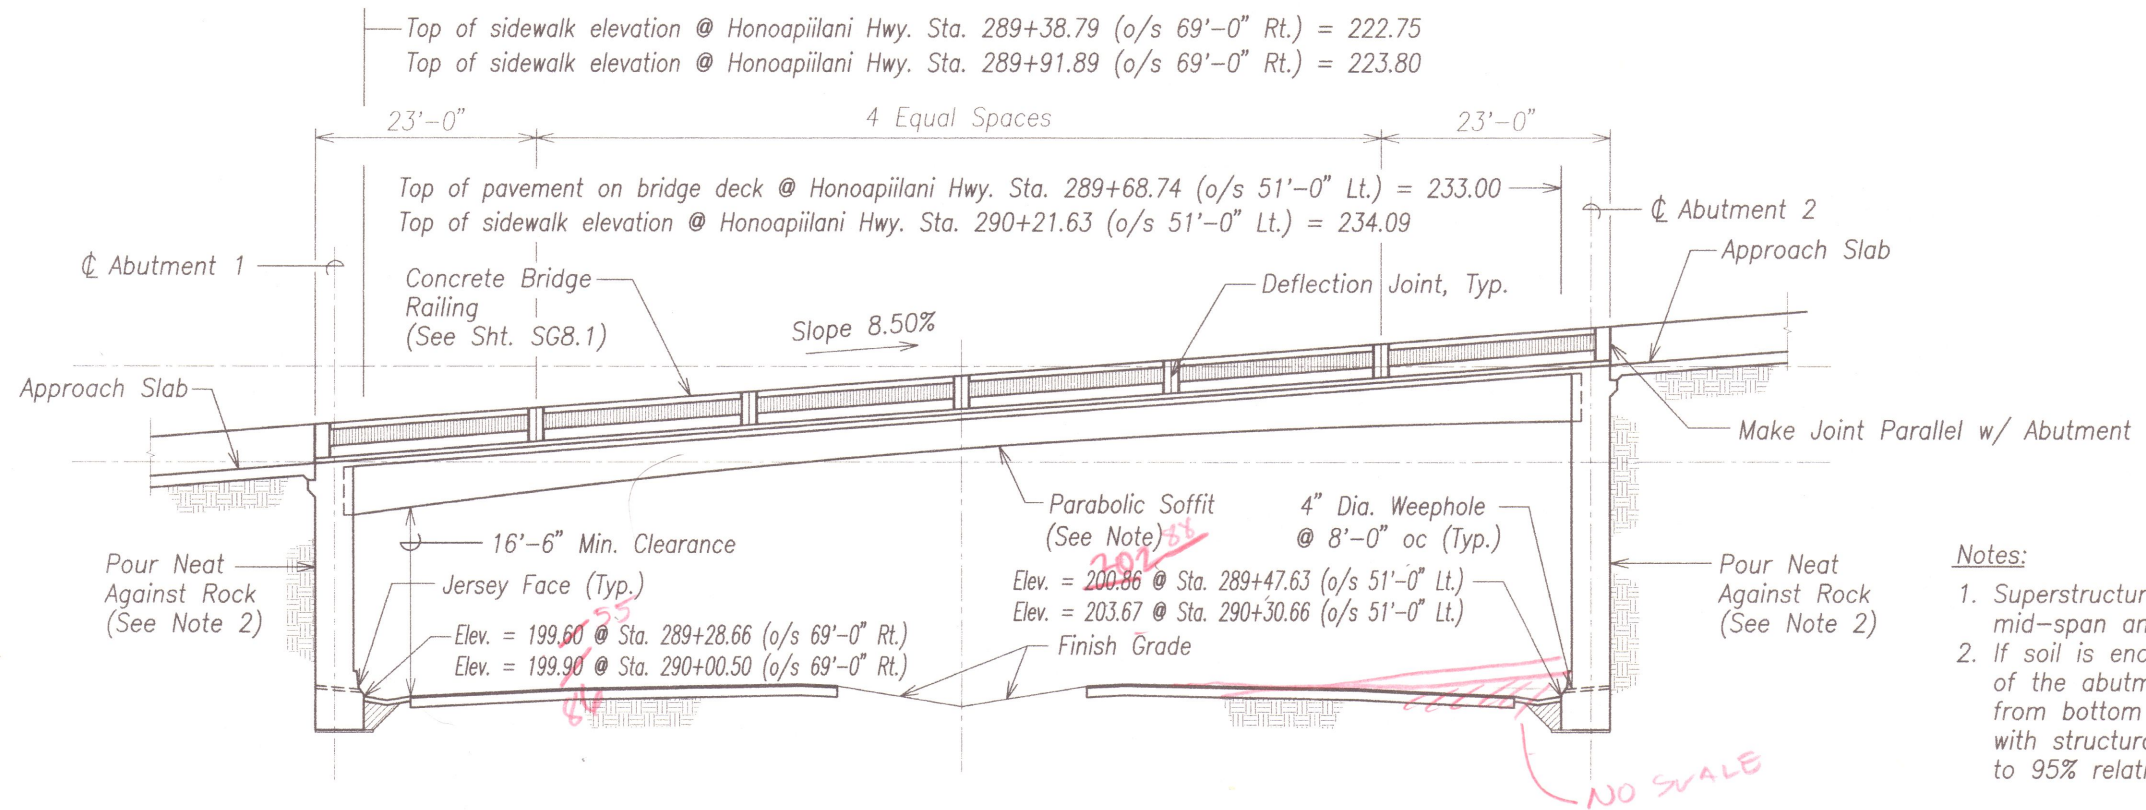


- Notes:
1. Superstructure is 3'-8" deep at mid-span and 5'-8" deep at abutments.
 2. If soil is encountered behind the top of the abutment, excavate 1H : 1V from bottom of soil layer and backfill with structural backfill type "A" compacted to 95% relative compaction.

LAHAINALUNA ROAD GRADE SEPARATION STRUCTURE - ELEVATION

Scale: 1" = 10'-0"

SG1.2, SG1.3, SG1.1, SG1.4

ORIGINAL PLAN	SURVEY PLOTTED BY	DATE
NOTE BOOK	DRAWN BY	
No.	QUANTITIES BY	
	CHECKED BY	

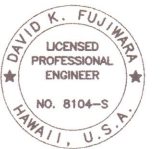

THIS WORK WAS PREPARED BY ME
OR UNDER MY SUPERVISION.

David K. Fujiwara
KSF, INC. APRIL 30, 2010
LIC. EXP. DATE

STATE OF HAWAII
DEPARTMENT OF TRANSPORTATION
HIGHWAYS DIVISION
**LAHAINALUNA ROAD GRADE SEPARATION STRUCTURE -
ELEVATION**
HONOAPIILANI HIGHWAY REALIGNMENT, PHASE 1A
Future Keawe St Extension to Lahainaluna Rd
Part A: Off Ramp Mass Grading
Fed. Aid Proj. No. NH-030-1(35)R
Scale: As Noted Date: April, 2009

SHEET No. SG1.4 OF 4 SHEETS

DIST. NO. STATE PROJ. NO. YEAR NO. SHEET
 HAWAII HAW. NH-030-1(35)R 2009 140 286

Lahainaluna Road Bridge
 Roadway Crown 2'-0" Varies


6'-0" Sidewalk 8'-0" Min. Shoulder 12'-0" Travelway 10'-0" Auxiliary lane 12'-0" Travelway 8'-0" Min. Shoulder 6'-0" Sidewalk

Concrete Bridge Railing. See Sheet SG8.1
 Top of Deck
 Slope
 Edge of Deck
 G-1 G-2 G-3 G-4 G-5 G-6 G-7 G-8 G-9
 See SG2.1 SG2.2
 Varies (4'-10" to 2'-10")
 8 Spaces @ 7'-6" = 60'-0"
 8 3/4" Cast-in-place
 2'-1"
 Precast Beams
 (4)-4 Dia. Ducts Each Side of Bridge
 2" Dia. Conduit
 Edge of Deck
 See SG2.1 SG2.2
 3'-0"

Stainless Strap Plate 3/8"x4" w/ 1/4" Thk. x 4" Wide
 Neoprene Between Strap Plate and Pipe.
 Length of Neoprene = 1/2 Perimeter of Pipe.
 2-1/2" Dia. Stainless Steel Anchors, See 1/SG2.3.
 Relocated 10" Dia. Sewerline (S10)


Notes:
 1. Section is taken perpendicular to precast beams.
 2. For precast beams, see sheets SG3.1 through SG3.8.
 3. Place pipe supports for (S10) 1 ft from faces of abutment and 1 ft on each side of diaphragm. Remainder of

Scale: $3/8" = 1'-0"$

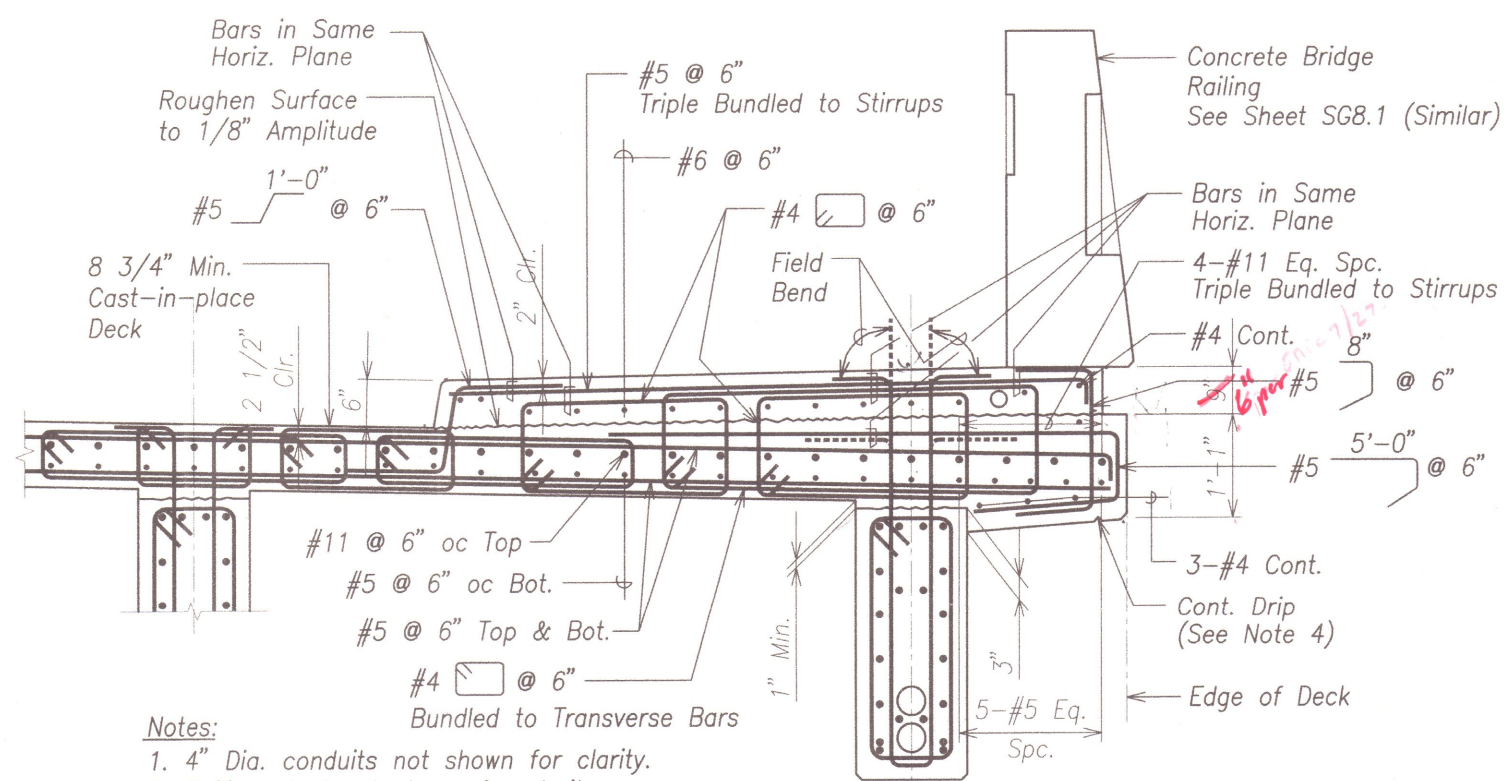


1. 4" Dia. conduits not shown for clarity.
2. Railing steel not shown for clarity.

Scale: $1'' = 1'-0''$

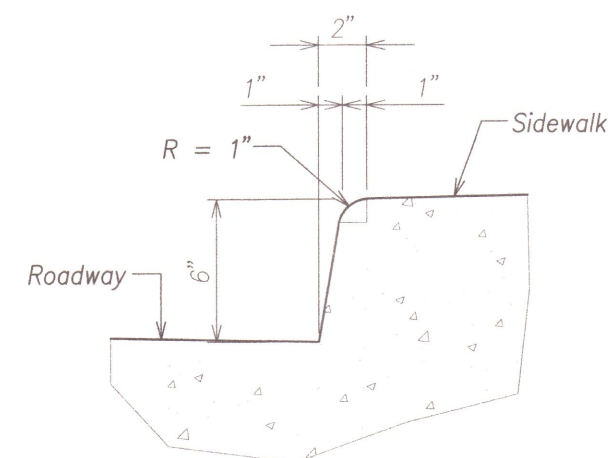


Scale: $3'' = 1'-0''$ SG2.1 SG2.1

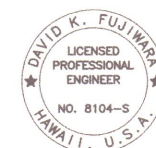

Donald K. Ferguson
KSF, INC.


SHEET No. *SG2.1* OF *5* SHEETS

FED. ROAD DIST. NO.	STATE	FED. AID PROJ. NO.	FISCAL YEAR	SHEET NO.	TOTAL SHEETS
HAWAII	HAW.	NH-030-1(35)R	2009	142	286

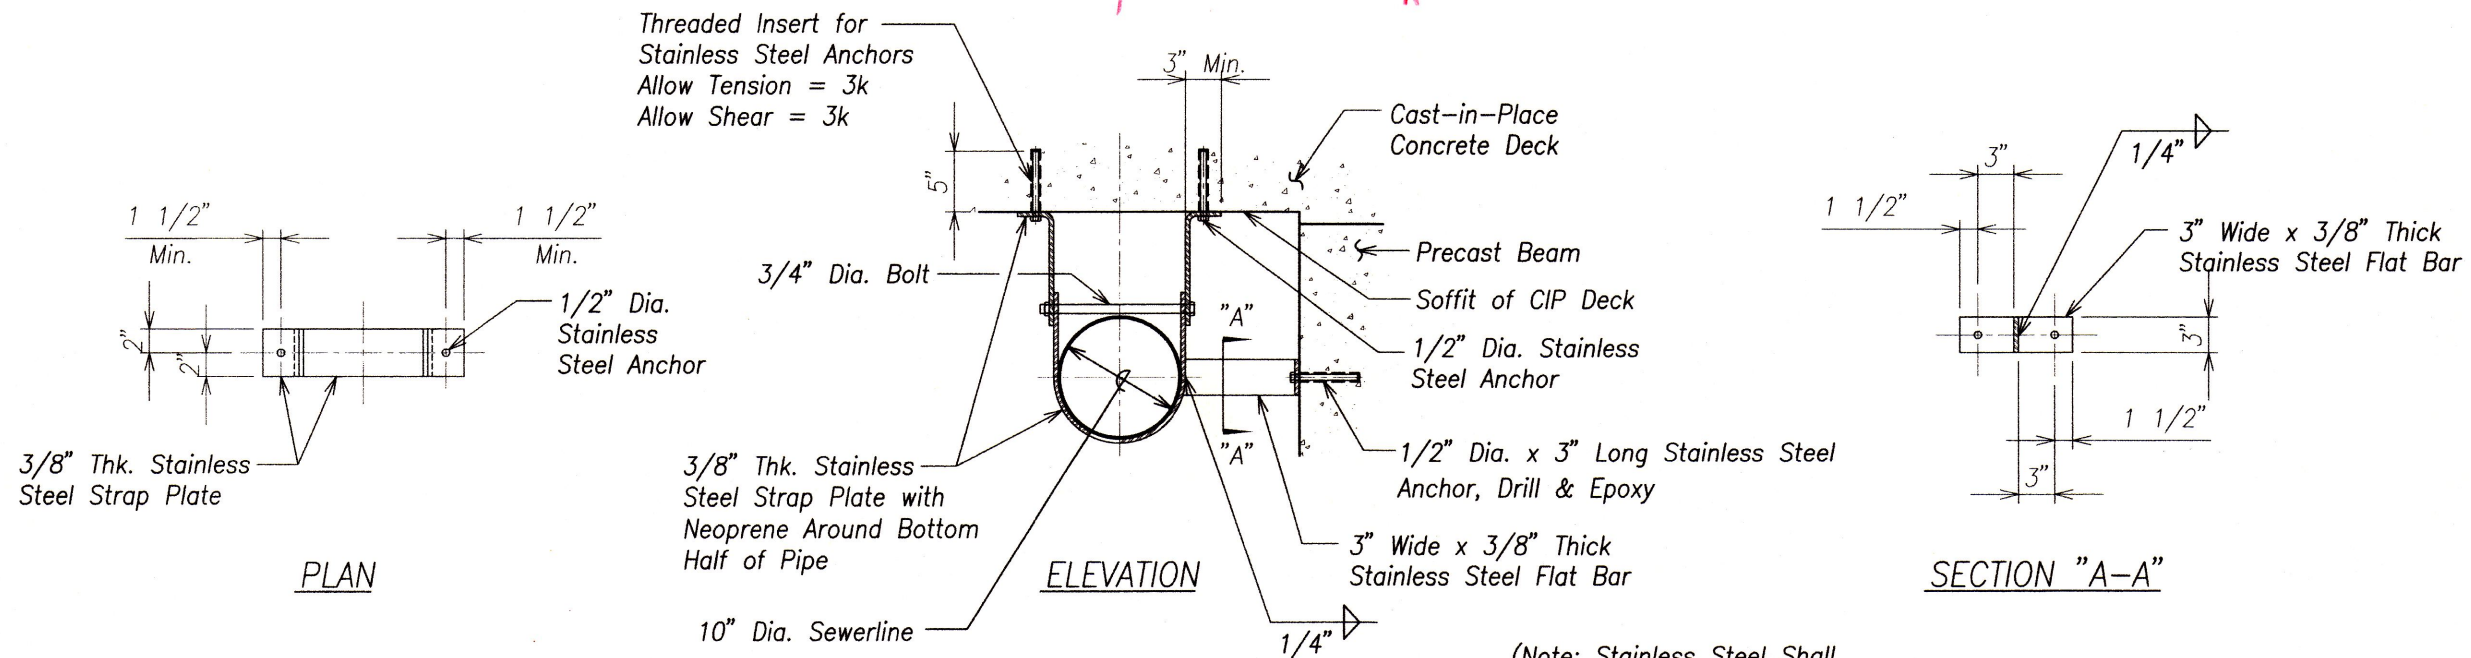

SEWERLINE SUPPORT DETAIL
Scale: 1 1/2" = 1'-0"
SG2.1 SG2.3

ORIGINAL PLAN	DATE
DRAWN BY	
TRACED BY	
QUANTITIES BY	
CHECKED BY	

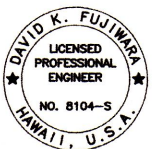

THIS WORK WAS PREPARED BY ME
OR UNDER MY SUPERVISION.

David K. Fujiwara
KSF, INC. APRIL 30, 2010
LIC. EXP. DATE


STATE OF HAWAII
DEPARTMENT OF TRANSPORTATION
HIGHWAYS DIVISION

SEWERLINE SUPPORT DETAILS


HONOAPIILANI HIGHWAY REALIGNMENT, PHASE 1A
Future Keawe St Extension to Lahainaluna Rd
Part A: Off Ramp Mass Grading
Fed. Aid Proj. No. NH-030-1(35)R
Scale: As Noted Date: April, 2009

SHEET No. SG2.3 OF 5 SHEETS

FED. ROAD DIST. NO.	STATE	FED. AID PROJ. NO.	FISCAL YEAR	SHEET NO.	TOTAL SHEETS
HAWAII	HAW.	NH-030-1(35)R	2009	143	286

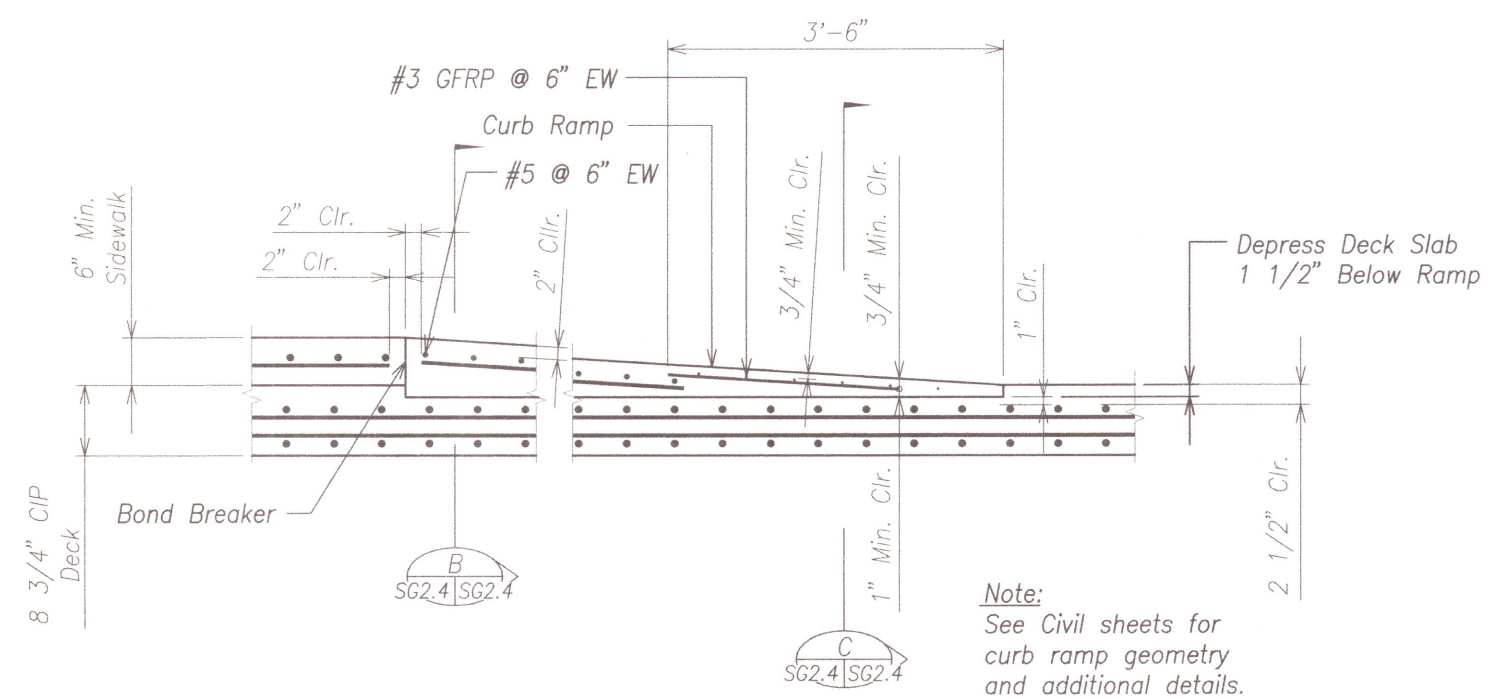


TYPICAL RAMP SECTION A
 Scale: 1" = 1'-0"
 SG1.1 SG2.4

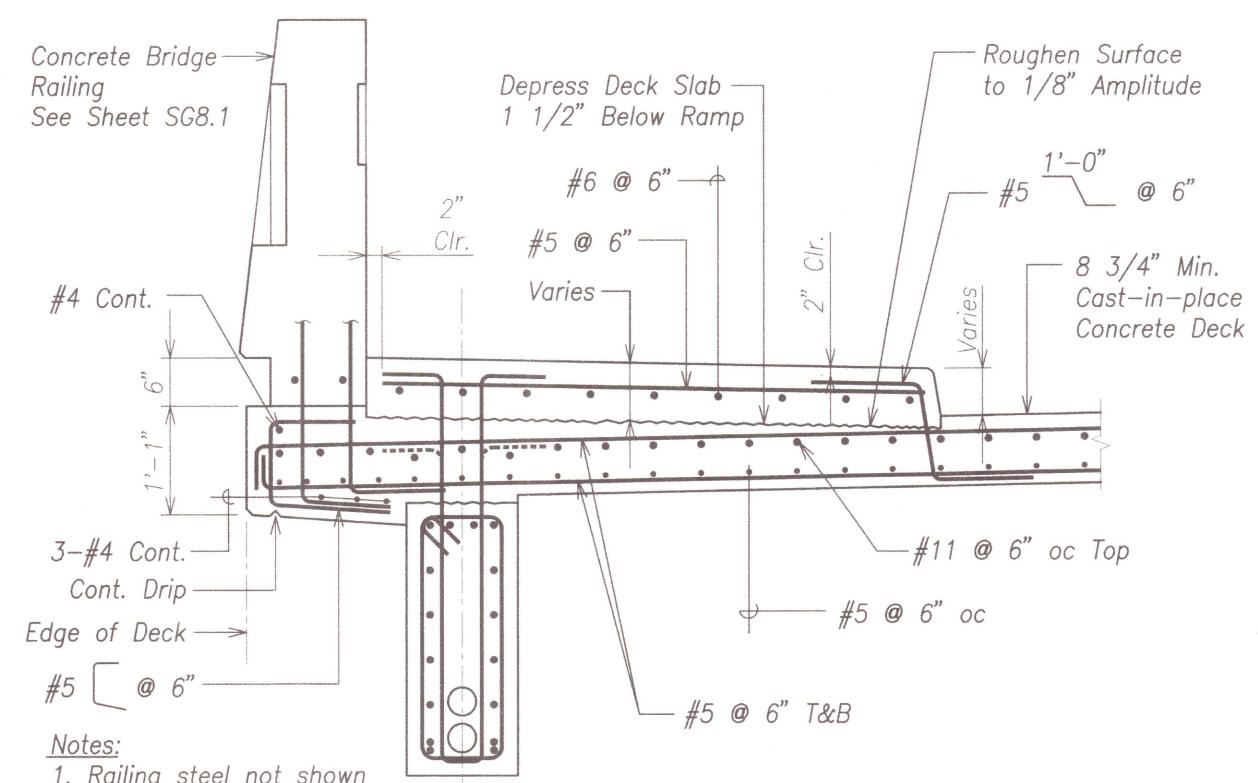

- Notes:**
1. Railing steel not shown for clarity.
 2. 4" Dia. ducts not shown for clarity.


SECTION AT CURB RAMP B
 Scale: 1" = 1'-0"
 SG2.4 SG2.4

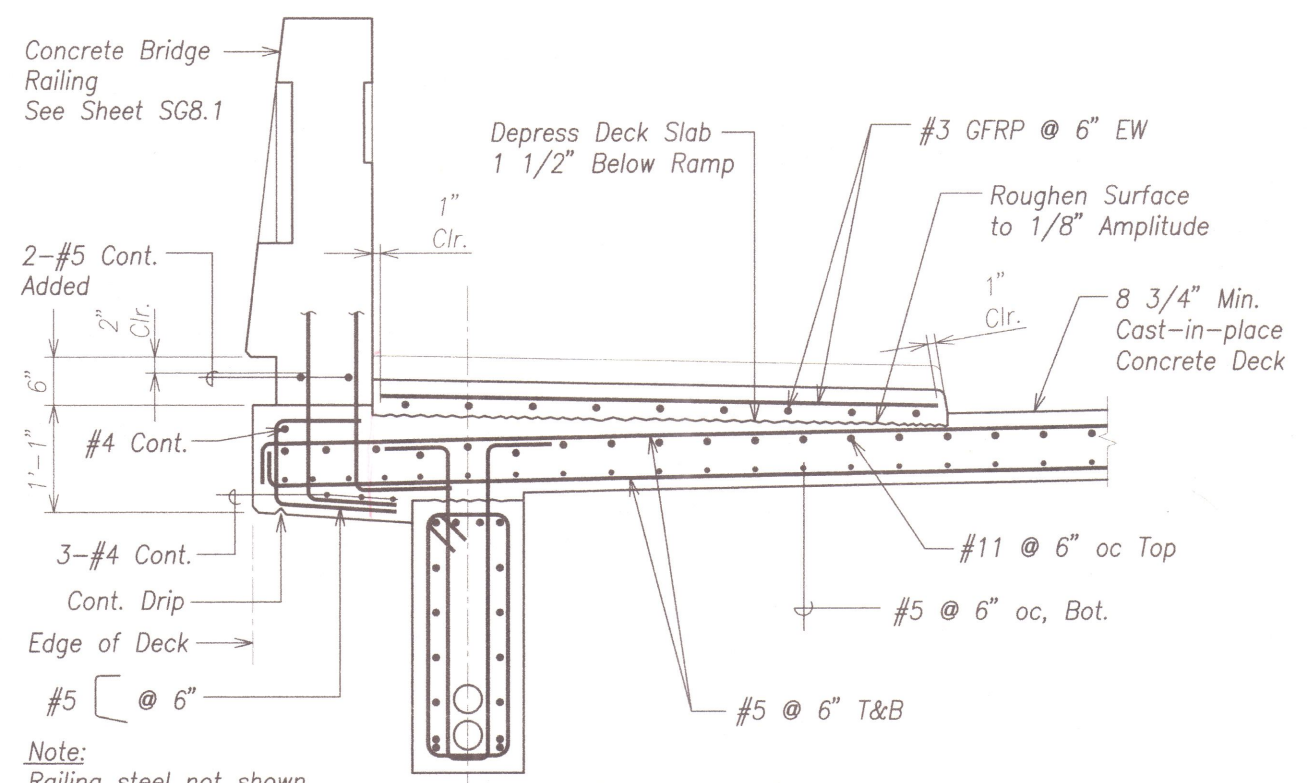

Note:
 Railing steel not shown for clarity.

SECTION AT CURB RAMP C
 Scale: 1" = 1'-0"
 SG2.4 SG2.4

ORIGINAL PLAN	DATE
NOTE BOOK	
DESIGNED BY	
QUANTITIES BY	
CHECKED BY	
No.	

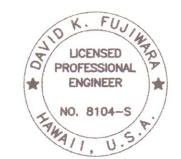


THIS WORK WAS PREPARED BY ME OR UNDER MY SUPERVISION.
David K. Fujiwara
 KSF, INC. APRIL 30, 2010
 LIC. EXP. DATE

STATE OF HAWAII
DEPARTMENT OF TRANSPORTATION
HIGHWAYS DIVISION

CURB RAMP SECTIONS

HONOAPIILANI HIGHWAY REALIGNMENT, PHASE 1A
Future Keawe St Extension to Lahainaluna Rd
Part A: Off Ramp Mass Grading
Fed. Aid Proj. No. NH-030-1(35)R
Scale: As Noted Date: April, 2009


FED. ROAD DIST. NO.	STATE	FED. AID PROJ. NO.	FISCAL YEAR	SHEET NO.	TOTAL SHEETS
HAWAII	HAW.	NH-030-1(35)R	2009	144	286

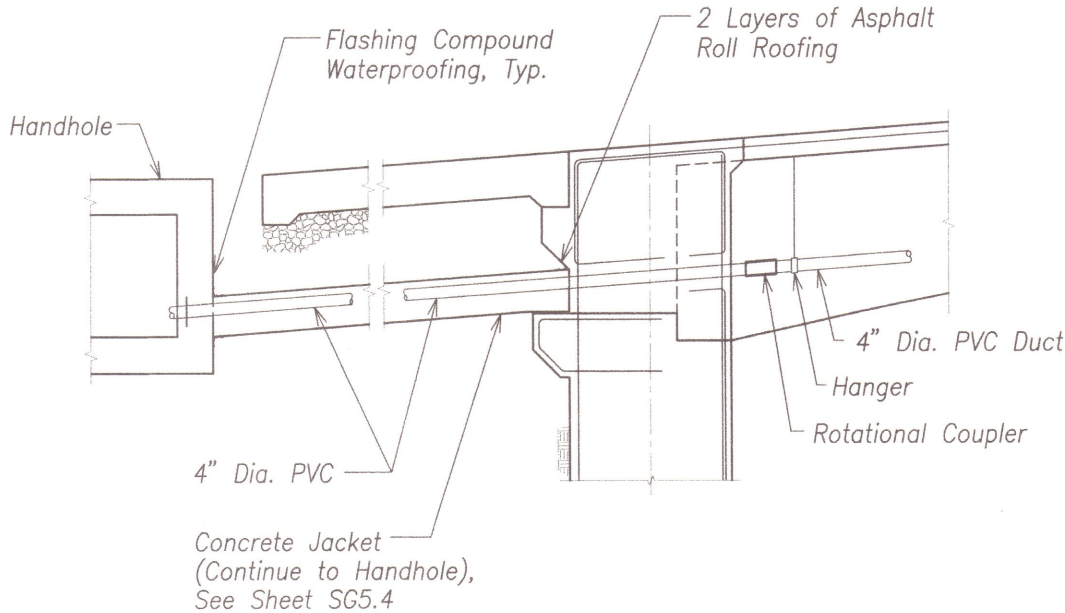

Note:
See Electrical Plans for couplers.


4" DIA. DUCTS THROUGH ABUTMENT A
Scale: 3/8" = 1'-0" SG2.5 | SG2.5

- Notes:
1. Stainless Steel shall not be in contact with dissimilar metals.
 2. Place 4" dia. duct supports 1'-0" from faces of abutments and 1'-0" each side of diaphragm. Remainder of supports shall be placed at 8'-0" max. verify locations w/ electrical.
 3. Contractor shall submit shop drawings of 4" dia. ducts supports.

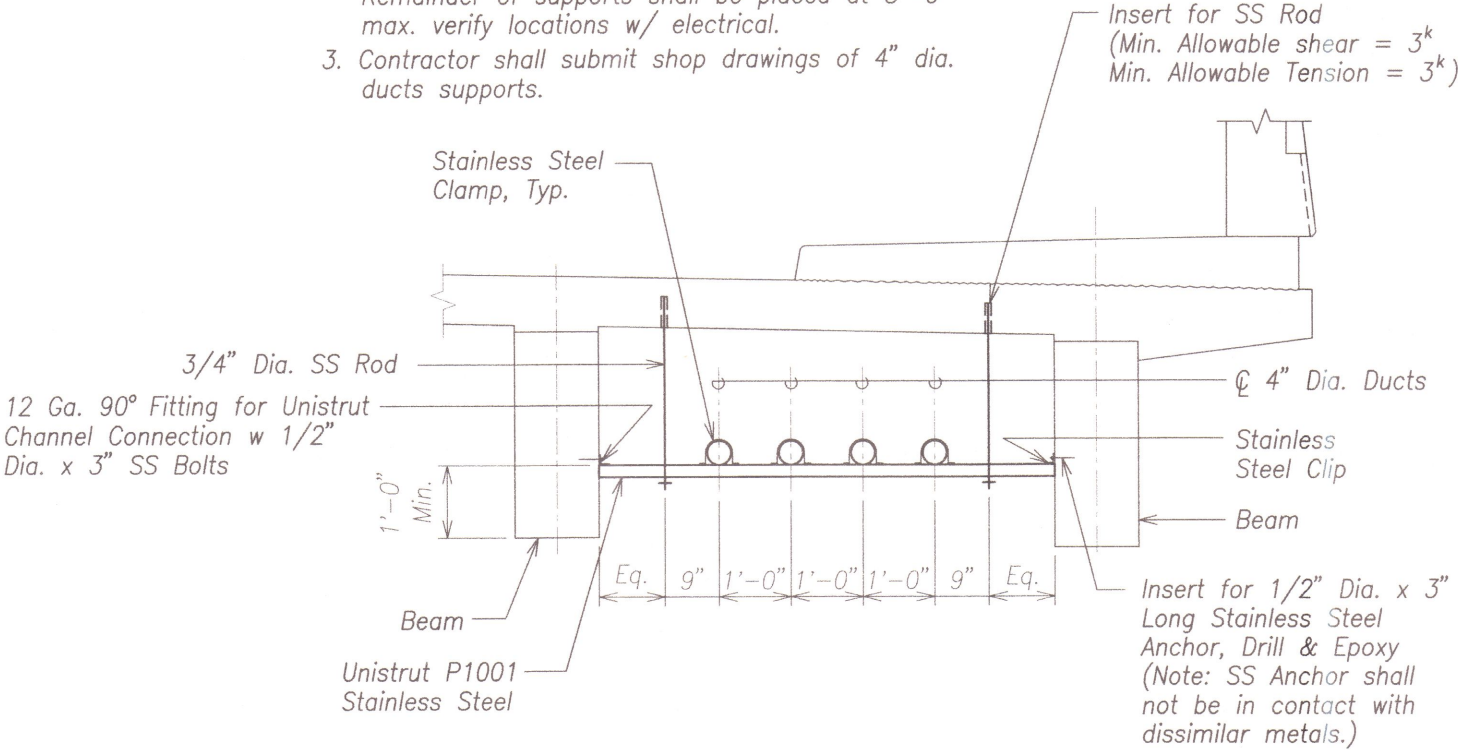

SECTION B
Scale: 3/4" = 1'-0" SG2.5 | SG2.5

ORIGINAL PLAN	SURVEY PLOTTED BY	DATE
NOTE BOOK	DESIGNED BY	
No.	CHECKED BY	

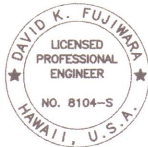

THIS WORK WAS PREPARED BY ME
OR UNDER MY SUPERVISION.


David K. Fujiwara
KSF, INC. APRIL 30, 2010
LIC. EXP. DATE

STATE OF HAWAII
DEPARTMENT OF TRANSPORTATION
HIGHWAYS DIVISION

4 INCH DIA. DUCT SUPPORT DETAILS
HONOAPIILANI HIGHWAY REALIGNMENT, PHASE 1A
Future Keawe St Extension to Lahainaluna Rd
Part A: Off Ramp Mass Grading
Fed. Aid Proj. No. NH-030-1(35)R
Scale: As Noted Date: April, 2009



POST-TENSIONING SEQUENCE

Girder No.	Tendon	Tendon Design Jacking Force (Kips)	
		Stage 1	Stage 2
G-5	T1	483	966
G-4	T1	483	966
G-6	T1	483	966
G-3	T1	483	966
G-7	T1	483	966
G-2	T1	483	966
G-8	T1	483	966
G-1	T1	483	966
G-9	T1	483	966
G-5	T2	483	966
G-4	T2	483	966
G-6	T2	483	966
G-3	T2	483	966
G-7	T2	483	966
G-2	T2	483	966
G-8	T2	483	966
G-1	T2	483	966
G-9	T2	483	966


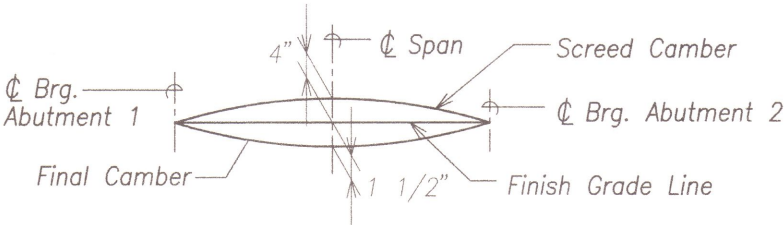


POST TENSIONING NOTES:

1. Post-tensioning ducts shall be 4 3/8" O.D. Spiro-Type Semi-Rigid galvanized.
2. After post-tensioning, all post-tensioning ducts tendons shall be pressure grouted w/ pre-packaged grout as specified in Specification Section 504.03 (H) (5) Grouting. Ducts shall have grouting vents at anchorages and at each high point along the tendon profile.
3. Duct shall be secured to prevent misalignment during concreting.
4. A minimum compressive strength of 8000 PSI shall be obtained in the beam and deck before the application of post tensioning.
5. Post tensioned strands shall be 7 wire 0.6 dia. low relaxation steel strands (Area = 0.217 in.²) with an ultimate tensile strength of 270 ksi conforming to ASTM A416.
6. The post tensioning design assumptions are as follows:
Curve Friction Coefficient 0.18
Wobble Friction Coefficient 0.0002/ft.
Anchor Set 3/8"
7. The design jacking force at end of each tendon = 966 k. The maximum stress in the strand before anchor set in is 75% of the guaranteed ultimate strength.
8. Post tensioning anchor shall be AVAR ACS 22 x 6 or equal.
9. Jacking symbols are as follows:
↗ Jacking end
↖ Dead end

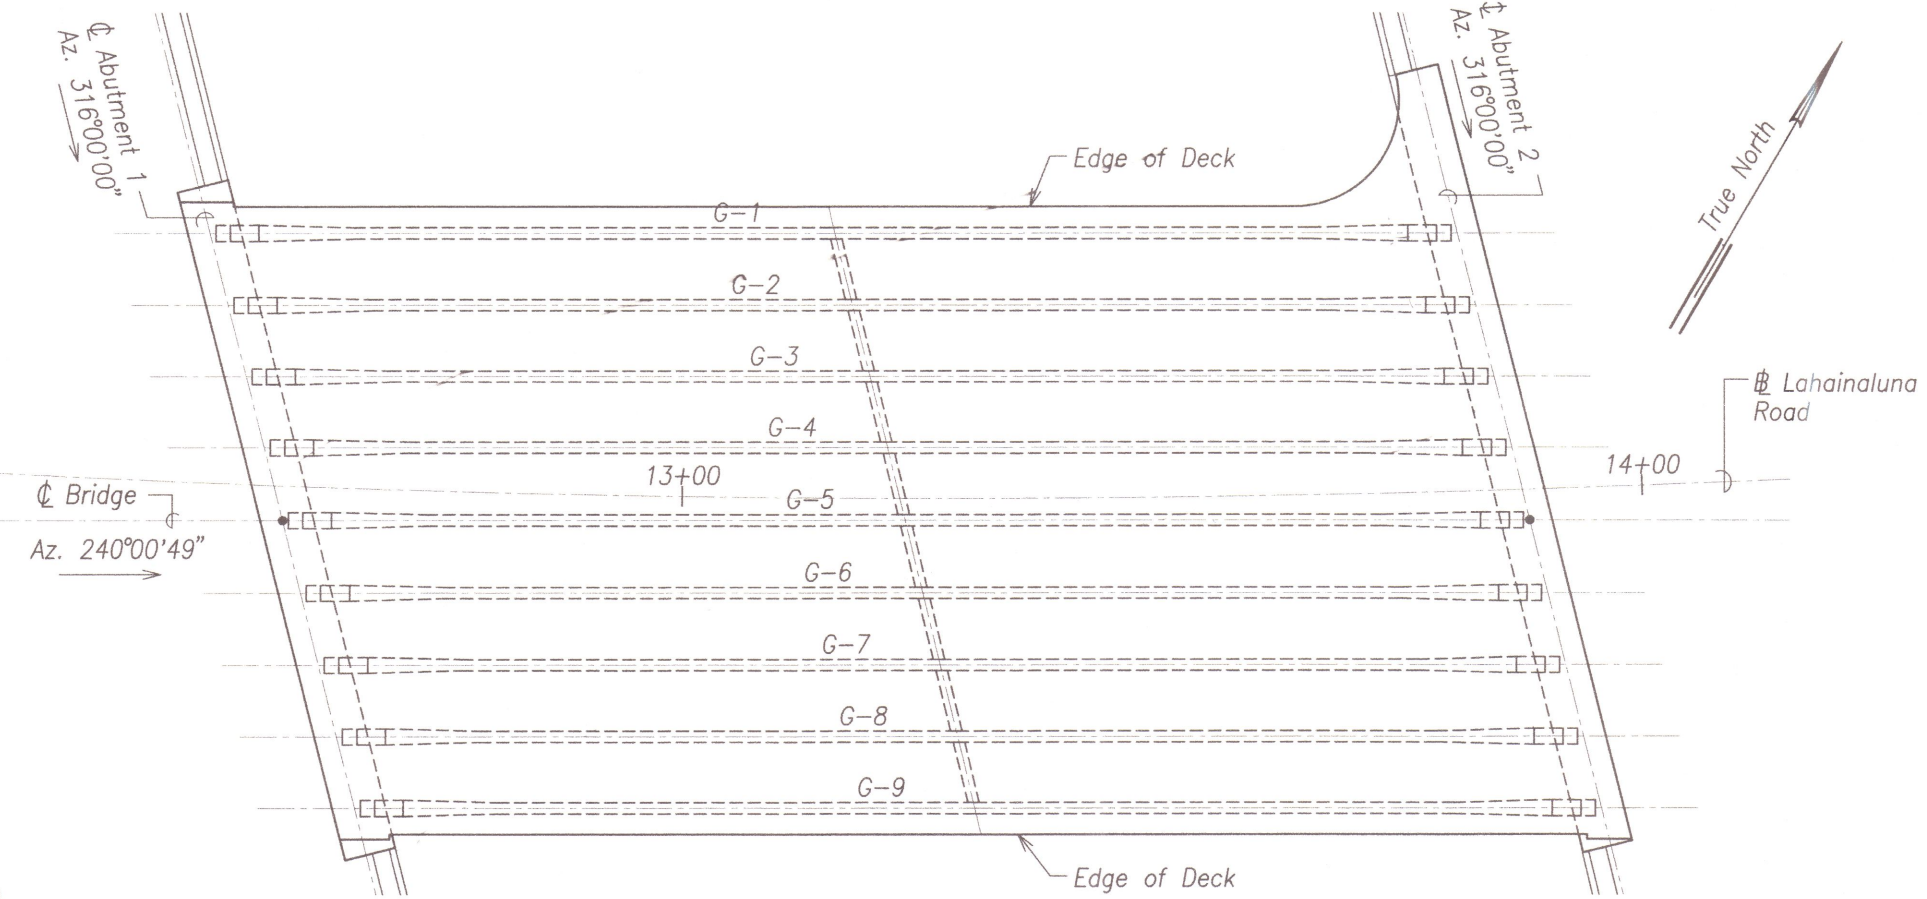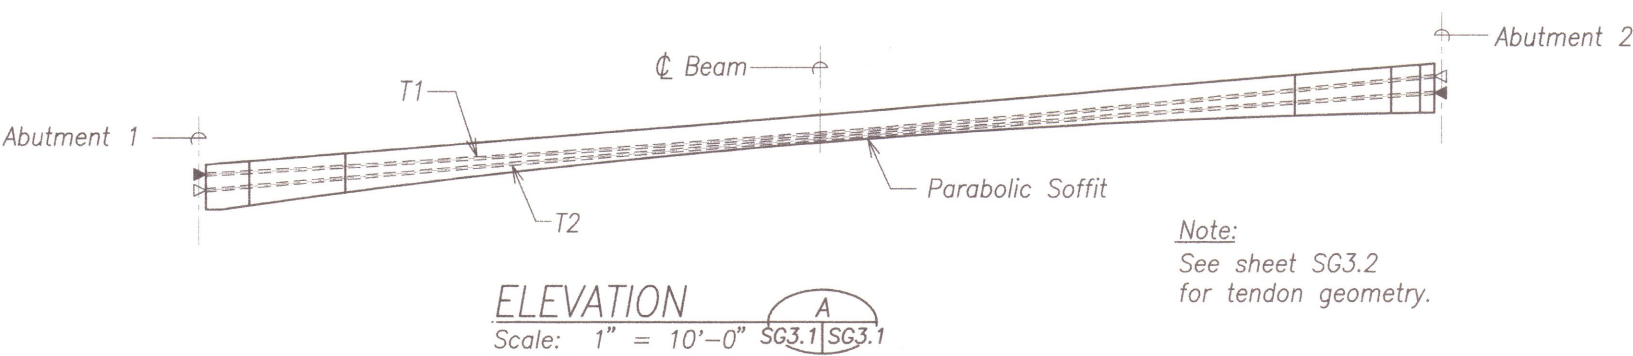

10. Apply corrosion inhibitor amine carboxylate powder (Cortec MCI-309) in all post-tension ducts.
11. The minimum force in prestressing steel shall not be less than shown in table above.
The force in the prestressing steel shall be considered as the smaller of the two values as determined by the measured elongation and the gage pressure. If the difference in stress as obtained by the measured elongation and the measured gage pressure exceeds 5 percent of the required prestressing force, the stressing process shall be terminated and shall not resume until the Contractor submits data indicating the cause of such difference and makes corrections, approved by the Engineer, to rectify such difference.
12. Prevent ducts, at all times, from getting plugged or damaged. Ducts shall be checked to show that ducts are clear and contain no obstructions prior to installing prestressing steel and stressing the member.
13. Extend 8 strands in each T2 tendon at each end 3'-0".

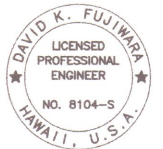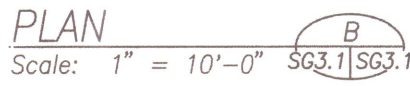

THIS WORK WAS PREPARED BY ME OR UNDER MY SUPERVISION.
APRIL 30, 2010
LIC. EXP. DATE

STATE OF HAWAII
DEPARTMENT OF TRANSPORTATION
HIGHWAYS DIVISION

BEAM POST-TENSIONING

HONOAPIILANI HIGHWAY REALIGNMENT, PHASE 1A
Future Keawe St Extension to Lahainaluna Rd
Part A: Off Ramp Mass Grading
Fed. Aid Proj. No. NH-030-1(35)R




Scale: As Noted Date: April, 2009

SHEET No. SG3.1 OF 8 SHEETS


FED. ROAD DIST. NO.	STATE	FED. AID PROJ. NO.	FISCAL YEAR	SHEET NO.	TOTAL SHEETS
HAWAII	HAW.	NH-030-1(35)R	2009	146	286

Legend:

- ↔ Jacking end
- ▶ Dead end

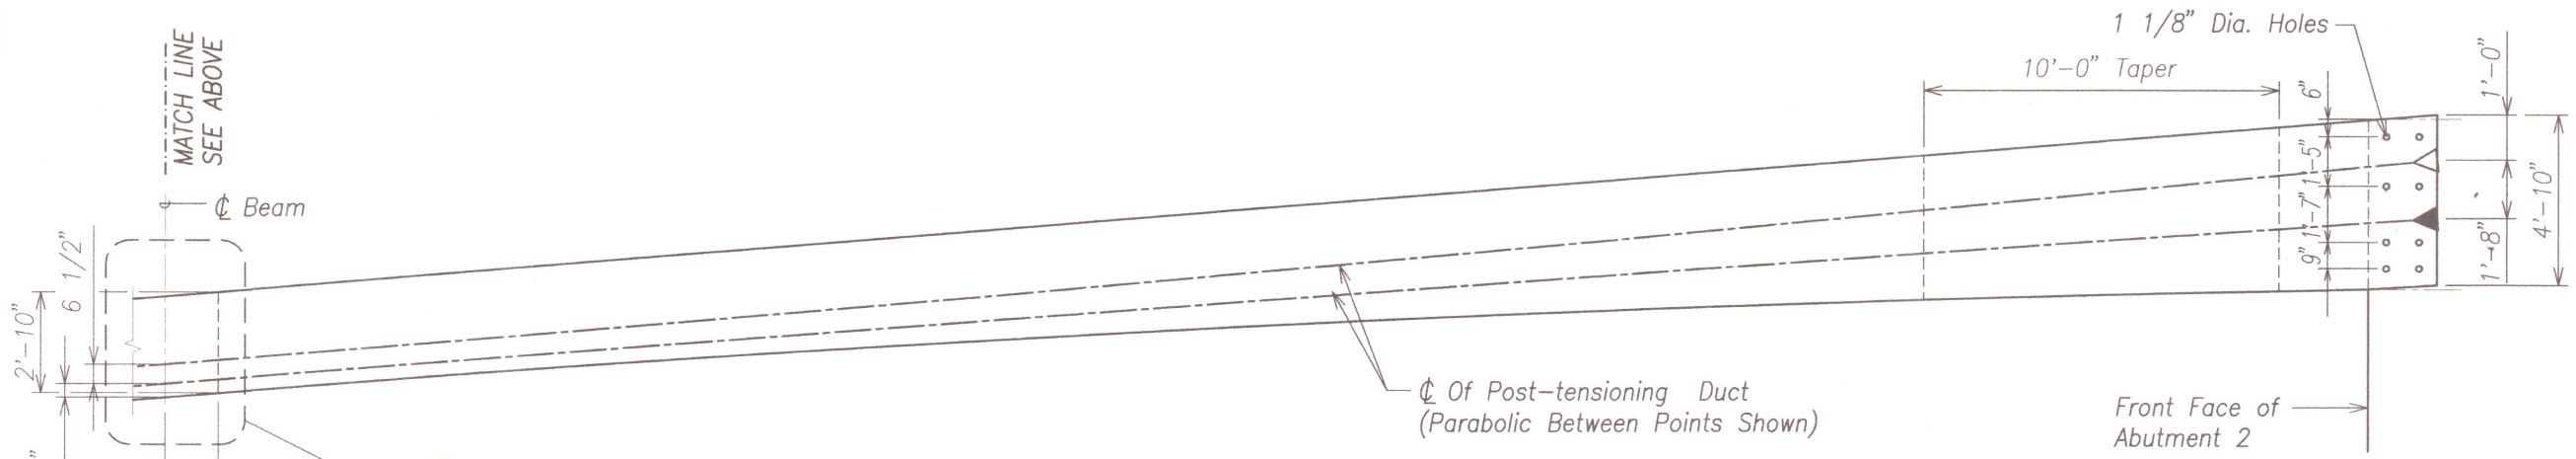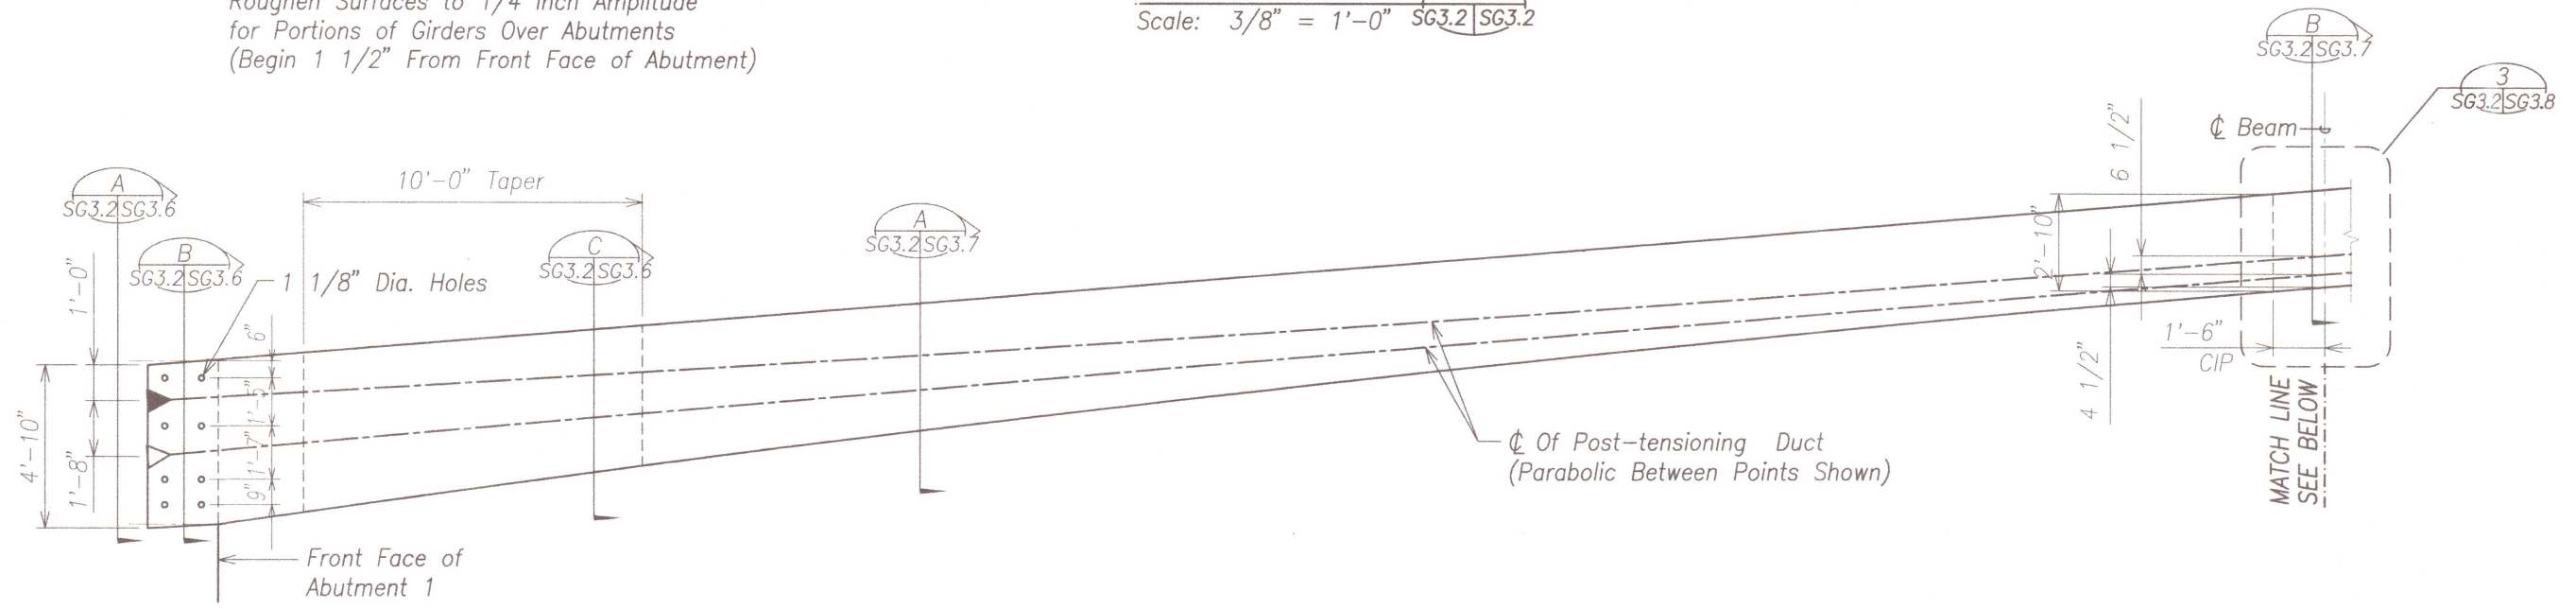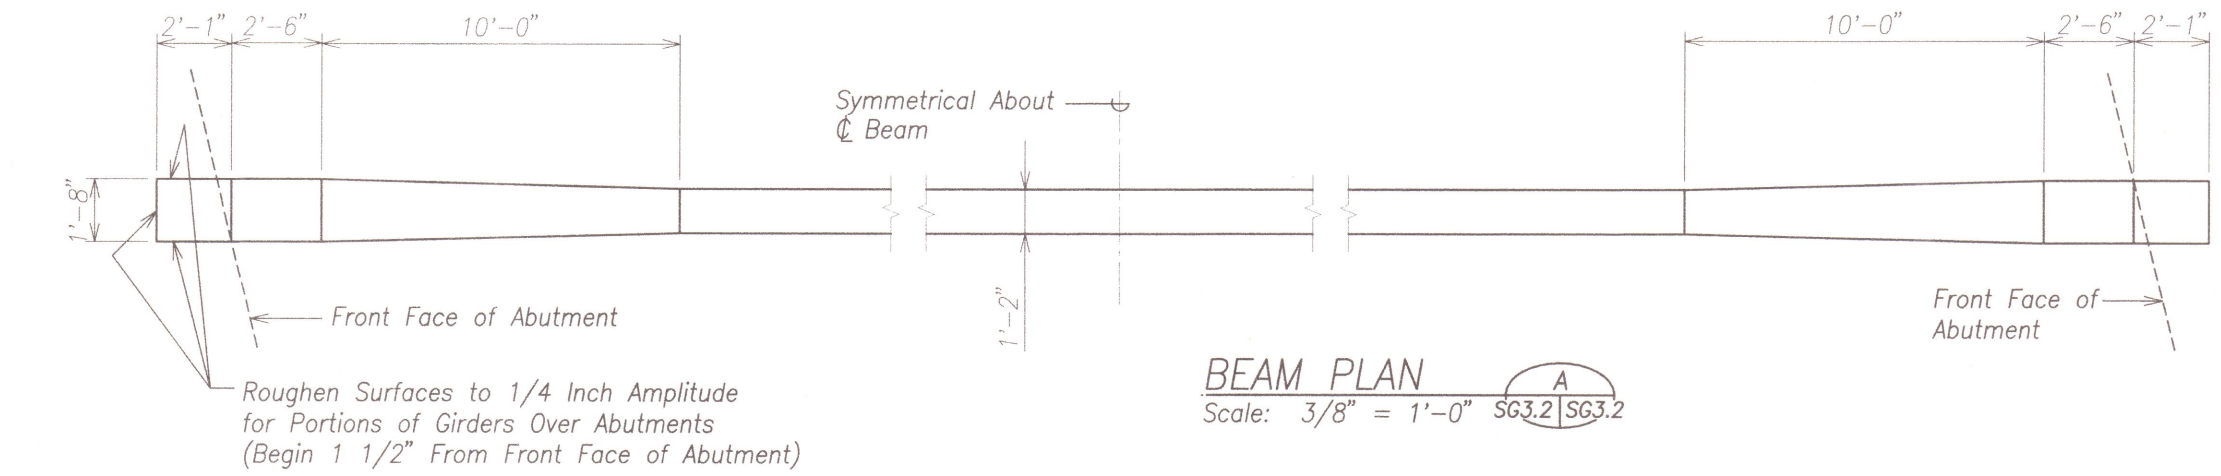

DATE	_____
SURVEY PLOTTED BY	_____
DESIGNED BY	_____
QUANTITIES BY	_____
CHECKED BY	_____
NOTE BOOK	_____
No.	_____

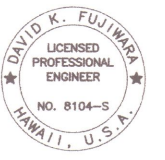

THIS WORK WAS PREPARED BY ME OR UNDER MY SUPERVISION.
APRIL 30, 2010
LIC. EXP. DATE


STATE OF HAWAII
DEPARTMENT OF TRANSPORTATION
HIGHWAYS DIVISION

BEAM PLAN AND ELEVATION

HONOAHIILANI HIGHWAY REALIGNMENT, PHASE 1A
Future Keawe St Extension to Lahainaluna Rd
Part A: Off Ramp Mass Grading
Fed. Aid Proj. No. NH-030-1(35)R
Scale: As Noted Date: April, 2009

SHEET No. SG3.2 OF 8 SHEETS

FED. ROAD DIST. NO.	STATE	FED. AID PROJ. NO.	FISCAL YEAR	SHEET NO.	TOTAL SHEETS
HAWAII	HAW.	NH-030-1(35)R	2009	147	286

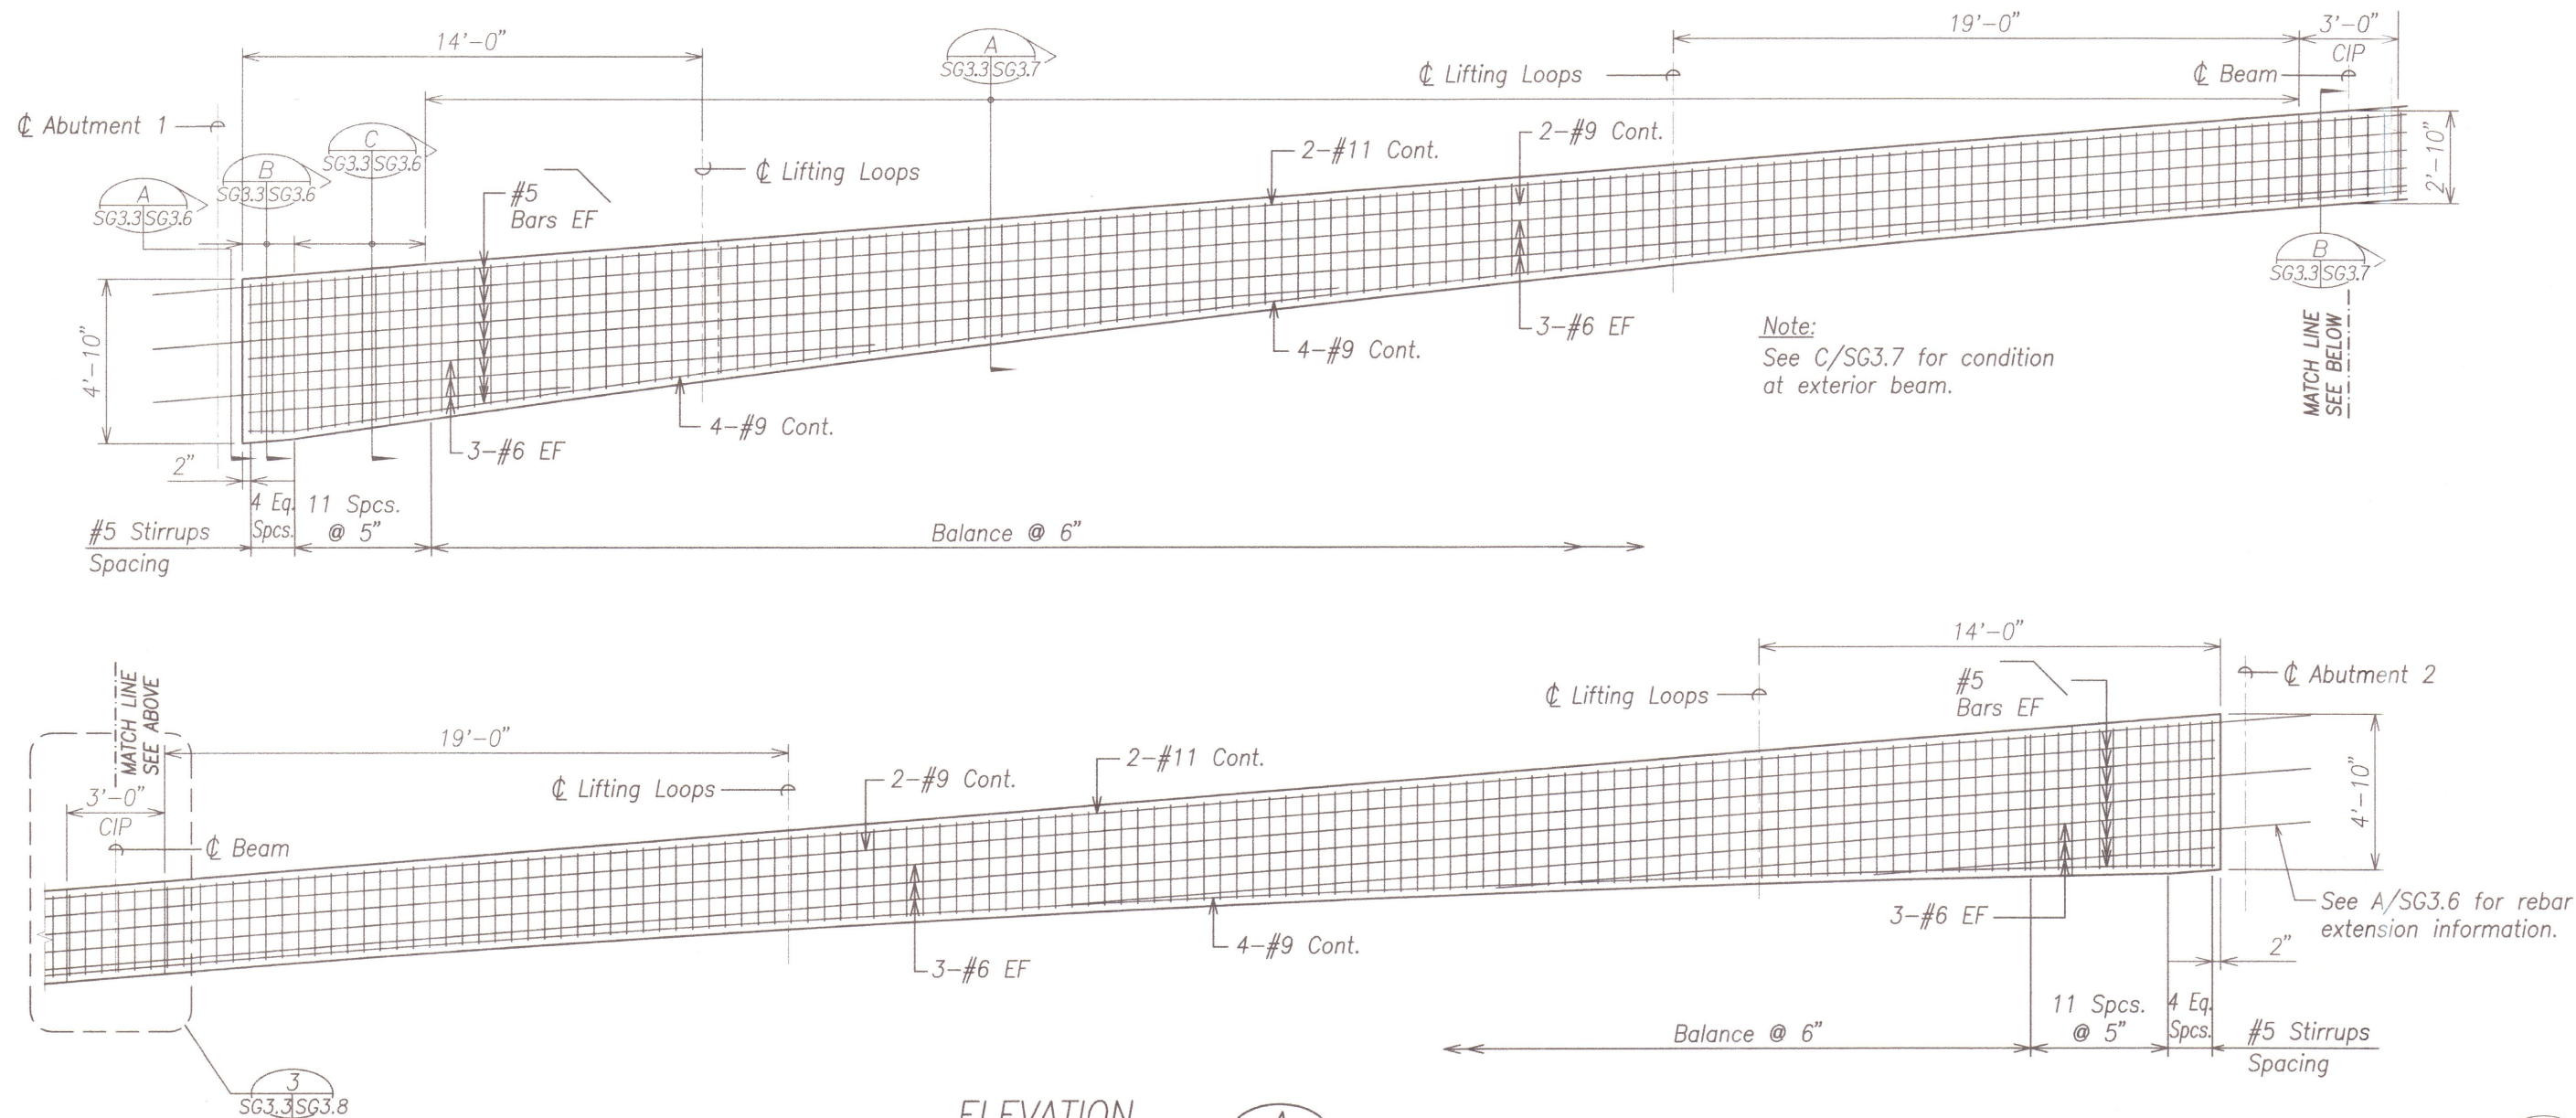

ELEVATION
Scale: 3/8" = 1'-0" SG3.3/SG3.3



THIS WORK WAS PREPARED BY ME
OR UNDER MY SUPERVISION.

David K. Fujiwara
KSF, INC. APRIL 30, 2010
LIC. EXP. DATE

STATE OF HAWAII
DEPARTMENT OF TRANSPORTATION
HIGHWAYS DIVISION


BEAM ELEVATION

HONOAPIILANI HIGHWAY REALIGNMENT, PHASE 1A
Future Keawe St Extension to Lahainaluna Rd
Part A: Off Ramp Mass Grading
Fed. Aid Proj. No. NH-030-1(35)R
Scale: As Noted Date: April, 2009


SHEET No. SG3.3 OF 8 SHEETS

ORIGINAL PLAN	DATE
SURVEY PLOTTED BY	
DRAWN BY	
DESIGNED BY	
QUANTITIES BY	
CHECKED BY	
No.	


FED. ROAD DIST. NO.	STATE	FED. AID PROJ. NO.	FISCAL YEAR	SHEET NO.	TOTAL SHEETS
HAWAII	HAW.	NH-030-1(35)R	2009	148	286

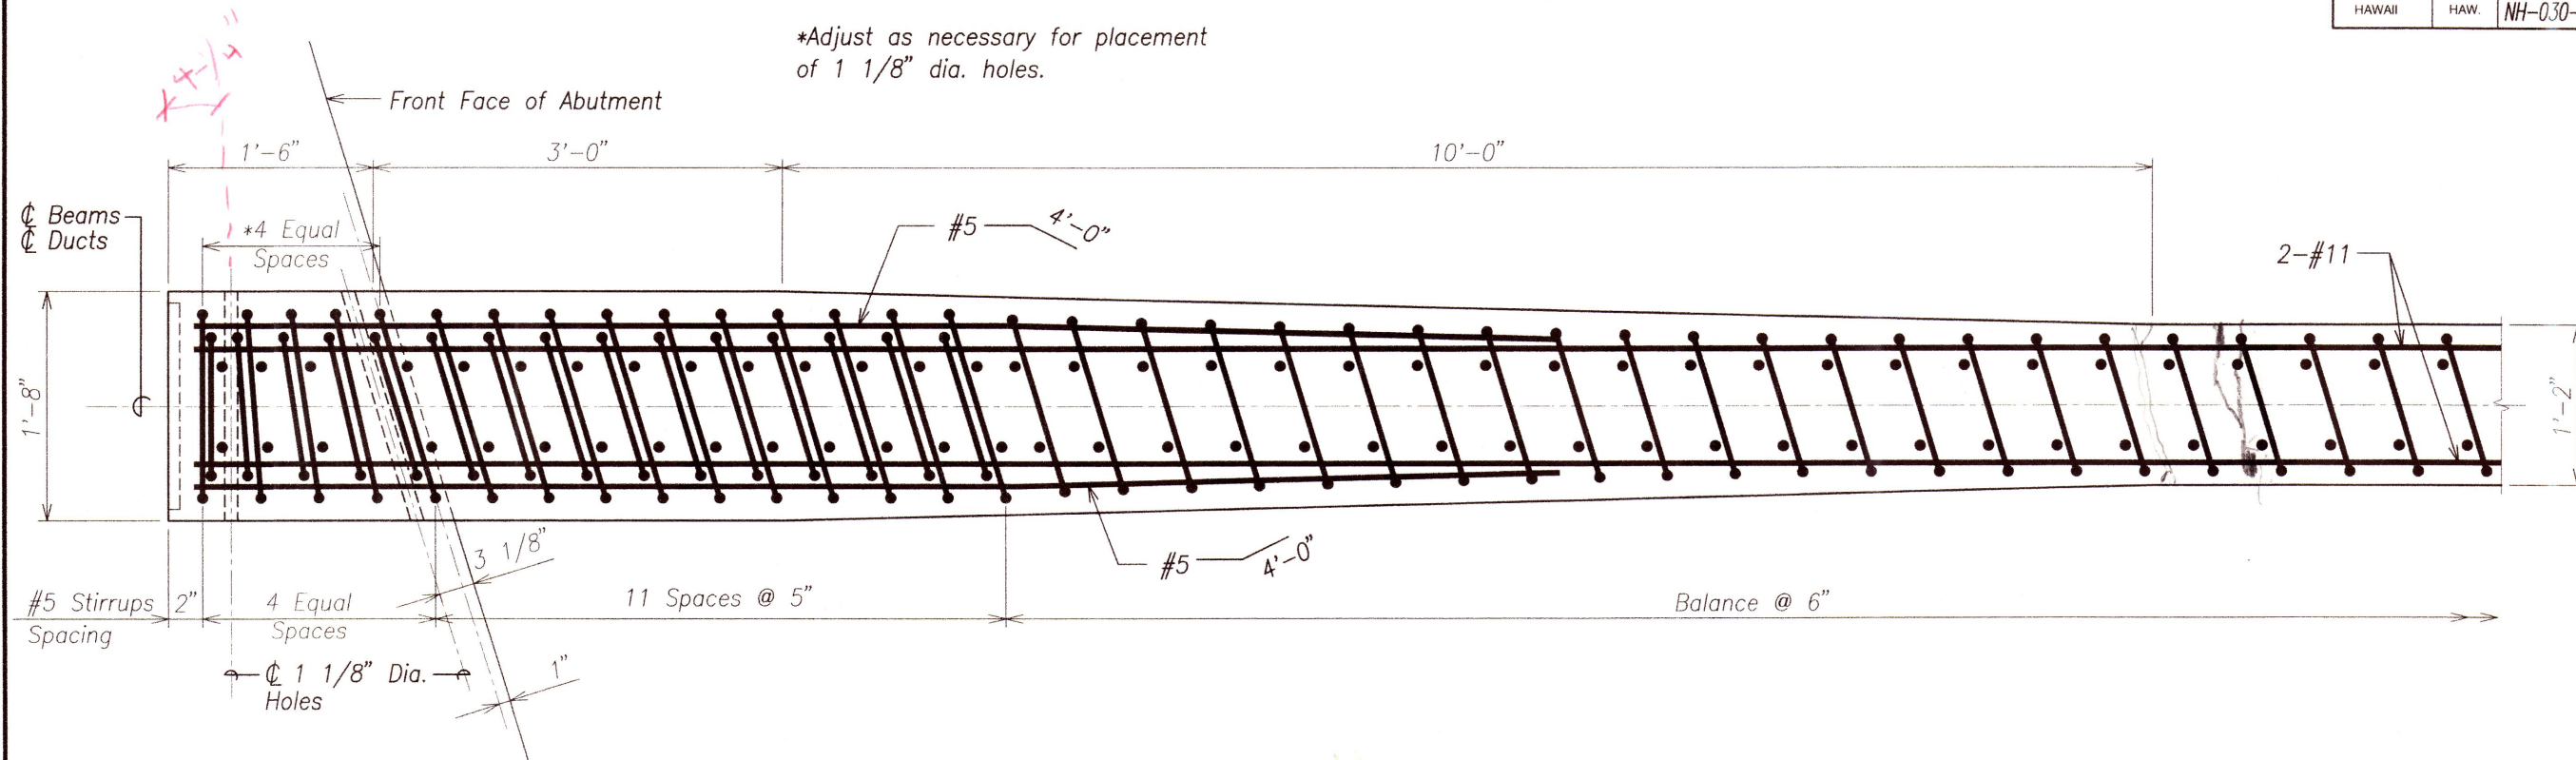

SECTION AT TOP OF BEAM A
Scale: 1 1/2" = 1'-0" SG3.4 SG3.4

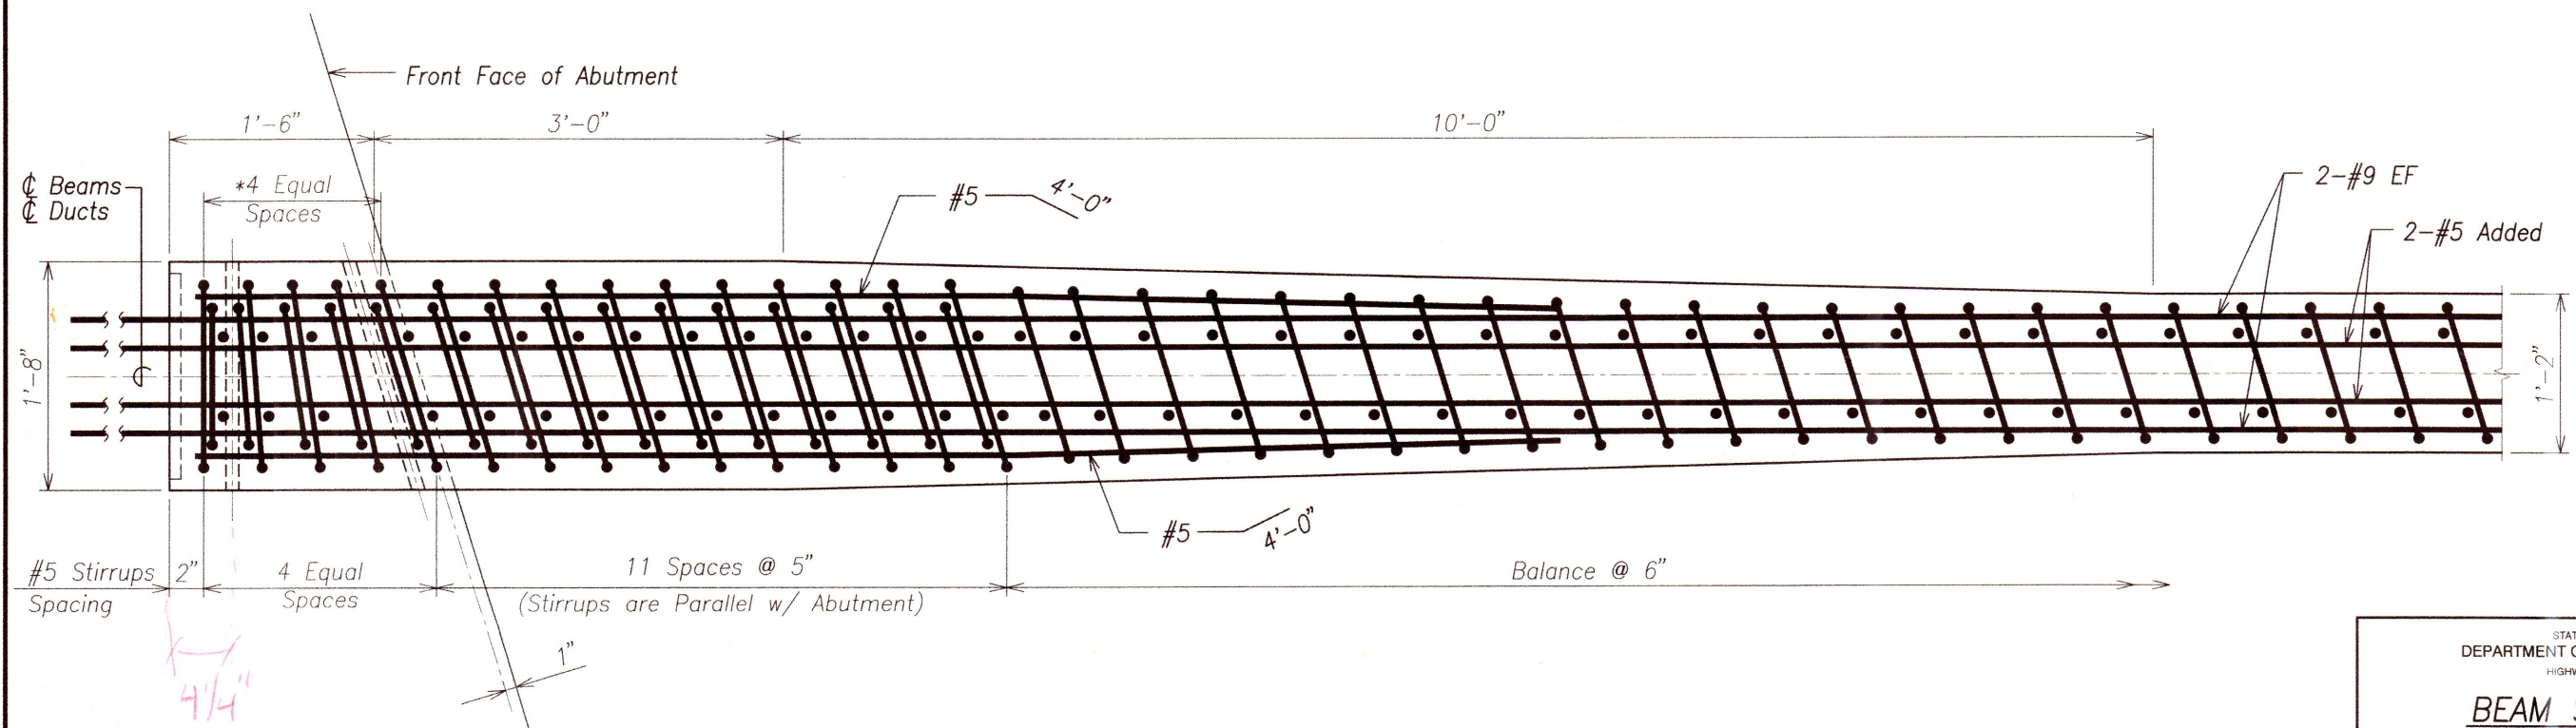

SECTION AT BOTTOM OF BEAM B
Scale: 1 1/2" = 1'-0" SG3.4 SG3.4

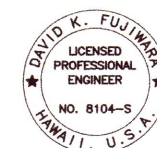

THIS WORK WAS PREPARED BY ME
OR UNDER MY SUPERVISION.
David K. Fujiwara
KSF, INC. APRIL 30, 2010
LIC. EXP. DATE

STATE OF HAWAII
DEPARTMENT OF TRANSPORTATION
HIGHWAYS DIVISION


BEAM SECTIONS

HONOAPIILANI HIGHWAY REALIGNMENT, PHASE 1A
Future Keawe St Extension to Lahainaluna Rd
Part A: Off Ramp Mass Grading
Fed. Aid Proj. No. NH-030-1(35)R
Scale: As Noted Date: April, 2009

SHEET No. SG3.4 OF 8 SHEETS

ORIGINAL PLAN	DATE
DESIGNED BY	
CHECKED BY	
NOTED BY	
QUANTITIES BY	
NO.	

FED. ROAD DIST. NO.	STATE	FED. AID PROJ. NO.	FISCAL YEAR	SHEET NO.	TOTAL SHEETS
HAWAII	HAW.	NH-030-1(35)R	2009	149	286

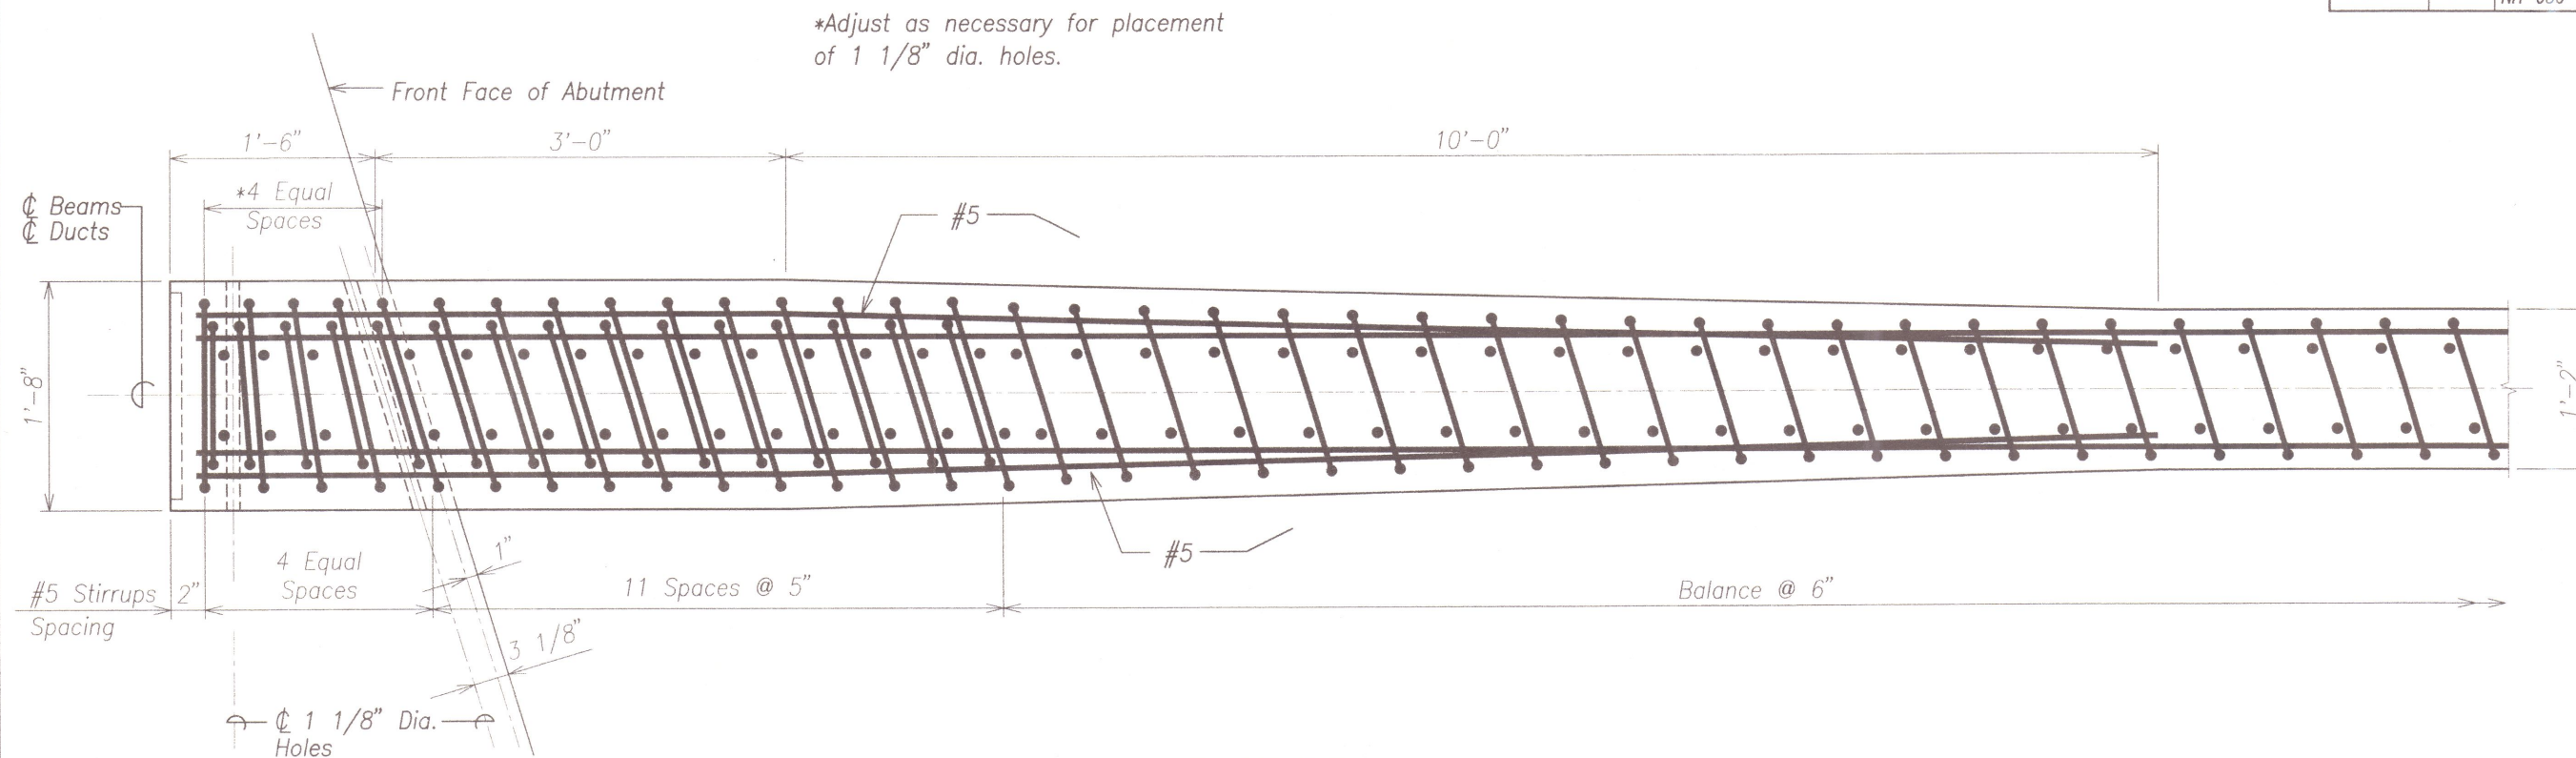


SECTION THROUGH MIDDLE OF BEAM

Scale: 1 1/2" = 1'-0"

A
SG3.5 | SG3.5

ORIGINAL PLAN	DATE
DESIGNED BY	
CHECKED BY	
NOTED BY	
QUANTITIES BY	
DATE	

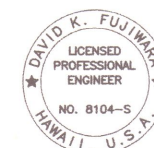

THIS WORK WAS PREPARED BY ME
OR UNDER MY SUPERVISION.

David K. Fujiwara

KSF, INC. APRIL 30, 2010
LIC. EXP. DATE

STATE OF HAWAII
DEPARTMENT OF TRANSPORTATION
HIGHWAYS DIVISION

BEAM SECTION

HONOAPIILANI HIGHWAY REALIGNMENT, PHASE 1A
Future Keawe St Extension to Lahainaluna Rd

Part A: Off Ramp Mass Grading


Fed. Aid Proj. No. NH-030-1(35)R

Scale: As Noted

Date: April, 2009

SHEET No. SG3.5 OF 8 SHEETS

FED. ROAD DIST. NO.	STATE	FED. AID PROJ. NO.	FISCAL YEAR	SHEET NO.	TOTAL SHEETS
HAWAII	HAW.	NH-030-1(35)R	2009	150	286

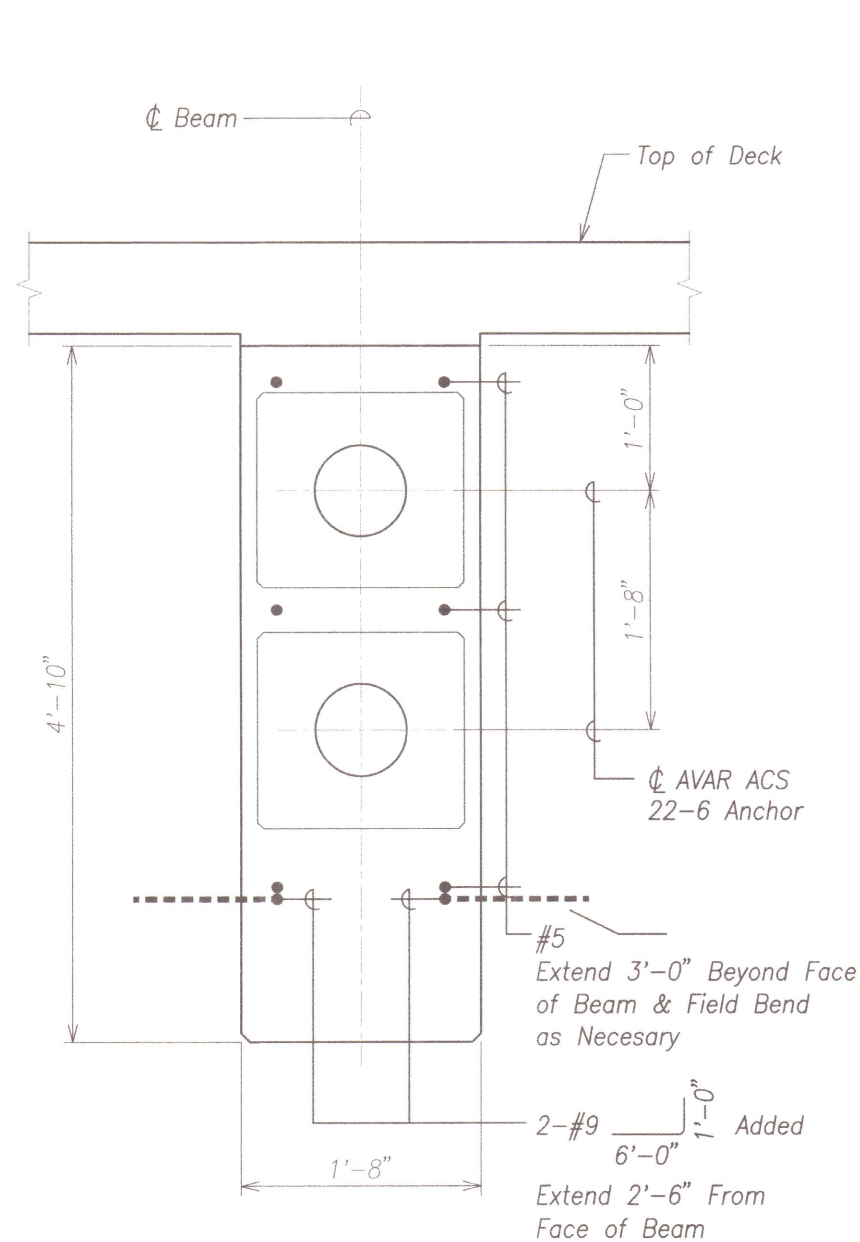


ELEVATION

Scale: $1 \frac{1}{2}'' = 1'-0''$

SG3.3 | SG3.6

SG3.2

A

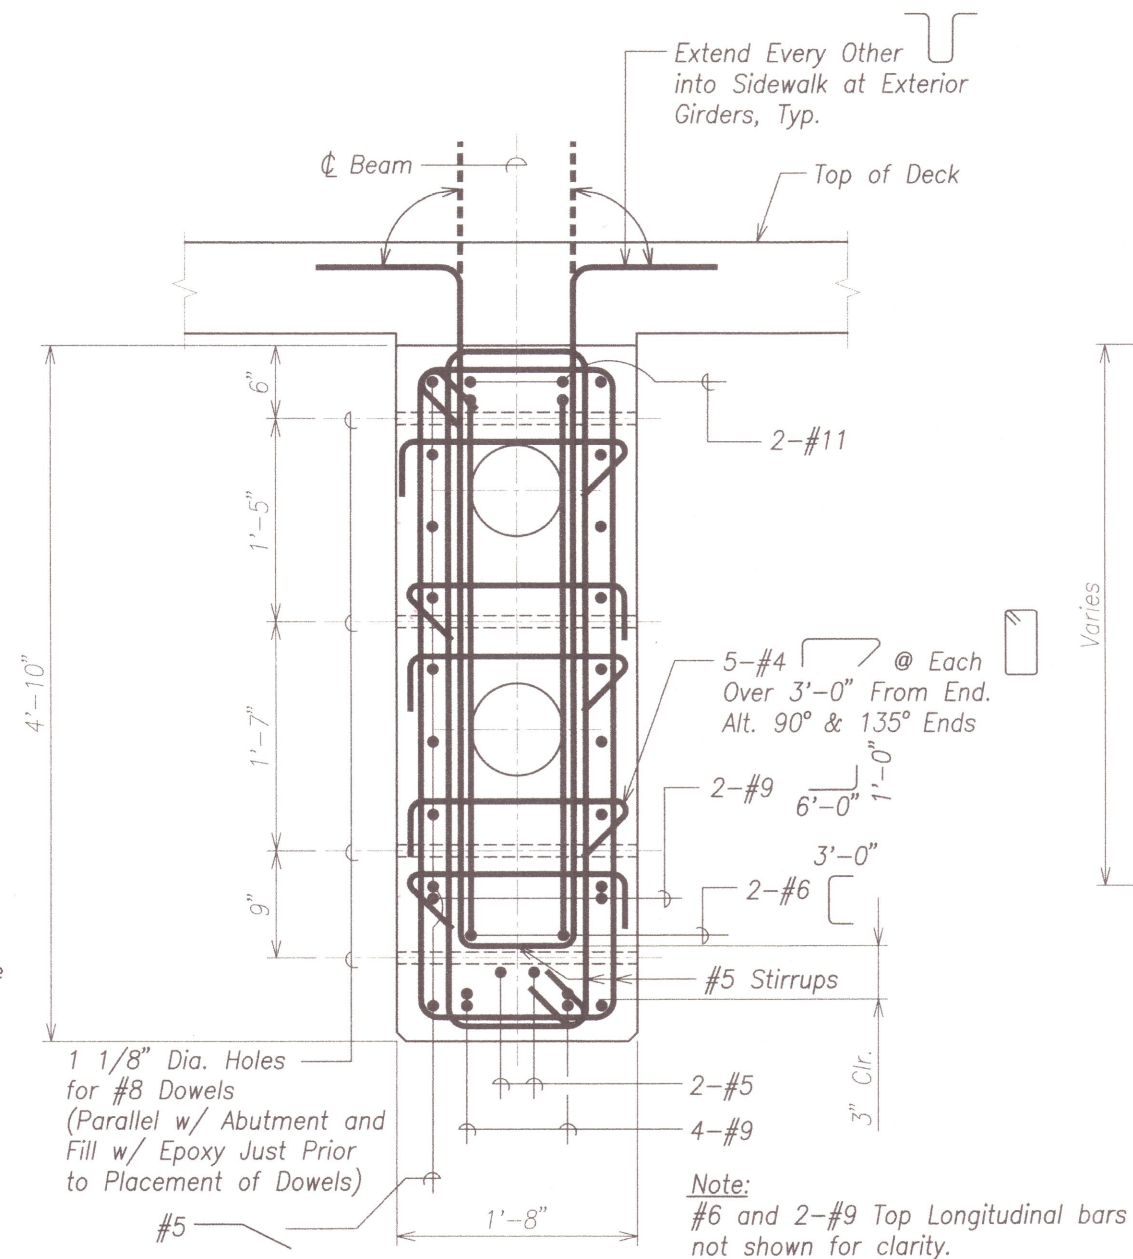


SECTION

Scale: $1 \frac{1}{2}'' = 1'-0''$

SG3.3 | SG3.6

SG3.2

B

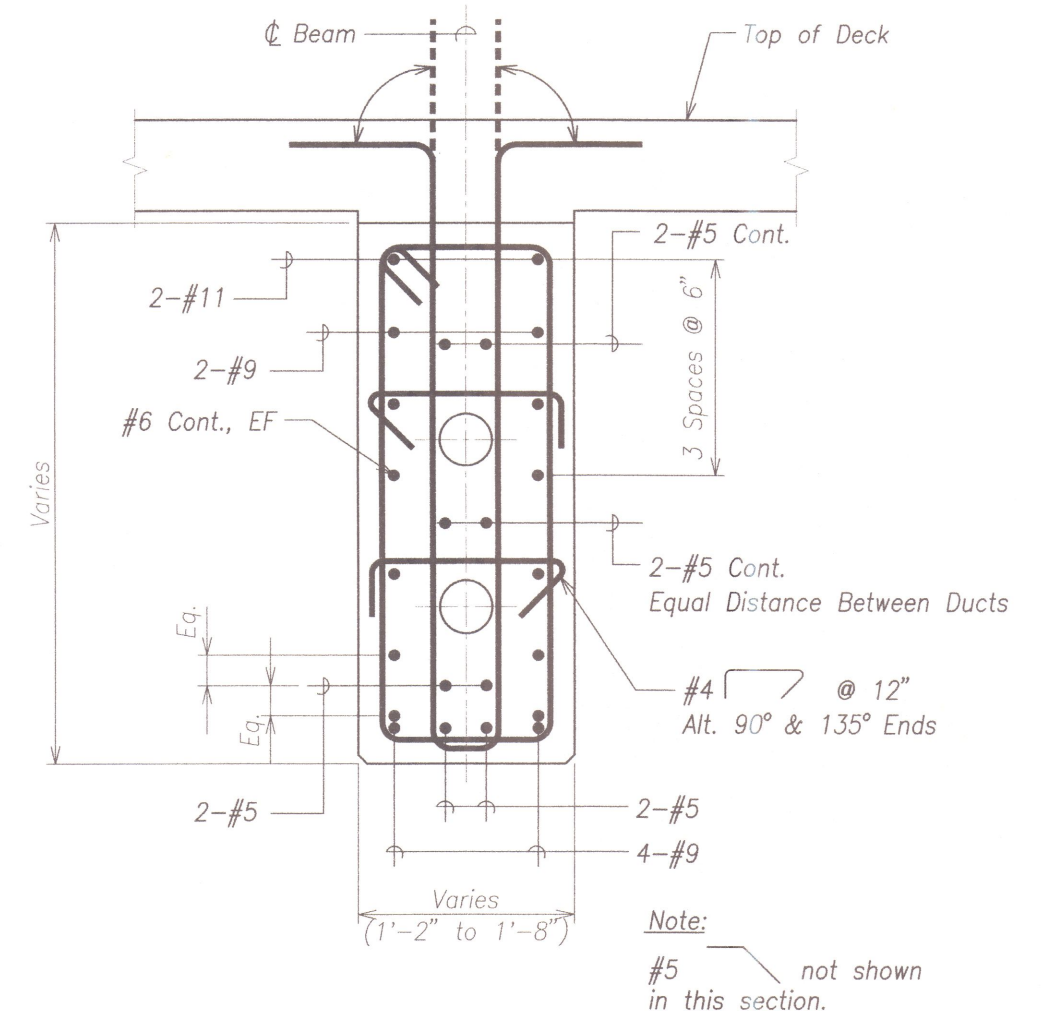

SECTION

Scale: 1 1/2" = 1'-0"

SG3.3 | SG3.6

SG3.2

C



THIS WORK WAS PREPARED BY ME
OR UNDER MY SUPERVISION.

David K. Ferguson APRIL 30, 2010
KSF, INC. LIC. EXP. DATE

STATE OF HAWAII
DEPARTMENT OF TRANSPORTATION
HIGHWAYS DIVISION

BEAM SECTIONS


HONOAPIILANI HIGHWAY REALIGNMENT, PHASE 1A
Future Keawe St Extension to Lahainaluna Rd
Part A: Off Ramp Mass Grading
Fed. Aid Proj. No. NH-030-1(35)R

Scale: As Noted Date: April, 2009


SHEET No. SG3.6 OF 8 SHEETS

ORIGINAL PLAN	SURVEY PLOTTED BY _____	DATE _____
NOTE BOOK	DRAWN BY _____	" _____
	TRACED BY _____	" _____
	DESIGNED BY _____	" _____
	QUANTITIES BY _____	" _____
No. _____	CHECKED BY _____	" _____


FED. ROAD DIST. NO.	STATE	FED. AID PROJ. NO.	FISCAL YEAR	SHEET NO.	TOTAL SHEETS
HAWAII	HAW.	NH-030-1(35)R	2009	151	379

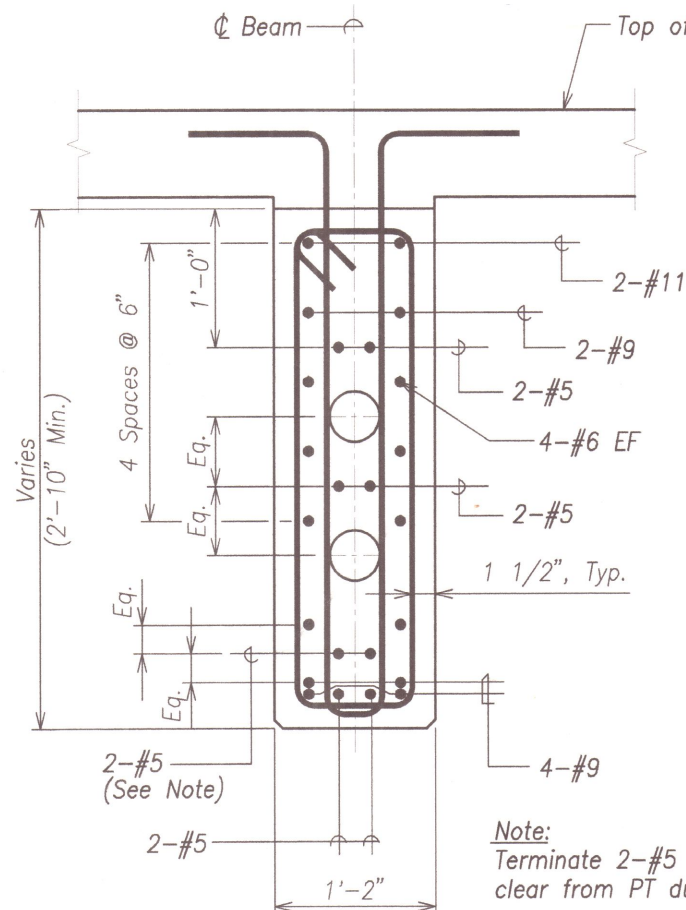


SECTION A
Scale: 1 1/2" = 1'-0"
SG3.2 | SG3.7
SG3.3

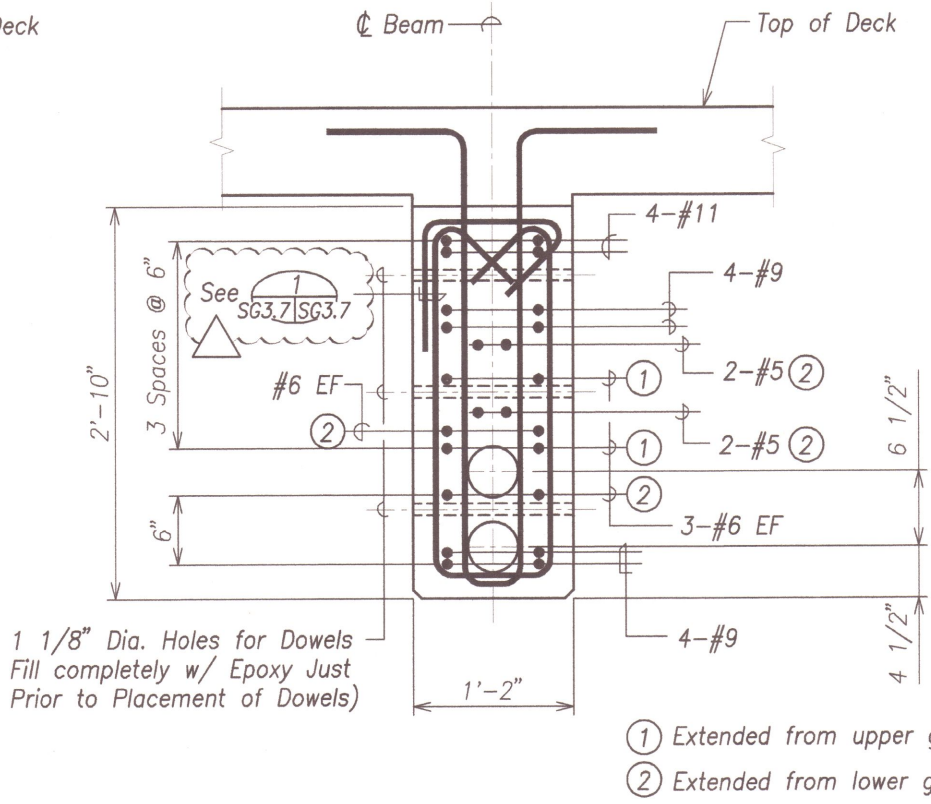

SECTION B
Scale: 1 1/2" = 1'-0"
SG3.2 | SG3.7
SG3.3

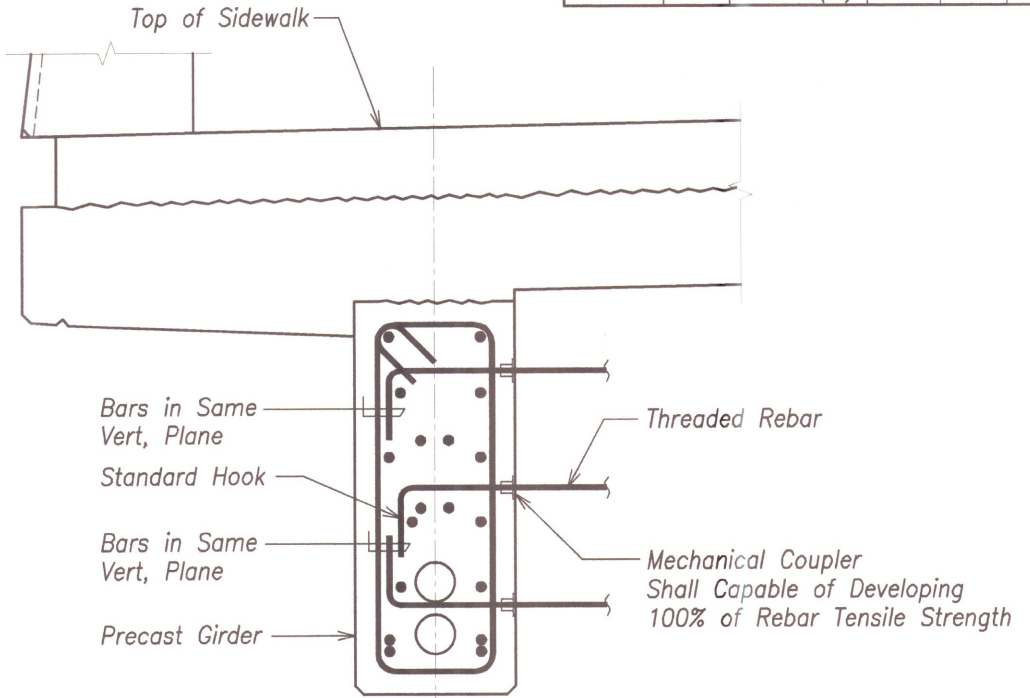

SECTION C
Scale: 1 1/2" = 1'-0"
SG3.2 | SG3.7
SG3.3

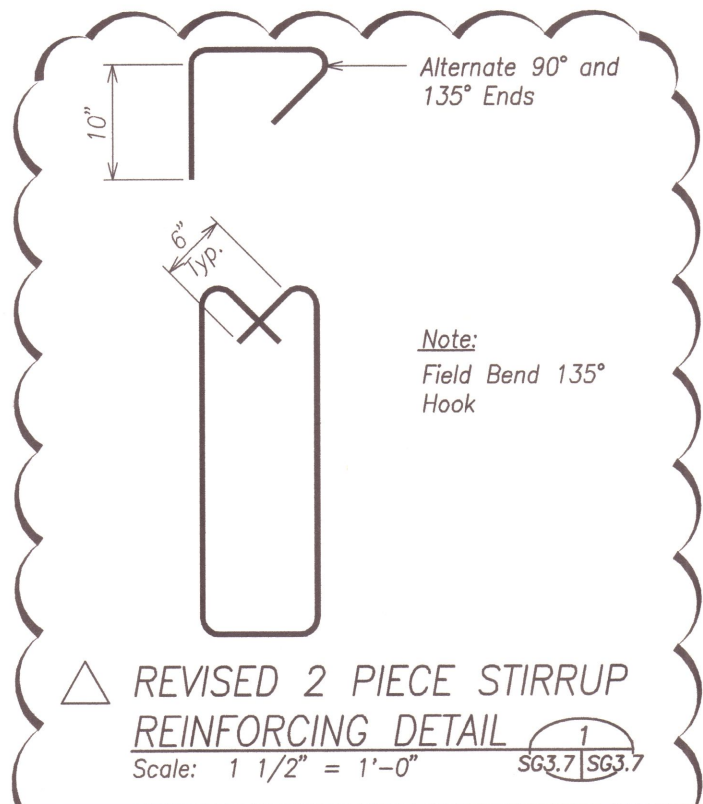

REVISED 2 PIECE STIRRUP REINFORCING DETAIL
Scale: 1 1/2" = 1'-0"
SG3.7 | SG3.7

Note:
#5 Not shown for clarity.



THIS WORK WAS PREPARED BY ME OR UNDER MY SUPERVISION.

APRIL 30, 2010
LIC. EXP. DATE

STATE OF HAWAII
DEPARTMENT OF TRANSPORTATION
HIGHWAYS DIVISION

BEAM SECTIONS


HONOAPIILANI HIGHWAY REALIGNMENT, PHASE 1A
Future Keawe St Extension to Lahainaluna Rd, Part B
Fed. Aid Proj. No. NH-030-1(35)R

Scale: As Noted


SHEET No. SG3.7 OF 8 SHEETS

DATE	REVISION
	12-04-09 Revised Reinf. Detail


FED. ROAD DIST. NO.	STATE	FED. AID PROJ. NO.	FISCAL YEAR	SHEET NO.	TOTAL SHEETS
HAWAII	HAW.	NH-030-1(35)R	2009	151	286

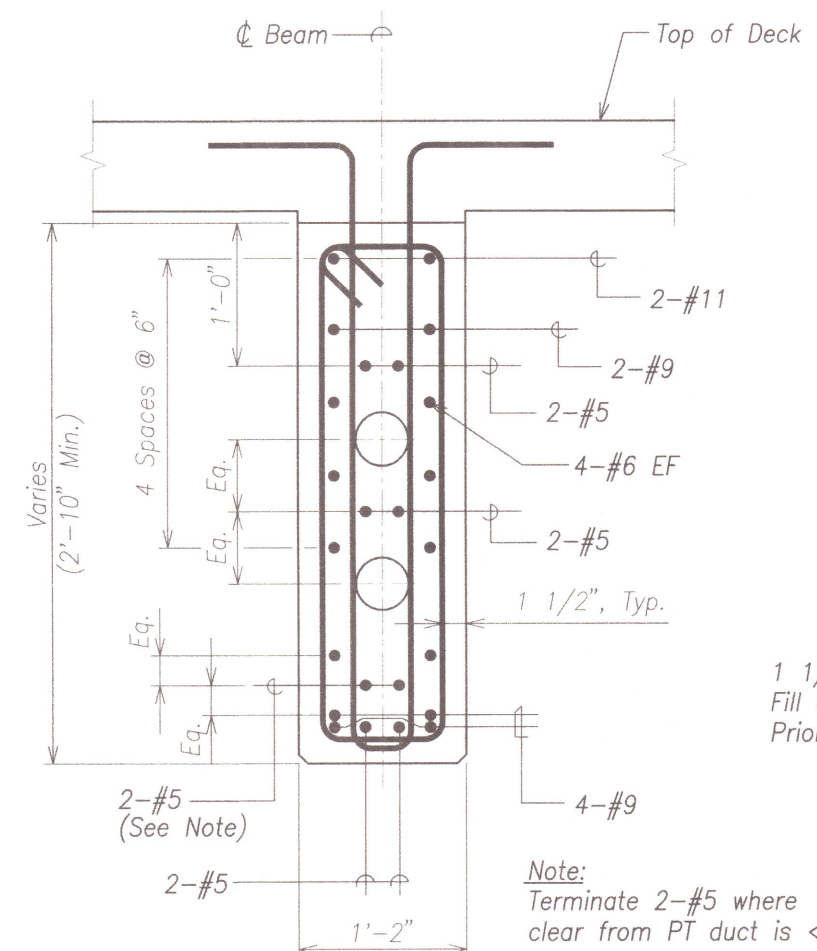

SECTION A
 Scale: 1 1/2" = 1'-0" SG3.2 | SG3.7
 SG3.3

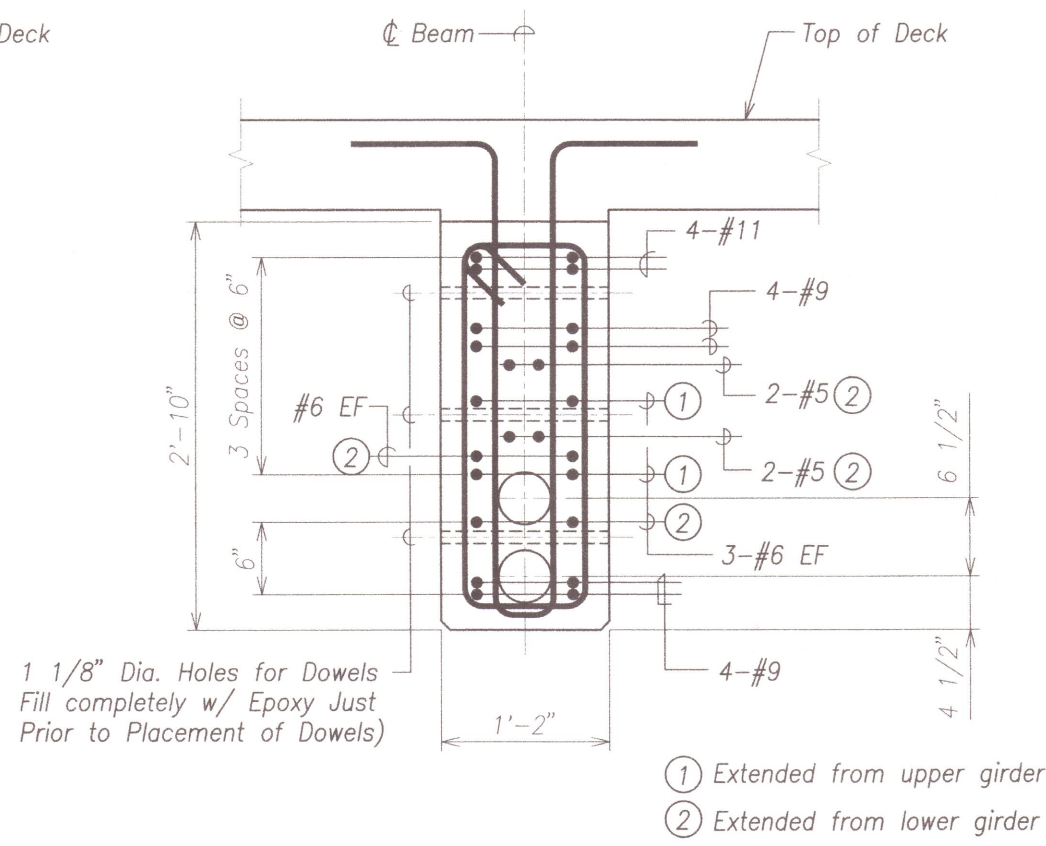

SECTION AT MID-SPAN B
 Scale: 1 1/2" = 1'-0" SG3.2 | SG3.7
 SG3.3

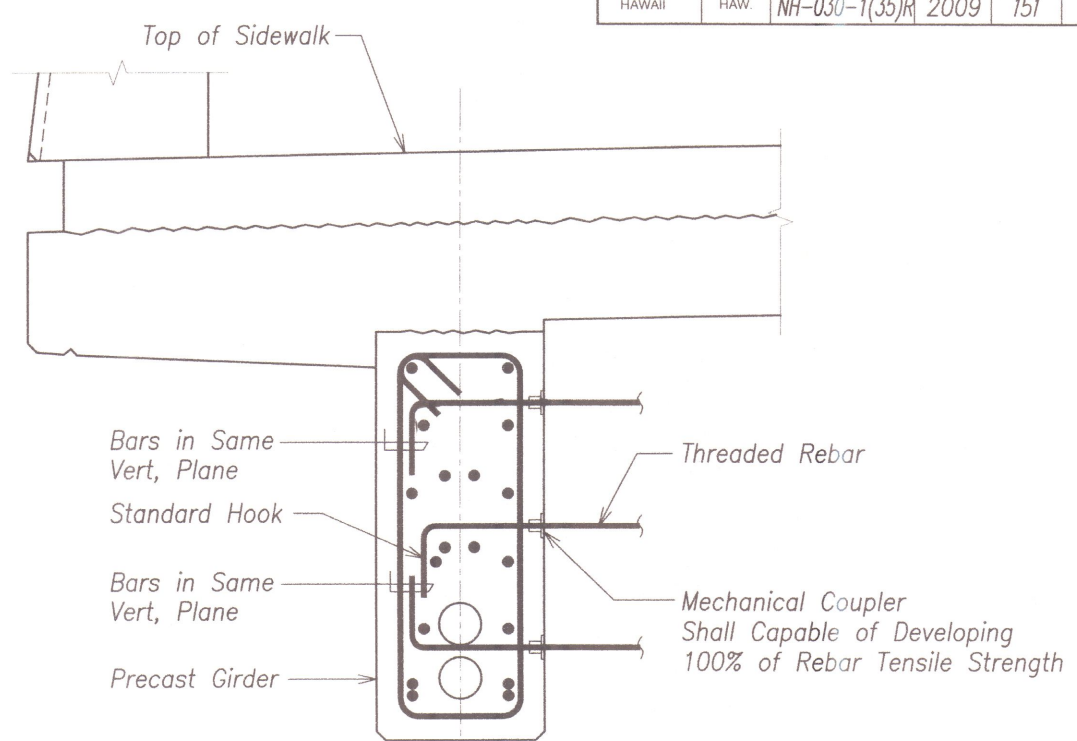

SECTION AT EXTERIOR BEAM C
 Scale: 1 1/2" = 1'-0" SG3.7 | SG3.7

Note:
 #5 Not shown for clarity.

ORIGINAL PLAN	SURVEY PLOTTED BY	DATE
NOTE BOOK	DRAWN BY	
	CHECKED BY	
	QUANTITIES BY	
	CHECKED BY	




THIS WORK WAS PREPARED BY ME OR UNDER MY SUPERVISION.
David K. Fujiwara
 KSF, INC. APRIL 30, 2010 LIC. EXP. DATE

STATE OF HAWAII
DEPARTMENT OF TRANSPORTATION
HIGHWAYS DIVISION


BEAM SECTIONS
 HONOAPIILANI HIGHWAY REALIGNMENT, PHASE 1A
 Future Keawe St Extension to Lahainaluna Rd
 Part A: Off Ramp Mass Grading
 Fed. Aid Proj. No. NH-030-1(35)R
 Scale: As Noted Date: April, 2009

SHEET No. SG3.7 OF 8 SHEETS
 Rev: 151


FED. ROAD DIST. NO.	STATE	FED. AID PROJ. NO.	FISCAL YEAR	SHEET NO.	TOTAL SHEETS
HAWAII	HAW.	NH-030-1(35)R	2009	152	286

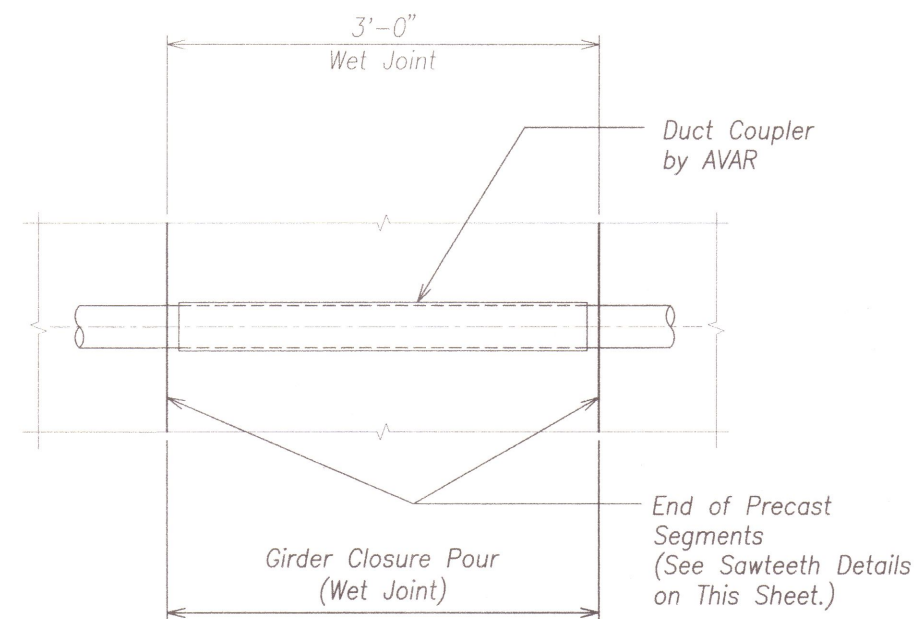

DUCT SPLICE DETAIL
Scale: 1 1/2" = 1'-0"
SG3.8 SG3.8

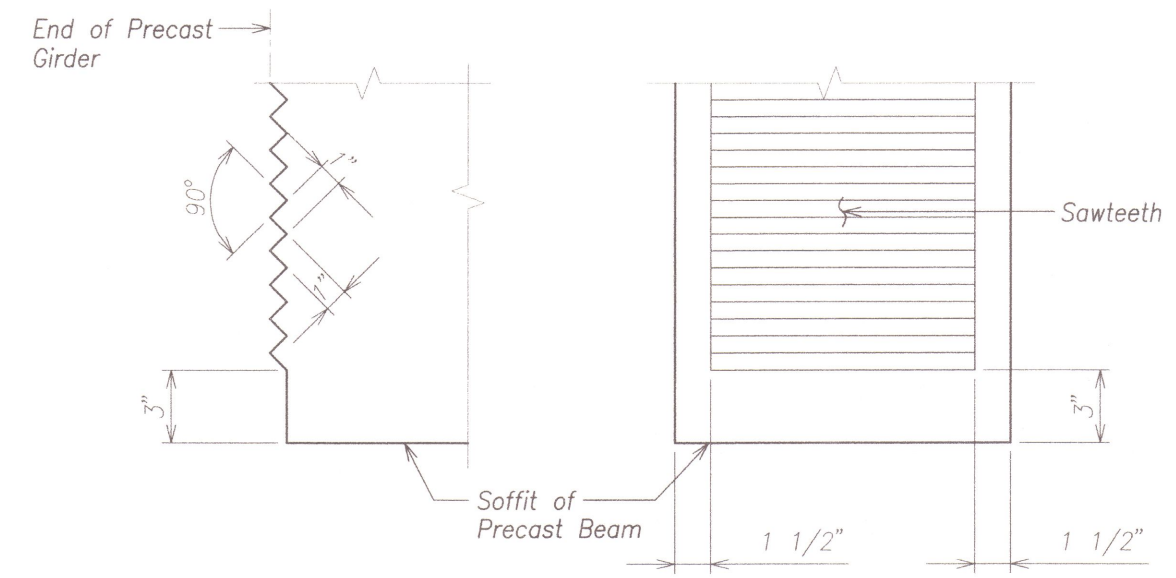


SECTION ELEVATION
SAWTEETH DETAIL
Use sawteeth key in areas outside of PT ducts.
SG3.8 SG3.8

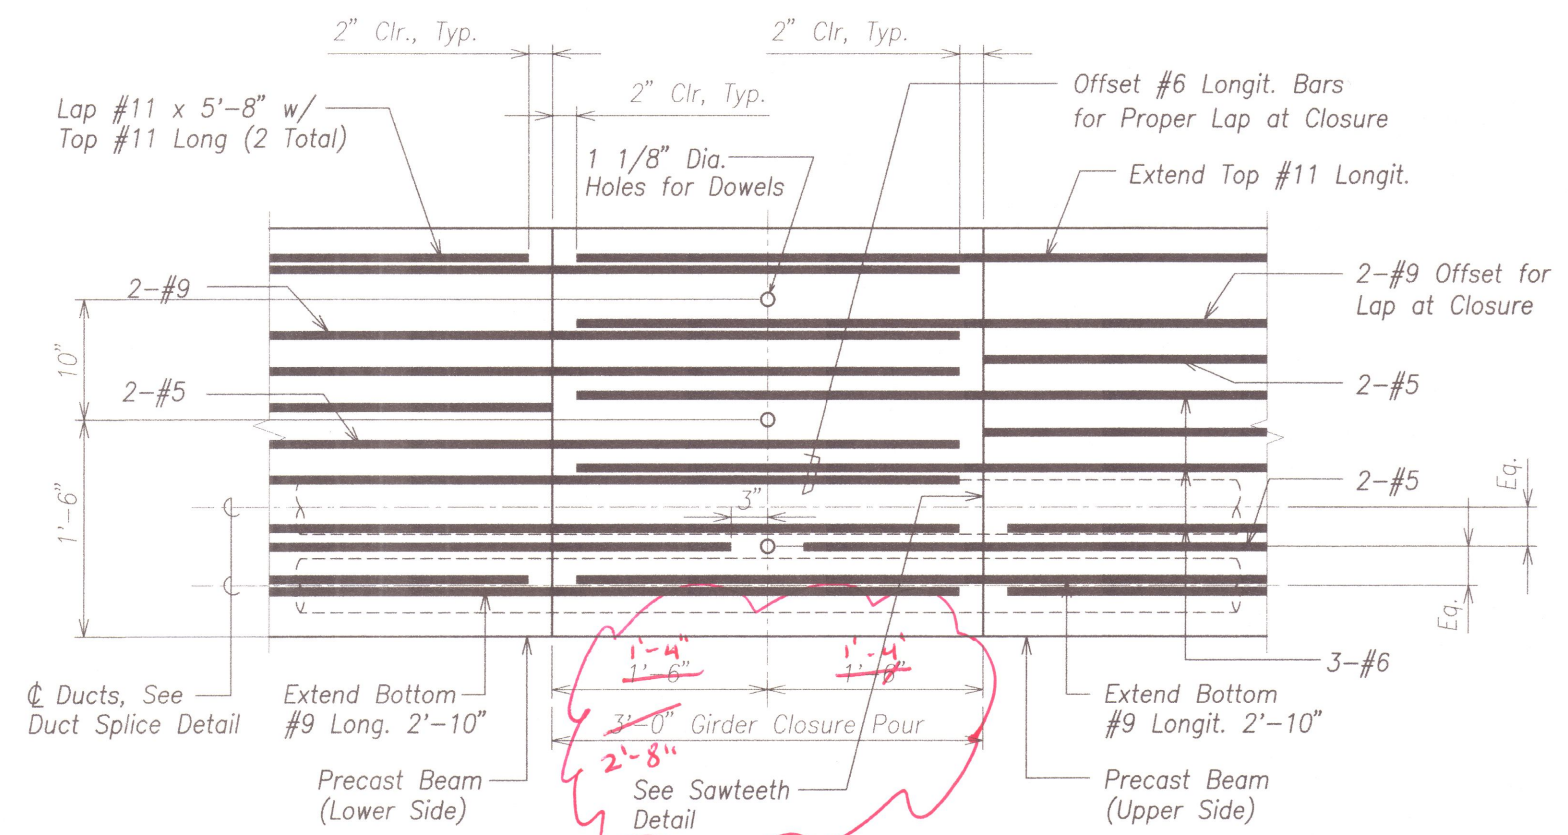

CIP BEAM CLOSURE
Scale: 1 1/2" = 1'-0"
SG3.2 SG3.8
SG3.3

Note:
Stirrups not shown for clarity.

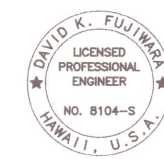

THIS WORK WAS PREPARED BY ME OR UNDER MY SUPERVISION.
David K. Fujiwara
KSF, INC. APRIL 30, 2010 LIC. EXP. DATE


STATE OF HAWAII
DEPARTMENT OF TRANSPORTATION
HIGHWAYS DIVISION


BEAM CLOSURE DETAILS

HONOAPIILANI HIGHWAY REALIGNMENT, PHASE 1A
Future Keawe St Extension to Lahainaluna Rd
Part A: Off Ramp Mass Grading
Fed. Aid Proj. No. NH-030-1(35)R
Scale: As Noted Date: April, 2009

[illegible]


Insert for —
#8 Dowels
(See C/SG3.7)

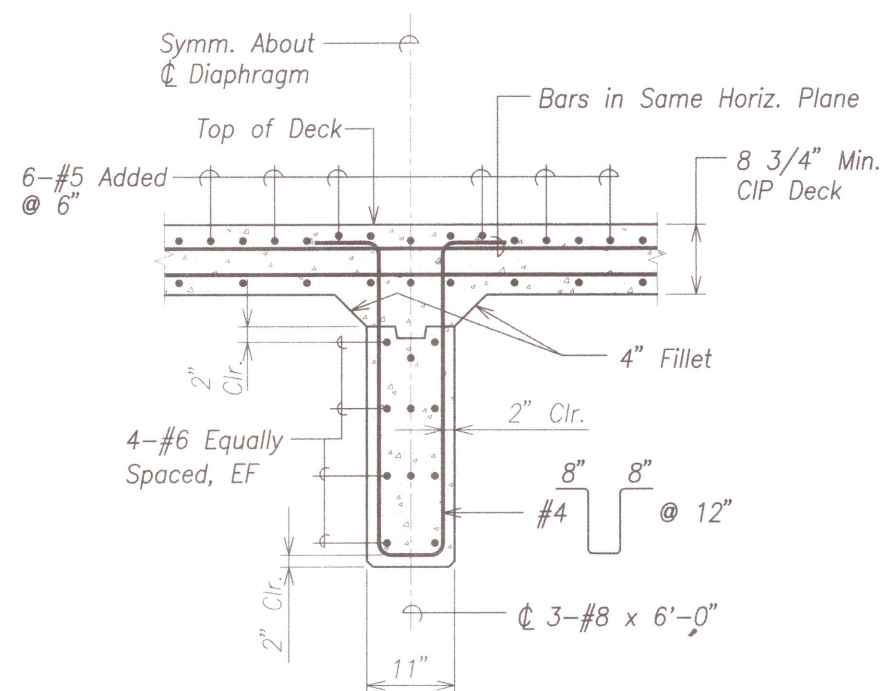

SECTION 

Scale: 1" = 1'-0" SG4.1 SG4.1

- Notes:
1. Section is taken perpendicular to Precast beams.
 2. For Precast beams, see sheets SG3.1 through SG3.8.
 3. Pipe supports (S10) shall be spaced @ 8'-0" oc max. and as noted on SG2.1.
Verify location with pipe manufacturer.
 4. See Hawaii State Standard Plans Sheet B-01 for drip details.

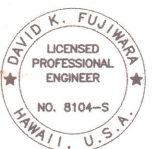

THIS WORK WAS PREPARED BY ME
OR UNDER MY SUPERVISION.

David L. Ferguson APRIL 30, 2010
KSF, INC. LIC. EXP. DATE

STATE OF HAWAII
DEPARTMENT OF TRANSPORTATION
HIGHWAYS DIVISION

TYPICAL MIDSPAN DIAPHRAGM


HONOAPIILANI HIGHWAY REALIGNMENT, PHASE 1A
Future Keawe St Extension to Lahainaluna Rd
Part A: Off Ramp Mass Grading
Fed. Aid Proj. No. NH-030-1(35)R

Scale: As Noted Date: April, 2009


ORIGINAL PLAN	SURVEY PLOTTED BY _____ DATE _____
NOTE BOOK	DRAWN BY _____
	TRACED BY _____
	DESIGNED BY _____
	QUANTITIES BY _____
No. _____	CHECKED BY _____



FED. ROAD DIST. NO.	STATE	FED. AID PROJ. NO.	FISCAL YEAR	SHEET NO.	TOTAL SHEETS
HAWAII	HAW.	NH-030-1(35)R	2009	155	286

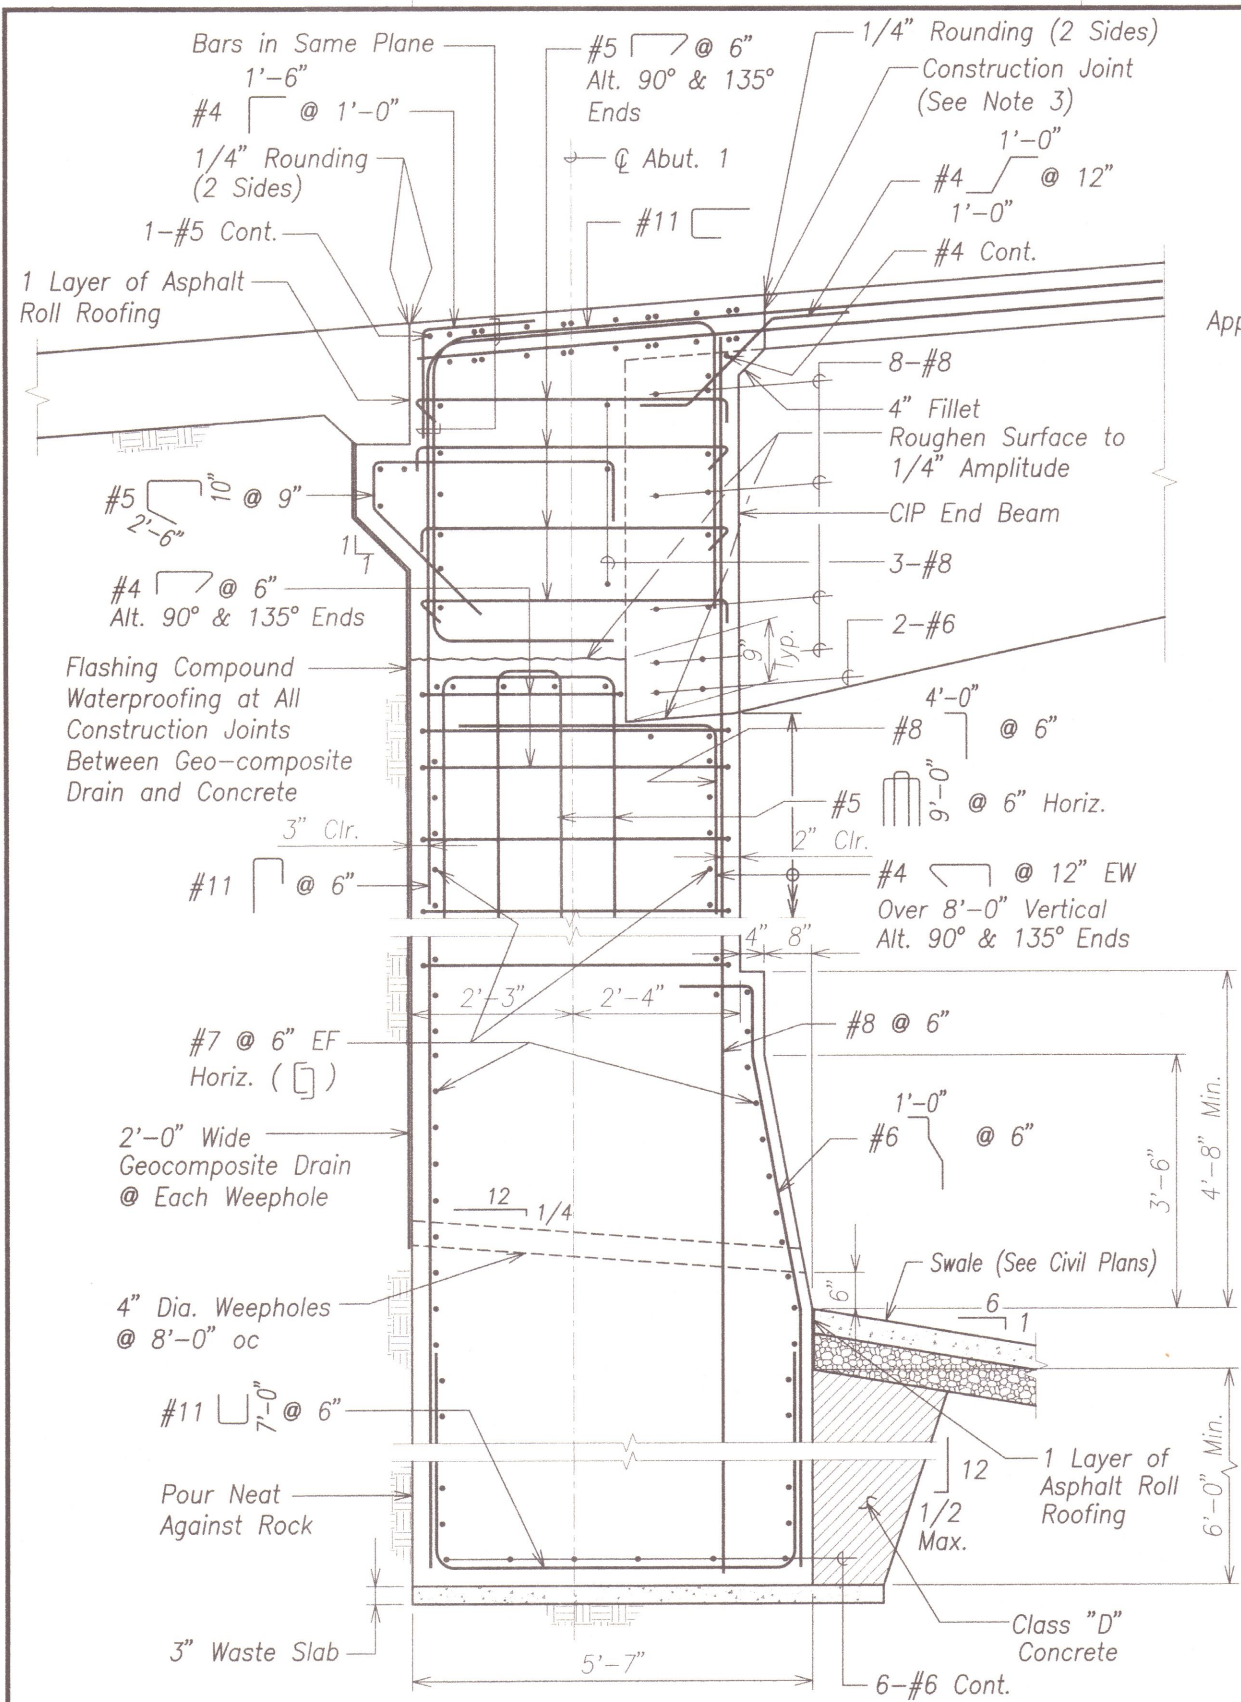

ABUTMENT SECTION BETWEEN CIP BEAMS **A**
Scale: 3/4" = 1'-0"
SG1.2 SG5.2
SG1.3

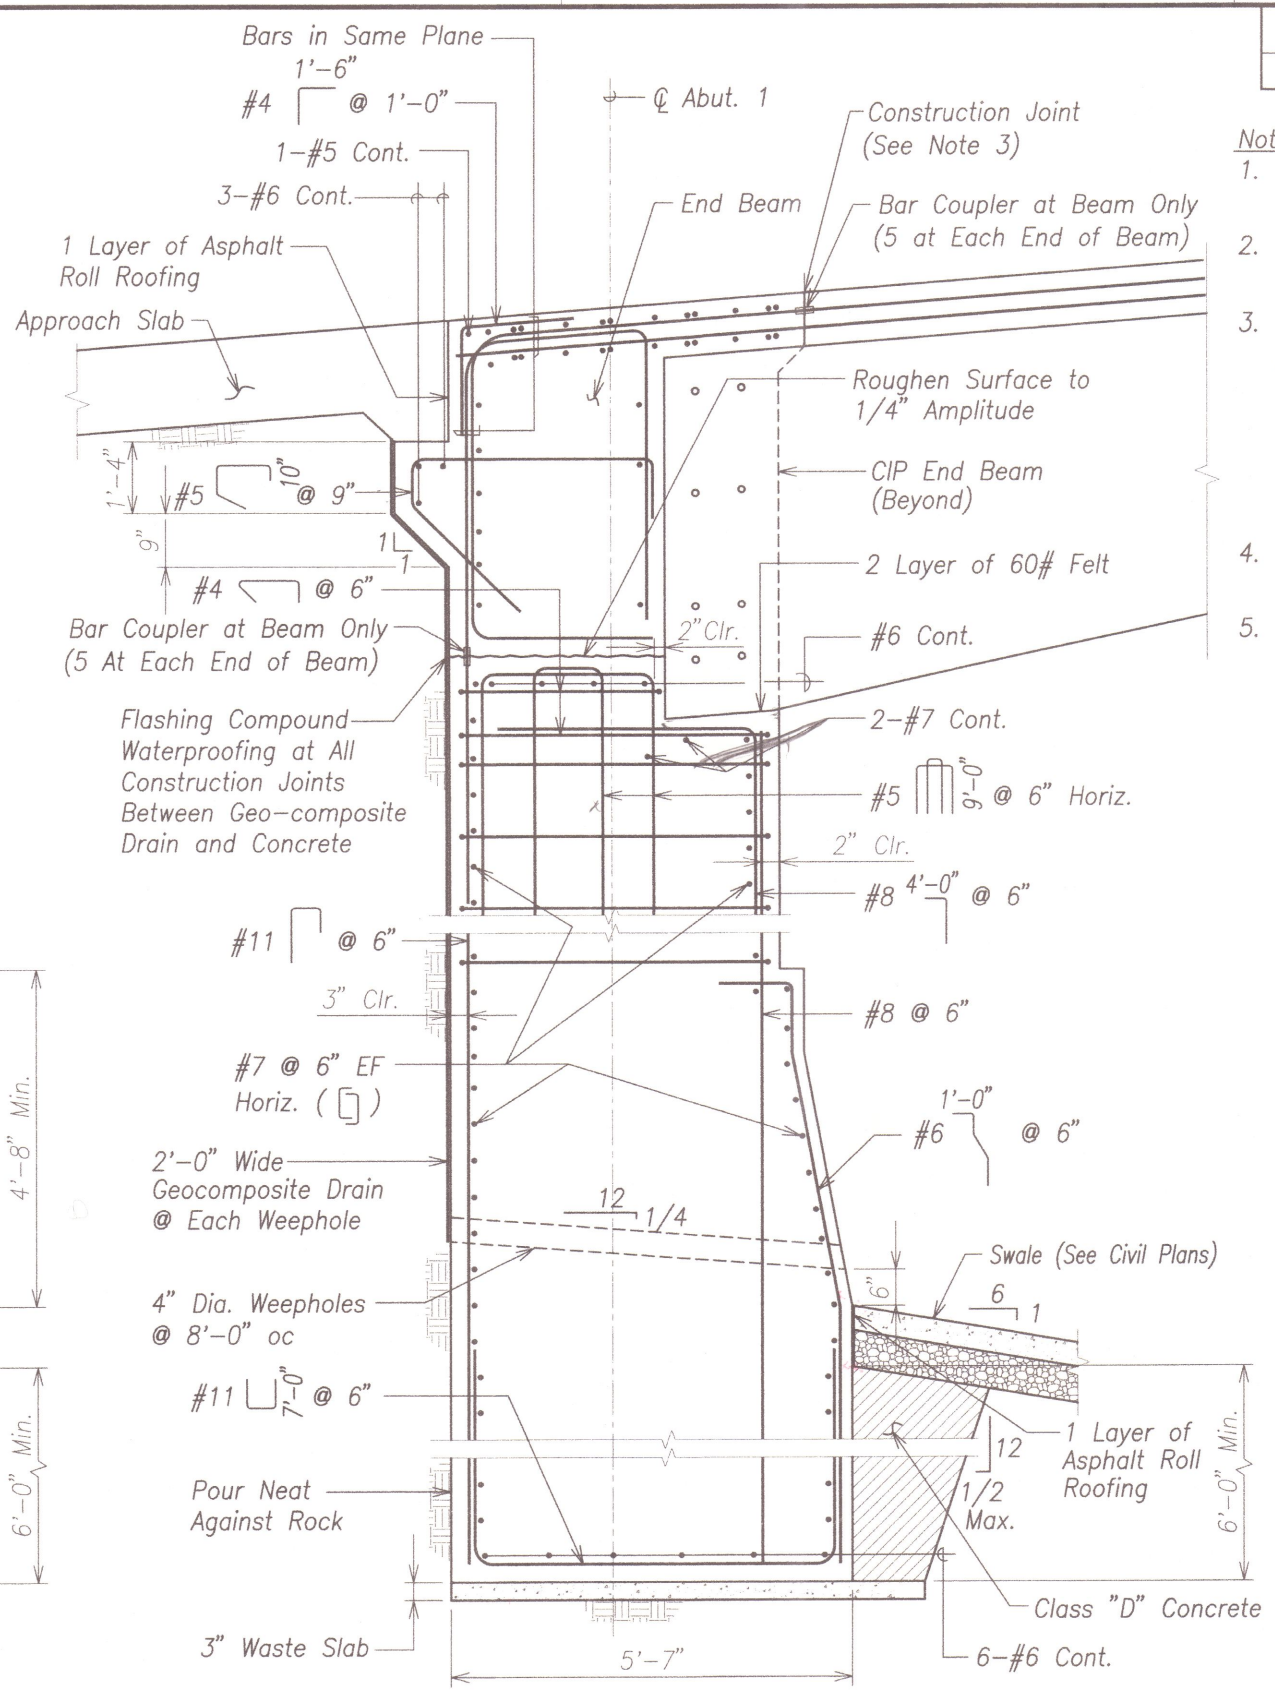

ABUTMENT SECTION - AT CIP BEAM **B**
Scale: 3/4" = 1'-0"
SG1.3 SG5.2

- Notes:
- For additional corbel details, See sheet SG7.2.
 - For approach slab, See sheets SG7.1 and SG7.2.
 - Roughen deck surface construction joint by abrasive blast method. Moisten to saturated surface. Dry prior to applying DURAL PREP AC bonding agent and anticorrosion coating prior to concrete pour. Typical at all deck construction joints.
 - Beam seat is parallel with deck in longitudinal direction.
 - If soil or clinker material is encountered at the bottom of the footing, remove the soil and clinker material until rock is encountered and backfill with Class "D" concrete.



THIS WORK WAS PREPARED BY ME OR UNDER MY SUPERVISION.
David K. Fujiwara
KSF, INC. APRIL 30, 2010 LIC. EXP. DATE

STATE OF HAWAII
DEPARTMENT OF TRANSPORTATION
HIGHWAYS DIVISION


ABUTMENT 1 SECTIONS

HONOAPIILANI HIGHWAY REALIGNMENT, PHASE 1A
Future Keawe St Extension to Lahainaluna Rd
Part A: Off Ramp Mass Grading
Fed. Aid Proj. No. NH-030-1(35)R
Scale: As Noted Date: April, 2009


SHEET No. SG5.2 OF 4 SHEETS

DATE
SURVEY PLOTTED BY
DESIGNED BY
NOTED BY
CHECKED BY
ORIGINAL PLAN
NOTE BOOK
No.


FED. ROAD DIST. NO.	STATE	FED. AID PROJ. NO.	FISCAL YEAR	SHEET NO.	TOTAL SHEETS
HAWAII	HAW.	NH-030-1(35)R	2009	156	286

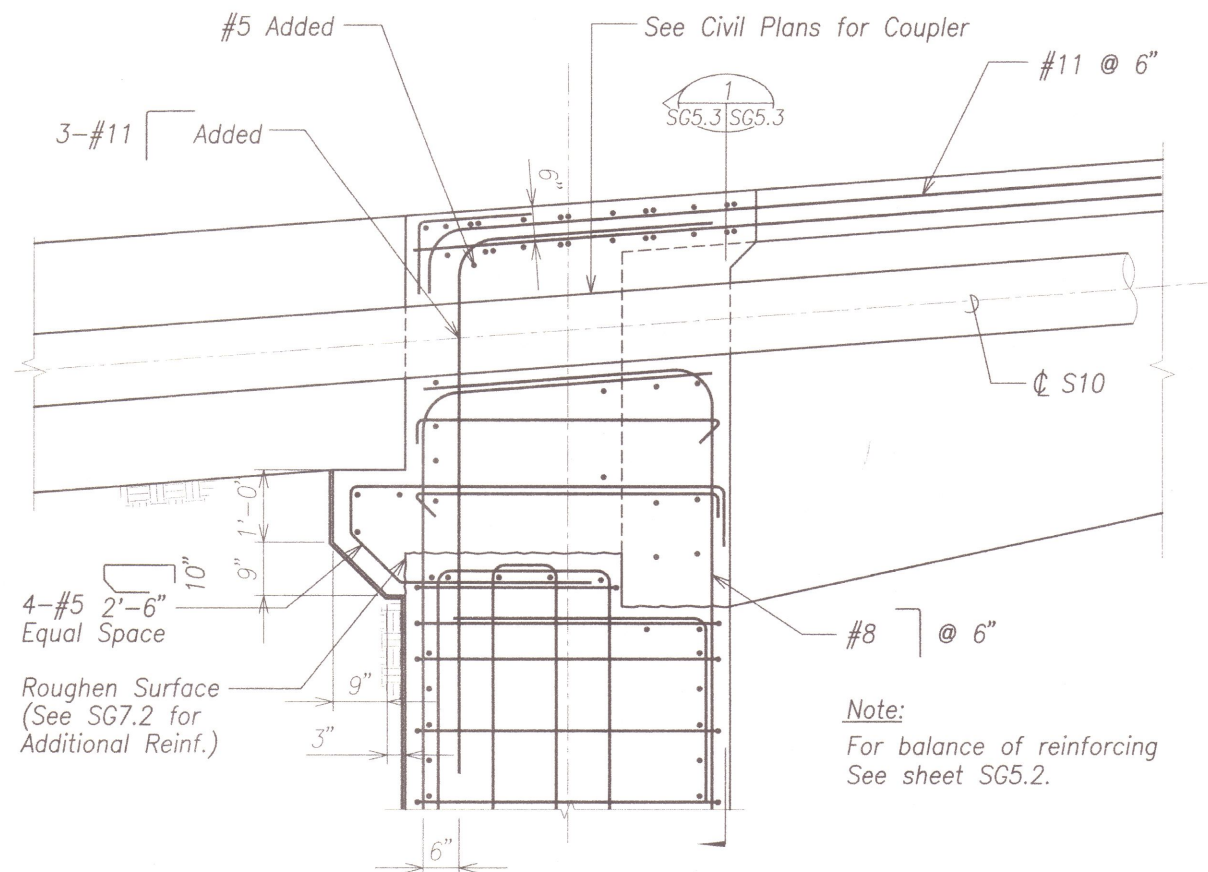


SECTION A
Scale: $\frac{3}{4}'' = 1'-0''$ SG5.3 SG5.3

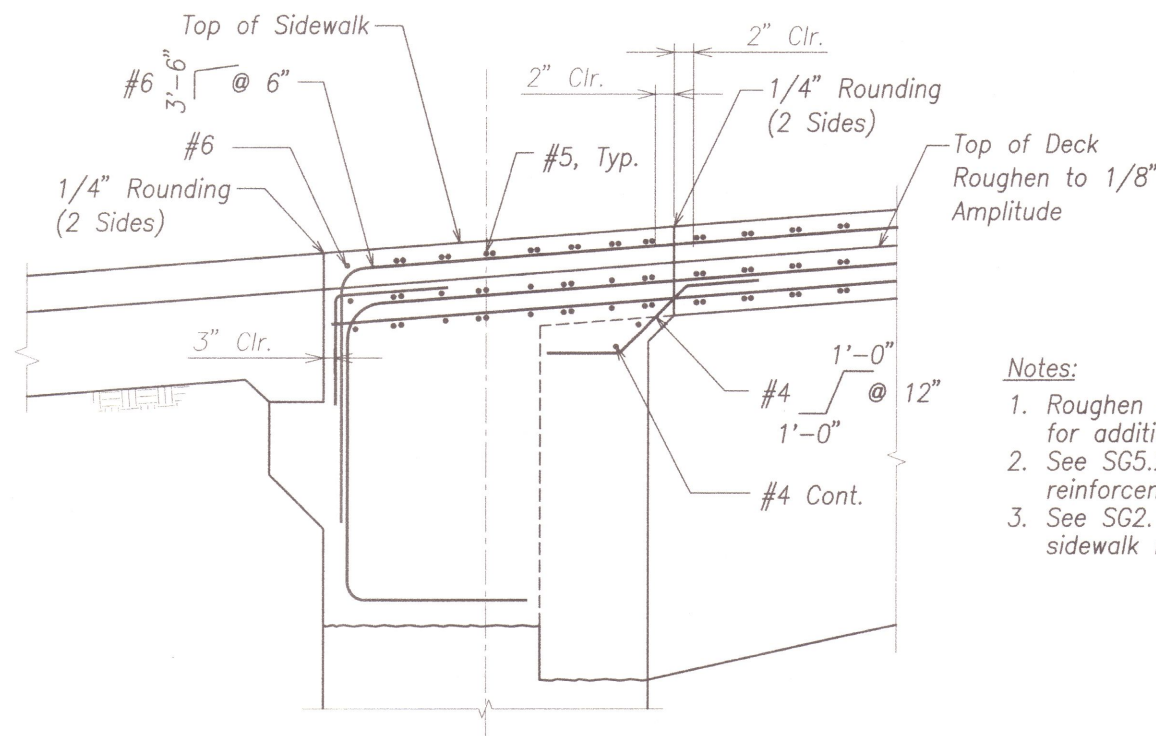

SECTION THROUGH ABUTMENT @ SIDEWALK B
Scale: $\frac{3}{4}'' = 1'-0''$ SG5.3 SG5.3

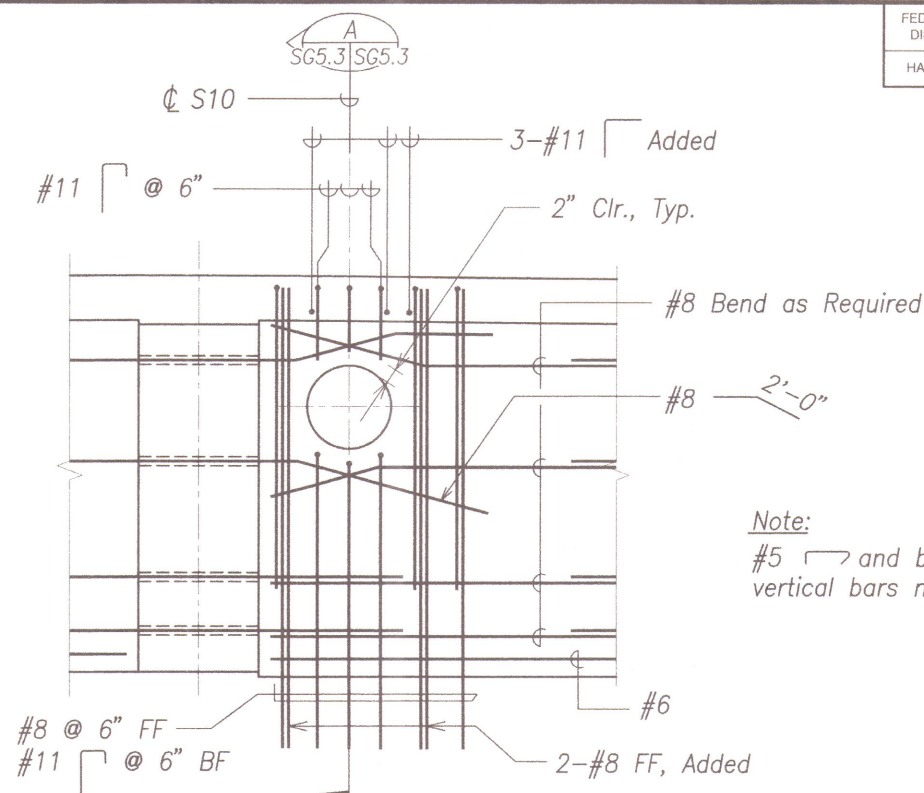

DETAIL 1
Scale: $\frac{3}{4}'' = 1'-0''$ SG5.1 SG5.3 SG6.1

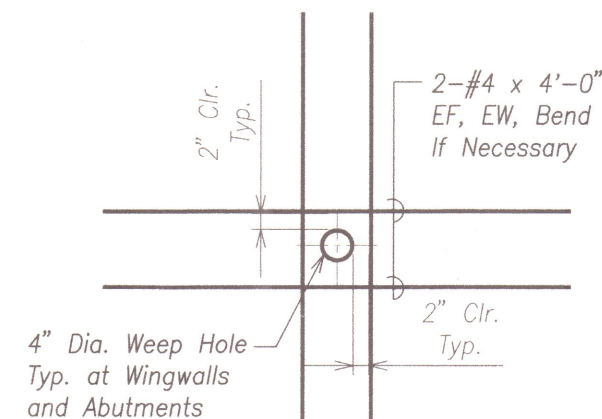

ADDED REINFORCING AT WEEPERS AND DRAINS 2
Scale: $1'' = 1'-0''$ SG5.3 SG5.3




THIS WORK WAS PREPARED BY ME OR UNDER MY SUPERVISION.

APRIL 30, 2010
LIC. EXP. DATE


STATE OF HAWAII
DEPARTMENT OF TRANSPORTATION
HIGHWAYS DIVISION
ABUTMENT 1 SECTION AND DETAIL
HONOAPIILANI HIGHWAY REALIGNMENT, PHASE 1A
Future Keawe St Extension to Lahainaluna Rd
Part A: Off Ramp Mass Grading
Fed. Aid Proj. No. NH-030-1(35)R
Scale: As Noted Date: April, 2009

SHEET No. SG5.3 OF 4 SHEETS

FED. ROAD DIST. NO.	STATE	FED. AID PROJ. NO.	FISCAL YEAR	SHEET NO.	TOTAL SHEETS
HAWAII	HAW.	NH-030-1(35)R	2009	157	286

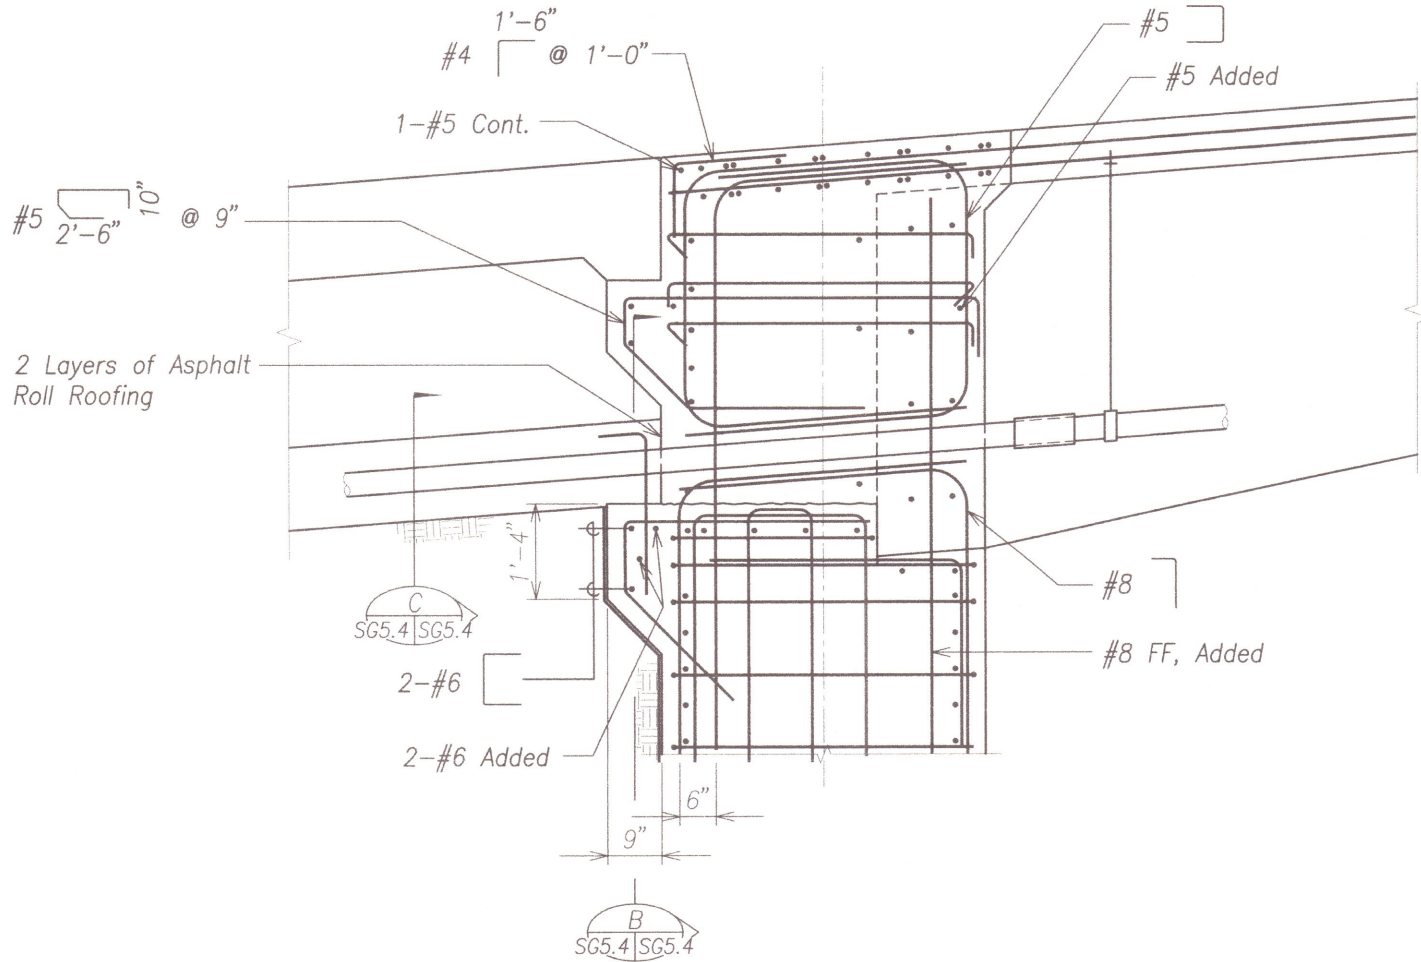


SECTION A
Scale: 3/4" = 1'-0" SG5.4 SG5.4

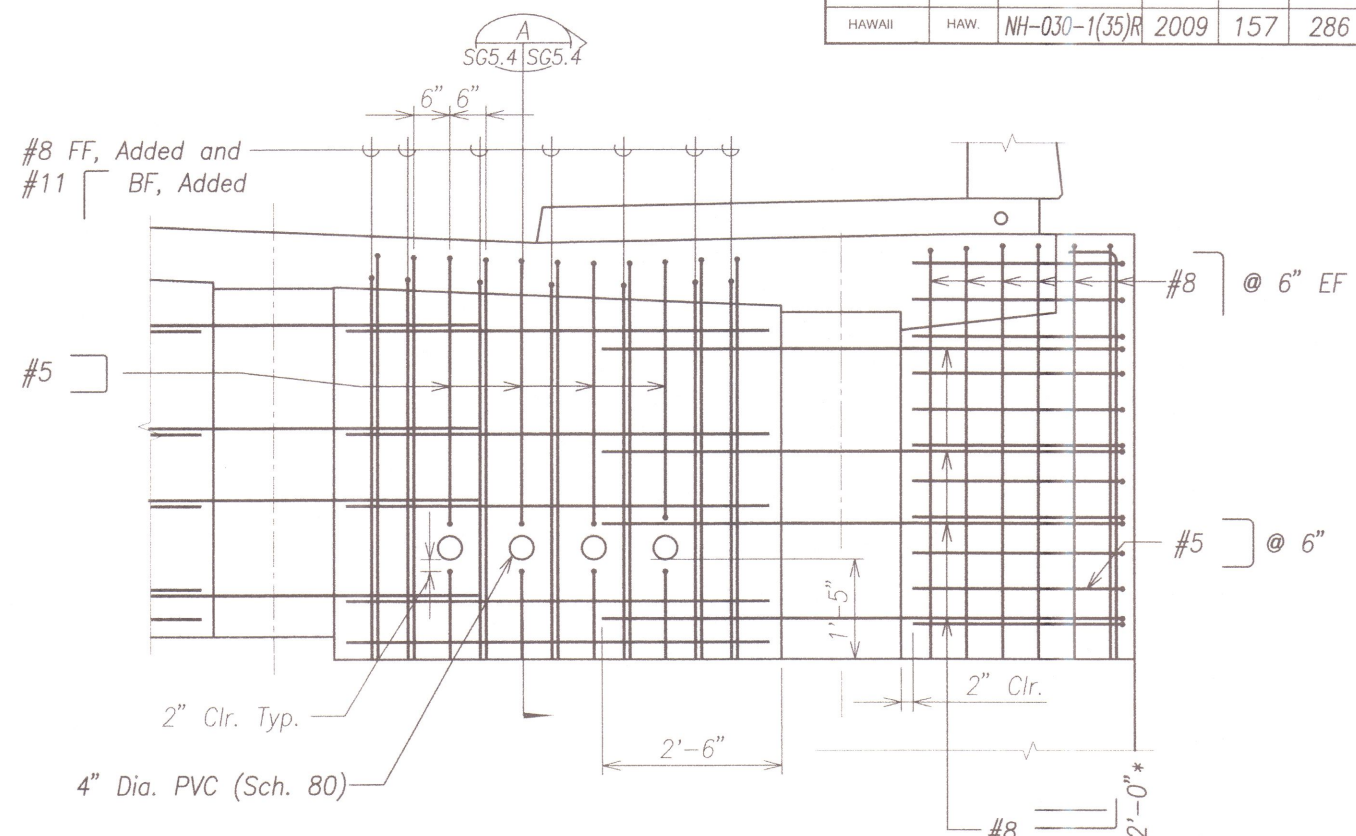


DETAIL 2
Scale: 3/4" = 1'-0" SG5.1 SG5.4

Dowels through Beam Horizontal Deck Steel and #5
Not Shown for Clarity
* 1'-0" Bottom of Beam Where 9" Lip Occurs

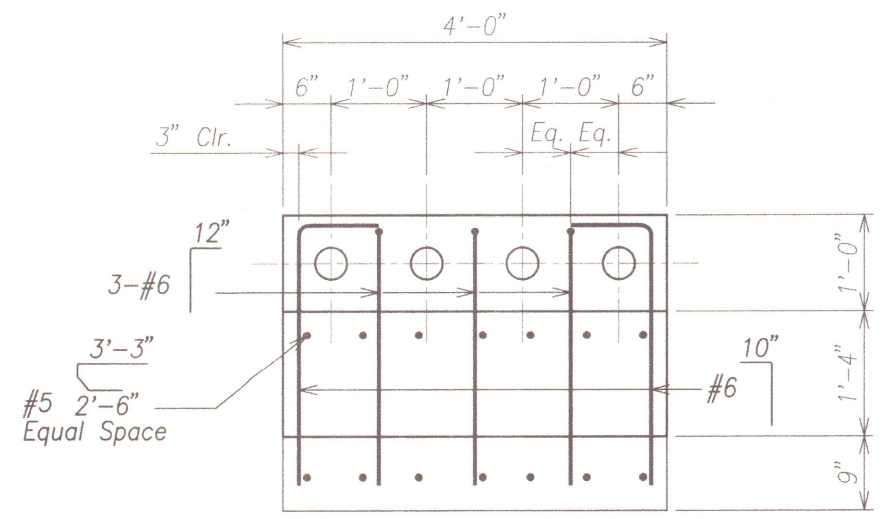

SECTION B
Scale: 1" = 1'-0" SG5.4 SG5.4

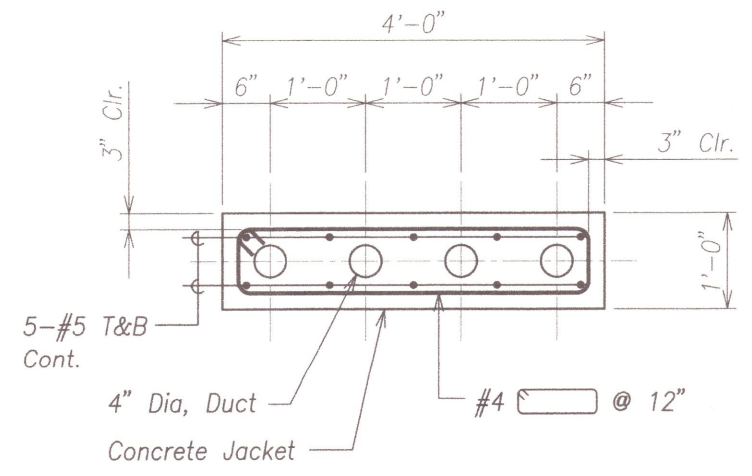

SECTION C
Scale: 1" = 1'-0" SG5.4 SG5.4

SURVEY PLOTTED BY	DATE
DRAWN BY	
TRACED BY	
DESIGNED BY	
CHECKED BY	
ORIGINAL PLAN	
NOTE BOOK	
No.	




THIS WORK WAS PREPARED BY ME OR UNDER MY SUPERVISION.
David K. Fujiwara
KSF, INC. APRIL 30, 2010 LIC. EXP. DATE

STATE OF HAWAII
DEPARTMENT OF TRANSPORTATION
HIGHWAYS DIVISION

ABUTMENT 1 SECTION AND DETAIL
HONOAPIILANI HIGHWAY REALIGNMENT, PHASE 1A
Future Keawe St Extension to Lahainaluna Rd
Part A: Off Ramp Mass Grading
Fed. Aid Proj. No. NH-030-1(35)R
Scale: As Noted Date: April, 2009


SHEET No. SG5.4 OF SHEETS

FED. ROAD DIST. NO.	STATE	FED. AID PROJ. NO.	FISCAL YEAR	SHEET NO.	TOTAL SHEETS
HAWAII	HAW.	NH-030-1(35)R	2009	158	286

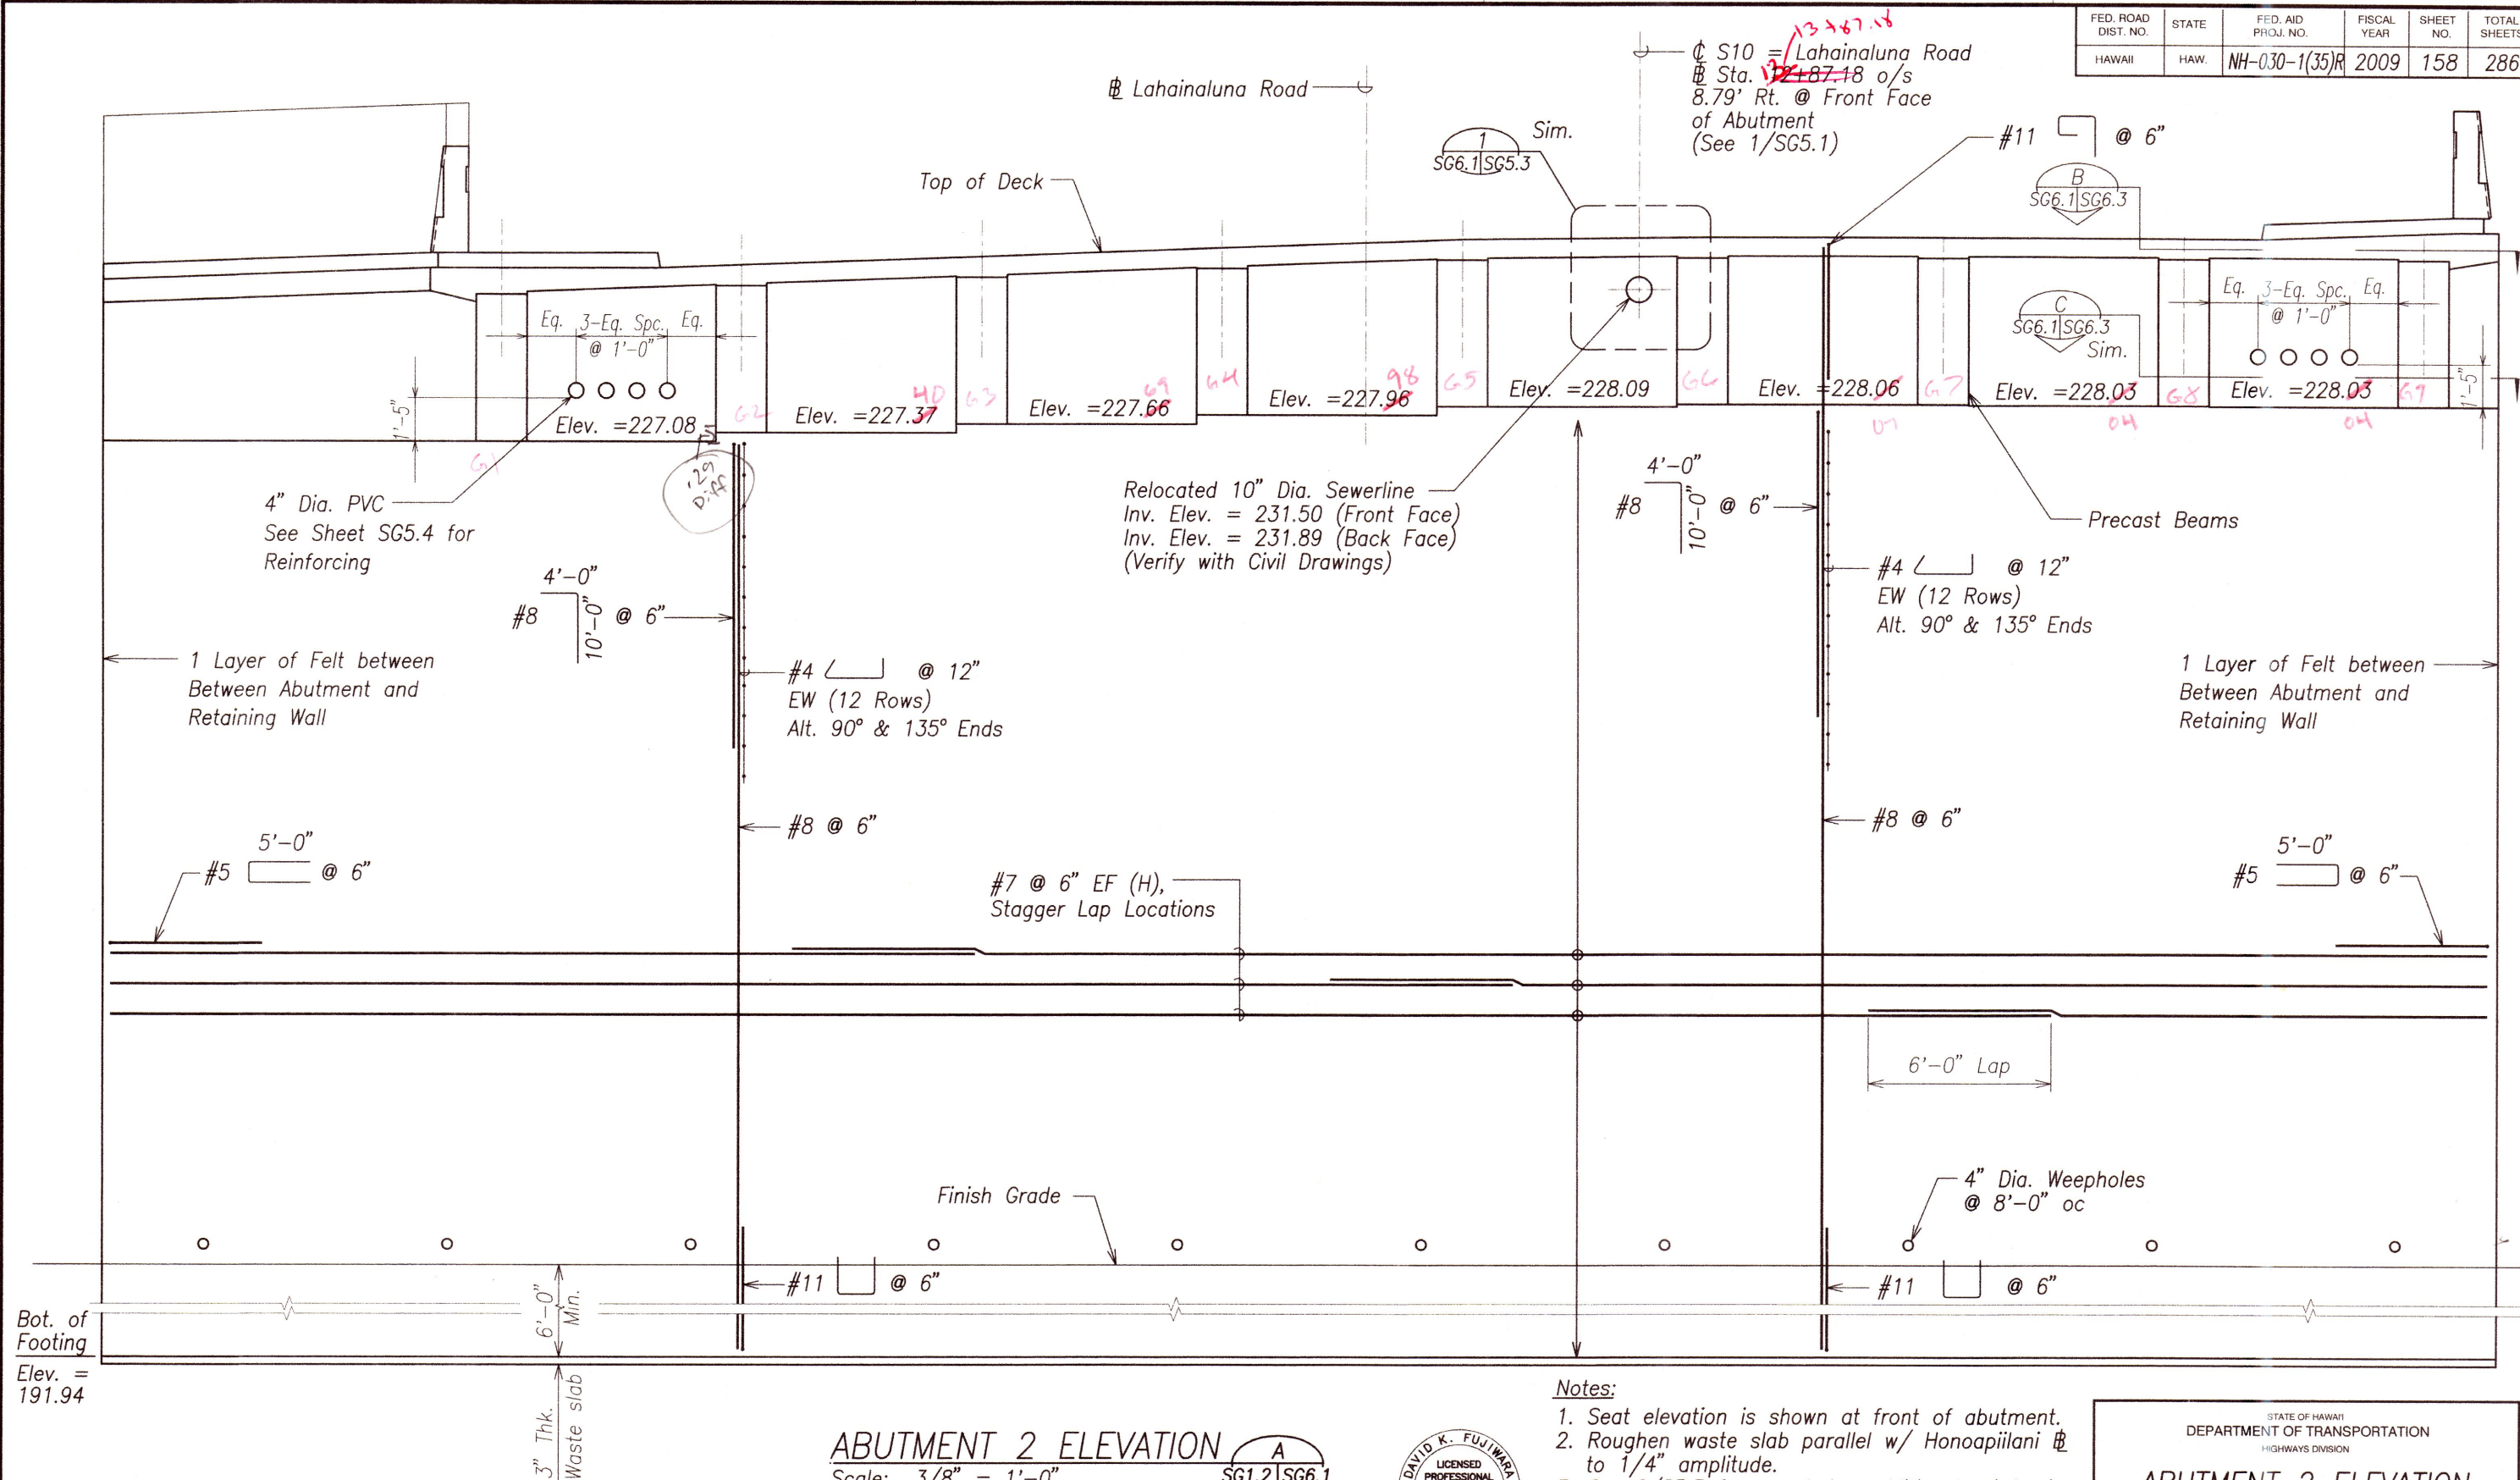

Notes:

1. Seat elevation is shown at front of abutment.
2. Roughen waste slab parallel w/ Honoapiilani @ to 1/4" amplitude.
3. See 2/S5.3 for weepholes additional reinforcing.

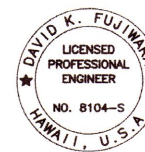

THIS WORK WAS PREPARED BY ME
OR UNDER MY SUPERVISION.

David K. Fujimura
KSF, INC. APRIL 30, 2010
LIC. EXP. DATE

STATE OF HAWAII
DEPARTMENT OF TRANSPORTATION
HIGHWAYS DIVISION

ABUTMENT 2 ELEVATION


HONOAPIILANI HIGHWAY REALIGNMENT, PHASE 1A
Future Keawe St Extension to Lahainaluna Rd
Part A: Off Ramp Mass Grading
Fed. Aid Proj. No. NH-030-1(35)R
Scale: As Noted Date: April, 2009

SHEET No. SG6.1 OF 3 SHEETS

FED. ROAD DIST. NO.	STATE	FED. AID PROJ. NO.	FISCAL YEAR	SHEET NO.	TOTAL SHEETS
HAWAII	HAW.	NH-030-1(35)R	2009	159	286

Notes:

- For additional corbel details, See sheet SG7.1.
- For approach slab, See sheet SG7.2
- Roughen deck surface construction joint by abrasive blast method. Moisten to saturated surface. Dry prior to applying **DURAL PREP AC** bonding agent and **anticorrosion coating** prior to concrete pour. Typical at all deck construction joints.
- Beam seat is parallel with deck in longitudinal direction.
- If soil or clinker material is encountered at the bottom of the footing, remove the soil and clinker material until rock is encountered and backfill with Class "D" concrete.

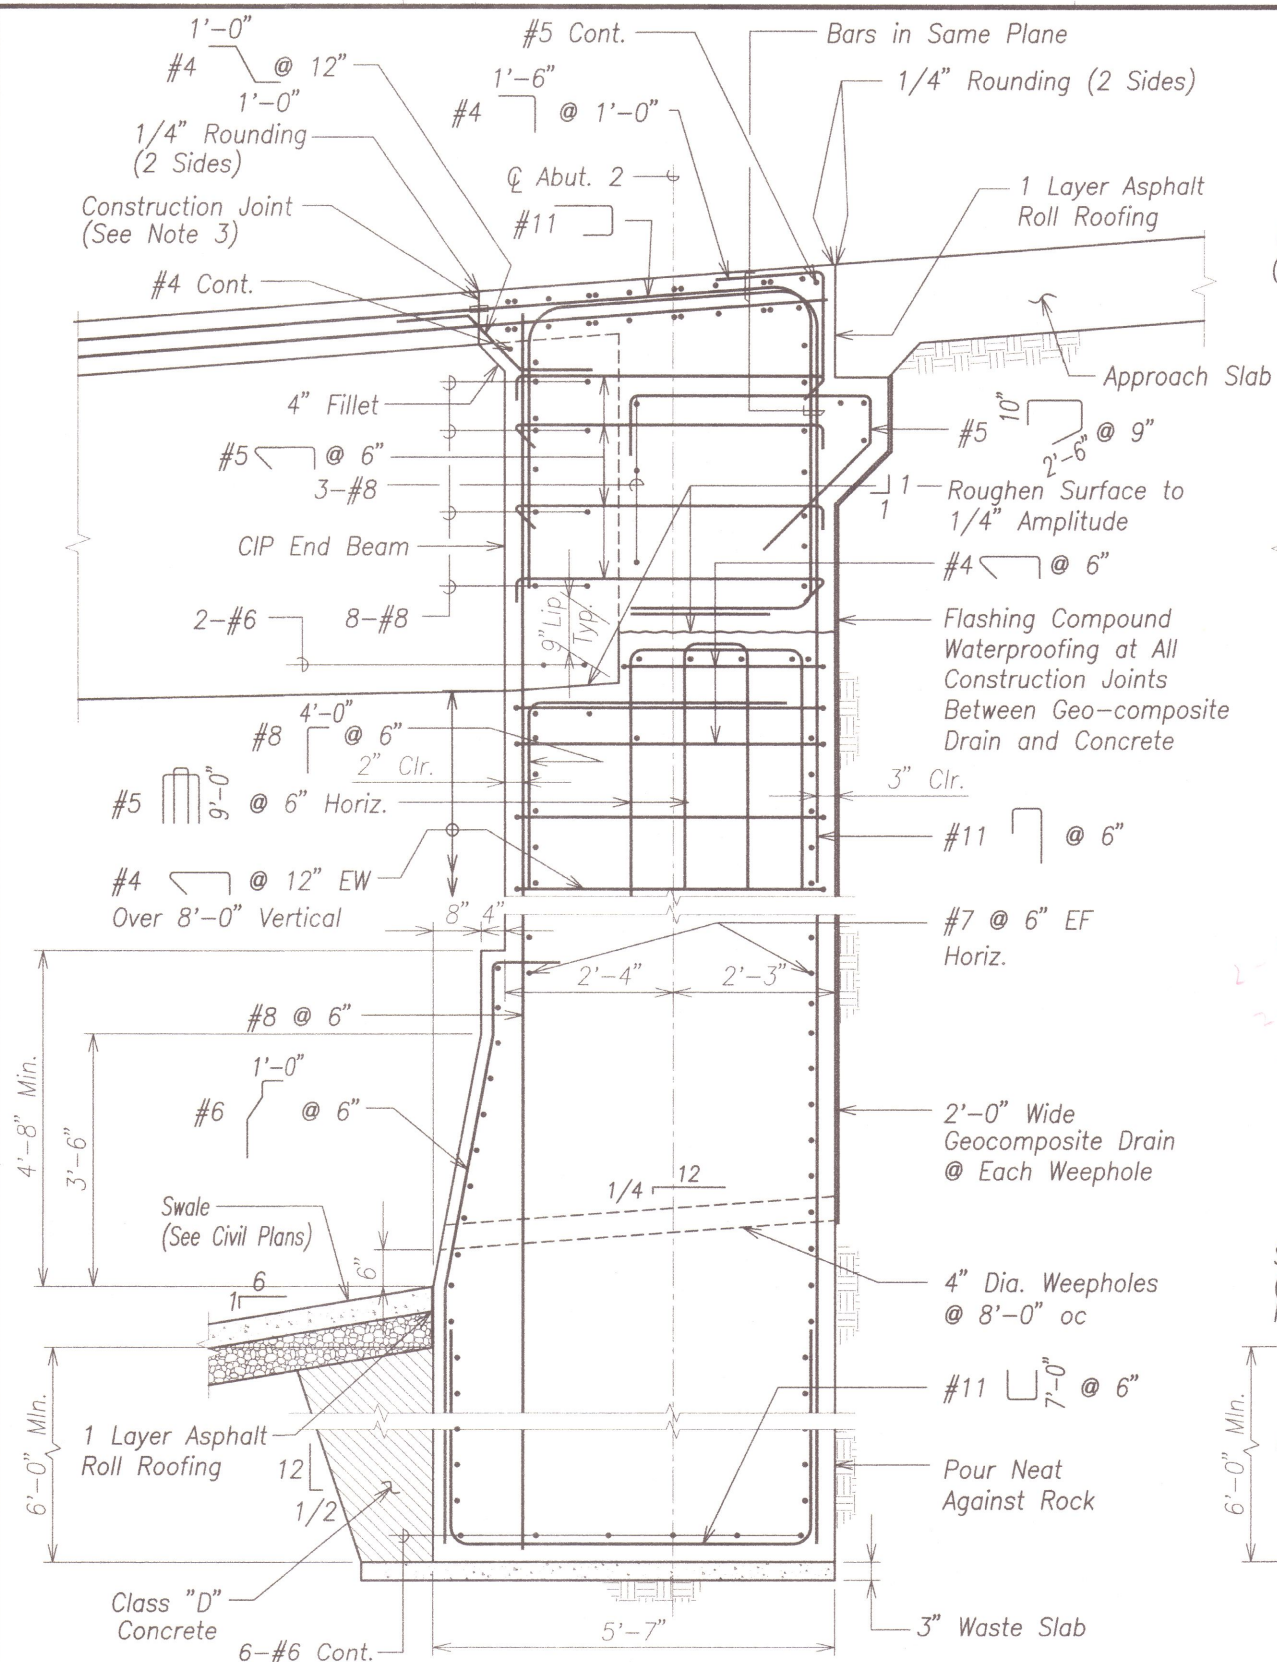


ABUTMENT SECTION BETWEEN CIP BEAMS

Scale: 3/4" = 1'-0"

SG1.2 SG6.2


SG1.3

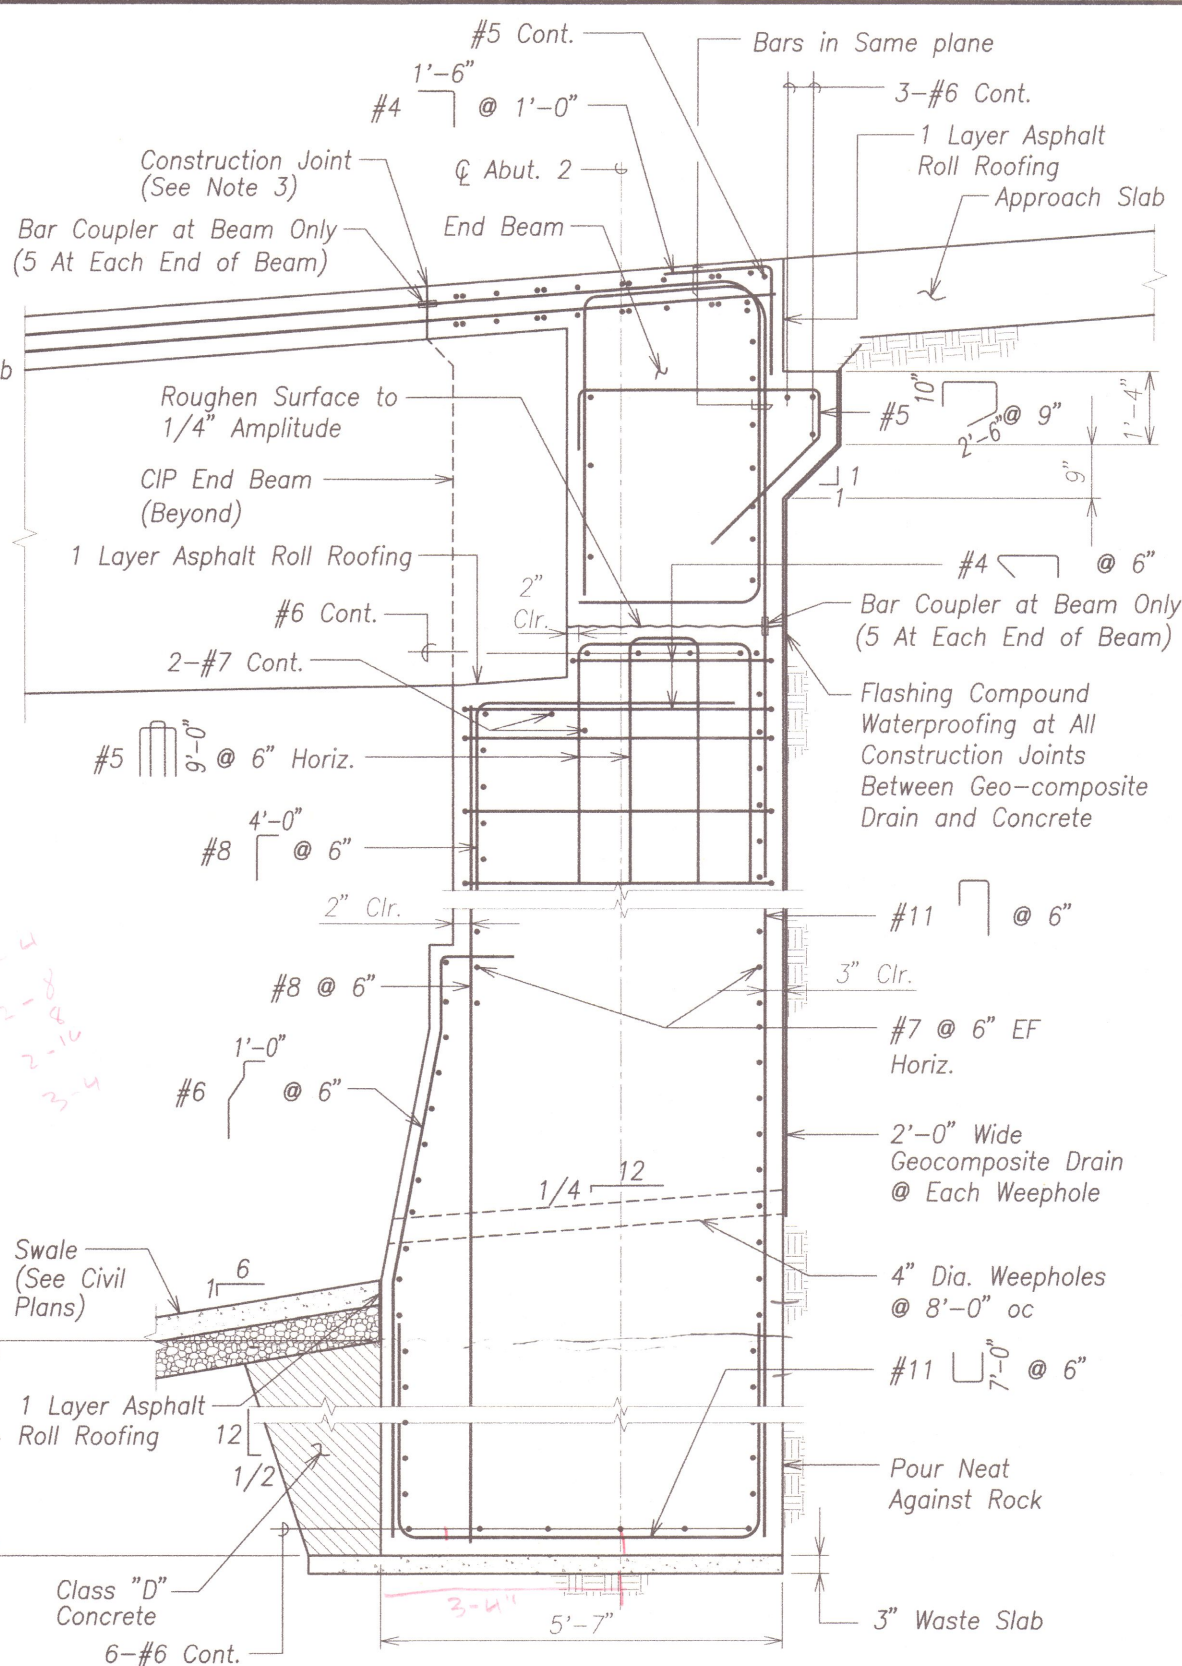

ABUTMENT SECTION - AT CIP BEAM

Scale: 3/4" = 1'-0"

SG1.3 SG6.2

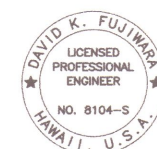

THIS WORK WAS PREPARED BY ME OR UNDER MY SUPERVISION.

David K. Fujiwara
KSF, INC. APRIL 30, 2010
LIC. EXP. DATE

STATE OF HAWAII
DEPARTMENT OF TRANSPORTATION
HIGHWAYS DIVISION

ABUTMENT 2 SECTIONS

HONOAPIILANI HIGHWAY REALIGNMENT, PHASE 1A
Future Keawe St Extension to Lahainaluna Rd

Part A: Off Ramp Mass Grading


Fed. Aid Proj. No. NH-030-1(35)R

Scale: As Noted


Date: April, 2009

SHEET No. SG6.2 OF 3 SHEETS


FED. ROAD DIST. NO.	STATE	FED. AID PROJ. NO.	FISCAL YEAR	SHEET NO.	TOTAL SHEETS
HAWAII	HAW.	NH-030-1(35)R	2009	160	286

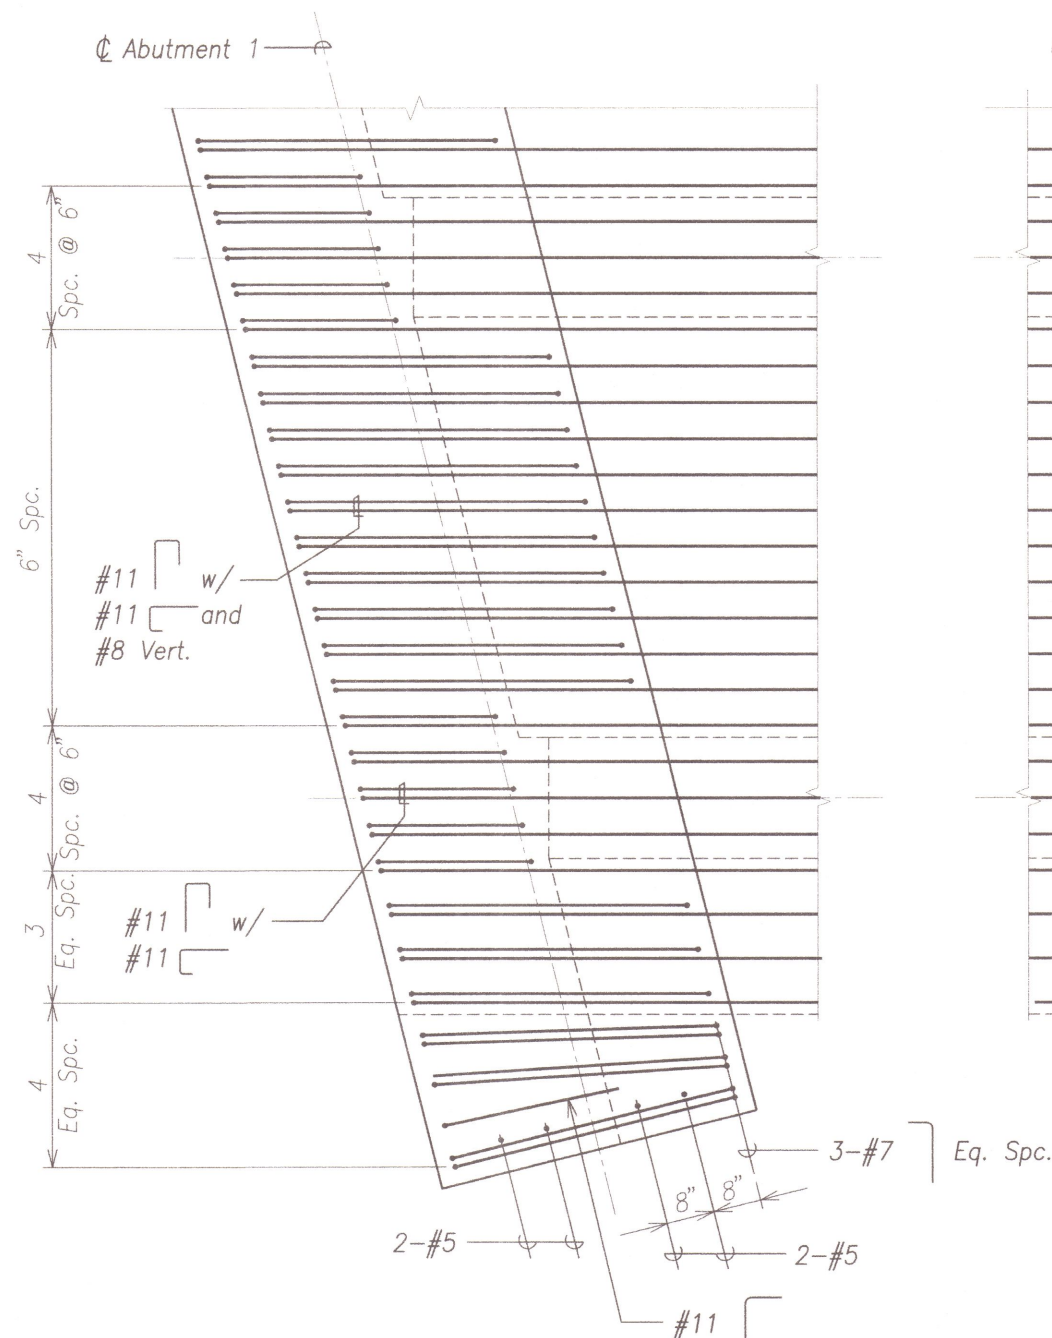


SECTION A
Scale: $3/4" = 1'-0"$ SG5.1 SG6.3

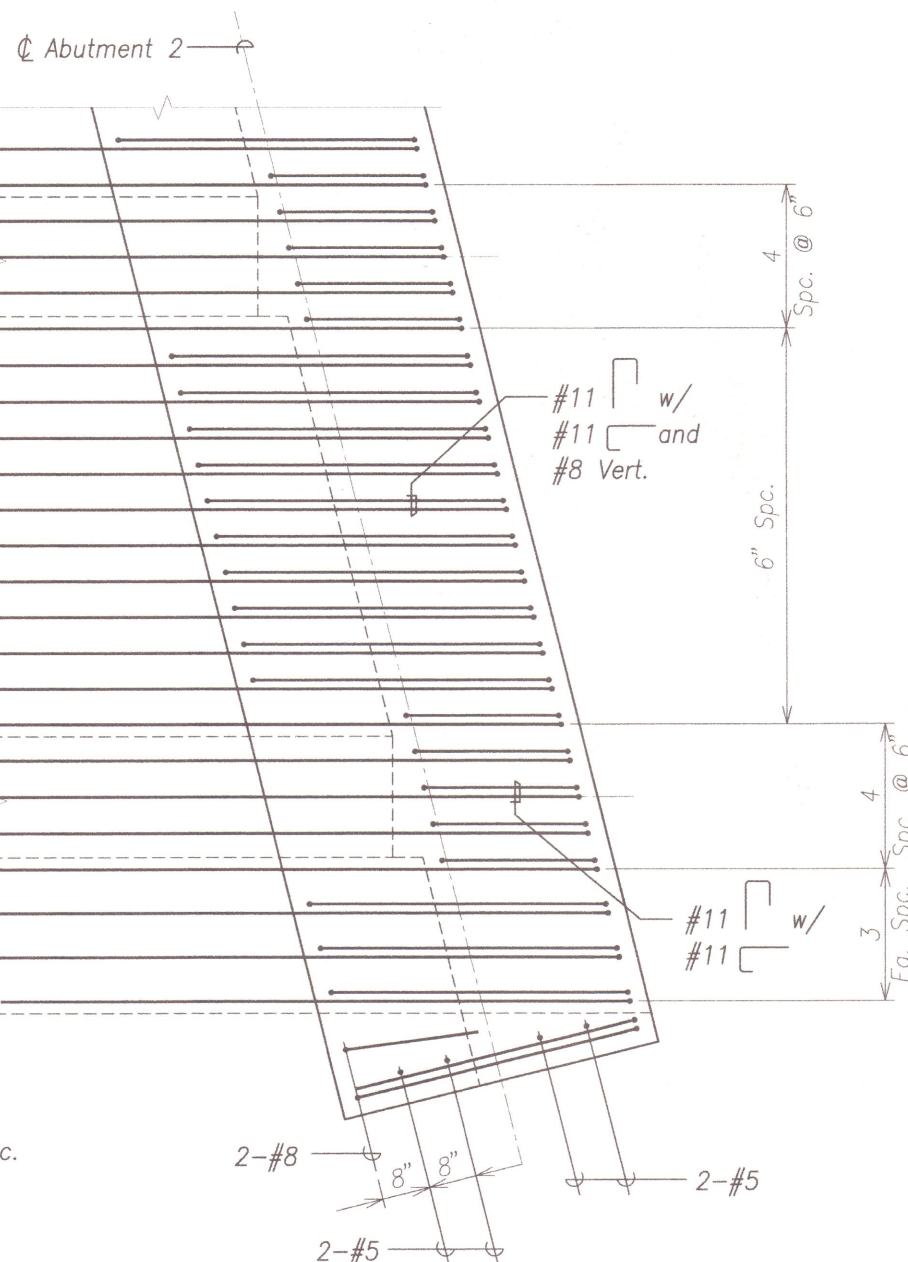

SECTION B
Scale: $3/4" = 1'-0"$ SG6.1 SG6.3

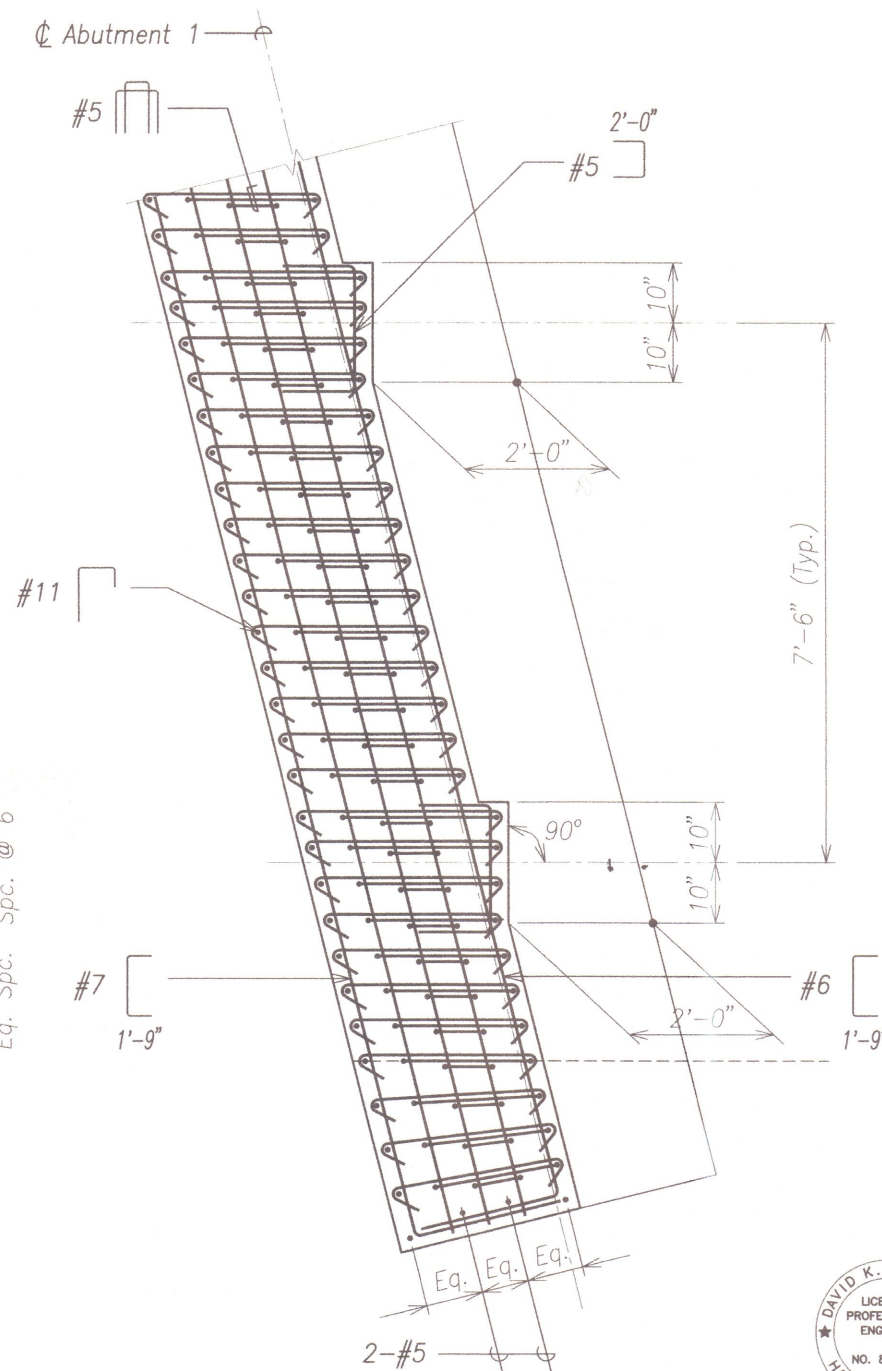

SECTION C
Scale: $3/4" = 1'-0"$ SG5.1 SG6.3

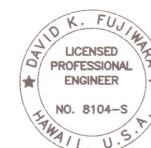

THIS WORK WAS PREPARED BY ME
OR UNDER MY SUPERVISION.
APRIL 30, 2010
LIC. EXP. DATE



STATE OF HAWAII
DEPARTMENT OF TRANSPORTATION
HIGHWAYS DIVISION

ABUTMENT SECTIONS


HONOAPIILANI HIGHWAY REALIGNMENT, PHASE 1A
Future Keawe St Extension to Lahainaluna Rd
Part A: Off Ramp Mass Grading
Fed. Aid Proj. No. NH-030-1(35)R
Scale: As Noted Date: April, 2009

SHEET No. SG6.3 OF 3 SHEETS

FED. ROAD DIST. NO.	STATE	FED. AID PROJ. NO.	FISCAL YEAR	SHEET NO.	TOTAL SHEETS
HAWAII	HAW.	NH-030-1(35)R	2009	161	286

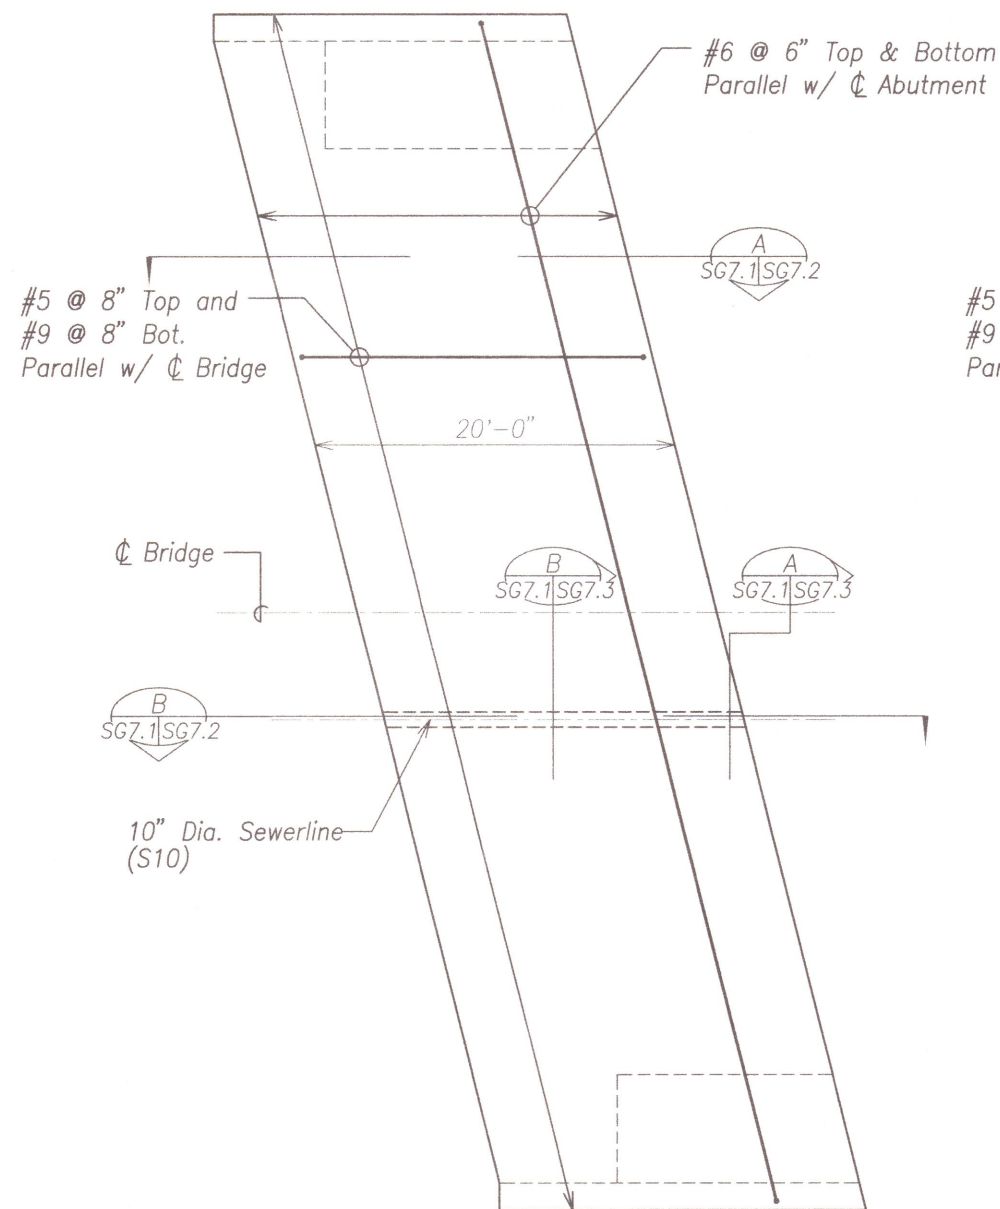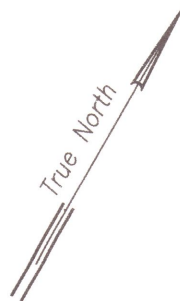


LOWER APPROACH SLAB A
Scale: 3/16" = 1'-0" SG7.1 SG7.1

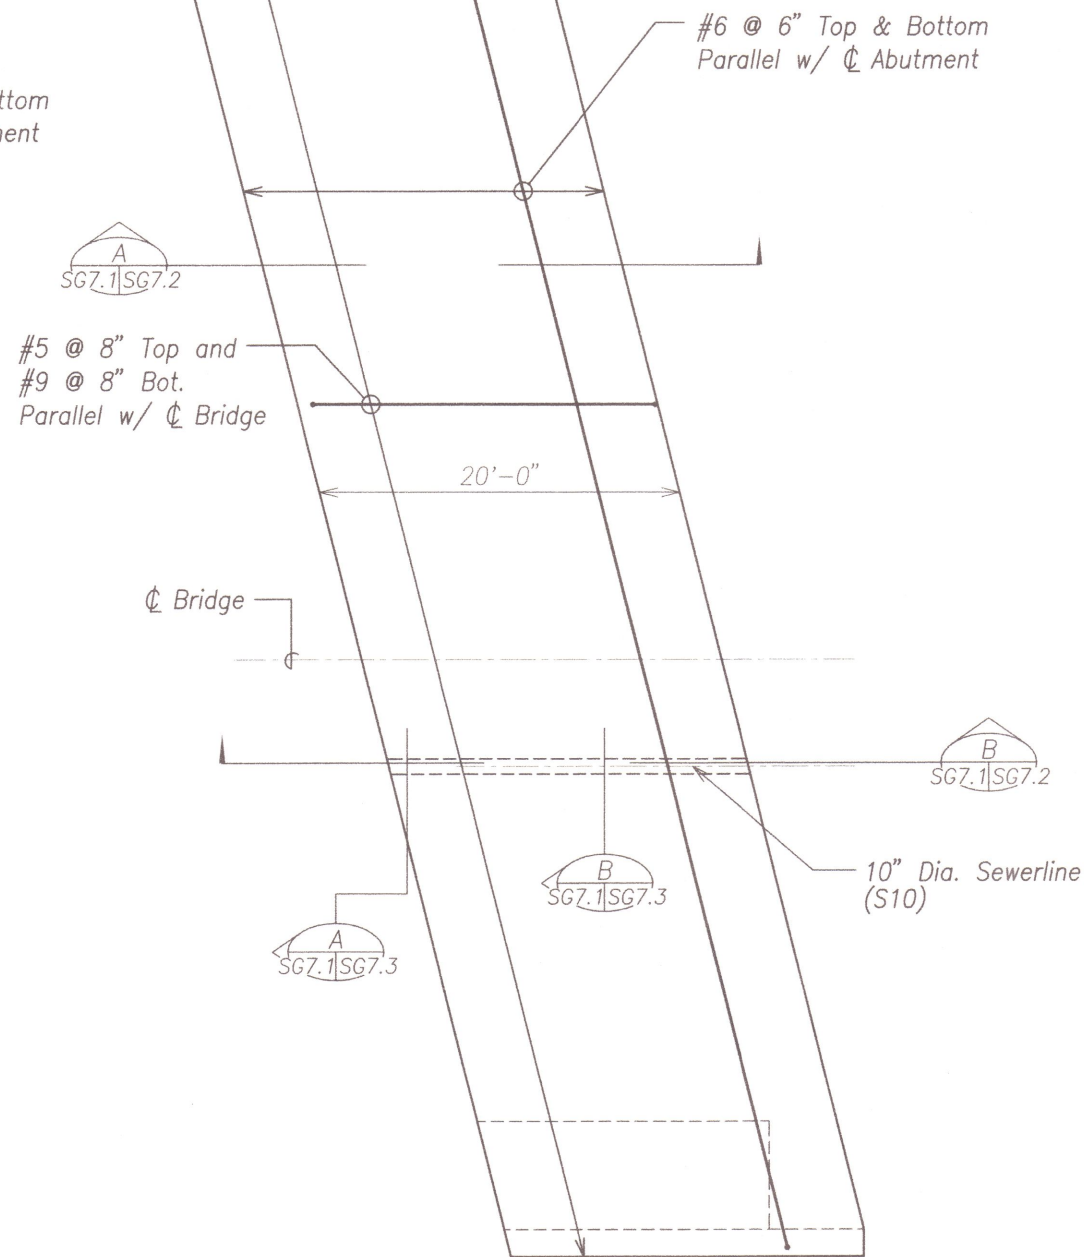

UPPER APPROACH SLAB B
Scale: 3/16" = 1'-0" SG7.1 SG7.1

ORIGINAL PLAN	SURVEY PLOTTED BY	DATE
NOTE BOOK	DRAWN BY	
No.	DESIGNED BY	
	QUANTITIES BY	
	CHECKED BY	

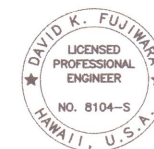

THIS WORK WAS PREPARED BY ME
OR UNDER MY SUPERVISION.
David K. Fujiwara
KSF, INC. APRIL 30, 2010
LIC. EXP. DATE



STATE OF HAWAII
DEPARTMENT OF TRANSPORTATION
HIGHWAYS DIVISION

APPROACH SLAB PLANS

HONOAPIILANI HIGHWAY REALIGNMENT, PHASE 1A
Future Keawe St Extension to Lahainaluna Rd
Part A: Off Ramp Mass Grading
Fed. Aid Proj. No. NH-030-1(35)R
Scale: As Noted Date: April, 2009

SHEET No. SG7.1 OF 3 SHEETS

FED. ROAD DIST. NO.	STATE	FED. AID PROJ. NO.	FISCAL YEAR	SHEET NO.	TOTAL SHEETS
HAWAII	HAW.	NH-030-1(35)R	2009	162	286

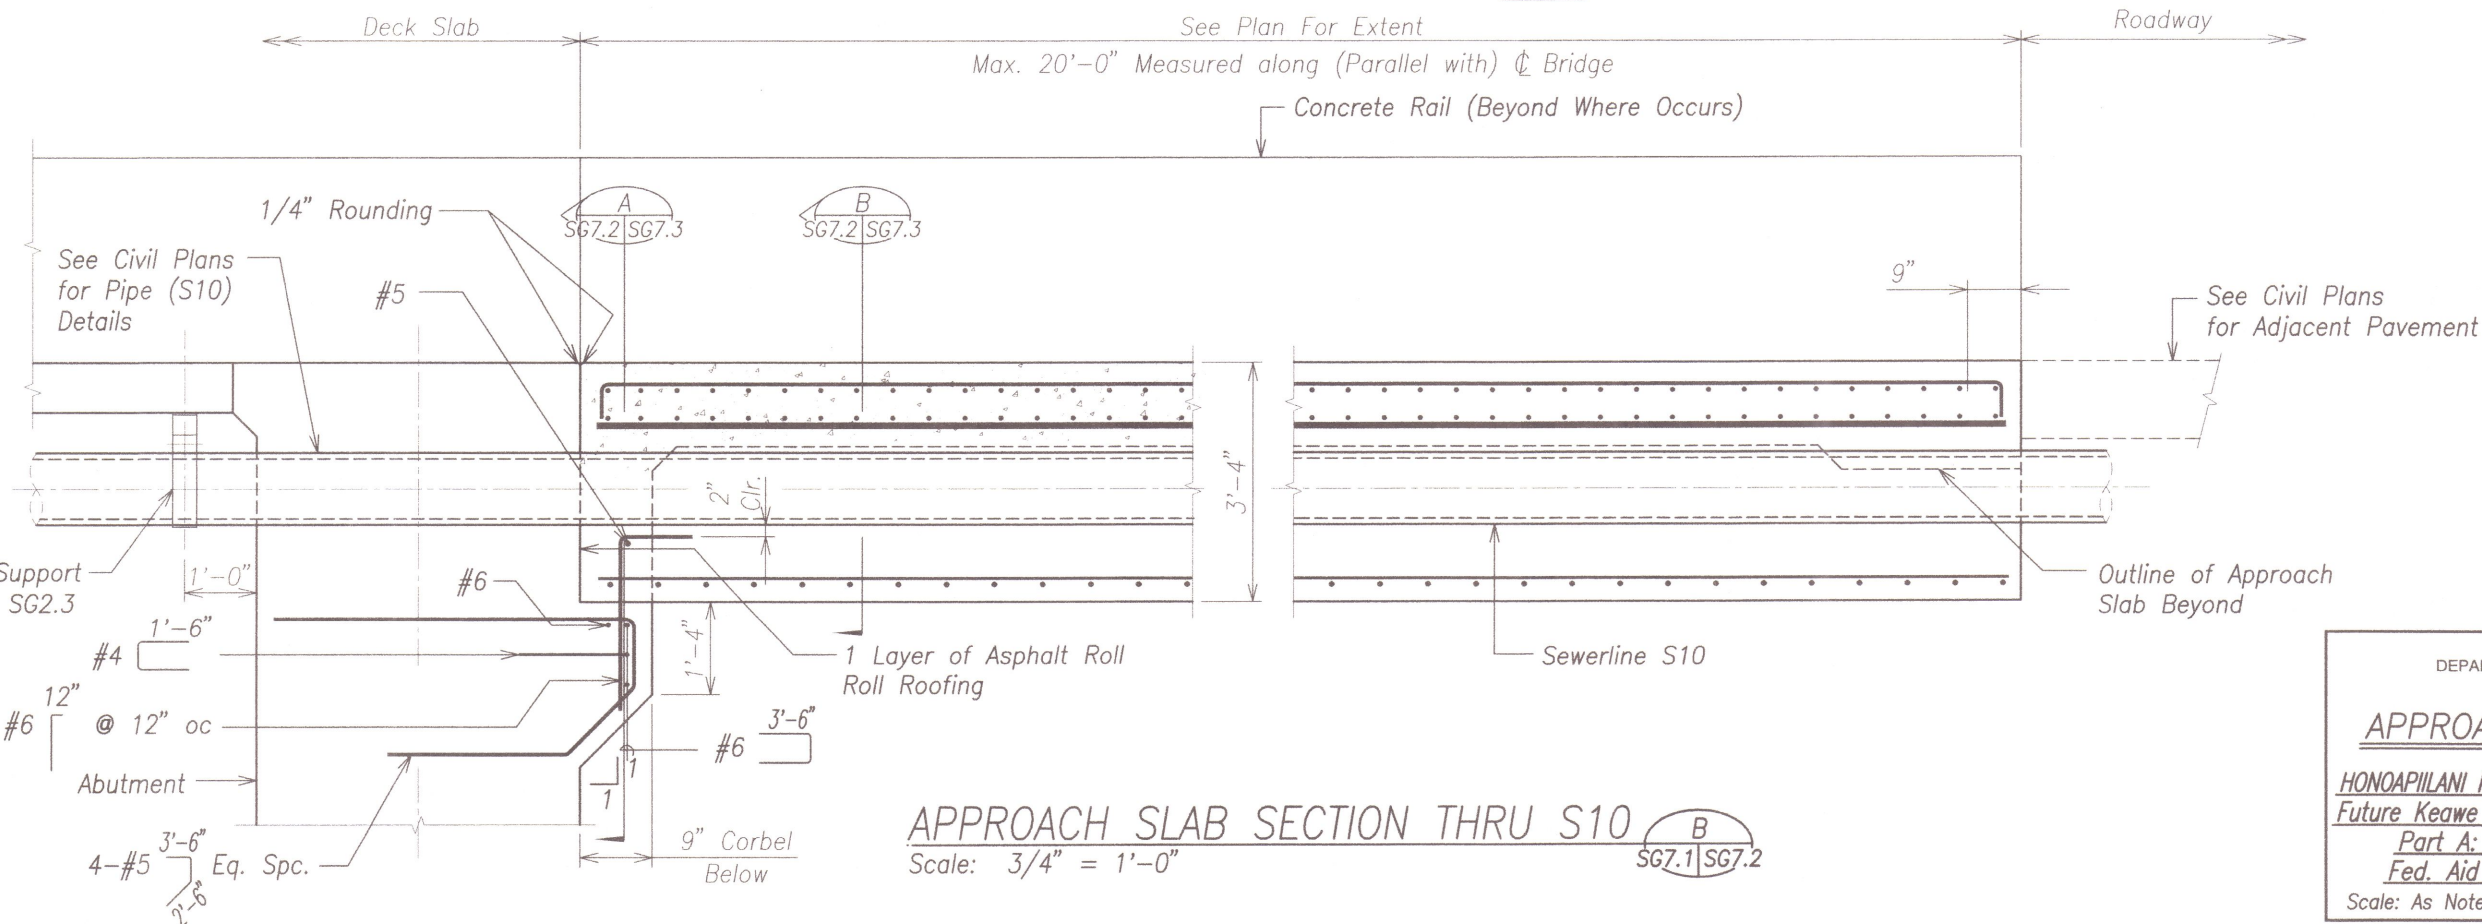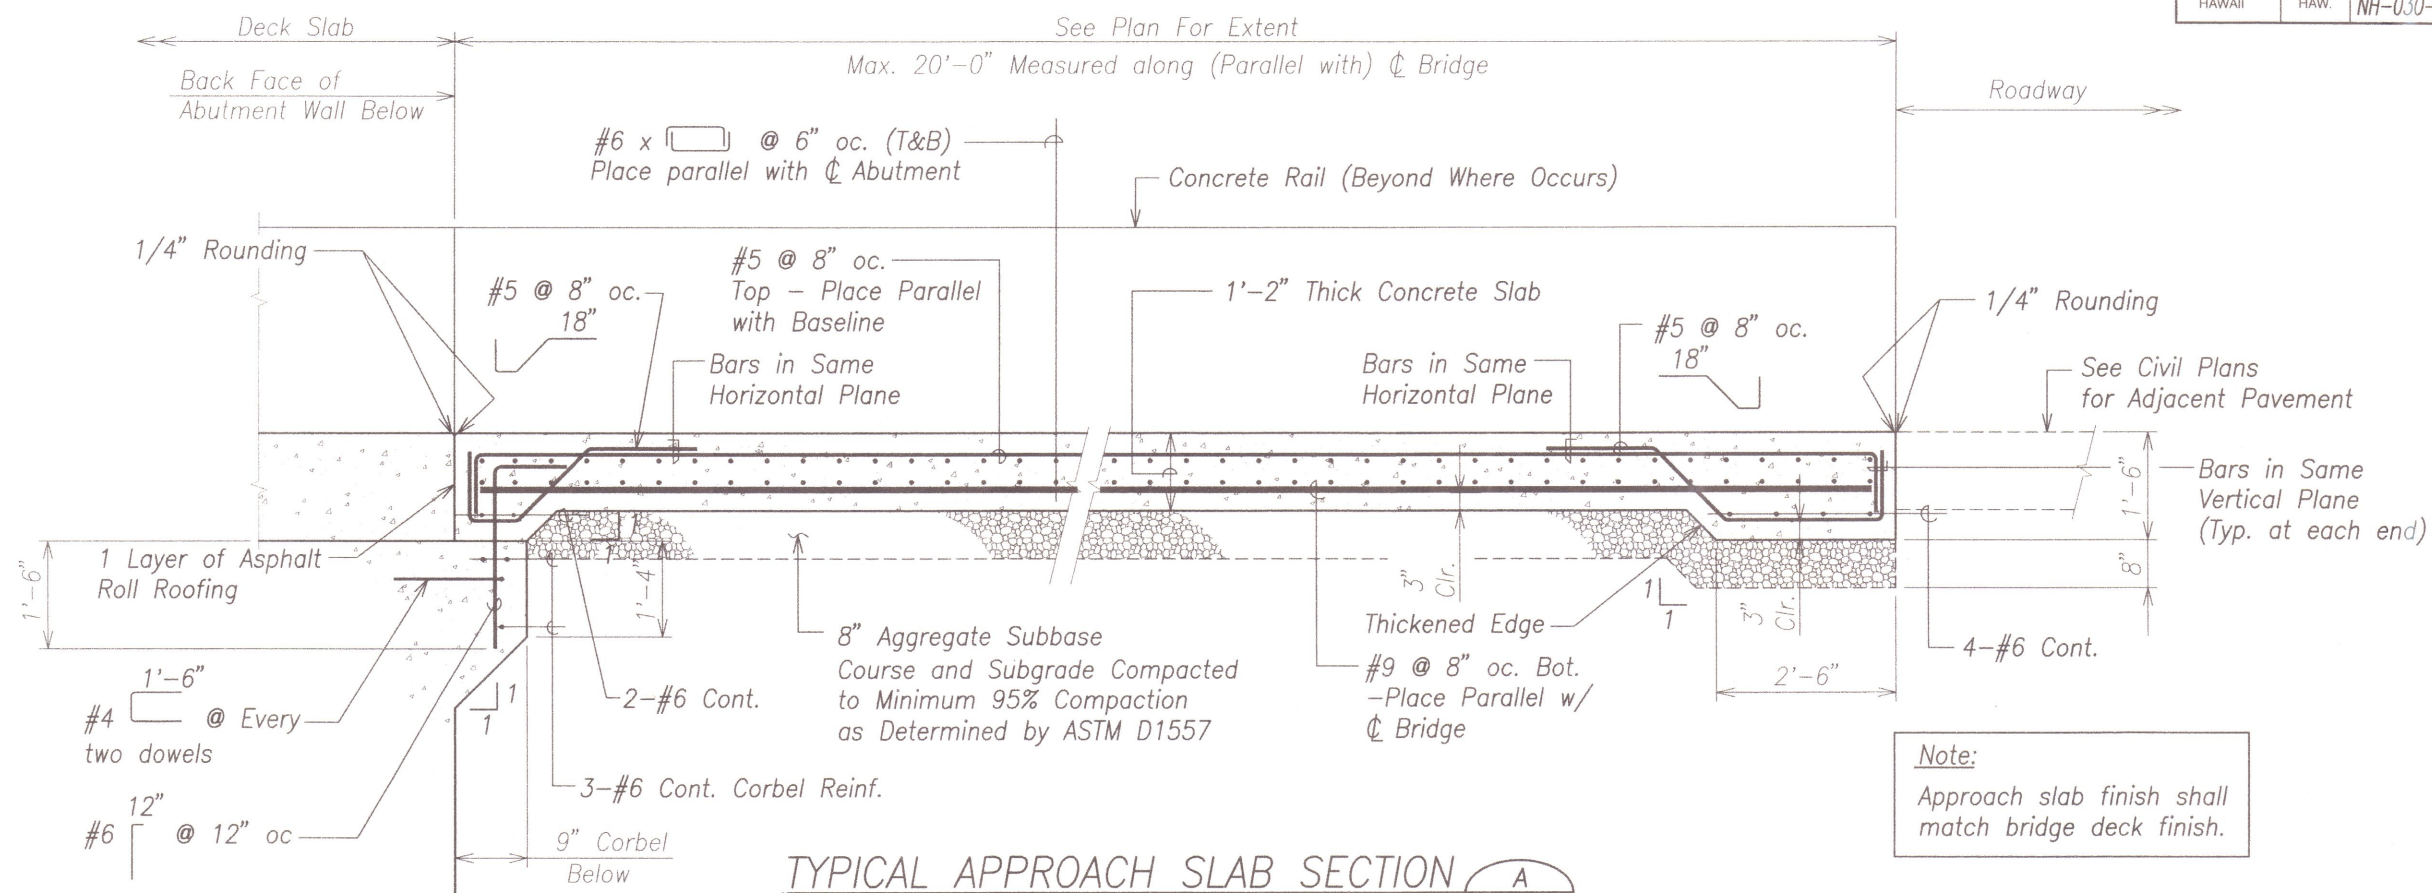

THIS WORK WAS PREPARED BY ME OR UNDER MY SUPERVISION.

David K. Fujiwara
KSF, INC. APRIL 30, 2010
LIC. EXP. DATE


STATE OF HAWAII
DEPARTMENT OF TRANSPORTATION
HIGHWAYS DIVISION

APPROACH SLAB SECTION

HONOLULU HIGHWAY REALIGNMENT, PHASE 1A
Future Keawe St Extension to Lahainaluna Rd
Part A: Off Ramp Mass Grading
Fed. Aid Proj. No. NH-030-1(35)R
Scale: As Noted Date: April, 2009

SHEET No. SG7.2 OF 3 SHEETS


FED. ROAD DIST. NO.	STATE	FED. AID PROJ. NO.	FISCAL YEAR	SHEET NO.	TOTAL SHEETS
HAWAII	HAW.	NH-030-1(35)R	2009	163	286

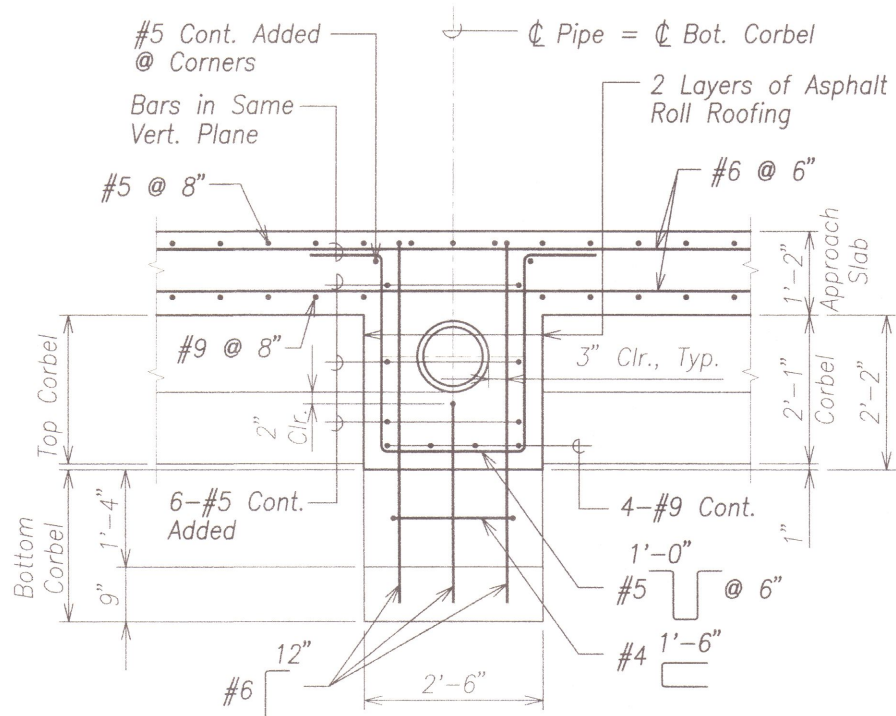

ELEVATION - CORBEL
AT SEWER PIPE

Scale: 3/4" = 1'-0"

SG7.1 SG7.3
SG7.2

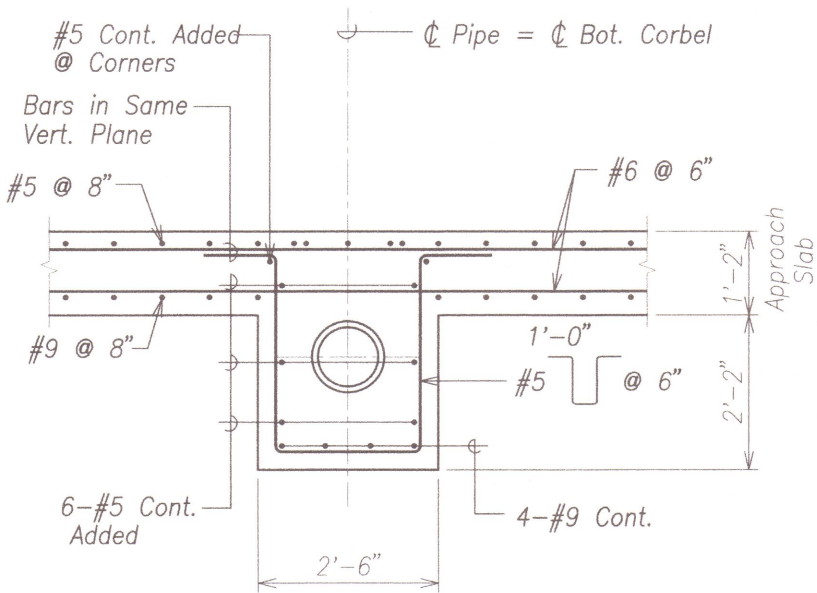

SECTION - APPROACH SLAB
AT SEWER PIPE

Scale: 3/4" = 1'-0"

SG7.1 SG7.3
SG7.2



THIS WORK WAS PREPARED BY ME
OR UNDER MY SUPERVISION.

David K. Fujiwara
KSF, INC. APRIL 30, 2010
LIC. EXP. DATE

STATE OF HAWAII
DEPARTMENT OF TRANSPORTATION
HIGHWAYS DIVISION


APPROACH SLAB SECTIONS

HONOAPIILANI HIGHWAY REALIGNMENT, PHASE 1A
Future Keawe St Extension to Lahainaluna Rd
Part A: Off Ramp Mass Grading
Fed. Aid Proj. No. NH-030-1(35)R


Scale: As Noted Date: April, 2009

SHEET No. SG7.3 OF 3 SHEETS



FED. ROAD DIST. NO.	STATE	FED. AID PROJ. NO.	FISCAL YEAR	SHEET NO.	TOTAL SHEETS
HAWAII	HAW.	NH-030-1(35)R	2009	164	286

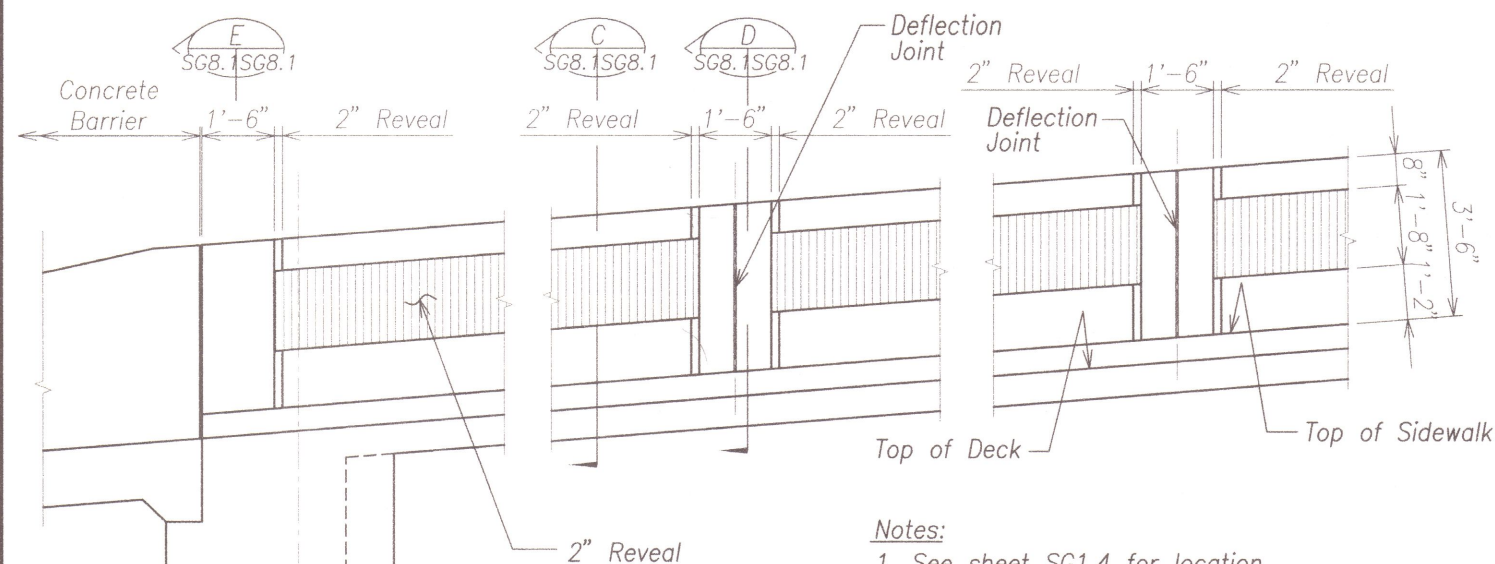


EXTERIOR RAILING ELEVATION A
Scale: 1/2" = 1'-0" SG8.1 SG8.1

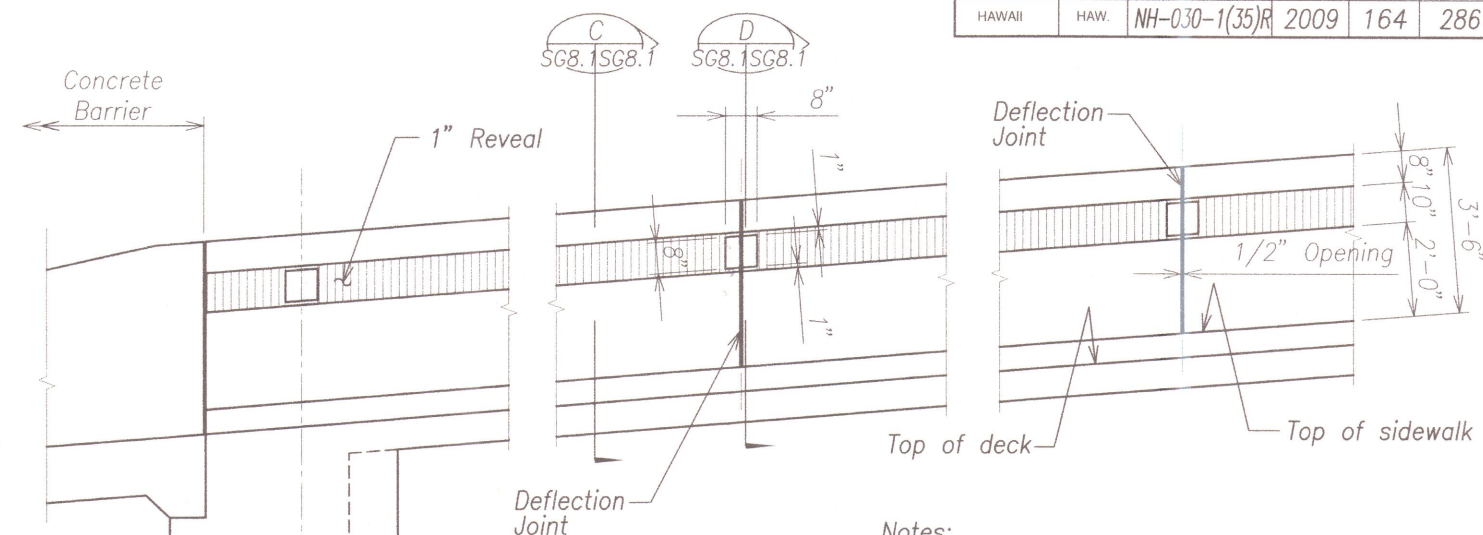

INTERIOR RAILING ELEVATION B
Scale: 1/2" = 1'-0" SG8.1 SG8.1

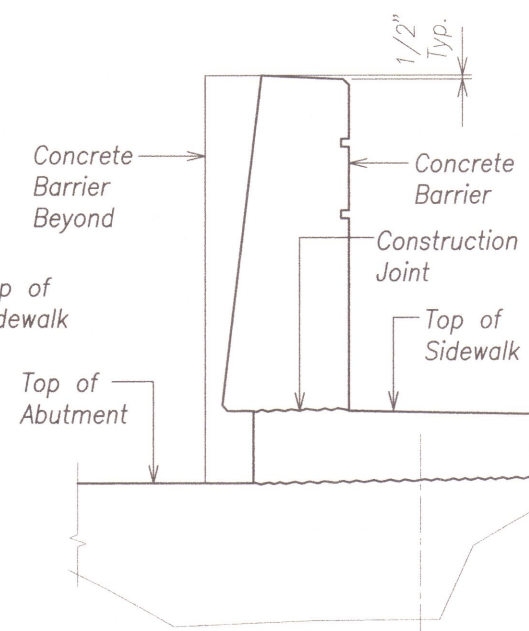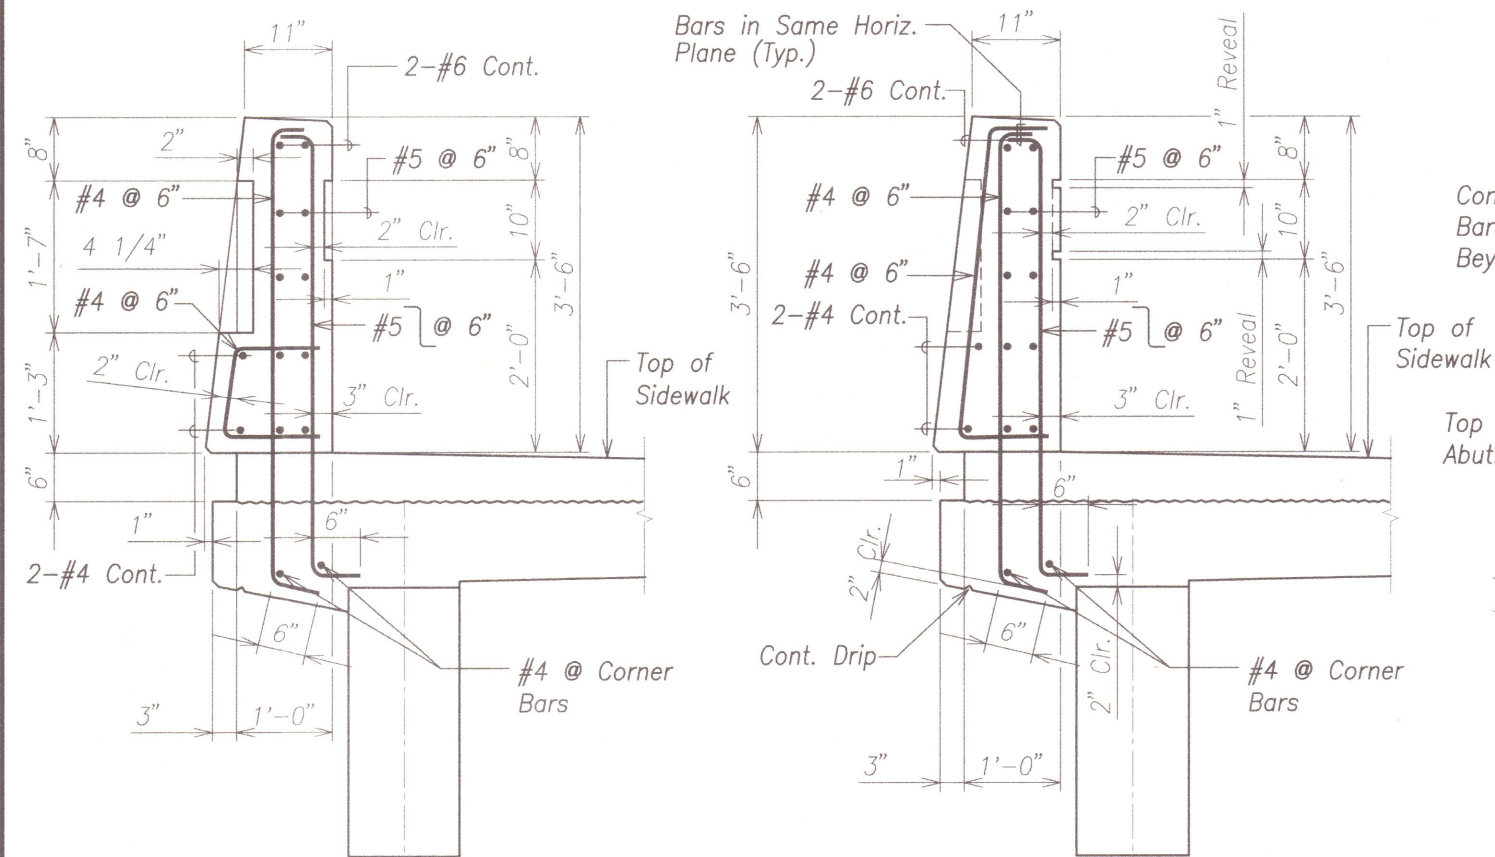

SECTION E
Scale: 1" = 1'-0" SG8.1 SG8.1

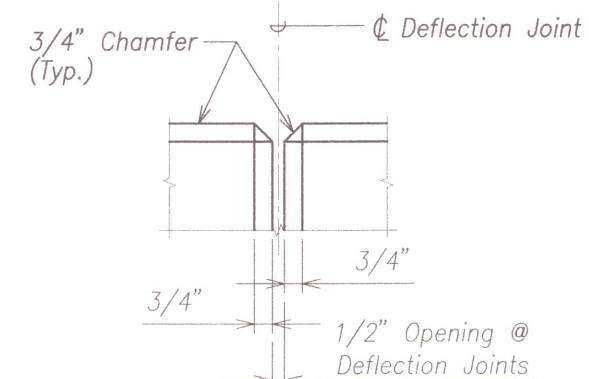


DEFLECTION JOINT DETAIL 1
Scale: 3" = 1'-0" SG8.1 SG8.1



THIS WORK WAS PREPARED BY ME OR UNDER MY SUPERVISION.
David K. Fujiwara
KSF, INC. APRIL 30, 2010 LIC. EXP. DATE

STATE OF HAWAII
DEPARTMENT OF TRANSPORTATION
HIGHWAYS DIVISION
CONCRETE RAILING ELEVATIONS AND SECTIONS
HONOLULU HIGHWAY REALIGNMENT, PHASE 1A
Future Keawe St Extension to Lahainaluna Rd
Part A: Off Ramp Mass Grading
Fed. Aid Proj. No. NH-030-1(35)R
Scale: As Noted Date: April, 2009
SHEET No. SG8.1 OF 5 SHEETS

FED. ROAD DIST. NO.	STATE	FED. AID PROJ. NO.	FISCAL YEAR	SHEET NO.	TOTAL SHEETS
HAWAII	HAW.	NH-030-1(35)R	2009	165	286

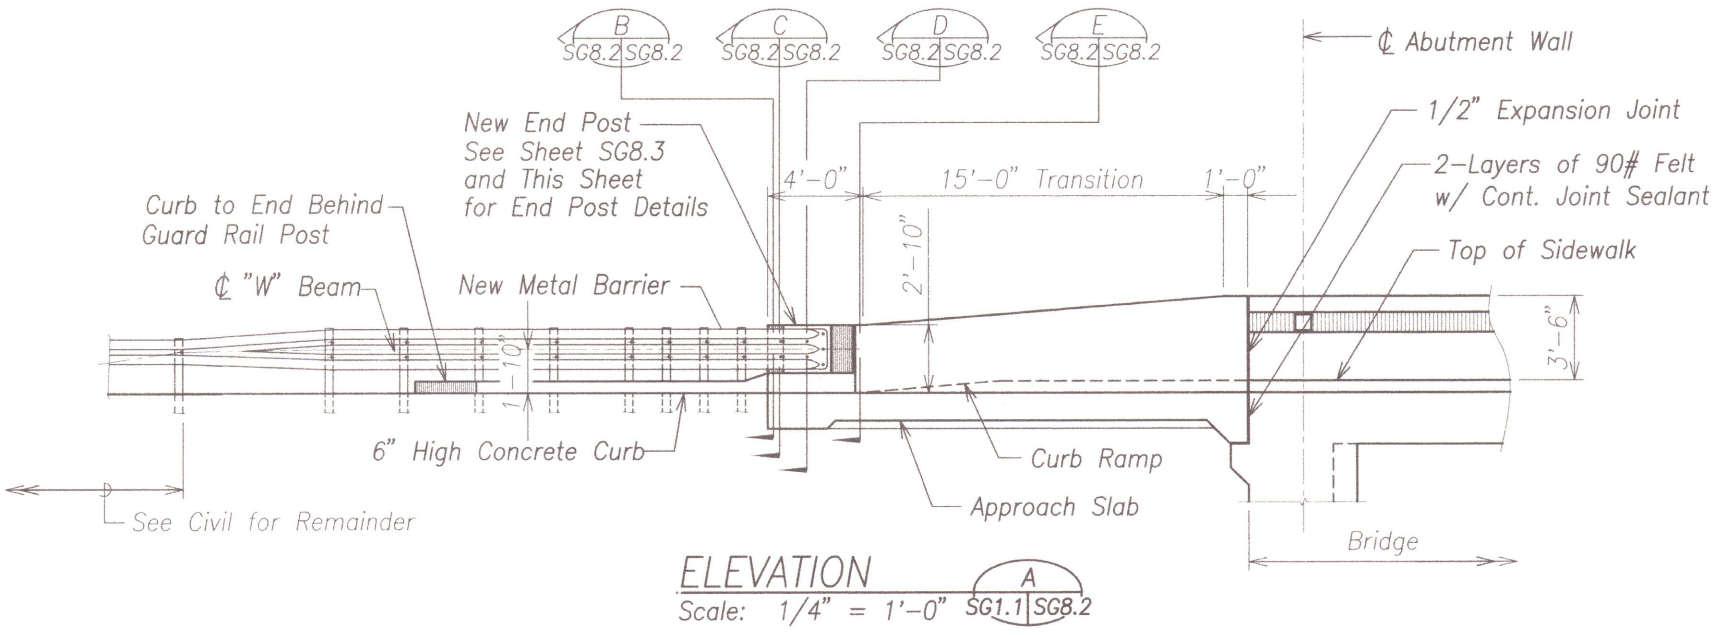


1/2"
 NAME
 3/8" Deep
 DATE

Name of Bridge
 Date of Year Built


- NOTES:
- Exact details and spacing of letter and figures and location shall be as directed by the Engineer. Gothic letters and figures approximating the dimensions shown will be acceptable if approved by the Engineer.
 - Name & date shall be place on the trailing (exit) end post on each side of bridge.
 - Unless otherwise directed by the Engineer, The name of the bridge shall be "LAHAINALUNA ROAD GRADE SEPARATION". The date shall be 2009.

TYPICAL DETAIL OF LETTERS AND FIGURES

BRIDGE IDENTIFICATION DETAIL
 Scale: 3" = 1'-0" SG8.2|SG8.2

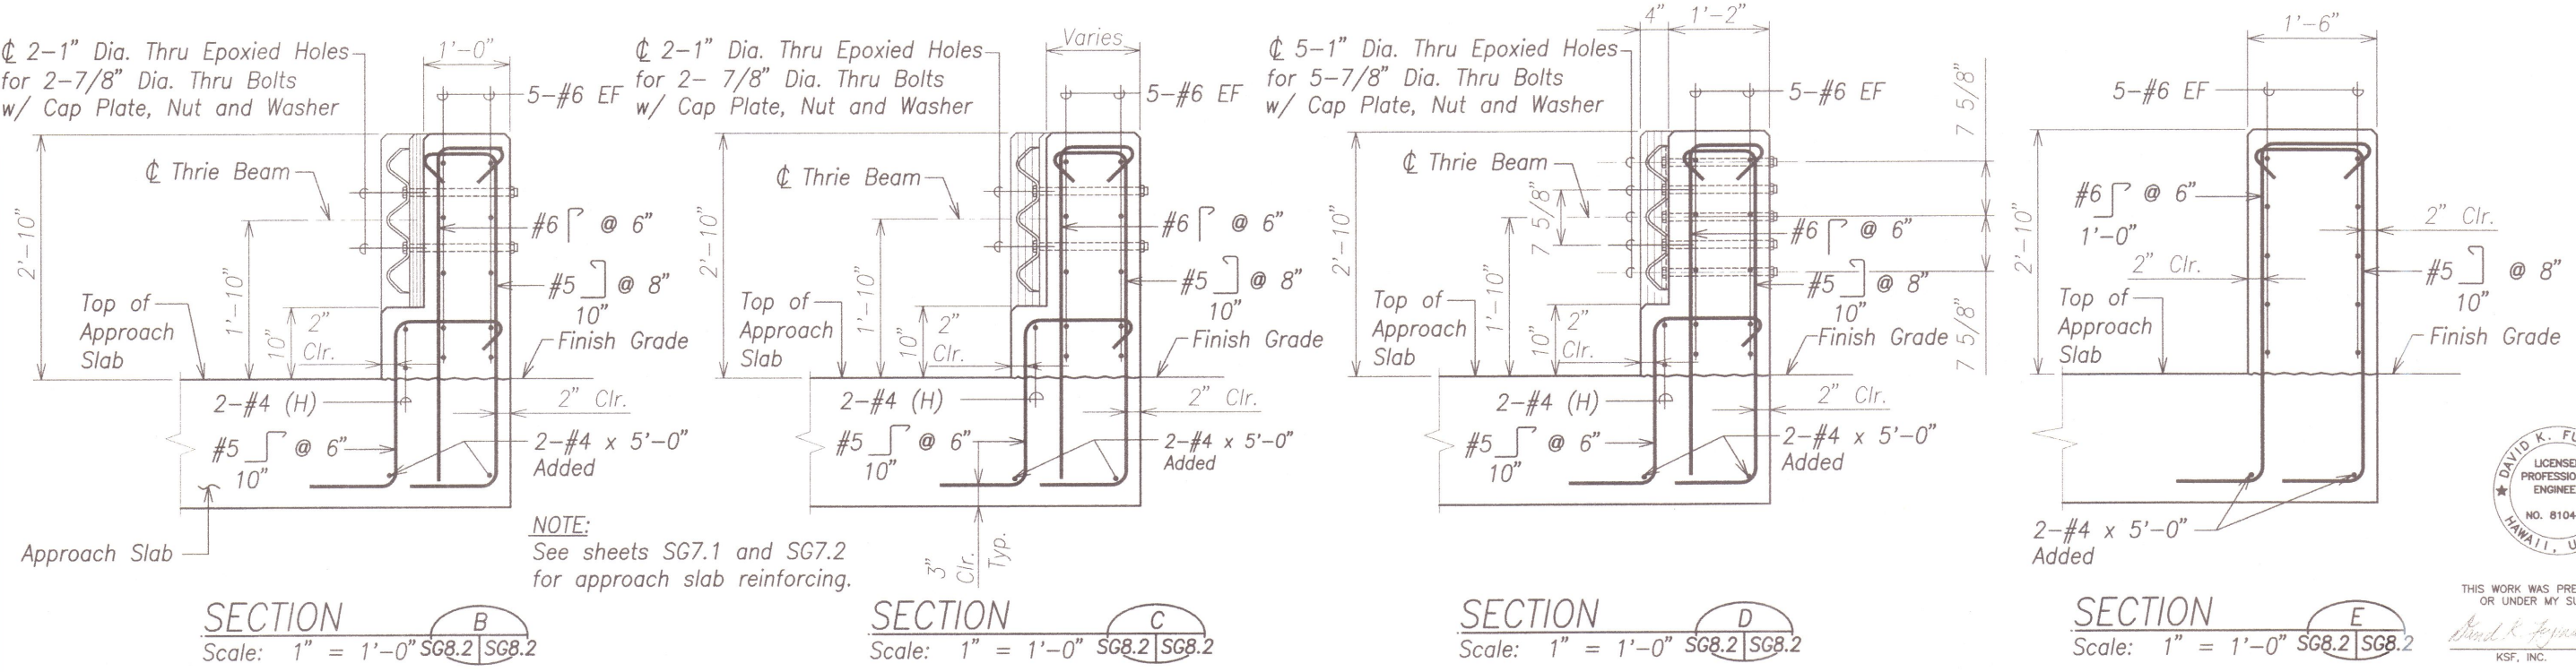


SURVEY PLOTTED BY	DATE
DRAWN BY	
TRACED BY	
QUANTITIES BY	
CHECKED BY	
ORIGINAL PLAN	
NOTE BOOK	
No.	

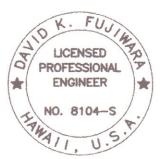



THIS WORK WAS PREPARED BY ME
 OR UNDER MY SUPERVISION.
 David K. Fujiwara
 KSF, INC. APRIL 30, 2010
 LIC. EXP. DATE

STATE OF HAWAII
 DEPARTMENT OF TRANSPORTATION
 HIGHWAYS DIVISION
GUARD RAIL AND END POST -
ELEVATION AND SECTIONS
 HONOAPILANI HIGHWAY REALIGNMENT, PHASE 1A
 Future Keawe St Extension to Lahainaluna Rd
 Part A: Off Ramp Mass Grading
 Fed. Aid Proj. No. NH-030-1(35)R
 Scale: As Noted Date: April, 2009
 SHEET No. SG8.2 OF 5 SHEETS



David E. Ferguson APRIL 30, 2010
KSF, INC. LIC. EXP. DATE

SHEET No. SG8.3 OF 5 SHEETS

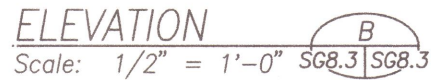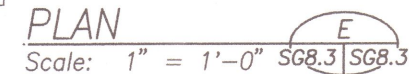

TYPICAL TYPE 3 THRIE BEAM METAL GUARDRAIL FOR END POST

Scale: $1/2" = 1'-0"$

SG8.3 | SG8.3


ORIGINAL PLAN	SURVEY PLOTTED BY _____ DATE _____
NOTE BOOK	DRAWN BY _____
	TRACED BY _____
	DESIGNED BY _____
	QUANTITIES BY _____
No. _____	CHECKED BY _____

FED. ROAD DIST. NO.	STATE	FED. AID PROJ. NO.	FISCAL YEAR	SHEET NO.	TOTAL SHEETS
HAWAII	HAW.	NH-030-1(35)R	2009	167	286

Notes:


1. See SG1.1 for Curve Data.
2. See SG8.5 for concrete rail transition elevations.

** See requirement on sheet SG5.2.

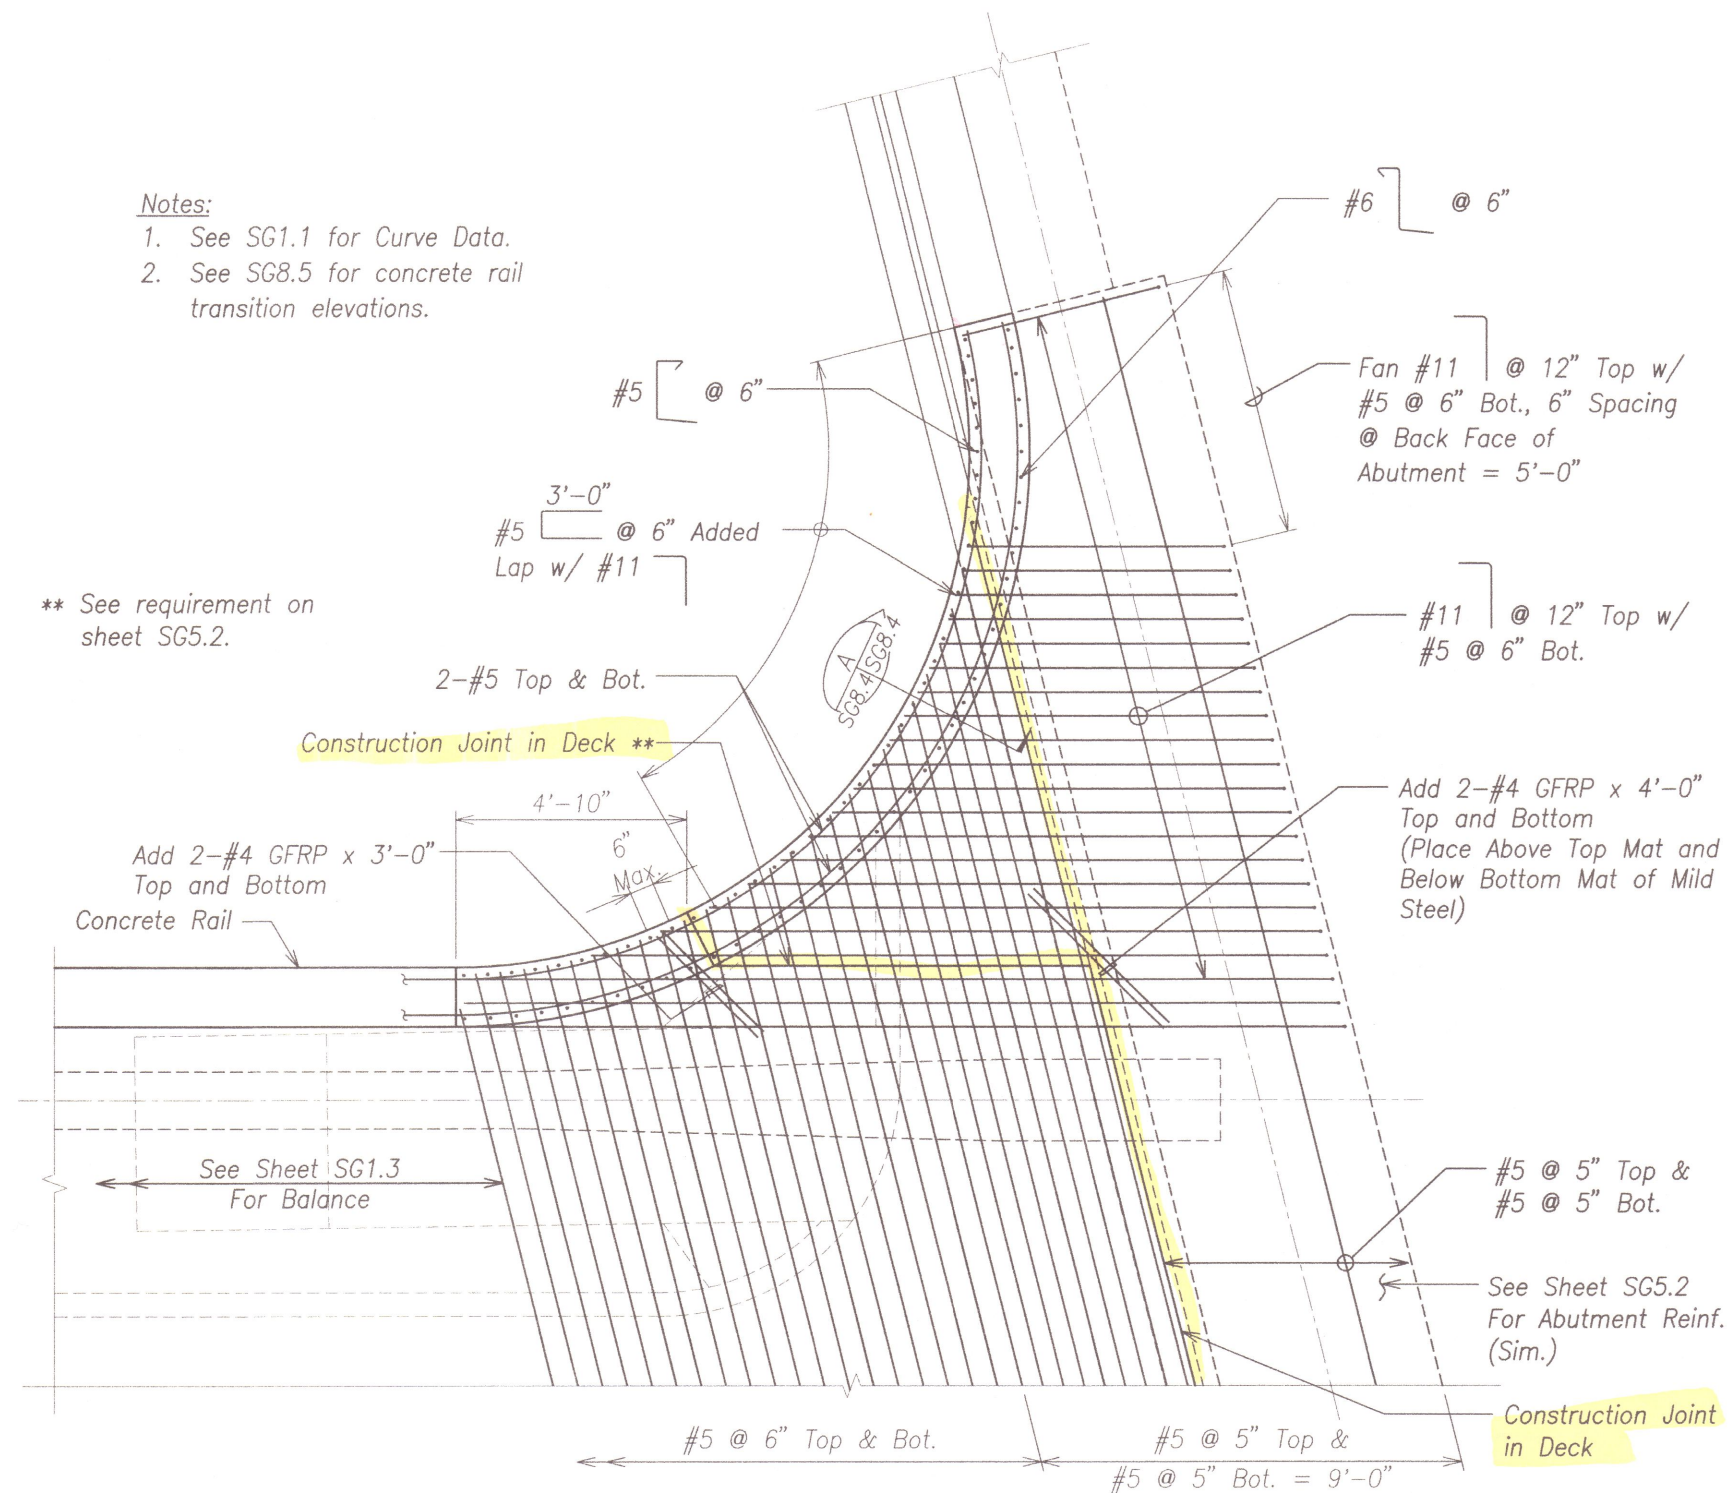

DETAIL

Scale: $1/2" = 1'-0"$ SG1.3 | SG8.4

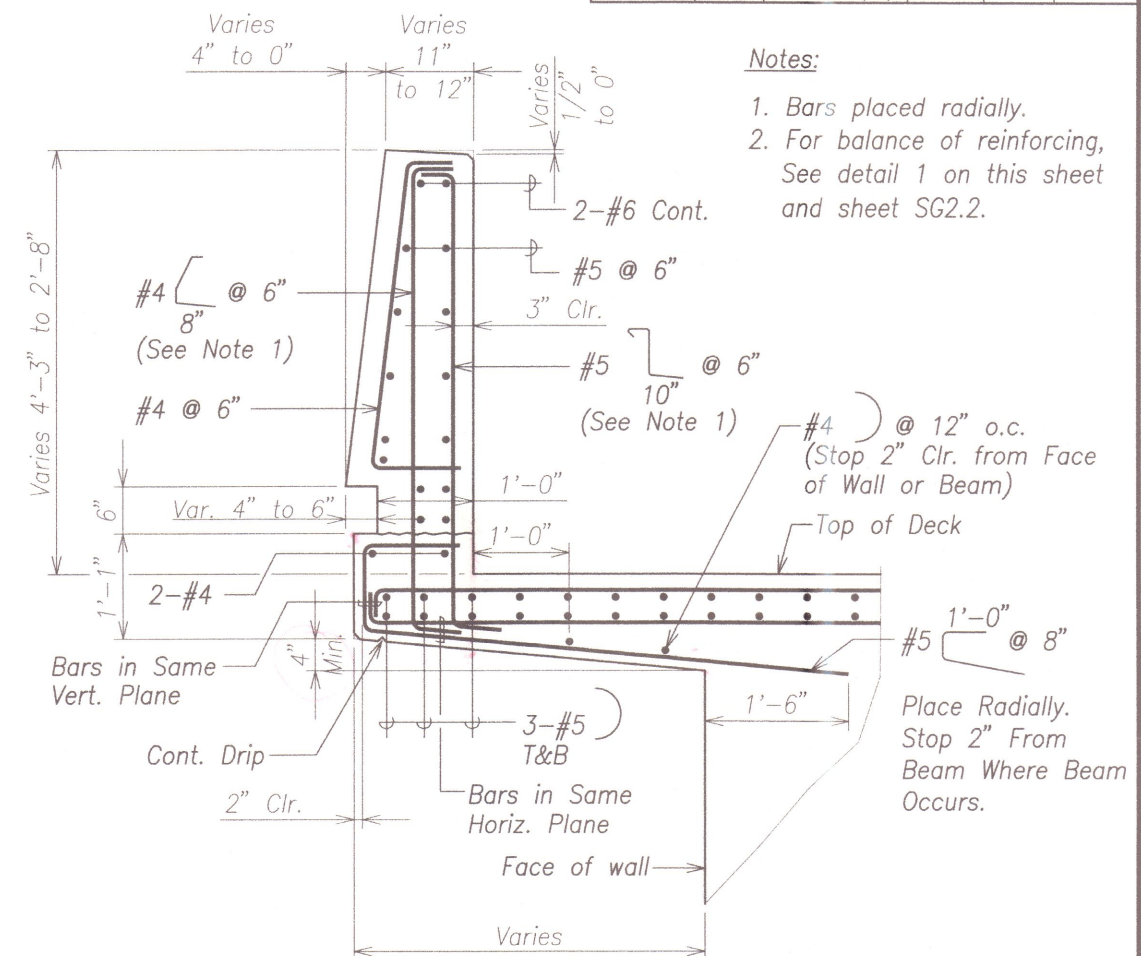


SECTION

Scale: 1" = 1'-0" SG8.4 SG8.4
SG8.5

Notes:

1. Bars placed radially.
2. For balance of reinforcing,
See detail 1 on this sheet
and sheet SG2.2.

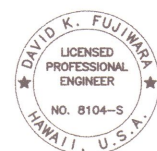

THIS WORK WAS PREPARED BY ME
OR UNDER MY SUPERVISION.

David K. Fymani APRIL 30, 2010
KSF, INC. LIC. EXP. DATE

STATE OF HAWAII
DEPARTMENT OF TRANSPORTATION
HIGHWAYS DIVISION
CONCRETE RAIL TRANSITION
PLAN AND SECTION
HONOAPIILANI HIGHWAY REALIGNMENT, PHASE 1A
Future Keawe St Extension to Lahainaluna Rd
Part A: Off Ramp Mass Grading
Fed. Aid Proj. No. NH-030-1(35)R
Scale: As Noted Date: 2009

SHEET No. SG8.4 OF 5 SHEETS

ORIGINAL PLAN	SURVEY PLOTTED BY _____ DATE _____
NOTE BOOK	DRAWN BY _____
	TRACED BY _____
	DESIGNED BY _____
	QUANTITIES BY _____
No. _____	CHECKED BY _____

ORIGINAL PLAN	SURVEY PLOTTED BY _____	DATE _____
NOTE BOOK	DRAWN BY _____	" _____
	TRACED BY _____	" _____
	DESIGNED BY _____	" _____
	QUANTITIES BY _____	" _____
No. _____	CHECKED BY _____	" _____

CONSTRUCTION SEQUENCE – LAHAINALUNA ROAD GRADE SEPARATION STRUCTURE

FED. ROAD DIST. NO.	STATE	FED. AID PROJ. NO.	FISCAL YEAR	SHEET NO.	TOTAL SHEETS
HAWAII	HAW.	NH-030-1(35)R	2009	169	379

STAGE

- 1 Construct detour road. See Civil Plans.
- 2 Cast beams.
- 3 Probe and grout at abutments. Pour waste slab.
- 4 Construct abutments after concrete in Stage 3 has attained a compressive strength of at least 3,000 psi.
Install diagonal (tilt-up) bracing prior to removing horizontal bracing for abutment formwork/falsework.

Note: Stages 5 and 6 maybe done concurrently.

- 5 Backfill in front of abutment footing w/ Class "D" concrete. Backfill in back of abutment up to an elevation that is 1 ft. below horiz. joint after concrete in Stage 4 has attained a compressive strength of at least 8,000 psi.
- 6 Install falsework. Place wedge between bottom 9" at end of beams and 9" vertical abutment lip.
- 7 Erect beams on falsework.
- 8 Pour closure joint and diaphragm.
- 9 Pour deck.

STAGE

- 10 Apply corrosion inhibitor amine carboxylate powder (Cortec MCI-309) in all post tension ducts. Post tension longitudinal tendons in beams 28 days after concrete pour in Stages 8 and 9, and the concrete in Stages 8 and 9 have attained a compressive strength of 8,000 psi. Coat wedges with epoxy or ZRC. (Note: Post tension ducts will be grouted after end beam pour).
[Verify Bridge did not lift off of falsework.]
- 11 Pour sidewalks. Do not pour curb ramp at depression.
- 12 Remove wedge between beams end of and 9" abutment lip. Remove falsework supporting vertical loads 21 days after concrete pour in Stage 11 and the concrete in Stage 11 has attained a compressive strength of 8,000 psi.
Do not remove diagonal (Tilt-up) bracing.
- 13 Fill gaps behind the girders at the abutments with the same prepackage post tensioning grout as used in the girders. Inject epoxy into gaps under girders with Sikadur 55 SLV.
- 14 Remove diagonal (Tilt-up) bracing at least 72 hours after the grouting in Stage 13 and until the grout in Stage 13 has attained a compressive strength of 5,000 psi.
- 15 Re-shore falsework supporting Girder G-1 under overhang at on-ramp.

STAGE

- 16 Pour overhang at on-ramp.
- 17 Pour end beams, and corbels at least 7 days after the concrete pour in Stage 16. The concrete pour shall occur between mid-night and 3:00 AM (3 hours).
[Coordinate installation and removal of grout tubes with AVAR.]
- 18 Remove falsework under on-ramp at least 14 days after the concrete pour in Stage 17.
- 19 Grout post tension ducts. Grout shall be prepackaged.
- 20 Backfill remainder of abutment and construct approach slab and curb ramps once grout in Stage 19 has aged for 72 hours and has attained a compressive strength of 5,000 psi.
- 21 Construct railings and end post after approach slab has aged 7 days and has attained a compressive strength of 4,000 psi.
- 22 Grind and mechanical groove deck and approach slab 7 days after the concrete pour in Stage 21 but not before the concrete in Stage 21 has attained a compressive strength of 4,000 psi. Re-apply SINAK LITHIUM over entire bridge deck and approach slab.
- 23 Bridge may be opened for traffic.


CONSTRUCTION SEQUENCE NOTES:

1. Order of construction sequence shall not be changed.
2. Each sequence stage shall be completely finished before proceeding to the next stage unless otherwise noted. The Engineer of record will be the sole judge of whether the sequence stage is complete, and may direct the Contractor to stop work on a sequence stage to complete work on the preceeding sequence stage.



THIS WORK WAS PREPARED BY ME OR UNDER MY SUPERVISION.

KSF, INC. APRIL 30, 2010 LIC. EXP. DATE

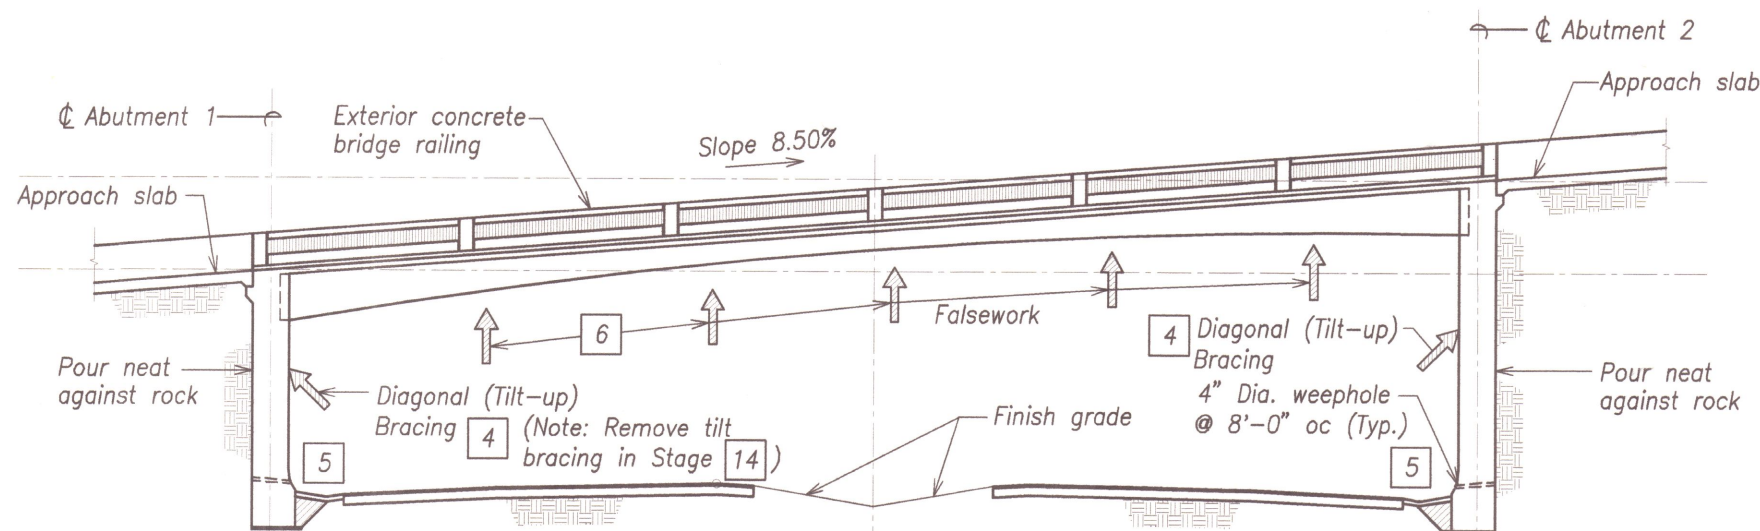

CONSTRUCTION SEQUENCE A
Scale: 1" = 10'-0"
SG9.1 SG9.1

4/20/10	1 Revised Construction Sequence
DATE	REVISION

STATE OF HAWAII DEPARTMENT OF TRANSPORTATION HIGHWAYS DIVISION
CONSTRUCTION SEQUENCE
HONOAPIILANI HIGHWAY REALIGNMENT, PHASE 1A Future Keawe St Extension to Lahainaluna Rd, Part B Fed. Aid Proj. No. NH-030-1(35)R Scale: As Noted
SHEET No. SG9.1 OF 1 SHEETS

100% DESIGN 169

SURVEY PLOTTED BY	DATE
DRAWN BY	
CHECKED BY	
NOTED BY	
ORIGINAL PLAN	
NOTE BOOK	
No.	

DRAWING NAME: Z:\2004\40019.0-HONOAPIILANI LAHAINA BYPASS-KAHOMA WOI\04-20-10 COMBINE LAHAINA CONSTRUCTN SEQ\HH-SG901.DWG PLOT TIME: 04-20-10, 2:50 PM

270-7511
Don.

CONSTRUCTION SEQUENCE - LAHAINALUNA ROAD GRADE SEPARATION STRUCTURE

STAGE

- 1 Construct detour road. See Civil Plans.
 - 2 Cast beams.
 - 3 Probe and grout at abutments. Pour waste slab.
 - 4 Construct abutments after concrete in stage 3 has attained a compressive strength of at least 3,000 psi.
Install diagonal (tilt-up) bracing prior to removing horizontal bracing for abutment formwork/falsework.
- Note:** Stages 5 and 6 maybe done concurrently.
- 5 Backfill in front of abutment footing w/ Class "D" concrete. Backfill in back of abutment up to an elevation that is 1 ft. below horiz. joint after concrete in stage 4 has attained a compressive strength of at least 8,000 psi.
 - 6 Install falsework. Place wedge between bottom 9" at end of beams and 9" vertical abutment lip.
 - 7 Erect beams on falsework.
 - 8 Pour closure joint and diaphragm.

STAGE


- 9 Pour deck.
- 10 Apply corrosion inhibitor amine carboxylate powder (Cortec MCI-309) in all post tension ducts. Post tension longitudinal tendons in beams 28 days after concrete pour in Stages 8 and 9, and the concrete in Stages 8 and 9 have attained a compressive strength of 8,000 psi.
- 11 Grout post tension ducts. Grout shall be prepackaged.
- 12 Pour sidewalks once grout in Stage 11 has aged for 72 hours and has attained a compressive strength of 5,000 psi.
- 13 Remove wedge between beams end of and 9" abutment lip. Remove falsework supporting vertical loads 21 days after concrete pour in stage 12 and the concrete in stage 12 has attained a compressive strength of 8,000 psi.
Do not remove diagonal (Tilt-up) bracing.
- 14 Fill gaps behind the girders at the abutments with the same prepackage post tensioning grout as used in the girders. Inject epoxy into gaps under girders with Sikadur 55 SLV.

STAGE

- 15 Pour end beams, remainder of deck, sidewalk, and corbel at least 72 hours after the grouting operation in Stage 14, whichever occurs later. The concrete pour shall occur between midnight and 3:00 AM (3 hours).
- 16 Remove diagonal (Tilt-up) bracing at least 14 days after the concrete pour in Stage 15 and until the concrete in Stage 15 has attained a compressive strength of 7,000 psi.
- 17 Backfill remainder of abutment and construct approach slab.
- 18 Construct railings and end post after approach slab has aged 14 days and has attained a compressive strength of 4,000 psi.
- 19 Grind and mechanical groove deck and approach slab 14 days after the concrete pour in Stage 17 but not before the concrete in Stage 17 has attained a compressive strength of 4,000 psi. Re-apply SINAK LITHIUM over entire bridge deck and approach slab.
- 20 Bridge may be opened for traffic.


CONSTRUCTION SEQUENCE NOTES:

1. Order of construction sequence shall not be changed.
2. Each sequence stage shall be completely finished before proceeding to the next stage unless otherwise noted. The Engineer of record will be the sole judge of whether the sequence stage is complete, and may direct the Contractor to stop work on a sequence stage to complete work on the preceeding sequence stage.

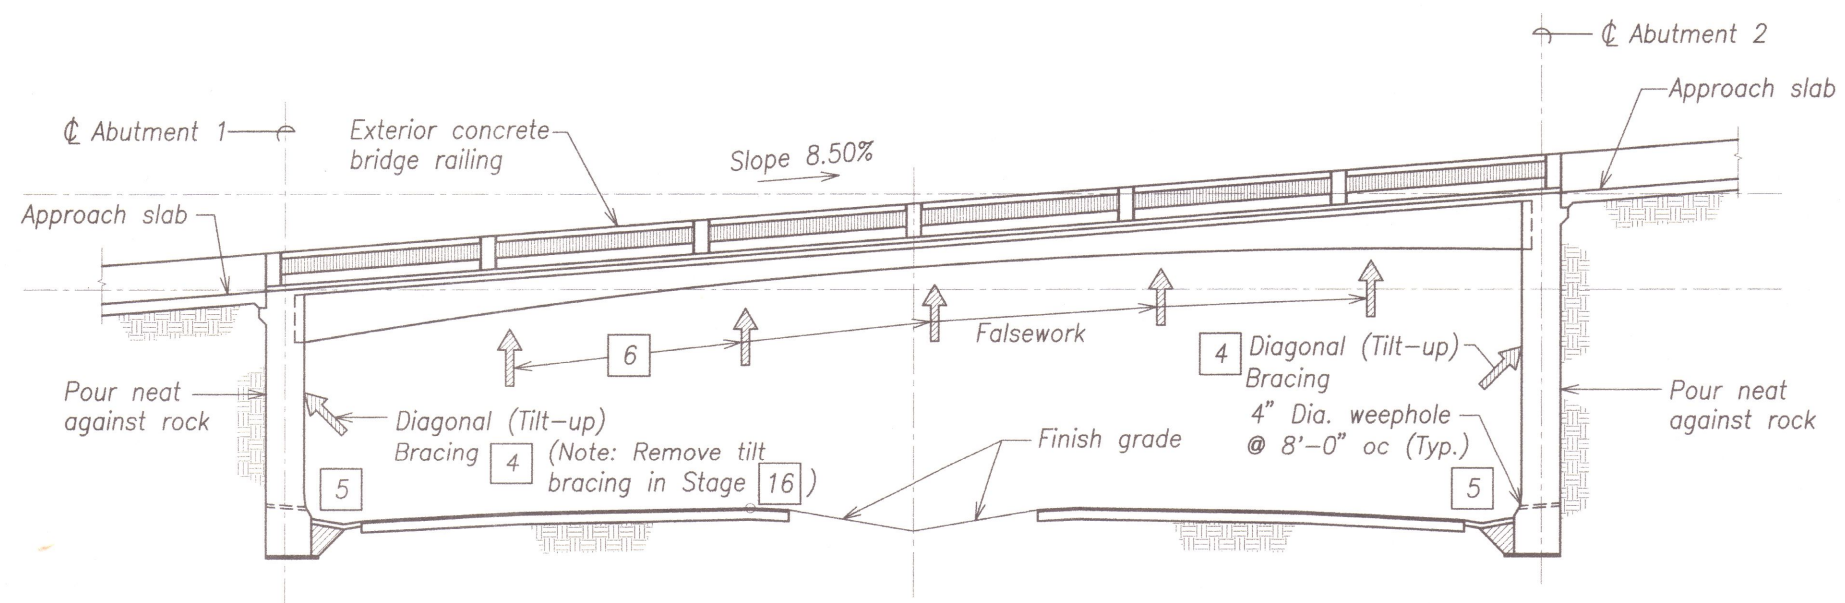

CONSTRUCTION SEQUENCE
Scale: 1" = 10'-0"
A
SG9.1 | SG9.1

SURVEY PLOTTED BY	DATE
DESIGNED BY	
NOTED BY	
CHECKED BY	
ORIGINAL PLAN	
NOTE BOOK	
NO.	

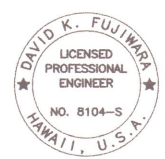

THIS WORK WAS PREPARED BY ME OR UNDER MY SUPERVISION.
David K. Fujiwara
KSF, INC. APRIL 30, 2010 LIC. EXP. DATE

STATE OF HAWAII
DEPARTMENT OF TRANSPORTATION
HIGHWAYS DIVISION

CONSTRUCTION SEQUENCE

HONOLULU HIGHWAY REALIGNMENT, PHASE 1A
Future Keawe St Extension to Lahainaluna Rd
Part A: Off Ramp Mass Grading
Fed. Aid Proj. No. NH-030-1(35)R
Scale: As Noted Date: April, 2009

SHEET No. SG9.1 OF 1 SHEETS