

SURVEY PLOTTED BY	DATE
DESIGNED BY	
TRACED BY	
NOTE BOOK	
QUANTITIES BY	
CHECKED BY	
No.	

DRAWING NAME: 2100 ONGOING 40019.0-HONOAPIILANI LAHANA BYPASS-KAHOMA WO 06-15-10 COMBINE LAHANA FINAL DESIGN\HH-SB001.DWG PLOT TIME: 06-14-10, 2:40 PM)

INDEX TO BRIDGE DRAWINGS

FED. ROAD DIST. NO.	STATE	FED. AID PROJ. NO.	FISCAL YEAR	SHEET NO.	TOTAL SHEETS
HAWAII	HAW.	NH-030-1(35)R	2009	271	383

SHEET NO.	DESCRIPTION
SB0.1	INDEX TO BRIDGE DRAWINGS
SB0.2	INDEX TO BRIDGE DRAWINGS
SB0.3	BRIDGE GENERAL NOTES
SB1.1	KAHOMA STREAM BRIDGE LAYOUT PLAN
SB1.2	KAHOMA STREAM BRIDGE ELEVATION AND SECTION
SB1.3	KAHOMA STREAM BRIDGE ELEVATION
SB1.4	KAHOMA STREAM BRIDGE MODELS
SB2.1	KAHOMA STREAM BRIDGE FOUNDATION PLAN
SB2.2	KAHOMA STREAM BRIDGE DECK FRAMING PLAN
SB2.3	KAHOMA STREAM BRIDGE PRECAST ARCH TIE PLANK
SB3.1	TYPICAL SECTION
SB3.2	TYPICAL SECTION AT BENT
SB3.3	TYPICAL SECTION
SB3.4	BENT ELEVATION
SB3.5	BENT ELEVATION
SB3.6	BENT ELEVATION
SB3.7	BENT ELEVATION
SB3.8	BENT ELEVATION
SB3.9	BENT ELEVATION
SB3.10	BENT ELEVATION
SB4A.1	PRECAST DECK PLANK DETAILS
SB4B.1	IN-SPAN DIAPHRAGM ELEVATIONS
SB4B.2	IN-SPAN DIAPHRAGM SECTIONS
SB5.1	PG-1 PRECAST GIRDER
SB5.2	PG-2 PRECAST GIRDER
SB5.3	PRECAST GIRDER SECTION
SB5.4	SOFFIT ACCESS SECTIONS
SB5.5	SOFFIT ACCESS TYPICAL DETAILS
SB6.1	PRECAST ARCH TIE PLANK
SB6.2	PRECAST ARCH TIE PLANK
SB6.3	PRECAST ARCH TIE PLANK

SHEET NO.	DESCRIPTION
SB6.4	PRECAST ARCH TIE PLANK
SB6.5	PRECAST ARCH TIE PLANK
SB6.6	PRECAST ARCH TIE PLANK NOTES
SB7A.1	TYPICAL BENT ELEVATION
SB7A.2	CIP BEAM ABOVE BENT CAP
SB7A.3	CIP BEAM ABOVE BENT CAP
SB7A.4	CIP BEAM ABOVE BENT CAP
SB7A.5	CIP BEAM ABOVE BENT CAP
SB7A.6	CIP BEAM ABOVE BENT CAP
SB7A.7	CIP BEAM ABOVE BENT CAP
SB7A.8	CIP BEAM ABOVE BENT CAP
SB7A.9	CIP BEAM ABOVE BENT CAP
SB7A.10	CIP BEAM ABOVE BENT CAP
SB7B.1	BENT ELEVATION
SB7B.2	SECTIONS THROUGH COLUMNS
SB7B.3	SECTIONS THROUGH COLUMNS
SB7B.4	BENT SECTIONS AND DETAIL
SB7B.5	BENT SECTION AND DETAIL
SB7C.1	BENT CAP
SB7D.1	STIFFENER BEAM SECTIONS AND DETAIL
SB7D.2	STIFFENER BEAM SECTIONS
SB7D.3	STIFFENER BEAM DETAIL
SB8.1	ABUTMENT 1 PLAN AND SECTIONS
SB8.2	ABUTMENT 1 ELEVATION AND CREEP BLOCK PLAN AND SECTION
SB8.3	ABUTMENT 1 FOOTING REINFORCING PLAN AND DETAIL
SB8.4	ABUTMENT 1 ELEVATION
SB8.5	ABUTMENT 1 SECTION
SB8.6	TYPICAL FABRIC REINFORCED RETAINING WALL SECTIONS
SB9.1	ABUTMENT 2 PLAN
SB9.2	ABUTMENT 2 ELEVATION
SB9.3	ABUTMENT 2 FOOTING REINFORCING PLAN

SHEET NO.	DESCRIPTION
SB9.4	ABUTMENT 2 ELEVATION
SB9.5	ABUTMENT 2 SECTION
SB10.1	END BLOCK AT ABUTMENT 1 PLAN
SB10.2	END BLOCK AT ABUTMENT 1 PLAN - REINFORCING LAYOUT
SB10.3	END BLOCK AT ABUTMENT 1 FRONT ELEVATION
SB10.4	END BLOCK AT ABUTMENT 1 BACK ELEVATION
SB10.5	END BLOCK AT ABUTMENT 1 MAKAI SECTION
SB10.6	END BLOCK AT ABUTMENT 1 MAUKA SECTION
SB10.7	END BLOCK AT ABUTMENT 1 SECTION AT DROP PANEL
SB10.8	END BLOCK DETAIL
SB10.9	END BLOCK DETAIL
SB10.10	END BLOCK DETAIL
SB11.1	END BLOCK AT ABUTMENT 2 PLAN
SB11.2	END BLOCK AT ABUTMENT 2 PLAN - REINFORCING LAYOUT
SB11.3	END BLOCK AT ABUTMENT 2 FRONT ELEVATION
SB11.4	END BLOCK AT ABUTMENT 2 BACK ELEVATION
SB11.5	END BLOCK AT ABUTMENT 2 DETAIL
SB11.6	SECTION AT 12x0.6 PT ANCHORS
SB11.7	END BLOCK AT ABUTMENT 2 MAKAI SECTION
SB11.8	END BLOCK AT ABUTMENT 2 MAUKA SECTION
SB11.9	END BLOCK AT ABUTMENT 2 SECTION AT DROP PANEL
SB11.10	END BLOCK AT ABUTMENT 2 SECTIONS
SB11.11	END BLOCK AT ABUTMENT 2 SECTION



THIS WORK WAS PREPARED BY ME
OR UNDER MY SUPERVISION.
David K. Fujiwara APRIL 30, 2012
KSF, INC. LIC. EXP. DATE

STATE OF HAWAII DEPARTMENT OF TRANSPORTATION HIGHWAYS DIVISION	
INDEX TO BRIDGE DRAWINGS	
HONOAPIILANI HIGHWAY REALIGNMENT, PHASE 1A Future Keawe St Extension to Lahainaluna Rd, Part B Fed. Aid Proj. No. NH-030-1(35)R	
Scale: None	Date: June, 2010
SHEET No. SB0.1 OF 3 SHEETS	

ORIGINAL PLAN	SURVEY PLOTTED BY	DATE
NOTE BOOK	DRAWN BY	
No.	DESIGNED BY	
	QUANTITIES BY	
	CHECKED BY	

DRAWING NAME: Z:\00 ONGOING\40019.0-HONOAPIILANI LAHANA BYPASS-KAHOMA WO\06-15-10 COMBINE LAHANA FINAL DESIGN\HH-SB001.DWG PLOT TIME: 06-14-10, 2:40 PM)

SHEET NO.	DESCRIPTION
SB12.1	CONCRETE RAILING SECTIONS AND DETAIL
SB12.2	THICKENED PARAPET AT LIGHT STANDARD SECTIONS
SB12.3	GUARDRAIL AND END POST – PLAN, ELEVATION, SECTIONS AND DETAILS
SB12.4	END POST SECTIONS
SB13.1	APPROACH SLAB
SB14.1	FRICTION PENDULUM BEARING DETAILS
SB15.1	PRECAST ARCH TIE PLANK POST-TENSIONING
SB16.1	CONSTRUCTION SEQUENCE

FED. ROAD DIST. NO.	STATE	FED. AID PROJ. NO.	FISCAL YEAR	SHEET NO.	TOTAL SHEETS
HAWAII	HAW.	NH-030-1(35)R	2009	272	383



THIS WORK WAS PREPARED BY ME
OR UNDER MY SUPERVISION.
David K. Fujimura
KSF, INC. APRIL 30, 2012
LIC. EXP. DATE

STATE OF HAWAII
DEPARTMENT OF TRANSPORTATION
HIGHWAYS DIVISION

INDEX TO BRIDGE DRAWINGS

HONOAPIILANI HIGHWAY REALIGNMENT, PHASE 1A
Future Keawe St Extension to Lahainaluna Rd, Part B
Fed. Aid Proj. No. NH-030-1(35)R

Scale: None Date: June, 2010

SHEET No. SB0.2 OF 3 SHEETS

BRIDGE GENERAL NOTES

FED. ROAD DIST. NO.	STATE	FED. AID PROJ. NO.	FISCAL YEAR	SHEET NO.	TOTAL SHEETS
HAWAII	HAW.	NH-030-1(35)R	2009	273	383

1. General Specifications: Hawaii Department of Transportation, Standard Specifications for Road and Bridge Construction, 1994, together with Special Provisions prepared for this Contract.

2. Design Specifications:

- (A) AASHTO 2004 LRFD Bridge Design Specifications (Third Edition) and its subsequent interim specifications with interim supplements and modifications by the Highways Division, Department of Transportation, State of Hawaii.
- (B) HDOT "Design Criteria for Bridges and Structures" Dated Feb. 14, 2005.
- (C) AASHTO "Standard Specifications for Structural Supports for Highway Signs, Luminaires, and Traffic Signals", 4th edition (2001) including all subsequent interim revisions.

3. Loads:

- (A) Dead Load: An allowance of 25 PSF for future wearing surface of asphalt concrete has been provided for in the design.
- (B) Live Load: AASHTO HL-93 Truck Loading
- (C) Seismic Loads: Acceleration coefficient..... 0.24
Seismic Performance Zone..... 3
Importance Category..... Critical
Soil Profile..... Type 1
- (D) Utility Load: An allowance of 150 PLF on each side of the Bridge for Utility Loads has been provided for in the design.

4. Materials:

- (A) All concrete strengths for Kahoma Stream Bridge shall be as noted below:

Item No.	Structural Parts	Classes of Concrete	Specified Compressive Strength, f'c (28 Days)	Maximum w/c Ratio
(1)	Deck Topping over Precast Deck Planks, Bent Caps, and End Blocks (See Note 4.(M))	—	8,000 psi	0.35
(2)	Precast Deck Planks & Topping above bottom slab of Precast Girder (See Note 4.(C))	—	8,000 psi	0.4
(3)	Precast Girders (See Note 4.(K))	—	8,000 psi	0.4
(4)	CIP Beam above Bent Cap & Topping above bottom slab of Precast Girder (See Note 4.(C))	—	8,000 psi	0.4
(5)	CIP Bent (Cap and Column) (See Note 4.(C) & (K))	—	8,000 psi	0.4
(6)	CIP Stiffener Beam (See Note 4.(C) & (K))	—	8,000 psi	0.4
(7)	Precast Arch Tie Plank (See Note 4.(C))	—	8,000 psi	0.4
(8)	End Block (See Note 4.(C))	—	8,000 psi	0.4
(9)	Tendon Anchorage Blockouts (See Notes 4.(C) and 4.(K))	—	8,000 psi	0.4
(10)	Abutment Walls & Footing (See Note 4.(C))	—	4,000 psi	0.45

4. Materials: (Cont.)

Item No.	Structural Parts	Classes of Concrete	Specified Compressive Strength, f'c (28 Days)	Maximum w/c Ratio
(11)	Makai Railing (See Notes 4.(C), 4.(K) and 4.(O))	—	4,000 psi	0.45
(12)	Mauka Railing (See Notes 4.(K), 4.(O), and 4.(P))	—	3,000 psi	0.38
(13)	End Post (See Note 4.(K))	—	4,000 psi	0.45
(14)	Approach Slabs (See Notes 4.(C), 4.(K), 4.(O),	—	5,000 psi	0.45
(15)	Except as noted otherwise, all others	A	3,000 psi	0.55
(C)	For Kahoma Stream Bridge 1 Gal. Shrinkage Reducing Admixture (SRA) per CY concrete shall be included in the concrete mix for the Bridge Deck Topping, Precast Deck Planks, End Blocks, CIP Stiffener Beam, and Topping above bottom slab of Precast Girder, Precast Arch Tie Plank, and Approach Slabs. 96 oz SRA per CY concrete shall be included in railing.			
(E)	All reinforcing steel shall be ASTM A615 Grade 60 unless otherwise noted.			
(F)	All structural steel shall be ASTM A36 hot-dip galvanized after fabrication, unless otherwise noted.			
(G)	All anchor bolts, washers and nuts shall be ASTM A325 hot-dip galvanized after fabrication, unless otherwise specified.			
(H)	For materials of post-tensioned concrete see applicable post-tensioned concrete notes.			
(I)	Steel tubes shall conform to ASTM A500, Grade B.			
(J)	Elastomeric polyurethane sealant shall be Sonneborn Sonolastic SL 2 or equal.			
(K)	For Kahoma Stream Bridge, 1.5 pints per CY concrete of CORTEC MCI-2005 NS corrosion inhibitor shall be added to Bridge Deck Topping over Precast Deck Planks, Bent Caps, Approach Slabs and End Blocks, Post-Tensioning Blockouts, Precast Girders and to non-shrink grout for the Friction Pendulum Seismic Isolation Bearings.			
(L)	For materials of post-tensioned concrete see applicable post-tensioned concrete notes.			
(M)	The concrete mix for Item No. (1) shall have a maximum shrinkage strain of .00006 at 28 days and .000145 at 56 days according to ASTM C512.			
(N)	The Contractor shall use curing compound SINAK LITHIUM for Bridge structures and Approach Slabs. Six copies of the Manufacturer's brochure and certificates of test result shall be submitted. All work shall conform with the Manufacturer's recommendations. Coverage rate shall be 500 square feet per gallon. After the curing compound is applied the deck surface shall be covered by burlene for seven days.			
(O)	13 lbs./c.y. of HP 67/36 fiber shall be included in the railing and Approach Slab concrete.			
(P)	Light Weight Concrete for mauka railing shall have an air dry density of less than 125 lb./ft ³ .			

5. Reinforcement:

- (A) The minimum covering measured from the surface of the concrete to the face of any reinforcing bars shall be as follows, except as otherwise shown:
- (1) Deck topping
- A. Top bars = 2 1/2"
- B. Bottom bars = 1 1/2" except as otherwise noted
- (2) Abutment Walls = 2" to outermost reinforcing except as otherwise noted
- (3) Approach Slab top bars = 2 1/2"
Approach Slab bottom bars = 3"
- (4) Concrete cast against and permanently exposed to earth = 3"
- (5) All others unless otherwise noted = 2"
- (B) Reinforcing bars shall be detailed in accordance with the latest edition of the design specification in Note 2 unless otherwise noted.
- (C) Minimum clear spacing between parallel bars shall be 1 1/2 times the diameter of bars (for non bundled bars). In no case shall the clear distance between the bars be less than 1 1/2 times the maximum size of the coarse aggregate or 1 1/2" (except at approach slab dowel).
- (D) All dimensions relating to reinforcing bars are to centers of bars unless otherwise noted.
- (E) Reinforcing bars shall be securely tied at all intersections and lap splices except where the spacing of intersections is less than one foot in each direction, in which case alternate intersections shall be tied.
- (F) Supports for reinforcing steel bars shall be precast concrete having 8,000 psi compressive strength. Wire bar supports and all plastic support shall not be allowed in precast concrete beams.

6. Foundation:

- (A) Kahoma Stream Bridge
- (1) For geotechnical design parameters, refer to Geotechnical Sheets.
- (2) For additional geotechnical information, see Soils Report by Geolabs, Inc.

7. Other Notes:

- (A) Reference Drawings:
- (1) For Construction Sequence of Kahoma Stream Bridge, See sheet SB16.1.
- (B) For Kahoma Stream Bridge unfactored loading at each shaded area (shown on SB8.1 and SB9.1) area as noted below:
- (1) DC = 3,000 kips
- (2) DW = 500 kips
- (3) LL+I = 1,500 kips



THIS WORK WAS PREPARED BY ME OR UNDER MY SUPERVISION.

KSF, INC. APRIL 30, 2012 LIC. EXP. DATE

01-28-13	4	Revision
01-17-13	3	Revision
08-18-10	1	Revision

DATE REVISION

STATE OF HAWAII DEPARTMENT OF TRANSPORTATION HIGHWAYS DIVISION
BRIDGE GENERAL NOTES
HONOAPIILANI HIGHWAY REALIGNMENT, PHASE 1A
Future Keawe St Extension to Lahainaluna Rd, Part B
Fed. Aid Proj. No. NH-030-1(35)R
Scale: None Date: August, 2010
SHEET No. SB0.3 OF 3 SHEETS

ORIGINAL PLAN	DATE
DRAWN BY	
REVISION	
NOTED BY	
QUANTITIES BY	
CHECKED BY	

DRAWING NAME: Z:\00 ONGOING\40019.0-HONOAPIILANI LAHAINA BYPASS-KAHOMA - HDCC\01-28-13 DEL\3 GENNOTES\NH-SP003 REV1 DEL\3.DWG PLOT TIME: 01-28-13, 2:51 PM

BRIDGE GENERAL NOTES

FED. ROAD DIST. NO.	STATE	FED. AID PROJ. NO.	FISCAL YEAR	SHEET NO.	TOTAL SHEETS
HAWAII	HAW.	NH-030-1(35)R	2009	273	383

- General Specifications:** Hawaii Department of Transportation, Standard Specifications for Road and Bridge Construction, 1994, together with Special Provisions prepared for this Contract.
- Design Specifications:**
 - AASHTO 2004 LRFD Bridge Design Specifications (Third Edition) and its subsequent interim specifications with interim supplements and modifications by the Highways Division, Department of Transportation, State of Hawaii.
 - HDOT "Design Criteria for Bridges and Structures" Dated Feb. 14, 2005.
 - AASHTO "Standard Specifications for Structural Supports for Highway Signs, Luminaires, and Traffic Signals", 4th edition (2001) including all subsequent interim revisions.
- Loads:**
 - Dead Load: An allowance of 25 PSF for future wearing surface of asphalt concrete has been provided for in the design.
 - Live Load: AASHTO HL-93 Truck Loading
 - Seismic Loads: Acceleration coefficient.....0.24
Seismic Performance Zone.....3
Importance Category.....Critical
Soil Profile.....Type 1
 - Utility Load: An allowance of 150 PLF on each side of the Bridge for Utility Loads has been provided for in the design.

4. Materials:

- All concrete strengths for Kahoma Stream Bridge shall be as noted below:

Item No.	Structural Parts	Classes of Concrete	Specified Compressive Strength, f'c (28 Days)	Maximum w/c Ratio
(1)	Deck Topping over Precast Deck Planks, Bent Caps, and End Blocks (See Note 4.(M))	—	8,000 psi	0.35
(2)	Precast Deck Planks & Topping above bottom slab of Precast Girder (See Note 4.(C))	—	8,000 psi	0.4
(3)	Precast Girders (See Note 4.(K))	—	8,000 psi	0.4
(4)	CIP Beam above Bent Cap & Topping above bottom slab of Precast Girder (See Note 4.(C))	—	8,000 psi	0.4
(5)	CIP Bent (Cap and Column) (See Note 4.(C) & (K))	—	8,000 psi	0.4
(6)	CIP Stiffener Beam (See Note 4.(C) & (K))	—	8,000 psi	0.4
(7)	Precast Arch Tie Plank (See Note 4.(C))	—	8,000 psi	0.4
(8)	End Block (See Note 4.(C))	—	8,000 psi	0.4
(9)	Tendon Anchorage Blockouts (See Notes 4.(C) and 4.(K))	—	8,000 psi	0.4
(10)	Abutment Walls & Footing (See Note 4.(C))	—	4,000 psi	0.45

4. Materials: (Cont.)

Item No.	Structural Parts	Classes of Concrete	Specified Compressive Strength, f'c (28 Days)	Maximum w/c Ratio
(11)	Makai Railing (See Notes 4.(C), 4.(K) and 4.(O))	—	4,000 psi	0.45
(12)	Mauka Railing (See Notes 4.(C), 4.(K), 4.(O), and 4.(P))	—	3,000 psi	0.38
(13)	End Post (See Note 4.(K))	—	4,000 psi	0.45
(14)	Approach Slabs (See Notes 4.(C), 4.(K), 4.(O), and 4.(P))	—	5,000 psi	0.45
(15)	Except as noted otherwise, all others	A	3,000 psi	0.55
(C)	For Kahoma Stream Bridge 1 Gal. Shrinkage Reducing Admixture (SRA) per CY concrete shall be included in the concrete mix for the Bridge Deck Topping, Precast Deck Planks, End Blocks, CIP Stiffener Beam, and Topping above bottom slab of Precast Girder, Precast Arch Tie Plank, and Approach Slabs. 96 oz SRA per CY concrete shall be included in railing.			
(E)	All reinforcing steel shall be ASTM A615 Grade 60 unless otherwise noted.			
(F)	All structural steel shall be ASTM A36 hot-dip galvanized after fabrication, unless otherwise noted.			
(G)	All anchor bolts, washers and nuts shall be ASTM A325 hot-dip galvanized after fabrication, unless otherwise specified.			
(H)	For materials of post-tensioned concrete see applicable post-tensioned concrete notes.			
(I)	Steel tubes shall conform to ASTM A500, Grade B.			
(J)	Elastomeric polyurethane sealant shall be Sonneborn Sonolastic SL 2 or equal.			
(K)	For Kahoma Stream Bridge, 1.5 pints per CY concrete of CORTEC MCI-2005 NS corrosion inhibitor shall be added to Bridge Deck Topping over Precast Deck Planks, Bent Caps, Approach Slabs and End Blocks, Post-Tensioning Blockouts, Precast Girders and to non-shrink grout for the Friction Pendulum Seismic Isolation Bearings.			
(L)	For materials of post-tensioned concrete see applicable post-tensioned concrete notes.			
(M)	The concrete mix for Item No. (1) shall have a maximum shrinkage strain of .00006 at 28 days and .000145 at 56 days according to ASTM C512.			
(N)	The Contractor shall use curing compound SINAK LITHIUM for Bridge structures and Approach Slabs. Six copies of the Manufacturer's brochure and certificates of test result shall be submitted. All work shall conform with the Manufacturer's recommendations. Coverage rate shall be 500 square feet per gallon. After the curing compound is applied the deck surface shall be covered by burlene for seven days.			
(O)	13 lbs./c.y. of HP 67/36 fiber shall be included in the railing and Approach Slab concrete.			
(P)	Light Weight Concrete for mauka railing shall have an air dry density of less than 125 lb./ft ³ .			

5. Reinforcement:

- The minimum covering measured from the surface of the concrete to the face of any reinforcing bars shall be as follows, except as otherwise shown:
 - Deck topping
 - Top bars = 2 1/2"
 - Bottom bars = 1 1/2" except as otherwise noted
 - Abutment Walls = 2" to outermost reinforcing except as otherwise noted
 - Approach Slab top bars = 2 1/2"
Approach Slab bottom bars = 3"
 - Concrete cast against and permanently exposed to earth = 3"
 - All others unless otherwise noted = 2"
- Reinforcing bars shall be detailed in accordance with the latest edition of the design specification in Note 2 unless otherwise noted.
- Minimum clear spacing between parallel bars shall be 1 1/2 times the diameter of bars (for non bundled bars). In no case shall the clear distance between the bars be less than 1 1/2 times the maximum size of the coarse aggregate or 1 1/2" (except at approach slab dowel).
- All dimensions relating to reinforcing bars are to centers of bars unless otherwise noted.
- Reinforcing bars shall be securely tied at all intersections and lap splices except where the spacing of intersections is less than one foot in each direction, in which case alternate intersections shall be tied.
- Supports for reinforcing steel bars shall be precast concrete having 8,000 psi compressive strength. Wire bar supports and all plastic support shall not be allowed in precast concrete beams.

6. Foundation:

- Kahoma Stream Bridge
 - For geotechnical design parameters, refer to Geotechnical Sheets.
 - For additional geotechnical information, see Soils Report by Geolabs, Inc.

7. Other Notes:

- Reference Drawings:
 - For Construction Sequence of Kahoma Stream Bridge, See sheet SB16.1.
- For Kahoma Stream Bridge unfactored loading at each shaded area (shown on SB8.1 and SB9.1) area as noted below:
 - DC = 3,000 kips
 - DW = 500 kips
 - LL+I = 1,500 kips



THIS WORK WAS PREPARED BY ME OR UNDER MY SUPERVISION.

KSF, INC. APRIL 30, 2012 LIC. EXP. DATE

STATE OF HAWAII DEPARTMENT OF TRANSPORTATION HIGHWAYS DIVISION	
BRIDGE GENERAL NOTES	
HONOAIPILANI HIGHWAY REALIGNMENT, PHASE 1A Future Keawe St Extension to Lahainaluna Rd, Part B Fed. Aid Proj. No. NH-030-1(35)R	
Scale: None	Date: August, 2010
SHEET No. SB0.3 OF 3 SHEETS	

01-17-13	3	Revision
08-18-10	1	Revision
DATE	REVISION	

FINAL DESIGN 273 Rev

DRAWING NAME: Z:\00 ONGOING\40019.0-HONOAIPILANI LAHANA BYPASS-KAHOMA - HDOT\01-18-13 DELTA GENNOTES\NH-SB003 REV1 DELTA.DWG PLOT TIME: 01-17-13, 10:11 AM

DESIGNED BY	DATE
CHECKED BY	
QUANTITIES BY	
NOTES BY	
ORIGINAL PLAN	

BRIDGE GENERAL NOTES

FED. ROAD DIST. NO.	STATE	FED. AID PROJ. NO.	FISCAL YEAR	SHEET NO.	TOTAL SHEETS
HAWAII	HAW.	NH-030-1(35)R	2009	273	383

- General Specifications:** Hawaii Department of Transportation, Standard Specifications for Road and Bridge Construction, 1994, together with Special Provisions prepared for this Contract.
- Design Specifications:**
 - AASHTO 2004 LRFD Bridge Design Specifications** (Third Edition) and its subsequent interim specifications with interim supplements and modifications by the Highways Division, Department of Transportation, State of Hawaii.
 - HDOT "Design Criteria for Bridges and Structures" Dated Feb. 14, 2005.
 - AASHTO "Standard Specifications for Structural Supports for Highway Signs, Luminaires, and Traffic Signals", 4th edition (2001) including all subsequent interim revisions.
- Loads:**
 - Dead Load: An allowance of 25 PSF for future wearing surface of asphalt concrete has been provided for in the design.
 - Live Load: AASHTO HL-93 Truck Loading
 - Seismic Loads: Acceleration coefficient..... 0.24
Seismic Performance Zone..... 3
Importance Category..... Critical
Soil Profile..... Type 1
 - Utility Load: An allowance of 150 PLF on each side of the Bridge for Utility Loads has been provided for in the design.

4. Materials:

- All concrete strengths for Kahoma Stream Bridge shall be as noted below:

Item No.	Structural Parts	Classes of Concrete	Specified Compressive Strength, f'c (28 Days)	Maximum w/c Ratio
(1)	Deck Topping over Precast Deck Planks, Bent Caps, End Blocks and Approach Slabs (See Note 4.(M))	-	8,000 psi	0.35
(2)	Precast Deck Planks & Topping above bottom slab of Precast Girder (See Note 4.(C))	-	8,000 psi	0.4
(3)	Precast Girders (See Note 4.(K))	-	8,000 psi	0.4
(4)	CIP Beam above Bent Cap & Topping above bottom slab of Precast Girder (See Note 4.(C))	-	8,000 psi	0.4
(5)	CIP Bent (Cap and Column) (See Note 4.(C) & (K))	-	8,000 psi	0.4
(6)	CIP Stiffener Beam (See Note 4.(C) & (K))	-	8,000 psi	0.4
(7)	Precast Arch Tie Plank (See Note 4.(C))	-	8,000 psi	0.4
(8)	End Block (See Note 4.(C))	-	8,000 psi	0.4
(9)	Tendon Anchorage Blockouts (See Notes 4.(C) and 4.(K))	-	8,000 psi	0.4

4. Materials: (Cont.)

Item No.	Structural Parts	Classes of Concrete	Specified Compressive Strength, f'c (28 Days)	Maximum w/c Ratio
(10)	Abutment Walls & Footing (See Note 4.(C))	-	4,000 psi	0.45 Δ
(11)	Railing (See Notes 4.(C) and 4.(K))	-	4,000 psi	0.45
(12)	End Post (See Note 4.(K))	-	4,000 psi	0.45
(13)	Except as noted otherwise, all others	A	3,000 psi	0.55
(C) For Kahoma Stream Bridge 1 Gal. Shrinkage Reducing Admixture (SRA) per CY concrete shall be included in the concrete mix for the Bridge Deck Topping, Precast Deck Planks, End Blocks, CIP Stiffener Beam, and Topping above bottom slab of Precast Girder, Precast Arch Tie Plank. 96 oz SRA per CY concrete shall be included in railing.				
(E) All reinforcing steel shall be ASTM A615 Grade 60 unless otherwise noted.				
(F) All structural steel shall be ASTM A36 hot-dip galvanized after fabrication, unless otherwise noted.				
(G) All anchor bolts, washers and nuts shall be ASTM A325 hot-dip galvanized after fabrication, unless otherwise specified.				
(H) For materials of post-tensioned concrete see applicable post-tensioned concrete notes.				
(I) Steel tubes shall conform to ASTM A500, Grade B.				
(J) Elastomeric polyurethane sealant shall be Sonneborn Sonolastic SL 2 or equal.				
(K) For Kahoma Stream Bridge, 1.5 pints per CY concrete of CORTEC MCI-2005 NS corrosion inhibitor shall be added to Bridge Deck Topping over Precast Deck Planks, Bent Caps, Approach Slabs and End Blocks, Post-Tensioning Blockouts, Precast Girders and to non-shrink grout for the Friction Pendulum Seismic Isolation Bearings.				
(L) For materials of post-tensioned concrete see applicable post-tensioned concrete notes.				
(M) The concrete mix for Item No. (1) shall have a maximum shrinkage strain of .00006 at 28 days and .000145 at 56 days according to ASTM C512.				
(N) The Contractor shall use curing compound SINAK LITHIUM for Bridge structures and Approach Slabs. Six copies of the Manufacturer's brochure and certificates of test result shall be submitted. All work shall conform with the Manufacturer's recommendations. Coverage rate shall be 500 square feet per gallon. After the curing compound is applied the deck surface shall be covered by burlene for seven days.				

5. Reinforcement:

- The minimum covering measured from the surface of the concrete to the face of any reinforcing bars shall be as follows, except as otherwise shown:
 - Deck topping
 - Top bars = 2 1/2"
 - Bottom bars = 1 1/2" except as otherwise noted

5. Reinforcement: (Cont.)

- Abutment Walls = 2" to outermost reinforcing except as otherwise noted
- Approach Slab top bars = 2 1/2"
Approach Slab bottom bars = 3"
- Concrete cast against and permanently exposed to earth = 3"
- All others unless otherwise noted = 2"
- Reinforcing bars shall be detailed in accordance with the latest edition of the design specification in Note 2 unless otherwise noted.
- Minimum clear spacing between parallel bars shall be 1 1/2 times the diameter of bars (for non bundled bars). In no case shall the clear distance between the bars be less than 1 1/2 times the maximum size of the coarse aggregate or 1 1/2" (except at approach slab dowel).
- All dimensions relating to reinforcing bars are to centers of bars unless otherwise noted.
- Reinforcing bars shall be securely tied at all intersections and lap splices except where the spacing of intersections is less than one foot in each direction, in which case alternate intersections shall be tied.
- Supports for reinforcing steel bars shall be precast concrete having 8,000 psi compressive strength. Wire bar supports and all plastic support shall not be allowed in precast concrete beams.

6. Foundation:

- Kahoma Stream Bridge
 - For geotechnical design parameters, refer to Geotechnical Sheets.
 - For additional geotechnical information, see Soils Report by Geolabs, Inc.

7. Other Notes:

- Reference Drawings:
 - For Construction Sequence of Kahoma Stream Bridge, See sheet SB16.1.
- For Kahoma Stream Bridge unfactored loading at each shaded area (shown on SB8.1 and SB9.1) area as noted below:
 - DC = 3,000 kips
 - DW = 500 kips
 - LL+I = 1,500 kips



THIS WORK WAS PREPARED BY ME OR UNDER MY SUPERVISION.

KSF, INC. APRIL 30, 2012 LIC. EXP. DATE

STATE OF HAWAII DEPARTMENT OF TRANSPORTATION HIGHWAYS DIVISION	
BRIDGE GENERAL NOTES	
HONOAPIILANI HIGHWAY REALIGNMENT, PHASE 1A Future Keawe St Extension to Lahainaluna Rd, Part B	
Fed. Aid Proj. No. NH-030-1(35)R	
Scale: None	Date: June, 2010
SHEET No. SB0.3 OF 3 SHEETS	

08-18-10 Δ Revision

DATE REVISION

FINAL DESIGN 273 *rev.*

DRAWING NAME: Z:\00 ONGOING\4019.0-HONOAPIILANI LAHAINA BYPASS-KAHOMA\08-18-10 COMBINE LAHAINA FINAL DESIGN\HH-SB003.DWG PLOT TIME: 08-18-10 1:33 PM

DESIGNED BY	DATE
DRAWN BY	
CHECKED BY	
IN CHARGE	
NOTED BY	
QUANTITIES BY	
CHECKED BY	
ORIGINAL PLAN	
NOTE BOOK	
No.	

BRIDGE GENERAL NOTES

FED. ROAD DIST. NO.	STATE	FED. AID PROJ. NO.	FISCAL YEAR	SHEET NO.	TOTAL SHEETS
HAWAII	HAW.	NH-030-1(35)R	2009	273	383

1. General Specifications: Hawaii Department of Transportation, Standard Specifications for Road and Bridge Construction, 1994, together with Special Provisions prepared for this Contract.

2. Design Specifications:

- (A) AASHTO 2004 LRFD Bridge Design Specifications (Third Edition) and its subsequent interim specifications with interim supplements and modifications by the Highways Division, Department of Transportation, State of Hawaii.
- (B) HDOT "Design Criteria for Bridges and Structures" Dated Feb. 14, 2005.
- (C) AASHTO "Standard Specifications for Structural Supports for Highway Signs, Luminaires, and Traffic Signals", 4th edition (2001) including all subsequent interim revisions.

3. Loads:

- (A) Dead Load: An allowance of 25 PSF for future wearing surface of asphalt concrete has been provided for in the design.
- (B) Live Load: AASHTO HL-93 Truck Loading
- (C) Seismic Loads: Acceleration coefficient..... 0.24
Seismic Performance Zone..... 3
Importance Category..... Critical
Soil Profile..... Type 1
- (D) Utility Load: An allowance of 150 PLF on each side of the Bridge for Utility Loads has been provided for in the design.

4. Materials:

- (A) All concrete strengths for Kahoma Stream Bridge shall be as noted below:

Item No.	Structural Parts	Classes of Concrete	Specified Compressive Strength, f'c (28 Days)	Maximum w/c Ratio
(1)	Deck Topping over Precast Deck Planks, Bent Caps, End Blocks and Approach Slabs (See Note 4.(M))	-	8,000 psi	0.35
(2)	Precast Deck Planks & Topping above bottom slab of Precast Girder (See Note 4.(C))	-	8,000 psi	0.4
(3)	Precast Girders (See Note 4.(K))	-	8,000 psi	0.4
(4)	CIP Beam above Bent Cap & Topping above bottom slab of Precast Girder (See Note 4.(C))	-	8,000 psi	0.4
(5)	CIP Bent (Cap and Column) (See Note 4.(C) & (K))	-	8,000 psi	0.4
(6)	CIP Stiffener Beam (See Note 4.(C) & (K))	-	8,000 psi	0.4
(7)	Precast Arch Tie Plank (See Note 4.(C))	-	8,000 psi	0.4
(8)	End Block (See Note 4.(C))	-	8,000 psi	0.4
(9)	Tendon Anchorage Blockouts (See Notes 4.(C) and 4.(K))	-	8,000 psi	0.4

4. Materials: (Cont.)

Item No.	Structural Parts	Classes of Concrete	Specified Compressive Strength, f'c (28 Days)	Maximum w/c Ratio
(10)	Abutment Walls & Footing (See Note 4.(C))	-	6,000 psi	0.4
(11)	Railing (See Notes 4.(C) and 4.(K))	-	4,000 psi	0.45
(12)	End Post (See Note 4.(K))	-	4,000 psi	0.45
(13)	Except as noted otherwise, all others	A	3,000 psi	0.55

(C) For Kahoma Stream Bridge 1 Gal. Shrinkage Reducing Admixture (SRA) per CY concrete shall be included in the concrete mix for the Bridge Deck Topping, Precast Deck Planks, End Blocks, CIP Stiffener Beam, and Topping above bottom slab of Precast Girder, Precast Arch Tie Plank. 96 oz SRA per CY concrete shall be included in railing.

(E) All reinforcing steel shall be ASTM A615 Grade 60 unless otherwise noted.

(F) All structural steel shall be ASTM A36 hot-dip galvanized after fabrication, unless otherwise noted.

(G) All anchor bolts, washers and nuts shall be ASTM A325 hot-dip galvanized after fabrication, unless otherwise specified.

(H) For materials of post-tensioned concrete see applicable post-tensioned concrete notes.

(I) Steel tubes shall conform to ASTM A500, Grade B.

(J) Elastomeric polyurethane sealant shall be Sonneborn Sonolastic SL 2 or equal.

(K) For Kahoma Stream Bridge, 1.5 pints per CY concrete of CORTEC MCI-2005 NS corrosion inhibitor shall be added to Bridge Deck Topping over Precast Deck Planks, Bent Caps, Approach Slabs and End Blocks, Post-Tensioning Blockouts, Precast Girders and to non-shrink grout for the Friction Pendulum Seismic Isolation Bearings.

(L) For materials of post-tensioned concrete see applicable post-tensioned concrete notes.

(M) The concrete mix for Item No. (1) shall have a maximum shrinkage strain of .00006 at 28 days and .000145 at 56 days according to ASTM C512.

(N) The Contractor shall use curing compound SINAK LITHIUM for Bridge structures and Approach Slabs. Six copies of the Manufacturer's brochure and certificates of test result shall be submitted. All work shall conform with the Manufacturer's recommendations. Coverage rate shall be 500 square feet per gallon. After the curing compound is applied the deck surface shall be covered by burlene for seven days.

5. Reinforcement:

- (A) The minimum covering measured from the surface of the concrete to the face of any reinforcing bars shall be as follows, except as otherwise shown:
- (1) Deck topping
A. Top bars = 2 1/2"
B. Bottom bars = 1 1/2" except as otherwise noted

5. Reinforcement: (Cont.)

- (2) Abutment Walls = 2" to outermost reinforcing except as otherwise noted
- (3) Approach Slab top bars = 2 1/2"
Approach Slab bottom bars = 3"
- (4) Concrete cast against and permanently exposed to earth = 3"
- (5) All others unless otherwise noted = 2"
- (B) Reinforcing bars shall be detailed in accordance with the latest edition of the design specification in Note 2 unless otherwise noted.
- (C) Minimum clear spacing between parallel bars shall be 1 1/2 times the diameter of bars (for non bundled bars). In no case shall the clear distance between the bars be less than 1 1/2 times the maximum size of the coarse aggregate or 1 1/2" (except at approach slab dowel).
- (D) All dimensions relating to reinforcing bars are to centers of bars unless otherwise noted.
- (E) Reinforcing bars shall be securely tied at all intersections and lap splices except where the spacing of intersections is less than one foot in each direction, in which case alternate intersections shall be tied.
- (F) Supports for reinforcing steel bars shall be precast concrete having 8,000 psi compressive strength. Wire bar supports and all plastic support shall not be allowed in precast concrete beams.

6. Foundation:

- (A) Kahoma Stream Bridge
- (1) For geotechnical design parameters, refer to Geotechnical Sheets.
- (2) For additional geotechnical information, see Soils Report by Geolabs, Inc.

7. Other Notes:

- (A) Reference Drawings:
- (1) For Construction Sequence of Kahoma Stream Bridge, See sheet SB16.1.
- (B) For Kahoma Stream Bridge unfactored loading at each shaded area (shown on SB8.1 and SB9.1) area as noted below:
- (1) DC = 3,000 kips
- (2) DW = 500 kips
- (3) LL+I = 1,500 kips



THIS WORK WAS PREPARED BY ME
OR UNDER MY SUPERVISION.
David K. Fujiwara
KSF, INC.
APRIL 30, 2012
LIC. EXP. DATE

STATE OF HAWAII
DEPARTMENT OF TRANSPORTATION
HIGHWAYS DIVISION

BRIDGE GENERAL NOTES

HONOAPIILANI HIGHWAY REALIGNMENT, PHASE 1A

Future Keawe St Extension to Lahainaluna Rd, Part B

Fed. Aid Proj. No. NH-030-1(35)R

Scale: None

Date: June, 2010

SHEET No. SB0.3 OF 3 SHEETS


FINAL DESIGN 273 new

PLOT TIME: 06-14-10, 2:43 PM

DRAWING NAME: Z:\00 ONGOING\40019.0-HONOAPIILANI LAHAINA BYPASS-KAHOMA.WC\06-15-10 COMBINE LAHAINA FINAL DESIGN\H-SB003.DWG

SURVEY PLOTTED BY	DATE
DRAWN BY	
TRACED BY	
DESIGNED BY	
CHECKED BY	
ORIGINAL PLAN	
NOTE BOOK	
No.	

FED. ROAD DIST. NO.	STATE	FED. AID PROJ. NO.	FISCAL YEAR	SHEET NO.	TOTAL SHEETS
HAWAII	HAW.	NH-030-1(35)R	2009	274	383

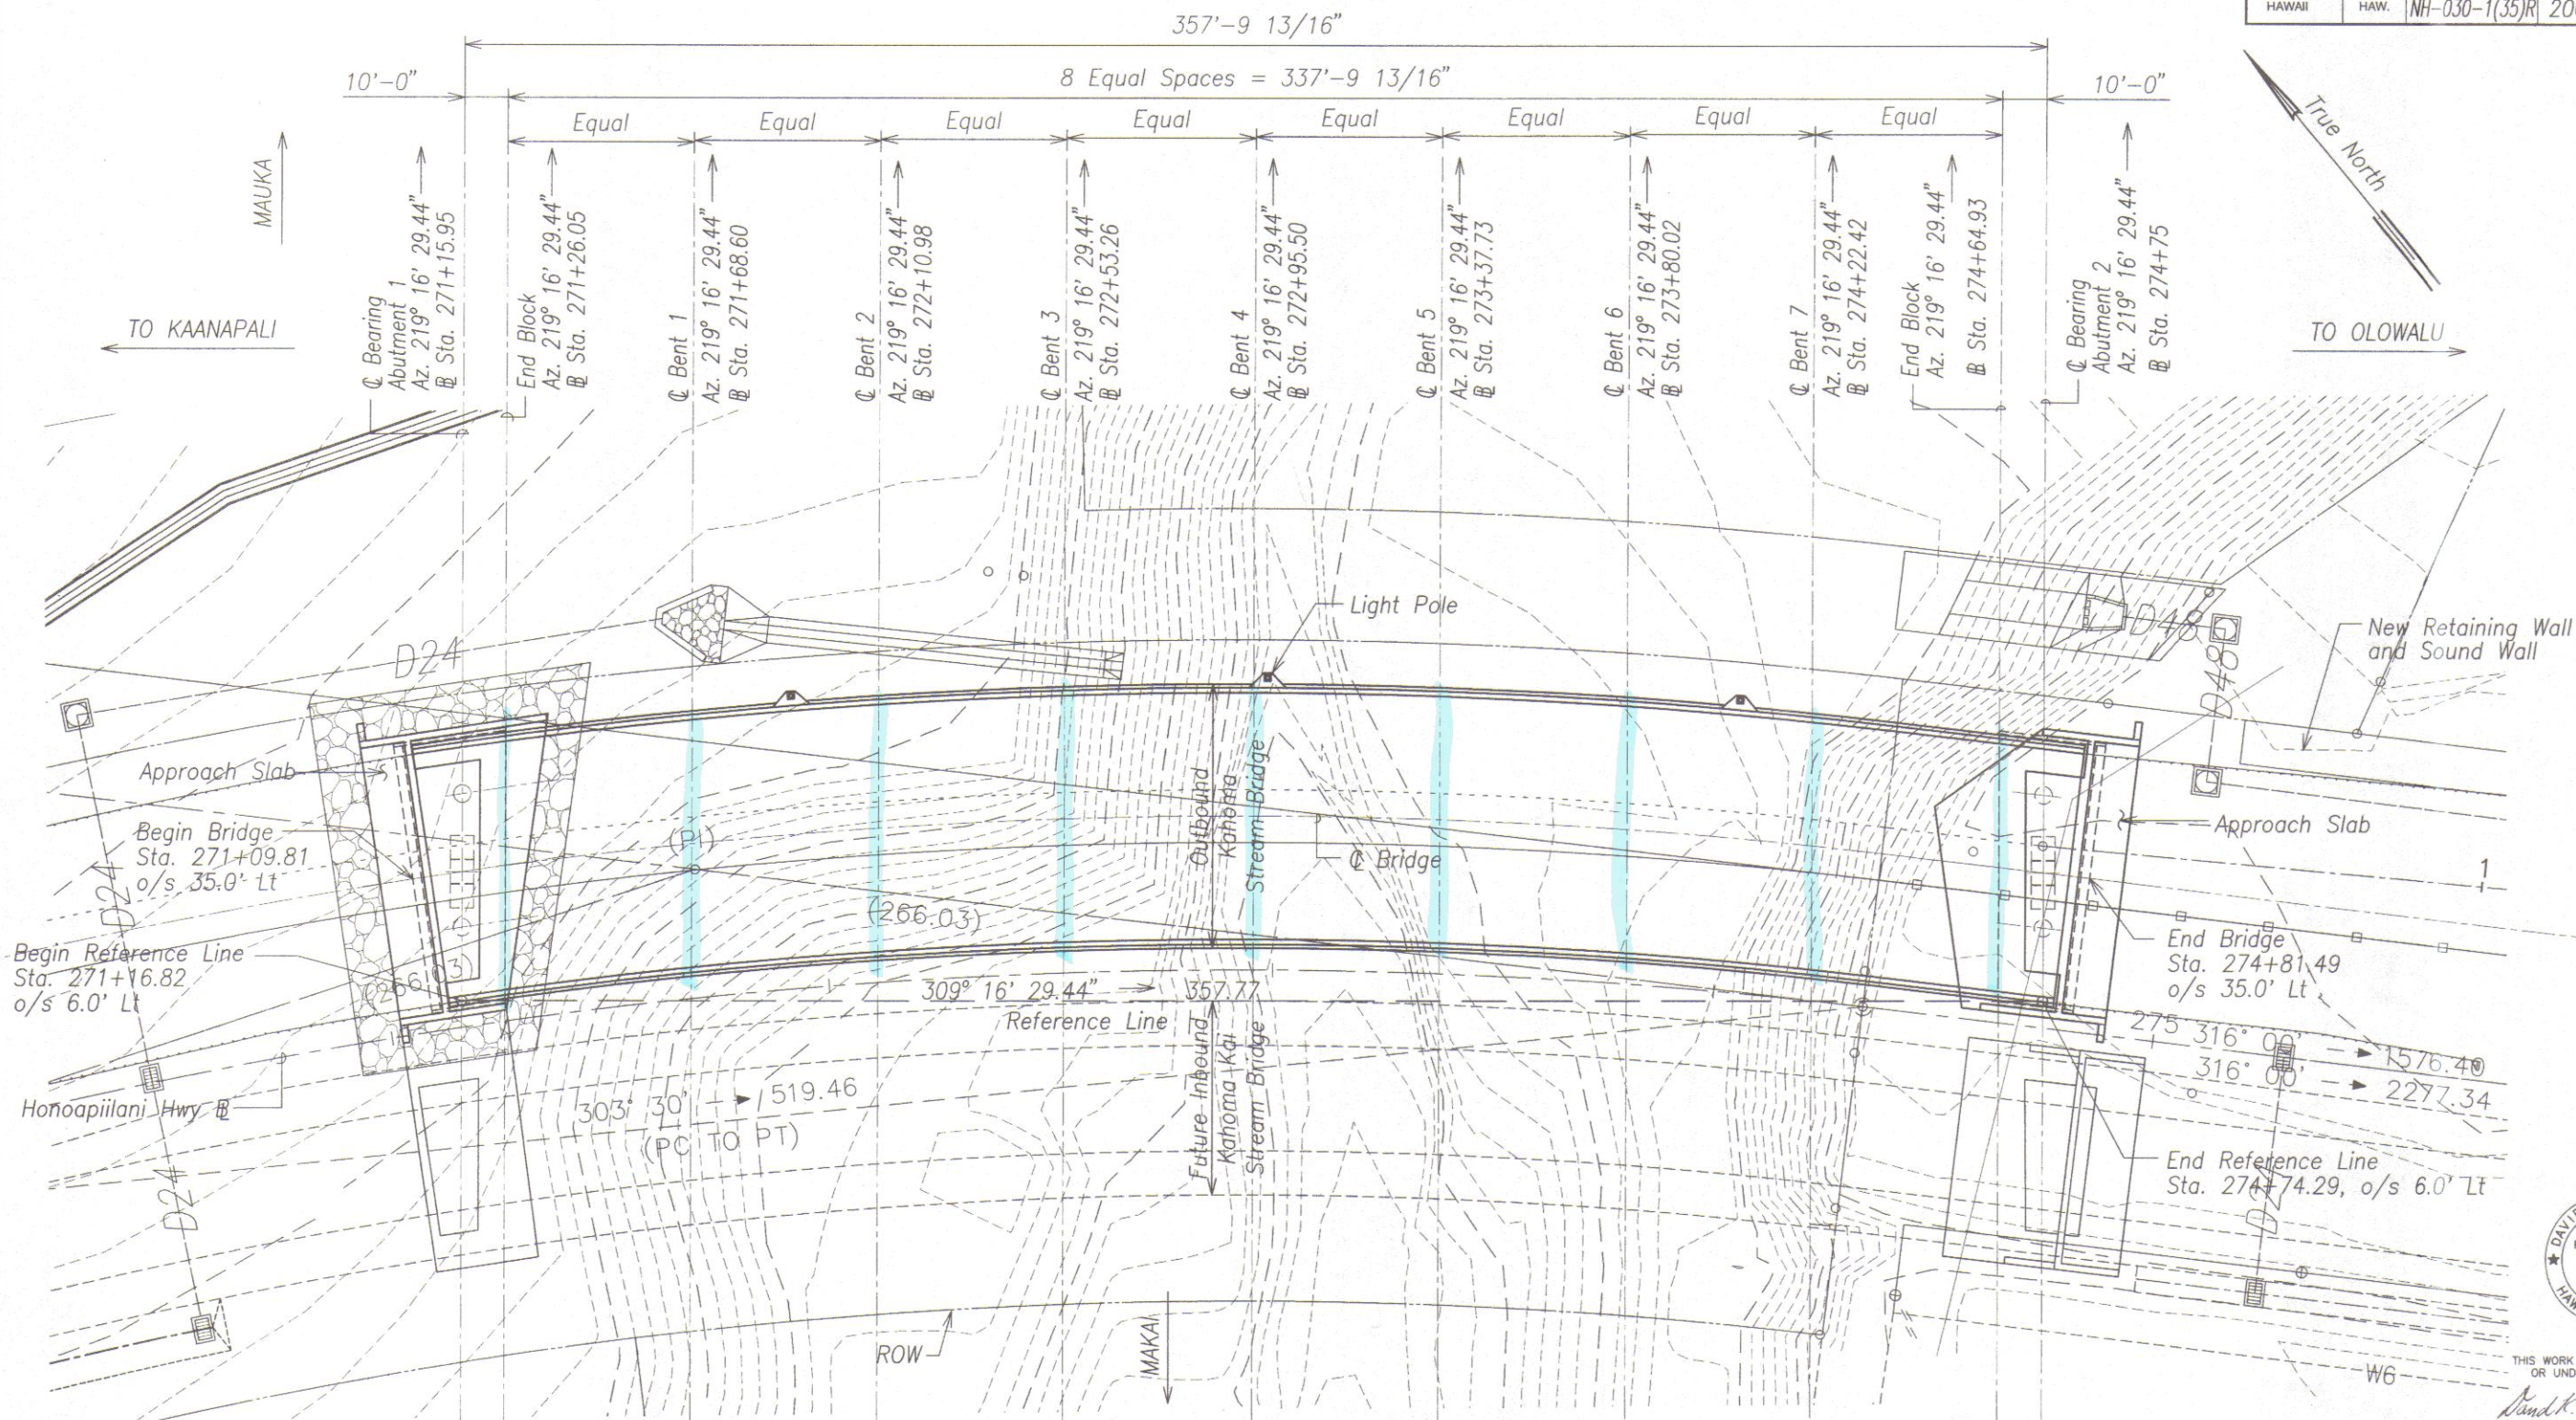

THIS WORK WAS PREPARED BY ME
OR UNDER MY SUPERVISION.
David K. Fujimura
KSF, INC. APRIL 30, 2012
LIC. EXP. DATE

NOTES:

Light Poles (3) are located on Mauka Rail at the following stations:

- Honoapiilani Hwy @ Sta. 271+96.38
- Honoapiilani Hwy @ Sta. 272+98.37
- Honoapiilani Hwy @ Sta. 274+00.00

See Sheet SB12.2 for Light Standard details.
See Civil Sheets for Curve Data.

KAHOMA STREAM BRIDGE LAYOUT PLAN


Scale: 1" = 20'-0"

A
SB1.1/SB1.1


STATE OF HAWAII DEPARTMENT OF TRANSPORTATION HIGHWAYS DIVISION	
KAHOMA STREAM BRIDGE LAYOUT PLAN	
HONOAPIILANI HIGHWAY REALIGNMENT, PHASE 1A Future Keawe St Extension to Lahainaluna Rd, Part B	
Fed. Aid Proj. No. NH-030-1(35)R	
Scale: As Noted	Date: June, 2010
SHEET No. SB1.1 OF 4 SHEETS	

FINAL DESIGN 274

FED. ROAD DIST. NO.	STATE	FED. AID PROJ. NO.	FISCAL YEAR	SHEET NO.	TOTAL SHEETS
HAWAII	HAW.	NH-030-1(35)R	2009	275	383

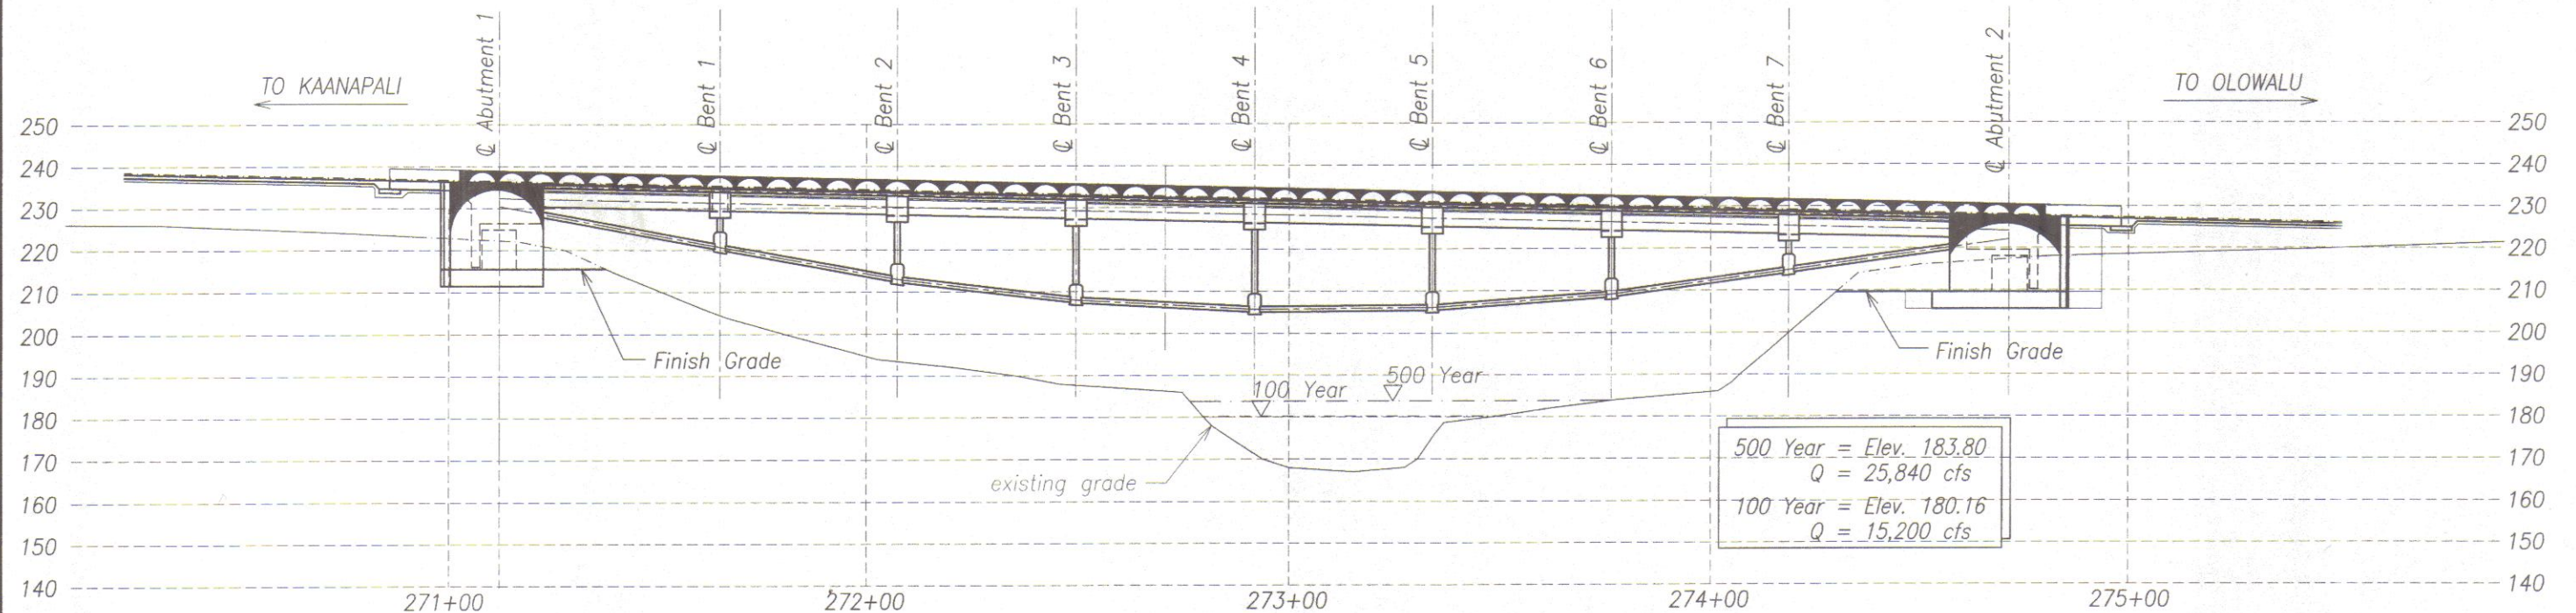

MAKAI ELEVATION - ALONG MAUKA BRIDGE
Scale: 1" = 20'-0"

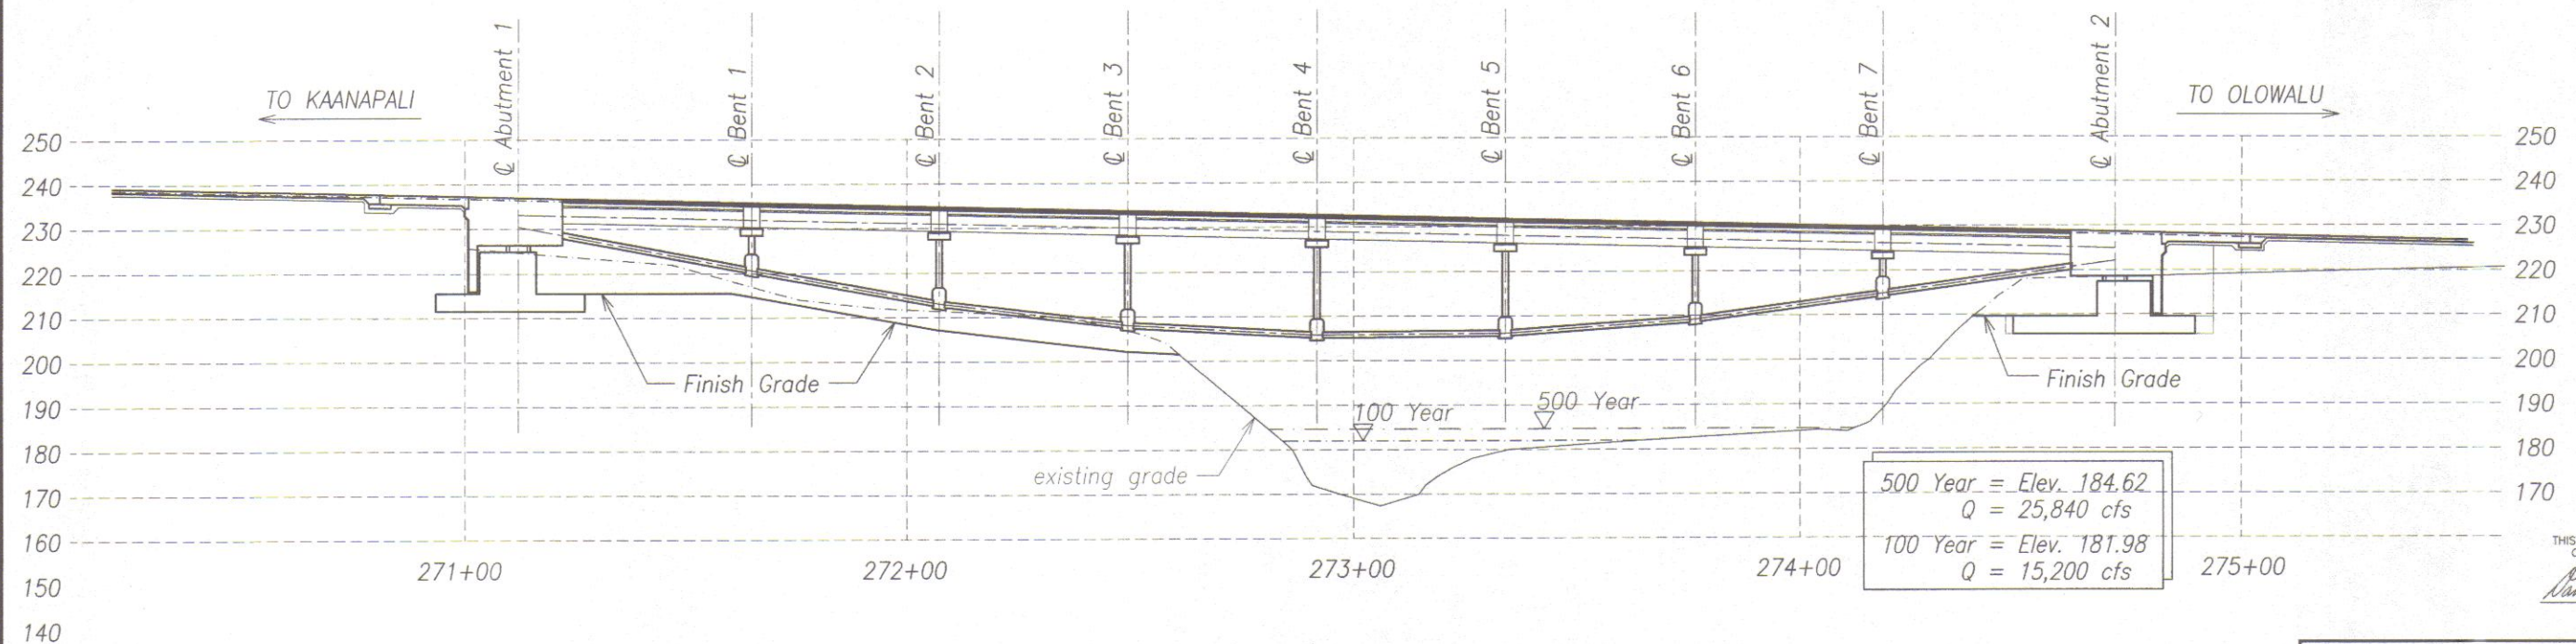

CENTERLINE SECTION - ALONG MAUKA BRIDGE
Scale: 1" = 20'-0"



THIS WORK WAS PREPARED BY ME
OR UNDER MY SUPERVISION.
David K. Fujiwara
KSF, INC. APRIL 30, 2012
LIC. EXP. DATE


STATE OF HAWAII
DEPARTMENT OF TRANSPORTATION
HIGHWAYS DIVISION
**KAHOMA STREAM BRIDGE
ELEVATION AND SECTION**
HONOAPIILANI HIGHWAY REALIGNMENT, PHASE 1A
Future Keawe St Extension to Lahainaluna Rd, Part B
Fed. Aid Proj. No. NH-030-1(35)R
Scale: As Noted Date: June, 2010
SHEET No. SB1.2 OF 4 SHEETS

FINAL DESIGN 275

ORIGINAL PLAN	SURVEY PLOTTED BY	DATE
No.	DRAWN BY	
	TRACED BY	
	DESIGNED BY	
	QUANTITIES BY	
	CHECKED BY	

DRAWING NAME: Z:\00 ONGOING\40019.0-HONOAPIILANI LAHAINA BYPASS-KAHOMA WD\06-15-10 COMBINE LAHAINA FINAL DESIGN\HH-SB102.DWG PLOT TIME: 06-14-10, 2:47 PM

FED. ROAD DIST. NO.	STATE	FED. AID PROJ. NO.	FISCAL YEAR	SHEET NO.	TOTAL SHEETS
HAWAII	HAW.	NH-030-1(35)R	2009	276	383

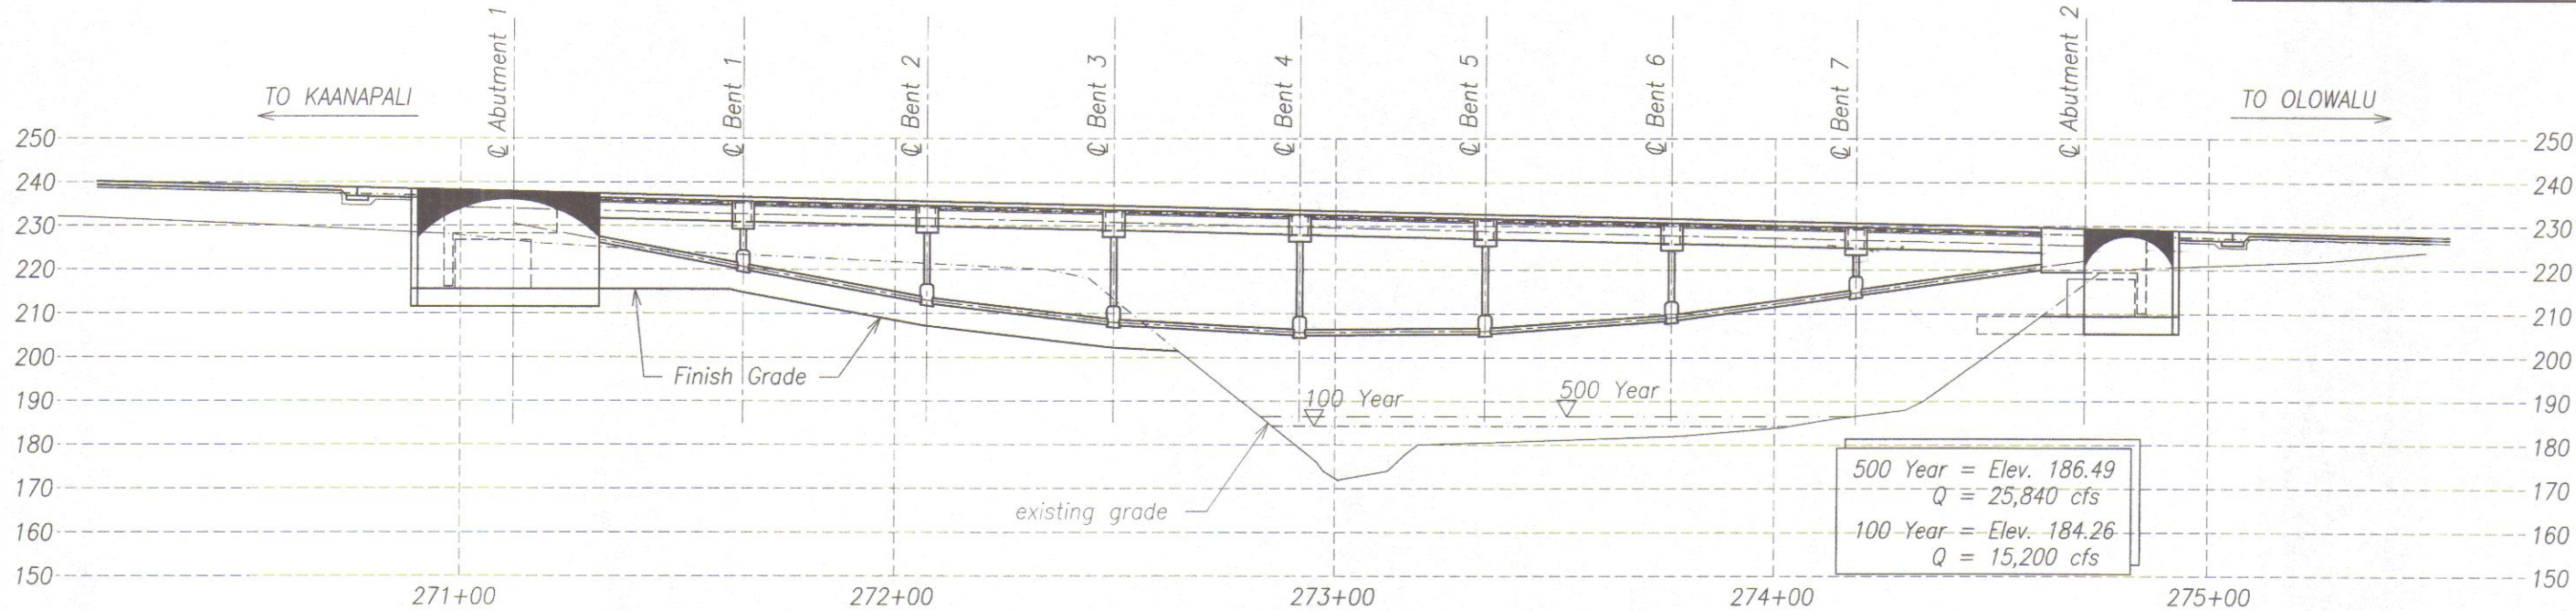

MAUKA ELEVATION – ALONG MAUKA BRIDGE
Scale: 1" = 20'-0"

ORIGINAL PLAN	SURVEY PLOTTED BY	DATE
NOTE BOOK	DRAWN BY	
No.	DESIGNED BY	
	QUANTITIES BY	
	CHECKED BY	

DRAWING NAME: 2100 ONCING\40019 0-HONOKAPILANI LAHANA BYPASS-KAHOMA WD\06-15-10 COMBINE LAHANA FINAL DESIGN\WH-SB102.DWG PLOT TIME: 06-14-10, 2:48 PM




THIS WORK WAS PREPARED BY ME OR UNDER MY SUPERVISION.

David K. Fujiwara
KSF, INC. APRIL 30, 2012
LIC. EXP. DATE

STATE OF HAWAII
DEPARTMENT OF TRANSPORTATION
HIGHWAYS DIVISION
KAHOMA STREAM BRIDGE
ELEVATION
HONOKAPILANI HIGHWAY REALIGNMENT, PHASE 1A
Future Keawe St Extension to Lahainaluna Rd, Part B
Fed. Aid Proj. No. NH-030-1(35)R
Scale: As Noted Date: June, 2010
SHEET No. SB1.3 OF 4 SHEETS

FED. ROAD DIST. NO.	STATE	FED. AID PROJ. NO.	FISCAL YEAR	SHEET NO.	TOTAL SHEETS
HAWAII	HAW.	NH-030-1(35)R	2009	277	383

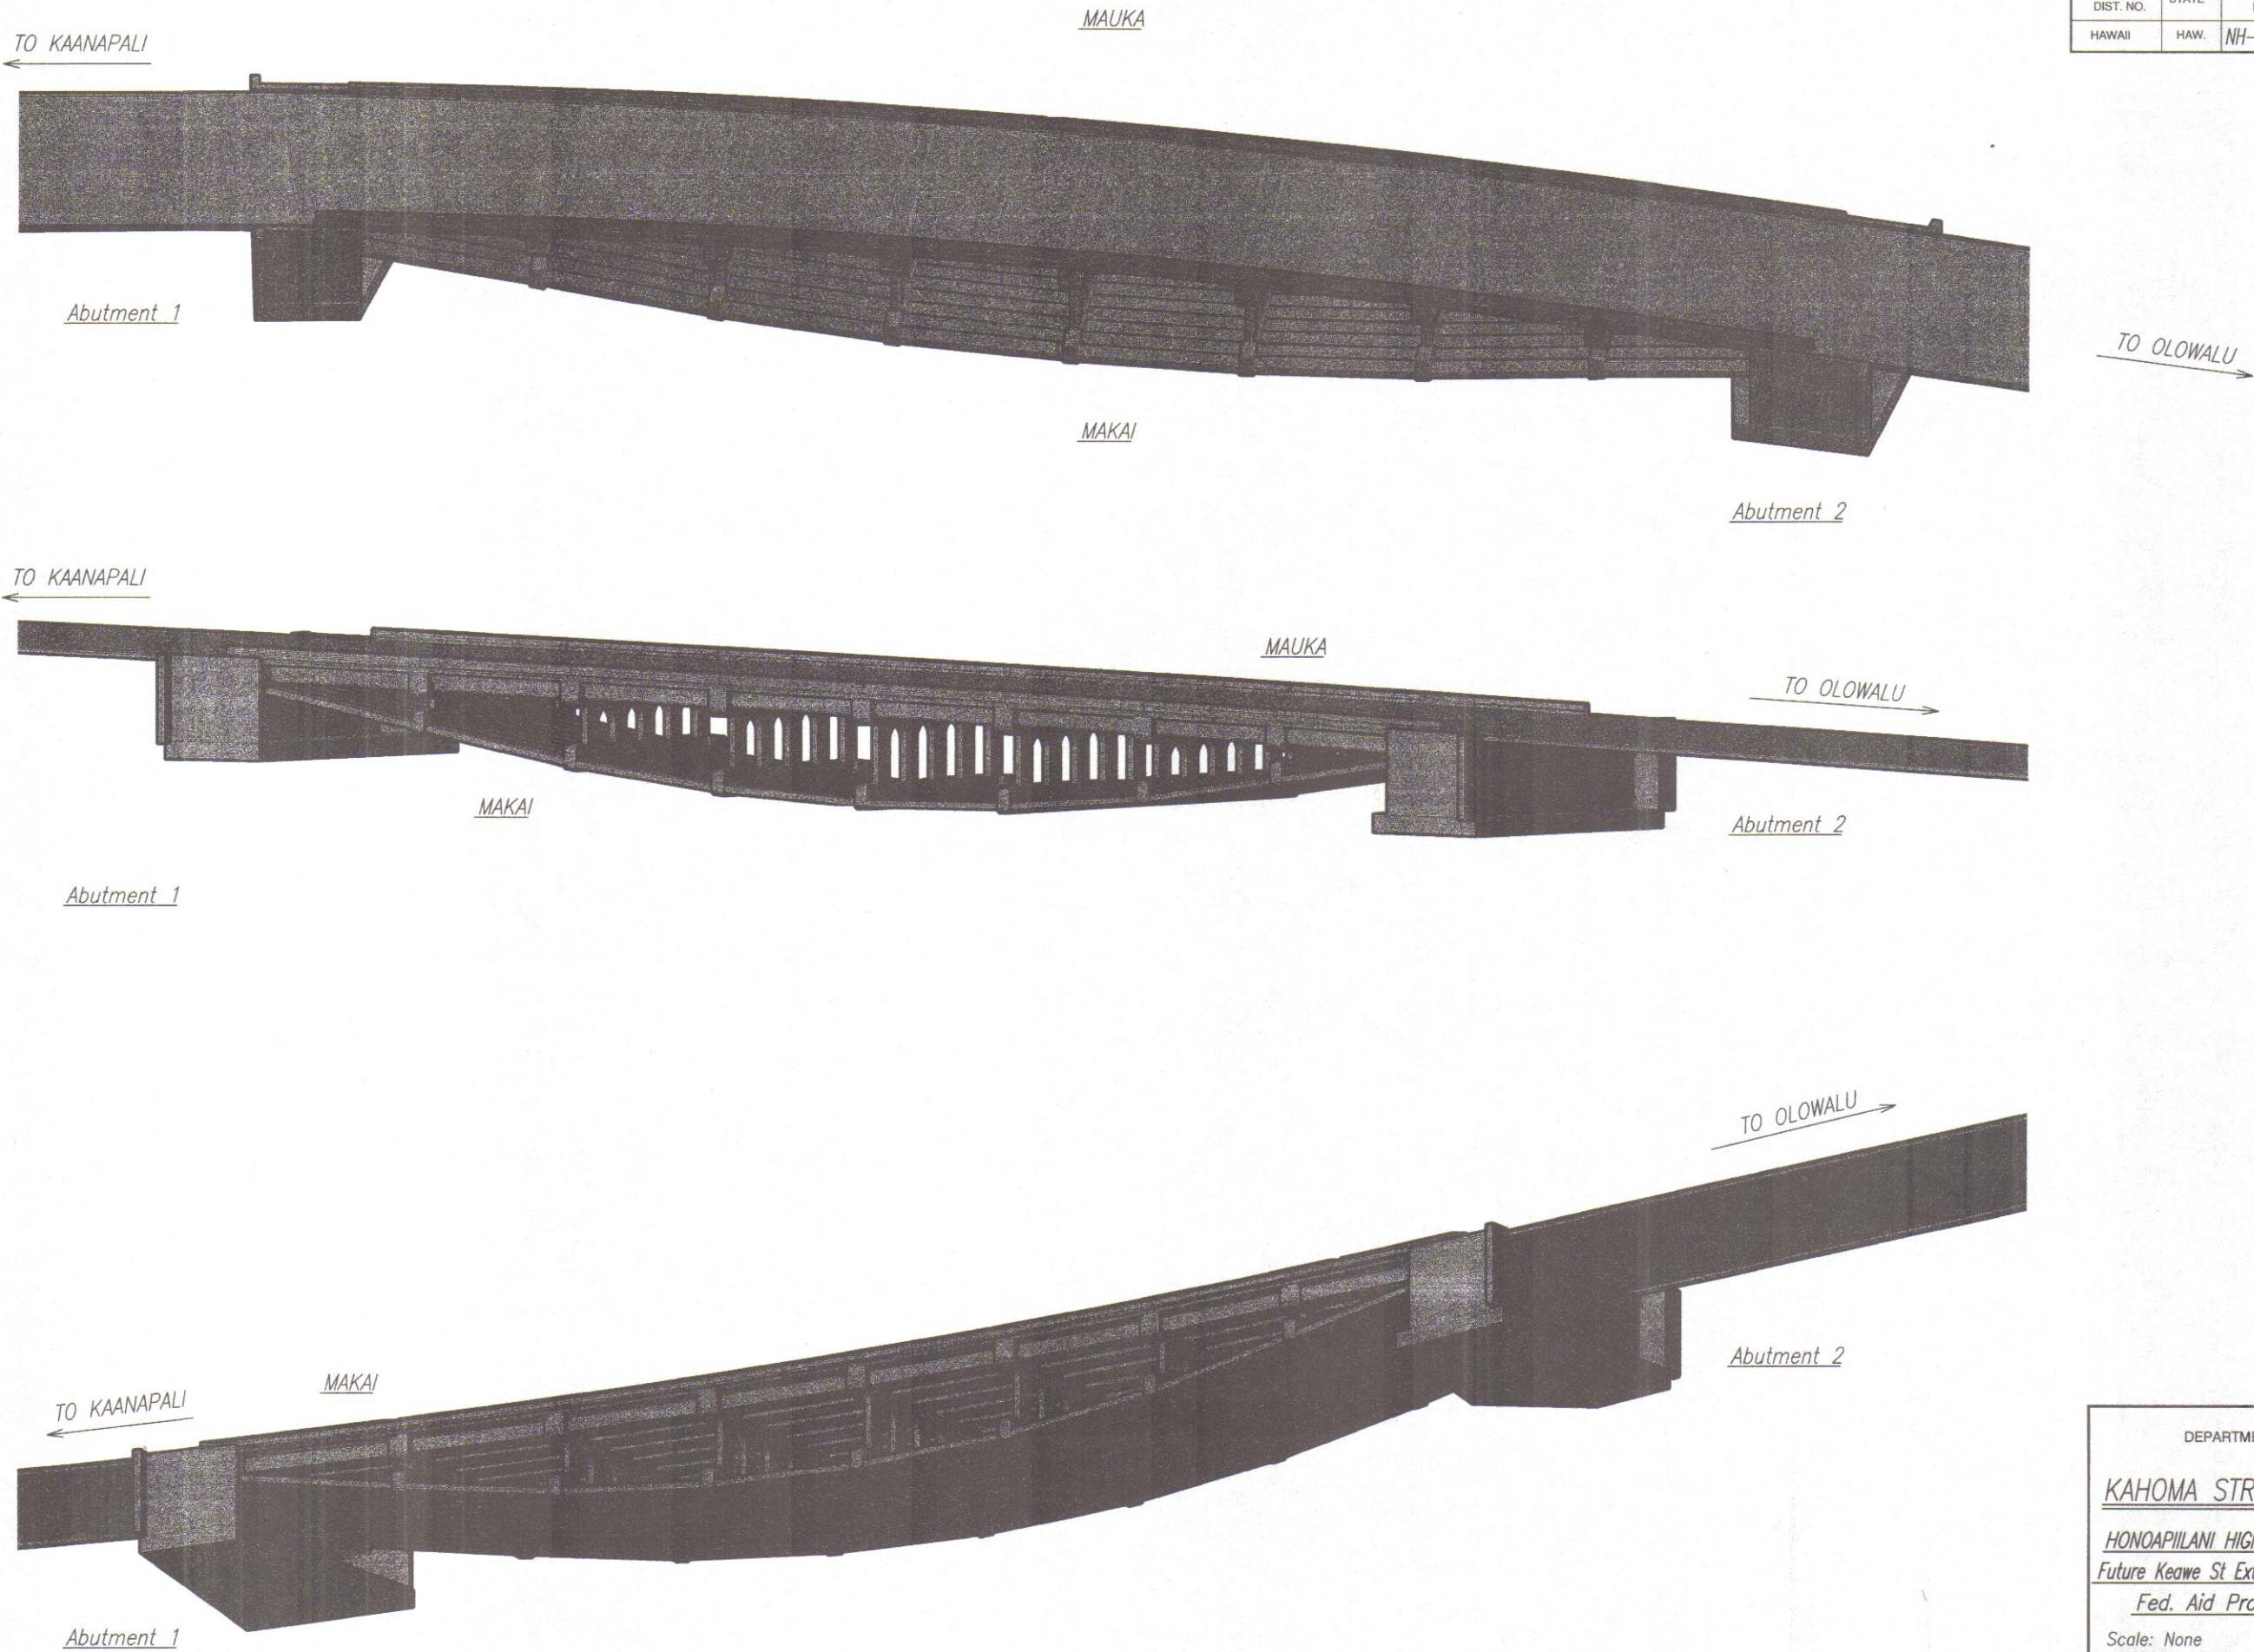

ORIGINAL PLAN	SURVEY PLOTTED BY	DATE
NOTE BOOK	DRAWN BY	
No.	DESIGNED BY	
	QUANTITIES BY	
	CHECKED BY	

DRAWING NAME: 21.00 OHCINGI 40019.0-HONOAPIILANI LAHANA BYPASS-KAHOMA WD 06-15-10 COMBINE LAHANA FINAL DESIGN\HH-SB104.DWG PLOT TIME: 06-14-10, 2:50 PM




THIS WORK WAS PREPARED BY ME
OR UNDER MY SUPERVISION.

David K. Fujiwara APRIL 30, 2012
KSF, INC. LIC. EXP. DATE

STATE OF HAWAII
DEPARTMENT OF TRANSPORTATION
HIGHWAYS DIVISION

KAHOMA STREAM BRIDGE MODELS
HONOAPIILANI HIGHWAY REALIGNMENT, PHASE 1A
Future Keawe St Extension to Lahainaluna Rd, Part B
Fed. Aid Proj. No. NH-030-1(35)R
Scale: None Date: June, 2010
SHEET No. SB1.4 OF 4 SHEETS

FED. ROAD DIST. NO.	STATE	FED. AID PROJ. NO.	FISCAL YEAR	SHEET NO.	TOTAL SHEETS
HAWAII	HAW.	NH-030-1(35)R	2009	278	383

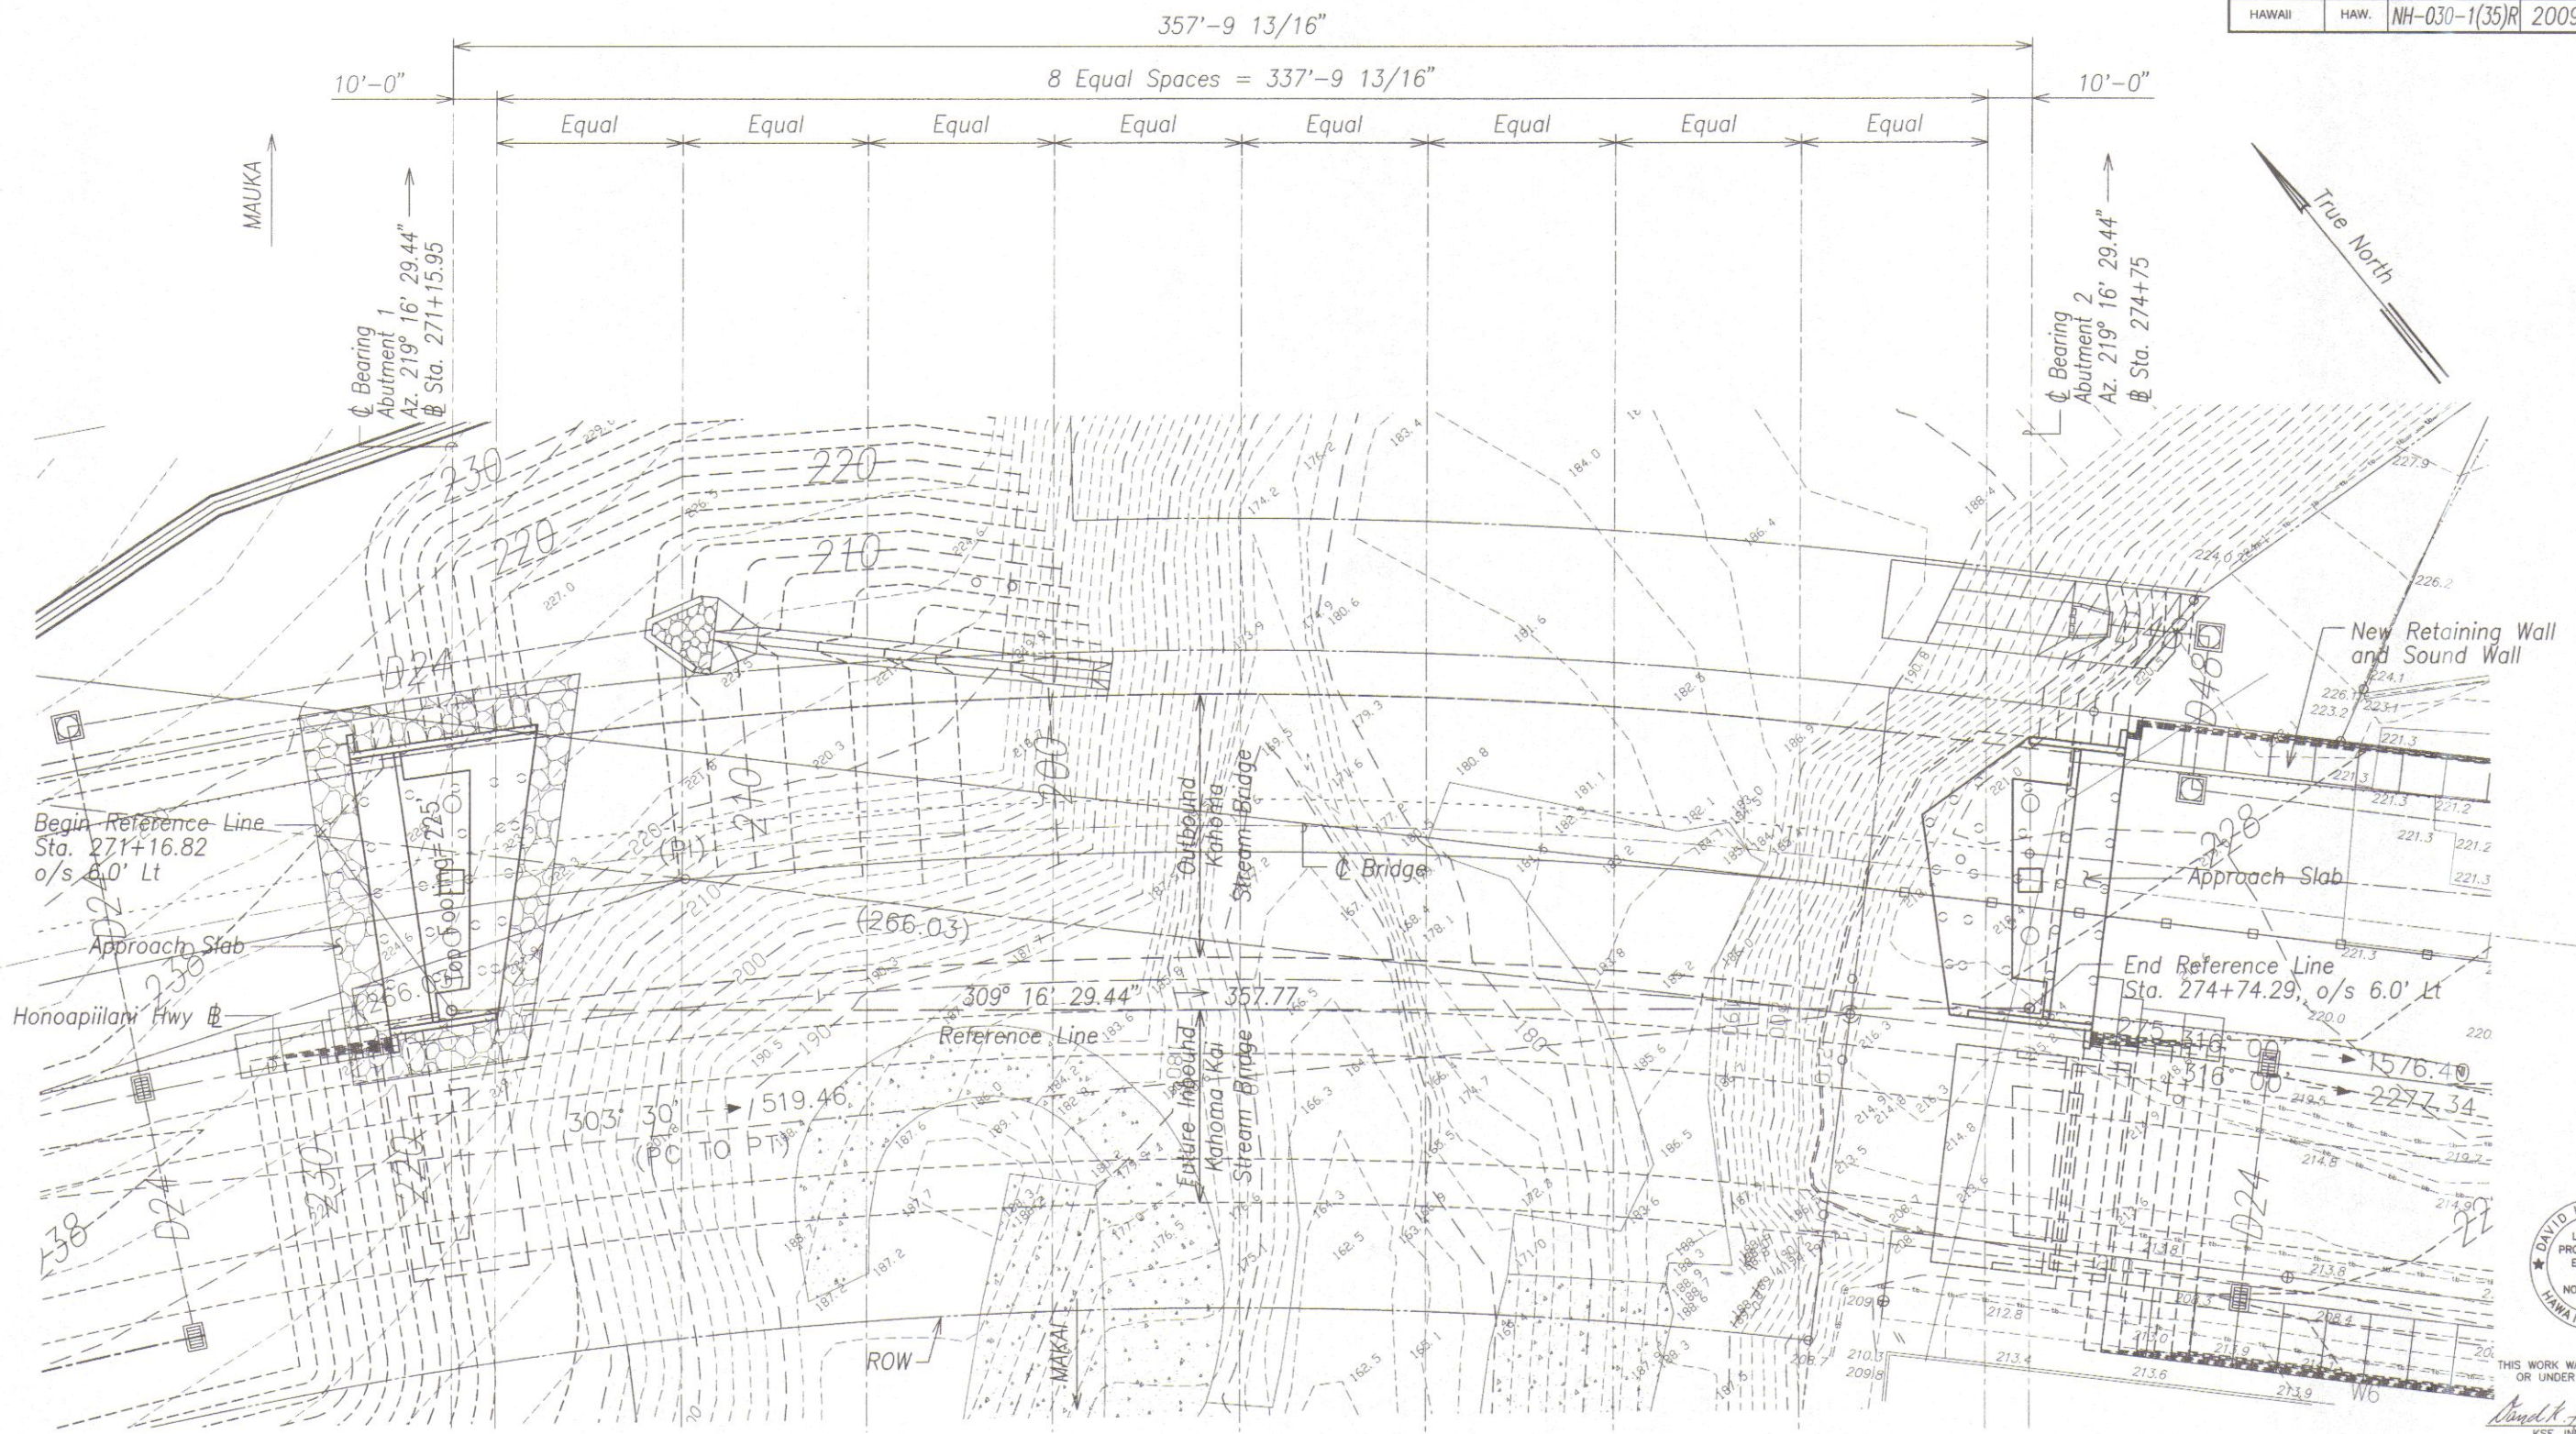

LEGEND:
 ○ Probe Hole Location, See Sheets SB8.3 and SB9.3 for spacing. See Special Provision Section 660.

KAHOMA STREAM BRIDGE FOUNDATION PLAN
 Scale: 1" = 20'-0"
 SB2.1 SB2.1

STATE OF HAWAII
DEPARTMENT OF TRANSPORTATION
HIGHWAYS DIVISION


KAHOMA STREAM BRIDGE
FOUNDATION PLAN
HONOAPIILANI HIGHWAY REALIGNMENT, PHASE 1A
Future Keawe St Extension to Lahainaluna Rd, Part B
Fed. Aid Proj. No. NH-030-1(35)R
Scale: As Noted Date: June, 2010
SHEET No. SB2.1 OF 3 SHEETS

ORIGINAL PLAN	DATE
NO. 1	
NO. 2	
NO. 3	
NO. 4	
NO. 5	
NO. 6	
NO. 7	
NO. 8	
NO. 9	
NO. 10	

DRAWING NAME: Z:\00 ONGOING\40019.0-HONOAPIILANI LAHAINA BYPASS-KAHOMA\0106-15-10 COMBINE LAHAINA FINAL DESIGN\HH-SB201.DWG PLOT TIME: 06-14-10, 2:59 PM

DAVID K. FUJIMURA
 LICENSED PROFESSIONAL ENGINEER
 NO. 8104-S
 HAWAII, U.S.A.
 THIS WORK WAS PREPARED BY ME OR UNDER MY SUPERVISION.
 KSF, INC. APRIL 30, 2012 U.C. EXP. DATE

FED. ROAD DIST. NO.	STATE	FED. AID PROJ. NO.	FISCAL YEAR	SHEET NO.	TOTAL SHEETS
HAWAII	HAW.	NH-030-1(35)R	2009	279	383

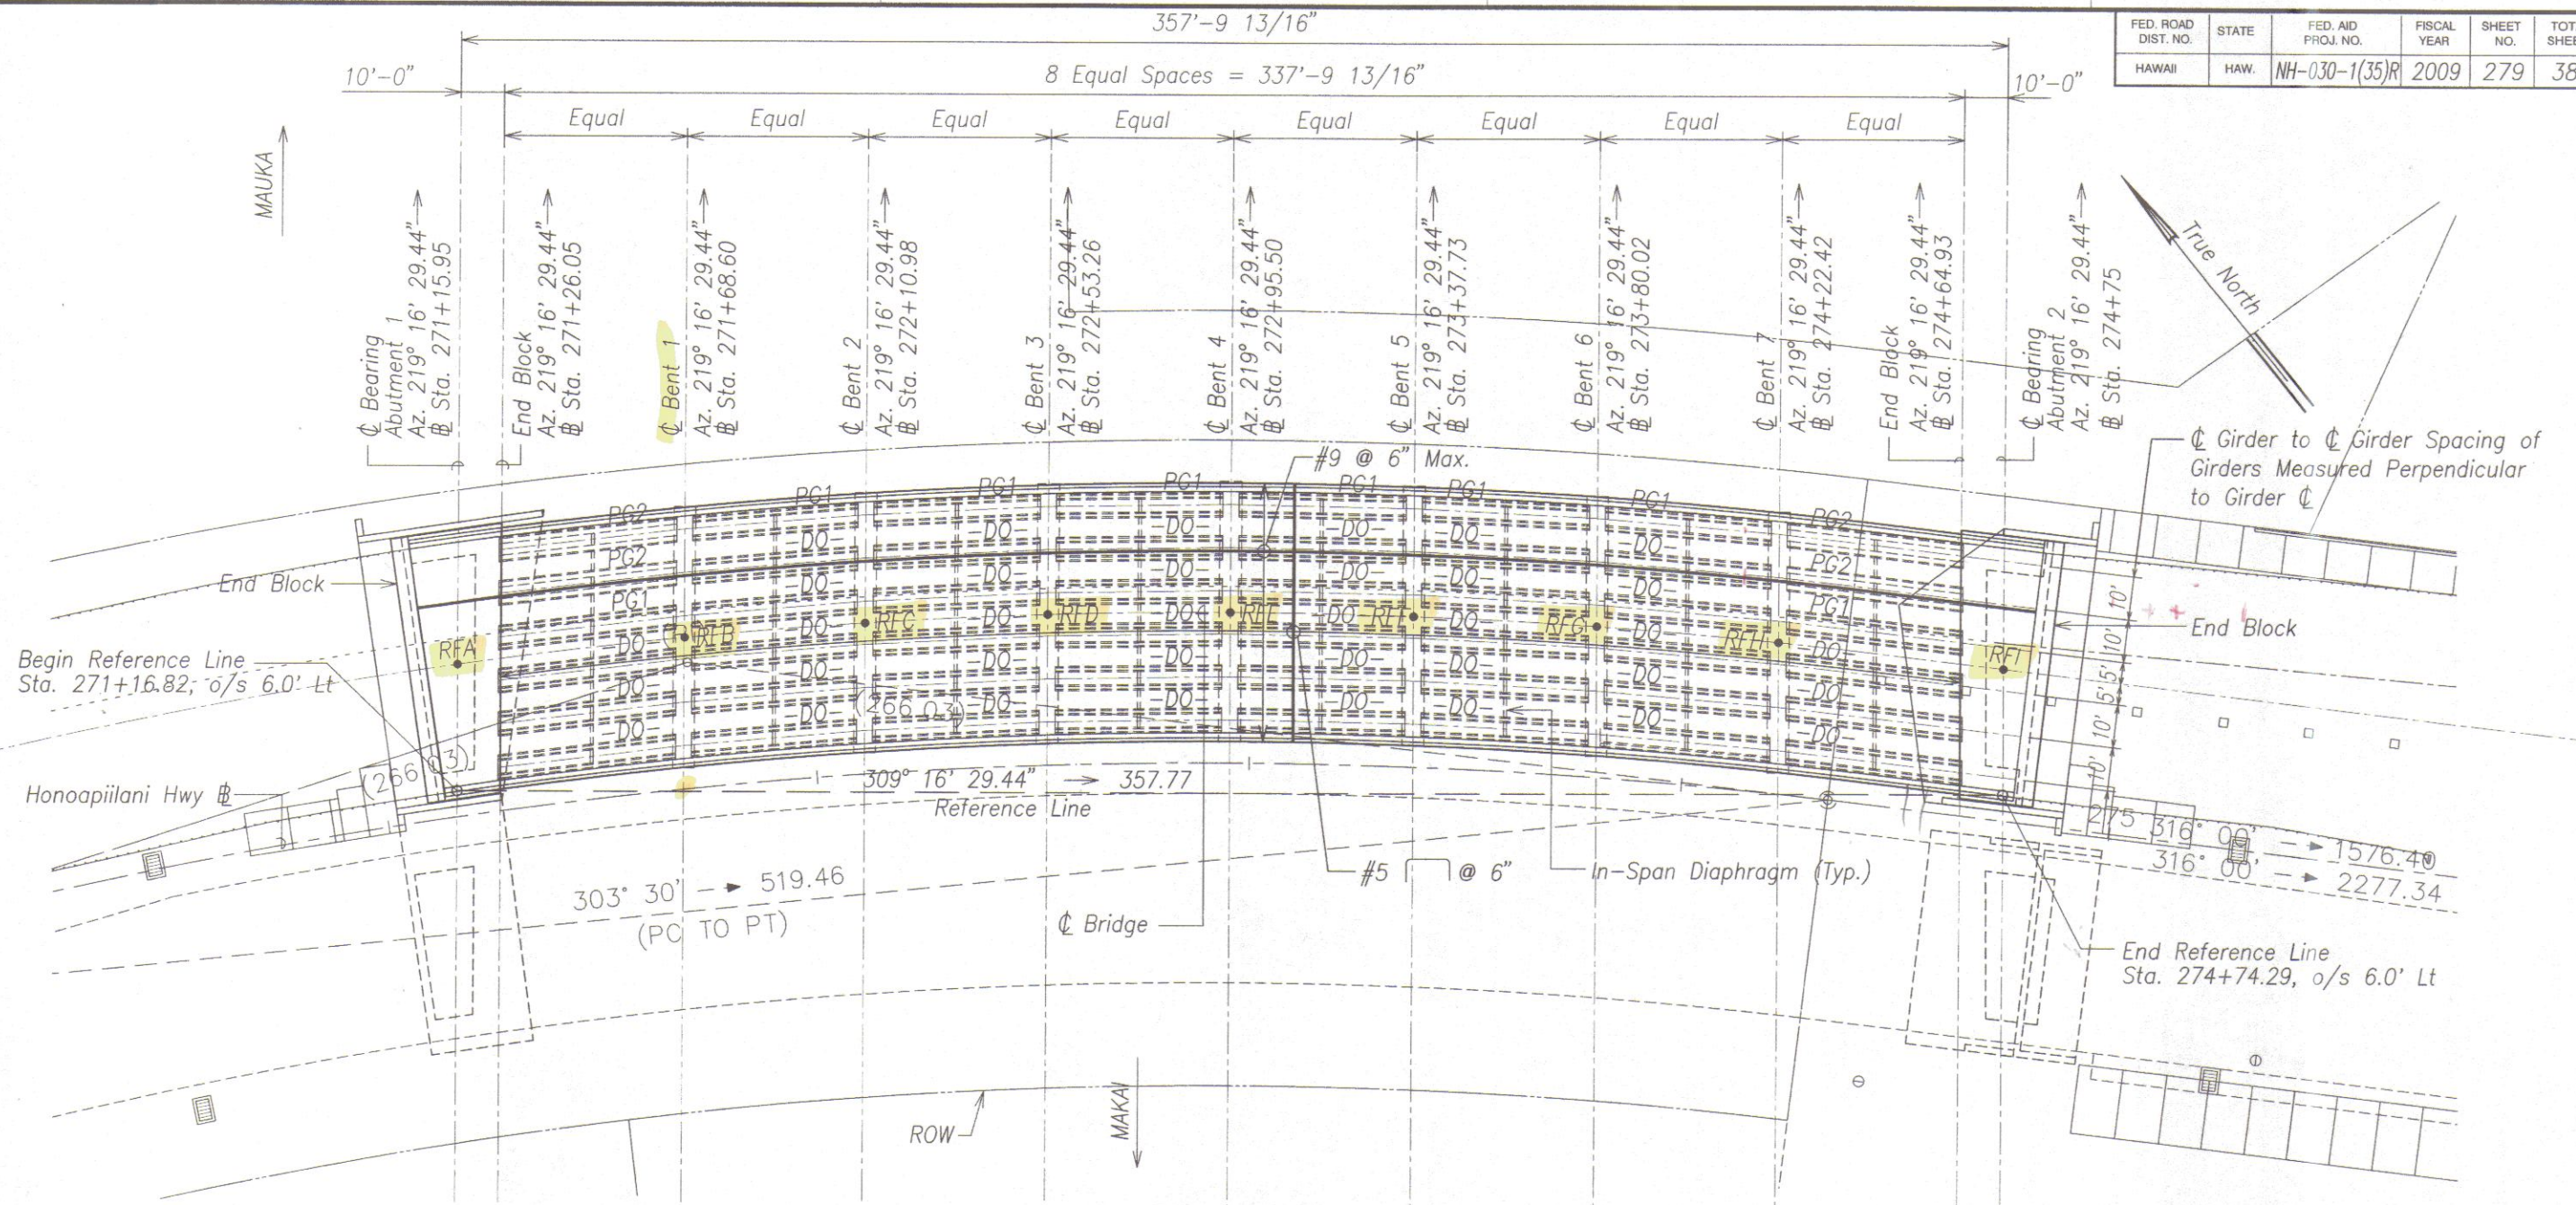

KAHOMA STREAM BRIDGE DECK FRAMING PLAN Scale: 1" = 20'-0"

LEGEND:

PG Denotes Precast Girders. See SB5 Series for details.
BENT Denotes CIP Bent. See SB7 Series for details.

NOTES:

- Span 1 Precast Girders are parallel w/ reference line between RFA and RFB.
- Span 2 Precast Girders are parallel w/ reference line between RFB and RFC.
- Span 3 Precast Girders are parallel w/ reference line between RFC and RFD.
- Span 4 Precast Girders are parallel w/ reference line between RFD and RFE.
- Span 5 Precast Girders are parallel w/ reference line between RFE and RFF.
- Span 6 Precast Girders are parallel w/ reference line between RFF and RFG.
- Span 7 Precast Girders are parallel w/ reference line between RFG and RFH.
- Span 8 Precast Girders are parallel w/ reference line between RFH and RFI.
- See SB6 Series for Arch Tie Plank information.
- See SB4B.1, SB4B.2 and SB5B.1 through SB5B.3 for In-Span Diaphragm.

REFERENCE POINTS

RFA	Honoapiilani Hwy @ Sta. 271+21.01 o/s 35'-0" Left
RFB	Honoapiilani Hwy @ Sta. 271+72.14 o/s 35'-0" Left
RFC	Honoapiilani Hwy @ Sta. 272+13.31 o/s 35'-0" Left
RFD	Honoapiilani Hwy @ Sta. 272+54.39 o/s 35'-0" Left
RFE	Honoapiilani Hwy @ Sta. 272+95.43 o/s 35'-0" Left
RFF	Honoapiilani Hwy @ Sta. 273+36.47 o/s 35'-0" Left
RFG	Honoapiilani Hwy @ Sta. 273+77.56 o/s 35'-0" Left
RFH	Honoapiilani Hwy @ Sta. 274+18.74 o/s 35'-0" Left
RFI	Honoapiilani Hwy @ Sta. 274+70.88 o/s 35'-0" Left



THIS WORK WAS PREPARED BY ME
OR UNDER MY SUPERVISION.
David K. Fujiwara
KSF, INC. APRIL 30, 2012
LIC. EXP. DATE

STATE OF HAWAII
DEPARTMENT OF TRANSPORTATION
HIGHWAYS DIVISION
KAHOMA STREAM BRIDGE
DECK FRAMING PLAN
HONOAPIILANI HIGHWAY REALIGNMENT, PHASE 1A
Future Keawe St Extension to Lahainaluna Rd, Part B
Fed. Aid Proj. No. NH-030-1(35)R
Scale: As Noted Date: June, 2010
SHEET No. SB2.2 OF 3 SHEETS


DATE	_____
DESIGNED BY	_____
CHECKED BY	_____
NOTED BY	_____
QUANTITIES BY	_____
NO.	_____

DRAWING NAME: Z:\00 ONGOING\401910-HONOAPIILANI LAHAINA BYPASS-KAHOMA WD\06-15-10 COMBINE LAHAINA FINAL DESIGN\H-SB202.DWG PLOT TIME: 06-14-10, 9:53 PM

FED. ROAD DIST. NO.	STATE	FED. AID PROJ. NO.	FISCAL YEAR	SHEET NO.	TOTAL SHEETS
HAWAII	HAW.	NH-030-1(35)R	2009	280	383

DRAWING NAME: 2A.00 ENCLOSURE 40019.0-HONOAPIILANI LAHAINA BYPASS-KAHOMA WD 06-15-10 COMBINE LAHAINA FINAL DESIGN\HAW-SB203.DWG PLOT TIME: 06-14-10, 3:03 PM

DATE	_____
SURVEY DICTATED BY	_____
DRAWN BY	_____
TRACED BY	_____
DESIGNED BY	_____
QUANTITIES BY	_____
CHECKED BY	_____
No.	_____

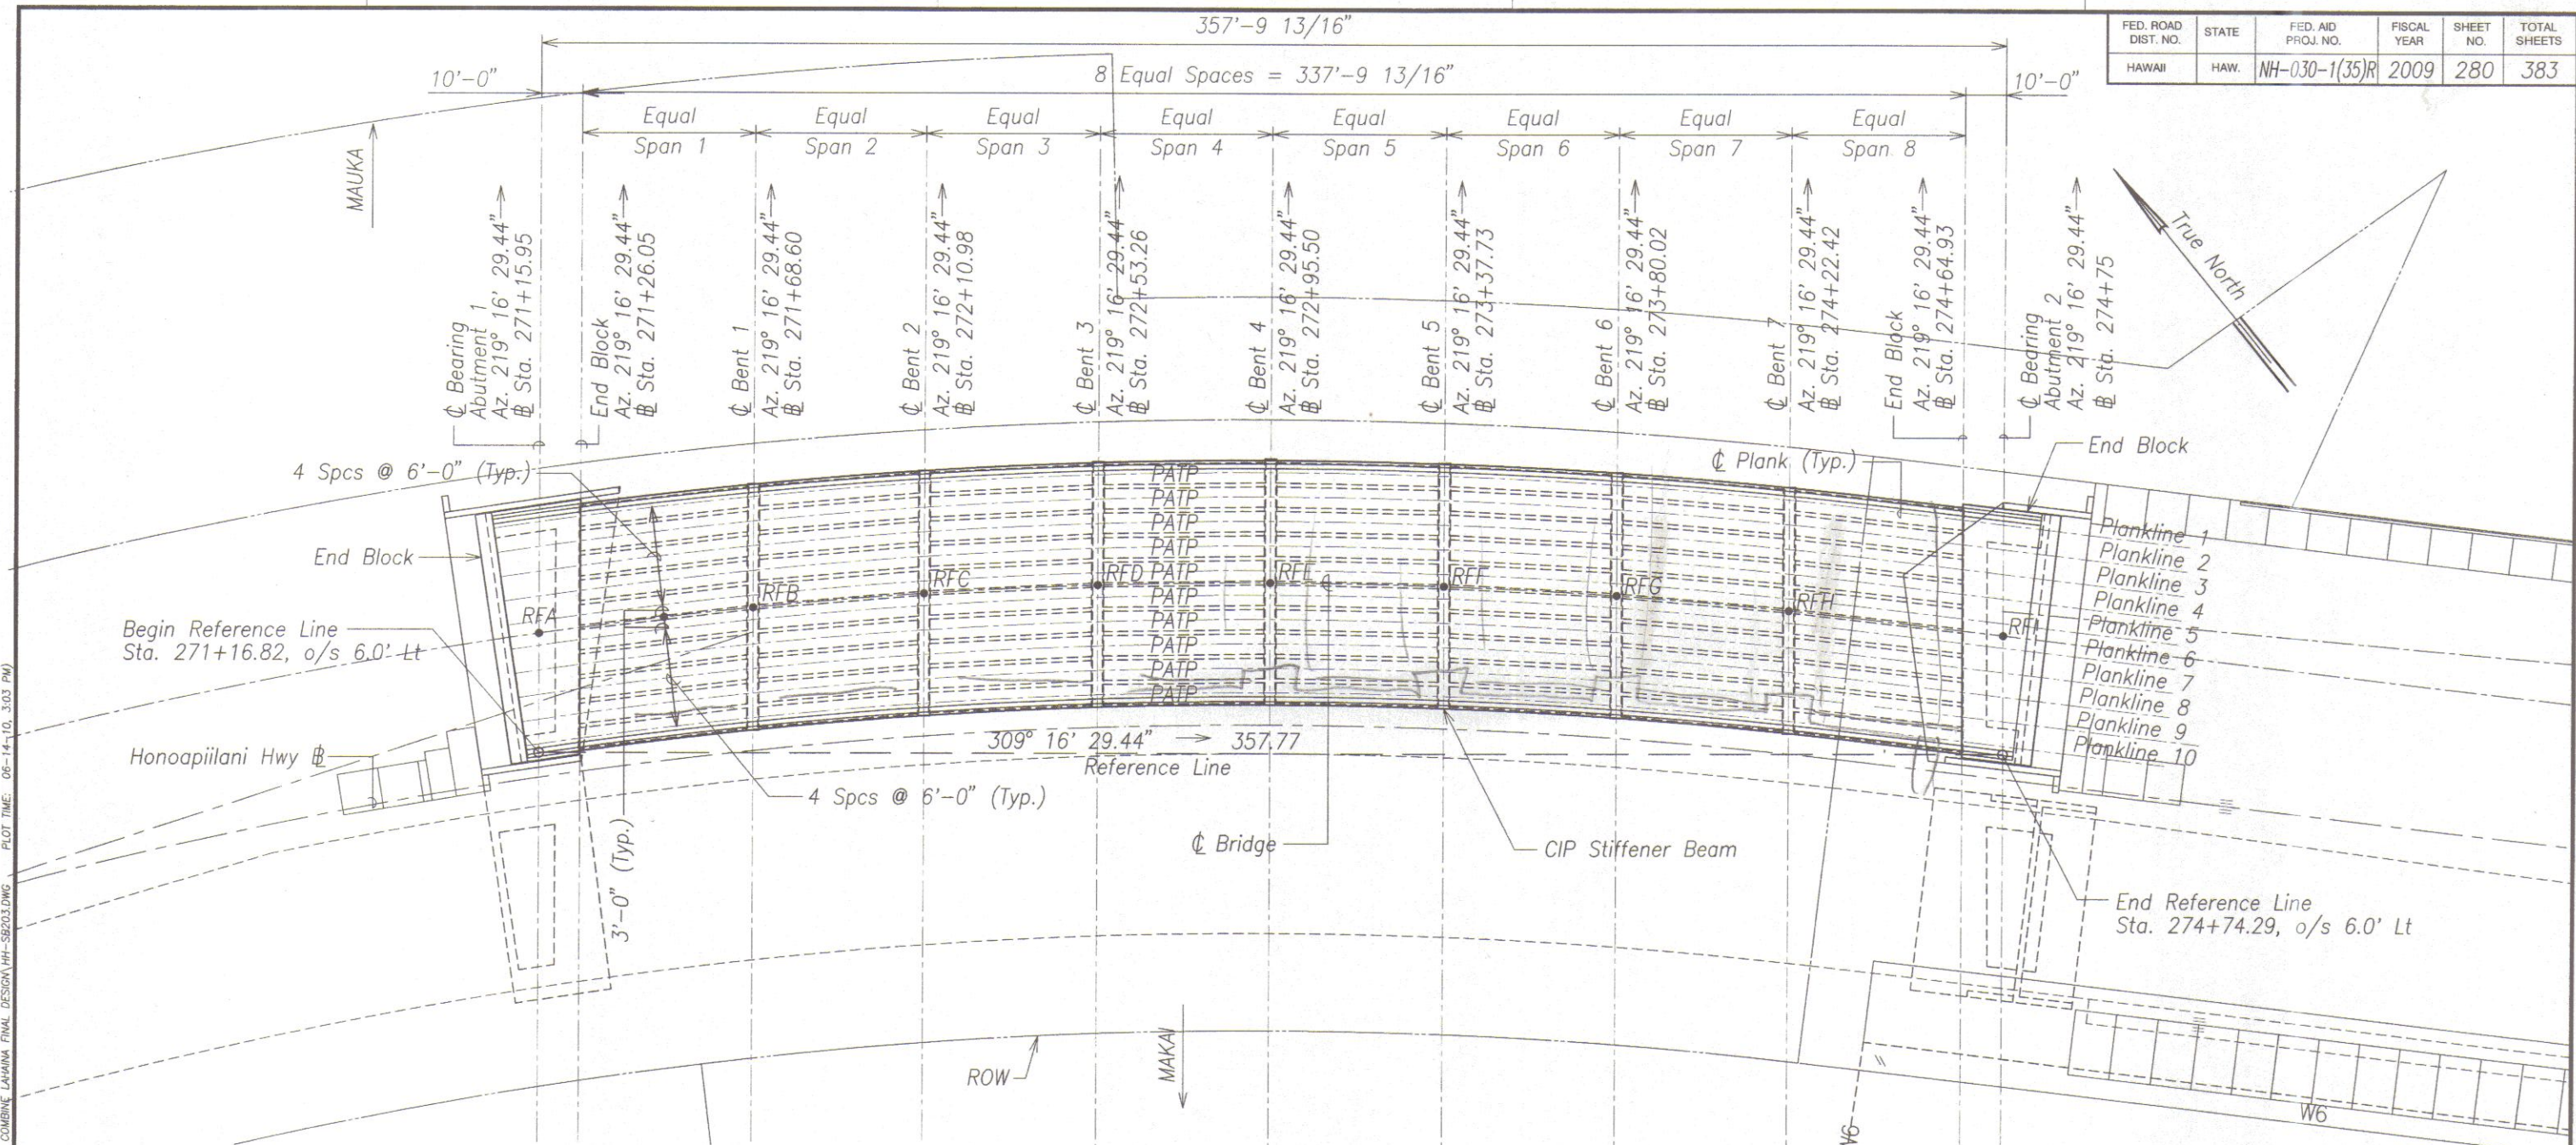

PRECAST ARCH TIE PLANK

Scale: 1" = 20'-0"

SB2.3/SB2.3

REFERENCE POINTS

RFA	Honoapiilani Hwy Sta. 271+21.01 o/s 35'-0" Left
RFB	Honoapiilani Hwy Sta. 271+72.14 o/s 35'-0" Left
RFC	Honoapiilani Hwy Sta. 272+13.31 o/s 35'-0" Left
RFD	Honoapiilani Hwy Sta. 272+54.39 o/s 35'-0" Left
RFE	Honoapiilani Hwy Sta. 272+95.43 o/s 35'-0" Left
RFF	Honoapiilani Hwy Sta. 273+36.47 o/s 35'-0" Left
RFG	Honoapiilani Hwy Sta. 273+77.56 o/s 35'-0" Left
RFH	Honoapiilani Hwy Sta. 274+18.74 o/s 35'-0" Left
RFI	Honoapiilani Hwy Sta. 274+70.88 o/s 35'-0" Left

NOTES:

- Span 1 Precast Arch Tie Planks (PATP) are parallel w/ reference line between RFA and RFB.
- Span 2 Precast Arch Tie Planks (PATP) are parallel w/ reference line between RFB and RFC.
- Span 3 Precast Arch Tie Planks (PATP) are parallel w/ reference line between RFC and RFD.
- Span 4 Precast Arch Tie Planks (PATP) are parallel w/ reference line between RFD and RFE.
- Span 5 Precast Arch Tie Planks (PATP) are parallel w/ reference line between RFE and RFF.
- Span 6 Precast Arch Tie Planks (PATP) are parallel w/ reference line between RFF and RFG.
- Span 7 Precast Arch Tie Planks (PATP) are parallel w/ reference line between RFG and RFH.
- Span 8 Precast Arch Tie Planks (PATP) are parallel w/ reference line between RFH and RFI.
- See SB6 Series for Precast Arch Tie Plank (PATP) information.
- See SB7D Series for Stiffener Beam information.




THIS WORK WAS PREPARED BY ME OR UNDER MY SUPERVISION.
David K. Fujiwara
 KSF, INC. APRIL 30, 2012 LIC. EXP. DATE

STATE OF HAWAII
 DEPARTMENT OF TRANSPORTATION
 HIGHWAYS DIVISION
KAHOMA STREAM BRIDGE
PRECAST ARCH TIE PLANK
 HONOAPIILANI HIGHWAY REALIGNMENT, PHASE 1A
 Future Keawe St Extension to Lahainaluna Rd, Part B
 Fed. Aid Proj. No. NH-030-1(35)R
 Scale: As Noted Date: June, 2010
 SHEET No. SB2.3 OF 3 SHEETS

FINAL DESIGN 280

FED. ROAD DIST. NO.	STATE	FED. AID PROJ. NO.	FISCAL YEAR	SHEET NO.	TOTAL SHEETS
HAWAII	HAW.	NH-030-1(35)R	2009	281	383

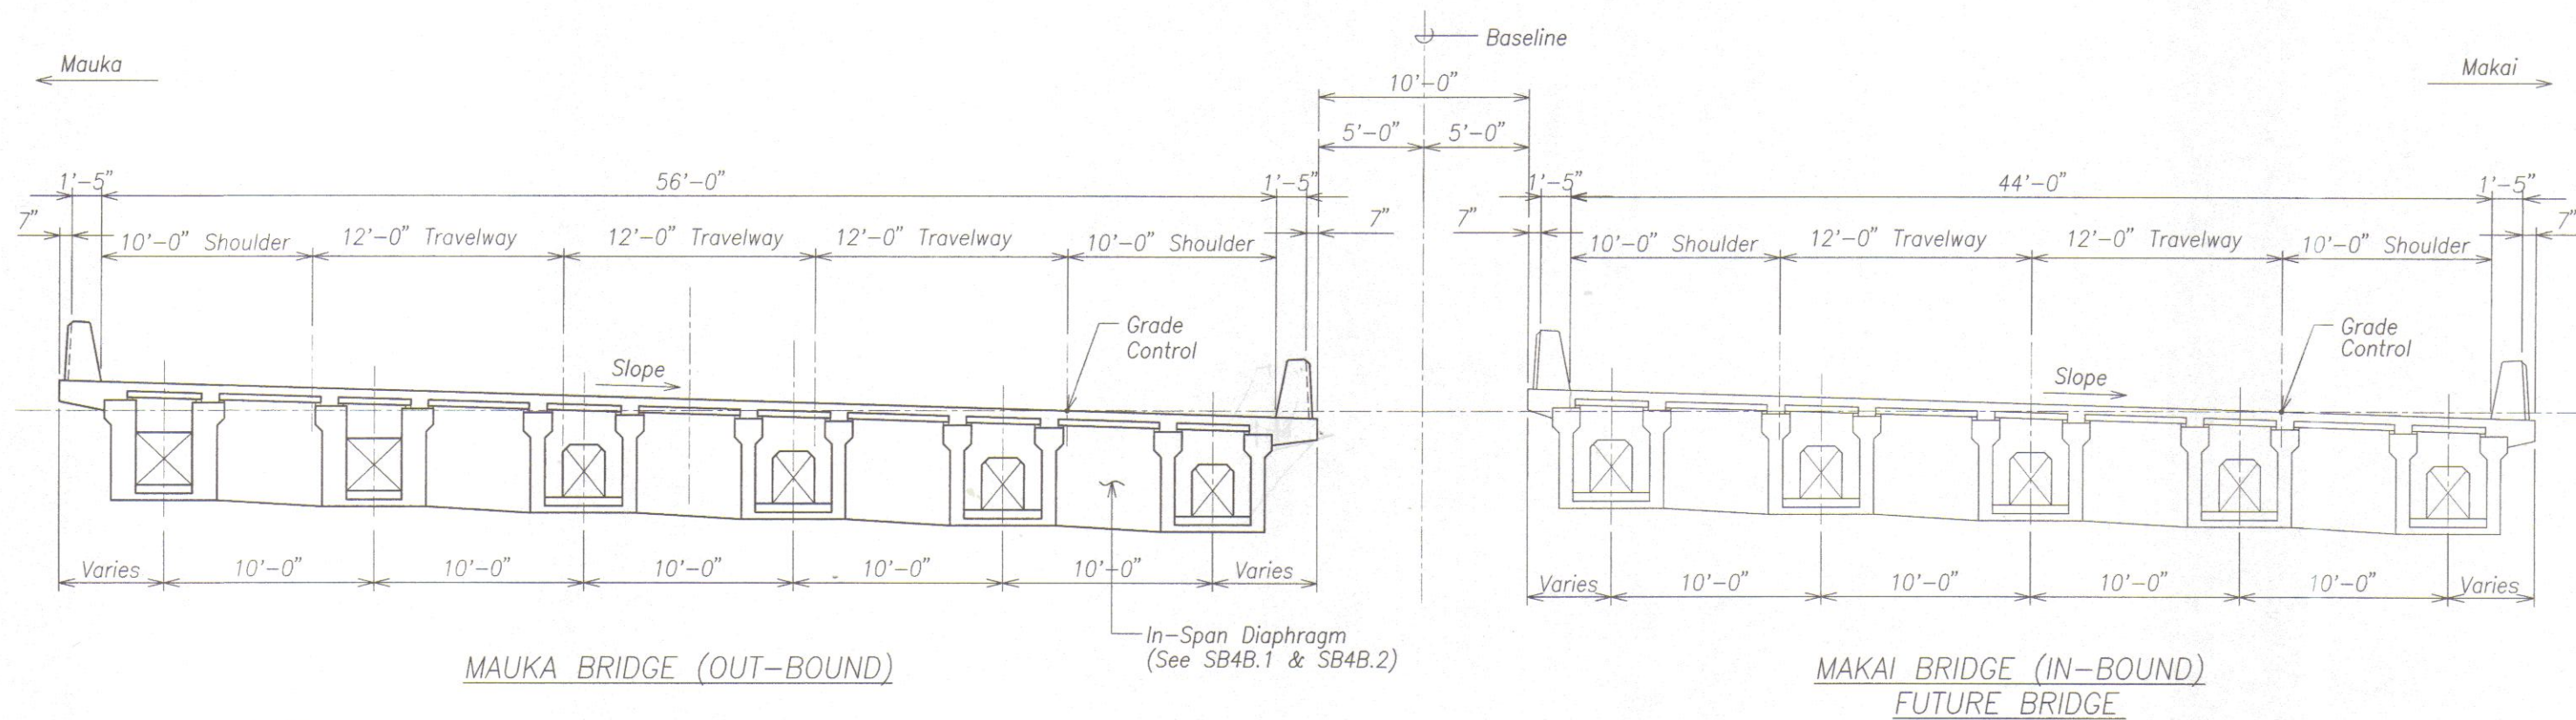


NOTES:

1. See Civil sheets for Superelevation of Finish Grade.
2. Dimensions for Girder spacing is measured perpendicular to Girder.

TYPICAL SECTION A
Scale: 1/4" = 1'-0" SB3.1/SB3.1

ORIGINAL PLAN	SURVEY PLOTTED BY	DATE
NOTE BOOK	DRAWN BY	
No.	TRACED BY	
	QUANTITIES BY	
	CHECKED BY	

DRAWING NAME: Z:\00 ONGOING\40019.0-HONOAPIILANI LAHAINA BYPASS-KAHOMA WO\06-15-10 COMBINE LAHAINA FINAL DESIGN\HH-SB301.DWG PLOT TIME: 06-14-10, 3:04 PM

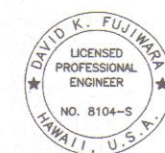


THIS WORK WAS PREPARED BY ME OR UNDER MY SUPERVISION.

David K. Fujiwara
KSF, INC. APRIL 30, 2012
LIC. EXP. DATE

STATE OF HAWAII DEPARTMENT OF TRANSPORTATION HIGHWAYS DIVISION	
TYPICAL SECTION	
HONOAPIILANI HIGHWAY REALIGNMENT, PHASE 1A Future Keawe St Extension to Lahainaluna Rd, Part B Fed. Aid Proj. No. NH-030-1(35)R	
Scale: As Noted	Date: June, 2010
SHEET No. SB3.1 OF 10 SHEETS	

FINAL DESIGN 281

FED. ROAD DIST. NO.	STATE	FED. AID PROJ. NO.	FISCAL YEAR	SHEET NO.	TOTAL SHEETS
HAWAII	HAW.	NH-030-1(35)R	2009	282	383

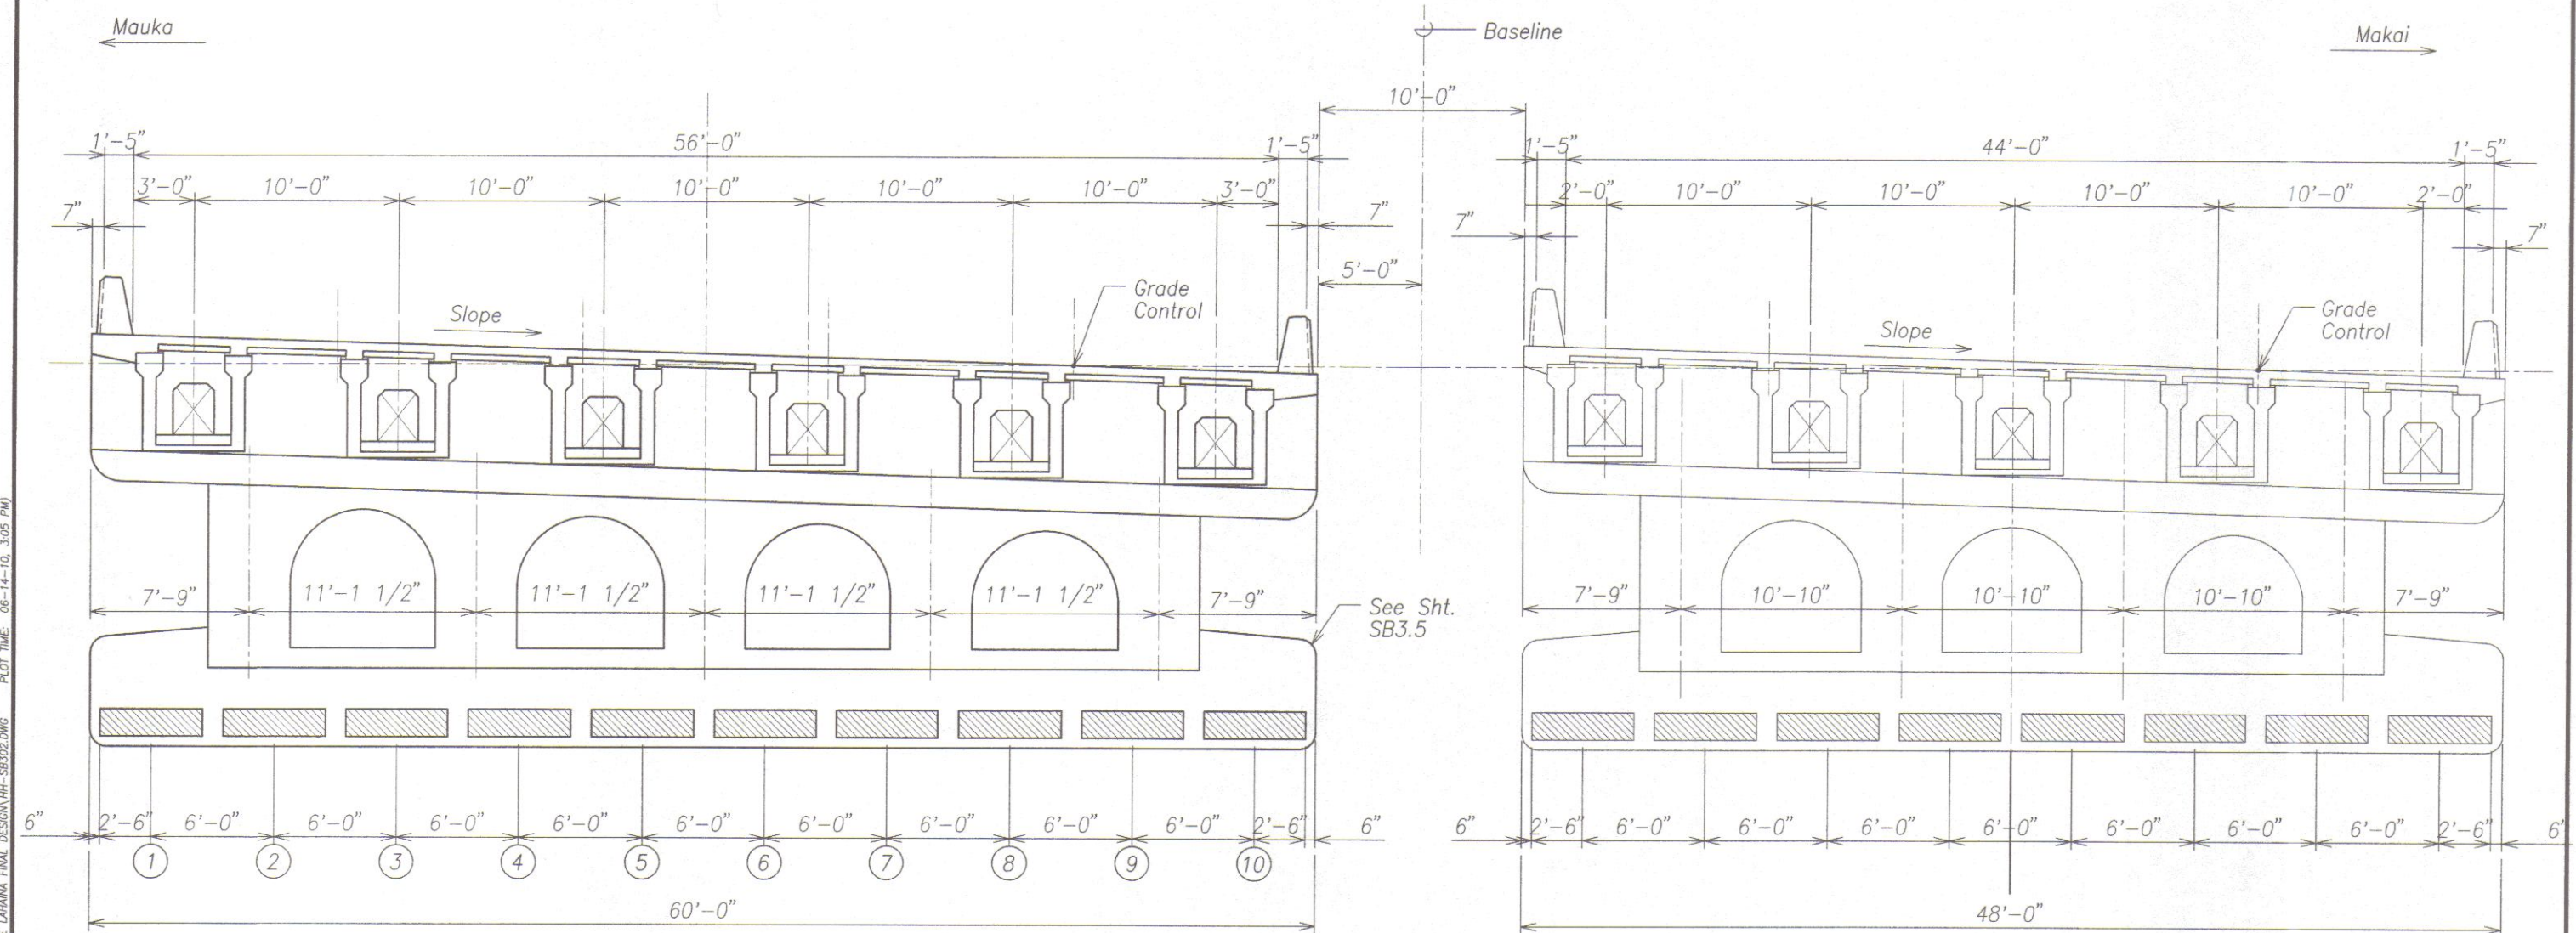

MAUKA BRIDGE (OUT-BOUND)

MAKAI BRIDGE (IN-BOUND)
FUTURE BRIDGE

LEGEND:

① - Denotes PATP Line Number

TYPICAL SECTION AT BENT A
Scale: 1/4" = 1'-0" SB3.2 SB3.2



THIS WORK WAS PREPARED BY ME
OR UNDER MY SUPERVISION.

David K. Fujiwara
KSF, INC. APRIL 30, 2012
LIC. EXP. DATE


STATE OF HAWAII DEPARTMENT OF TRANSPORTATION HIGHWAYS DIVISION	
TYPICAL SECTION AT BENT	
HONOAPIILANI HIGHWAY REALIGNMENT, PHASE 1A Future Keawe St Extension to Lahainaluna Rd, Part B Fed. Aid Proj. No. NH-030-1(35)R	
Scale: As Noted	Date: June, 2010
SHEET No. SB3.2 OF 10 SHEETS	

FINAL DESIGN 282

DRAWING NAME: Z:\00 ONGOING\2009\10-HONOAPIILANI LAHAINA BYPASS-KAHOMA W\06-15-10 COMBINE LAHAINA FINAL DESIGN\HH-SB302.DWG PLOT TIME: 06-14-10, 3:05 PM


SURVEY PLOTTED BY:	DATE:
DRAWN BY:	
DESIGNED BY:	
QUANTITIES BY:	
CHECKED BY:	
ORIGINAL PLAN	NOTE BOOK
No.	

FED. ROAD DIST. NO.	STATE	FED. AID PROJ. NO.	FISCAL YEAR	SHEET NO.	TOTAL SHEETS
HAWAII	HAW.	NH-030-1(35)R	2009	283	383

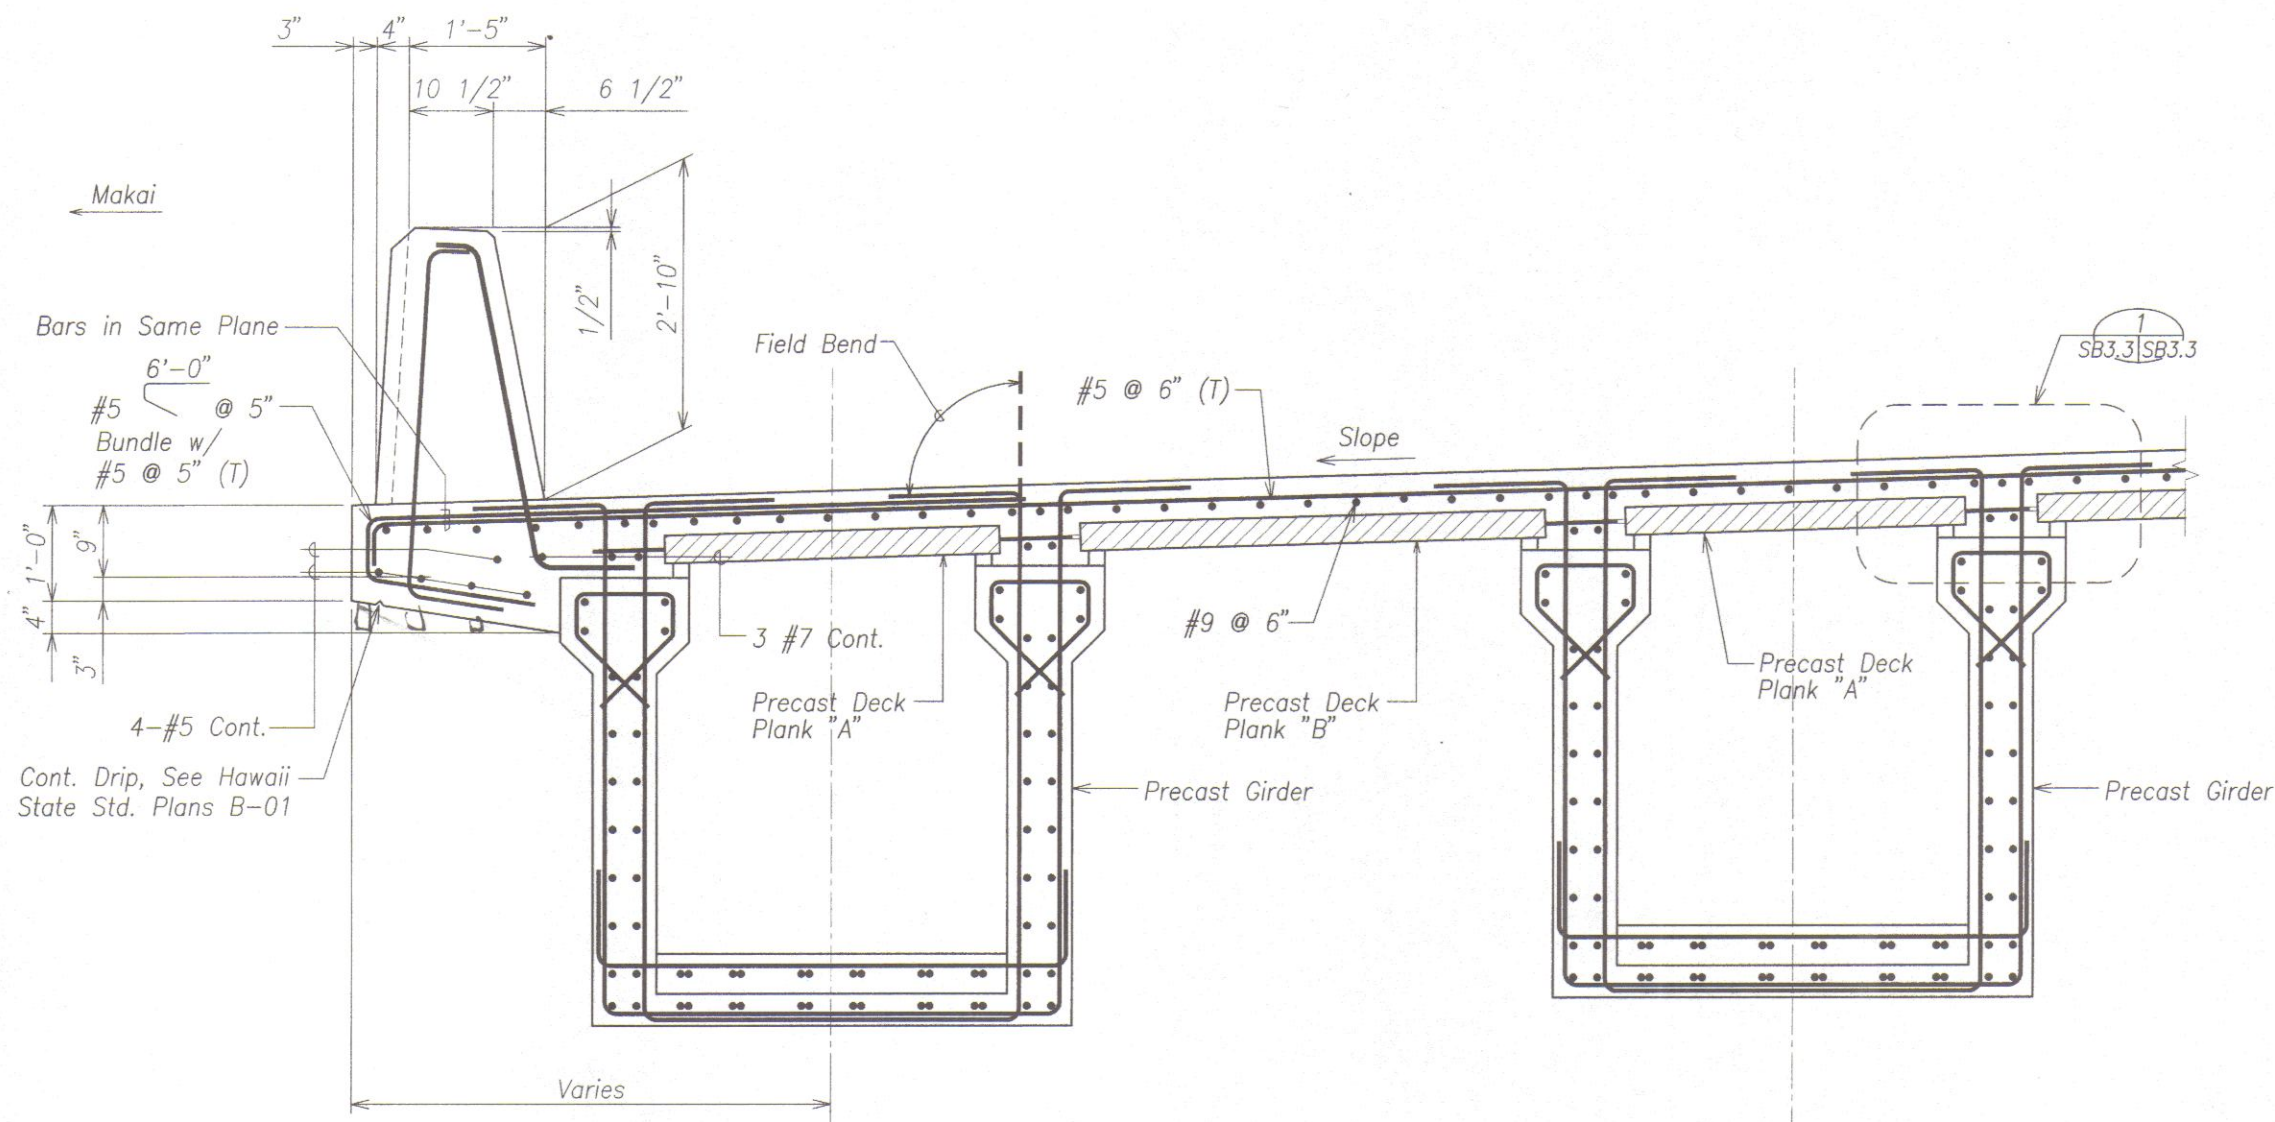

NOTES:

1. See Sheet SB4A.1 for Precast Deck Plank details.
2. See Sheets SB5.1 through SB5.4 for Precast Girder details.

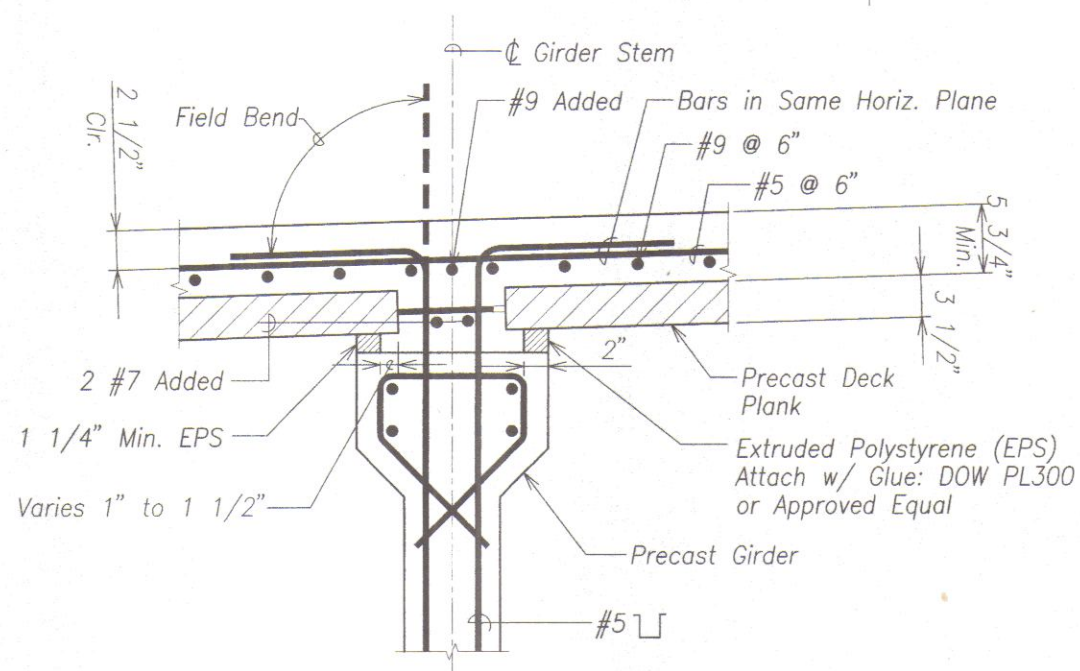

TYPICAL SECTION A
Scale: 1" = 1'-0" SB3.3|SB3.3

DETAIL 1
Scale: 1 1/2" = 1'-0" SB3.3|SB3.3



THIS WORK WAS PREPARED BY ME
OR UNDER MY SUPERVISION.
David K. Fujiwara
KSF, INC. APRIL 30, 2012
LIC. EXP. DATE

STATE OF HAWAII
DEPARTMENT OF TRANSPORTATION
HIGHWAYS DIVISION

TYPICAL SECTION

HONOAPIILANI HIGHWAY REALIGNMENT, PHASE 1A
Future Keawe St Extension to Lahainaluna Rd, Part B
Fed. Aid Proj. No. NH-030-1(35)R

Scale: As Noted Date: June, 2010

SHEET No. SB3.3 OF 10 SHEETS

FINAL DESIGN 283


DATE	_____
SURVEY PLOTTED BY	_____
DRAWN BY	_____
DESIGNED BY	_____
CHECKED BY	_____
ORIGINAL PLAN	_____
NOTE BOOK	_____
No.	_____

DRAWING NAME: Z:\00 ONGOING\40019.0-HONOAPIILANI LAHANA BYPASS-KAHOMA W\06-15-10 COMBINE LAHANA FINAL DESIGN\HH-SB303.DWG PLOT TIME: 06-14-10, 3:05 PM

MAUKA

MAKAI

FED. ROAD DIST. NO.	STATE	FED. AID PROJ. NO.	FISCAL YEAR	SHEET NO.	TOTAL SHEETS
HAWAII	HAW.	NH-030-1(35)R	2009	284	383

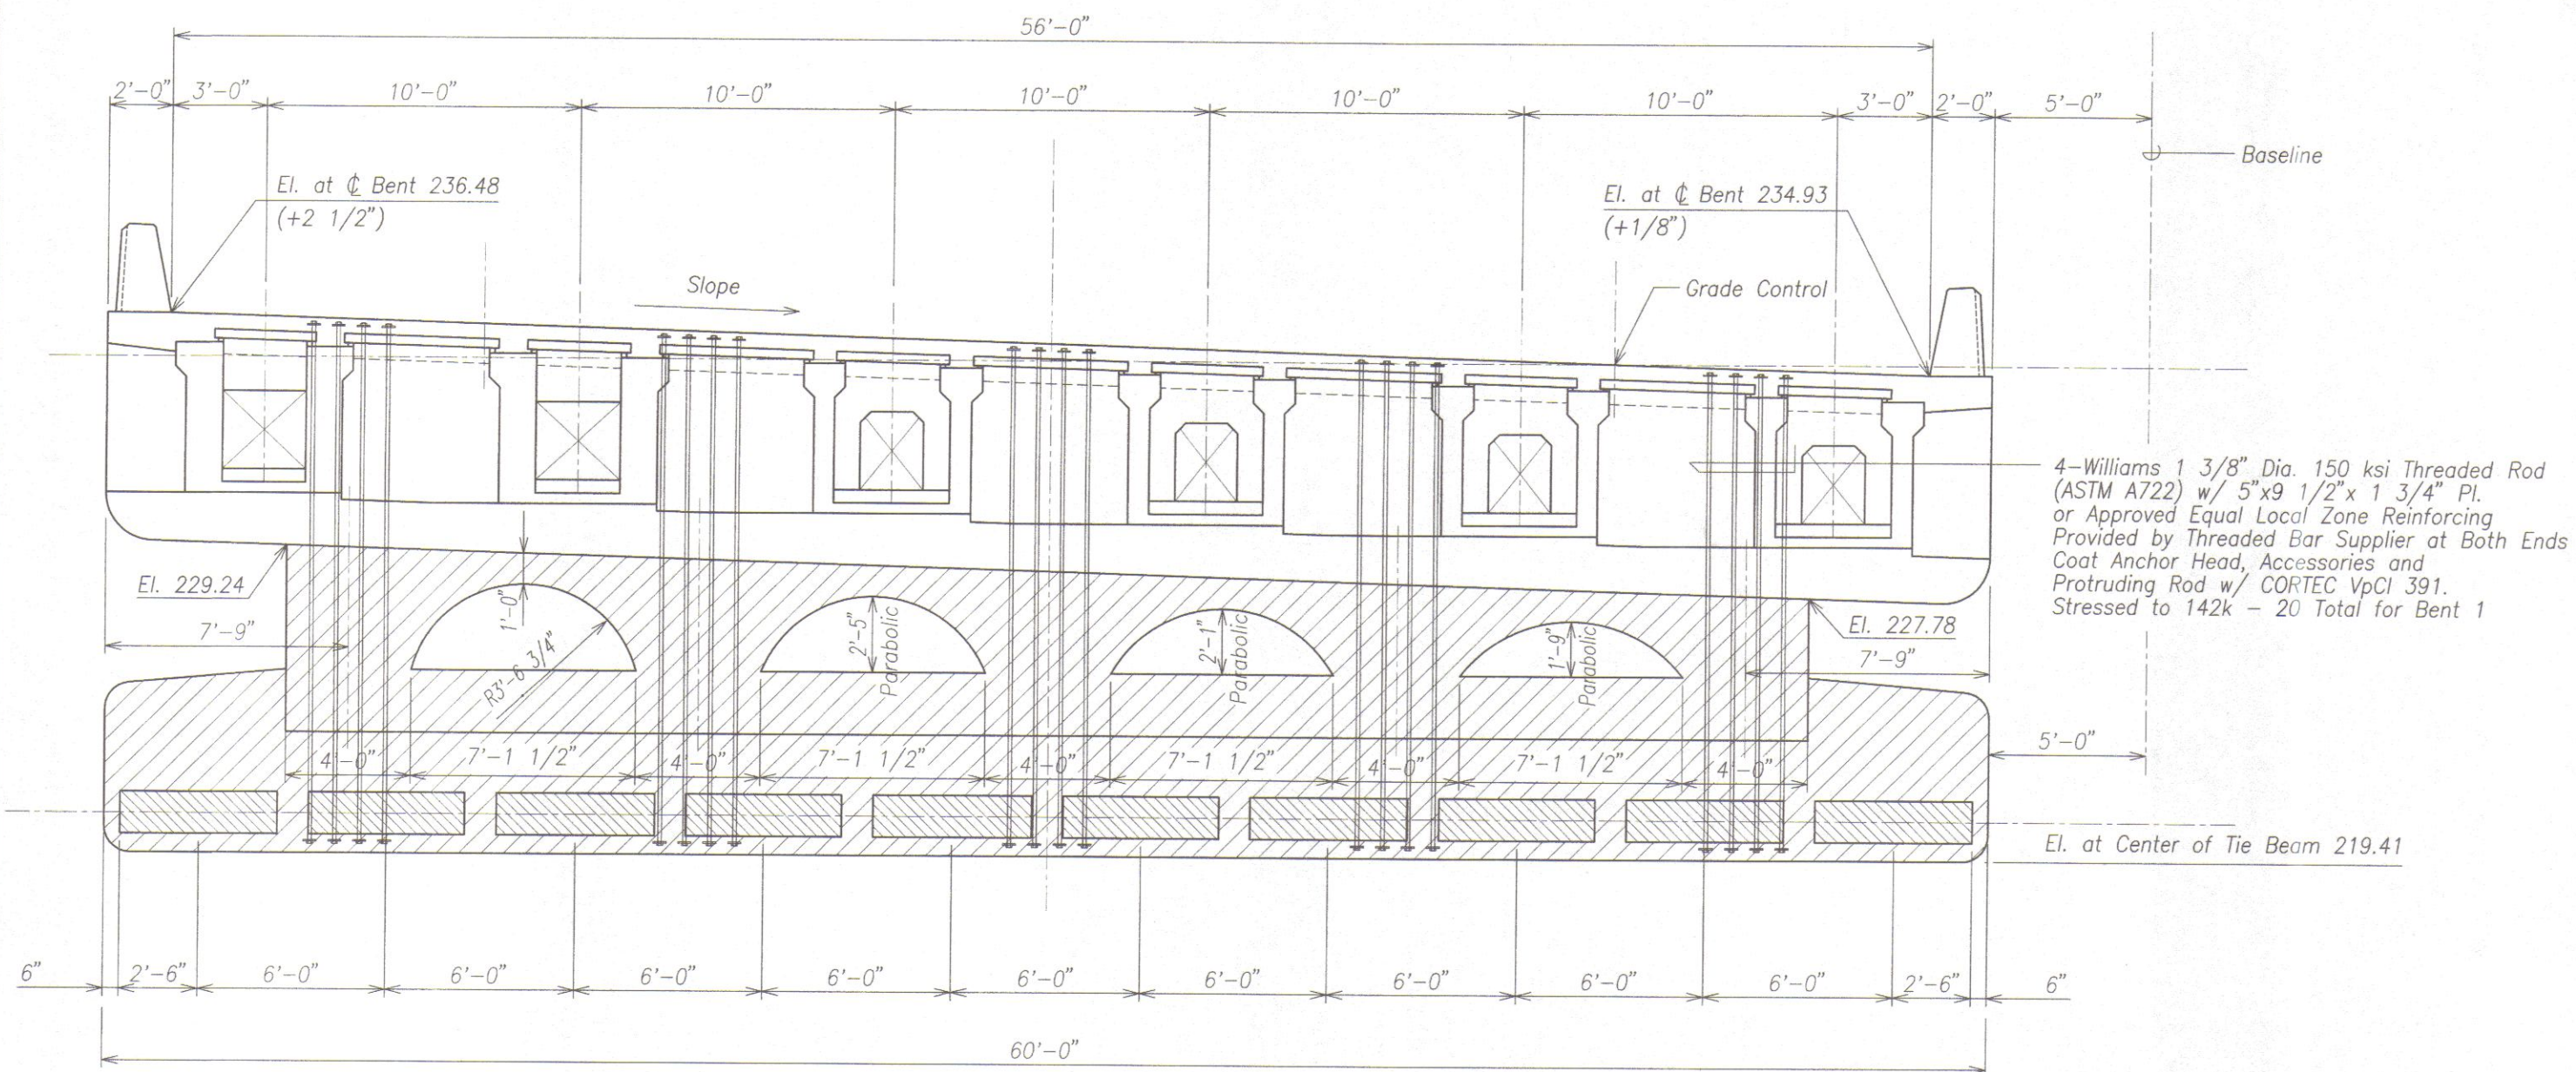**NOTE:**

Elevations and dimensions shown are design and theoretical values and do not include the effects of camber. Camber value are in (). For elevations and dimensions to be used for construction, refer to Form drawings.

LEGEND:

Indicates "Special" Concrete - High Concentration of Fibers

MAUKA BRIDGE (OUT-BOUND)**BENT 1 ELEVATION**

Scale: 3/8" = 1'-0"

A
SB3.4 SB3.4



THIS WORK WAS PREPARED BY ME
OR UNDER MY SUPERVISION.
David K. Fujiwara
KSF, INC. APRIL 30, 2012
LIC. EXP. DATE

STATE OF HAWAII
DEPARTMENT OF TRANSPORTATION
HIGHWAYS DIVISION

BENT ELEVATION

HONOAPIILANI HIGHWAY REALIGNMENT, PHASE 1A
Future Keawe St Extension to Lahainaluna Rd, Part B
Fed. Aid Proj. No. NH-030-1(35)R

Scale: As Noted

Date: June, 2010


SHEET No. SB3.4 OF 10 SHEETS

FINAL DESIGN 284

SURVEY PLOTTED BY	DATE
DRAWN BY	
TRACED BY	
DESIGNED BY	
CHECKED BY	
ORIGINAL PLAN	
NOTE BOOK	
No.	

DRAWING NAME: Z:\00 ONGOING\40019.0-HONOAPIILANI LAHAINA BYPASS-KAHOMA WO\06-15-10 COMBINE LAHAINA FINAL DESIGN\HH-SB3.4.DWG PLOT TIME: 06-14-10, 3:06 PM

FED. ROAD DIST. NO.	STATE	FED. AID PROJ. NO.	FISCAL YEAR	SHEET NO.	TOTAL SHEETS
HAWAII	HAW.	NH-030-1(35)R	2009	285	383

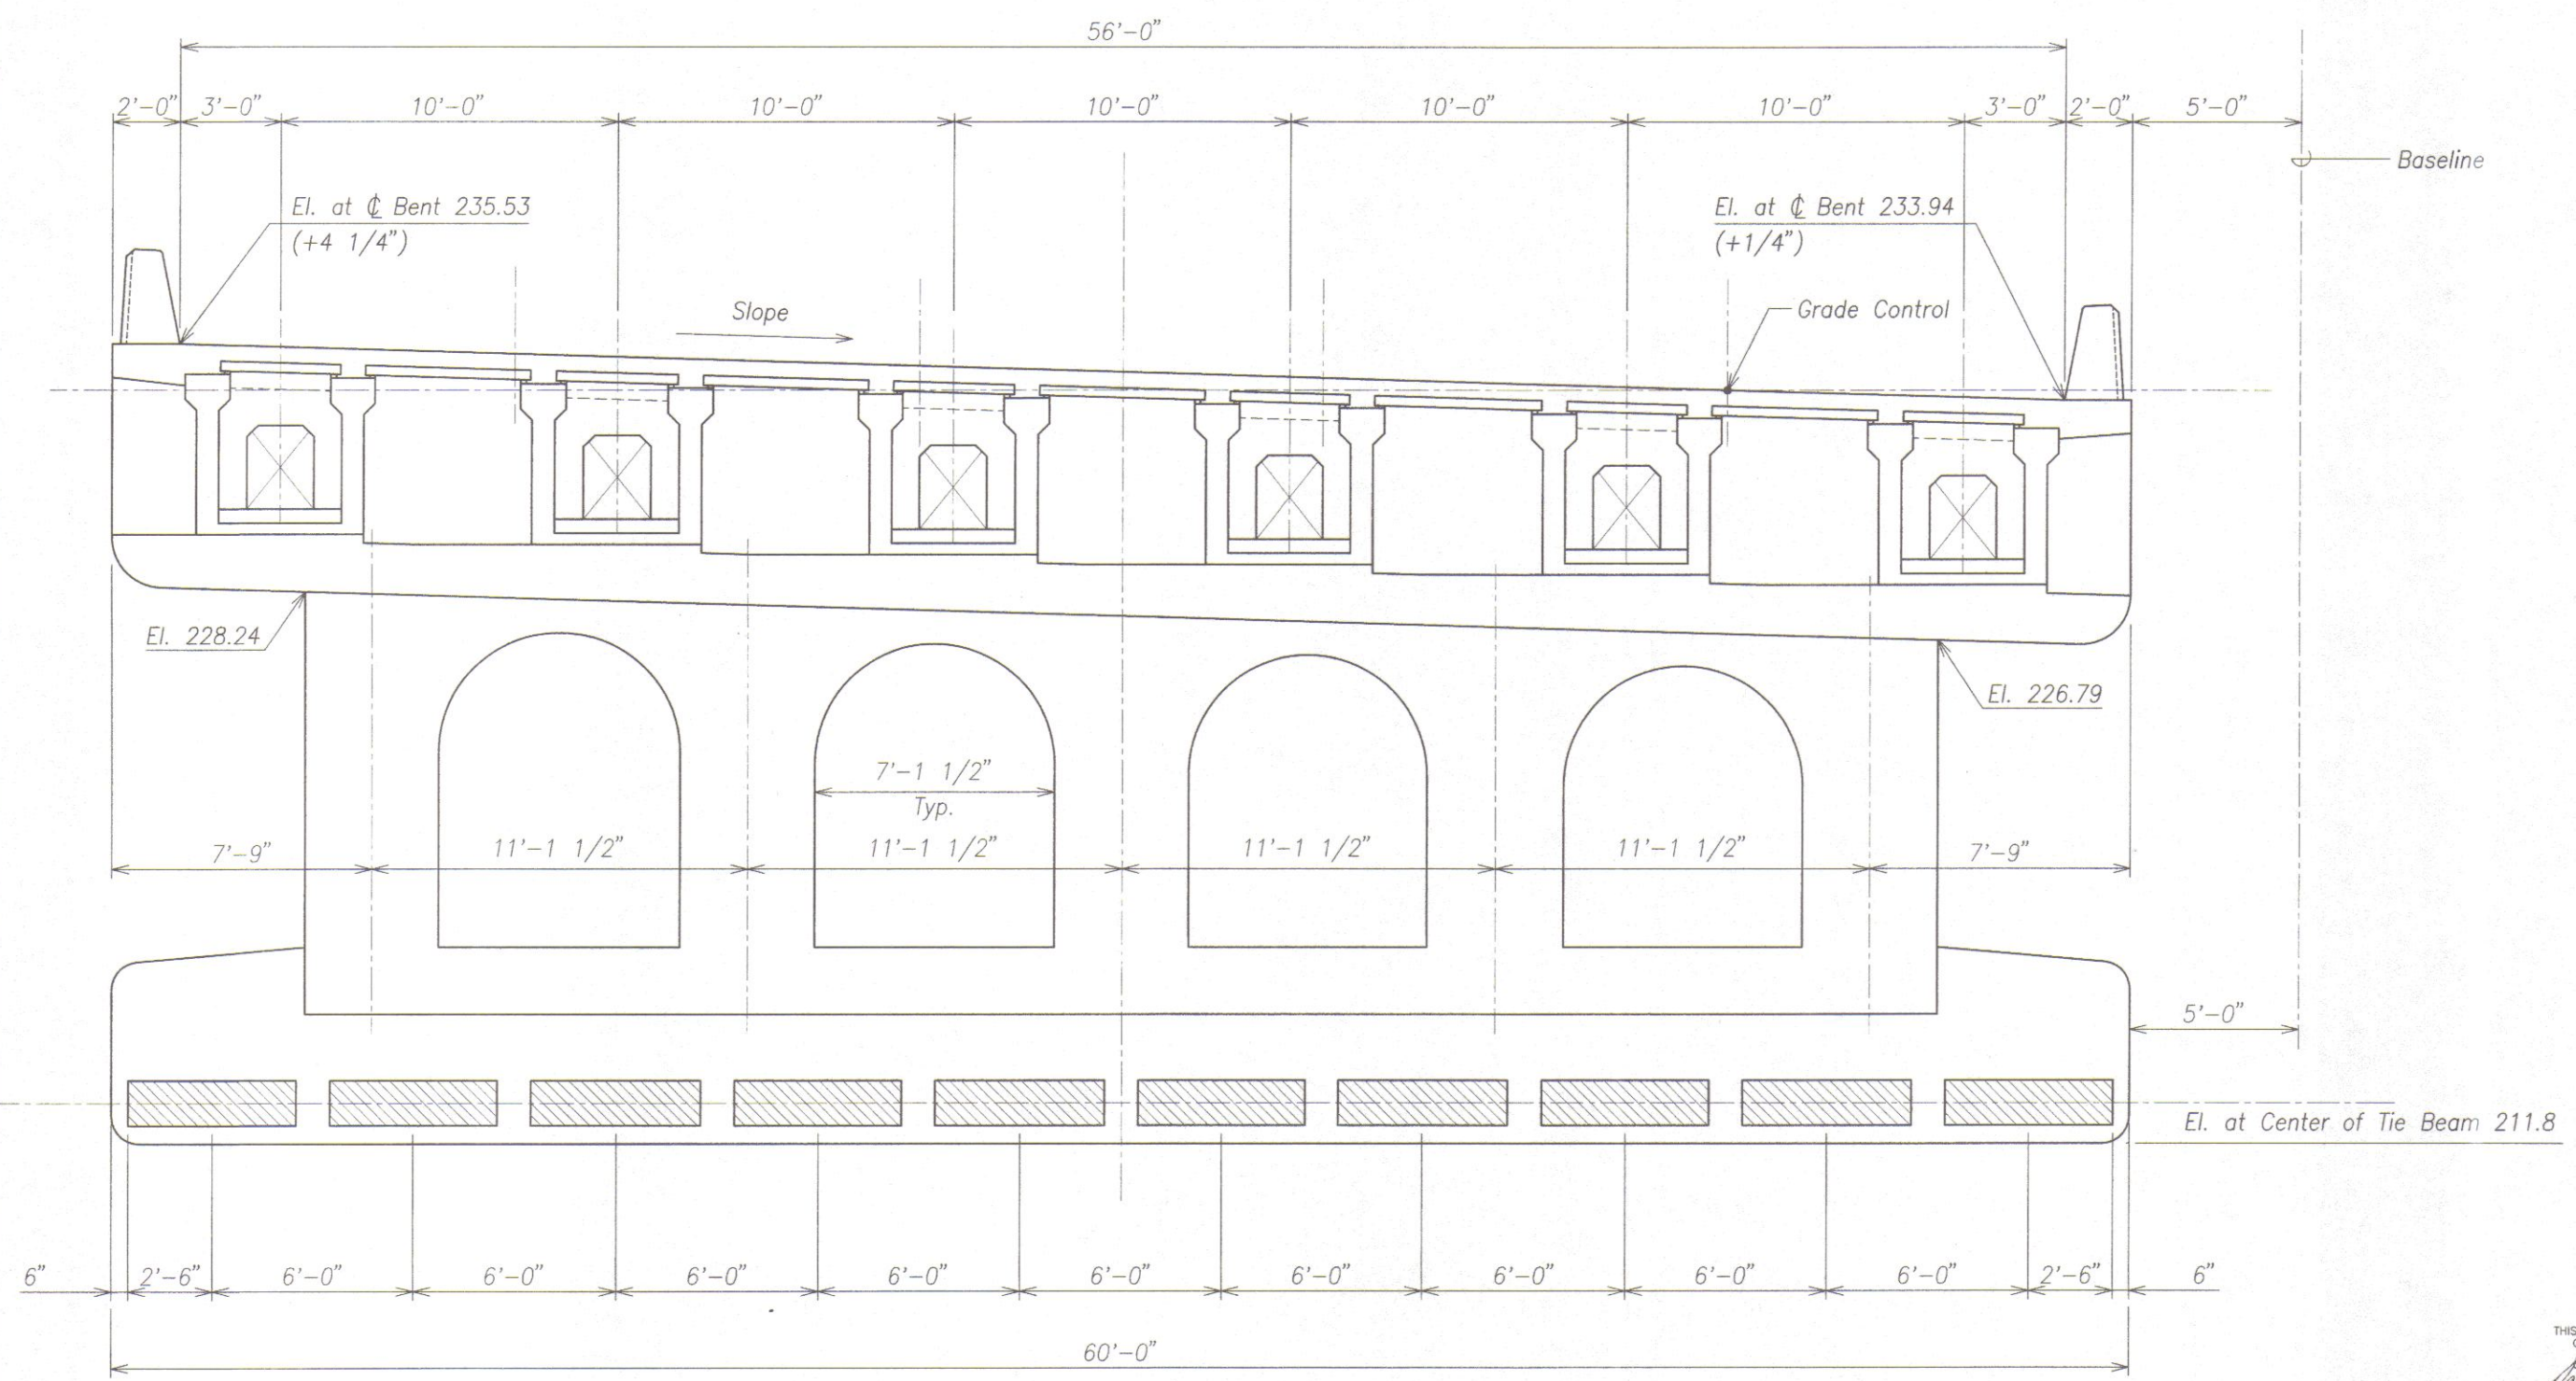

NOTE:
 Elevations and dimensions shown are design and theoretical values and do not include the effects of camber. Camber value are in ().
 For elevations and dimensions to be used for construction, refer to Form drawings.

MAUKA BRIDGE (OUT-BOUND)
BENT 2 ELEVATION
 Scale: 3/8" = 1'-0"



THIS WORK WAS PREPARED BY ME OR UNDER MY SUPERVISION.
 David K. Fujiwara
 KSF, INC. APRIL 30, 2012
 LIC. EXP. DATE


STATE OF HAWAII
 DEPARTMENT OF TRANSPORTATION
 HIGHWAYS DIVISION

BENT ELEVATION

HONOLULU HIGHWAY REALIGNMENT, PHASE 1A
 Future Keawe St Extension to Lahainaluna Rd, Part B
 Fed. Aid Proj. No. NH-030-1(35)R

Scale: As Noted Date: June, 2010

SHEET No. SB3.5 OF 10 SHEETS

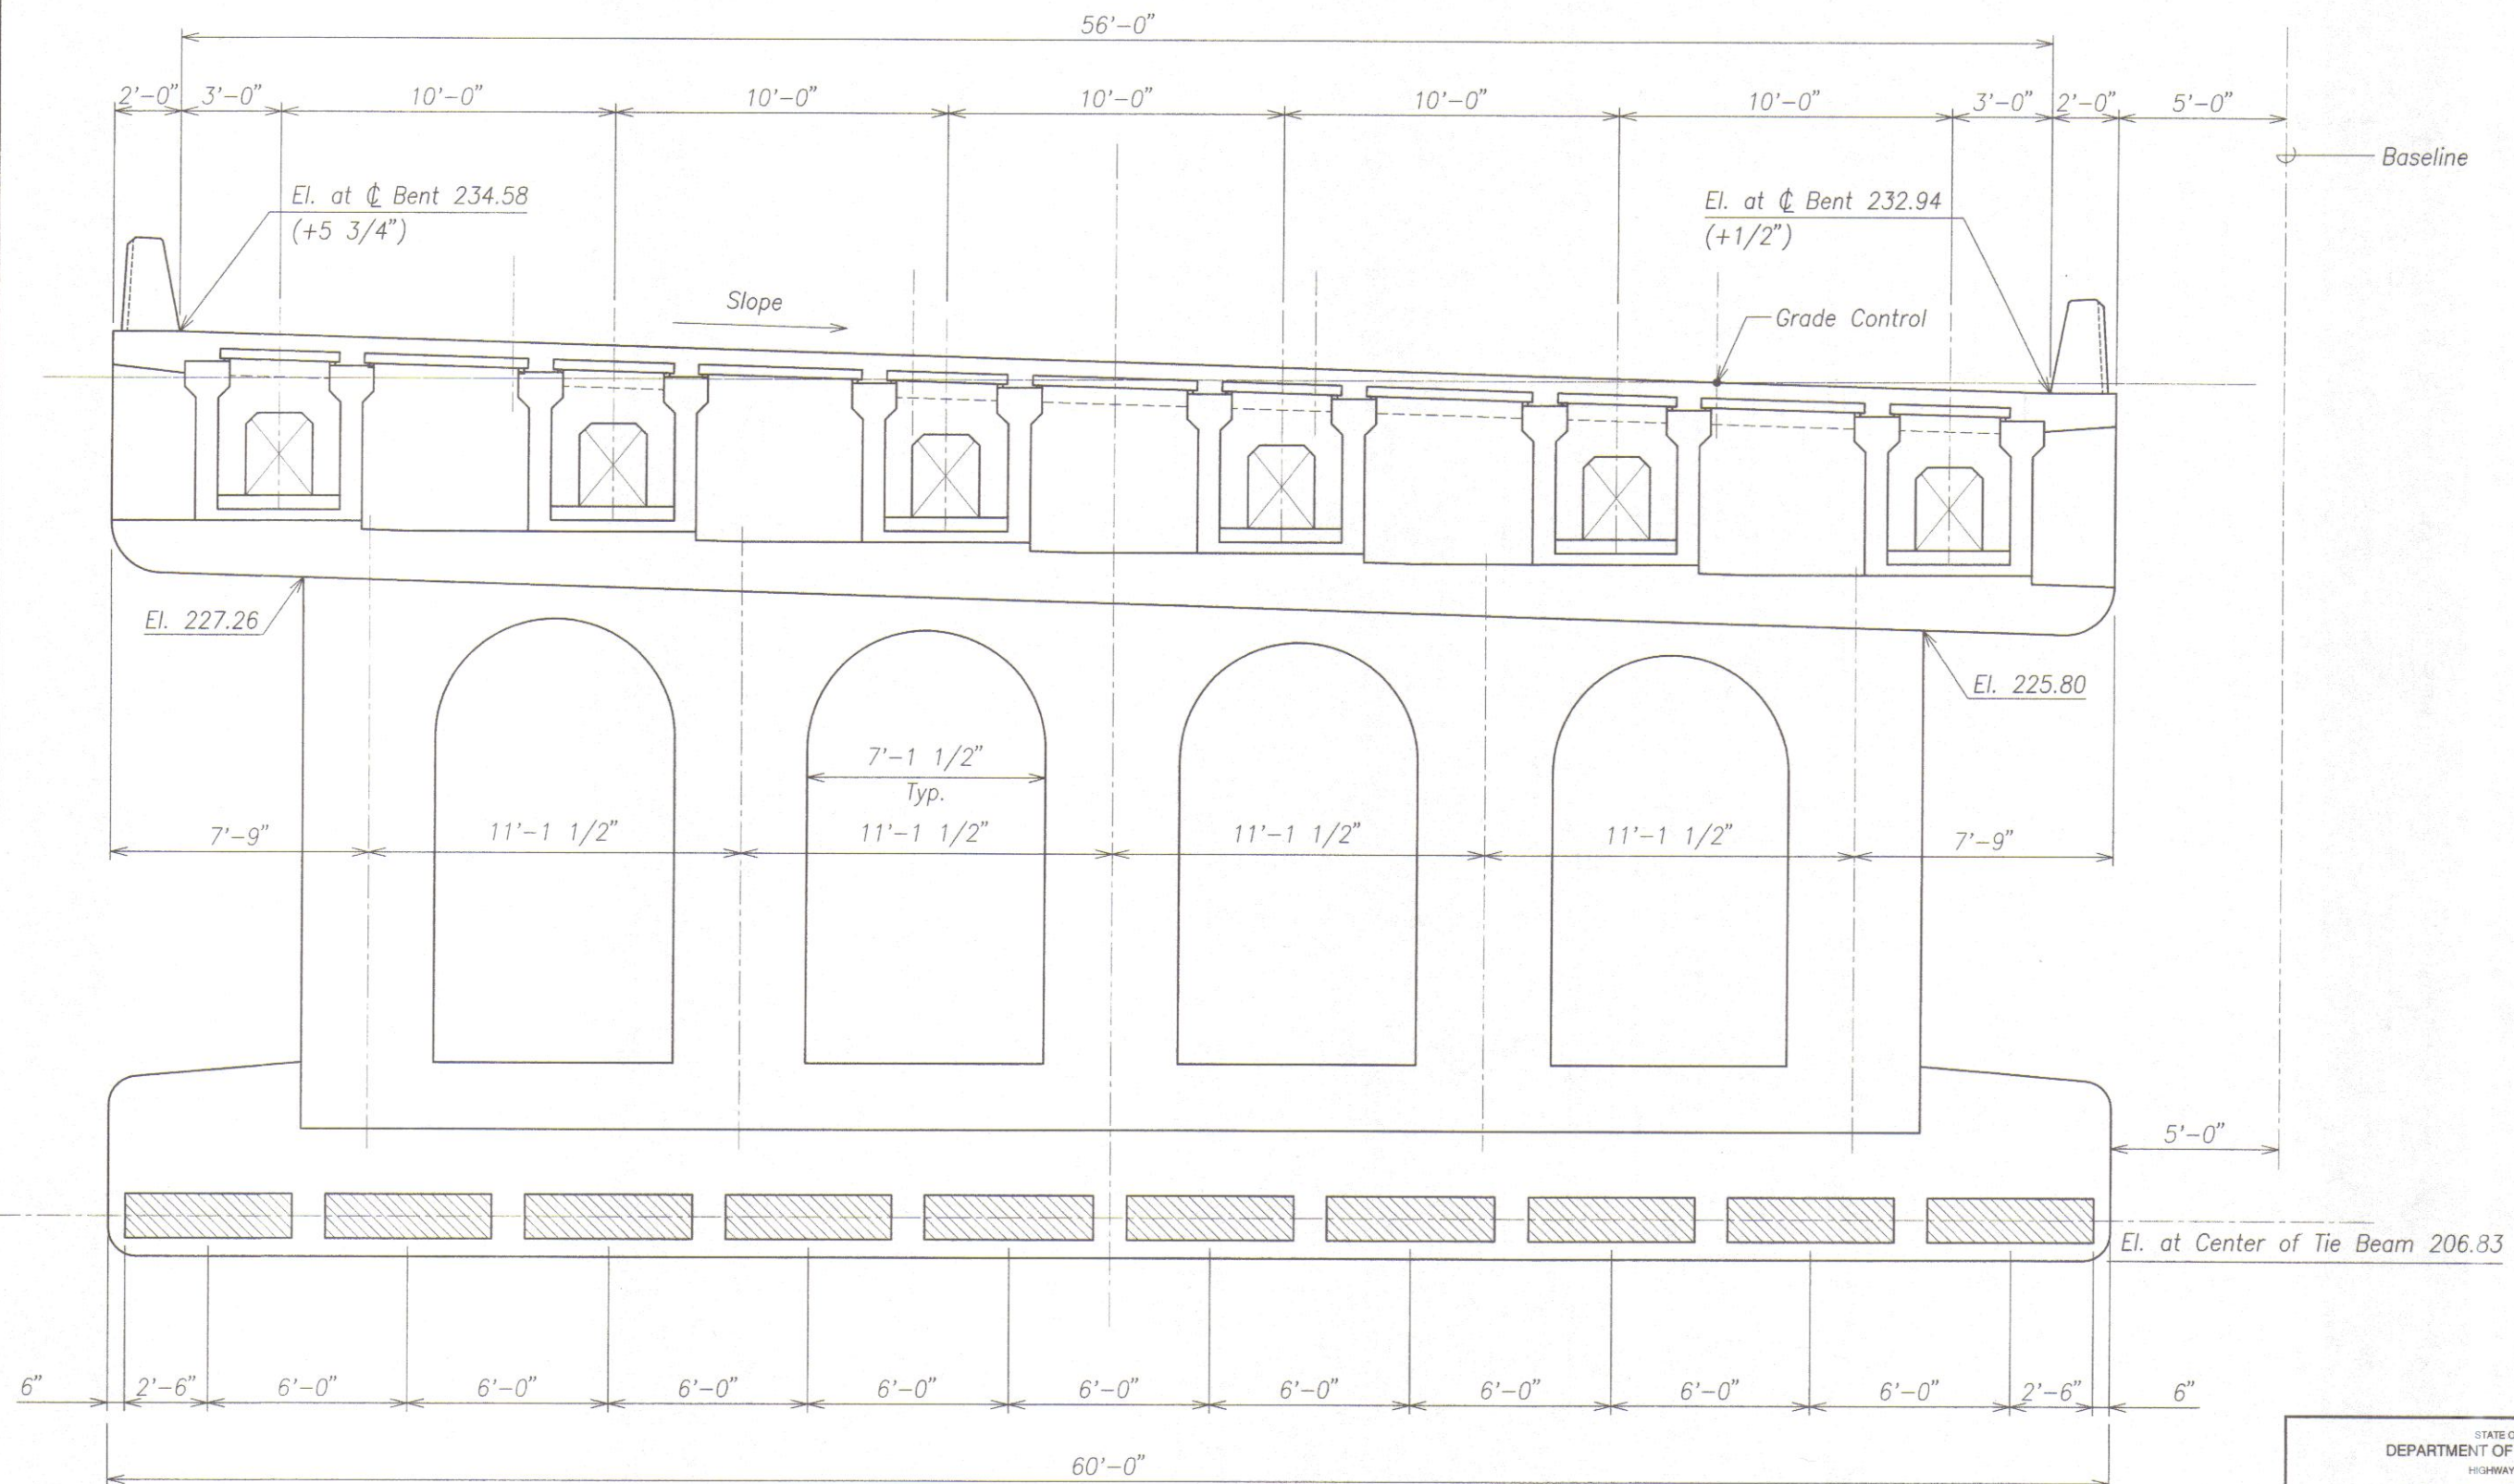

NOTE:

Elevations and dimensions shown are design and theoretical values and do not include the effects of camber. Camber value are in (). For elevations and dimensions to be used for construction, refer to Form drawings.

MAUKA BRIDGE (OUT-BOUND)

BENT 3 ELEVATION

Scale: $3/8" = 1'-0"$



THIS WORK WAS PREPARED BY ME
OR UNDER MY SUPERVISION.

Daniel K. Lyman APRIL 30, 2012
KSF, INC. LIC. EXP. DATE

STATE OF HAWAII
DEPARTMENT OF TRANSPORTATION
HIGHWAYS DIVISION

BENT ELEVATION

HONOAPIILANI HIGHWAY REALIGNMENT, PHASE 1A
Future Keawe St Extension to Lahainaluna Rd, Part B
Fed. Aid Proj. No. NH-030-1(35)R


Scale: As Noted Date: June, 2010

SHEET No. SB3.6 OF 10 SHEETS

FED. ROAD DIST. NO.	STATE	FED. AID PROJ. NO.	FISCAL YEAR	SHEET NO.	TOTAL SHEETS
HAWAII	HAW.	NH-030-1(35)R	2009	287	383


MAUKA

MAKAI

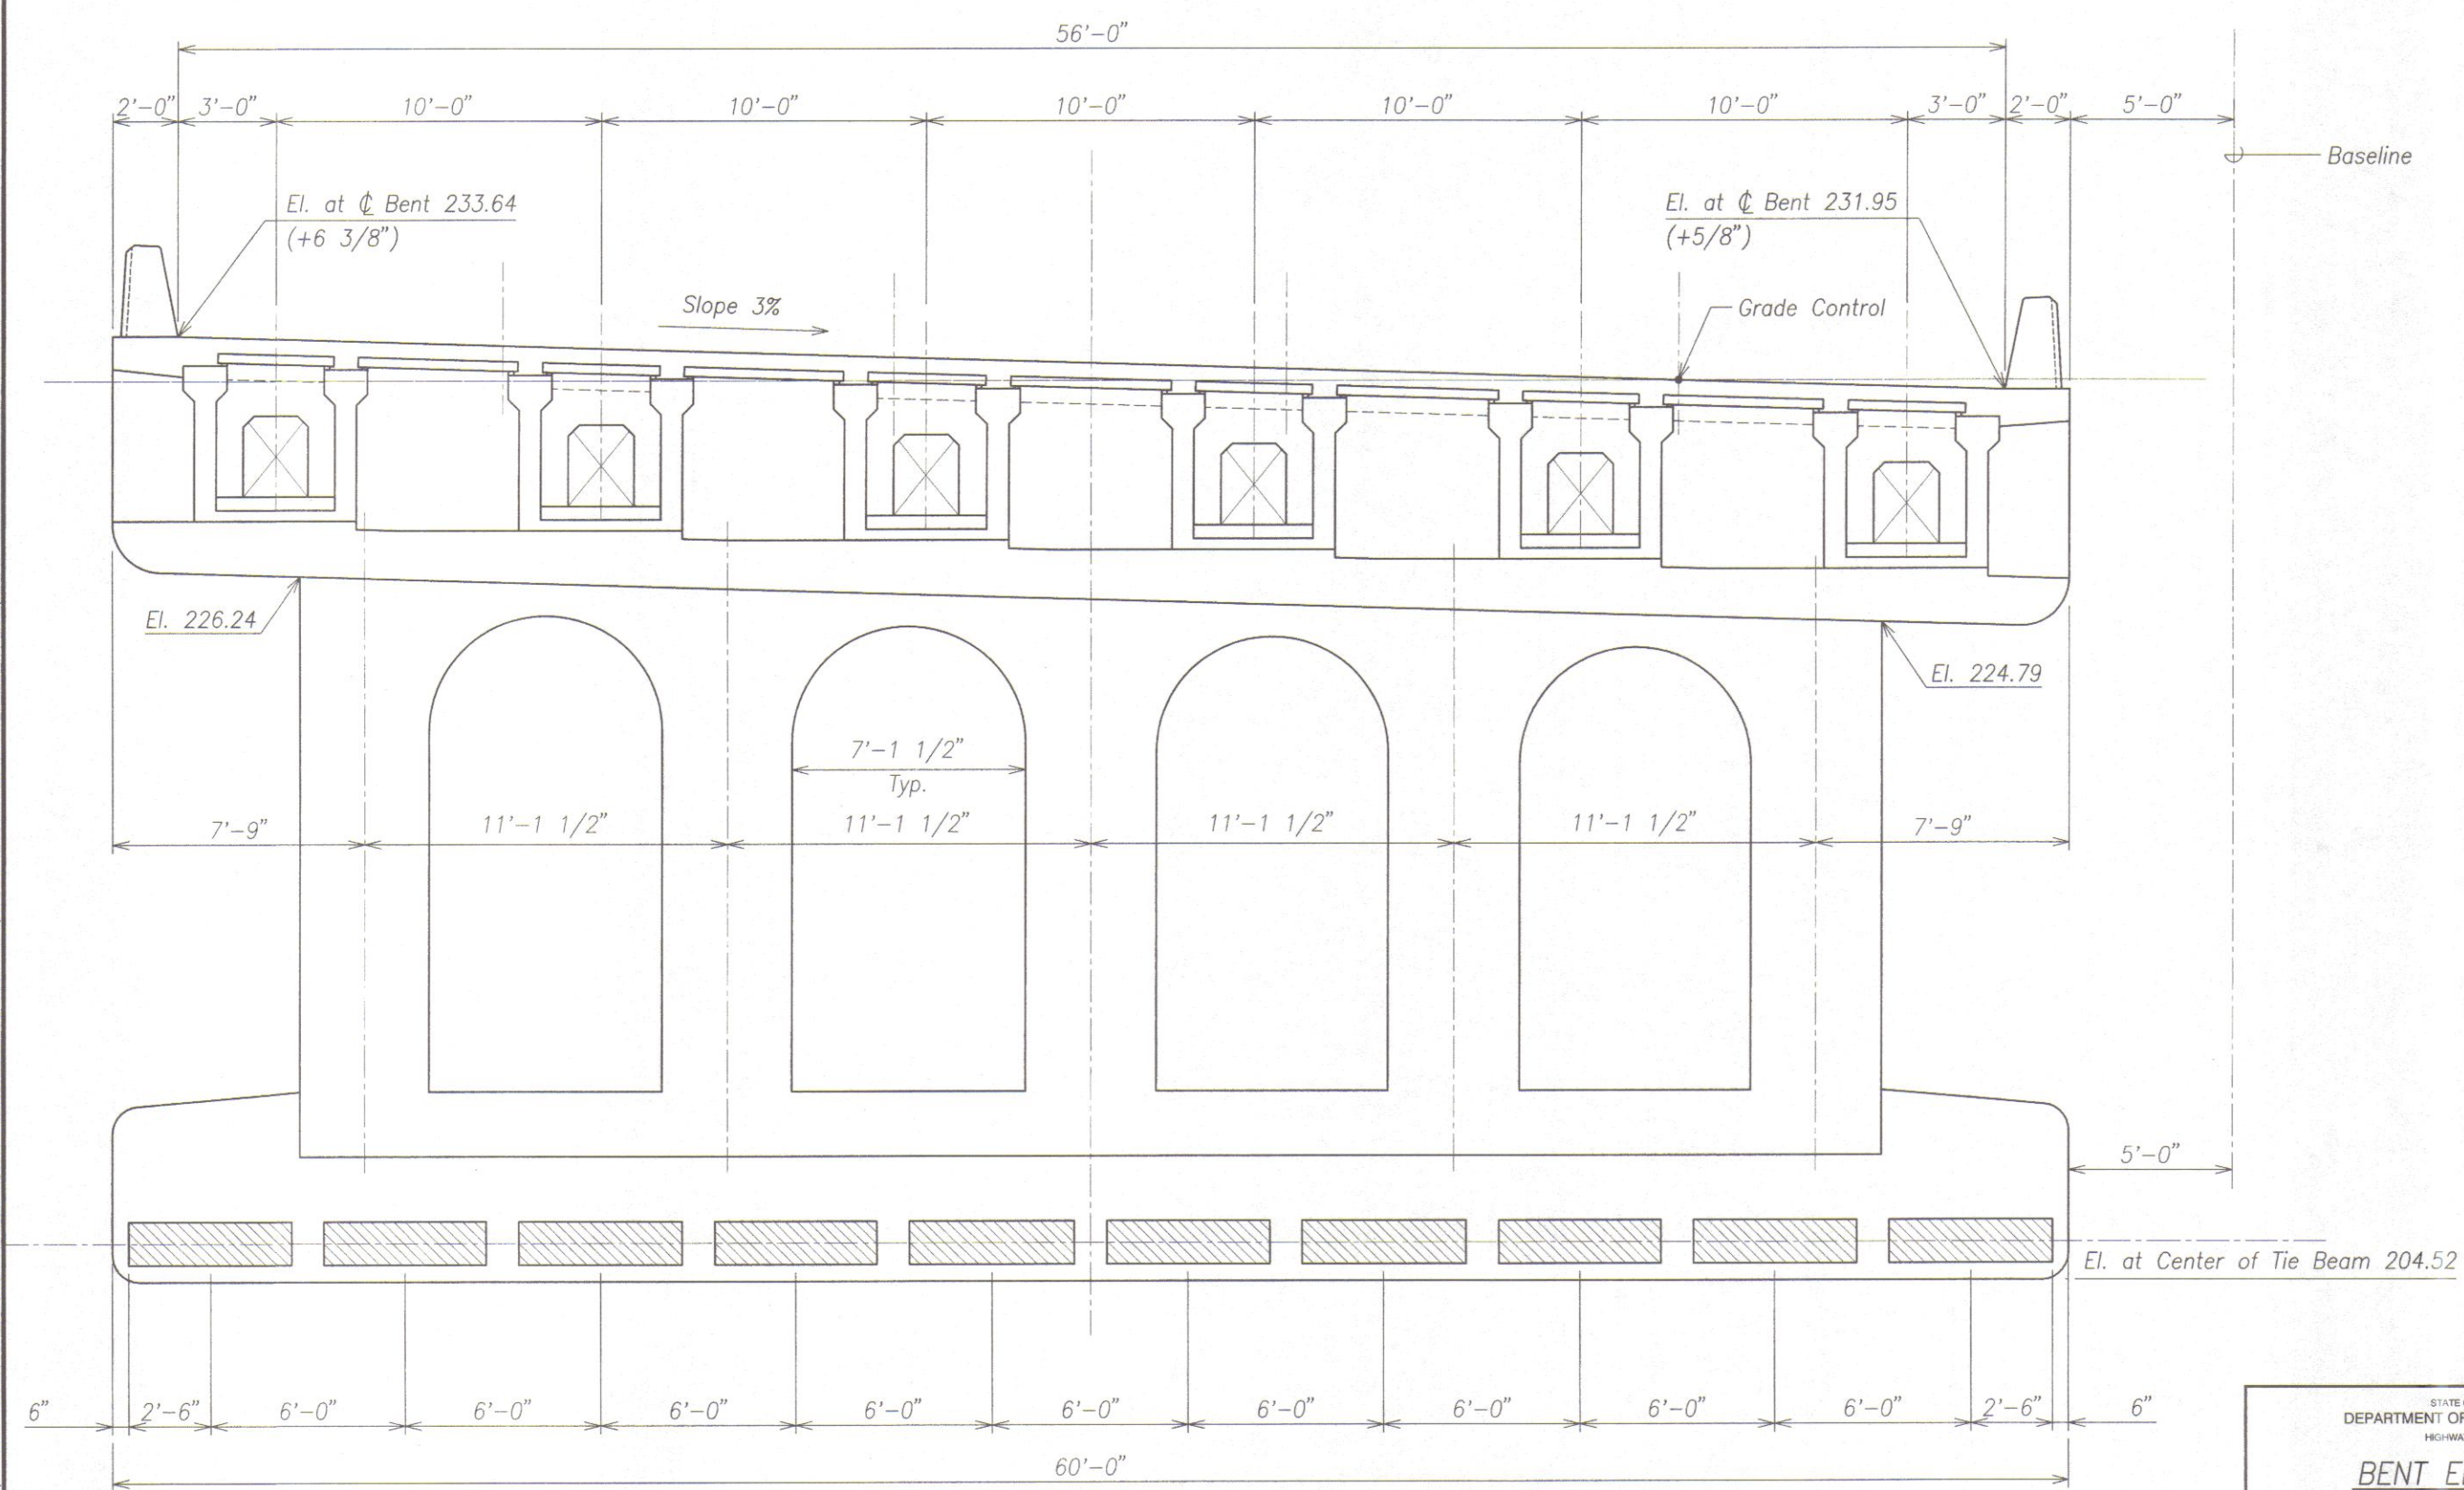

NOTE:
Elevations and dimensions shown are design and theoretical values and do not include the effects of camber. Camber value are in ().
For elevations and dimensions to be used for construction, refer to Form drawings.

MAUKA BRIDGE (OUT-BOUND)
BENT 4 ELEVATION
Scale: 3/8" = 1'-0"
A
SB3.7/SB3.7

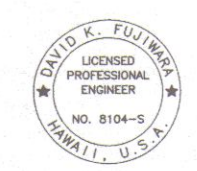


THIS WORK WAS PREPARED BY ME OR UNDER MY SUPERVISION.
David K. Fujiwara
KSF, INC. APRIL 30, 2012
LIC. EXP. DATE

STATE OF HAWAII
DEPARTMENT OF TRANSPORTATION
HIGHWAYS DIVISION
BENT ELEVATION
HONOAPIILANI HIGHWAY REALIGNMENT, PHASE 1A
Future Keawe St Extension to Lahainaluna Rd, Part B
Fed. Aid Proj. No. NH-030-1(35)R
Scale: As Noted Date: June, 2010
SHEET No. SB3.7 OF 10 SHEETS

ORIGINAL PLAN	DATE
NOTED BY	
DESIGNED BY	
CHECKED BY	
QUANTITIES BY	
NO.	

DRAWING NAME: 2100 ONGOING 40019.0-HONOAPIILANI LAHAINA BYPASS-KAHOMA WOI 08-15-10 COMBINE LAHAINA FINAL DESIGN HH-SB304.DWG PLOT TIME: 06-14-10, 3:07 PM

FED. ROAD DIST. NO.	STATE	FED. AID PROJ. NO.	FISCAL YEAR	SHEET NO.	TOTAL SHEETS
HAWAII	HAW.	NH-030-1(35)R	2009	288	383

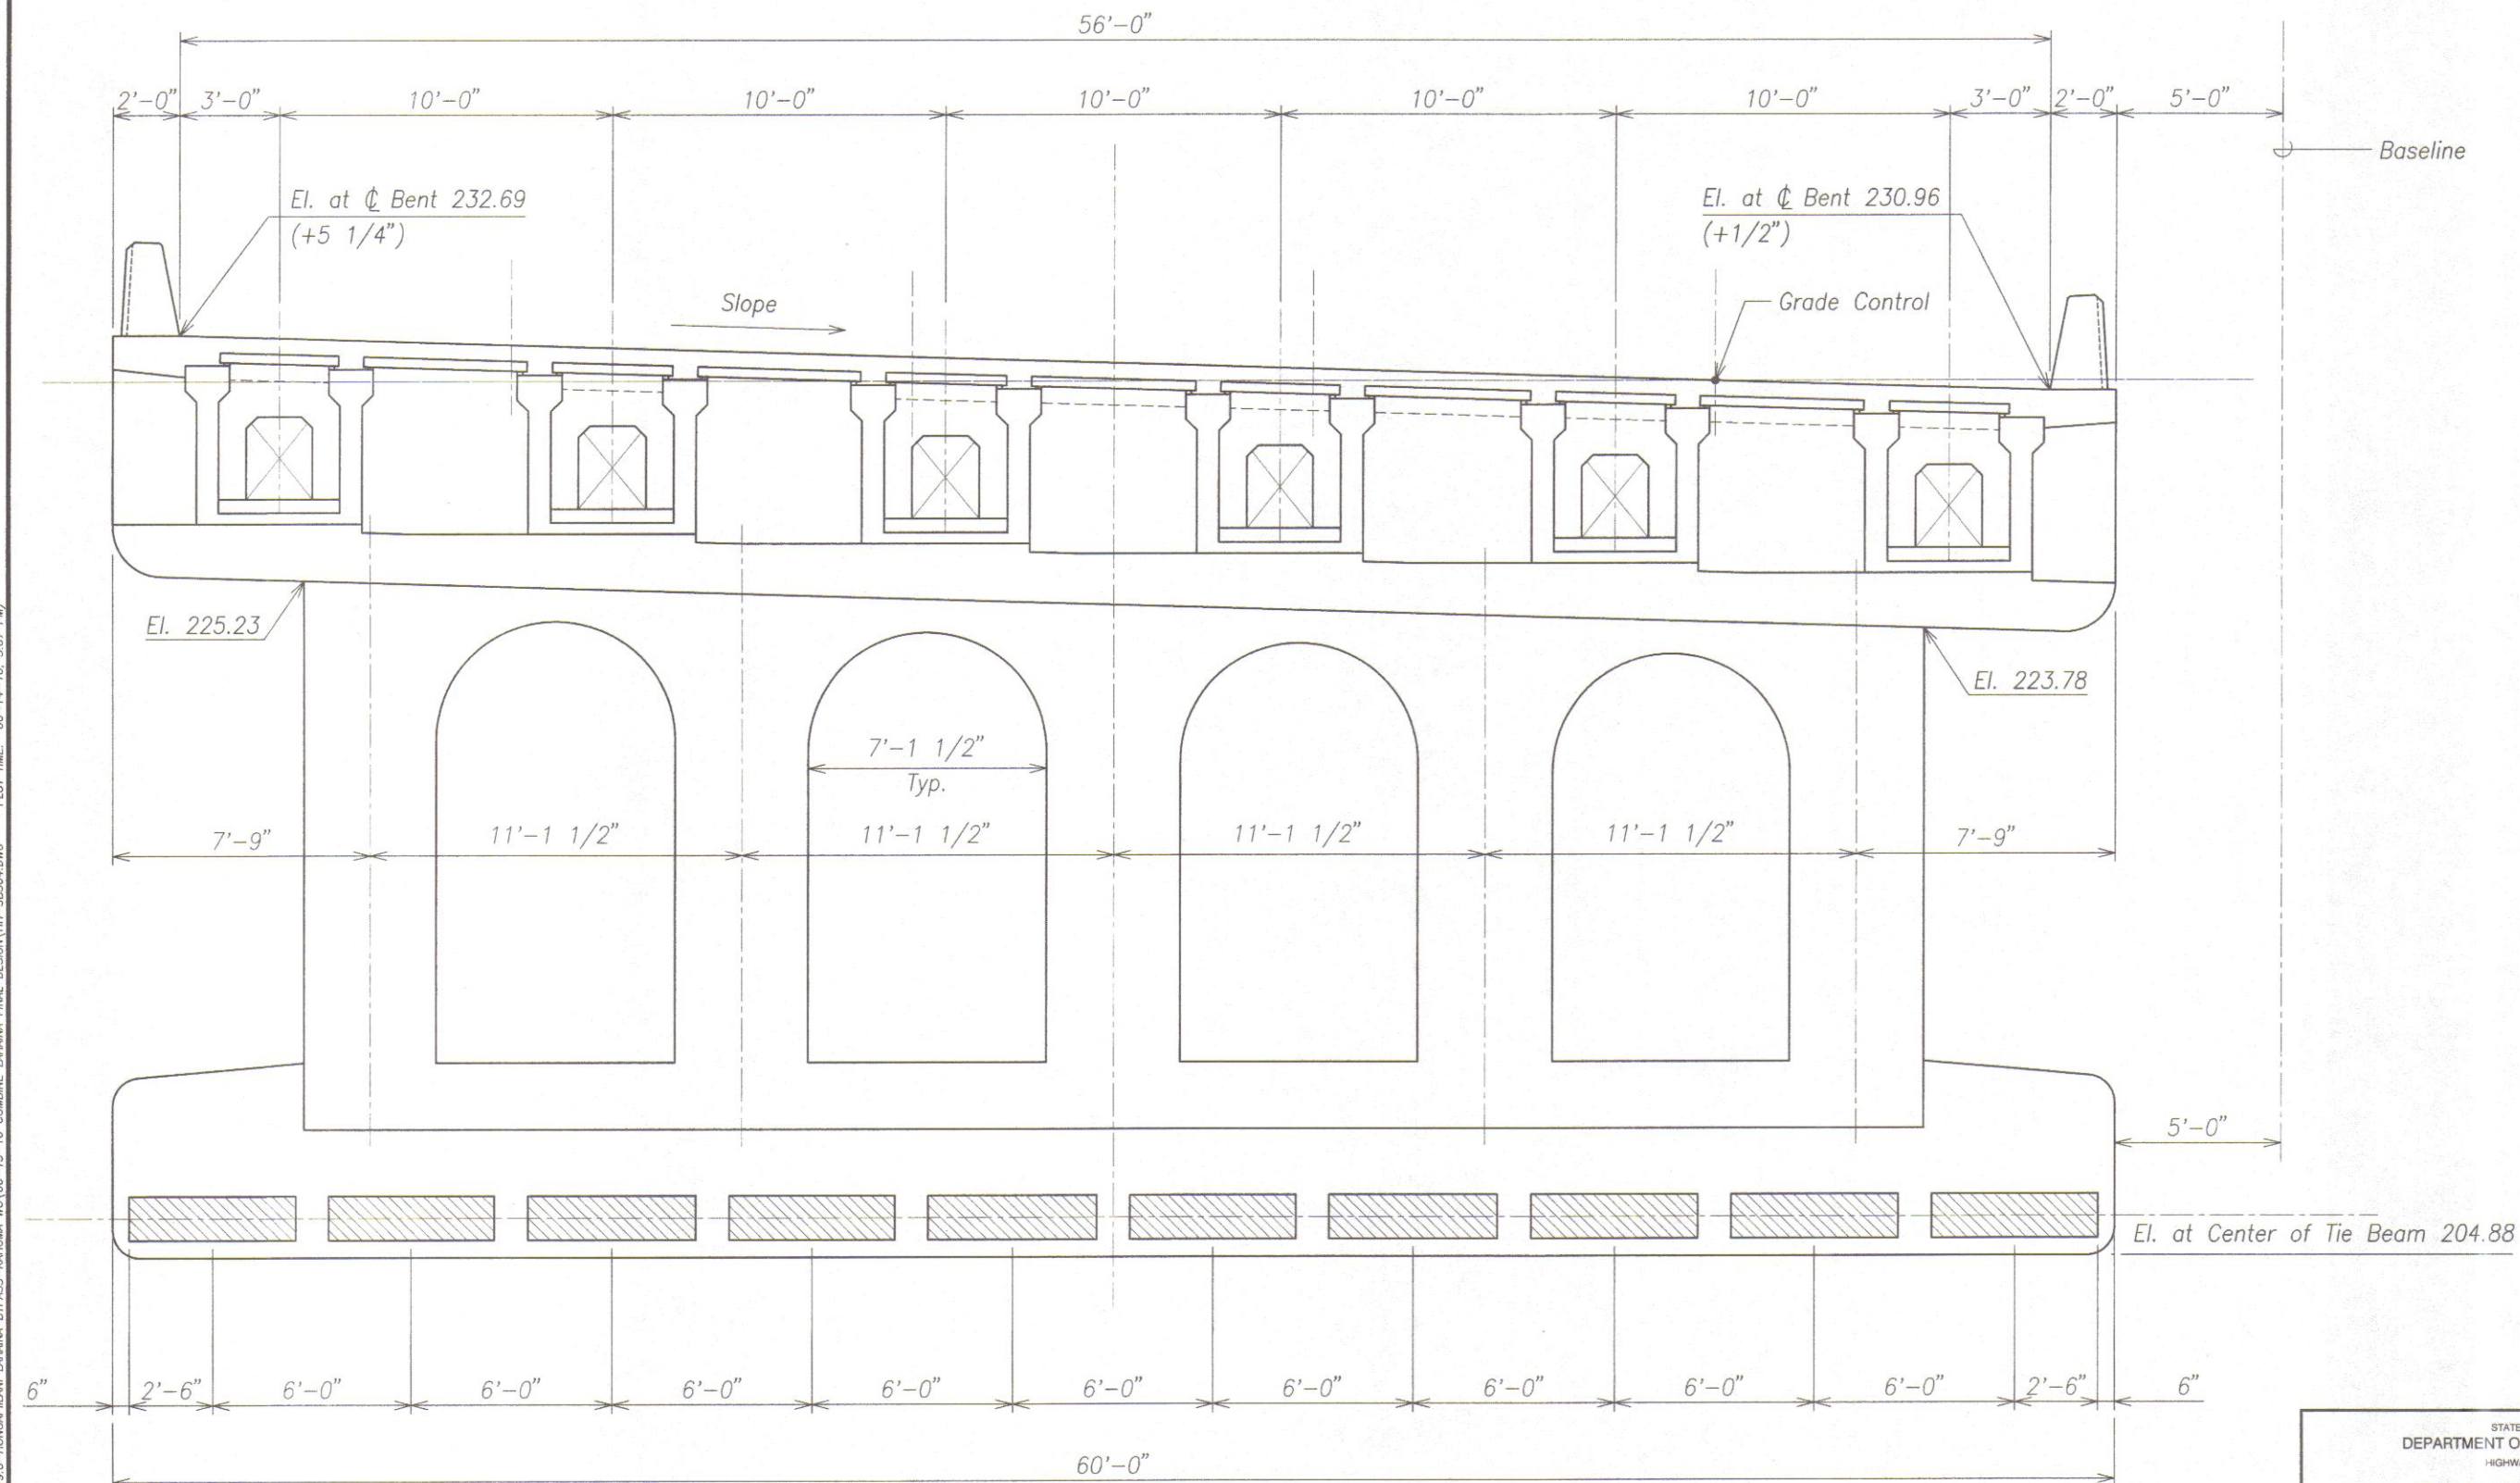

NOTE:

Elevations and dimensions shown are design and theoretical values and do not include the effects of camber. Camber value are in (). For elevations and dimensions to be used for construction, refer to Form drawings.

MAUKA BRIDGE (OUT-BOUND)

BENT 5 ELEVATION

Scale: $3/8" = 1'-0"$

A
SB3.8 SB3.8



THIS WORK WAS PREPARED BY ME
OR UNDER MY SUPERVISION.
David K. Fujiwara
KSF, INC. APRIL 30, 2012
LIC. EXP. DATE

STATE OF HAWAII
DEPARTMENT OF TRANSPORTATION
HIGHWAYS DIVISION

BENT ELEVATION

HONOAPIILANI HIGHWAY REALIGNMENT, PHASE 1A
Future Keawe St Extension to Lahainaluna Rd, Part B
Fed. Aid Proj. No. NH-030-1(35)R

Scale: As Noted Date: June, 2010


SHEET No. SB3.8 OF 10 SHEETS

FINAL DESIGN 288

MAUKA

MAKAI

FED. ROAD DIST. NO.	STATE	FED. AID PROJ. NO.	FISCAL YEAR	SHEET NO.	TOTAL SHEETS
HAWAII	HAW.	NH-030-1(35)R	2009	289	383

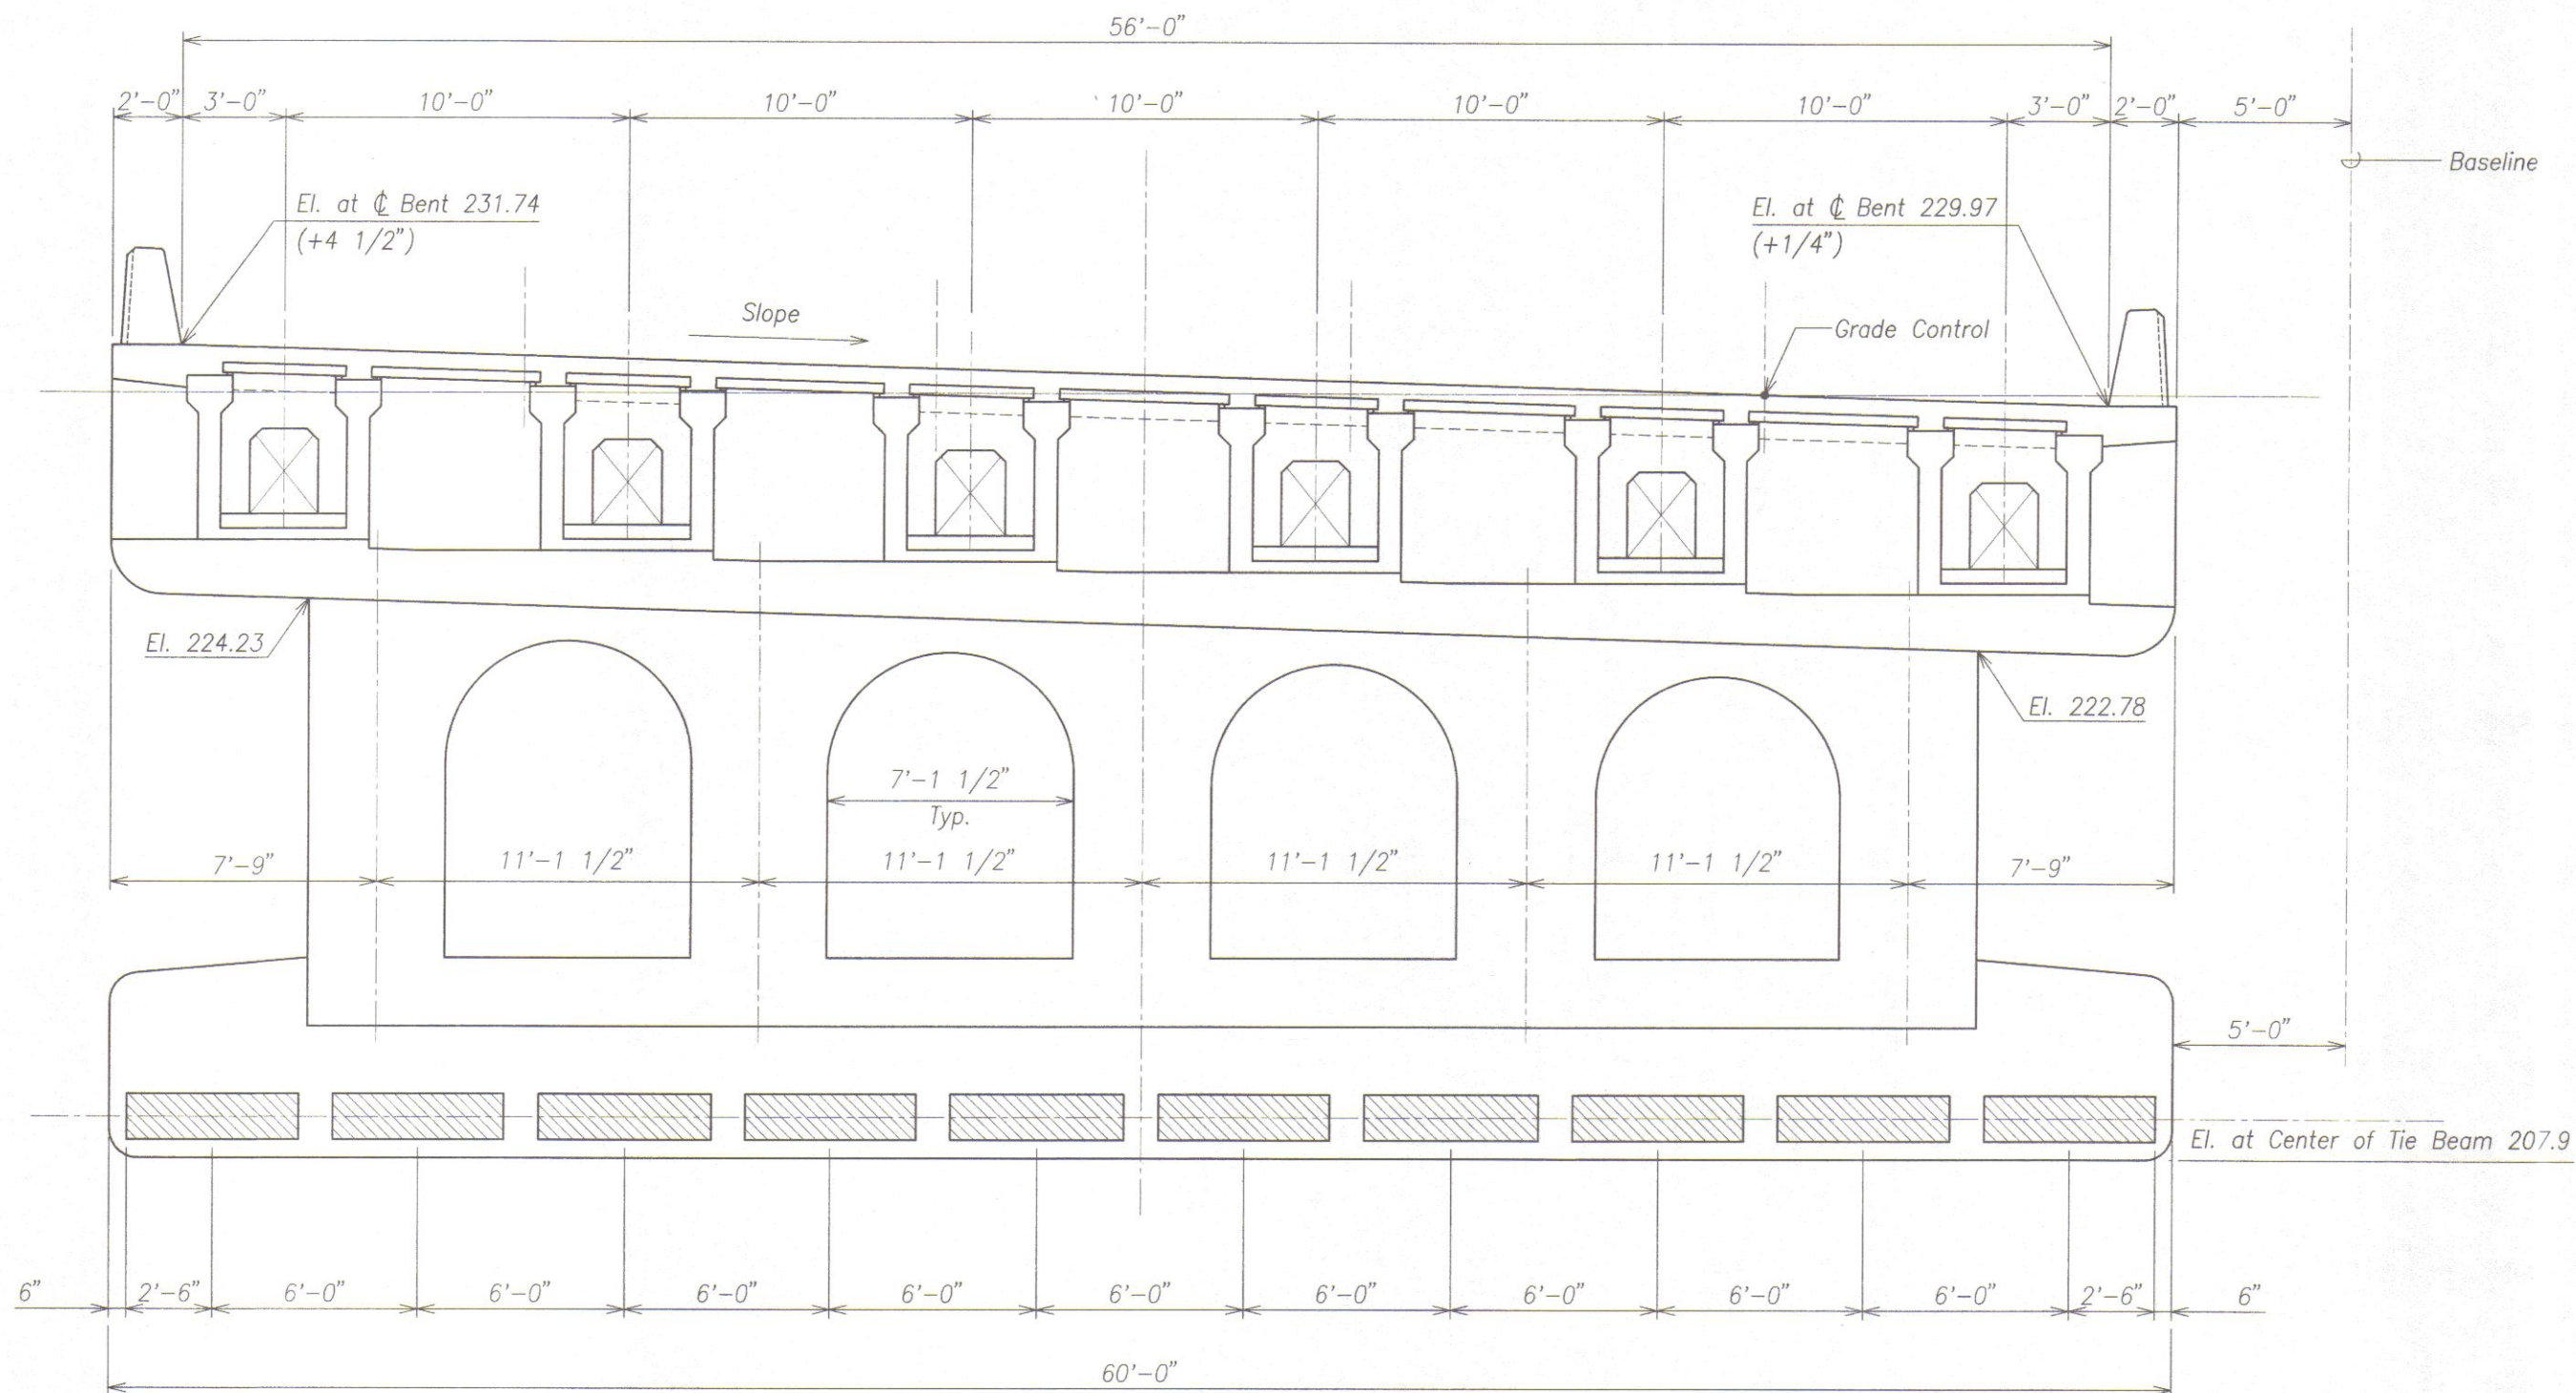

MAUKA BRIDGE (OUT-BOUND)

BENT 6 ELEVATION

Scale: $3/8" = 1'-0"$ A
SB3.9/SB3.9

NOTE:

Elevations and dimensions shown are design and theoretical values and do not include the effects of camber. Camber value are in ().
For elevations and dimensions to be used for construction, refer to Form drawings.



THIS WORK WAS PREPARED BY ME
OR UNDER MY SUPERVISION.

David K. Fujiwara
KSF, INC. APRIL 30, 2012
LIC. EXP. DATE

STATE OF HAWAII
DEPARTMENT OF TRANSPORTATION
HIGHWAYS DIVISION

BENT ELEVATION

HONOAPIILANI HIGHWAY REALIGNMENT, PHASE 1A
Future Keawe St Extension to Lahainaluna Rd, Part B
Fed. Aid Proj. No. NH-030-1(35)R

Scale: As Noted

Date: June, 2010

SHEET No. SB3.9 OF 10 SHEETS

FINAL DESIGN 289


SURVEY PLOTTED BY	DATE
DRAWN BY	
DESIGNED BY	
CHECKED BY	
ORIGINAL PLAN	
NOTE BOOK	
QUANTITIES BY	
CHECKED BY	
No.	

DRAWING NAME: 2100 ONCONC/40019.0-HONOAPIILANI LAHAINA BYPASS-KAHOMA WD 06-15-10 COMBINE LAHAINA FINAL DESIGN (H-SB304.DWG) PLOT TIME: 06-14-10, 3:07 PM

MAUKA

MAKAI

FED. ROAD DIST. NO.	STATE	FED. AID PROJ. NO.	FISCAL YEAR	SHEET NO.	TOTAL SHEETS
HAWAII	HAW.	NH-030-1(35)R	2009	290	383

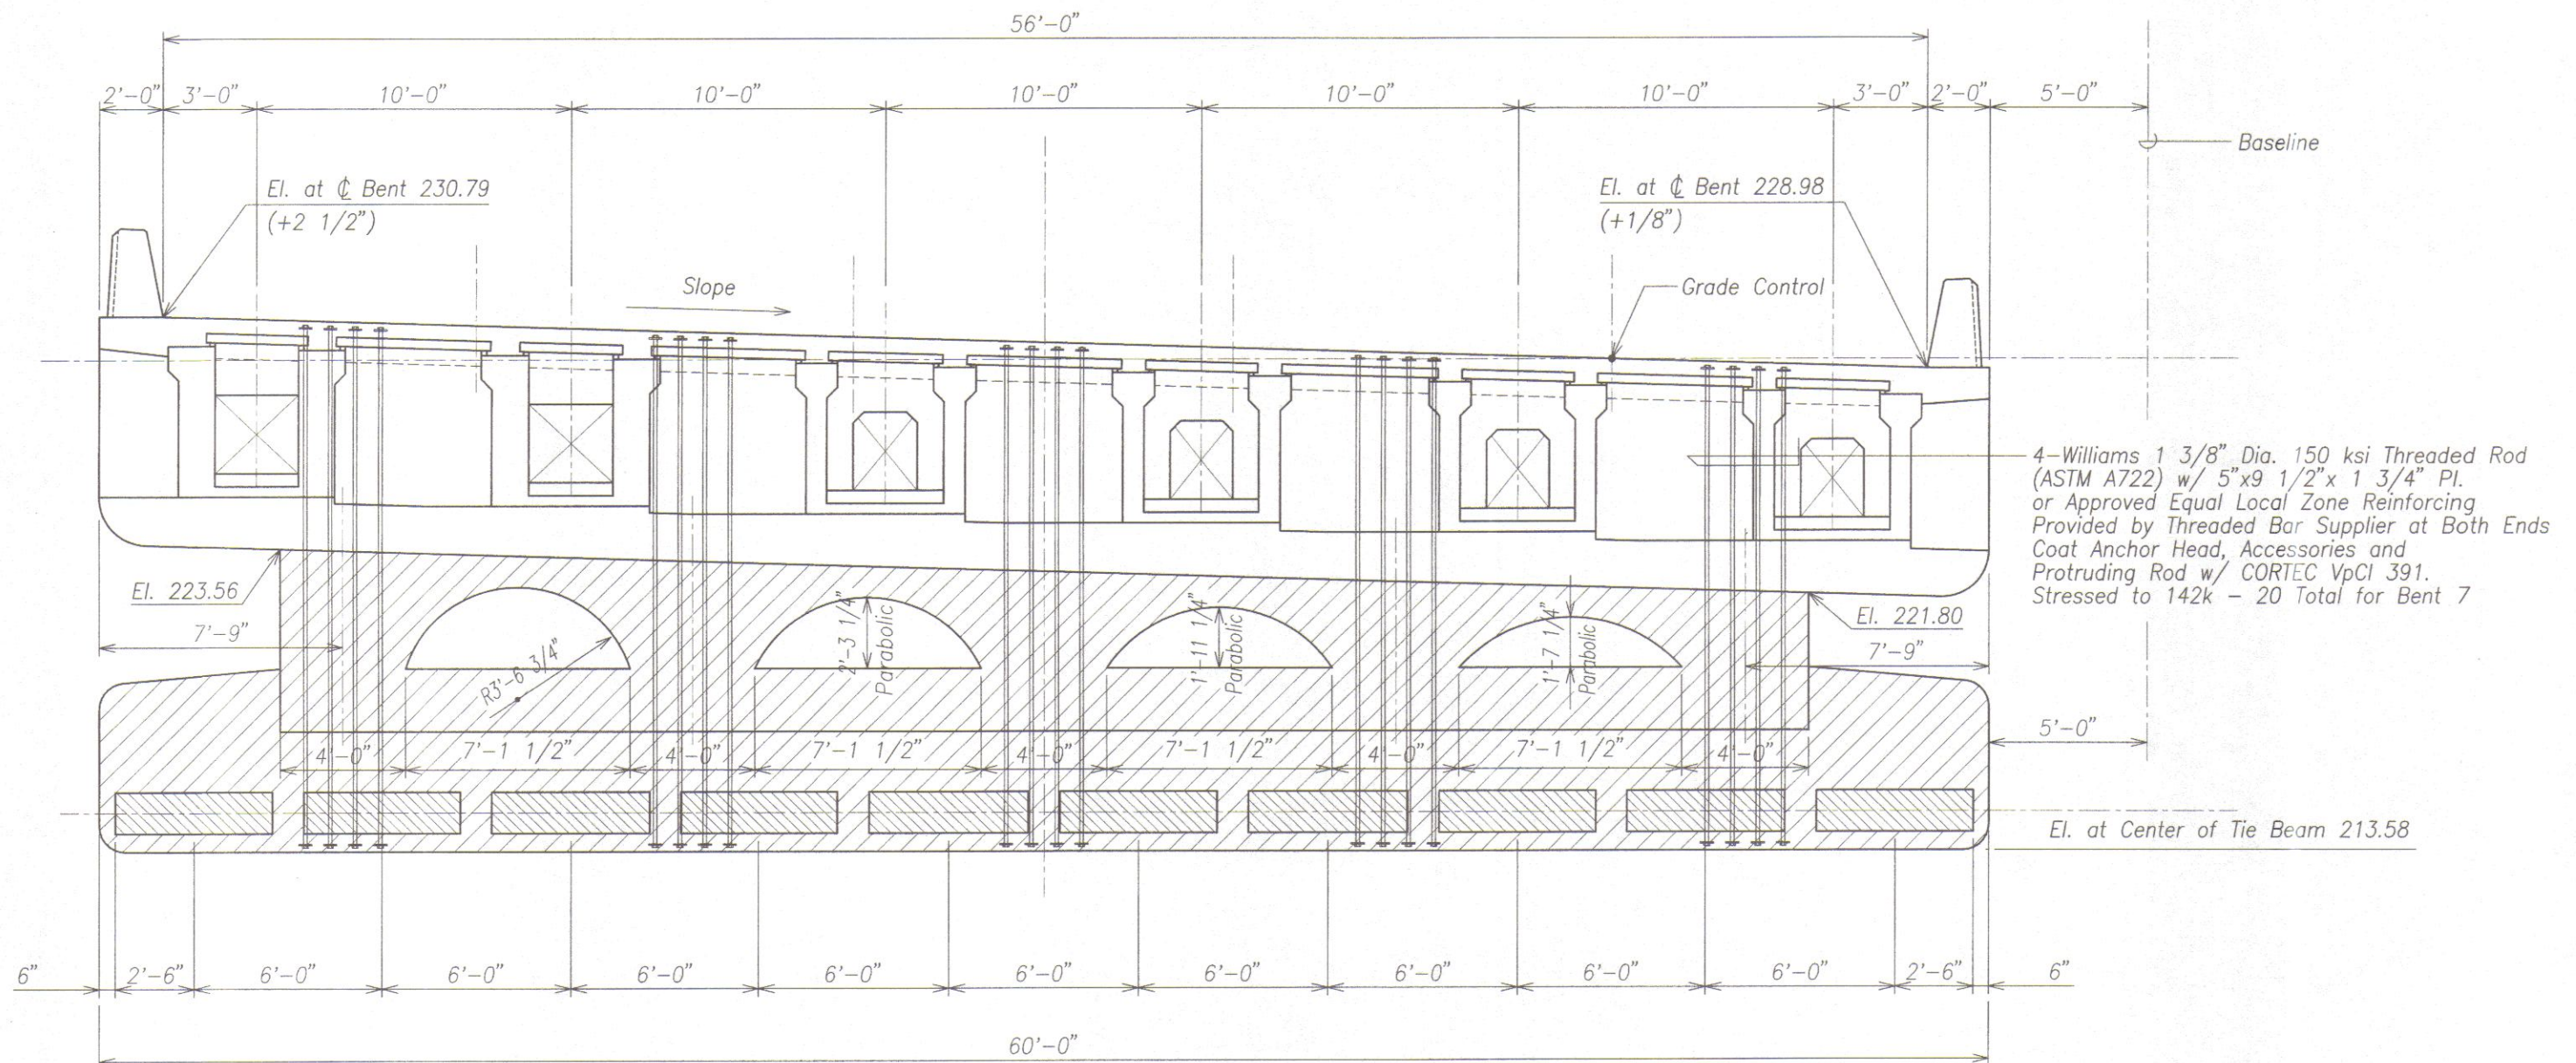**NOTE:**

Elevations and dimensions shown are design and theoretical values and do not include the effects of camber. Camber value are in (). For elevations and dimensions to be used for construction, refer to Form drawings.

LEGEND:

Indicates "Special" Concrete - High Concentration of Fibers

MAUKA BRIDGE (OUT-BOUND)**BENT 7 ELEVATION**

Scale: 3/8" = 1'-0"

A
SB3.10/SB3.10



THIS WORK WAS PREPARED BY ME OR UNDER MY SUPERVISION.

David K. Fujiwara
KSF, INC. APRIL 30, 2012
LIC. EXP. DATE

STATE OF HAWAII
DEPARTMENT OF TRANSPORTATION
HIGHWAYS DIVISION

BENT ELEVATION

HONOAPIILANI HIGHWAY REALIGNMENT, PHASE 1A
Future Keawe St Extension to Lahainaluna Rd, Part B
Fed. Aid Proj. No. NH-030-1(35)R

Scale: As Noted Date: June, 2010

SHEET No. SB3.10 OF 10 SHEETS


FINAL DESIGN 290

ORIGINAL PLAN	DATE
NOTE BOOK	
DESIGNED BY	
CHECKED BY	
QUANTITIES BY	
NO.	

DRAWING NAME: Z:\00 ONGOING\40019.0-HONOAPIILANI LAHAINA BYPASS-KAHOMA W\06-15-10 COMBINE LAHAINA FINAL DESIGN\HH-SB304.DWG PLOT TIME: 06-14-10, 3:08 PM


FED. ROAD DIST. NO.	STATE	FED. AID PROJ. NO.	FISCAL YEAR	SHEET NO.	TOTAL SHEETS
HAWAII	HAW.	NH-030-1(35)R	2009	291	383

Top Surface Shall be Clean,
Free of Laitance and Intentionally
Roughened to a Full Amplitude
of Approximately 1/4"

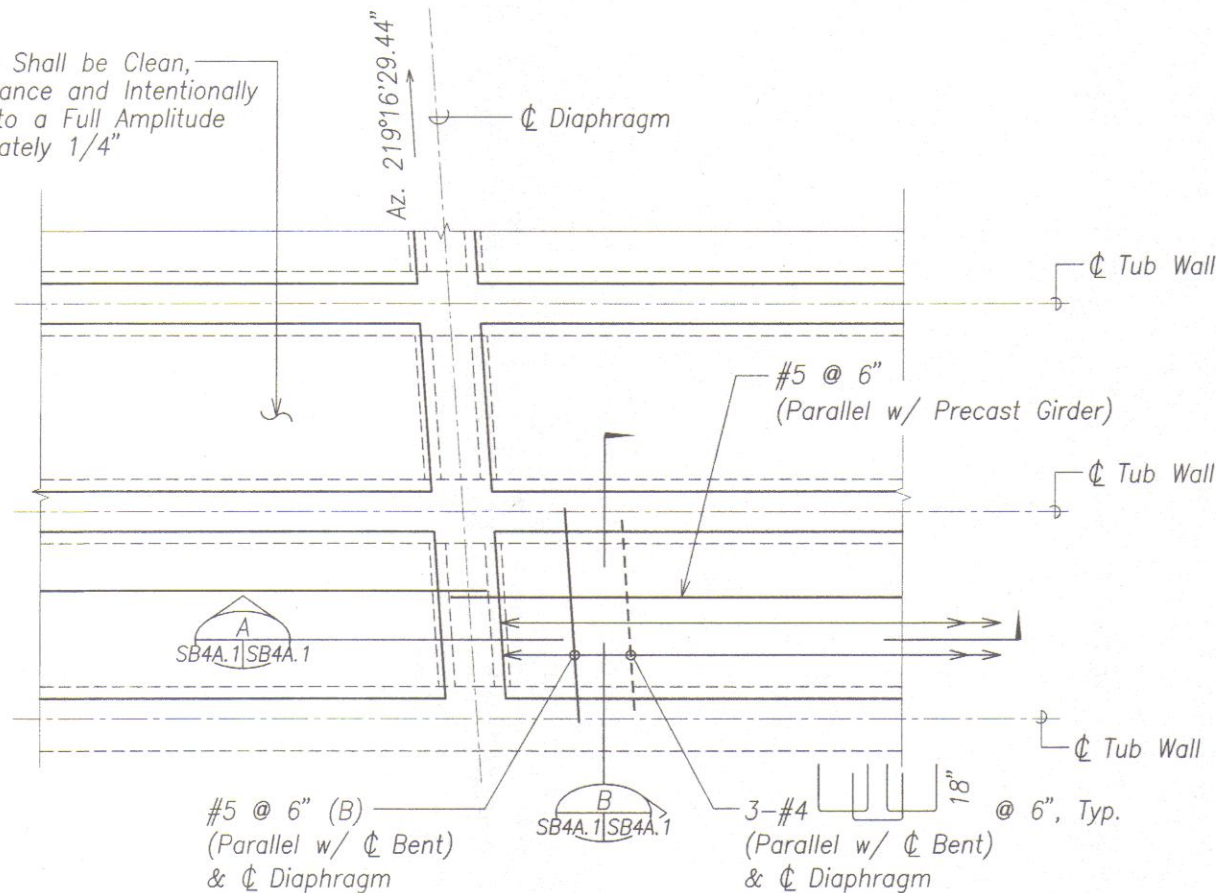


PRECAST DECK PLANK PLAN

Scale: 1/2" = 1'-0"

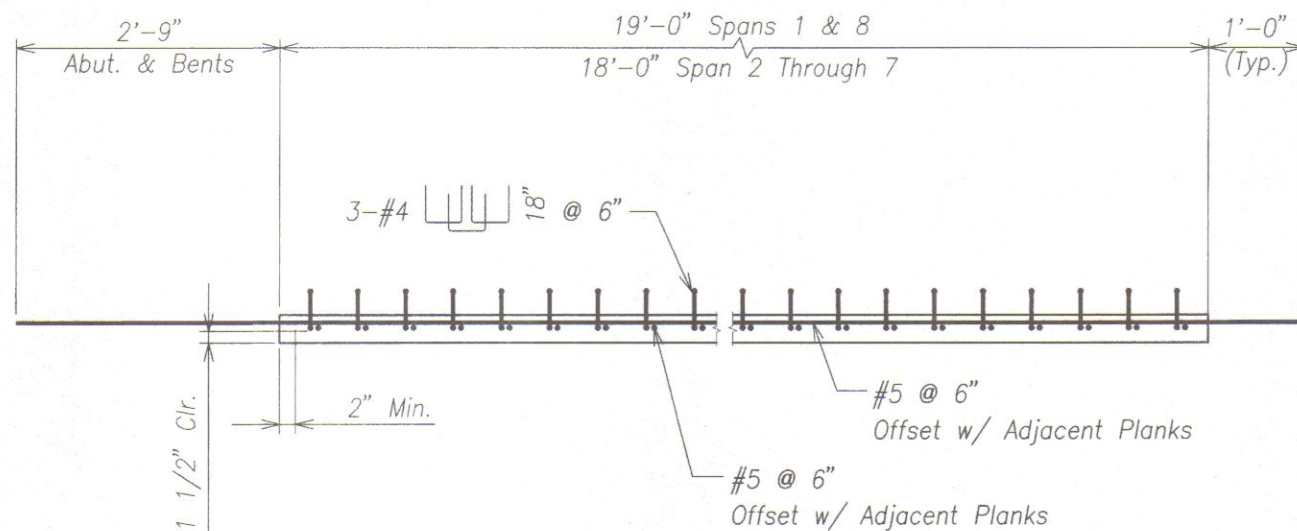

SECTION A
Scale: 1" = 1'-0" SB4A.1/SB4A.1

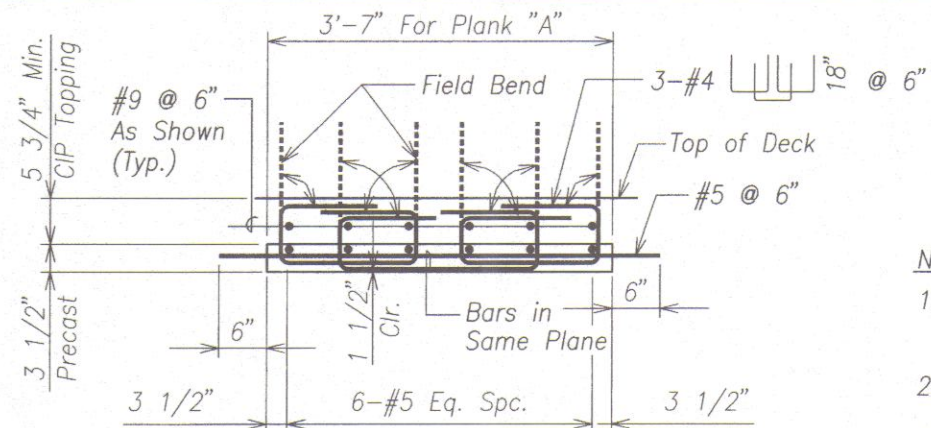


SECTION - PLANK "A" (ABOVE PG1)

Scale: 1" = 1'-0"

B
SB4A.1/SB4A.1

NOTES:


1. Plank "A" is located above PG-1 Precast Tub Girder.
2. Plank "B" is located between Tub Girders.
3. Plank "C" is located above PG-2 Precast Tub Girders.

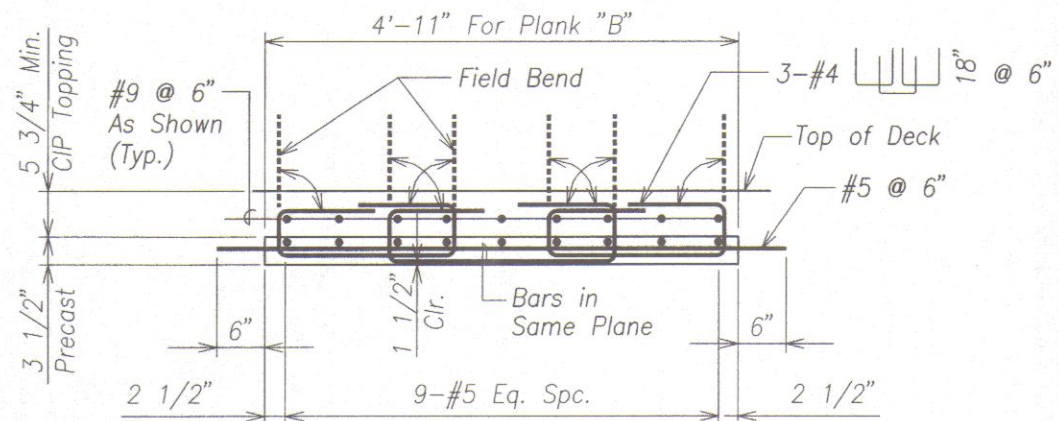

SECTION - PLANK "B" (BETWEEN GIRDERS)

Scale: 1" = 1'-0"

C
SB4A.1/SB4A.1

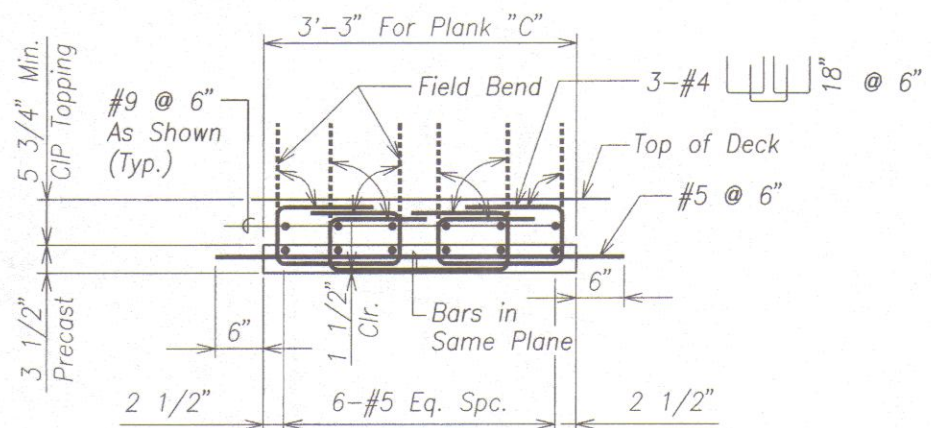

SECTION - PLANK "C" (ABOVE PG2)

Scale: 1" = 1'-0"

D
SB4A.1/SB4A.1



THIS WORK WAS PREPARED BY ME
OR UNDER MY SUPERVISION.

David K. Fujiwara
KSF, INC. APRIL 30, 2012
LIC. EXP. DATE

STATE OF HAWAII
DEPARTMENT OF TRANSPORTATION
HIGHWAYS DIVISION

PRECAST DECK PLANK DETAILS

HONOAPIILANI HIGHWAY REALIGNMENT, PHASE 1A
Future Keawe St Extension to Lahainaluna Rd, Part B
Fed. Aid Proj. No. NH-030-1(35)R

Scale: As Noted

Date: June, 2010


SHEET No. SB4A.1 OF 3 SHEETS

FINAL DESIGN 291


DRAWING NAME: 2100 ONCONING 40019.0-HONOAPIILANI LAHAINA BYPASS-KAHOMA WD 06-15-10 COMBINE LAHAINA FINAL DESIGN NH-SB4001.DWG PLOT TIME: 06-14-10, 3:08 PM

ORIGINAL PLAN	SURVEY PLOTTED BY	DATE
NOTE BOOK	DESIGNED BY	
QUANTITIES BY	TRACED BY	
CHECKED BY	DESIGNED BY	
No.		


FED. ROAD DIST. NO.	STATE	FED. AID PROJ. NO.	FISCAL YEAR	SHEET NO.	TOTAL SHEETS
HAWAII	HAW.	NH-030-1(35)R	2009	292	383

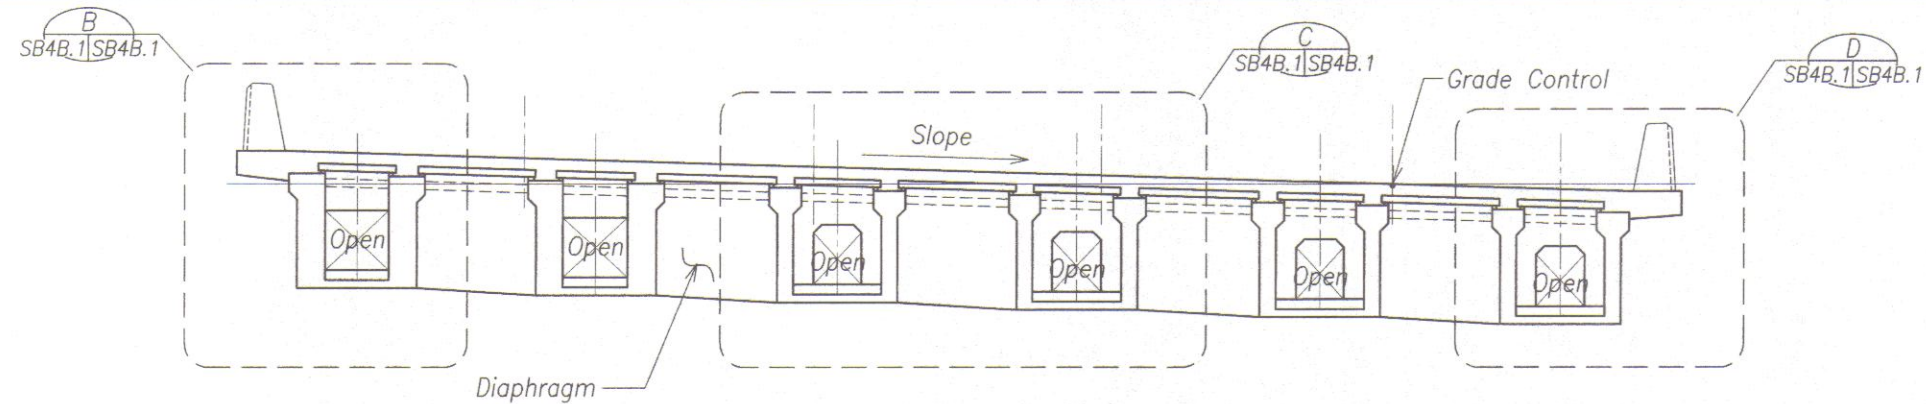


TYPICAL DIAPHRAGM ELEVATION
 Scale: 1/4" = 1'-0"
 SB4B.1|SB4B.1

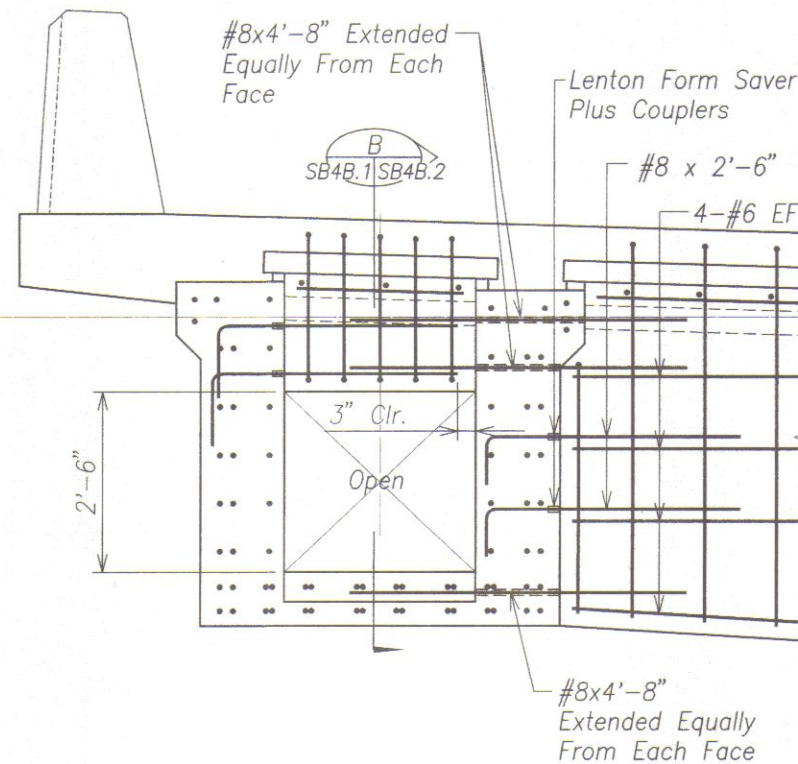

ELEVATION
 Scale: 3/4" = 1'-0"
 SB4B.1|SB4B.1

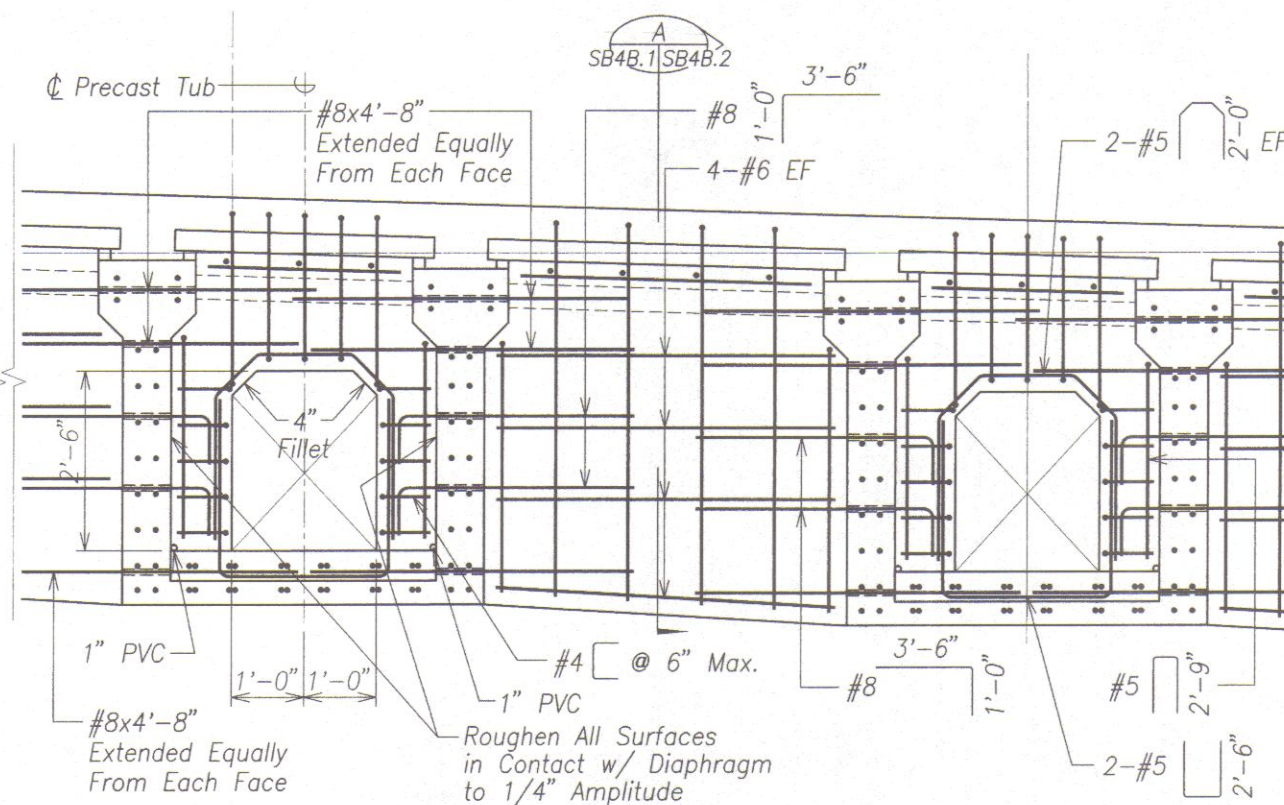

ELEVATION
 Scale: 3/4" = 1'-0"
 SB4B.1|SB4B.1

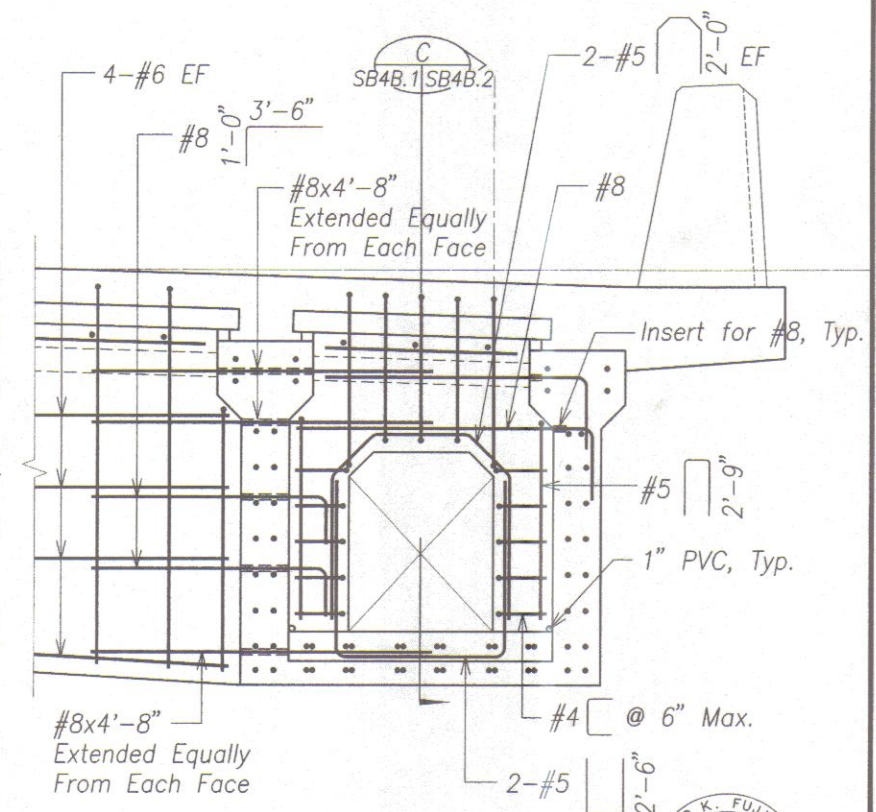

ELEVATION
 Scale: 3/4" = 1'-0"
 SB4B.1|SB4B.1



THIS WORK WAS PREPARED BY ME
 OR UNDER MY SUPERVISION.
David K. Fujiwara
 KSF, INC. APRIL 30, 2012
 L.C. EXP. DATE

STATE OF HAWAII
 DEPARTMENT OF TRANSPORTATION
 HIGHWAYS DIVISION

IN-SPAN DIAPHRAGM ELEVATIONS

HONOAPIILANI HIGHWAY REALIGNMENT, PHASE 1A
 Future Keawe St Extension to Lahainaluna Rd, Part B
 Fed. Aid Proj. No. NH-030-1(35)R


Scale: As Noted Date: June, 2010

SHEET No. SB4B.1 OF 3 SHEETS


DATE	
SURVEY PLOTTED BY	
DESIGNED BY	
NOTED BY	
CHECKED BY	
ORIGINAL PLAN	
NOTE BOOK	
No.	

DRAWING NAME: 2:100 ONGOING 40019.0-HONOAPIILANI LAHAINA BYPASS-KAHOOLA W/06-15-10 COMBINE LAHAINA FINAL DESIGN-HH-SB4B.1.DWG PLOT TIME: 06-14-10, 3:09 PM

FED. ROAD DIST. NO.	STATE	FED. AID PROJ. NO.	FISCAL YEAR	SHEET NO.	TOTAL SHEETS
HAWAII	HAW.	NH-030-1(35)R	2009	294	379

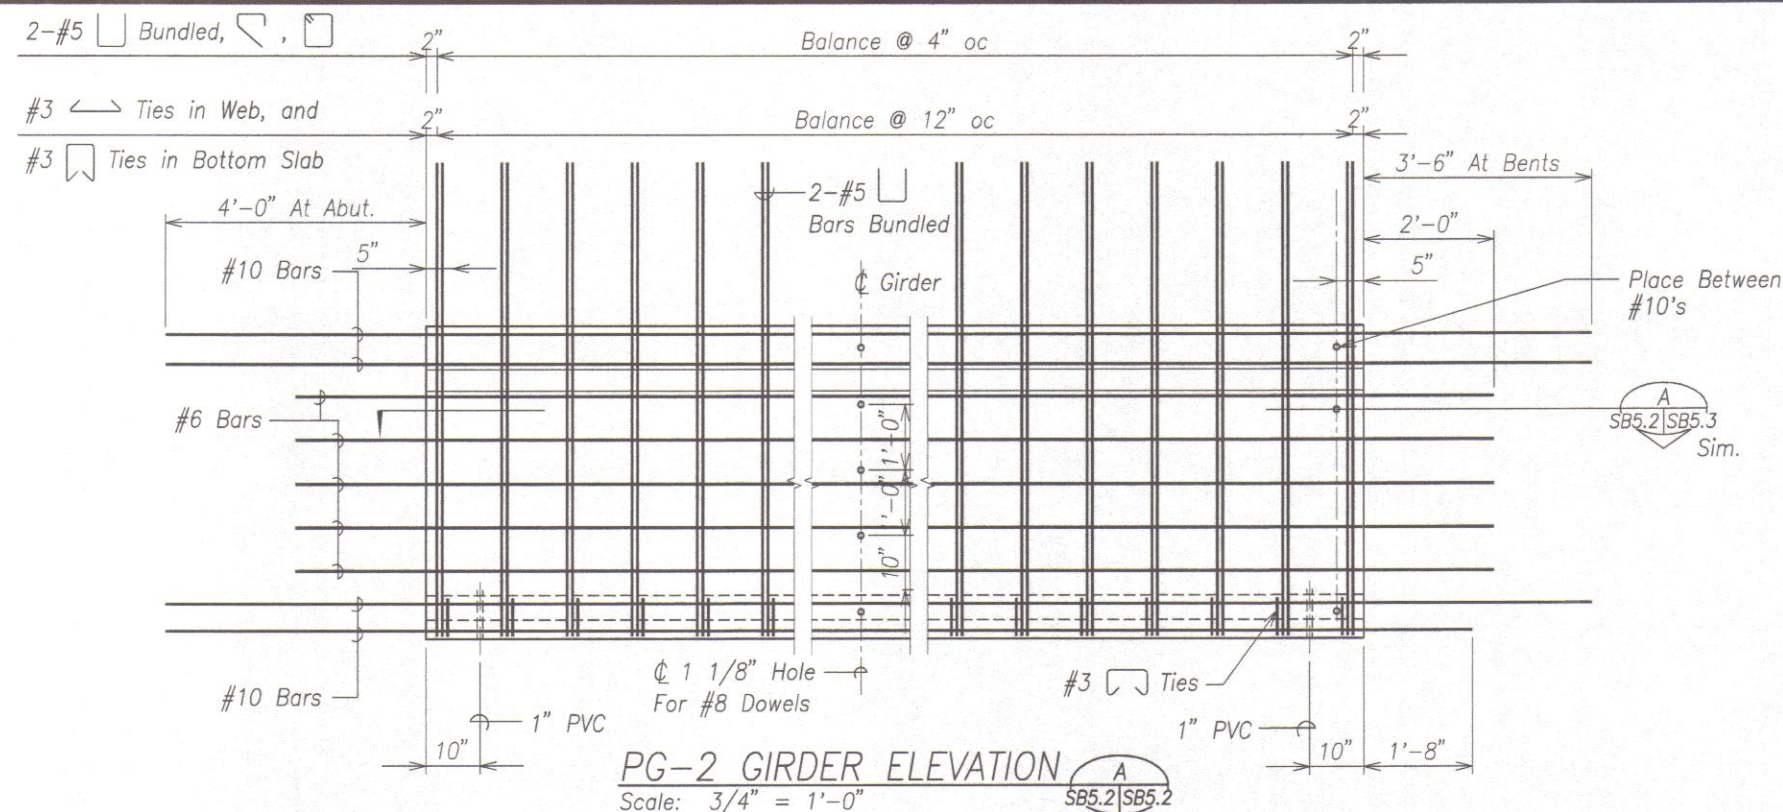

- Notes:
1. See plan sheet SB3.1 for girder cross section and typical deck section.
 2. Camber precast girder 1/4" at centerline span. Soffit of girder shall be parabolic.
 3. Just before placing precast girder at designated supports, apply slush grout on supporting surfaces.
 4. Offset rebars extending beyond ends of girders w/ rebars extend of beyond ends of girders in adjacent spans.
 5. Precast girder shall attain a compressive concrete strength of 6,000 psi and age 14 days prior to handling and form release.
 6. Contractor may add #10 x 8'-0" and lap to #10 cont. in order to offset extended bars. Length of extension beyond girder shall be as shown in elevation "A".
 7. For details at exterior girder, See sheets SB3.3 and SB4B.2.

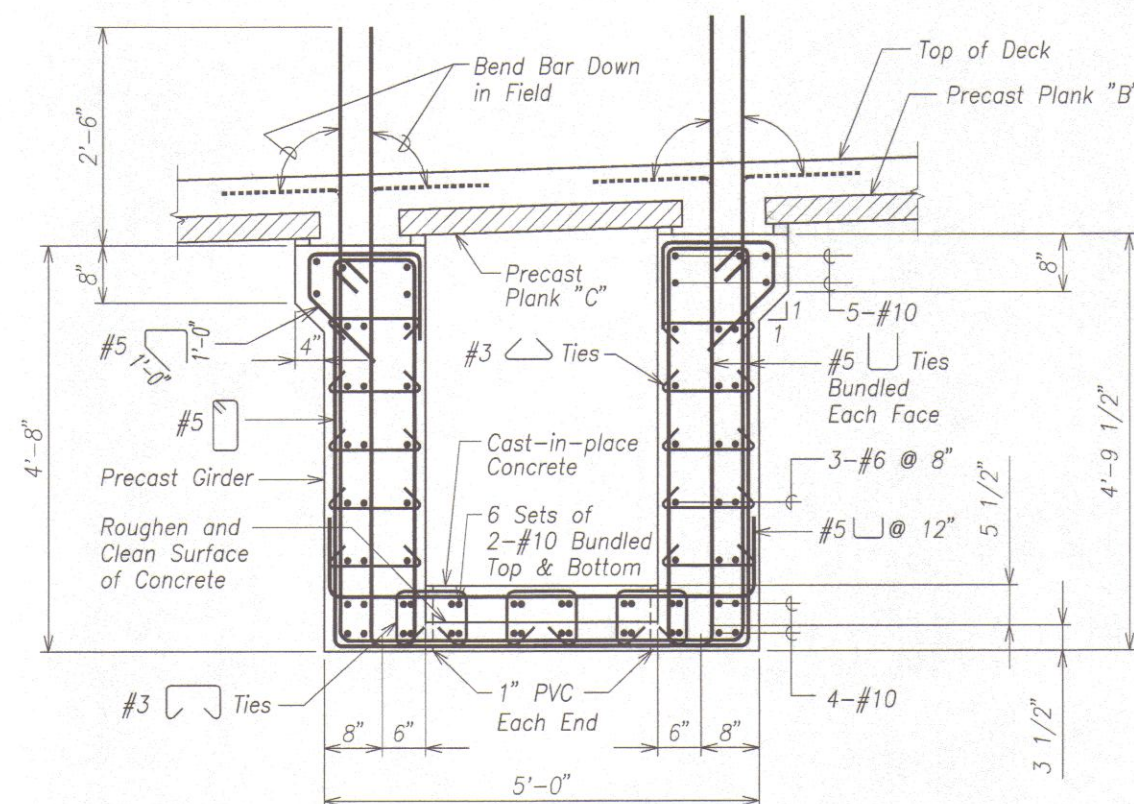

THIS WORK WAS PREPARED BY ME OR UNDER MY SUPERVISION.

KSF, INC. APRIL 30, 2010 LIC. EXP. DATE


STATE OF HAWAII DEPARTMENT OF TRANSPORTATION HIGHWAYS DIVISION	
PG-2 PRECAST GIRDER	
HONOAPIILANI HIGHWAY REALIGNMENT, PHASE 1A Future Keawe St Extension to Lahainaluna Rd, Part B Fed. Aid Proj. No. NH-030-1(35)R	
Scale: As Noted	Date: November, 2009
SHEET No. SB5.2 OF 5 SHEETS	

100% DESIGN 294

ORIGINAL PLAN	DATE
DRAWN BY	
TRACED BY	
QUANTITIES BY	
CHECKED BY	
NOTE BOOK	
No.	


DRAWING NAME: Z:\2004\40719-HONOAPIILANI LAHAINA BYPASS-KAHOMA WD\11-09-09 COMBINE KAHOMA\H1-SB501.DWG PLOT TIME: 11-09-09, 3:25 PM

FED. ROAD DIST. NO.	STATE	FED. AID PROJ. NO.	FISCAL YEAR	SHEET NO.	TOTAL SHEETS
HAWAII	HAW.	NH-030-1(35)R	2009	294	383

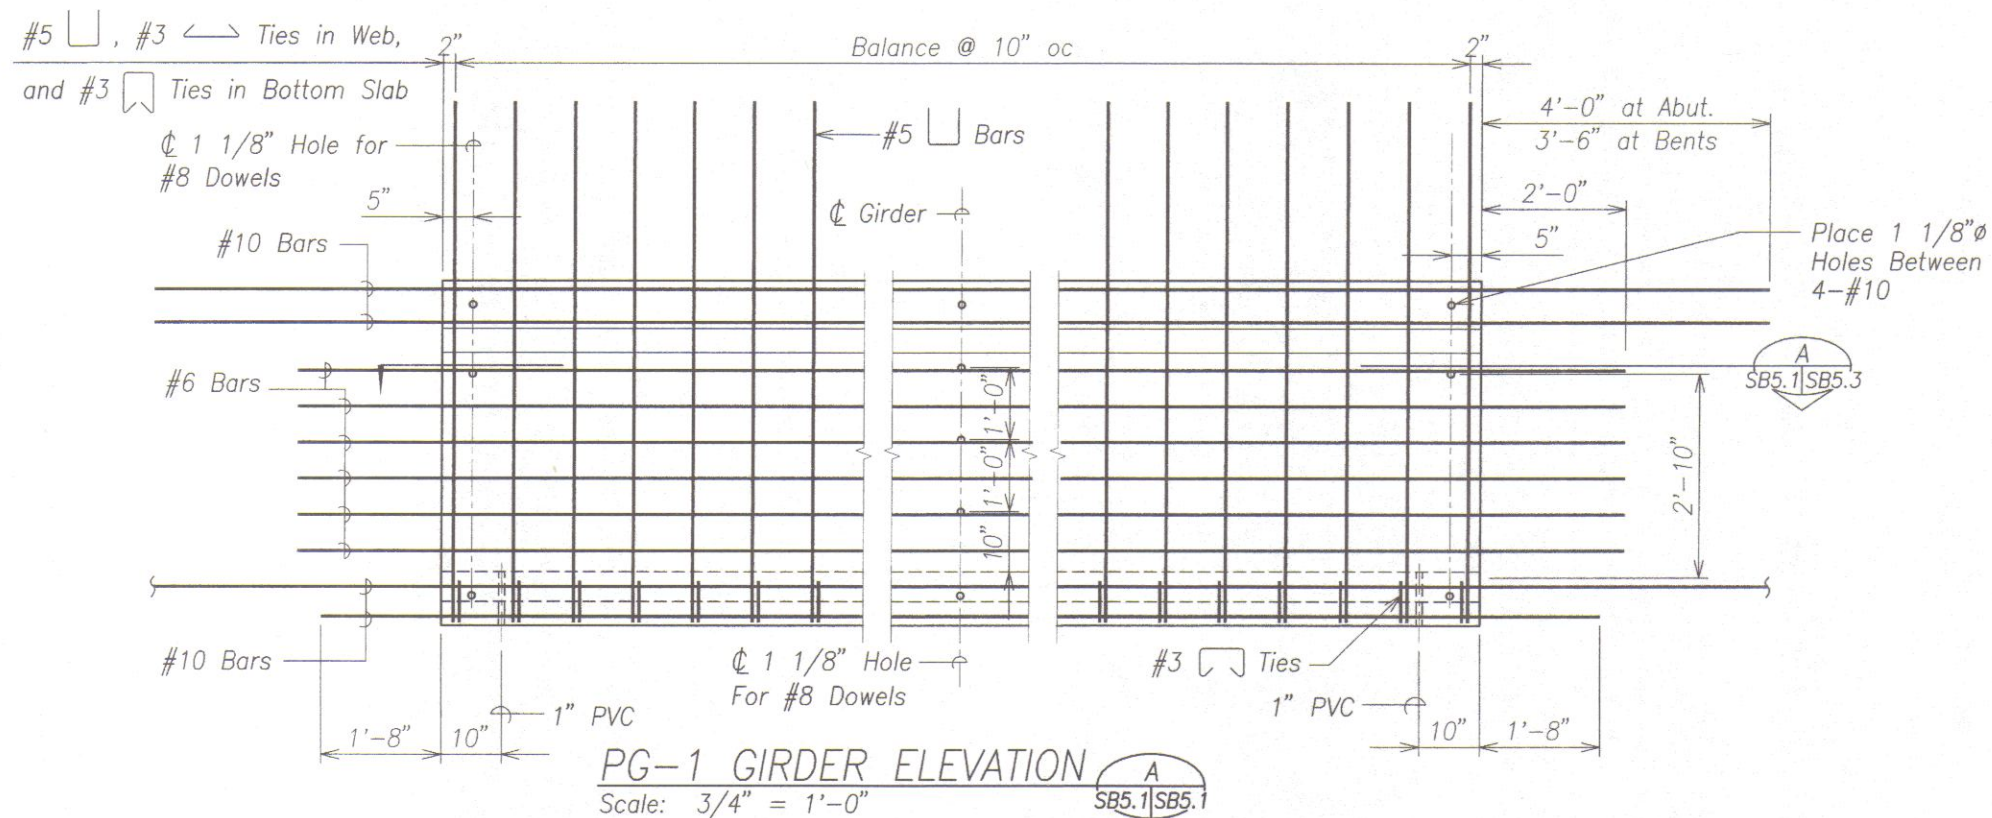

NOTES:

- See plan Sheet SB3.1 for Girder cross section and typical Deck section.
- Camber Precast Girder 1/4" at centerline span. Soffit of Girder shall be parabolic.
- Just before placing Precast Girder at designated supports, apply slush grout on supporting surfaces.
- Offset rebars extending beyond ends of Girders w/ rebars extending beyond ends of Girders in adjacent Spans.
- Precast Girder shall attain a compressive concrete strength of 6,000 psi and age 14 days prior to handling and form release.
- Contractor may add #10 x 8'-0" and lap to #10 cont. in order to offset extended bars. Length of extension beyond Girder shall be as shown in Elevation "A".
- For details at exterior Girder, see Sheets SB3.3 and SB4B.2.

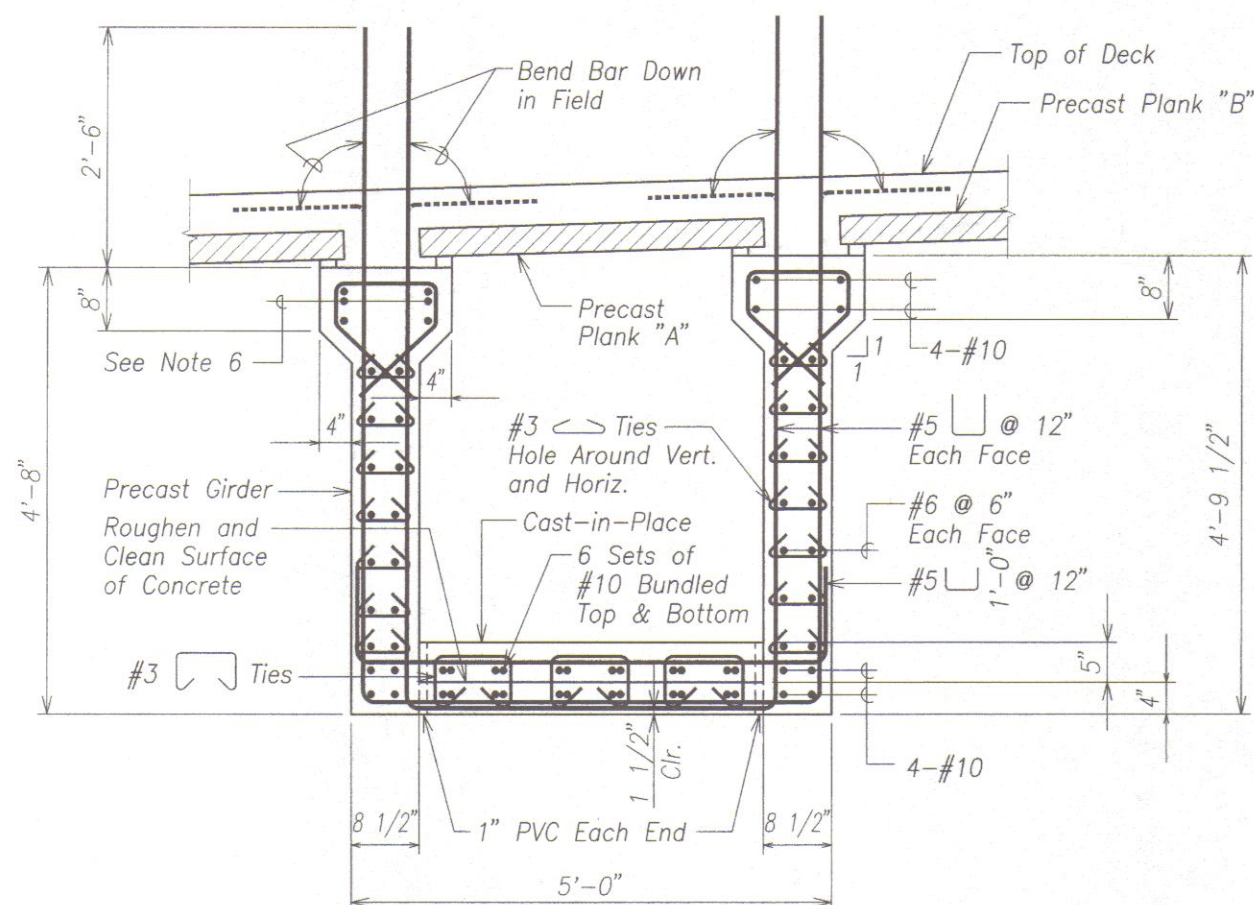

TYPICAL SECTION PG-1 GIRDER 
Scale: 1" = 1'-0" 



THIS WORK WAS PREPARED BY ME OR UNDER MY SUPERVISION.

David K. Fujimori
KSF, INC. APRIL 30, 2012
LIC. EXP. DATE

STATE OF HAWAII
DEPARTMENT OF TRANSPORTATION
HIGHWAYS DIVISION

PG-1 PRECAST GIRDER

HONOAPIILANI HIGHWAY REALIGNMENT, PHASE 1A
Future Keawe St Extension to Lahainaluna Rd, Part B
Fed. Aid Proj. No. NH-030-1(35)R

Scale: As Noted Date: June, 2010


SHEET No. SB5.1 OF 5 SHEETS

FINAL DESIGN 294 *Rev*


SURVEY PLOTTED BY	DATE
DRAWN BY	
DESIGNED BY	
CHECKED BY	
ORIGINAL PLAN	
NOTE BOOK	
No.	

DRAWING NAME: Z:\00 ONGOING\40019.0-HONOAPIILANI LAHANA BYPASS-KAHOMA W\06-15-10 COMBINE LAHANA FINAL DESIGN\HH-SB501.DWG PLOT TIME: 06-15-10, 8:38 AM

FED. ROAD DIST. NO.	STATE	FED. AID PROJ. NO.	FISCAL YEAR	SHEET NO.	TOTAL SHEETS
HAWAII	HAW.	NH-030-1(35)R	2009	295	383

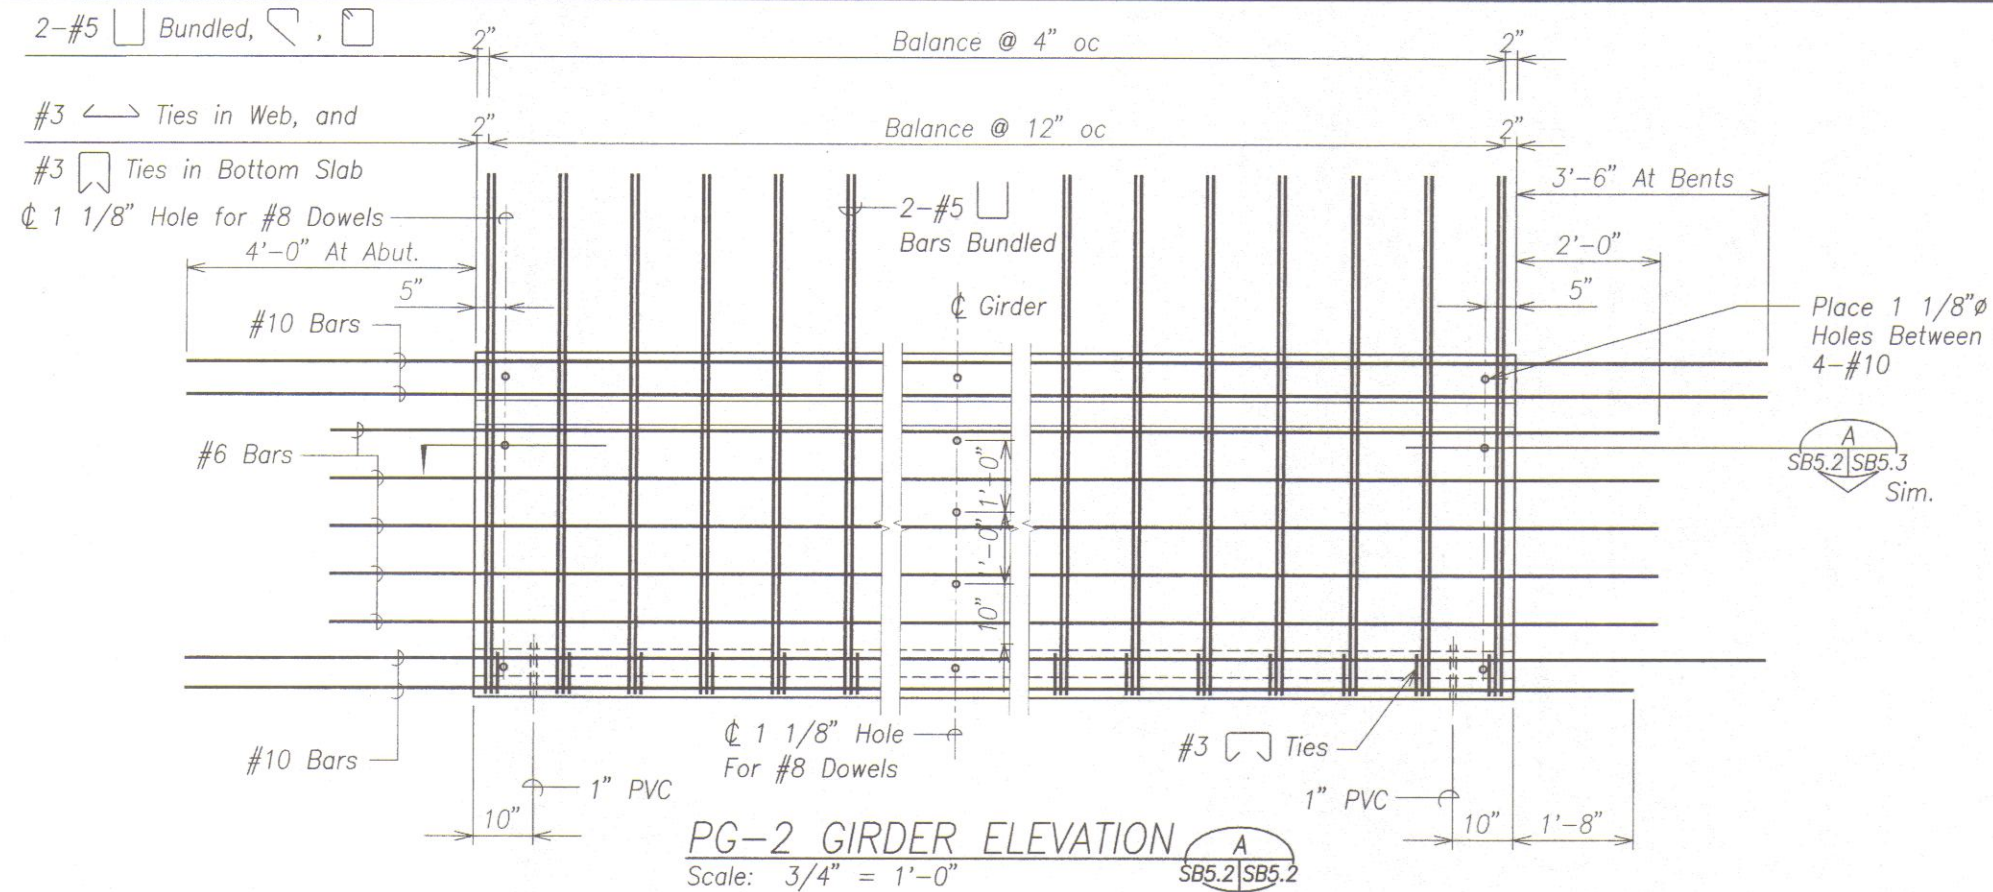

- NOTES:
1. See plan Sheet SB3.1 for Girder cross section and typical Deck section.
 2. Camber Precast Girder 1/4" at centerline span. Soffit of Girder shall be parabolic.
 3. Just before placing Precast Girder at designated supports, apply slush grout on supporting surfaces.
 4. Offset rebars extending beyond ends of Girders w/ rebars extending beyond ends of Girders in adjacent spans.
 5. Precast Girder shall attain a compressive concrete strength of 6,000 psi and age 14 days prior to handling and form release.
 6. Contractor may add #10 x 8'-0" and lap to #10 cont. in order to offset extended bars. Length of extension beyond Girder shall be as shown in Elevation "A".
 7. For details at exterior Girder, see Sheets SB3.3 and SB4B.2.

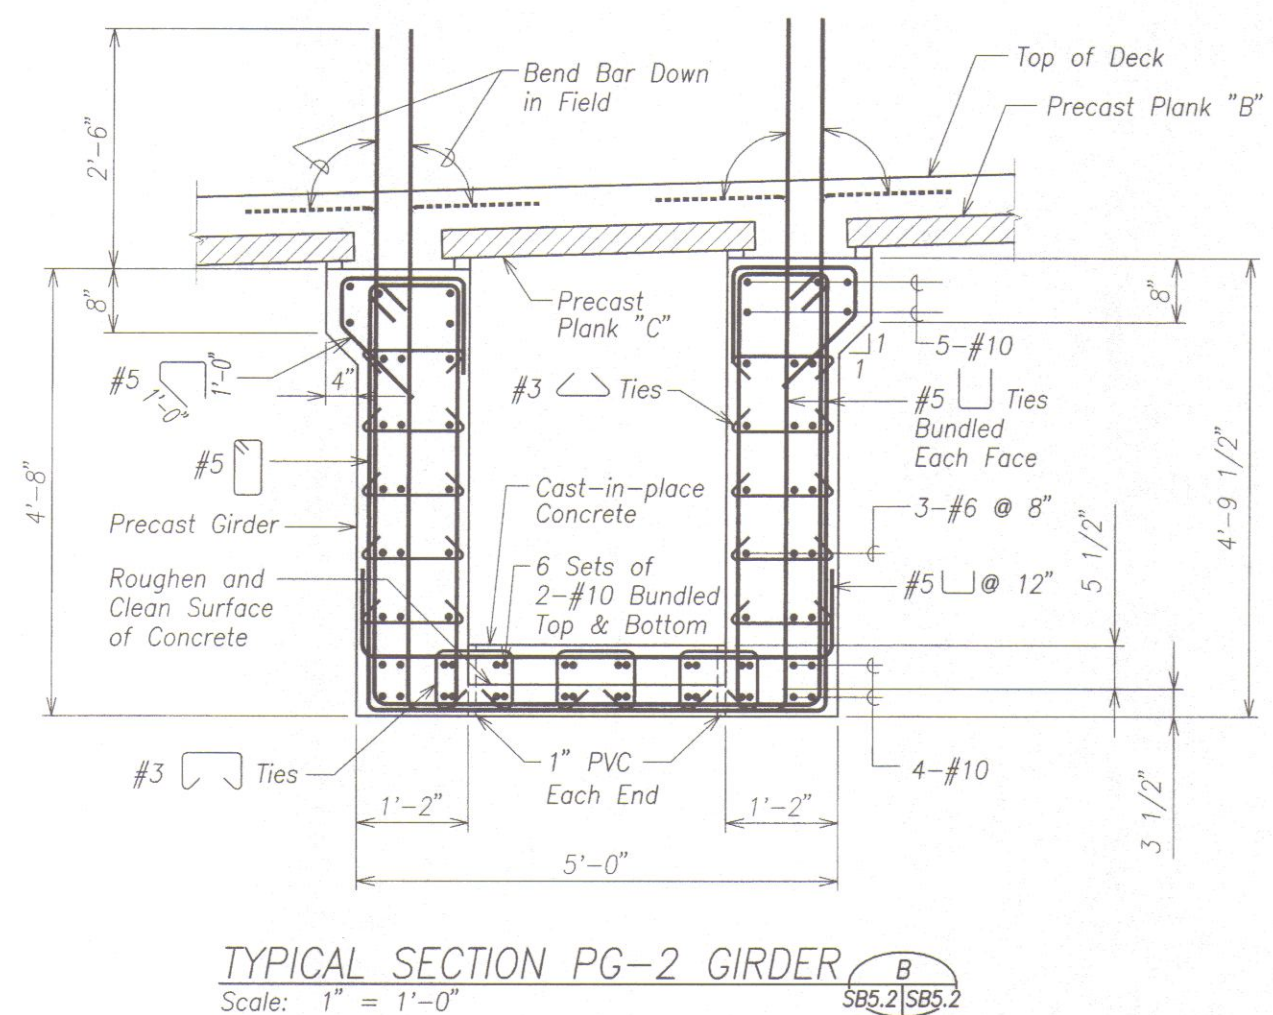

THIS WORK WAS PREPARED BY ME OR UNDER MY SUPERVISION.

David K. Fujiwara APRIL 30, 2012

KSF, INC. LIC. EXP. DATE

STATE OF HAWAII
DEPARTMENT OF TRANSPORTATION
HIGHWAYS DIVISION

PG-2 PRECAST GIRDER

HONOAPIILANI HIGHWAY REALIGNMENT, PHASE 1A
Future Keawe St Extension to Lahainaluna Rd, Part B
Fed. Aid Proj. No. NH-030-1(35)R


Scale: As Noted Date: June, 2010

SHEET No. SB5.2 OF 5 SHEETS

DATE	SURVEY PLOTTED BY
DATE	DESIGNED BY
DATE	CHECKED BY


DRAWING NAME: 2100 ONCONING 40019.0-HONOAPIILANI LAHANA BYPASS-KAHOMA WD 06-15-10 COMBINE LAHANA FINAL DESIGN\HH-SB501.DWG PLOT TIME: 06-14-10, 10:02 PM

FED. ROAD DIST. NO.	STATE	FED. AID PROJ. NO.	FISCAL YEAR	SHEET NO.	TOTAL SHEETS
HAWAII	HAW.	NH-030-1(35)R	2009	296	383

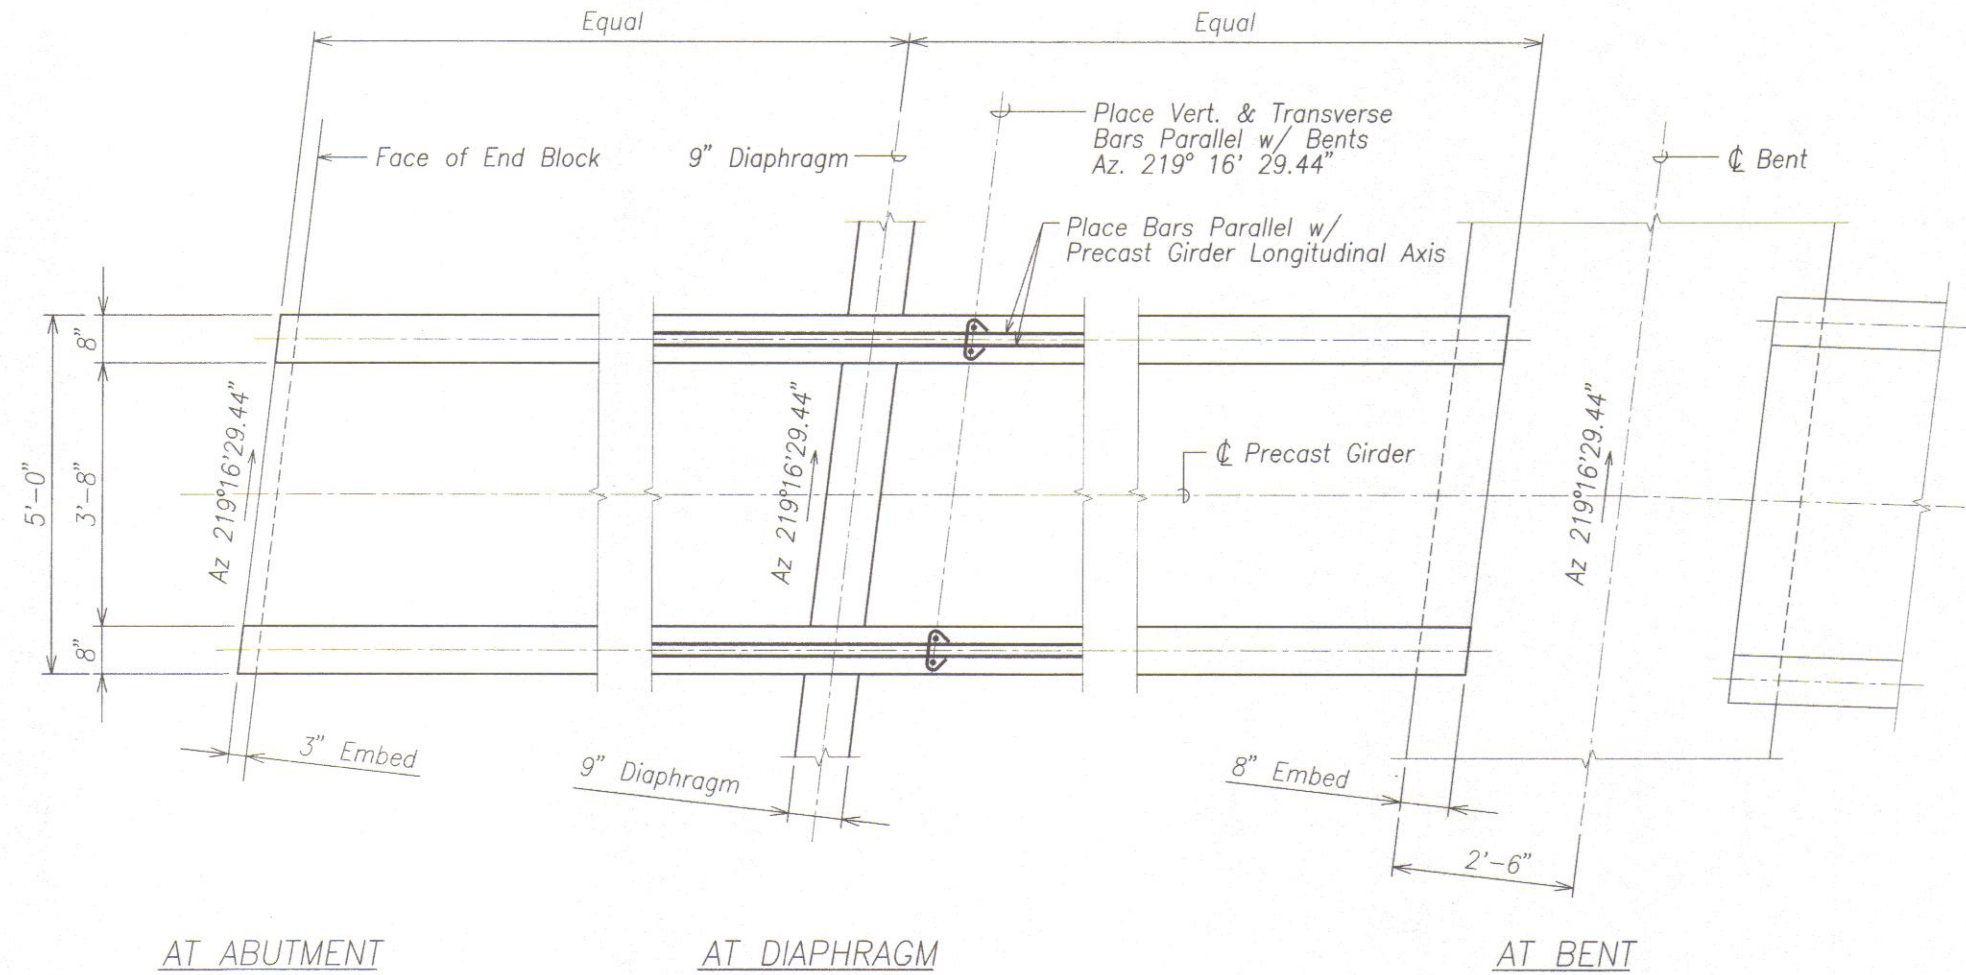

PRECAST GIRDER SECTION
 Scale: 3/4" = 1'-0"
 SB5.1 SB5.3
 SB5.2

NOTE:
 PG-1 Precast girder shown.

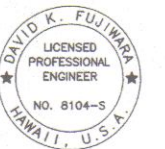

THIS WORK WAS PREPARED BY ME
 OR UNDER MY SUPERVISION.
 David K. Fujiwara
 KSF, INC. APRIL 30, 2012
 LIC. EXP. DATE

STATE OF HAWAII
 DEPARTMENT OF TRANSPORTATION
 HIGHWAYS DIVISION

PRECAST GIRDER SECTION

HONOAPIILANI HIGHWAY REALIGNMENT, PHASE 1A
 Future Keawe St Extension to Lahainaluna Rd, Part B
 Fed. Aid Proj. No. NH-030-1(35)R

Scale: As Noted Date: June, 2010


SHEET No. SB5.3 OF 5 SHEETS

FINAL DESIGN 296


ORIGINAL PLAN	SURVEY PLOTTED BY	DATE
NO. 1	DRAWN BY	
NO. 2	DESIGNED BY	
NO. 3	CHECKED BY	

DRAWING NAME: Z:\00 ONCONG\40019.0-HONOAPIILANI LAHAINA BYPASS-KAHOMA WD\06-15-10 COMBINE LAHAINA FINAL DESIGN\HH-SB503.DWG PLOT TIME: 06-14-10, 3:13 PM


FED. ROAD DIST. NO.	STATE	FED. AID PROJ. NO.	FISCAL YEAR	SHEET NO.	TOTAL SHEETS
HAWAII	HAW.	NH-030-1(35)R	2009	297	383

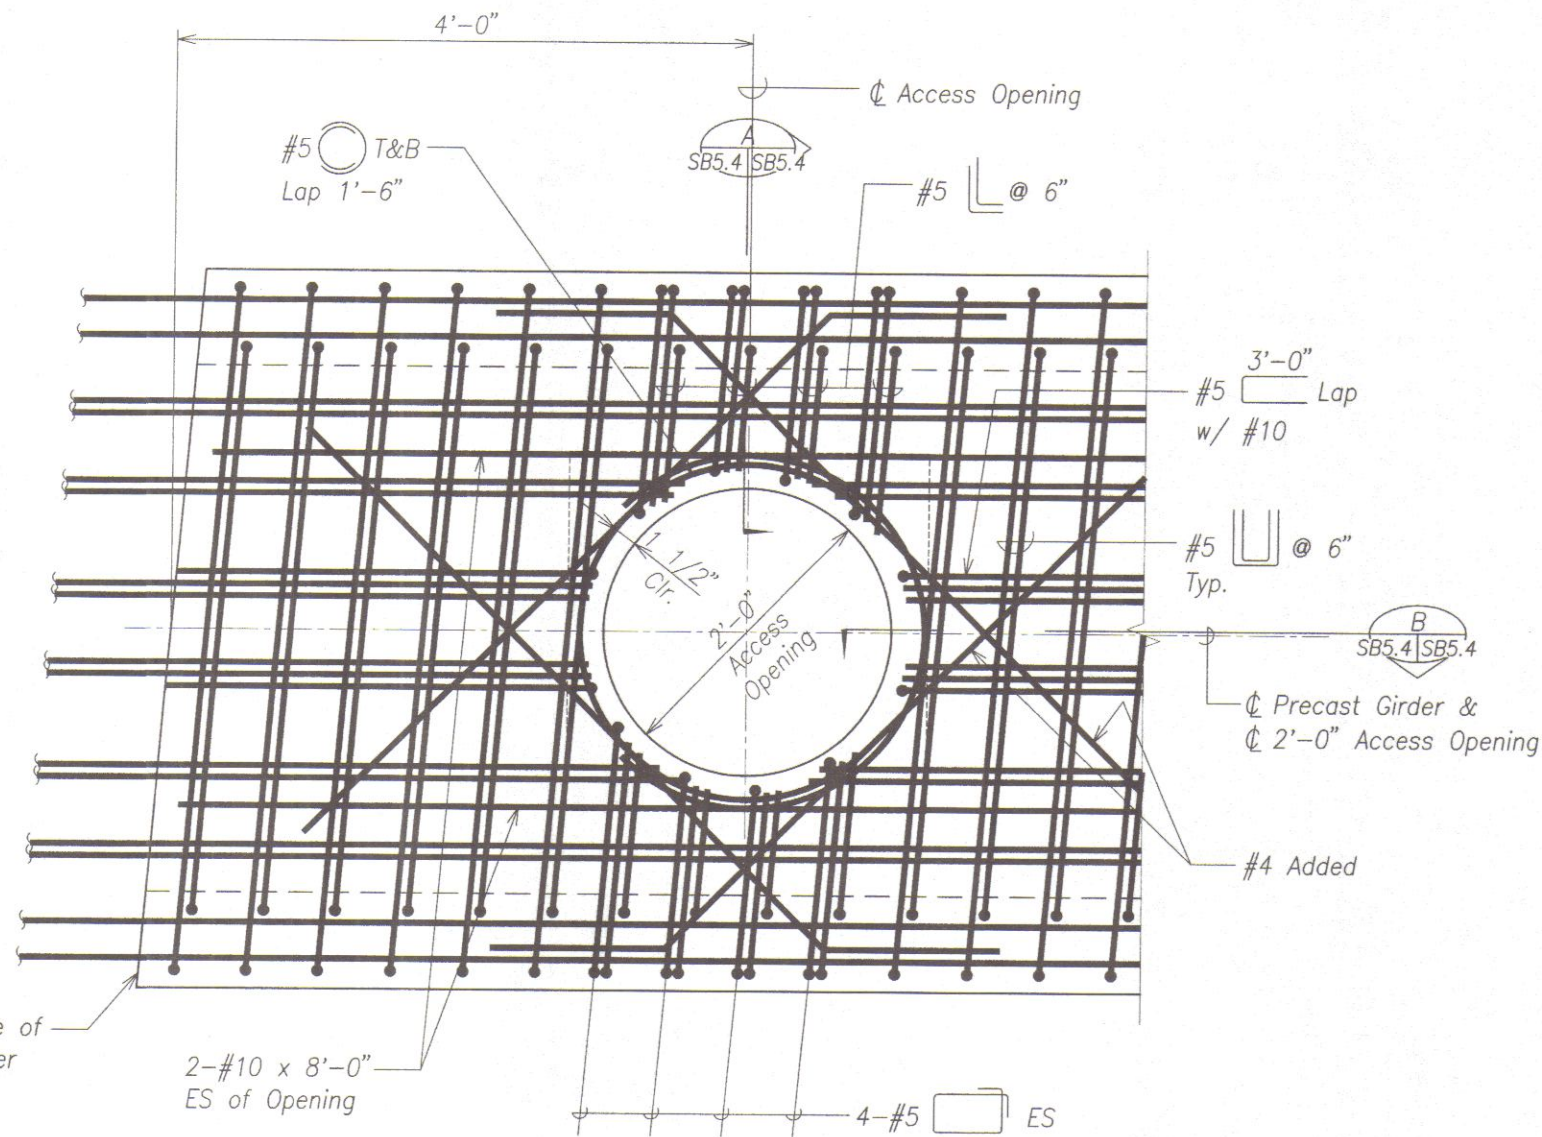

ACCESS OPENING SECTION
Scale: 1 1/2" = 1'-0"

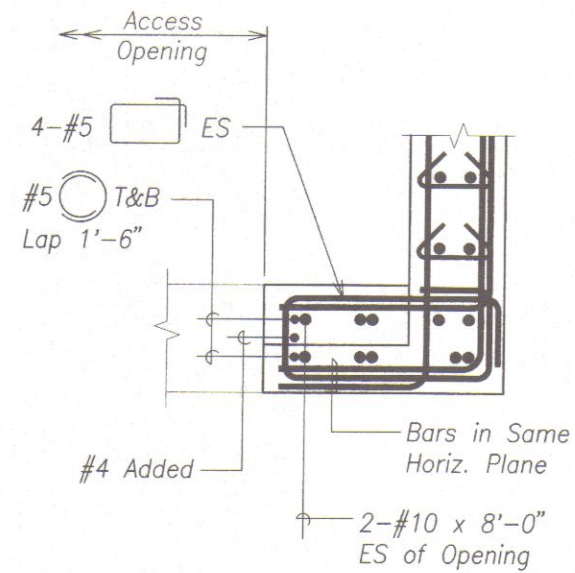

SECTION A-A
Scale: 1 1/2" = 1'-0" SB5.4 SB5.4

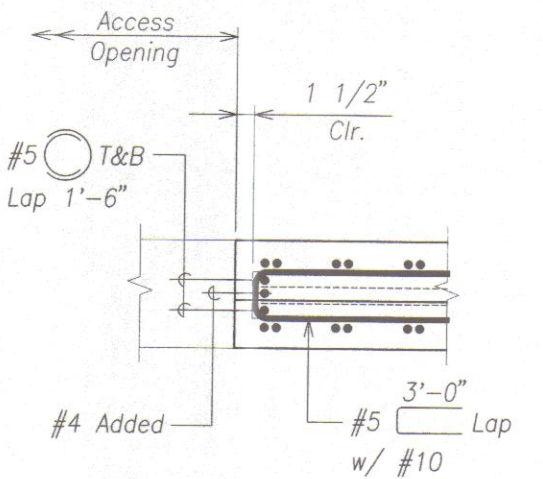

SECTION B-B
Scale: 1 1/2" = 1'-0" SB5.4 SB5.4



THIS WORK WAS PREPARED BY ME
OR UNDER MY SUPERVISION.
David K. Fujiwara
KSF, INC. APRIL 30, 2012
LIC. EXP. DATE

STATE OF HAWAII
DEPARTMENT OF TRANSPORTATION
HIGHWAYS DIVISION

SOFFIT ACCESS SECTIONS

HONOAPIILANI HIGHWAY REALIGNMENT, PHASE 1A
Future Keawe St Extension to Lahainaluna Rd, Part B
Fed. Aid Proj. No. NH-030-1(35)R


Scale: As Noted Date: June, 2010

SHEET No. SB5.4 OF 5 SHEETS


ORIGINAL PLAN	DATE
DRAWN BY	
TRACED BY	
NOTED BY	
CHECKED BY	
NO.	

DRAWING NAME: Z:\00 ONGOING\40019.0-HONOAPIILANI LAHAINA BYPASS-KAHOMA WO\06-15-10 COMBINE LAHAINA FINAL DESIGN\NH-SB504.DWG PLOT TIME: 06-14-10, 3:13 PM


FED. ROAD DIST. NO.	STATE	FED. AID PROJ. NO.	FISCAL YEAR	SHEET NO.	TOTAL SHEETS
HAWAII	HAW.	NH-030-1(35)R	2009	298	383

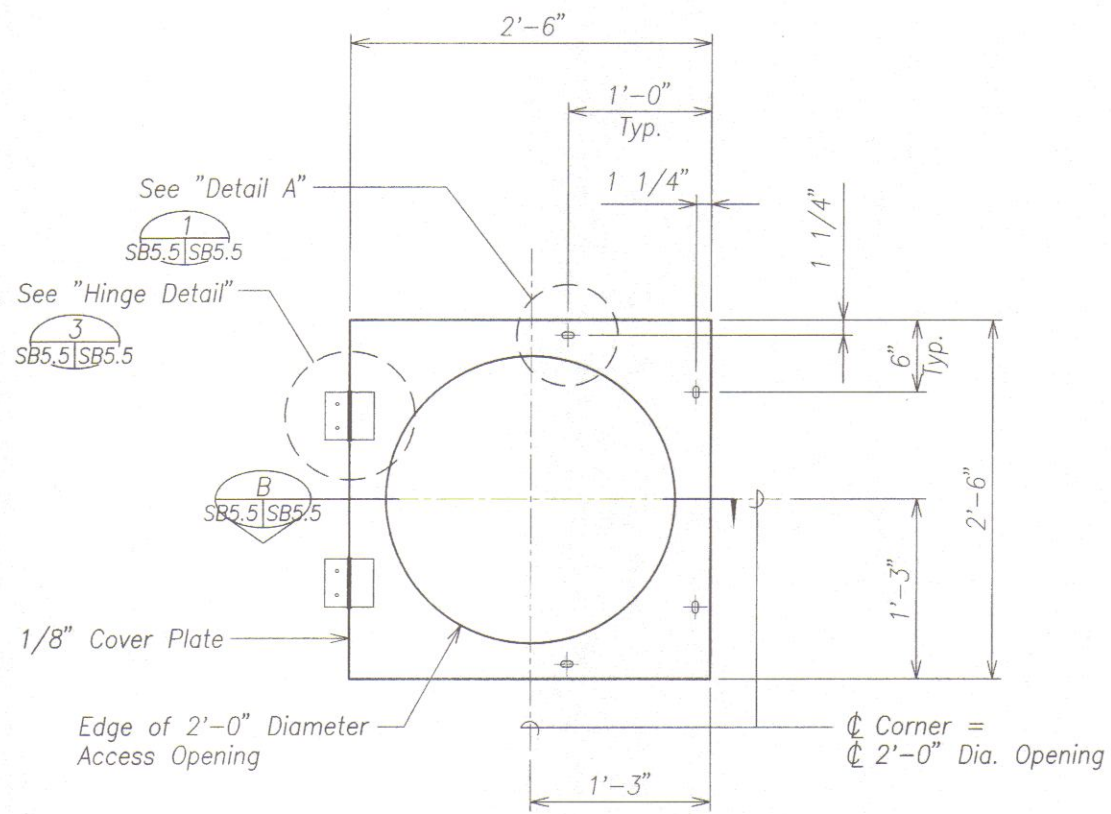

REFLECTED CEILING PLAN
Scale: 1 1/2" = 1'-0"

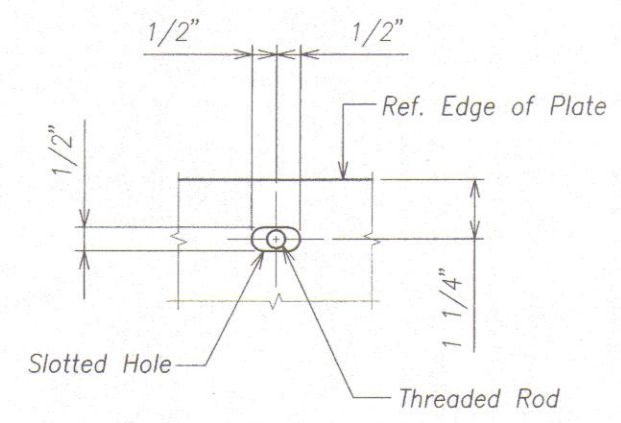


DETAIL "A"
Not to Scale

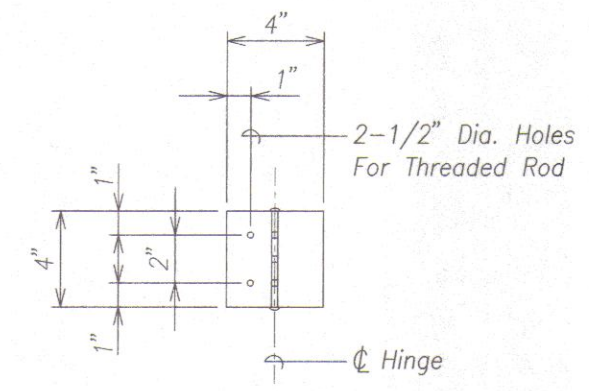


HINGE DETAIL
Scale: 3" = 1'-0"

ACCESS HATCH ASSEMBLY NOTES:

- Soffit Access Hatch swing direction to be determined by the Engineer.
- Access opening cover plates shall be ASTM A36 hot-dip galvanized after fabrication.
- All hinges, pins, threaded rods and connectors shall be stainless steel.
- Hinge assembly to be minimum 1/8" thick with non-removable pins.
- Anchorage device and hardware shall be stainless steel and allow for safe connection with a personal fall arrest system. It shall be capable of supporting a minimum load of 5000 lbs without failure when tested in accordance to ANSI Z359.1.

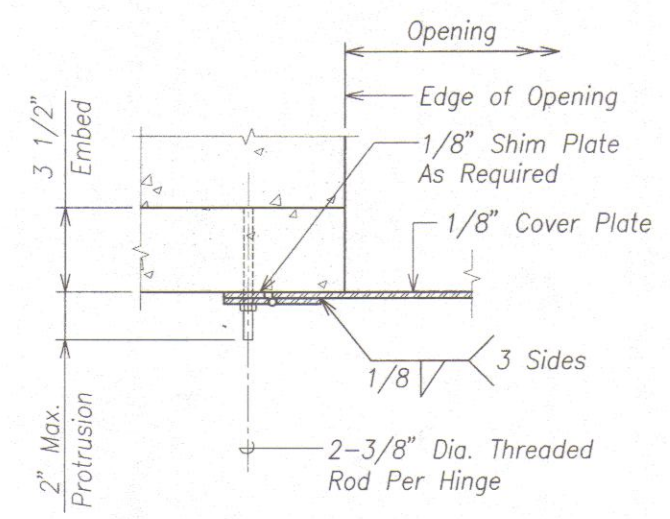

HINGE ANCHORAGE DETAIL
Scale: 3" = 1'-0"

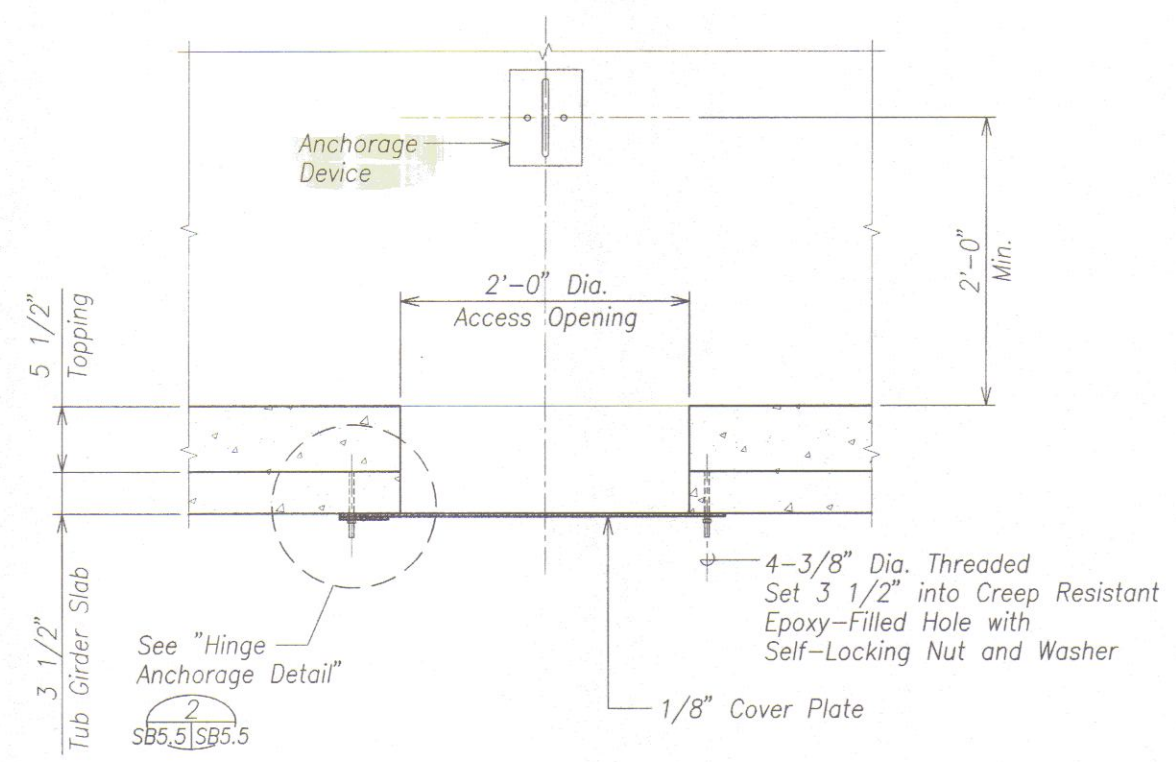

SECTION
Scale: 1 1/2" = 1'-0"



THIS WORK WAS PREPARED BY ME OR UNDER MY SUPERVISION.
David K. Fujiwara
KSF, INC. APR 30, 2012 LIC. EXP. DATE


STATE OF HAWAII
DEPARTMENT OF TRANSPORTATION
HIGHWAYS DIVISION

SOFFIT ACCESS TYPICAL DETAILS
HONOAPIILANI HIGHWAY REALIGNMENT, PHASE 1A
Future Keawe St Extension to Lahainaluna Rd, Part B
Fed. Aid Proj. No. NH-030-1(35)R
Scale: As Noted Date: June, 2010
SHEET No. SB5.5 OF 5 SHEETS


ORIGINAL PLAN	SURVEY PLOTTED BY	DATE
NOTE BOOK	DRAWN BY	
No.	DESIGNED BY	
	CHECKED BY	

DRAWING NAME: Z:\00 ONGOING\40019.0-HONOAPIILANI LAHAINA BYPASS-KAHOMA WO\06-15-10 COMBINE LAHAINA FINAL DESIGN\HH-SB504.DWG PLOT TIME: 06-14-10, 3:14 PM


FED. ROAD DIST. NO.	STATE	FED. AID PROJ. NO.	FISCAL YEAR	SHEET NO.	TOTAL SHEETS
HAWAII	HAW.	NH-030-1(35)R	2009	299	383

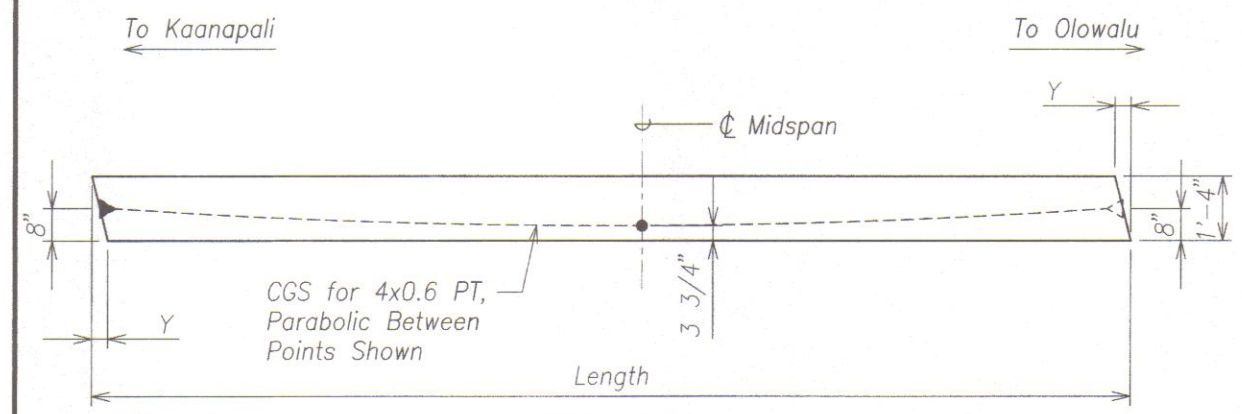


SPAN NO. 1

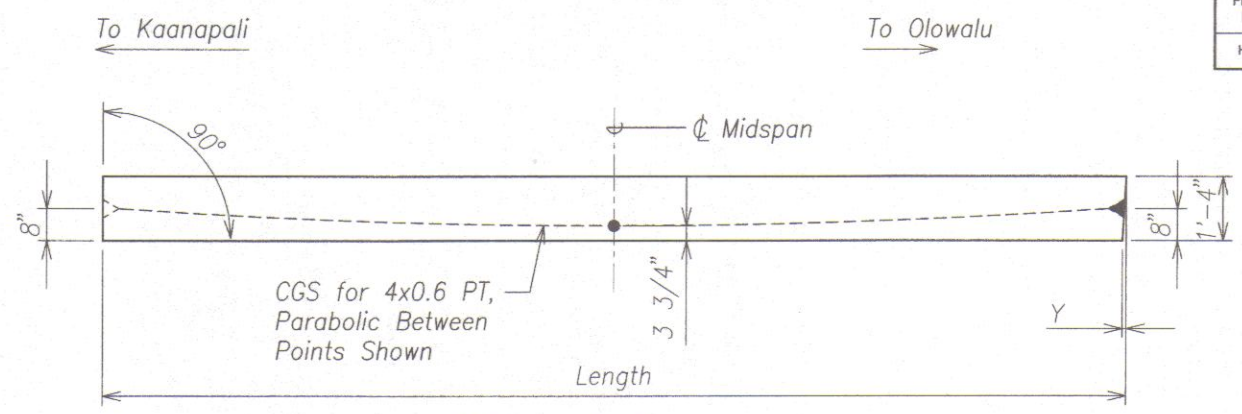


SPAN NO. 5

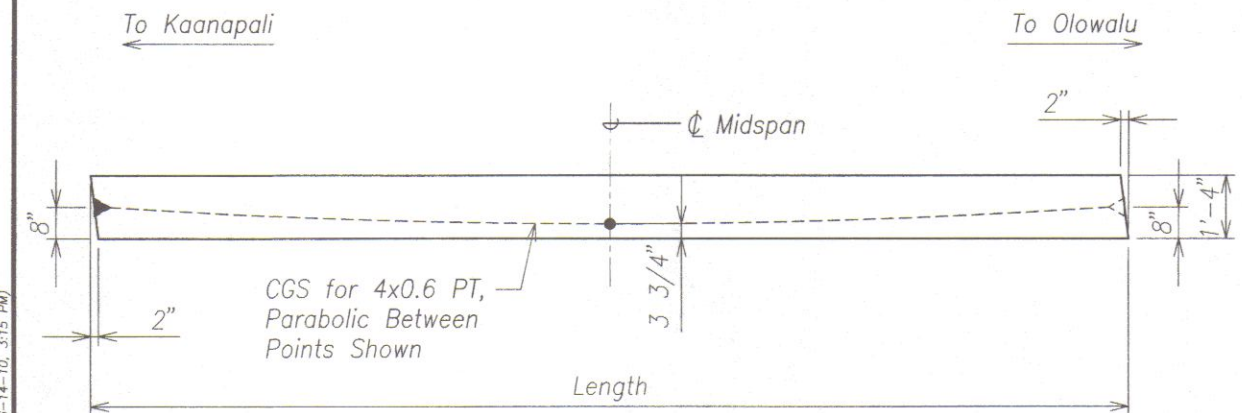


SPAN NO. 2

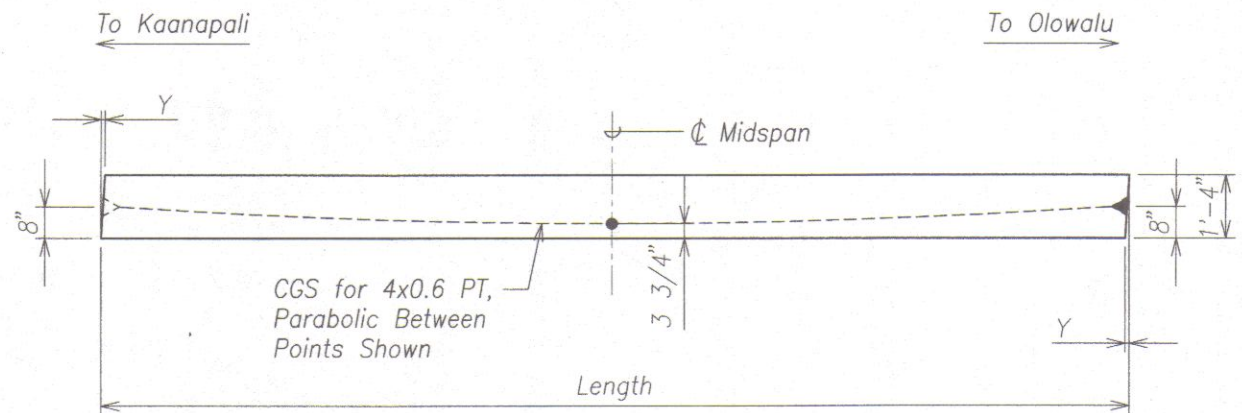


SPAN NO. 6

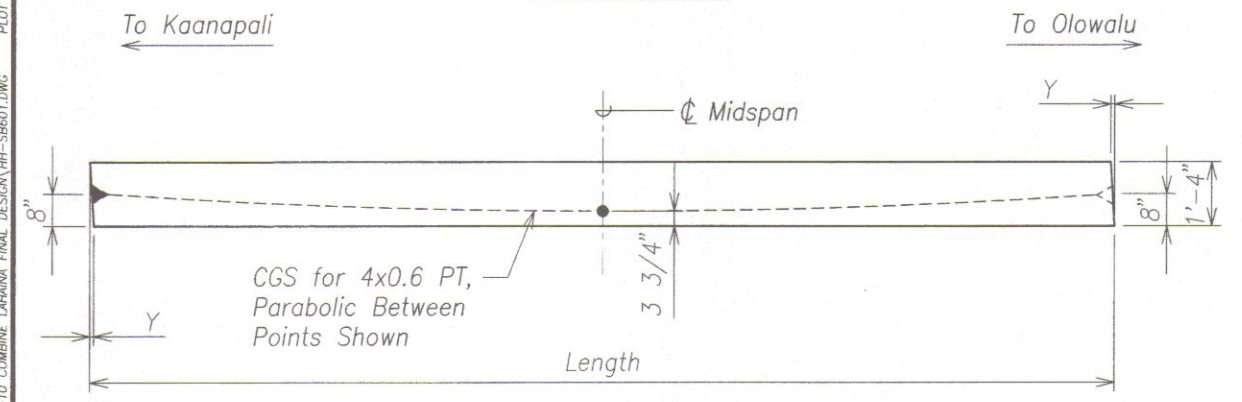


SPAN NO. 3

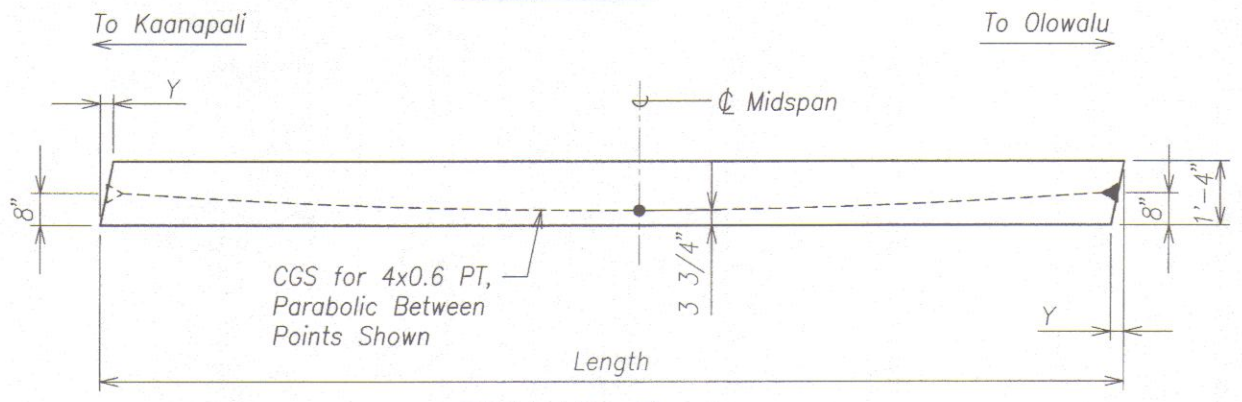

SPAN NO. 7

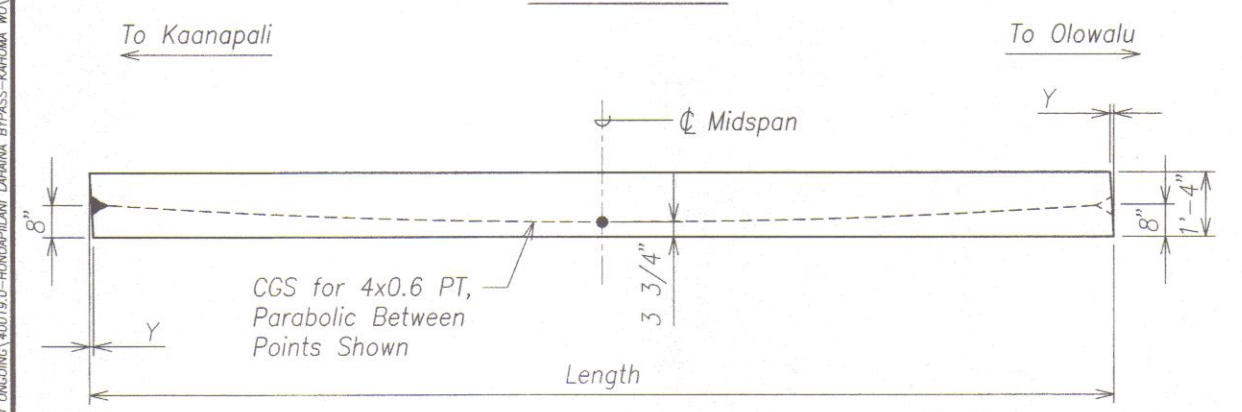

SPAN NO. 4

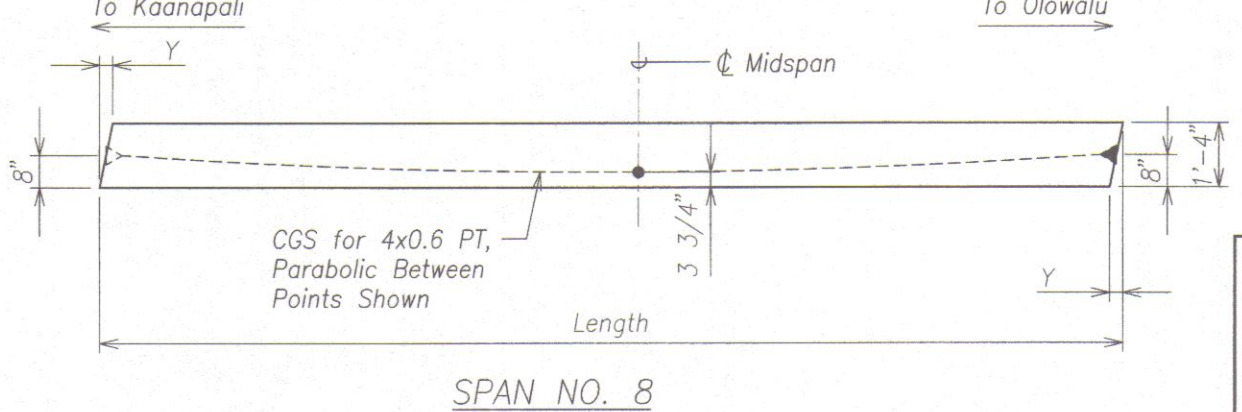

SPAN NO. 8

PATP SCHEMATIC
Scale: None

- LEGEND:
- Denotes Dead End
 - Denotes Jacking End



THIS WORK WAS PREPARED BY ME
OR UNDER MY SUPERVISION.
David K. Fujiwara
KSF, INC. APRIL 30, 2012
LIC. EXP. DATE

STATE OF HAWAII
DEPARTMENT OF TRANSPORTATION
HIGHWAYS DIVISION

PRECAST ARCH TIE PLANK

HONOAPIILANI HIGHWAY REALIGNMENT, PHASE 1A
Future Keawe St Extension to Lahainaluna Rd, Part B
Fed. Aid Proj. No. NH-030-1(35)R


Scale: As Noted Date: June, 2010

SHEET No. SB6.1 OF 6 SHEETS

SURVEY PLOTTED BY	DATE
DRAWN BY	
DESIGNED BY	
CHECKED BY	
ORIGINAL PLAN	
NOTE BOOK	
No.	


DRAWING NAME: Z:\00 ONGOING\40019.0-HONOAPIILANI LAHAINA BYPASS-KAHONA WD\06-15-10 COMBINE LAHAINA FINAL DESIGN\HH-SB601.DWG PLOT TIME: 06-14-10, 3:15 PM

FED. ROAD DIST. NO.	STATE	FED. AID PROJ. NO.	FISCAL YEAR	SHEET NO.	TOTAL SHEETS
HAWAII	HAW.	NH-030-1(35)R	2009	301	383

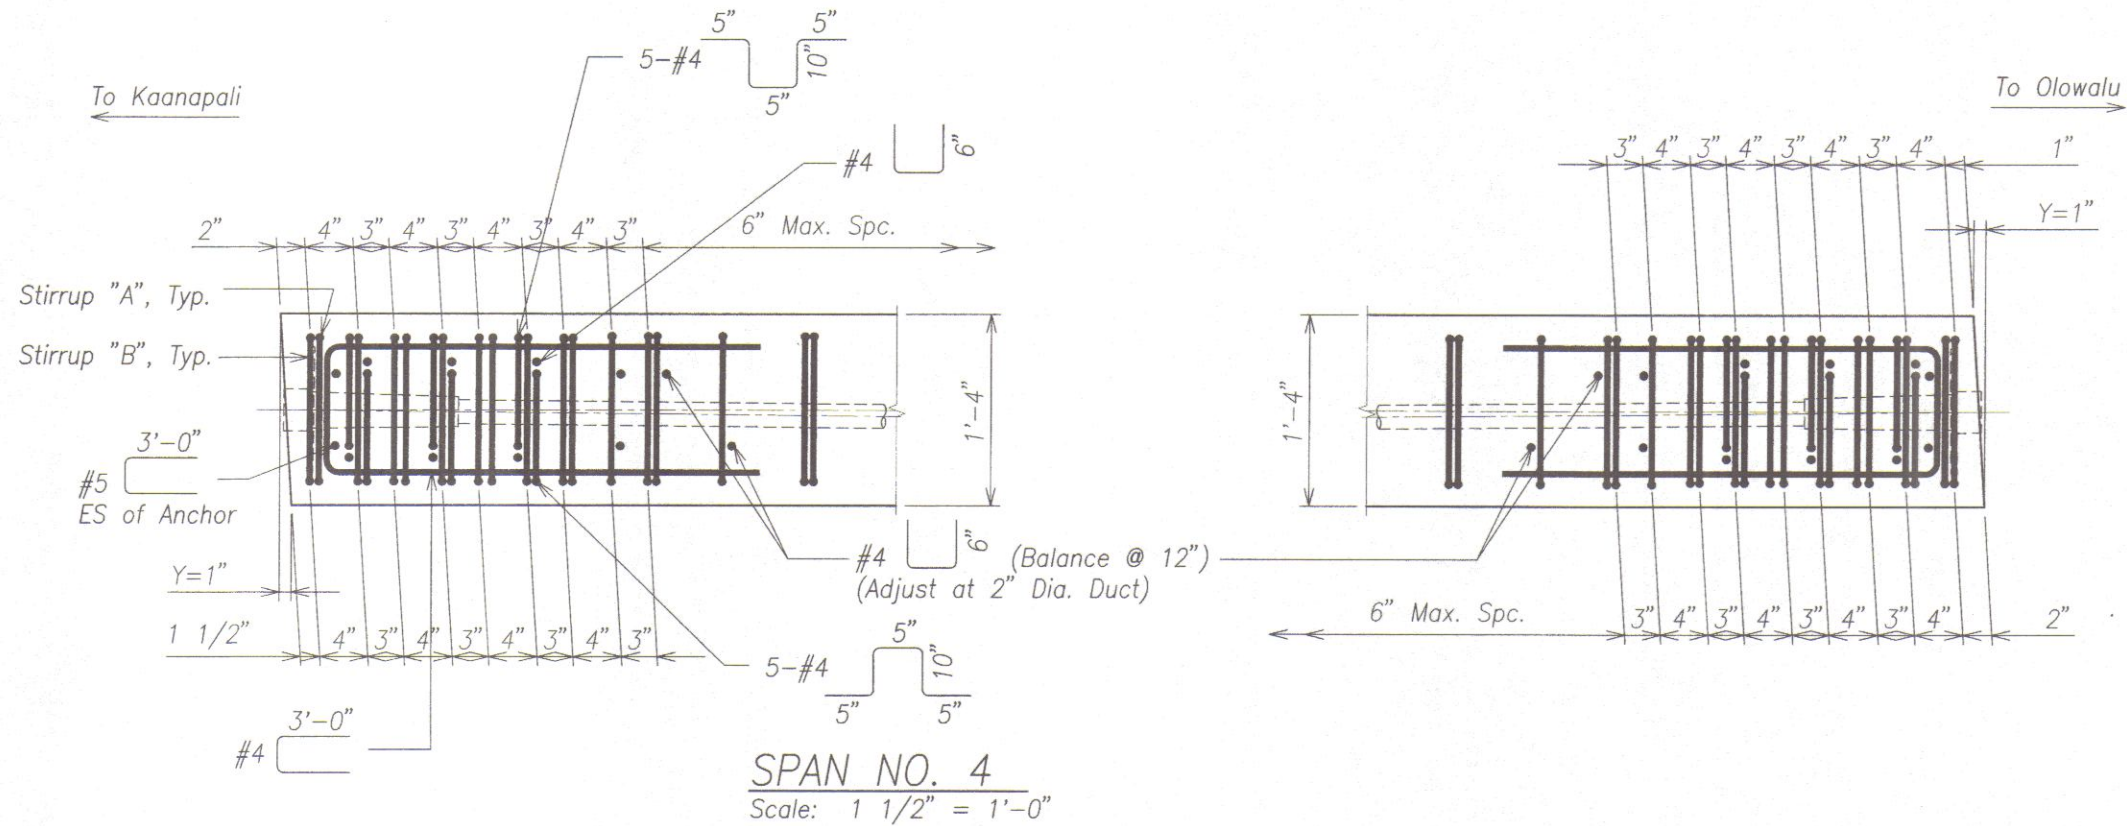

NOTES:

1. See Sht. SB6.5 for additional details.
2. See Sht. SB6.5 for Drip details.

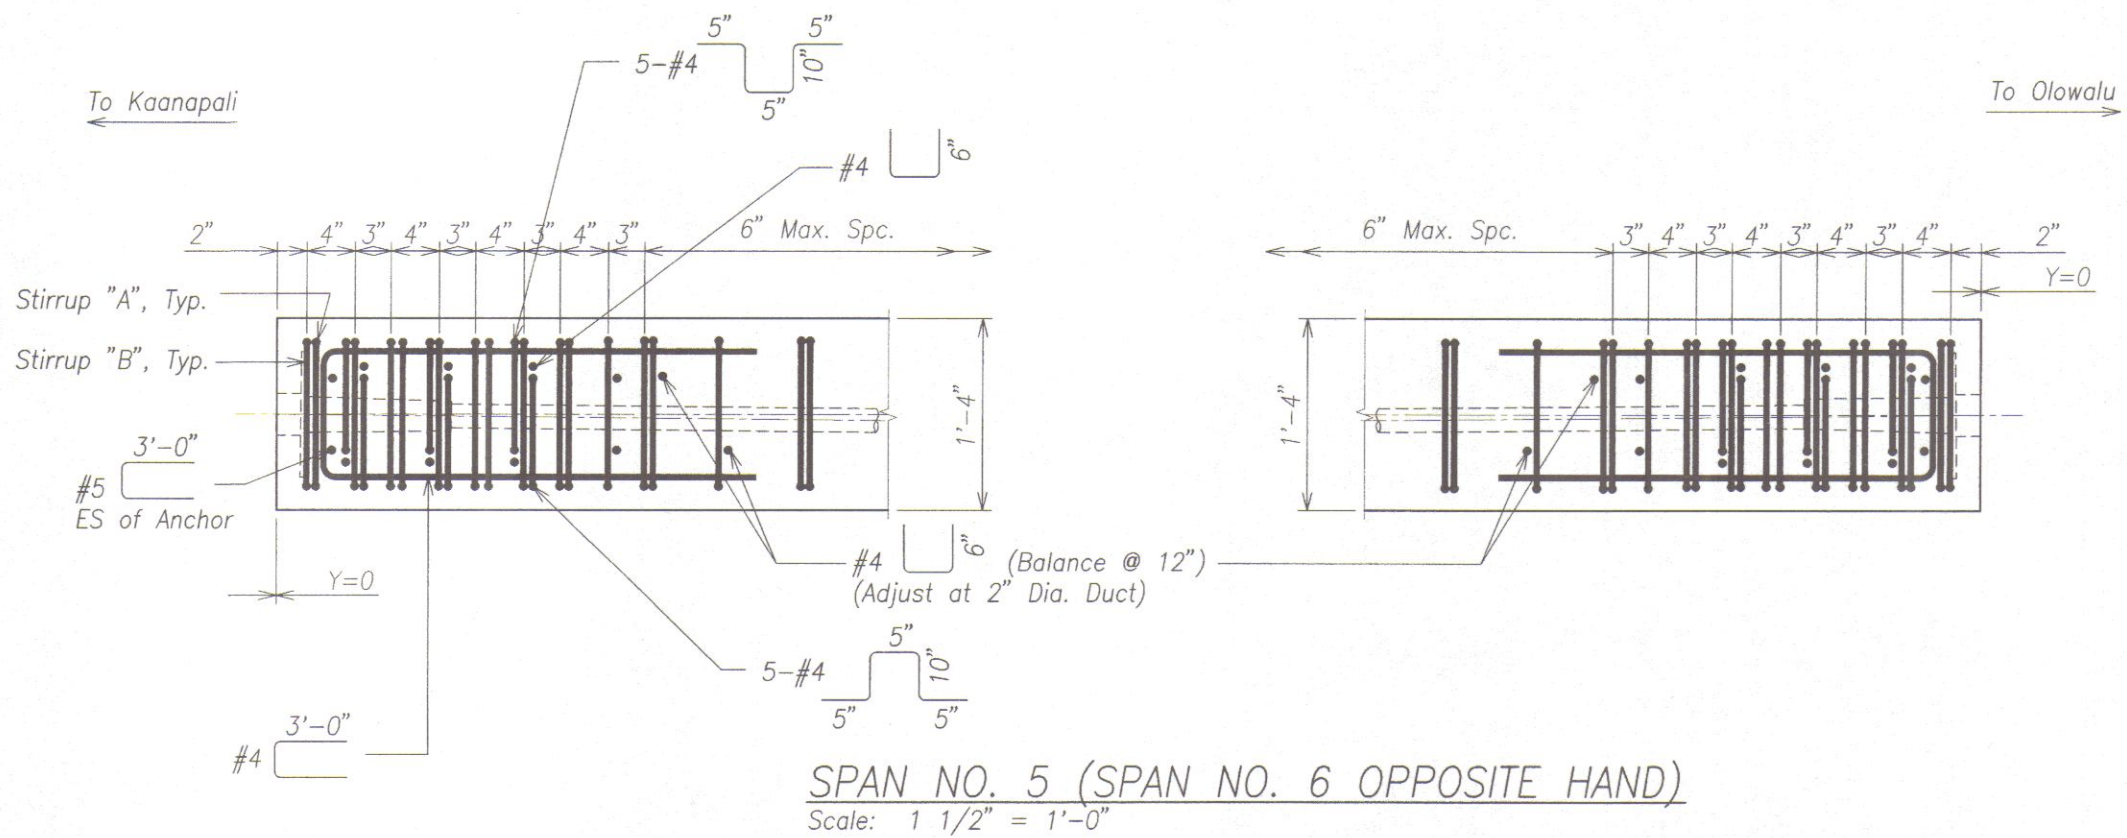

THIS WORK WAS PREPARED BY ME OR UNDER MY SUPERVISION.

David K. Fujiwara APRIL 30, 2012 LIC. EXP. DATE KSF, INC.

STATE OF HAWAII
DEPARTMENT OF TRANSPORTATION
HIGHWAYS DIVISION

PRECAST ARCH TIE PLANK

HONOAPIILANI HIGHWAY REALIGNMENT, PHASE 1A
Future Keawe St Extension to Lahainaluna Rd, Part B
Fed. Aid Proj. No. NH-030-1(35)R

Scale: As Noted Date: June, 2010


SHEET No. SB6.3 OF 6 SHEETS

FINAL DESIGN 301

ORIGINAL PLAN	DATE
NO. 1	...
NO. 2	...
NO. 3	...
NO. 4	...
NO. 5	...
NO. 6	...
NO. 7	...
NO. 8	...
NO. 9	...
NO. 10	...

DRAWING NAME: 21.00 ONGOING 40019.0-HONOAPIILANI LAHAINA BYPASS-KAHOMA WO 06-15-10 COMBINE LAHAINA FINAL DESIGN\H-SB602.DWG PLOT TIME: 06-14-10, 3:15 PM

FED. ROAD DIST. NO.	STATE	FED. AID PROJ. NO.	FISCAL YEAR	SHEET NO.	TOTAL SHEETS
HAWAII	HAW.	NH-030-1(35)R	2009	302	383

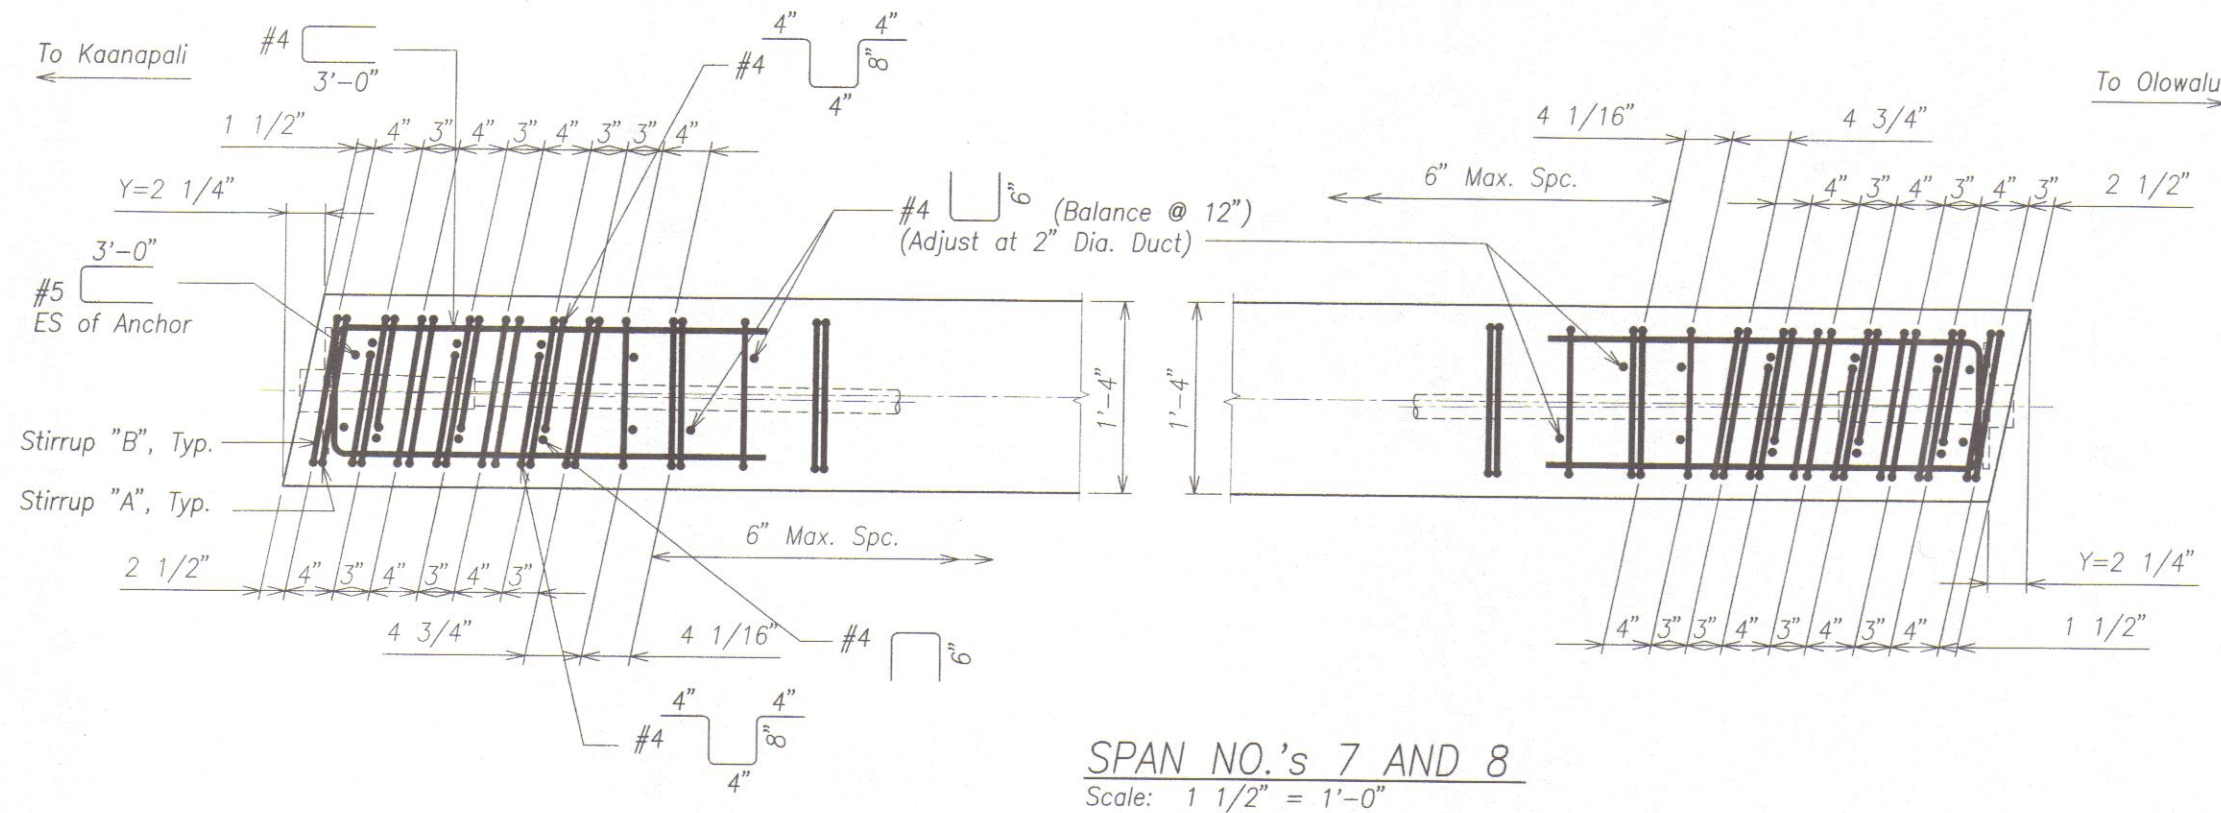

NOTE:
See Sht. SB6.5 for additional details.

SPAN NO.'s 7 AND 8
Scale: 1 1/2" = 1'-0"



THIS WORK WAS PREPARED BY ME
OR UNDER MY SUPERVISION.

David K. Ferguson APRIL 30, 2012
KSF, INC. LIC. EXP. DATE

STATE OF HAWAII
DEPARTMENT OF TRANSPORTATION
HIGHWAYS DIVISION

PRECAST ARCH TIE PLANK


HONOAPIILANI HIGHWAY REALIGNMENT, PHASE 1A
Future Keawe St Extension to Lahainaluna Rd, Part B
Fed. Aid Proj. No. NH-030-1(35)R

Scale: As Noted Date: June, 2010

SHEET No. SB6.4 OF 6 SHEETS


ORIGINAL PLAN	SURVEY PLOTTED BY _____ DATE _____
NOTE BOOK	DRAWN BY _____
	TRACED BY _____
	DESIGNED BY _____
	QUANTITIES BY _____
No. _____	CHECKED BY _____

DRAWING NAME: Z:\00 ONGOING\40019.0-HONOPILANI LAHAINA BYPASS-KAHOMA WO\06-15-10 COMBINE LAHAINA FINAL DESIGN\HH-SB602.DWG PLOT TIME: 06-14-10, 3:16 PM

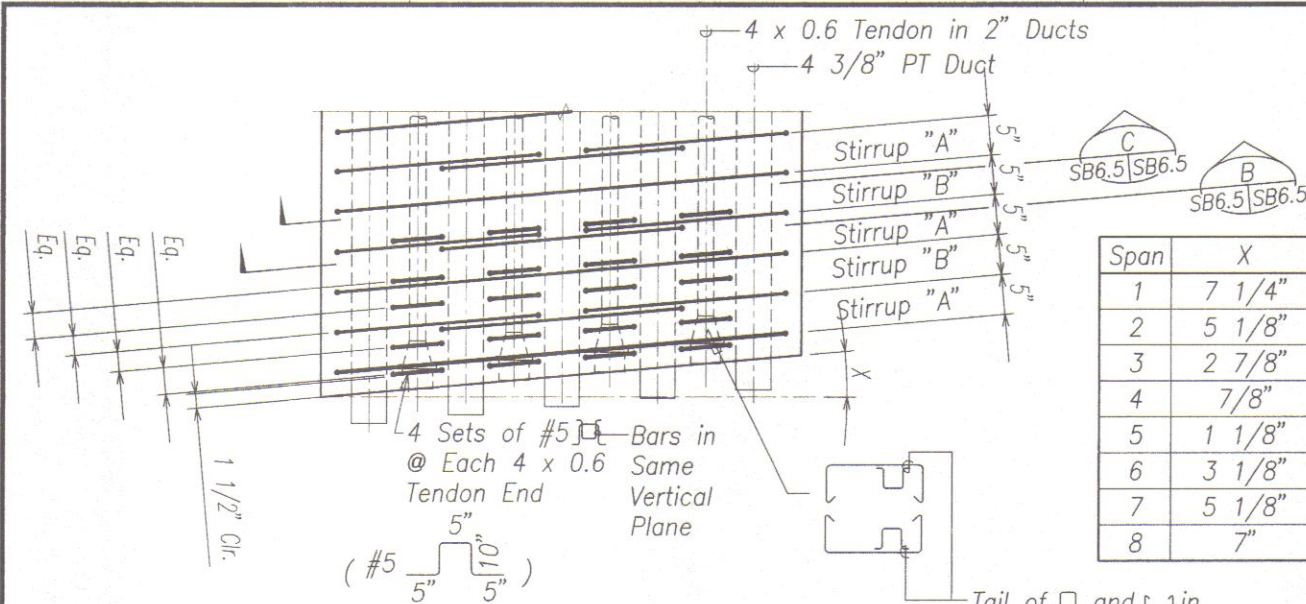


PLAN - TOP OF PLANK
Scale: 1" = 1'-0"


Span	X
1	7 1/4"
2	5 1/8"
3	2 7/8"
4	7/8"
5	1 1/8"
6	3 1/8"
7	5 1/8"
8	7"

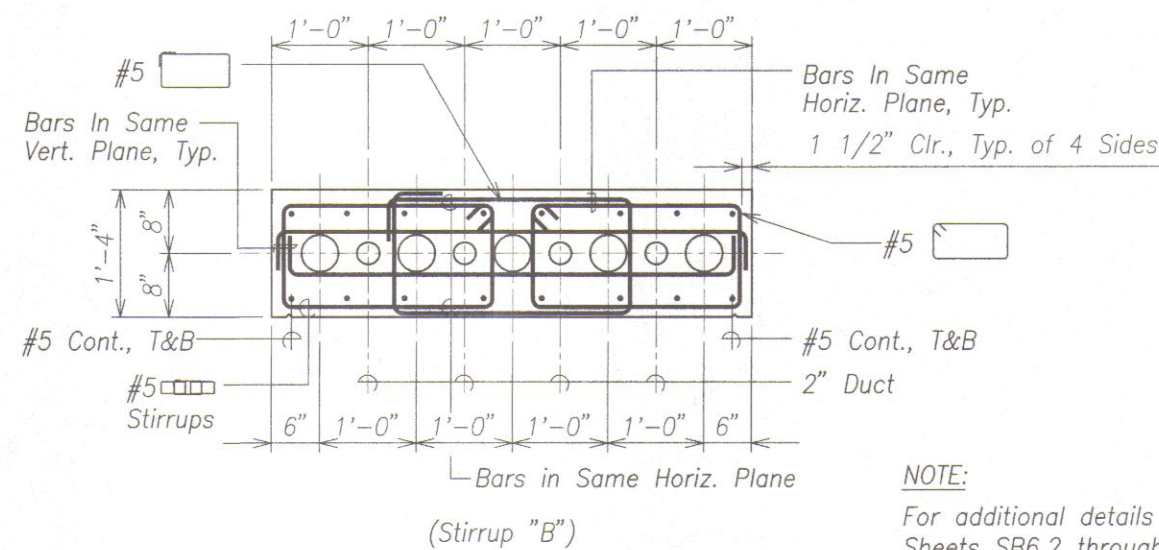


SECTION B
Scale: 1" = 1'-0" SB6.5 SB6.5

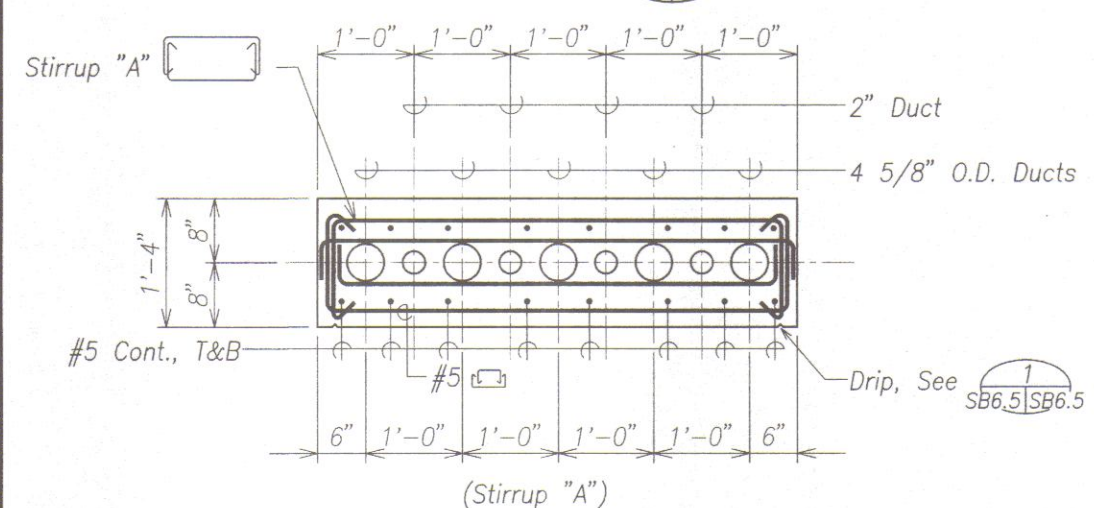


SECTION C
Scale: 1" = 1'-0" SB6.5 SB6.5

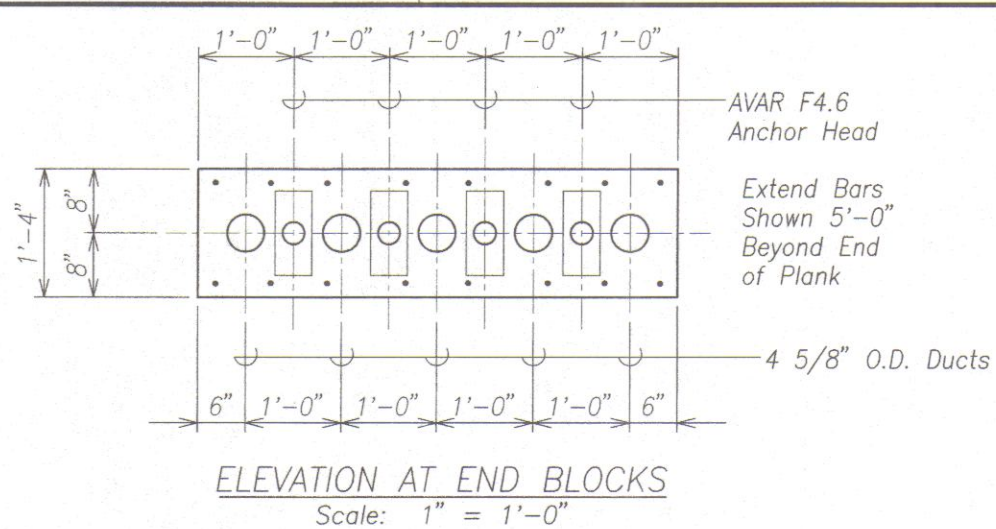

ELEVATION AT END BLOCKS
Scale: 1" = 1'-0"

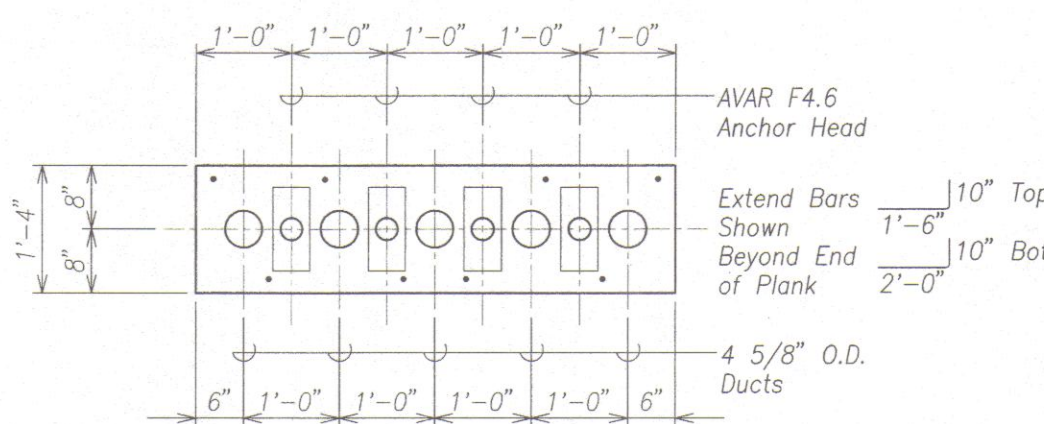


ALT. "A" ELEVATION AT STIFFENER BEAM
Scale: 1" = 1'-0"

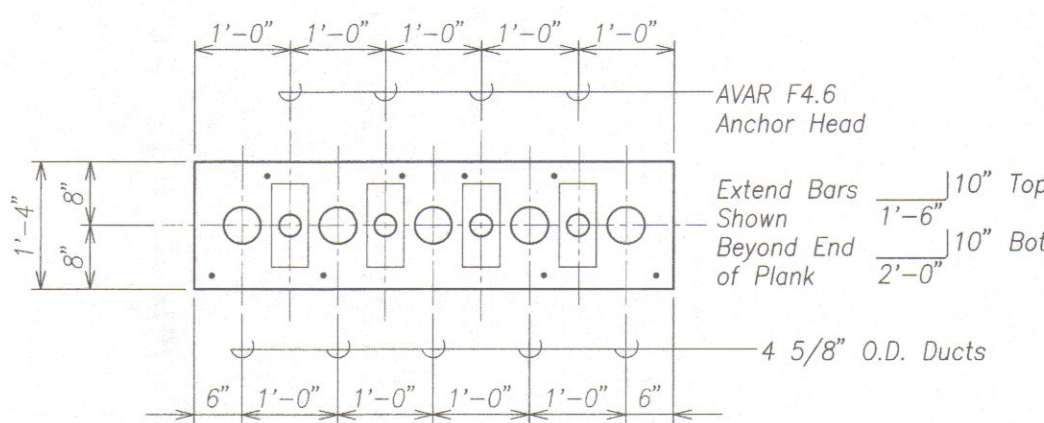

ALT. "B" ELEVATION AT STIFFENER BEAM
Scale: 1" = 1'-0"

ELEVATION OF ARCH TIE PLANK ENDS
Scale: 1" = 1'-0" SB6.5 SB6.5

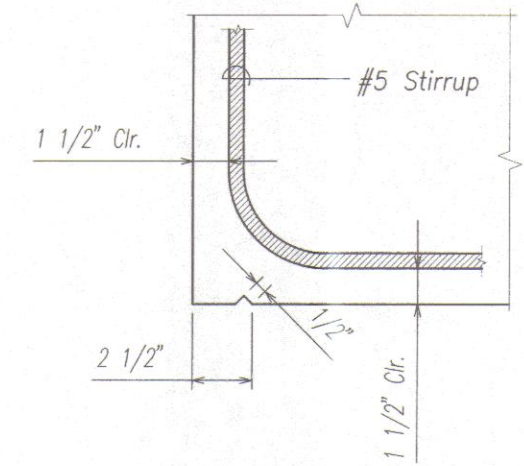

DRIP DETAIL FOR PLANK
Scale: 3" = 1'-0" SB6.5 SB6.5

- NOTES:**
1. Post Tensioning Ducts shall be supported horizontally and vertically at intervals not exceeding 4'-ft.
 2. Alternate Stirrups "A" and "B".
 3. Stirrups "A" and "B" are #5 bars.
 4. Coordinate Alt. "A" and Alt. "B" ends at Stiffener Beams.
 5. 4 5/8" OD Ducts shown are for PATP lines 1-3, see Sheet SB15.1.



THIS WORK WAS PREPARED BY ME OR UNDER MY SUPERVISION.
David K. Fujimura
KSF, INC. APRIL 30, 2012 U.C. EXP. DATE

STATE OF HAWAII
DEPARTMENT OF TRANSPORTATION
HIGHWAYS DIVISION

PRECAST ARCH TIE PLANK

HONOAPIILANI HIGHWAY REALIGNMENT, PHASE 1A
Future Keawe St Extension to Lahainaluna Rd, Part B
Fed. Aid Proj. No. NH-030-1(35)R

Scale: As Noted Date: June, 2010

SHEET No. SB6.5 OF 6 SHEETS

SURVEY PLOTTED BY: DATE: _____
DRAWN BY: _____
CHECKED BY: _____
NOTE BOOK: _____
No. _____

DRAWING NAME: 2:00 ONGOING 40019 D-HONOAPIILANI LAHAINA BYPASS-KAHOMA RD 06-15-10 COMBINE LAHAINA FINAL DESIGN HH-SB605.DWG PLOT TIME: 06-14-10, 3:16 PM

PRECAST ARCH TIE PLANK NOTES:

FED. ROAD DIST. NO.	STATE	FED. AID PROJ. NO.	FISCAL YEAR	SHEET NO.	TOTAL SHEETS
HAWAII	HAW.	NH-030-1(35)R	2009	304	383

1. Ducts for Continuous Tendons are at a constant elevation (at mid-depth of PATP). See Sheet SB15.1 for information on Continuous Tendons.
2. Post-Tensioning Ducts for 4x0.6 Tendons shall be 2" O.D. Spiro-Type Semi-Rigid galvanized.
3. After post-tensioning, Tendons shall be pressure grouted w/ Masterflow 1205 Cable Grout or Sika Grout 300 PT or equal. Ducts shall have grouting vents at anchorage and at each high point along the Tendon profile.
4. Duct shall be secured to prevent misalignment during concreting.
Post-Tensioning Ducts shall be supported horizontally and vertically at intervals not exceeding 4-ft.
5. A minimum compressive strength of 8000 PSI shall be obtained in the PATP before the application of post-tensioning.
6. Post-Tensioned Strands shall be 7 wire 0.6 dia. low relaxation steel strands (Area = 0.217 in.²) with an ultimate tensile strength of 270 ksi. For properties, see "Special Provisions".
7. The Post-Tensioning design assumptions are as follows:

Curve Friction Coefficient	0.18
Wobble Friction Coefficient	0.0002/ft.
Anchor Set	3/8"
8. The design jacking force at end of each 4x0.6 Tendon = 175K. The maximum stress in the Strand before anchor set in is 75% of the guaranteed ultimate strength.
9. Post-Tensioning Anchor for 4x0.6 PATP Tendons shall be AVAR F4.6 or equal.
10. All Anchor Heads and protruding Strands shall be coated with CORTEC VpCI 391.

ORIGINAL PLAN	SURVEY PLOTTED BY	DATE
NOTE BOOK	DRAWN BY	
No.	TRACED BY	
	DESIGNED BY	
	QUANTITIES BY	
	CHECKED BY	

DRAWING NAME: Z:\00 ONGOING\40019.0-HONOAPIILANI LAHANA BYPASS-KAHOWA WD\06-15-10 COMBINE LAHANA FINAL DESIGN\HH-SB606.DWG PLOT TIME: 06-14-10, 3:17 PM




THIS WORK WAS PREPARED BY ME
OR UNDER MY SUPERVISION.

David K. Fujimura APRIL 30, 2012
KSF, INC. LIC. EXP. DATE

STATE OF HAWAII DEPARTMENT OF TRANSPORTATION HIGHWAYS DIVISION	
PRECAST ARCH TIE PLANK NOTES	
HONOAPIILANI HIGHWAY REALIGNMENT, PHASE 1A Future Keawe St Extension to Lahainaluna Rd, Part B Fed. Aid Proj. No. NH-030-1(35)R	
Scale: As Noted	Date: June, 2010
SHEET No. SB6.6 OF 6 SHEETS	

FINAL DESIGN 304

FED. ROAD DIST. NO.	STATE	FED. AID PROJ. NO.	FISCAL YEAR	SHEET NO.	TOTAL SHEETS
HAWAII	HAW.	NH-030-1(35)R	2009	305	383

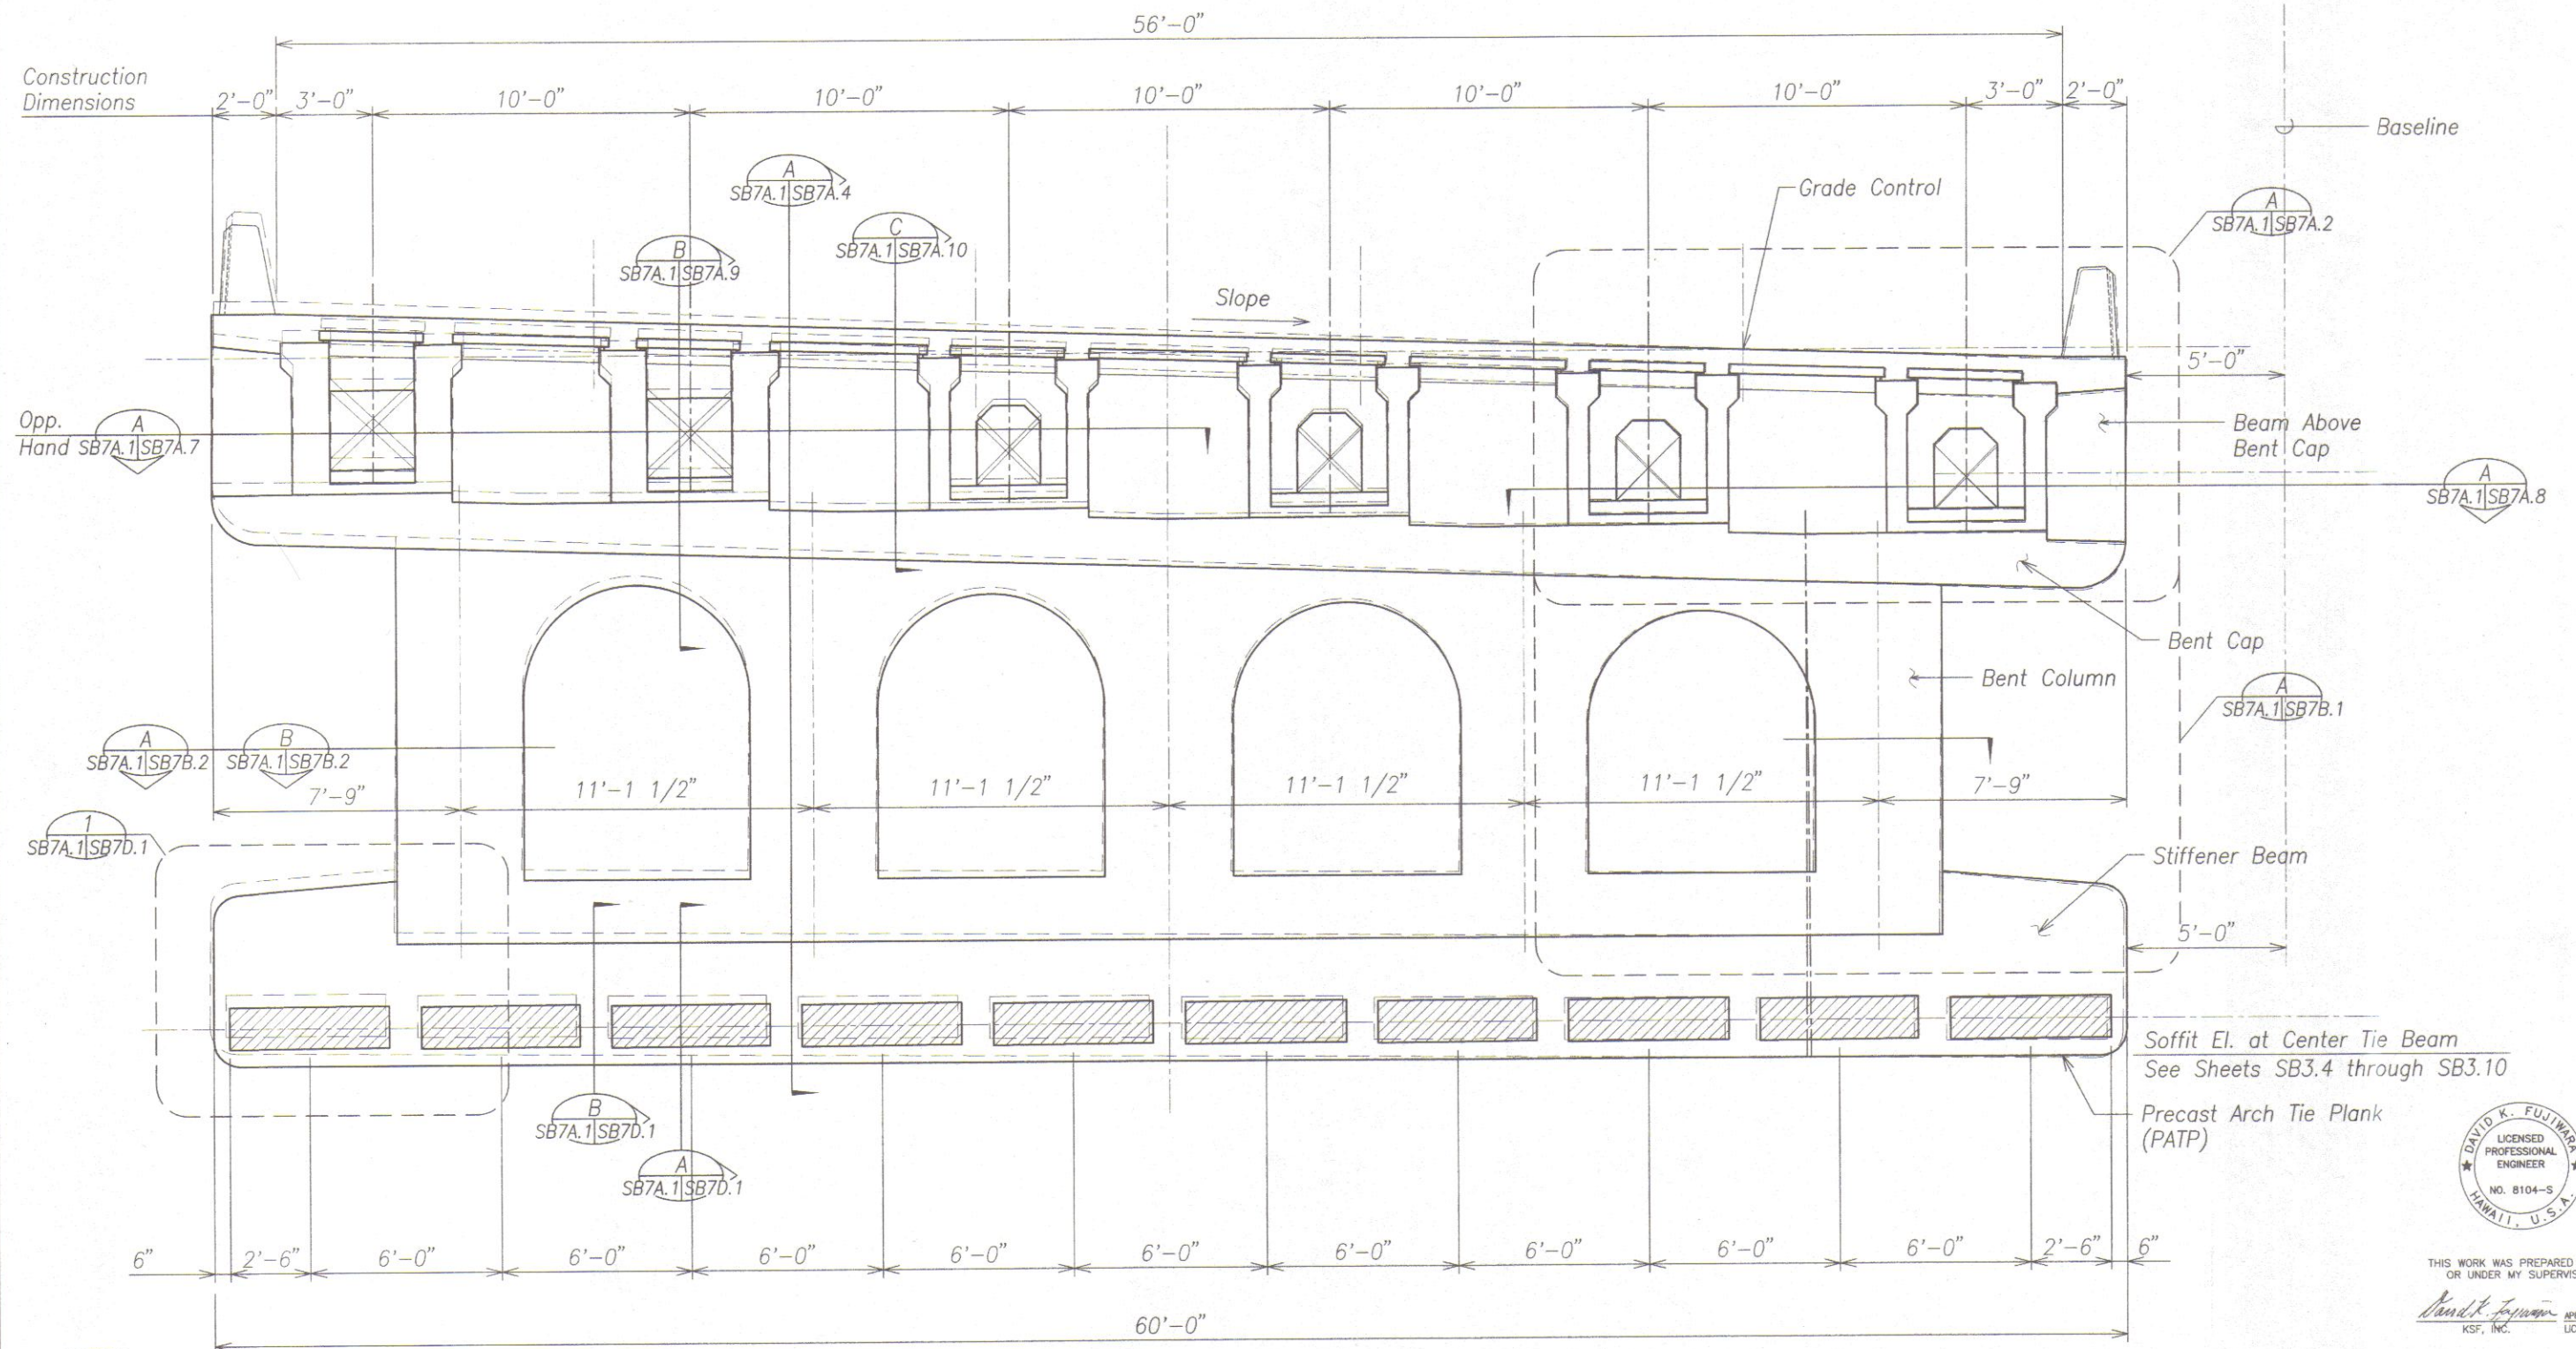

NOTES:

1. See Sheet SB7A Series for Beam above Bent Cap.
2. See Sheet SB7C Series for Bent Cap.
3. See Sheet SB7B Series for Bent.
4. See Sheet SB7D Series for Stiffener Beam.
5. See Sheet SB7B Series for PATP.

LEGEND:

- Construction Phase
- Final Design

MAUKA BRIDGE (OUT-BOUND)

TYPICAL BENT ELEVATION

Scale: 3/8" = 1'-0"

SB7A.1/SB7A.1

STATE OF HAWAII
DEPARTMENT OF TRANSPORTATION
HIGHWAYS DIVISION

TYPICAL BENT ELEVATION

HONOAPIILANI HIGHWAY REALIGNMENT, PHASE 1A
Future Keawe St Extension to Lahainaluna Rd, Part B
Fed. Aid Proj. No. NH-030-1(35)R


Scale: As Noted Date: June, 2010
SHEET No. SB7A.1 OF 10 SHEETS

FINAL DESIGN 305

SURVEY PLOTTED BY	DATE
DRAWN BY	
TRACED BY	
NOTE BOOK	
QUANTITIES BY	
CHECKED BY	
No.	

DRAWING NAME: Z:\00 ONGOING\40019.0-HONOAPIILANI LAHAINA BYPASS-KAHOMA WOL06-15-10 COMBINE LAHAINA FINAL DESIGN\HH-SB7001.DWG PLOT TIME: 06-14-10, 3:18 PM

FED. ROAD DIST. NO.	STATE	FED. AID PROJ. NO.	FISCAL YEAR	SHEET NO.	TOTAL SHEETS
HAWAII	HAW.	NH-030-1(35)R	2009	306	383

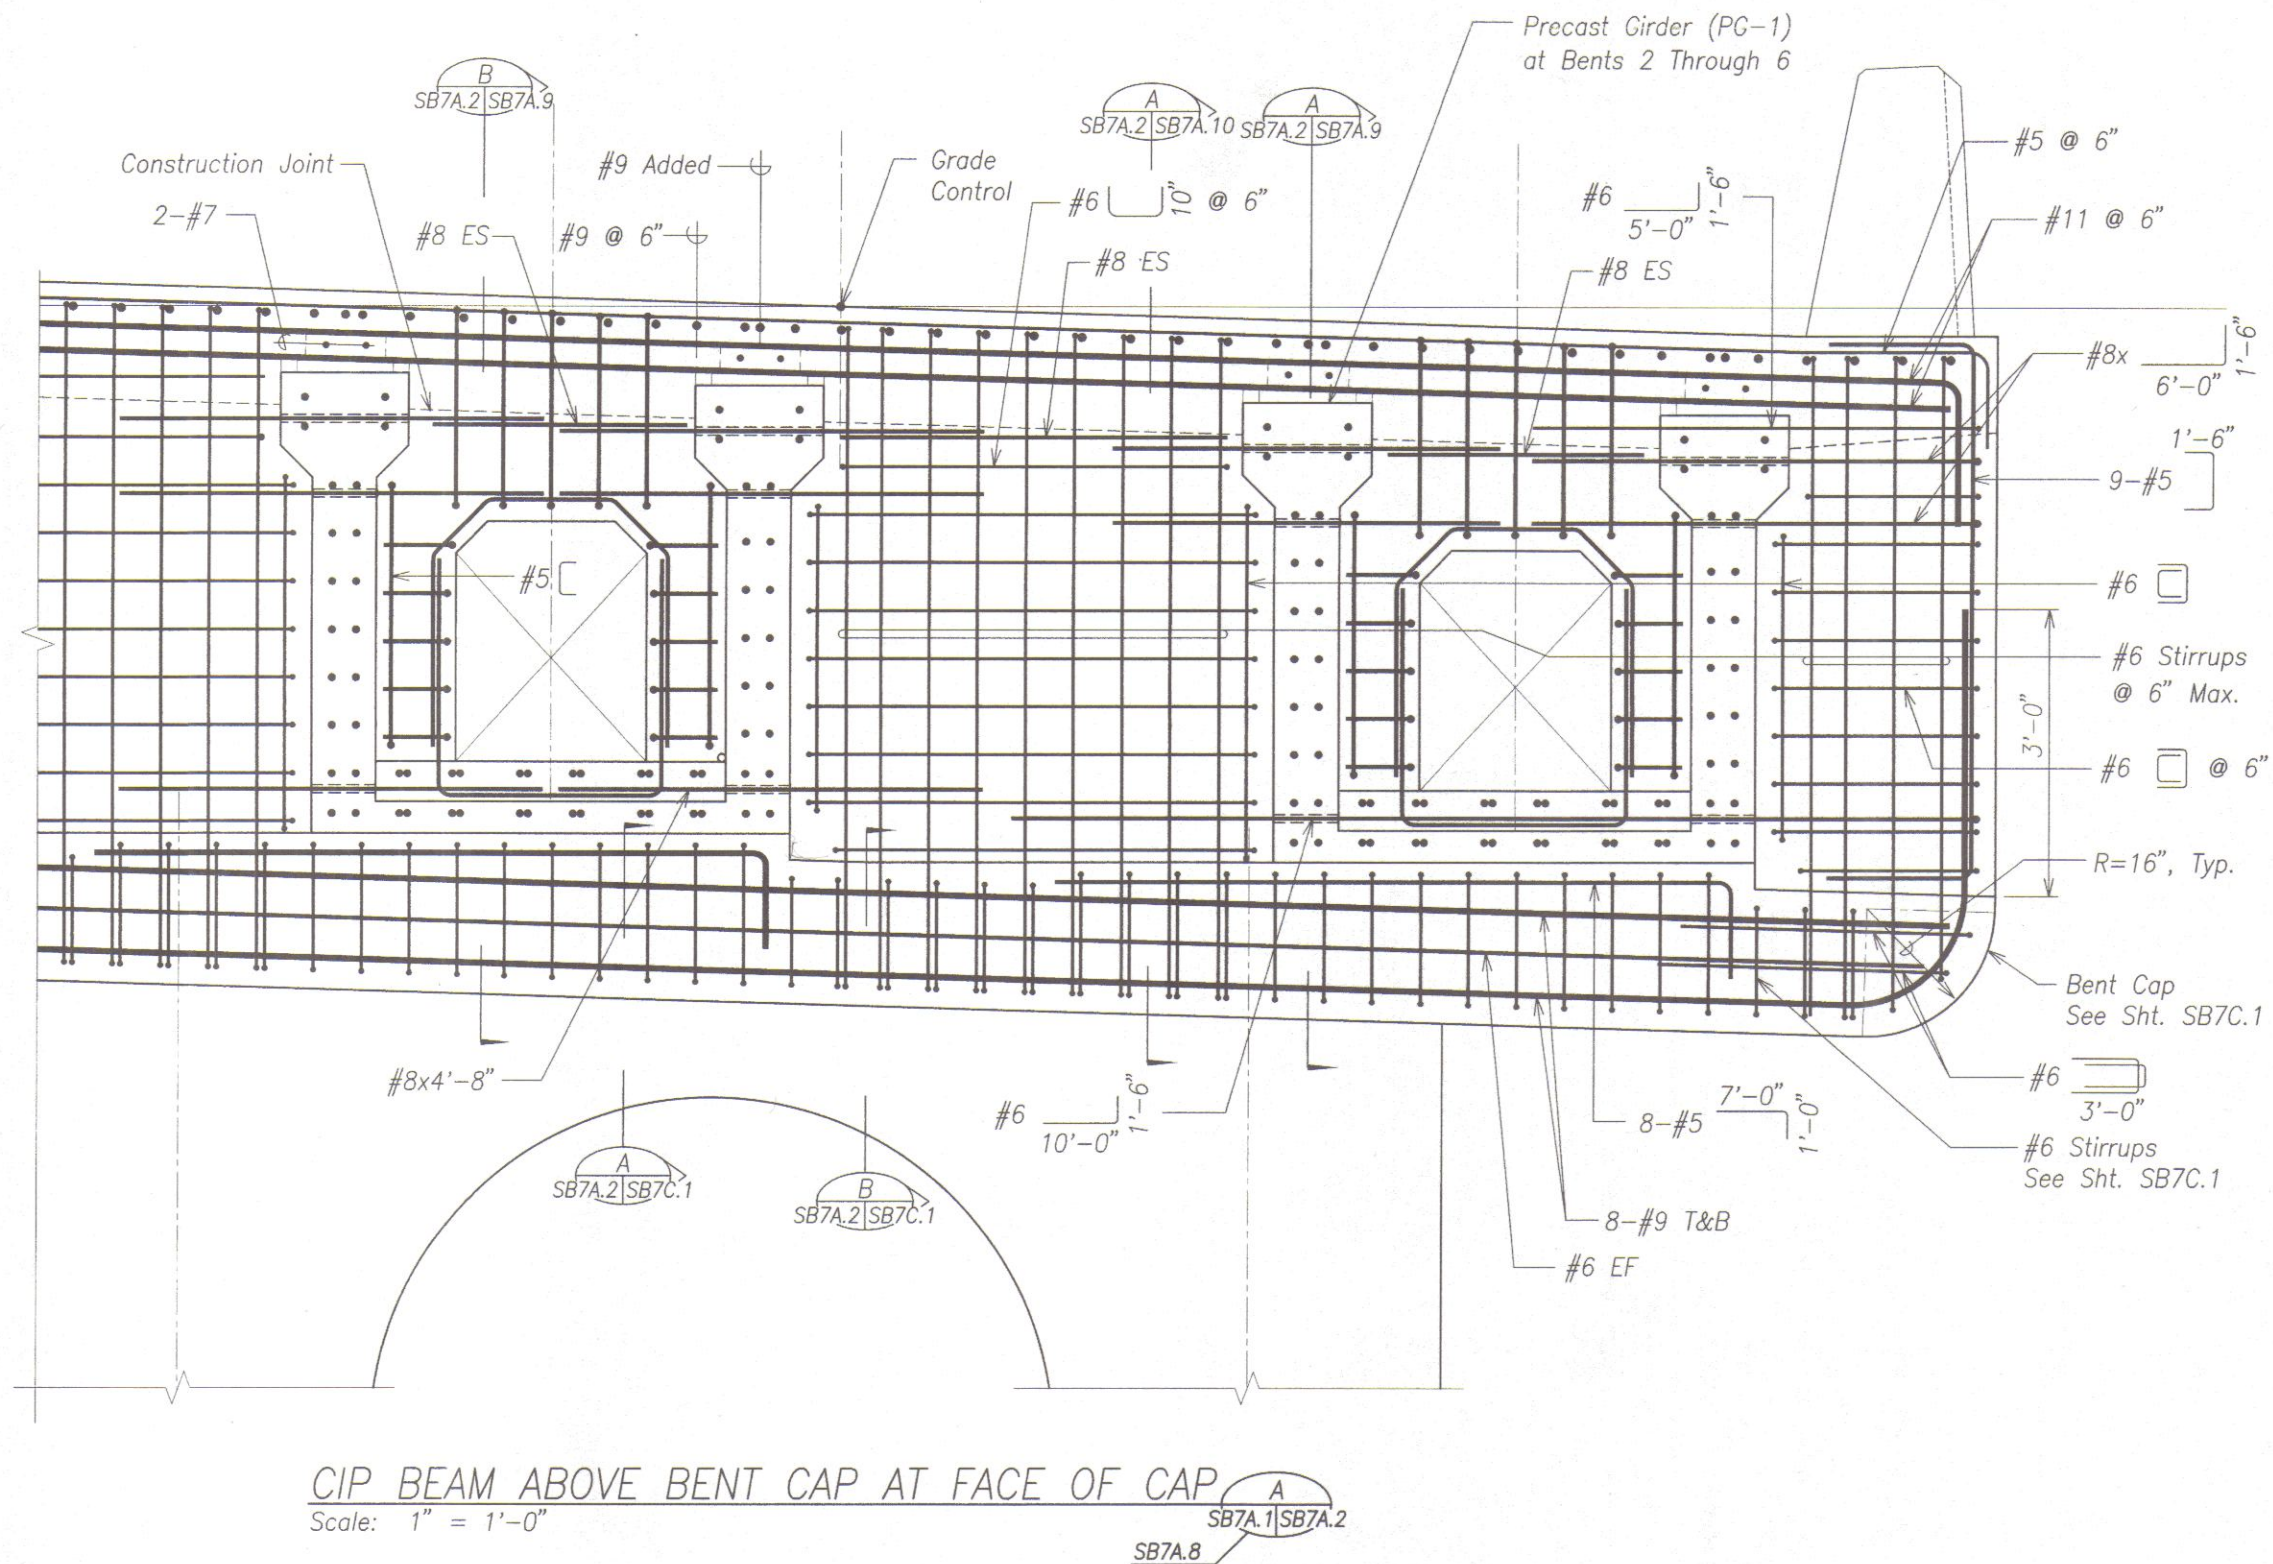

CIP BEAM ABOVE BENT CAP AT FACE OF CAP
Scale: 1" = 1'-0"

CAP

A

SB7A.1 | SB7A.2

SB7A.8



THIS WORK WAS PREPARED BY ME
OR UNDER MY SUPERVISION.

Daniel K. Fagowski APRIL 30, 2012
KSF, INC. LIC. EXP. DATE

STATE OF HAWAII
DEPARTMENT OF TRANSPORTATION
HIGHWAYS DIVISION

CIP BEAM ABOVE BENT CAP

HONOAPIILANI HIGHWAY REALIGNMENT, PHASE 1A
Future Keawe St Extension to Lahainaluna Rd, Part B
Fed. Aid Proj. No. NH-030-1(35)R

Scale: As Noted Date: June, 2010


SHEET No. SB7A.2 OF 10 SHEETS

FINAL DESIGN 306

ORIGINAL PLAN	SURVEY PLOTTED BY _____	DATE _____
NOTE BOOK	DRAWN BY _____	_____
	TRACED BY _____	_____
	DESIGNED BY _____	_____
	QUANTITIES BY _____	_____
No. _____	CHECKED BY _____	_____

DRAWING NAME: Z:\00 ONGOING\40019.0-HONDA\PILANI LAHAINA BYPASS-KAHOMA WO\06-15-10 COMBINE LAHAINA FINAL DESIGN\HH-SB700A2.DWG PLOT TIME: 06-14-10, 3:18 PM)

FED. ROAD DIST. NO.	STATE	FED. AID PROJ. NO.	FISCAL YEAR	SHEET NO.	TOTAL SHEETS
HAWAII	HAW.	NH-030-1(35)R	2009	307	383

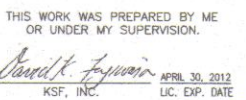

STATE OF HAWAII
DEPARTMENT OF TRANSPORTATION
HIGHWAYS DIVISION

CIP BEAM ABOVE BENT CAP

HONOAPIILANI HIGHWAY REALIGNMENT, PHASE 1A
Future Keawe St Extension to Lahainaluna Rd, Part B
Fed. Aid Proj. No. NH-030-1(35)R

Scale: As Noted Date: June, 2010


SHEET No. SB7A.3 OF 10 SHEETS

FINAL DESIGN 307

ORIGINAL PLAN	SURVEY PLOTTED BY _____	DATE _____
NOTE BOOK	DRAWN BY _____	" _____
	TRACED BY _____	" _____
	DESIGNED BY _____	" _____
	QUANTITIES BY _____	" _____
No.	CHECKED BY _____	" _____

DRAWING NAME: Z:\00 ONGOING\40019.0-HONOAPILANI LAHAINA BYPASS-KAHOMA WO\06-15-10 COMBINE LAHAINA FINAL DESIGN\HH-SB700A2.DWG PLOT TIME: 06-14-10, 3:18 PM)

FED. ROAD DIST. NO.	STATE	FED. AID PROJ. NO.	FISCAL YEAR	SHEET NO.	TOTAL SHEETS
HAWAII	HAW.	NH-030-1(35)R	2009	308	383

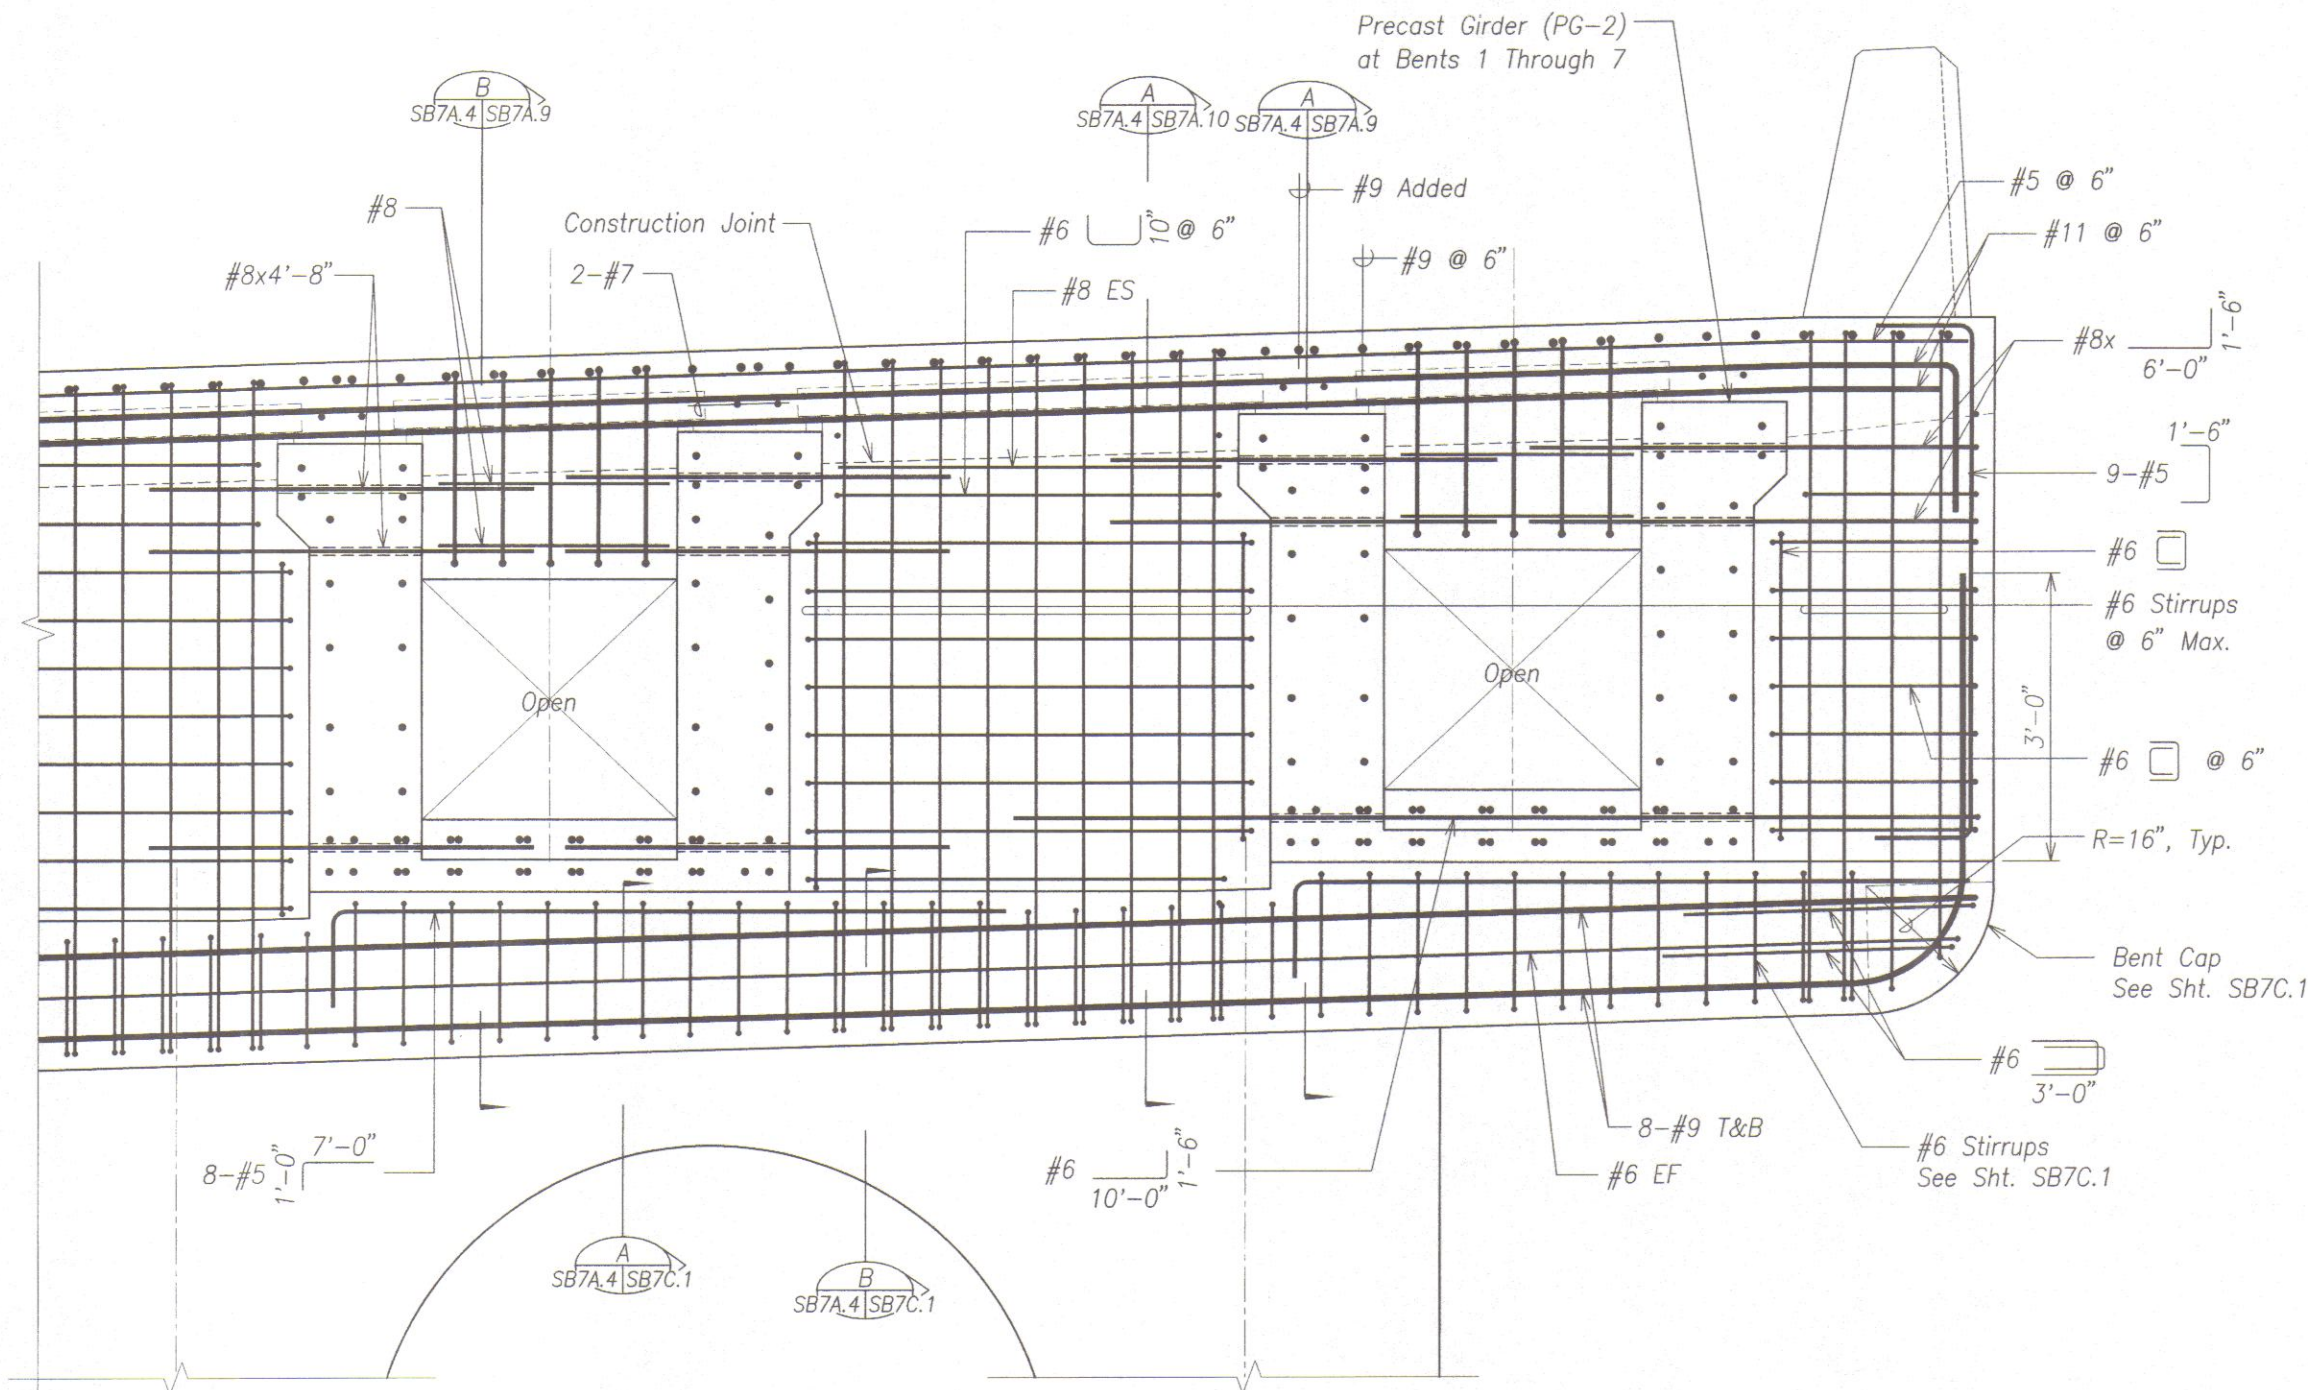

CIP BEAM ABOVE BENT CAP AT FACE OF CAP
Scale: 1" = 1'-0"



THIS WORK WAS PREPARED BY ME
OR UNDER MY SUPERVISION.

David K. Fujiwara
KSF, INC. APRIL 30, 2012
LIC. EXP. DATE

STATE OF HAWAII
DEPARTMENT OF TRANSPORTATION
HIGHWAYS DIVISION

CIP BEAM ABOVE BENT CAP

HONOAPIILANI HIGHWAY REALIGNMENT, PHASE 1A
Future Keawe St Extension to Lahainaluna Rd, Part B
Fed. Aid Proj. No. NH-030-1(35)R

Scale: As Noted Date: June, 2010


SHEET No. SB7A.4 OF 10 SHEETS

FINAL DESIGN 308

ORIGINAL PLAN	SURVEY PLOTTED BY	DATE
NOTE BOOK	DRAWN BY	
No.	DESIGNED BY	
	CHECKED BY	

DRAWING NAME: 2:100 ONGOING 40019.0-HONOAPIILANI LAHAINA BYPASS-KAHOMA WO 06-15-10 COMBINE LAHAINA FINAL DESIGN (HH-SB70042.DWG) PLOT TIME: 06-14-10, 3:19 PM

FED. ROAD DIST. NO.	STATE	FED. AID PROJ. NO.	FISCAL YEAR	SHEET NO.	TOTAL SHEETS
HAWAII	HAW.	NH-030-1(35)R	2009	309	383

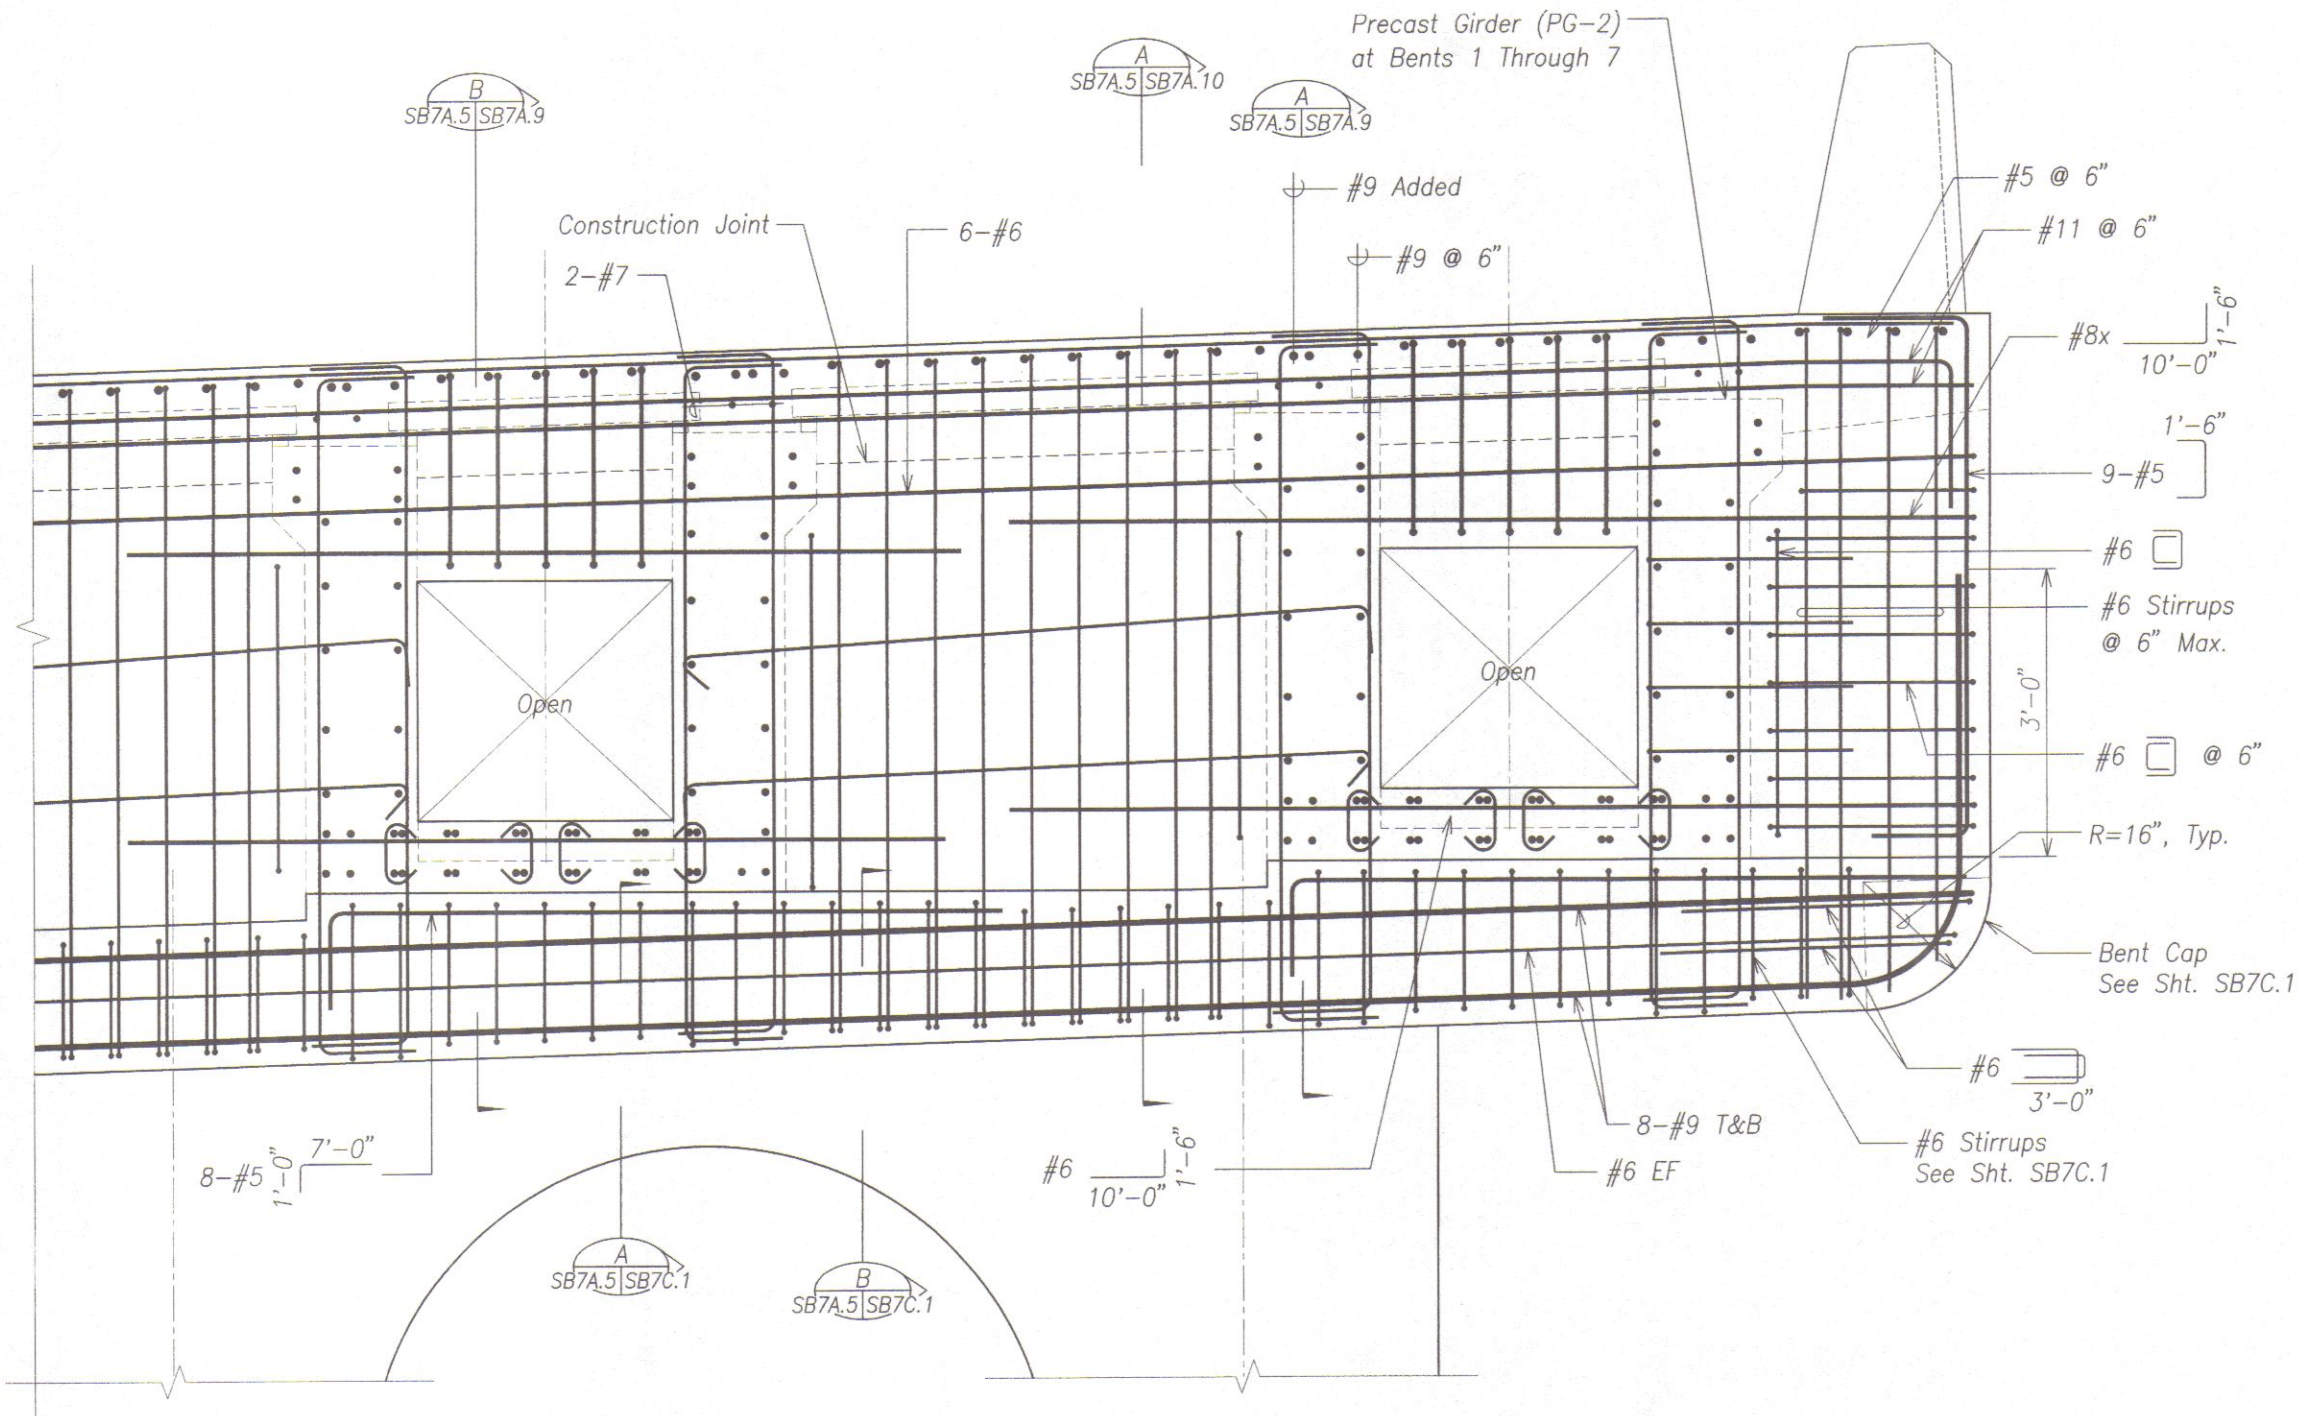

CIP BEAM ABOVE BENT CAP THRU $\oslash$ BENT $\frac{A}{SB7A.1|SB7A.5}$
Scale: 1" = 1'-0"



THIS WORK WAS PREPARED BY ME
OR UNDER MY SUPERVISION.
David K. Fujiwara APRIL 30, 2012
KSF, INC. LIC. EXP. DATE

STATE OF HAWAII
DEPARTMENT OF TRANSPORTATION
HIGHWAYS DIVISION

CIP BEAM ABOVE BENT CAP

HONOAPIILANI HIGHWAY REALIGNMENT, PHASE 1A
Future Keawe St Extension to Lahainaluna Rd, Part B
Fed. Aid Proj. No. NH-030-1(35)R


Scale: As Noted Date: June, 2010

SHEET No. SB7A.5 OF 10 SHEETS

ORIGINAL PLAN	SURVEY PLOTTED BY	DATE
NOTE BOOK	DRAWN BY	
No.	DESIGNED BY	
	CHECKED BY	

DRAWING NAME: Z:\00 ONGOING\40019.0-HONOAPIILANI LAHAINA BYPASS-KAHOMA W\06-15-10 COMBINE LAHAINA FINAL DESIGN\HH-SB700A2.DWG PLOT TIME: 06-14-10, 3:19 PM

FED. ROAD DIST. NO.	STATE	FED. AID PROJ. NO.	FISCAL YEAR	SHEET NO.	TOTAL SHEETS
HAWAII	HAW.	NH-030-1(35)R	2009	310	383

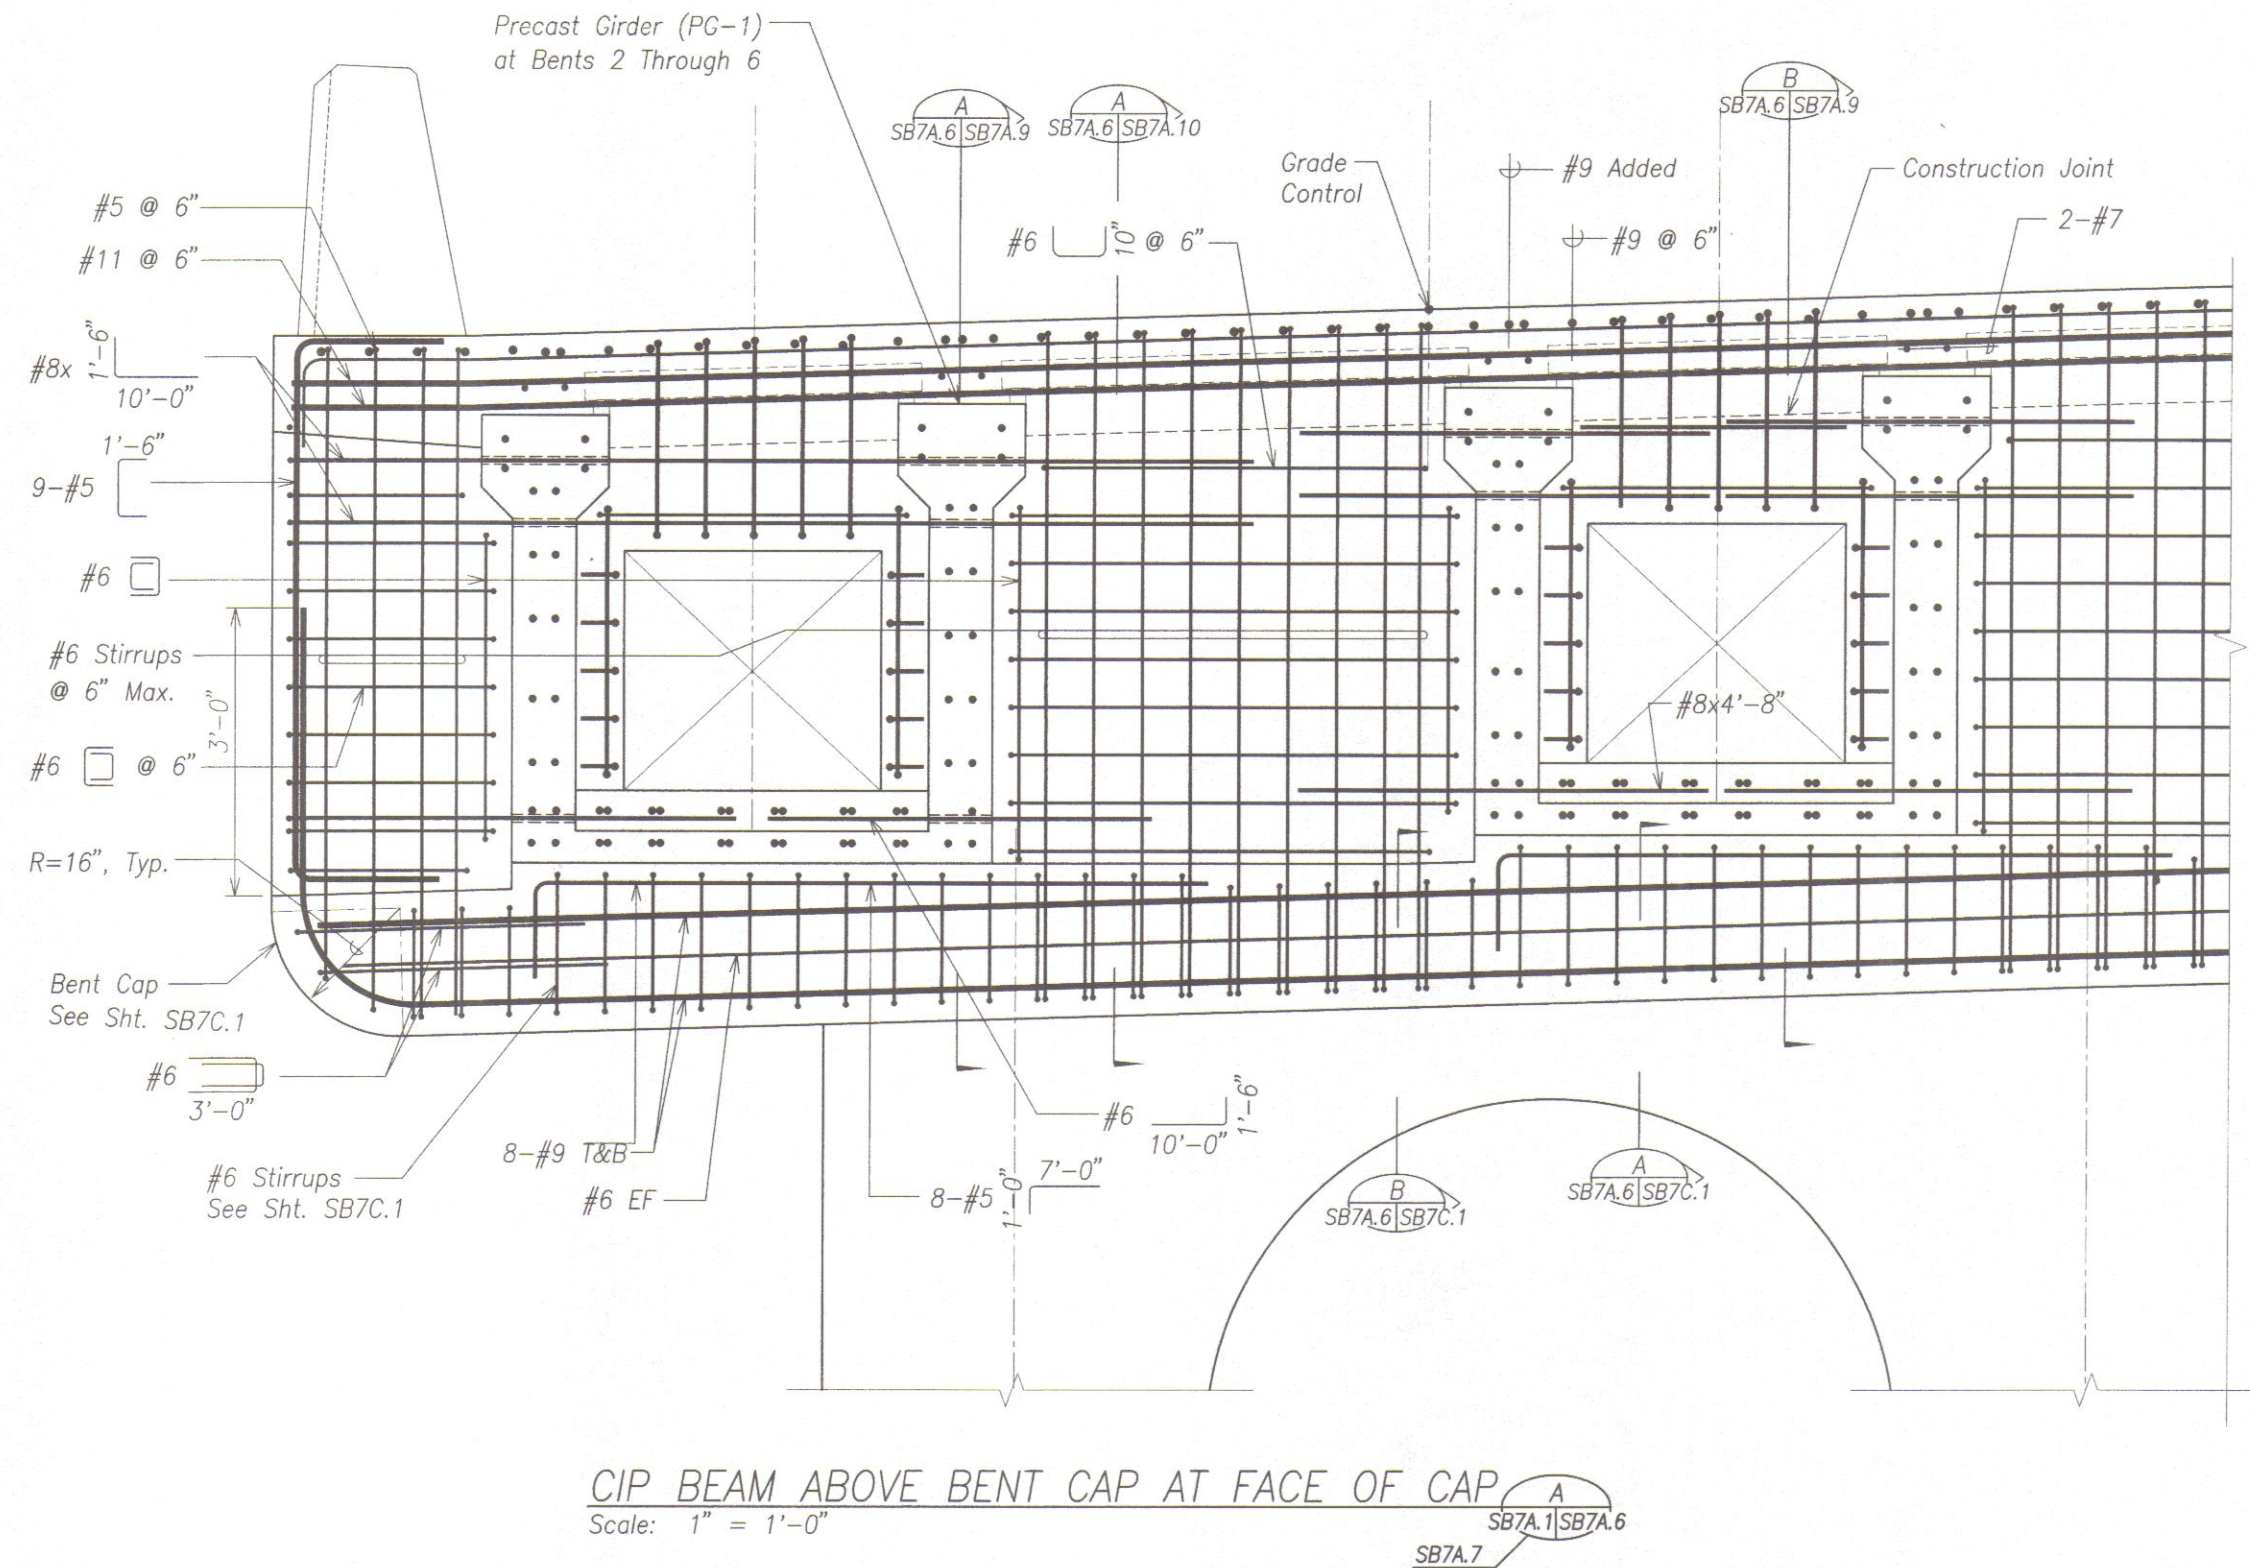

THIS WORK WAS PREPARED BY ME
OR UNDER MY SUPERVISION.

David K. Fujiwara
KSF, W.C. APRIL 30, 2012
LIC. EXP. DATE

STATE OF HAWAII
DEPARTMENT OF TRANSPORTATION
HIGHWAYS DIVISION

CIP BEAM ABOVE BENT CAP

HONOAPIILANI HIGHWAY REALIGNMENT, PHASE 1A
Future Keawe St Extension to Lahainaluna Rd, Part B
Fed. Aid Proj. No. NH-030-1(35)R

Scale: As Noted Date: June, 2010


SHEET No. SB7A.6 OF 10 SHEETS

FINAL DESIGN 310

ORIGINAL PLAN	DATE
SURVEY PLOTTED BY	
DESIGNED BY	
TRACED BY	
NOTE BOOK	
DESIGNED BY	
QUANTITIES BY	
CHECKED BY	
No.	

DRAWING NAME: Z:\00 ONGOING\40019.0-HONOAPIILANI LAHAINA BYPASS-KAHOMA WC\06-15-10 COMBINE LAHAINA FINAL DESIGN\NH-SB70042.DWG PLOT TIME: 06-14-10, 3:19 PM

FED. ROAD DIST. NO.	STATE	FED. AID PROJ. NO.	FISCAL YEAR	SHEET NO.	TOTAL SHEETS
HAWAII	HAW.	NH-030-1(35)R	2009	311	383

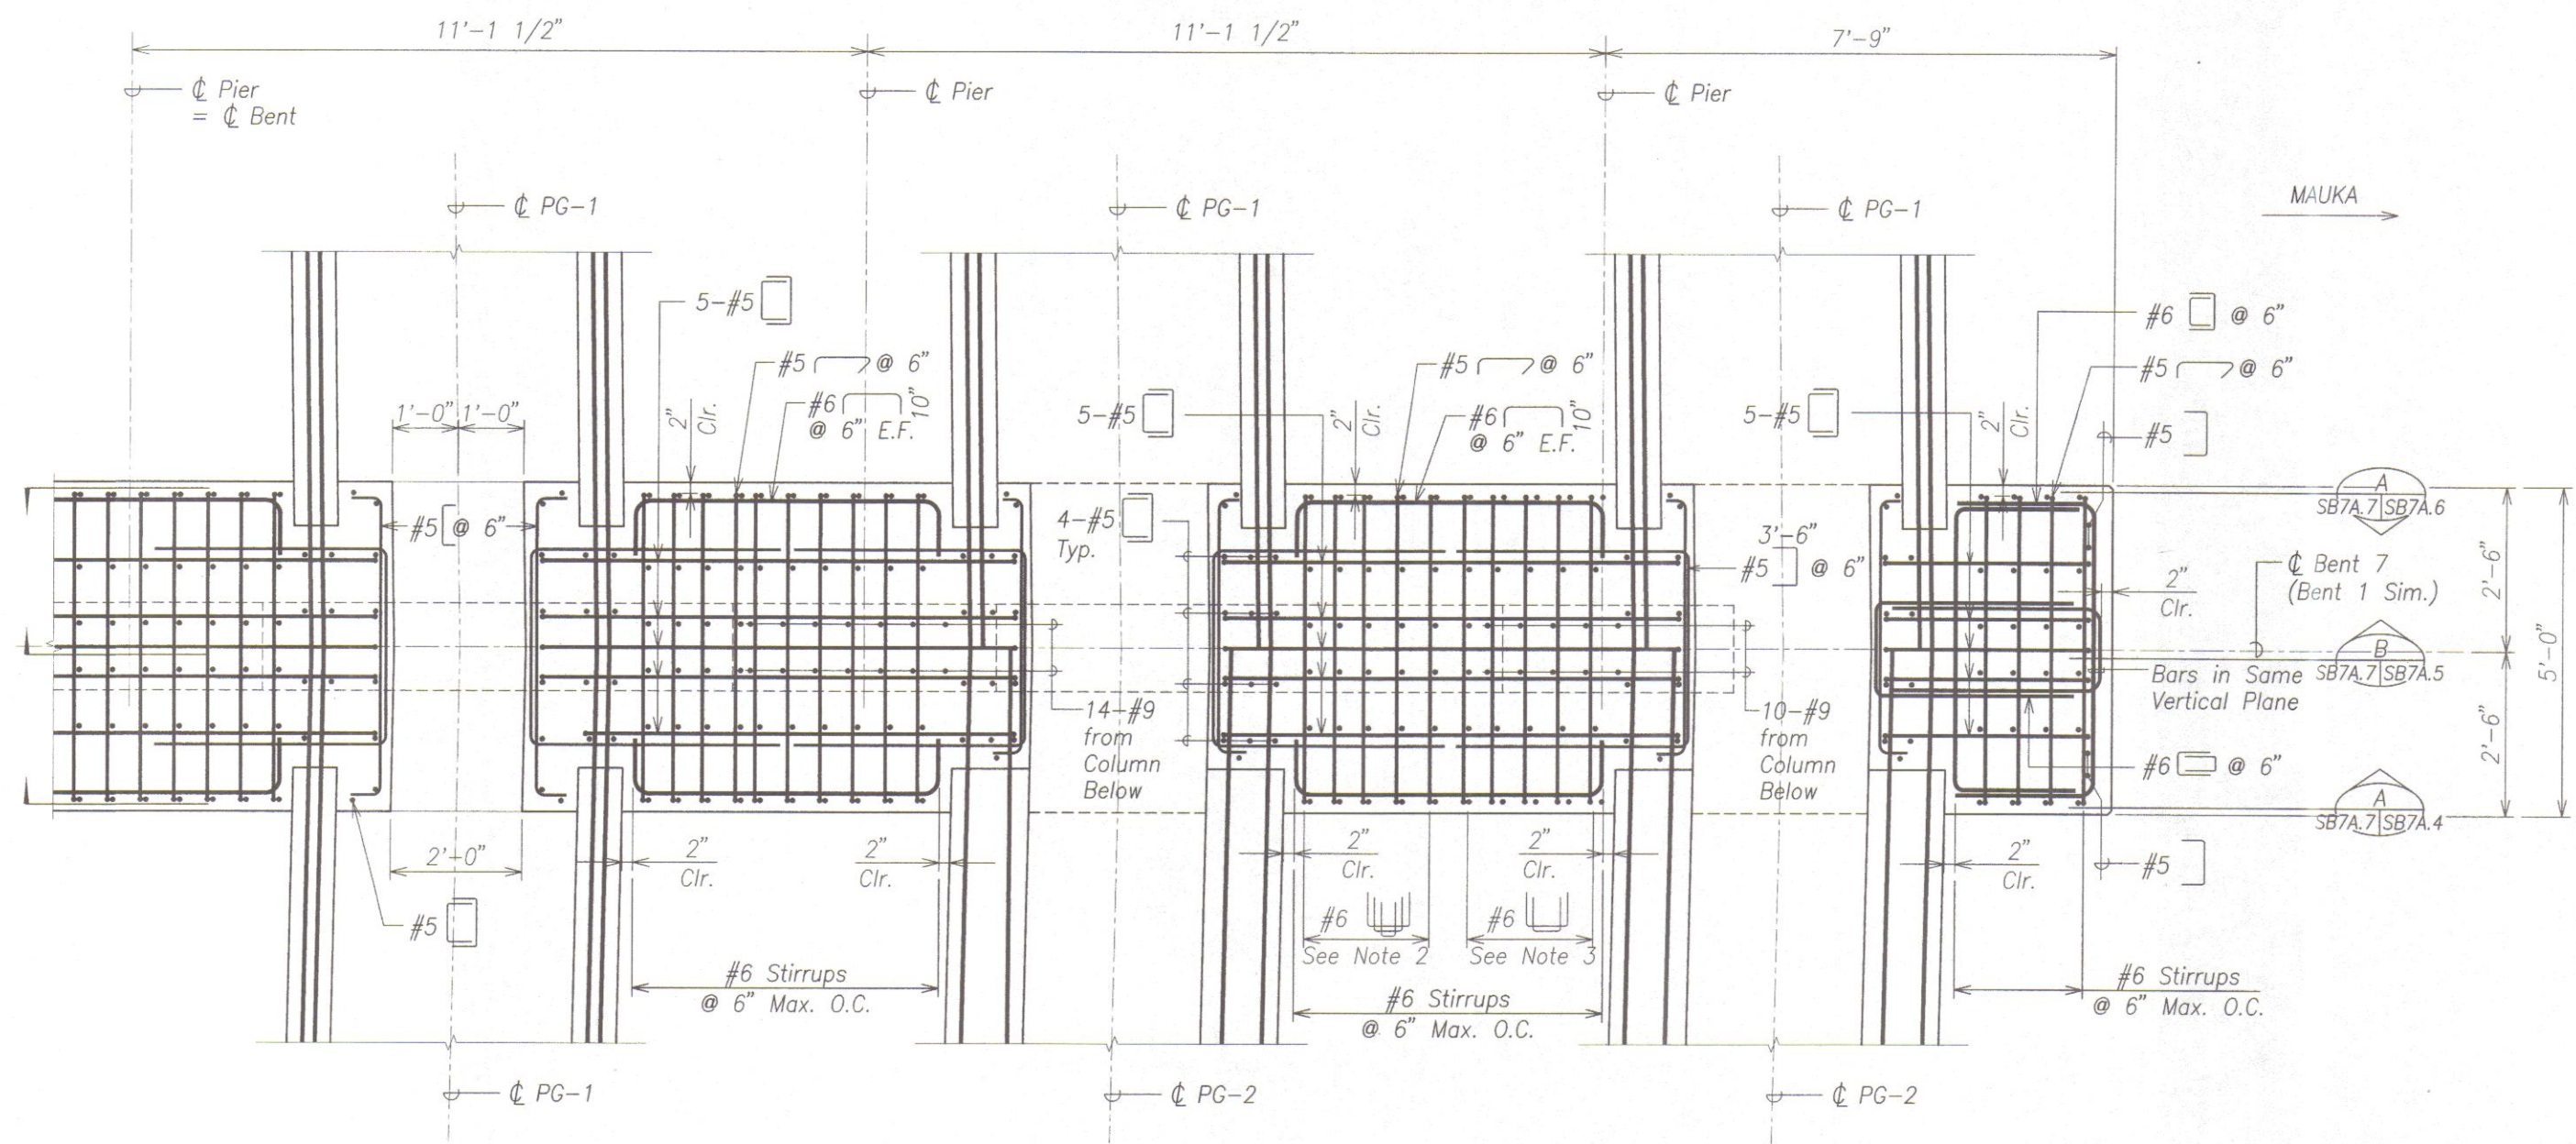

REINFORCING AT CIP BENT CAP
 Scale: 3/4" = 1'-0"
 SB7A.2

- NOTES:
- Girder vertical bars are not shown for clarity.
 - Locate #6 where vertical column reinforcing does not occur (Typ.).
 - Locate #6 where vertical column reinforcing occurs (Typ.).



THIS WORK WAS PREPARED BY ME OR UNDER MY SUPERVISION.
 David K. Fujimura
 KSF, INC. APRIL 30, 2012
 LIC. EXP. DATE

STATE OF HAWAII
 DEPARTMENT OF TRANSPORTATION
 HIGHWAYS DIVISION


CIP BEAM ABOVE BENT CAP

HONOAPIILANI HIGHWAY REALIGNMENT, PHASE 1A
 Future Keawe St Extension to Lahainaluna Rd, Part B
 Fed. Aid Proj. No. NH-030-1(35)R

Scale: As Noted Date: June, 2010

SHEET No. SB7A.7 OF 10 SHEETS

FED. ROAD DIST. NO.	STATE	FED. AID PROJ. NO.	FISCAL YEAR	SHEET NO.	TOTAL SHEETS
HAWAII	HAW.	NH-030-1(35)R	2009	312	383

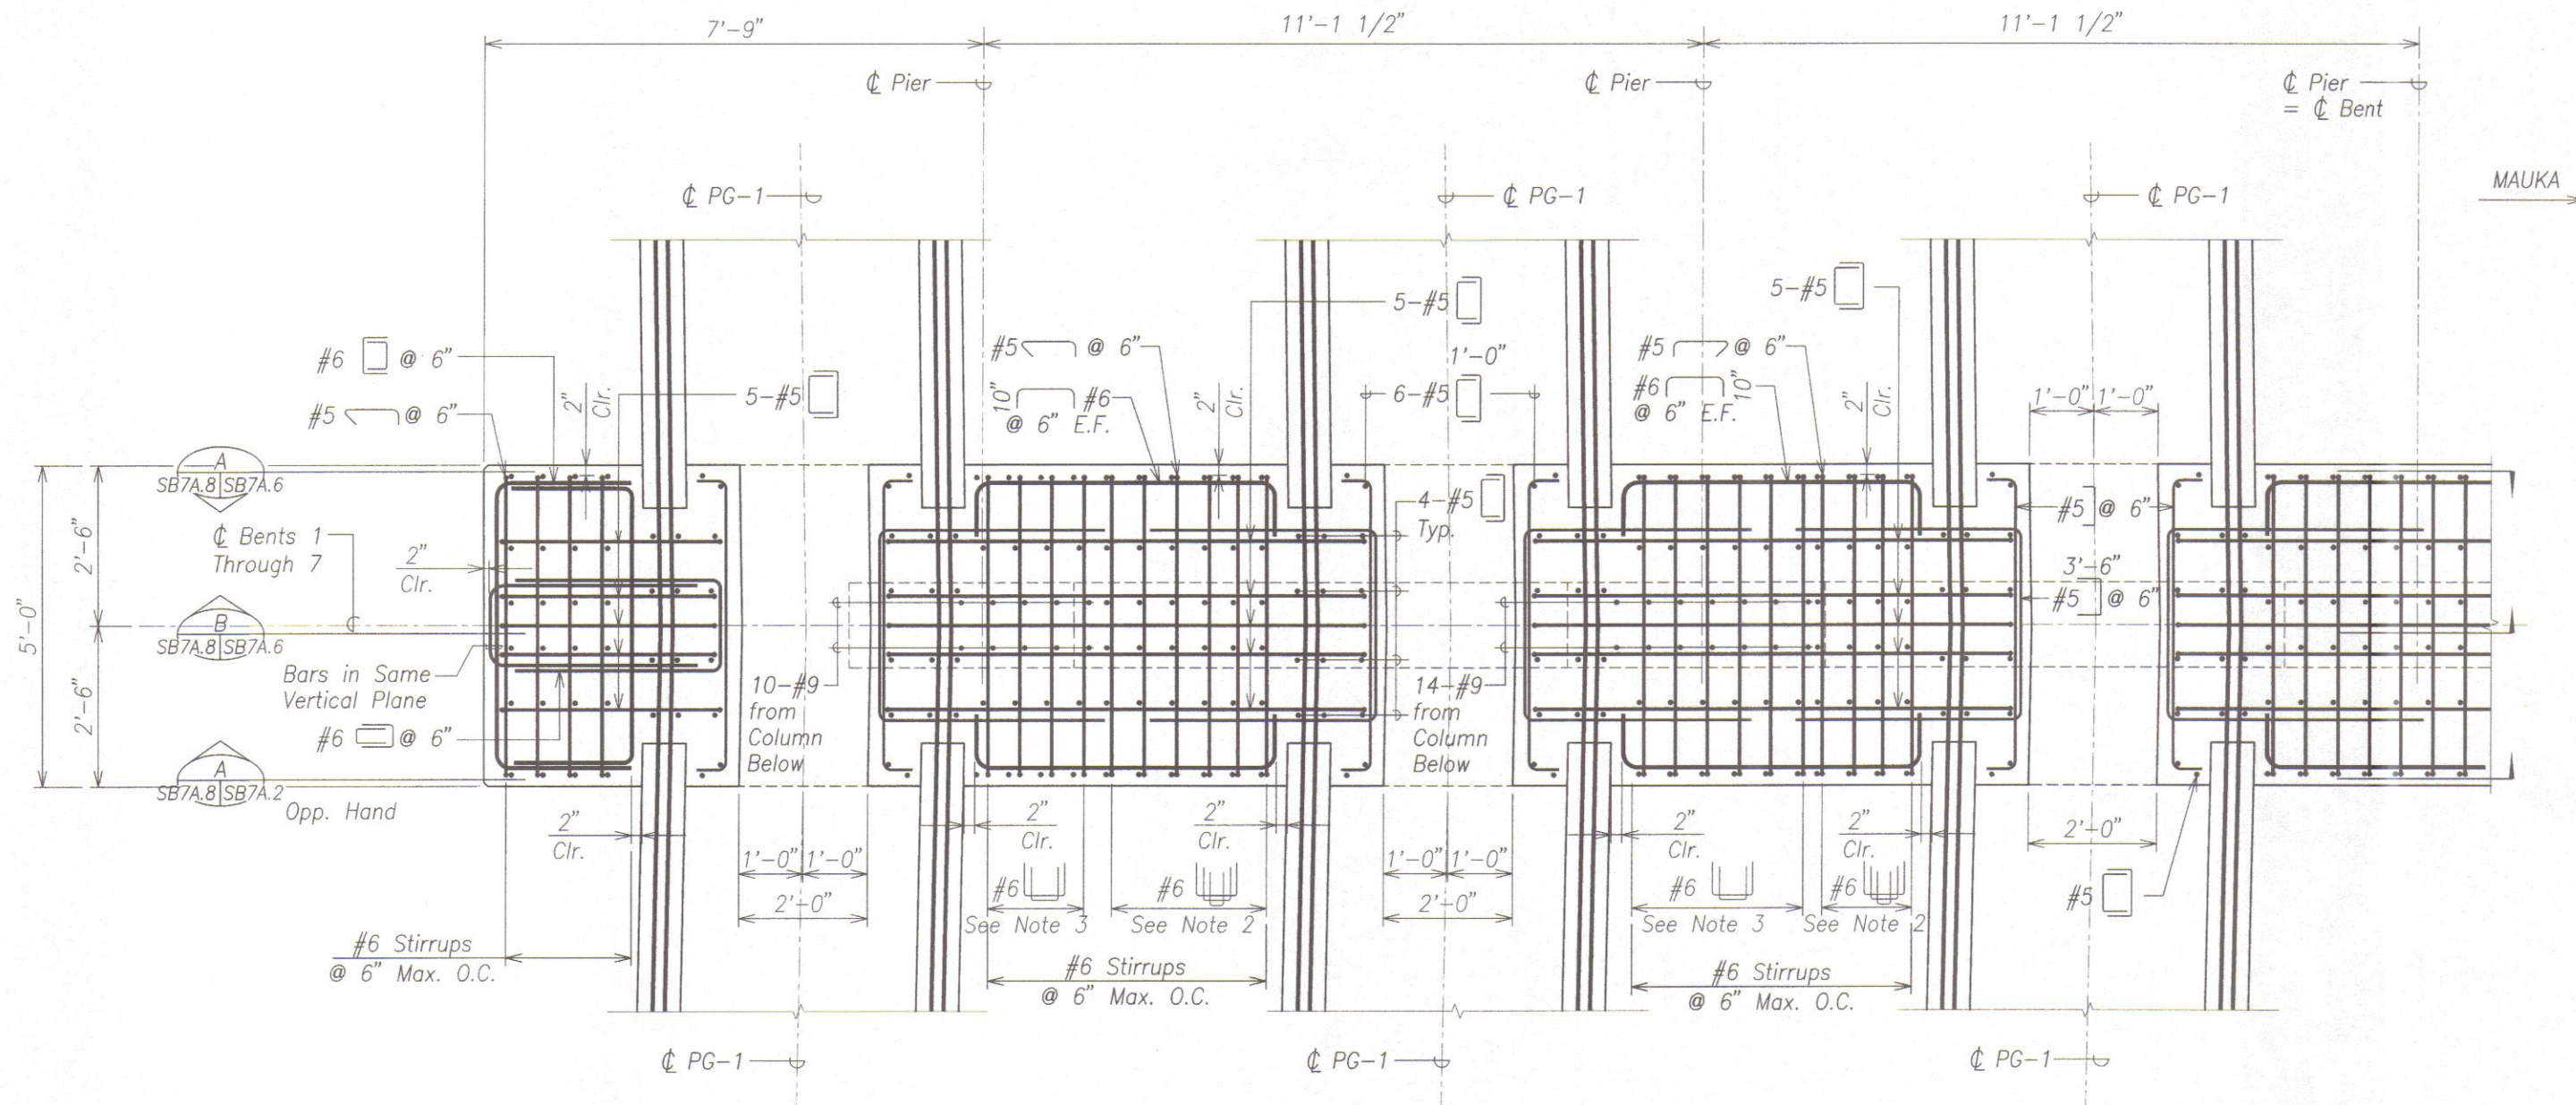

REINFORCING AT CIP BENT CAP A
 Scale: 3/4" = 1'-0" SB7A.1/SB7A.8

NOTES:

- Girder vertical bars are not shown for clarity.
- Locate #6 where vertical column reinforcing does not occur (Typ.).
- Locate #6 where vertical column reinforcing occurs (Typ.).



THIS WORK WAS PREPARED BY ME
OR UNDER MY SUPERVISION.

David K. Fujimura APRIL 30, 2012
KSF, INC. LIC. EXP. DATE

STATE OF HAWAII
DEPARTMENT OF TRANSPORTATION
HIGHWAYS DIVISION

CIP BEAM ABOVE BENT CAP

HONOAPIILANI HIGHWAY REALIGNMENT, PHASE 1A
 Future Keawe St Extension to Lahainaluna Rd, Part B
 Fed. Aid Proj. No. NH-030-1(35)R


Scale: As Noted Date: June, 2010

SHEET No. SB7A.8 OF 10 SHEETS

DRAWING NAME: Z:\00 ONGOING\40019.0-HONOAPIILANI LAHAINA BYPASS-KAHOMA WO\06-15-10 COMBINE LAHAINA FINAL DESIGN\HH-SB700A7.DWG PLOT TIME: 06-14-10, 3:20 PM


ORIGINAL PLAN	SURVEY PLOTTED BY	DATE
NOTE BOOK	DRAWN BY	
No.	DESIGNED BY	
	CHECKED BY	

FED. ROAD DIST. NO.	STATE	FED. AID PROJ. NO.	FISCAL YEAR	SHEET NO.	TOTAL SHEETS
HAWAII	HAW.	NH-030-1(35)R	2009	313	383

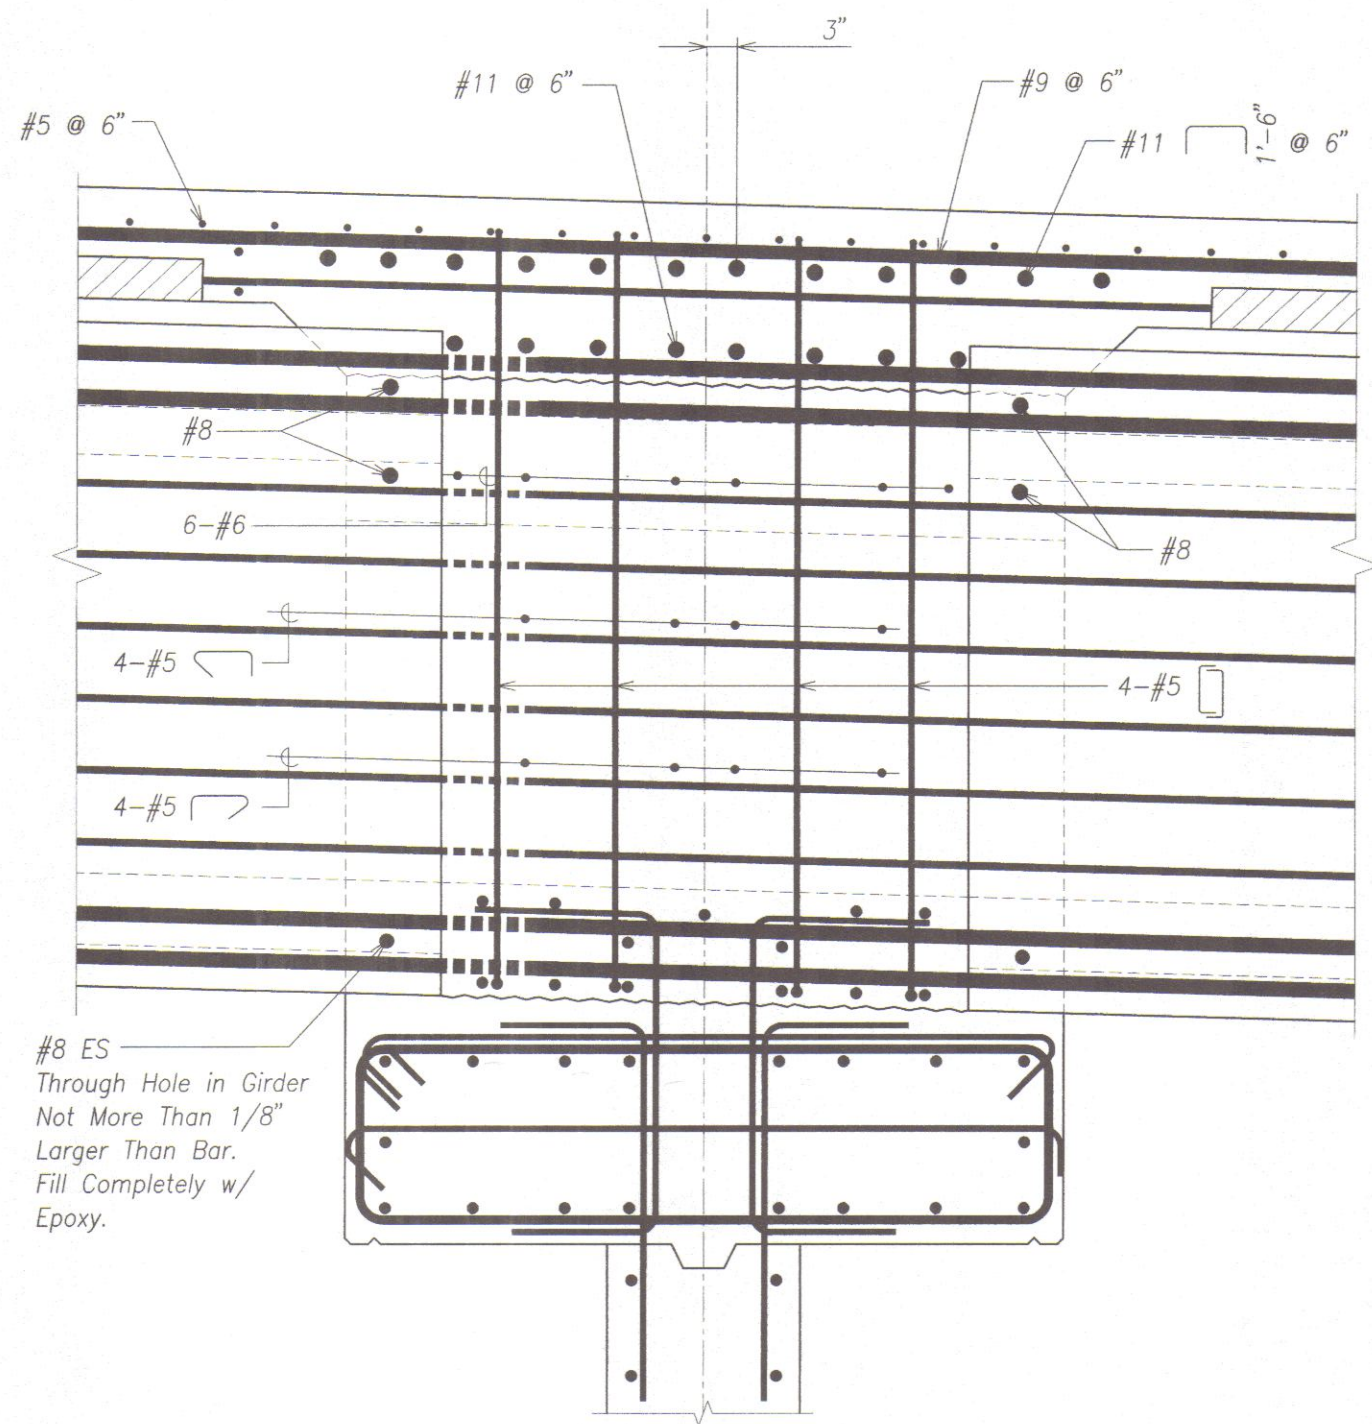

**TYPICAL SECTION
THROUGH GIRDER STEMS**
Scale: 1 1/2" = 1'-0"
SB7A.2 SB7A.9

NOTE:
See SB7B series for bent information
& SB7C series of bent cap information.

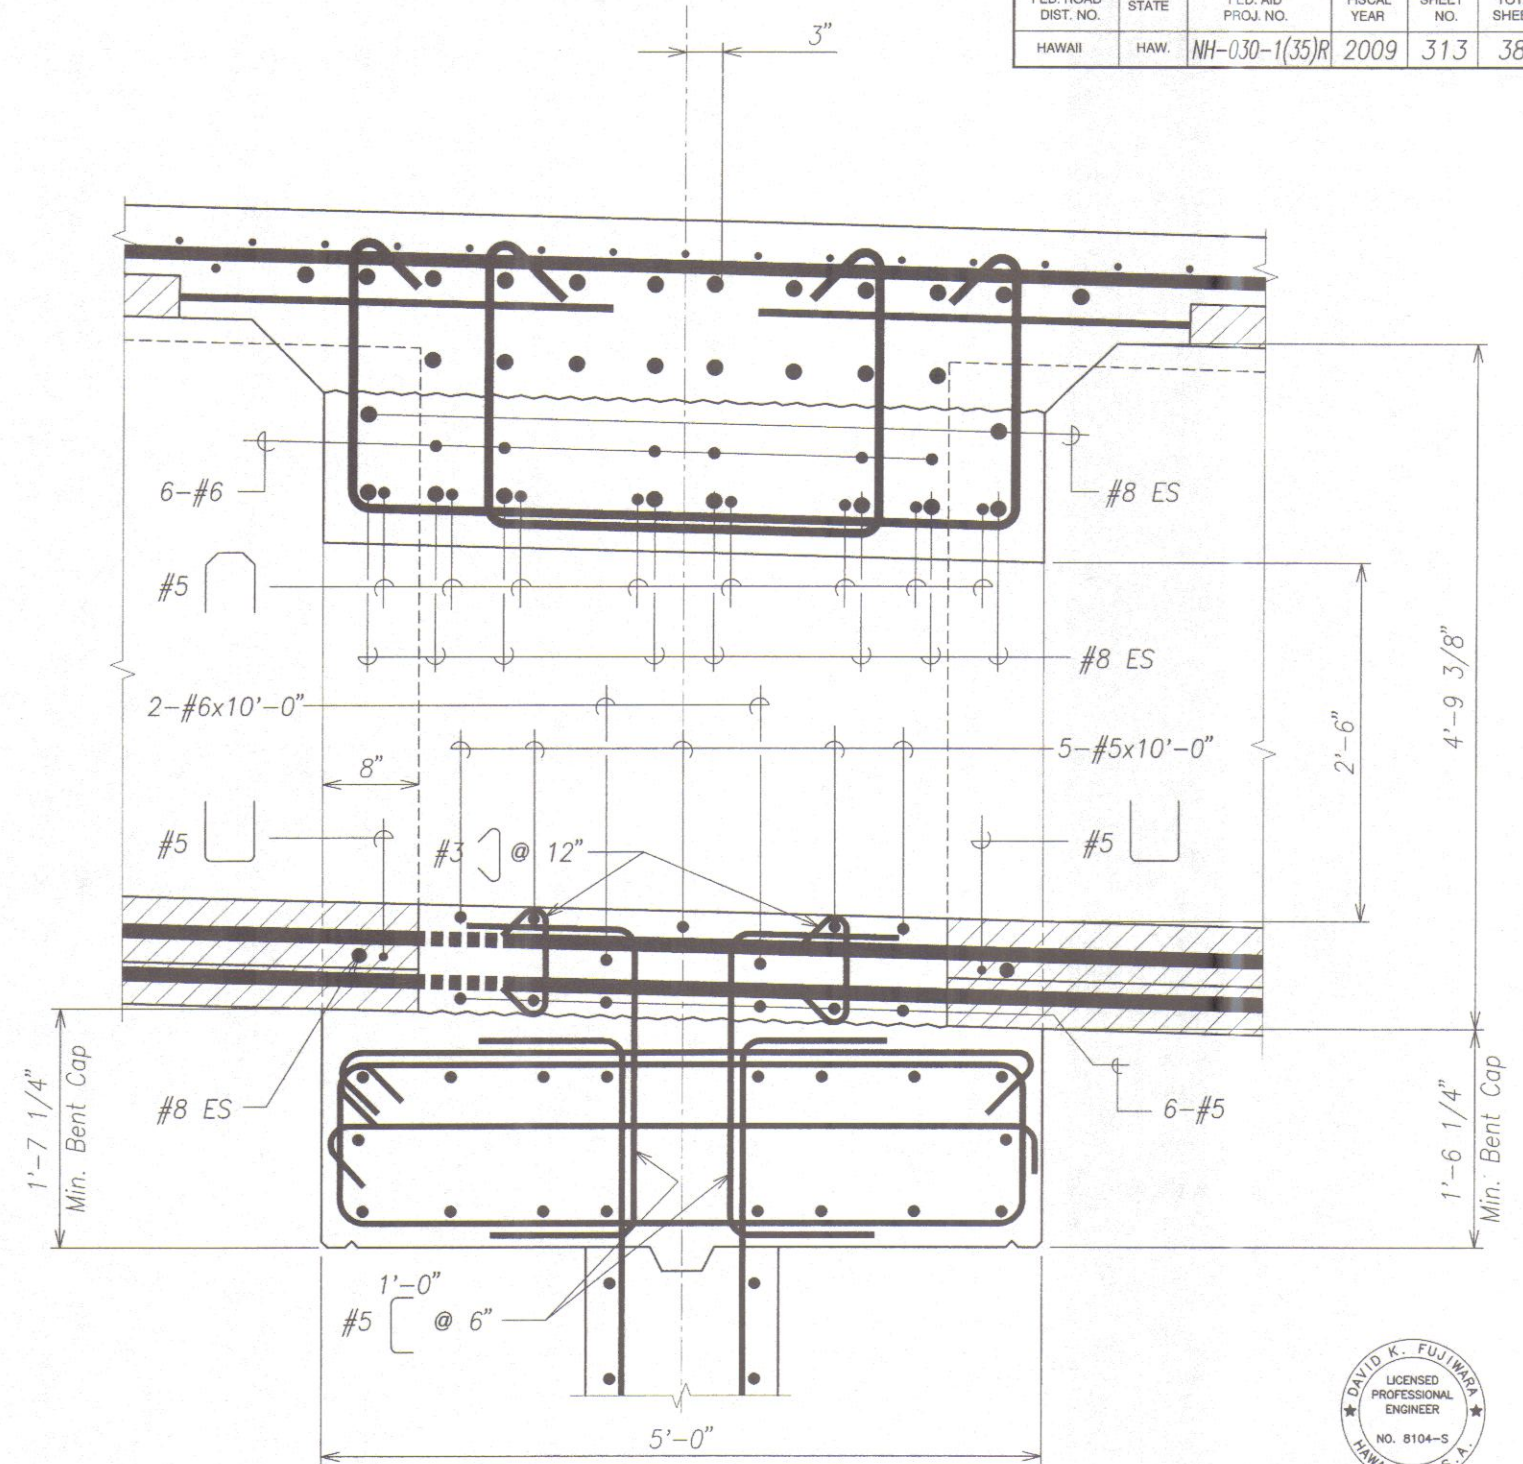

**TYPICAL SECTION (INSIDE GIRDER)
BETWEEN GIRDER STEMS**
Scale: 1 1/2" = 1'-0"
SB7A.2 SB7A.1 SB7A.9



THIS WORK WAS PREPARED BY ME
OR UNDER MY SUPERVISION.
David K. Fujiwara
KSF, INC. APRIL 30, 2012
LIC. EXP. DATE

STATE OF HAWAII
DEPARTMENT OF TRANSPORTATION
HIGHWAYS DIVISION

CIP BEAM ABOVE BENT CAP

HONOAPIILANI HIGHWAY REALIGNMENT, PHASE 1A
Future Keawe St Extension to Lahainaluna Rd, Part B
Fed. Aid Proj. No. NH-030-1(35)R


Scale: As Noted Date: June, 2010

SHEET No. SB7A.9 OF 10 SHEETS

DATE	
DESIGNED BY	
CHECKED BY	
NOTED BY	
ORIGINAL PLAN	
NO.	

DRAWING NAME: 2:100 ONGOING 40019.0-HONOAPIILANI LAHAINA BYPASS-KAHOMA W/06-15-10 COMBINE LAHAINA FINAL DESIGN NH-SB700A2.DWG PLOT TIME: 06-14-10, 3:20 PM


FED. ROAD DIST. NO.	STATE	FED. AID PROJ. NO.	FISCAL YEAR	SHEET NO.	TOTAL SHEETS
HAWAII	HAW.	NH-030-1(35)R	2009	314	383

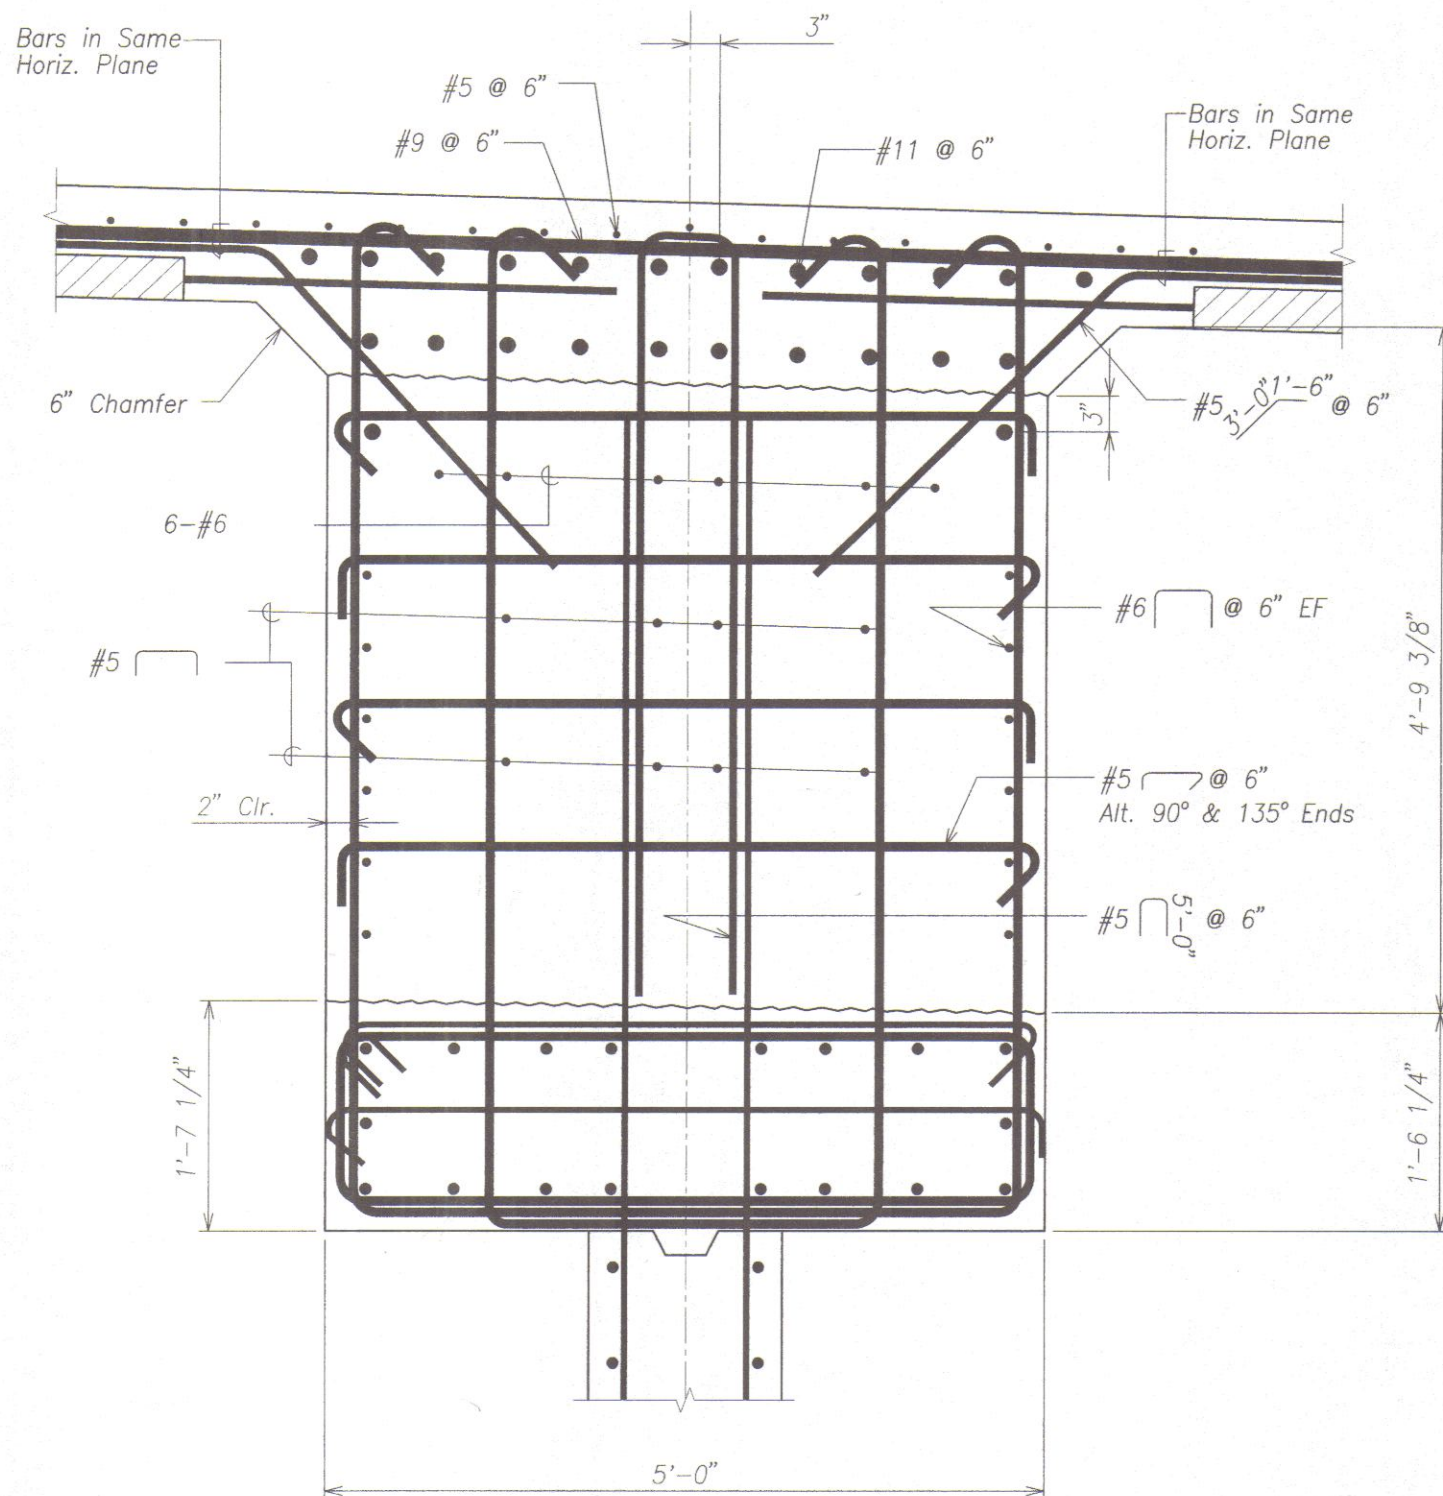

TYPICAL SECTION
BETWEEN GIRDERS
Scale: 1 1/2" = 1'-0"
SB7A.1 SB7A.10
SB7A.2

SURVEY PLOTTED BY	DATE
DRAWN BY	
TRACED BY	
DESIGNED BY	
CHECKED BY	
NO.	


DRAWING NAME: Z:\00 ONGOING\40019.0-HONOAPILANI LAHAINA BYPASS-KAHOMA WO\06-15-10 COMBINE LAHAINA FINAL DESIGN\HH-SB700A9.DWG PLOT TIME: 06-14-10, 3:21 PM

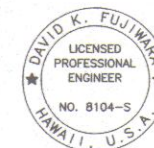

THIS WORK WAS PREPARED BY ME
OR UNDER MY SUPERVISION.
David K. Fujiwara APRIL 30, 2012
KSF, INC. LIC. EXP. DATE

STATE OF HAWAII
DEPARTMENT OF TRANSPORTATION
HIGHWAYS DIVISION
CIP BEAM ABOVE BENT CAP
HONOAPILANI HIGHWAY REALIGNMENT, PHASE 1A
Future Keawe St Extension to Lahainaluna Rd, Part B
Fed. Aid Proj. No. NH-030-1(35)R
Scale: As Noted Date: June, 2010
SHEET No. SB7A.10 OF 10 SHEETS

FED. ROAD DIST. NO.	STATE	FED. AID PROJ. NO.	FISCAL YEAR	SHEET NO.	TOTAL SHEETS
HAWAII	HAW.	NH-030-1(35)R	2009	315	383

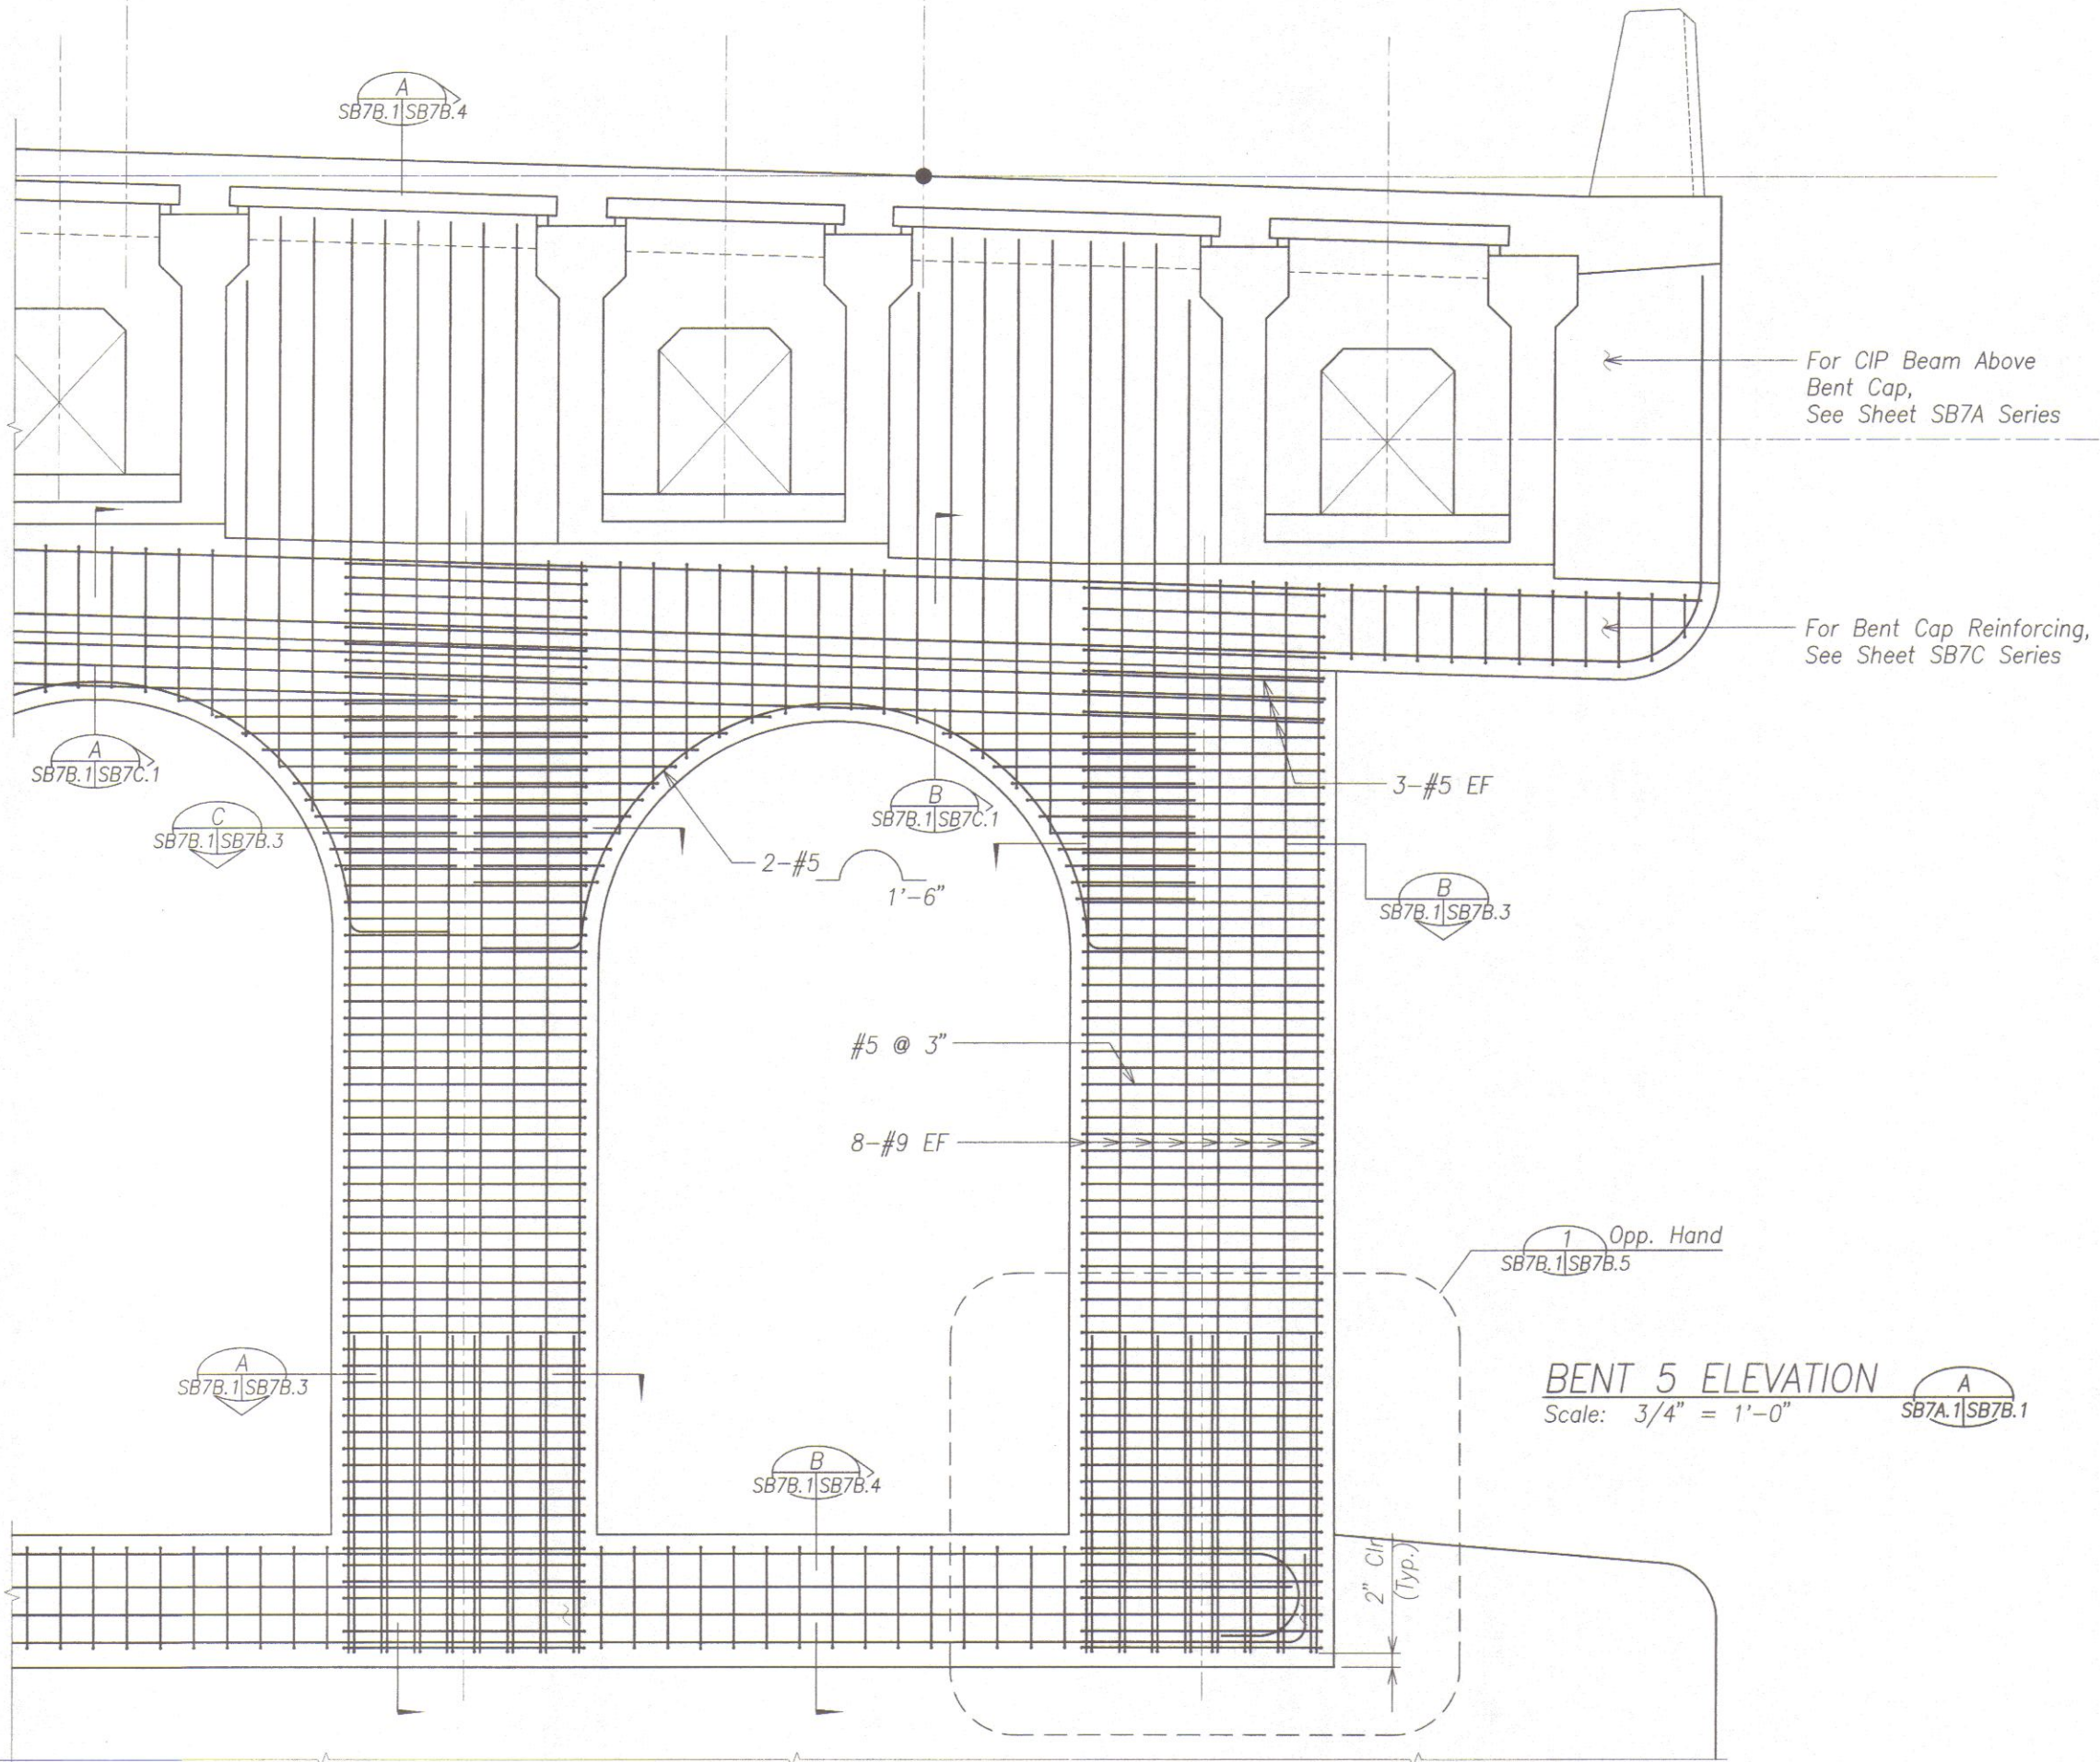

BENT 5 ELEVATION
 Scale: 3/4" = 1'-0" A SB7A.1|SB7B.1



THIS WORK WAS PREPARED BY ME
 OR UNDER MY SUPERVISION.
David K. Fujimura APRIL 30, 2012
 KSF, INC. LIC. EXP. DATE

STATE OF HAWAII
 DEPARTMENT OF TRANSPORTATION
 HIGHWAYS DIVISION

BENT ELEVATION

HONOAPIILANI HIGHWAY REALIGNMENT, PHASE 1A
 Future Keawe St Extension to Lahainaluna Rd, Part B
 Fed. Aid Proj. No. NH-030-1(35)R


Scale: As Noted Date: June, 2010

SHEET No. SB7B.1 OF 5 SHEETS

ORIGINAL PLAN	SURVEY PLOTTED BY	DATE
NOTE BOOK	DRAWN BY	
QUANTITIES BY	DESIGNED BY	
CHECKED BY		


DRAWING NAME: 2100 ONGOING 4001.9.0-HONOAPIILANI LAHAINA BYPASS-KAHOMA WD 06-15-10 COMBINE LAHAINA FINAL DESIGN HH-SB700B1.DWG PLOT TIME: 06-14-10, 3:21 PM

FED. ROAD DIST. NO.	STATE	FED. AID PROJ. NO.	FISCAL YEAR	SHEET NO.	TOTAL SHEETS
HAWAII	HAW.	NH-030-1(35)R	2009	316	383

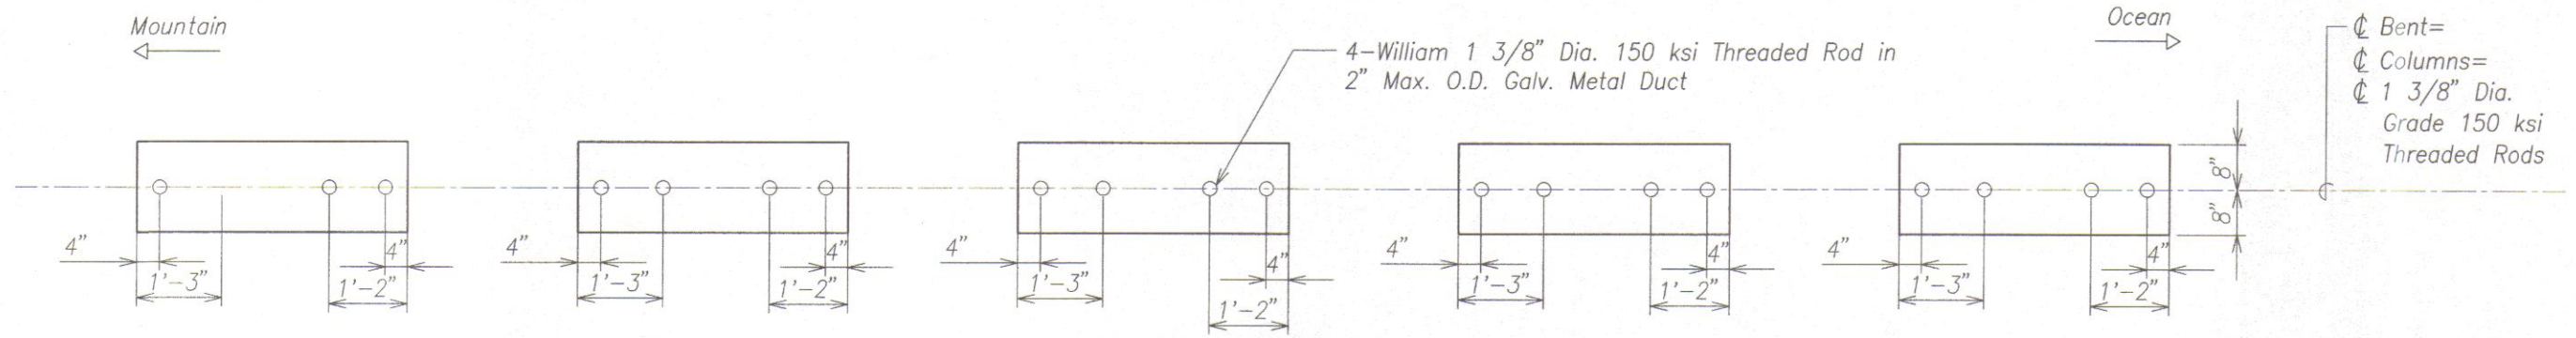

LAYOUT OF 1 3/8" DIA. GRADE 150 H.S. THREADED BARS
(BENTS 1 AND 7)
Not to Scale

A
SB7B.2|SB7B.2

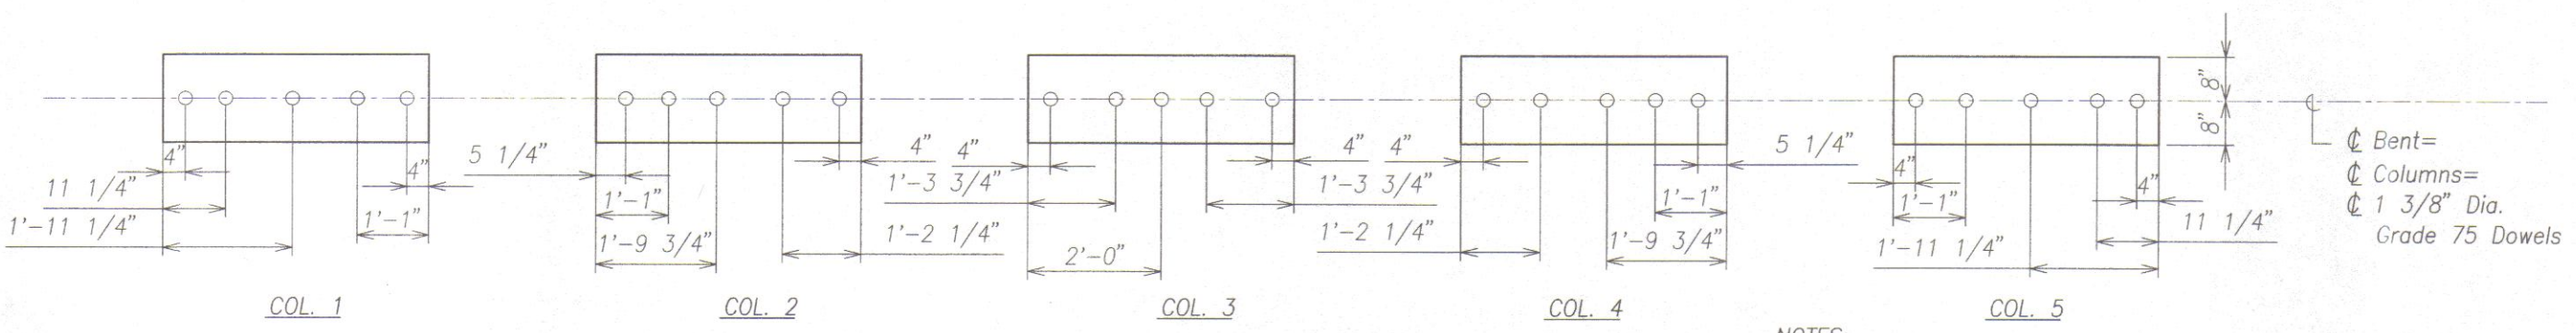

LAYOUT OF 1 3/8" DIA. GRADE 75 THREADED BARS
(BENTS 2 THROUGH 6)
Not to Scale

B
SB7B.2|SB7B.2

- NOTES:
- Contractor shall verify location of 1 3/8" diameter dowels with continuous PT Ducts in Stiffener Beam. If adjustments are required, verify with Engineer.
 - See Detail 1 on Sheet SB7B.4 for Epoxy Coating.



THIS WORK WAS PREPARED BY ME
OR UNDER MY SUPERVISION.
David K. Fujiwara
KSF, INC. APRIL 30, 2012
LIC. EXP. DATE




STATE OF HAWAII
DEPARTMENT OF TRANSPORTATION
HIGHWAYS DIVISION

SECTIONS THROUGH COLUMNS
HONOAPIILANI HIGHWAY REALIGNMENT, PHASE 1A
Future Keawe St Extension to Lahainaluna Rd, Part B
Fed. Aid Proj. No. NH-030-1(35)R
Scale: As Noted Date: June, 2010
SHEET No. SB7B.2 OF 5 SHEETS

ORIGINAL PLAN	SURVEY PLOTTED BY	DATE
NOTE BOOK	DRAWN BY	
No.	DESIGNED BY	
	QUANTITIES BY	
	CHECKED BY	

DRAWING NAME: Z:\00 ONGOING\40019.0 -HONAPIILANI LAHAINA BYPASS-KAHOMA WO\06-15-10 COMBINE LAHAINA FINAL DESIGN\NH-SB700B2.DWG PLOT TIME: 06-14-10, 3:22 PM

FED. ROAD DIST. NO.	STATE	FED. AID PROJ. NO.	FISCAL YEAR	SHEET NO.	TOTAL SHEETS
HAWAII	HAW.	NH-030-1(35)R	2009	317	383

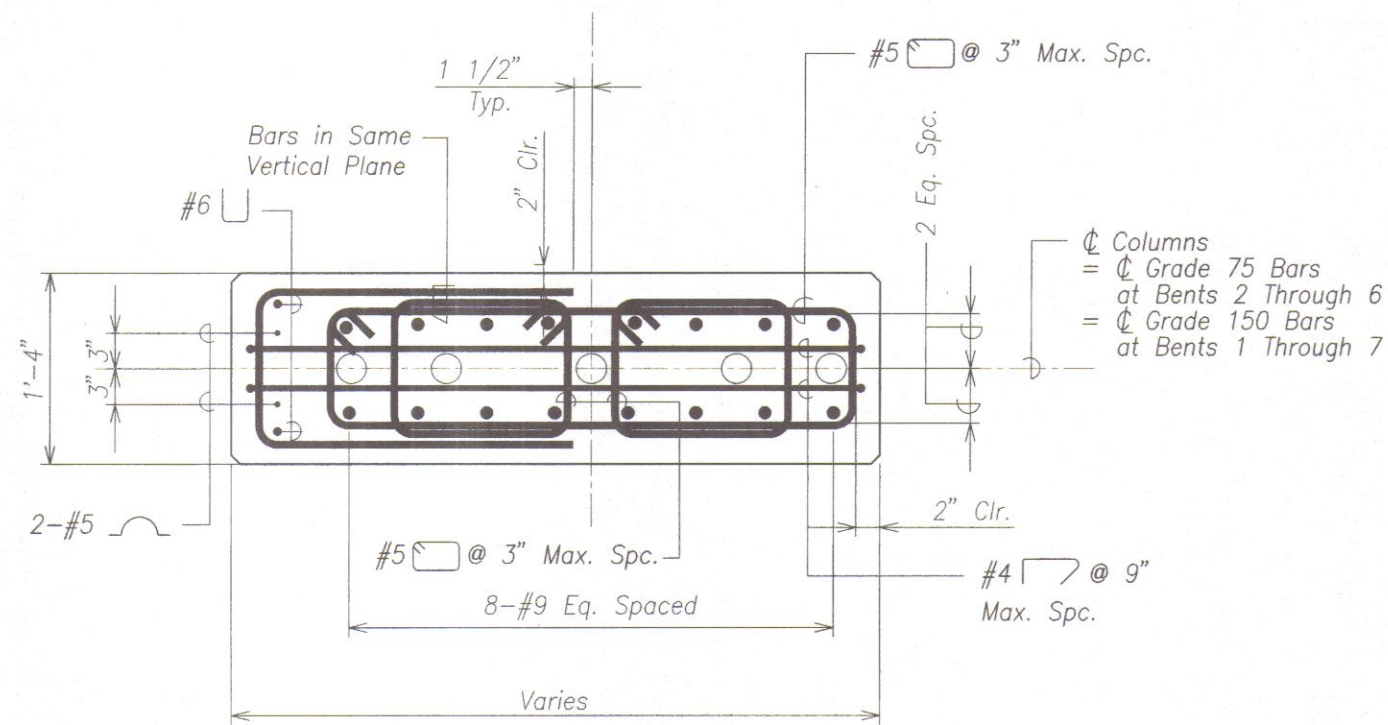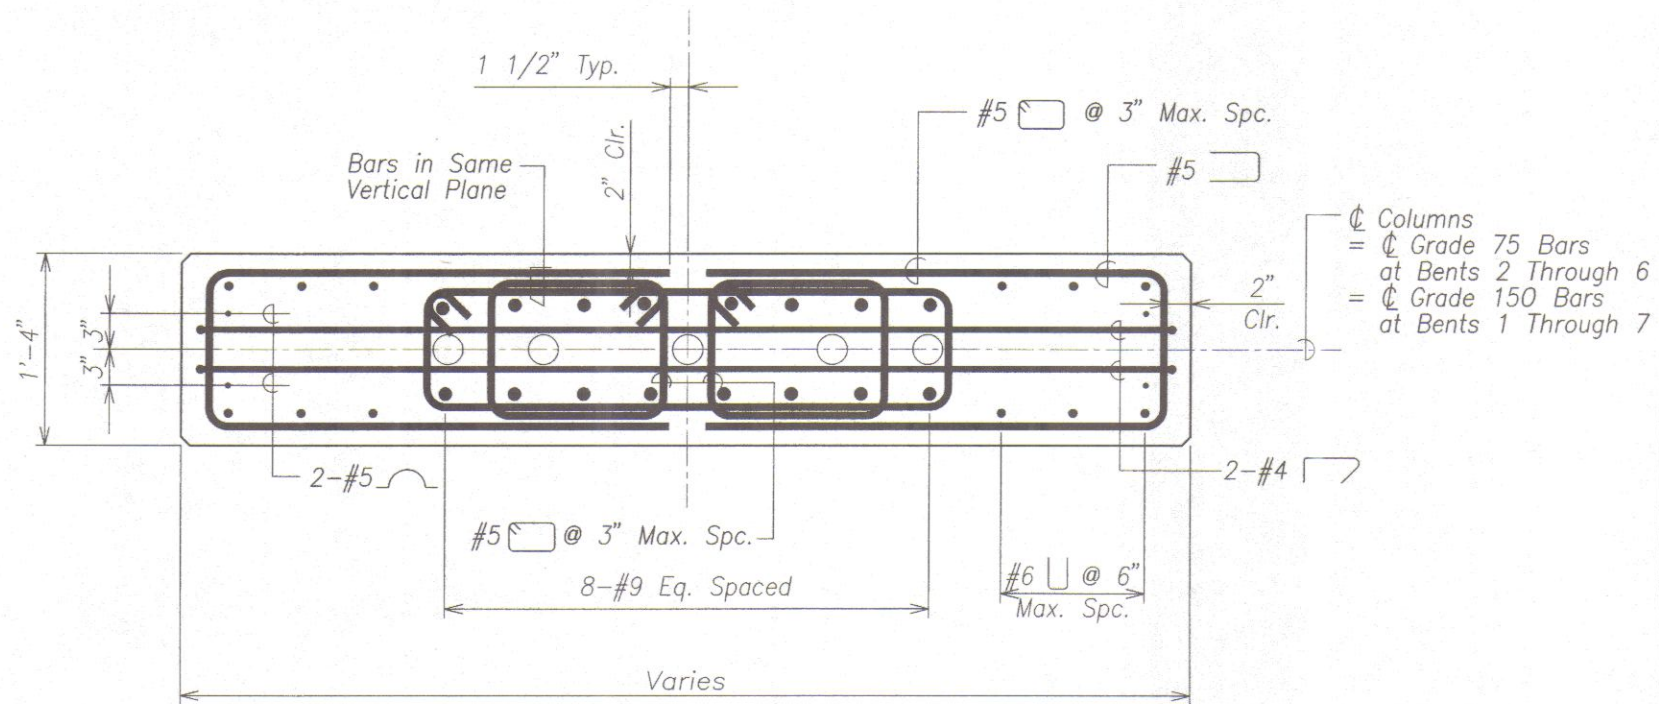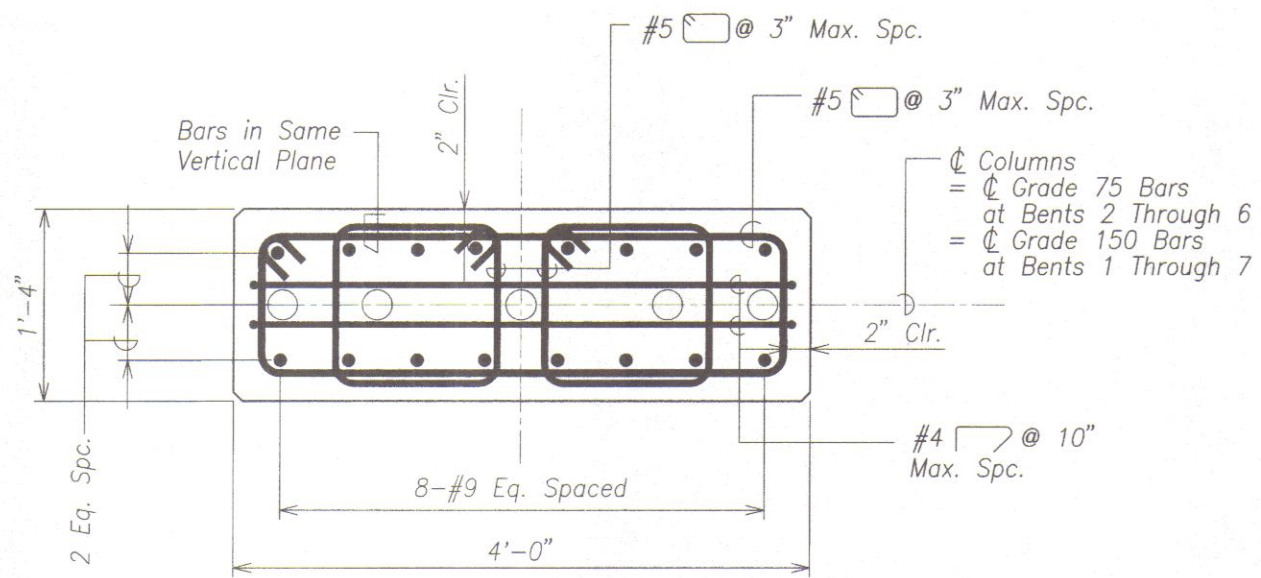


THIS WORK WAS PREPARED BY ME
OR UNDER MY SUPERVISION.
David K. Fujiwara
KSF, INC. APRIL 30, 2012
LIC. EXP. DATE

STATE OF HAWAII DEPARTMENT OF TRANSPORTATION HIGHWAYS DIVISION
SECTIONS THROUGH COLUMNS
HONOAPIILANI HIGHWAY REALIGNMENT, PHASE 1A Future Keawe St Extension to Lahainaluna Rd, Part B Fed. Aid Proj. No. NH-030-1(35)R
Scale: As Noted Date: June, 2010
SHEET No. SB7B.3 OF 5 SHEETS

FINAL DESIGN 317

FED. ROAD DIST. NO.	STATE	FED. AID PROJ. NO.	FISCAL YEAR	SHEET NO.	TOTAL SHEETS
HAWAII	HAW.	NH-030-1(35)R	2009	318	383

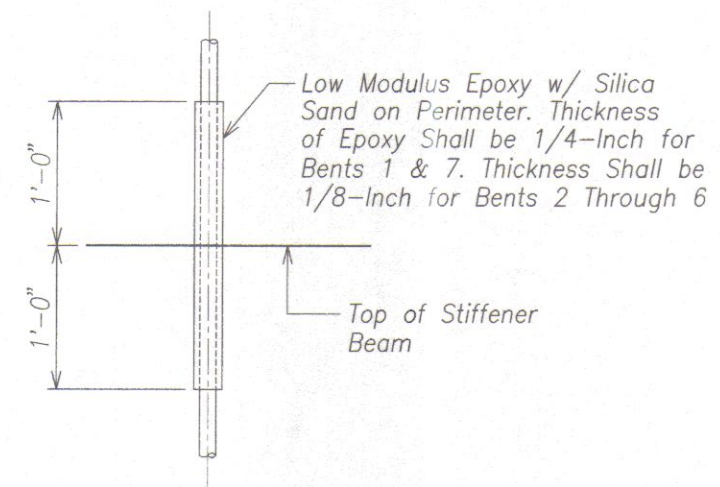

DETAIL
Scale: 1 1/2" = 1'-0" SB7B.1/SB7B.4


NOTE:
1. See Sheet SB7B.2 for Threaded Rod locations.




THIS WORK WAS PREPARED BY ME OR UNDER MY SUPERVISION.
David K. Fujiwara
KSF, INC. APRIL 30, 2012 LIC. EXP. DATE

STATE OF HAWAII
DEPARTMENT OF TRANSPORTATION
HIGHWAYS DIVISION

BENT SECTIONS AND DETAIL
HONOAPIILANI HIGHWAY REALIGNMENT, PHASE 1A
Future Keawe St Extension to Lahainaluna Rd, Part B
Fed. Aid Proj. No. NH-030-1(35)R
Scale: As Noted Date: June, 2010
SHEET No. SB7B.4OF 5 SHEETS

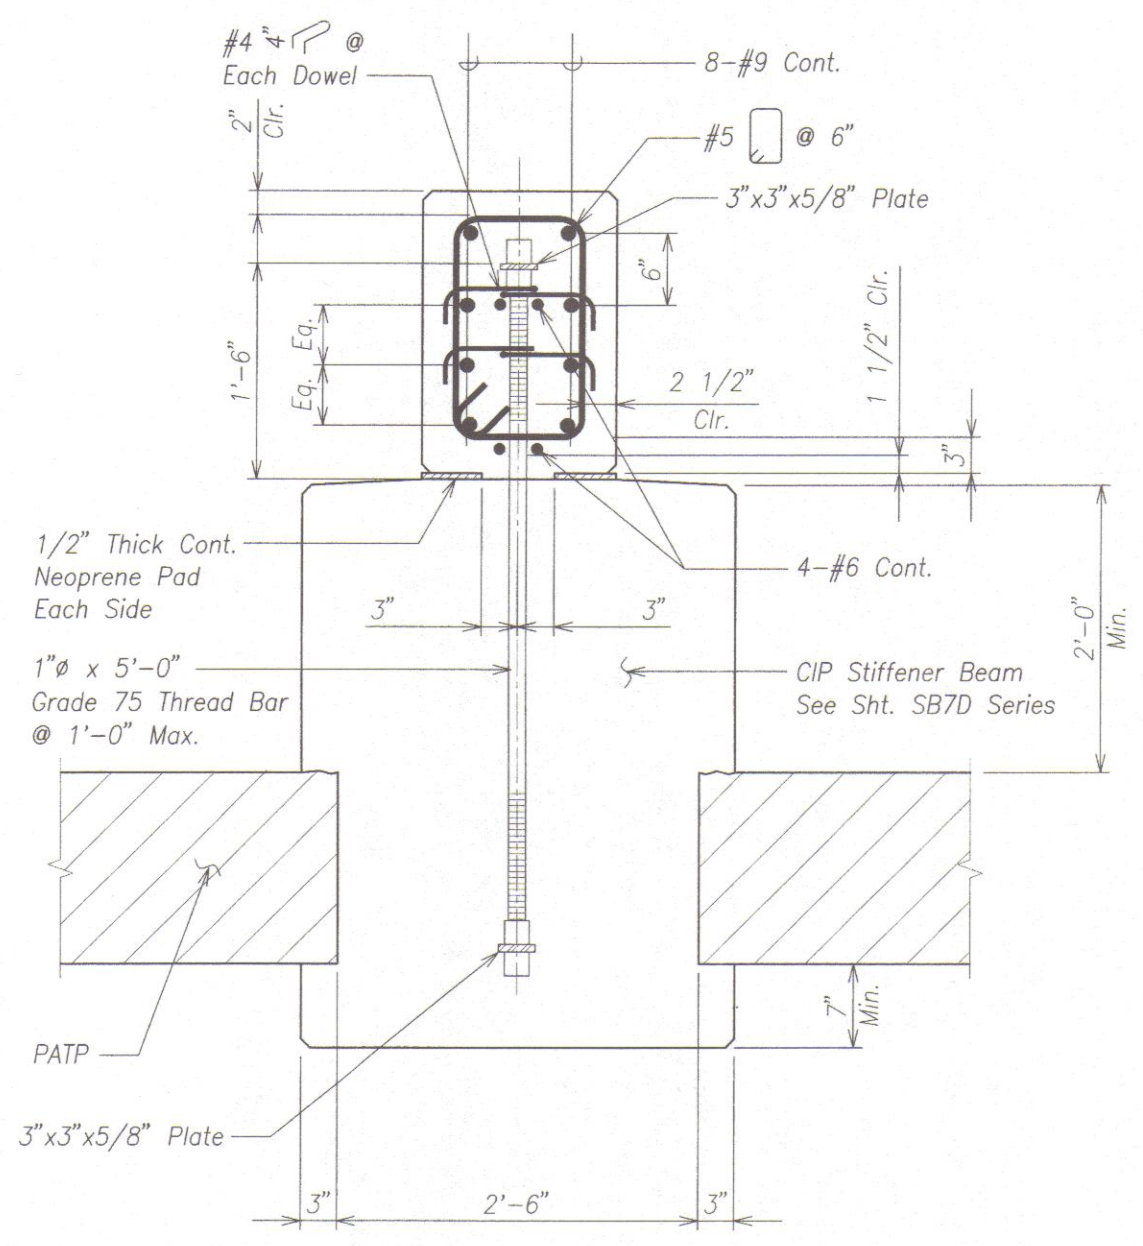

SECTION B
Scale: 1 1/2" = 1'-0" SB7B.1/SB7B.4

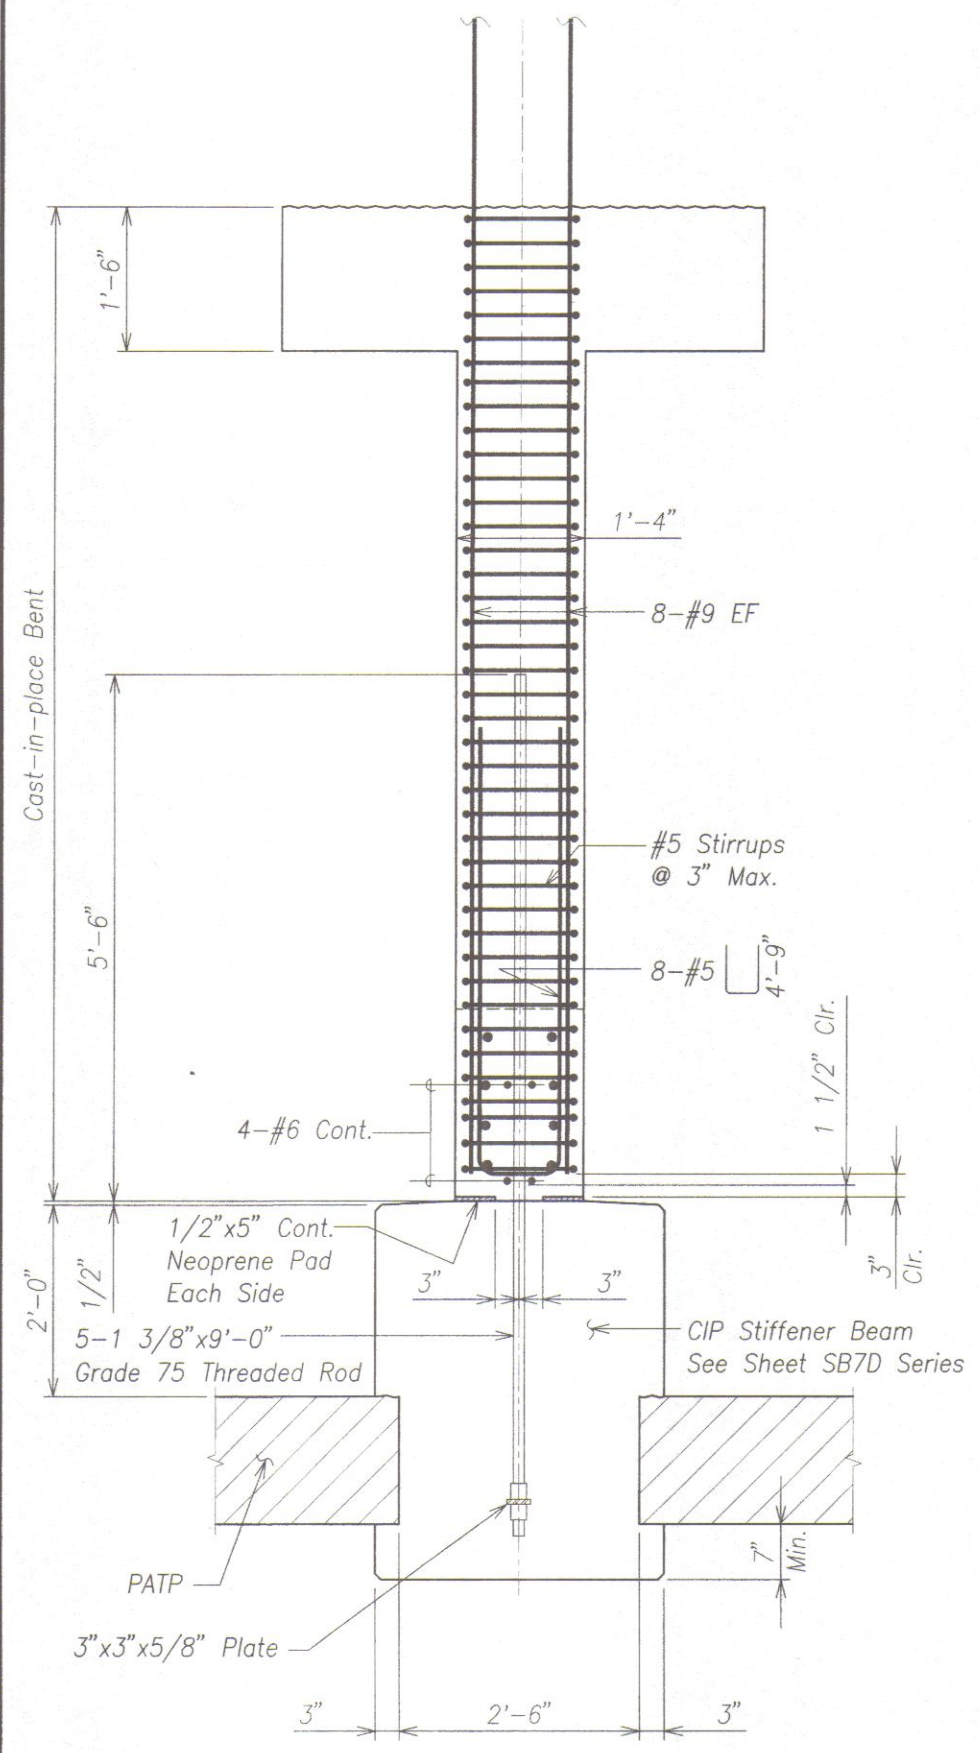


SECTION A
Scale: 1" = 1'-0" SB7A.1/SB7B.4

ORIGINAL PLAN	SURVEY PLOTTED BY	DATE
NOTE BOOK	DRAWN BY	
	DESIGNED BY	
	QUANTITIES BY	
	CHECKED BY	
No.		


DRAWING NAME: 2:100 ONGOING 40019.0-HONOAPIILANI LAHAINA BYPASS-KAHOMA W/06-15-10 COMBINE LAHAINA FINAL DESIGN HH-SB700B4.DWG PLOT TIME: 06-14-10, 3:23 PM

FED. ROAD DIST. NO.	STATE	FED. AID PROJ. NO.	FISCAL YEAR	SHEET NO.	TOTAL SHEETS
HAWAII	HAW.	NH-030-1(35)R	2009	319	383

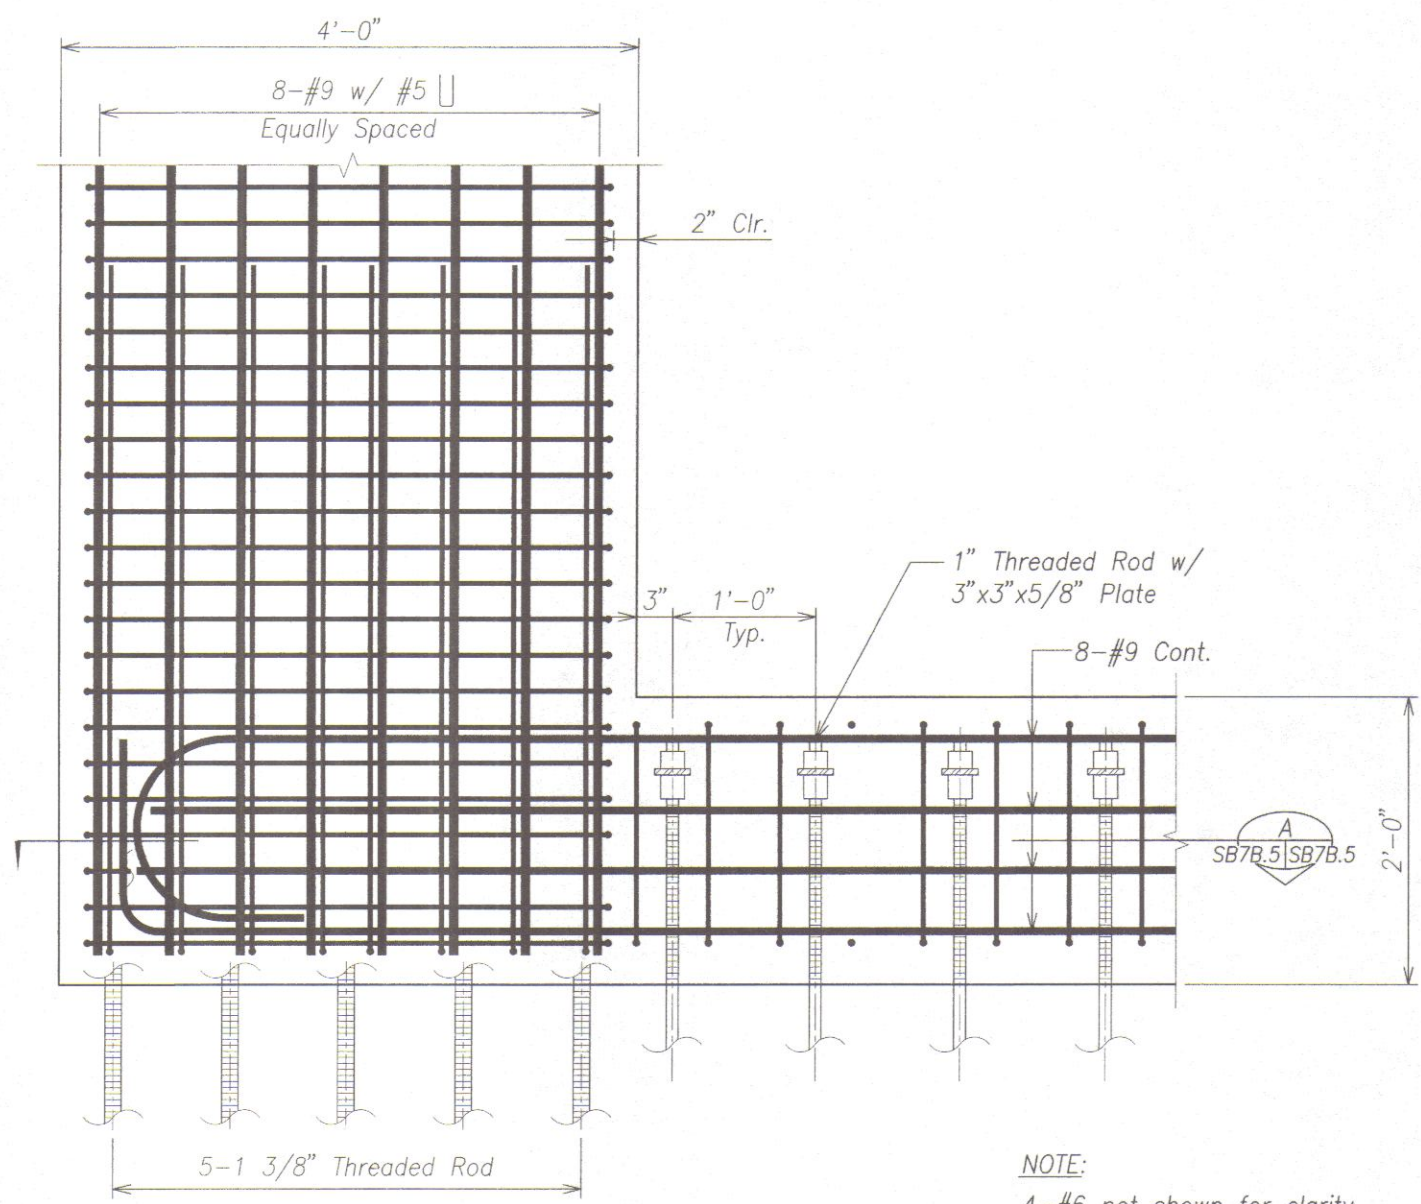

DETAIL
Scale: 1 1/2" = 1'-0" SB7B.1 SB7B.5


NOTE:
4-#6 not shown for clarity.
See Section A on this sheet.

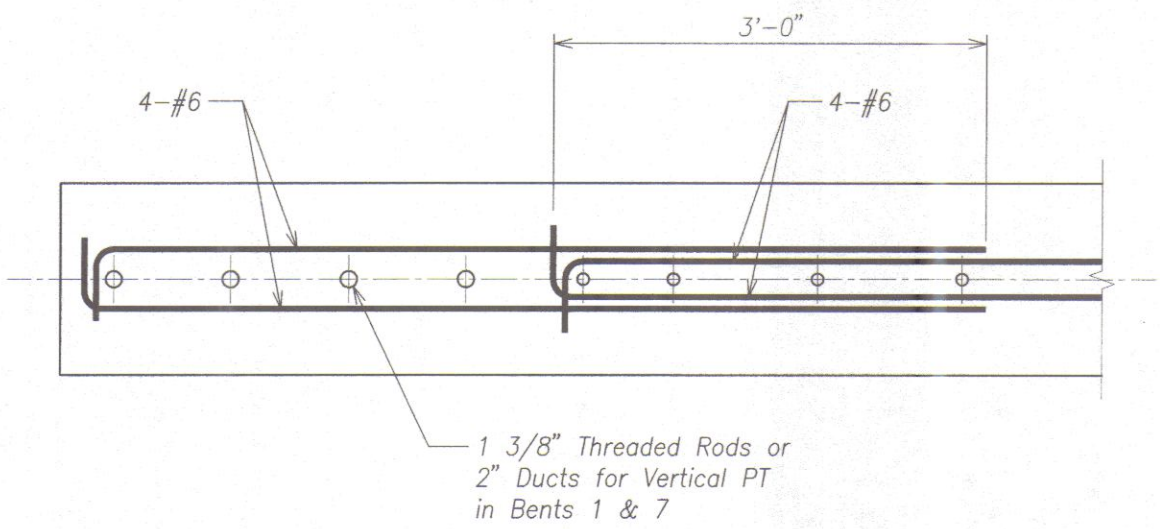

SECTION A
Scale: 1 1/2" = 1'-0" SB7B.5 SB7B.5

ORIGINAL PLAN	DATE
NOTED BY	
DESIGNED BY	
QUANTITIES BY	
CHECKED BY	

DRAWING NAME: Z:\00 ONGOING\40019.0-HONOAPIILANI LAHAINA BYPASS-KAHOA W\06-15-10 COMBINE LAHAINA FINAL DESIGN\HH-SB700B4.DWG PLOT TIME: 06-14-10, 3:23 PM

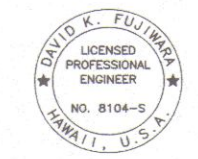


THIS WORK WAS PREPARED BY ME
OR UNDER MY SUPERVISION.
David K. Fujiwara
KSF, INC. APRIL 30, 2012
LIC. EXP. DATE

STATE OF HAWAII
DEPARTMENT OF TRANSPORTATION
HIGHWAYS DIVISION

BENT SECTION AND DETAIL

HONOAPIILANI HIGHWAY REALIGNMENT, PHASE 1A
Future Keawe St Extension to Lahainaluna Rd, Part B
Fed. Aid Proj. No. NH-030-1(35)R
Scale: As Noted Date: June, 2010
SHEET No. SB7B.5of 5 SHEETS

FED. ROAD DIST. NO.	STATE	FED. AID PROJ. NO.	FISCAL YEAR	SHEET NO.	TOTAL SHEETS
HAWAII	HAW.	NH-030-1(35)R	2009	320	383

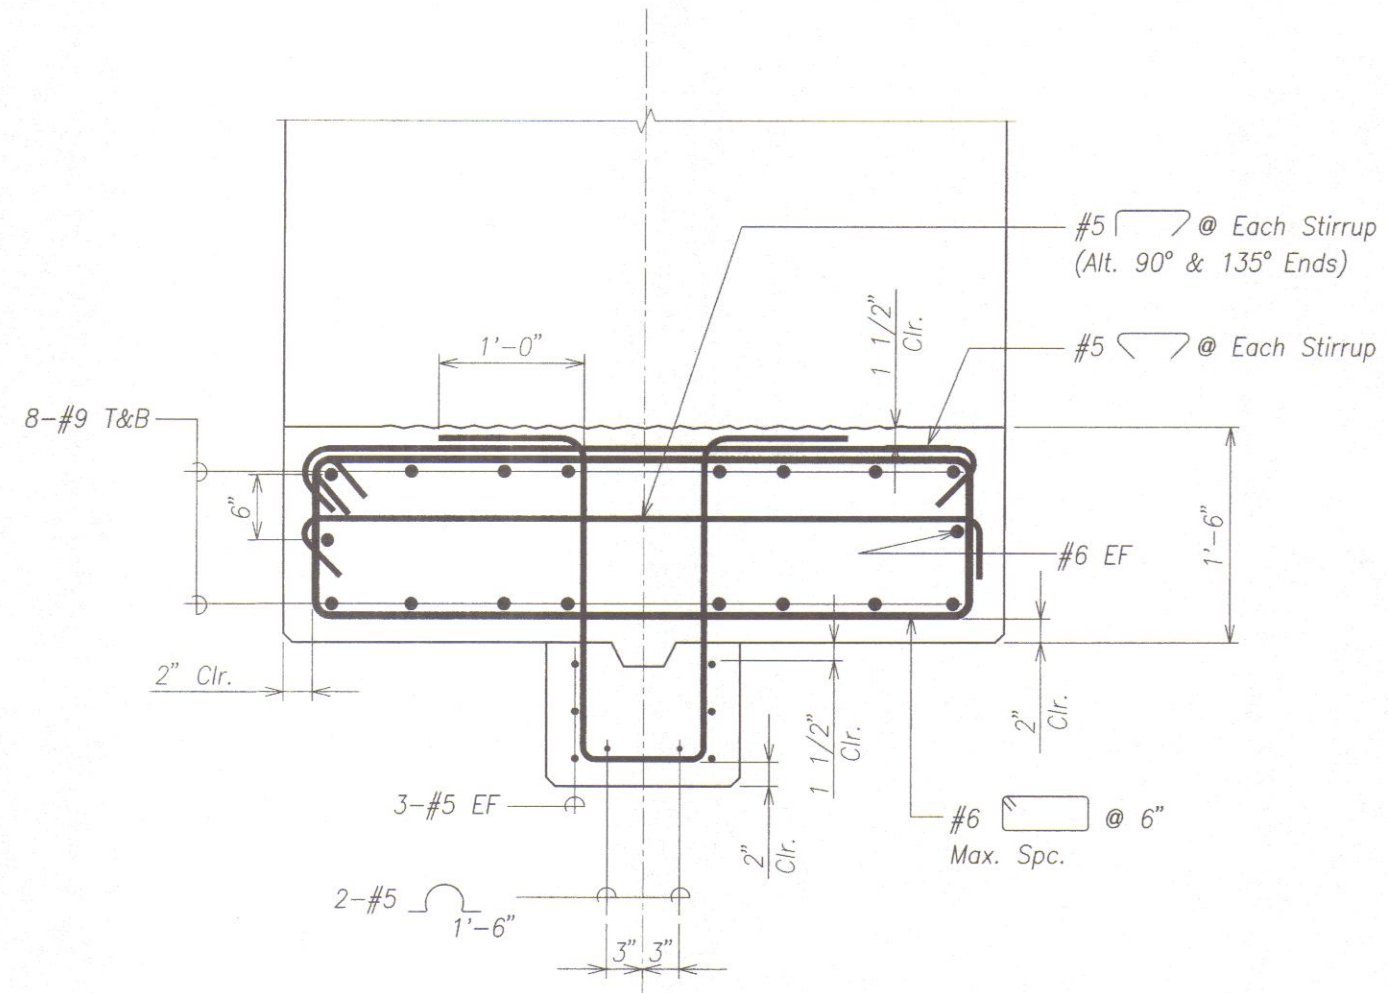


SECTION - BELOW GIRDER

Scale: 1 1/2" = 1'-0"

SB7A.2 | SB7C.1

SB7A.3, SB7A.4 SB7A.5, SB7A.6

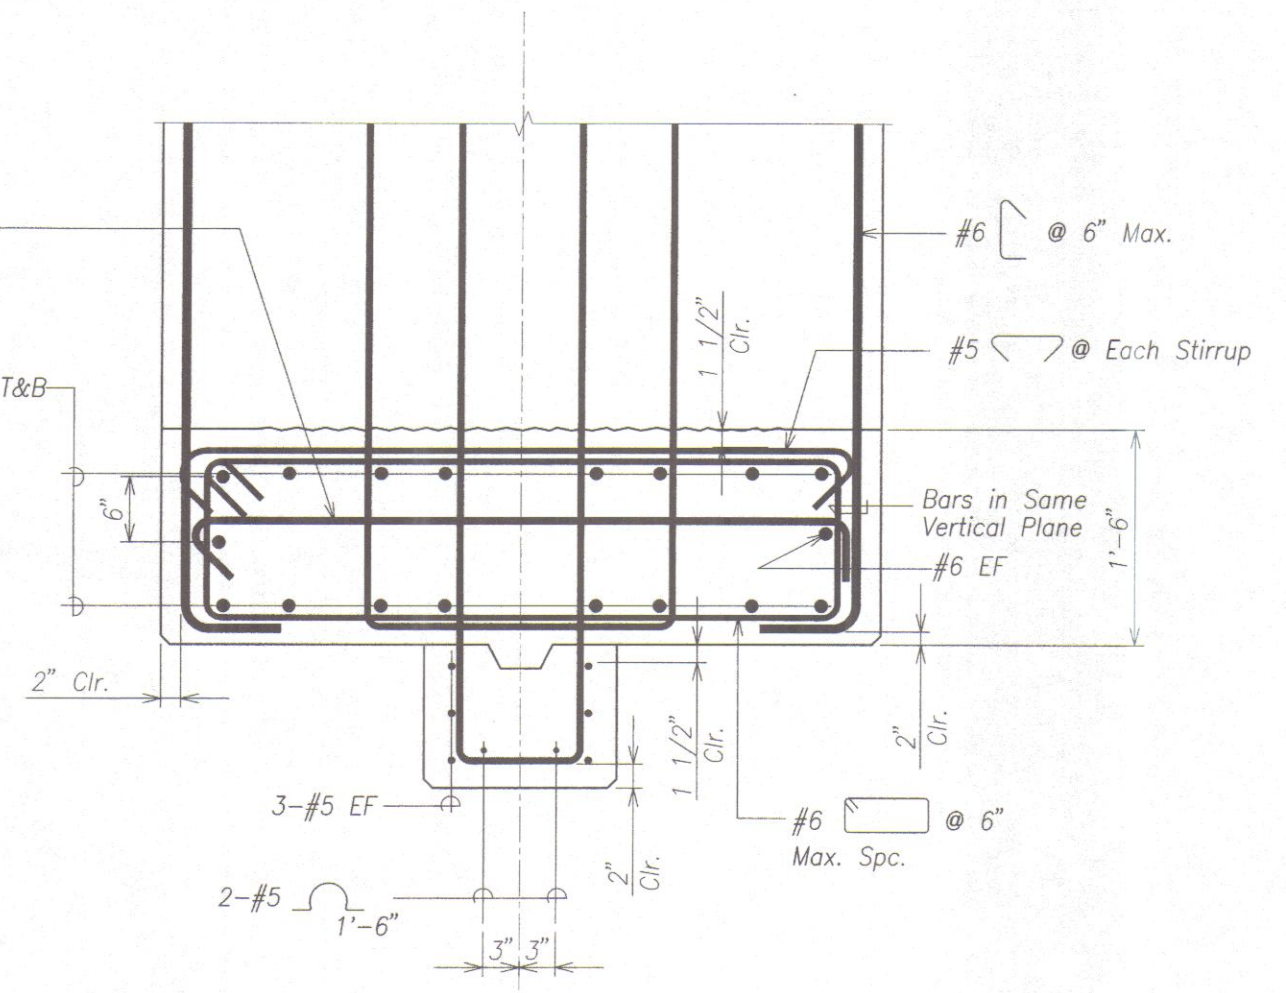

SECTION

Scale: 1 1/2" = 1'-0"

SB7A.2 | SB7C.1

SB7A.3, SB7A.4 SB7A.5, SB7A.6



THIS WORK WAS PREPARED BY ME
OR UNDER MY SUPERVISION.

David K. Fujimura
KSF, INC. APRIL 30, 2012
LIC. EXP. DATE

STATE OF HAWAII
DEPARTMENT OF TRANSPORTATION
HIGHWAYS DIVISION

BENT CAP

HONOAPIILANI HIGHWAY REALIGNMENT, PHASE 1A
Future Keawe St Extension to Lahainaluna Rd, Part B
Fed. Aid Proj. No. NH-030-1(35)R

Scale: As Noted Date: June, 2010

SHEET No. SB7C.1 OF 1 SHEETS

FINAL DESIGN 320




ORIGINAL PLAN	SURVEY PLOTTED BY	DATE
NOTE BOOK	DRAWN BY	
	DESIGNED BY	
	CHECKED BY	
No.		

DRAWING NAME: Z:\100 CONCRETE\40019.0-HONOAPIILANI LAHAINA BYPASS-KAHOMA WO\06-15-10 COMBINE LAHAINA FINAL DESIGN\HH-SB700C1.DWG PLOT TIME: 06-14-10, 3:24 PM

FED. ROAD DIST. NO.	STATE	FED. AID PROJ. NO.	FISCAL YEAR	SHEET NO.	TOTAL SHEETS
HAWAII	HAW.	NH-030-1(35)R	2009	321	383

NOTE:


See A/SB7D.2 for Section at Bents 1 & 7.

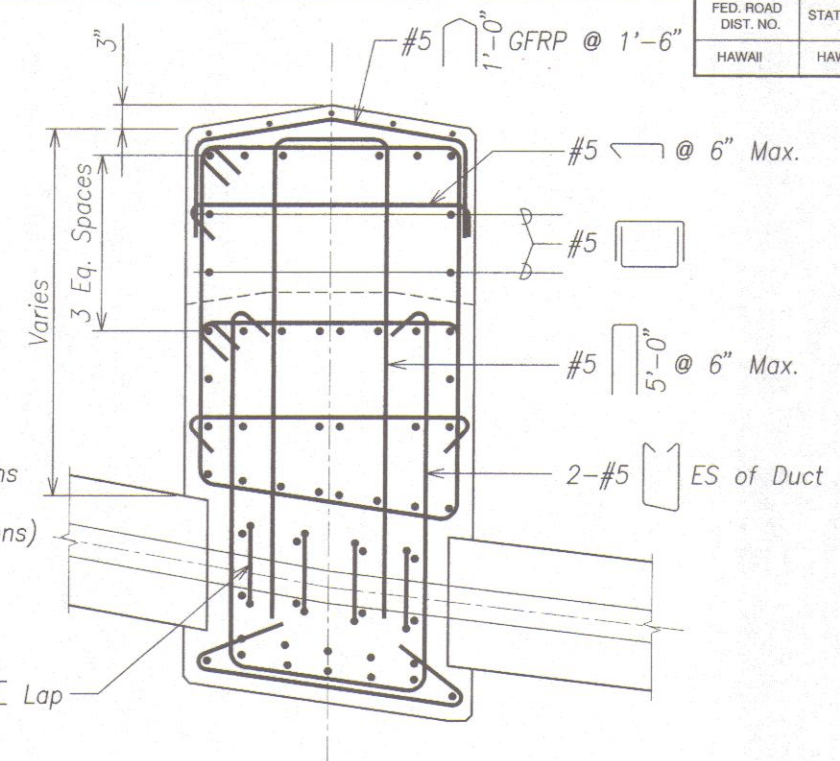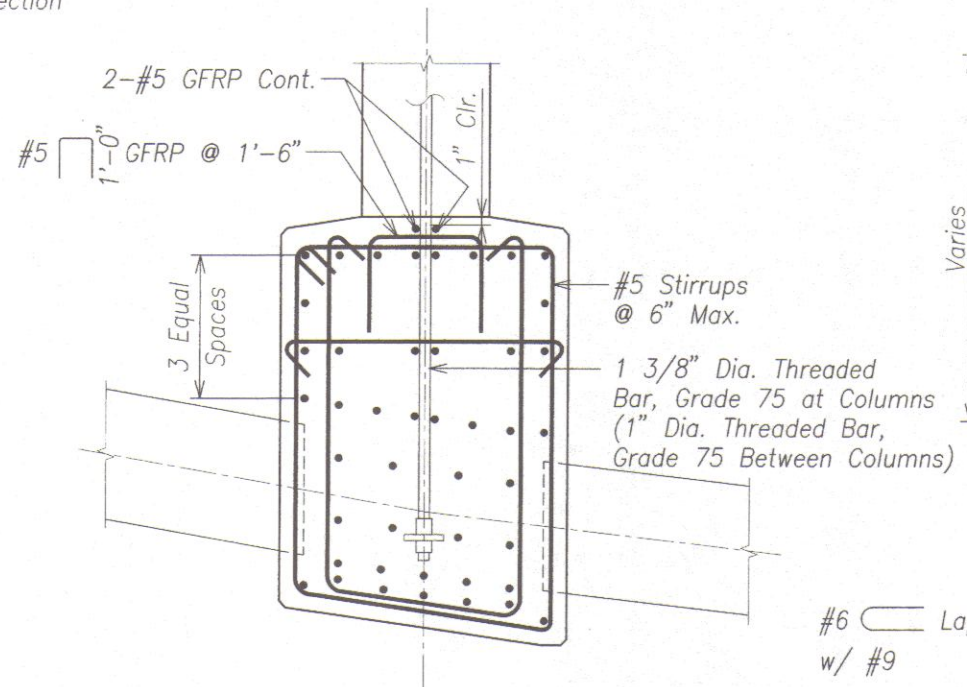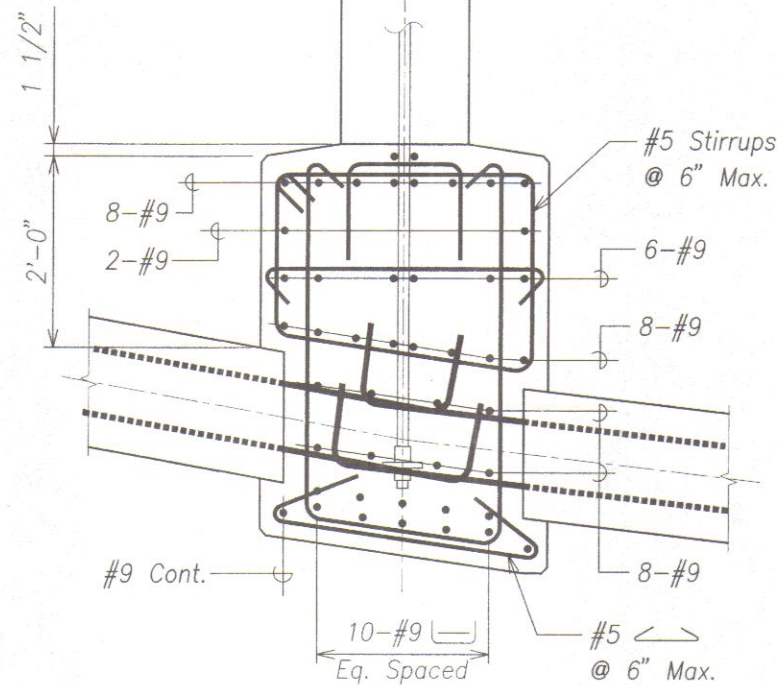

SECTION AT PATP A
Scale: 1" = 1'-0" SB7D.1/SB7D.1

SECTION BETWEEN PATP B
Scale: 1" = 1'-0" SB7D.1/SB7D.1

SECTION AT PATP C
Scale: 1" = 1'-0" SB7D.1/SB7D.1

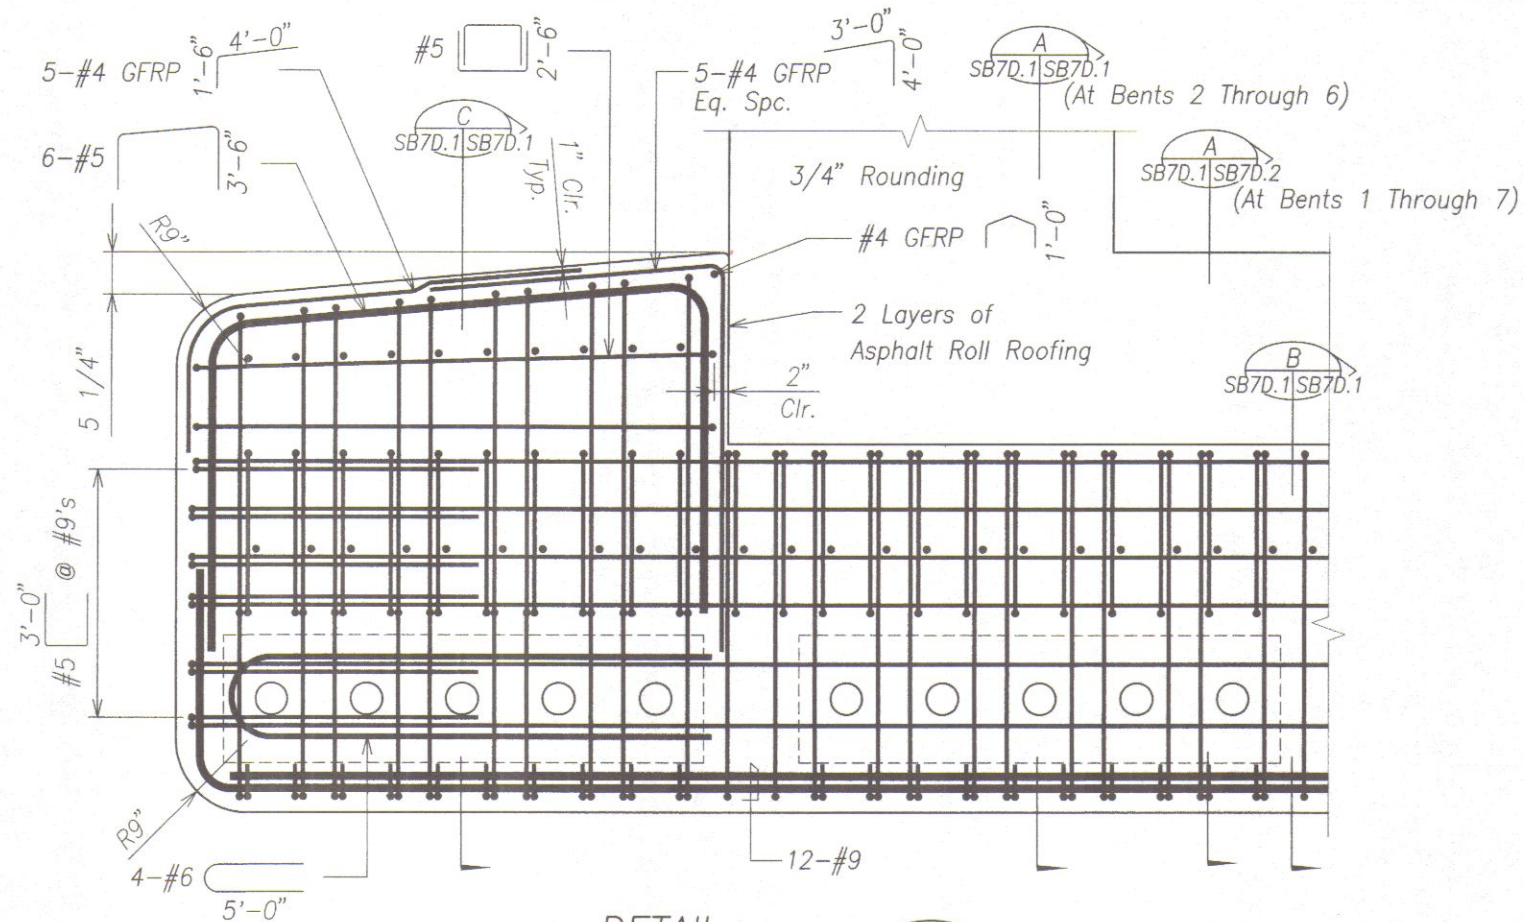

DETAIL 1
Scale: 1" = 1'-0" SB7A.1/SB7D.1




THIS WORK WAS PREPARED BY ME
OR UNDER MY SUPERVISION.
David K. Fujiwara
KSF, INC. APRIL 30, 2012
LIC. EXP. DATE

STATE OF HAWAII
DEPARTMENT OF TRANSPORTATION
HIGHWAYS DIVISION


STIFFENER BEAM
SECTIONS AND DETAIL
HONOAPIILANI HIGHWAY REALIGNMENT, PHASE 1A
Future Keawe St Extension to Lahainaluna Rd, Part B
Fed. Aid Proj. No. NH-030-1(35)R
Scale: As Noted Date: June, 2010
SHEET No. SB7D.1 OF 3 SHEETS

FINAL DESIGN 321

FED. ROAD DIST. NO.	STATE	FED. AID PROJ. NO.	FISCAL YEAR	SHEET NO.	TOTAL SHEETS
HAWAII	HAW.	NH-030-1(35)R	2009	322	383

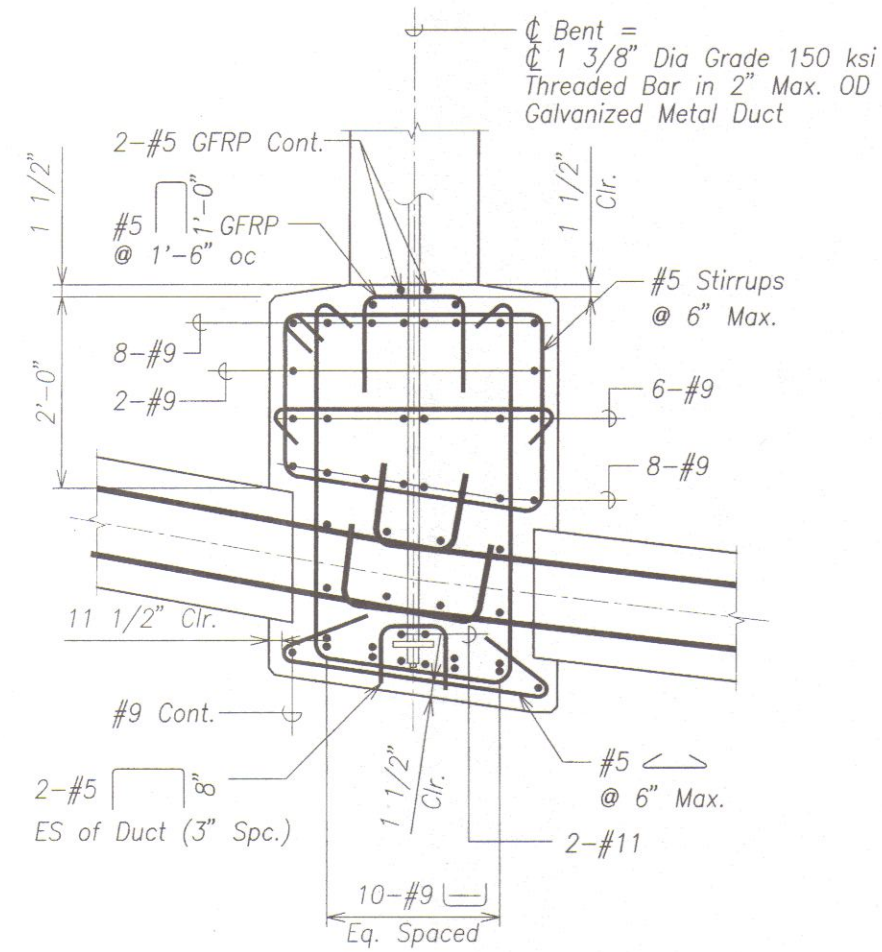


SECTION AT BENTS 1 & 7
Scale: 1" = 1'-0"
SB7A.1/SB7D.2

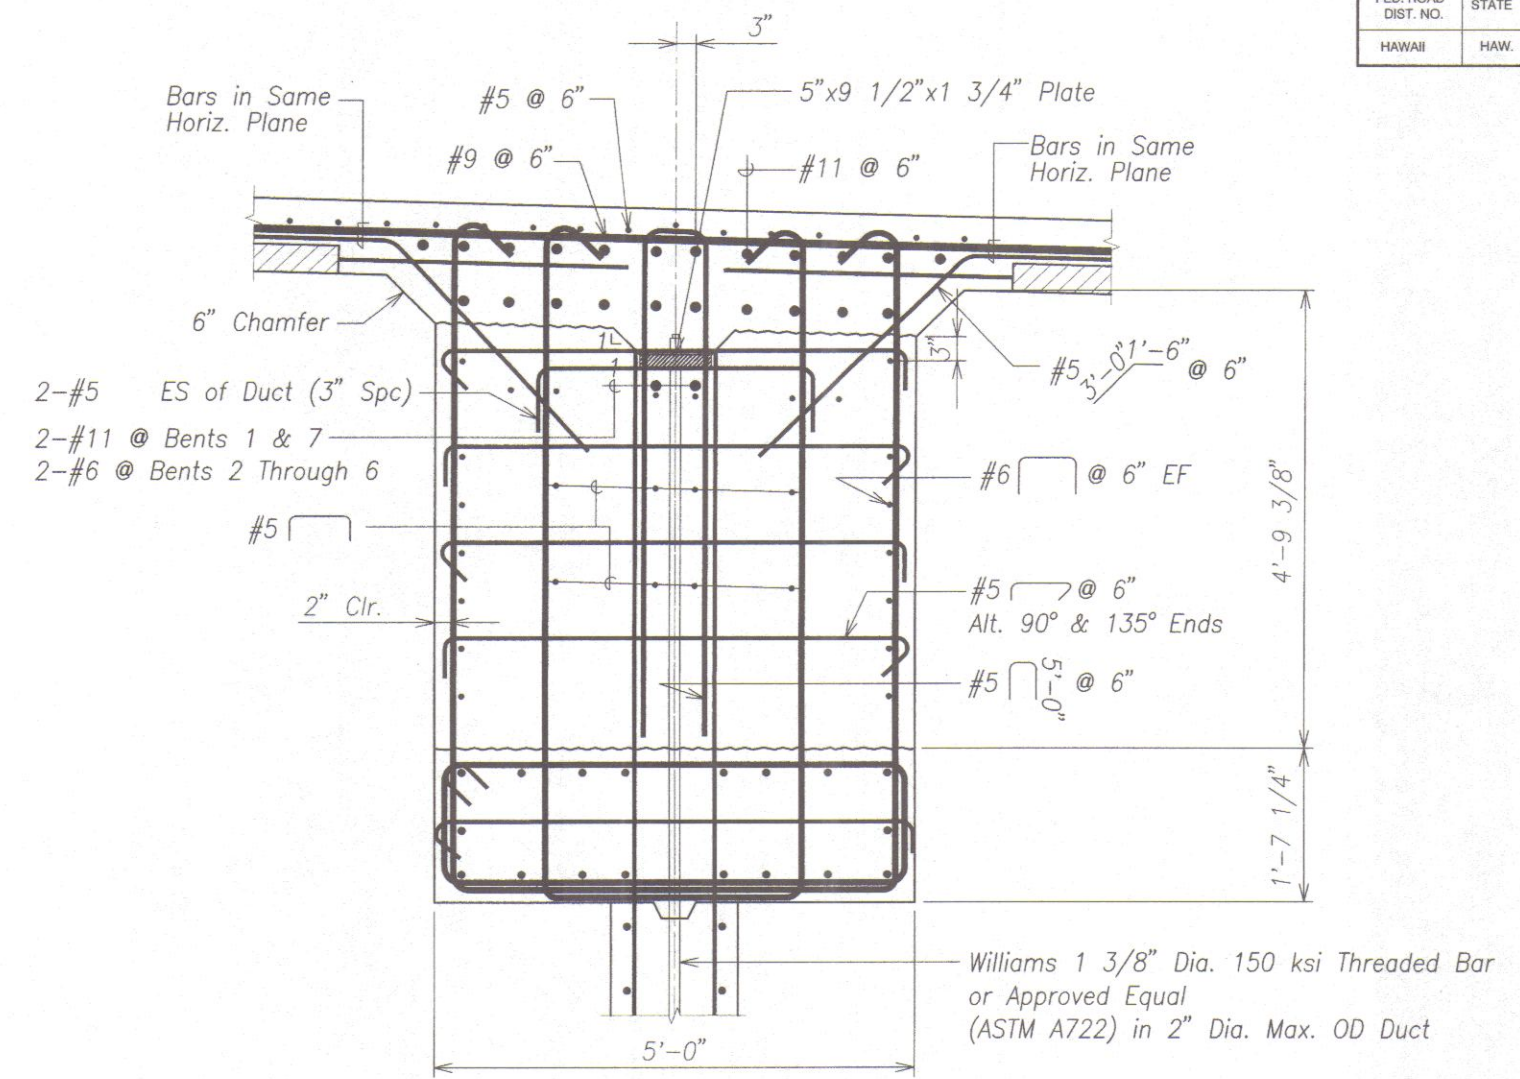

TYPICAL SECTION
BETWEEN GIRDERS
Scale: 1" = 1'-0"
SB3.4, SB3.10
SB7A.1/SB7D.2

ORIGINAL PLAN	SURVEY PLOTTED BY	DATE
NOTE BOOK	DRAWN BY	
No.	DESIGNED BY	
	QUANTITIES BY	
	CHECKED BY	

DRAWING NAME: Z:\00 ONGOING\40019.0-HONOAPIILANI LAHAINA BYPASS-KAHOMA WO\06-15-10 COMBINE LAHAINA FINAL DESIGN\HH-SB700D1.DWG PLOT TIME: 06-14-10, 3:25 PM

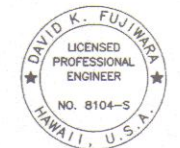


THIS WORK WAS PREPARED BY ME OR UNDER MY SUPERVISION.
David K. Fujiwara
KSF, INC. APRIL 30, 2012
LIC. EXP. DATE


STATE OF HAWAII
DEPARTMENT OF TRANSPORTATION
HIGHWAYS DIVISION
STIFFENER BEAM SECTIONS
HONOAPIILANI HIGHWAY REALIGNMENT, PHASE 1A
Future Keawe St Extension to Lahainaluna Rd, Part B
Fed. Aid Proj. No. NH-030-1(35)R
Scale: As Noted Date: June, 2010
SHEET No. SB7D.20F 3 SHEETS

FED. ROAD DIST. NO.	STATE	FED. AID PROJ. NO.	FISCAL YEAR	SHEET NO.	TOTAL SHEETS
HAWAII	HAW.	NH-030-1(35)R	2009	323	383

- NOTES:
1. Stiffener Beam at Bent 2 shown.
 2. For reinforcing, see Sht. SB7D.1, similar.
 3. For PATP, See Sheet SB6 Series.

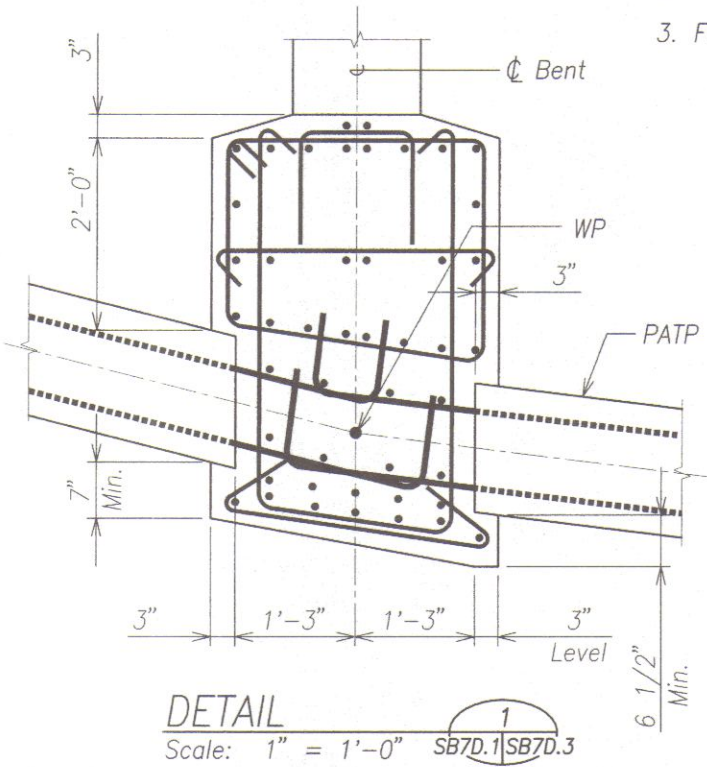

BENT NO.	⊖
1	0
2	4°
3	4°
4	4°
5	4°
6	4°
7	0°

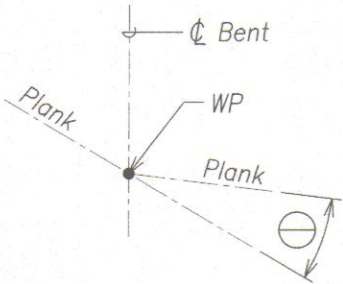

ANGLE CHANGE IN PATP AT STIFFENER BEAM

ORIGINAL PLAN	DATE
NOTED BY	DESIGNED BY
CHECKED BY	QUANTITIES BY
NO.	

DRAWING NAME: Z:\00 ONGOING\400\9.0-HONOAPIILANI LAHAINA BYPASS-KAHOMA WD\06-15-10 COMBINE LAHAINA FINAL DESIGN\HH-SB7D001.DWG PLOT TIME: 06-14-10, 3:28 PM)



THIS WORK WAS PREPARED BY ME OR UNDER MY SUPERVISION.

David K. Fujiwara APRIL 30, 2012
KSF, INC. LIC. EXP. DATE

STATE OF HAWAII
DEPARTMENT OF TRANSPORTATION
HIGHWAYS DIVISION

STIFFENER BEAM DETAIL

HONOAPIILANI HIGHWAY REALIGNMENT, PHASE 1A
Future Keawe St Extension to Lahainaluna Rd, Part B
Fed. Aid Proj. No. NH-030-1(35)R

Scale: As Noted Date: June, 2010

SHEET No. SB7D.3 OF 3 SHEETS

5'-0"

2'-6"

2'-6"

2" Clr. Typ.

⌀ Bearing Lower Element

SB8.1 SB8.1

5'-0"

2'-6"

2'-6"

⌀ Bearing Lower Element

2-#4 @ 3"

9 Sets of #5

1'-10" 2'-8" 1'-10"

Equally Spaced, EW

Bars in Same Vertical Plane

Top of Abutment Cap

2" Clr.

2'-6"

C Bearing

Lower Element

Level at Top

2'-6"

2" Clr.

9 Sets of #5

1'-10" 2'-8" 1'-10"

Equally Spaced, EW Except Bundle Bars at Shear Lugs. Provide 2" Clear to Bundle Bars


2-#4 @ 3"

NOTE:


DAVID K. FUJIMURA
LICENSED PROFESSIONAL

SECTION - CONCRETE SEAT 


SCALE: 1" = 1'-0"

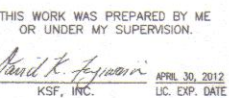


FINAL DESIGN 324

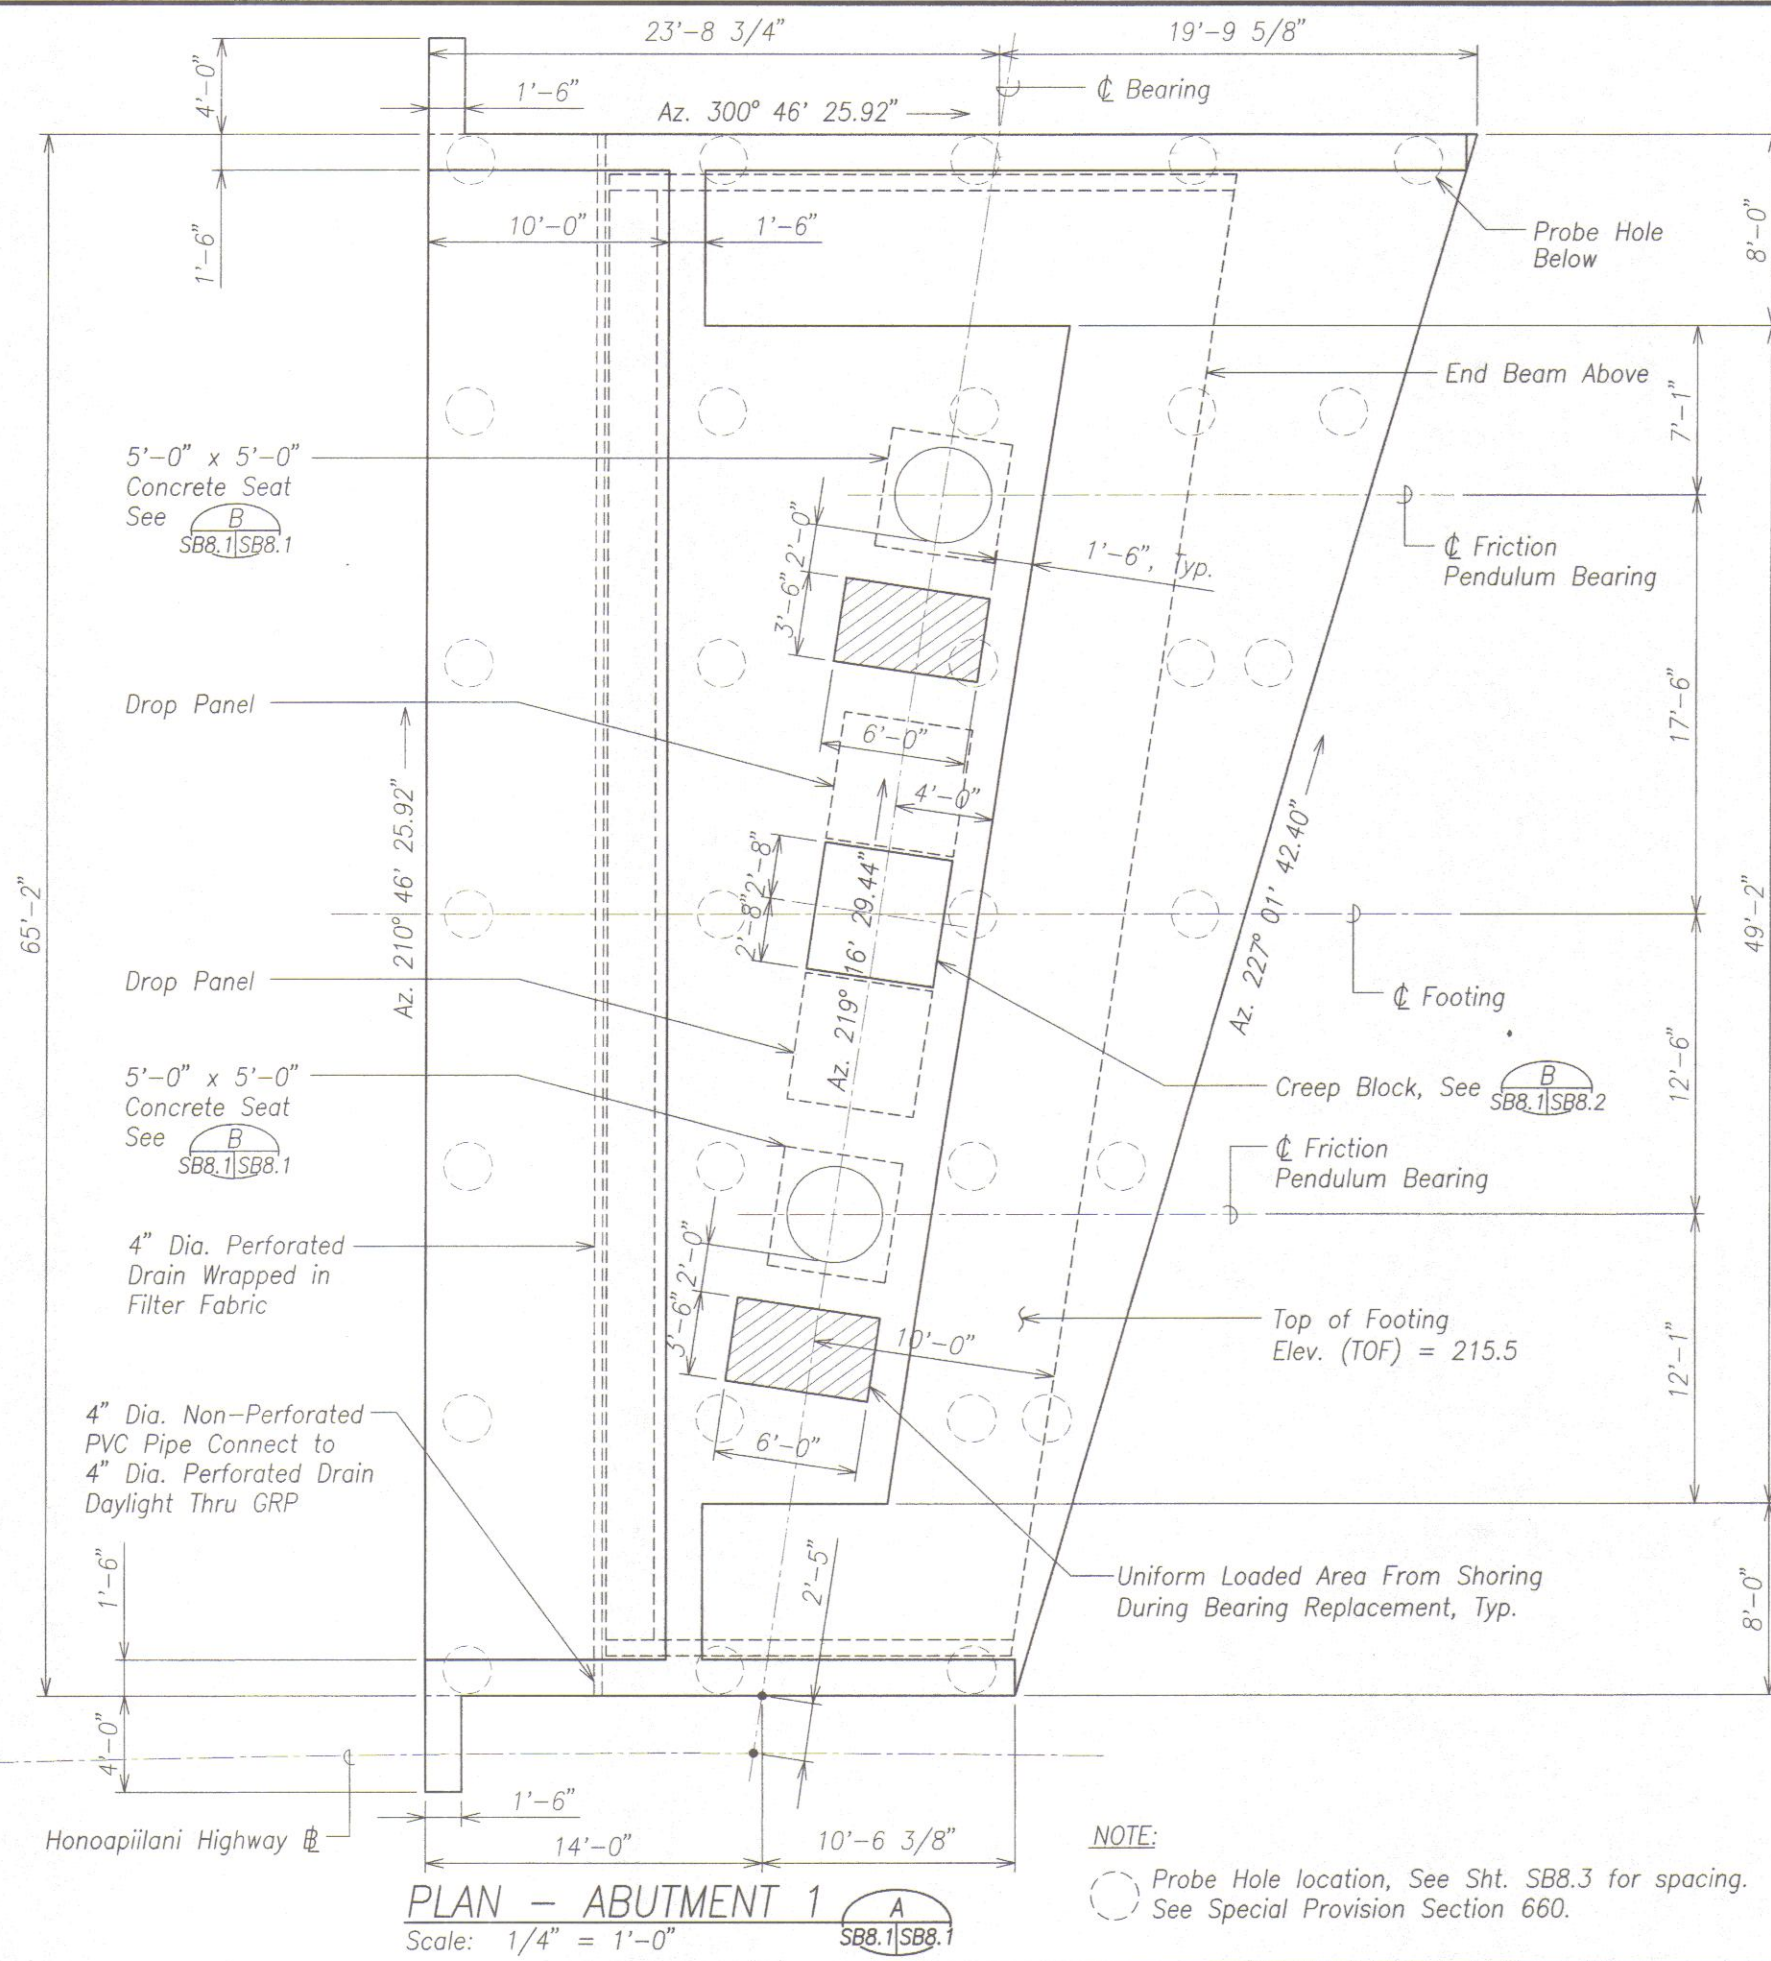


FED. ROAD DIST. NO.	STATE	FED. AID PROJ. NO.	FISCAL YEAR	SHEET NO.	TOTAL SHEETS
HAWAII	HAW.	NH-030-1(35)R	2009	325	383

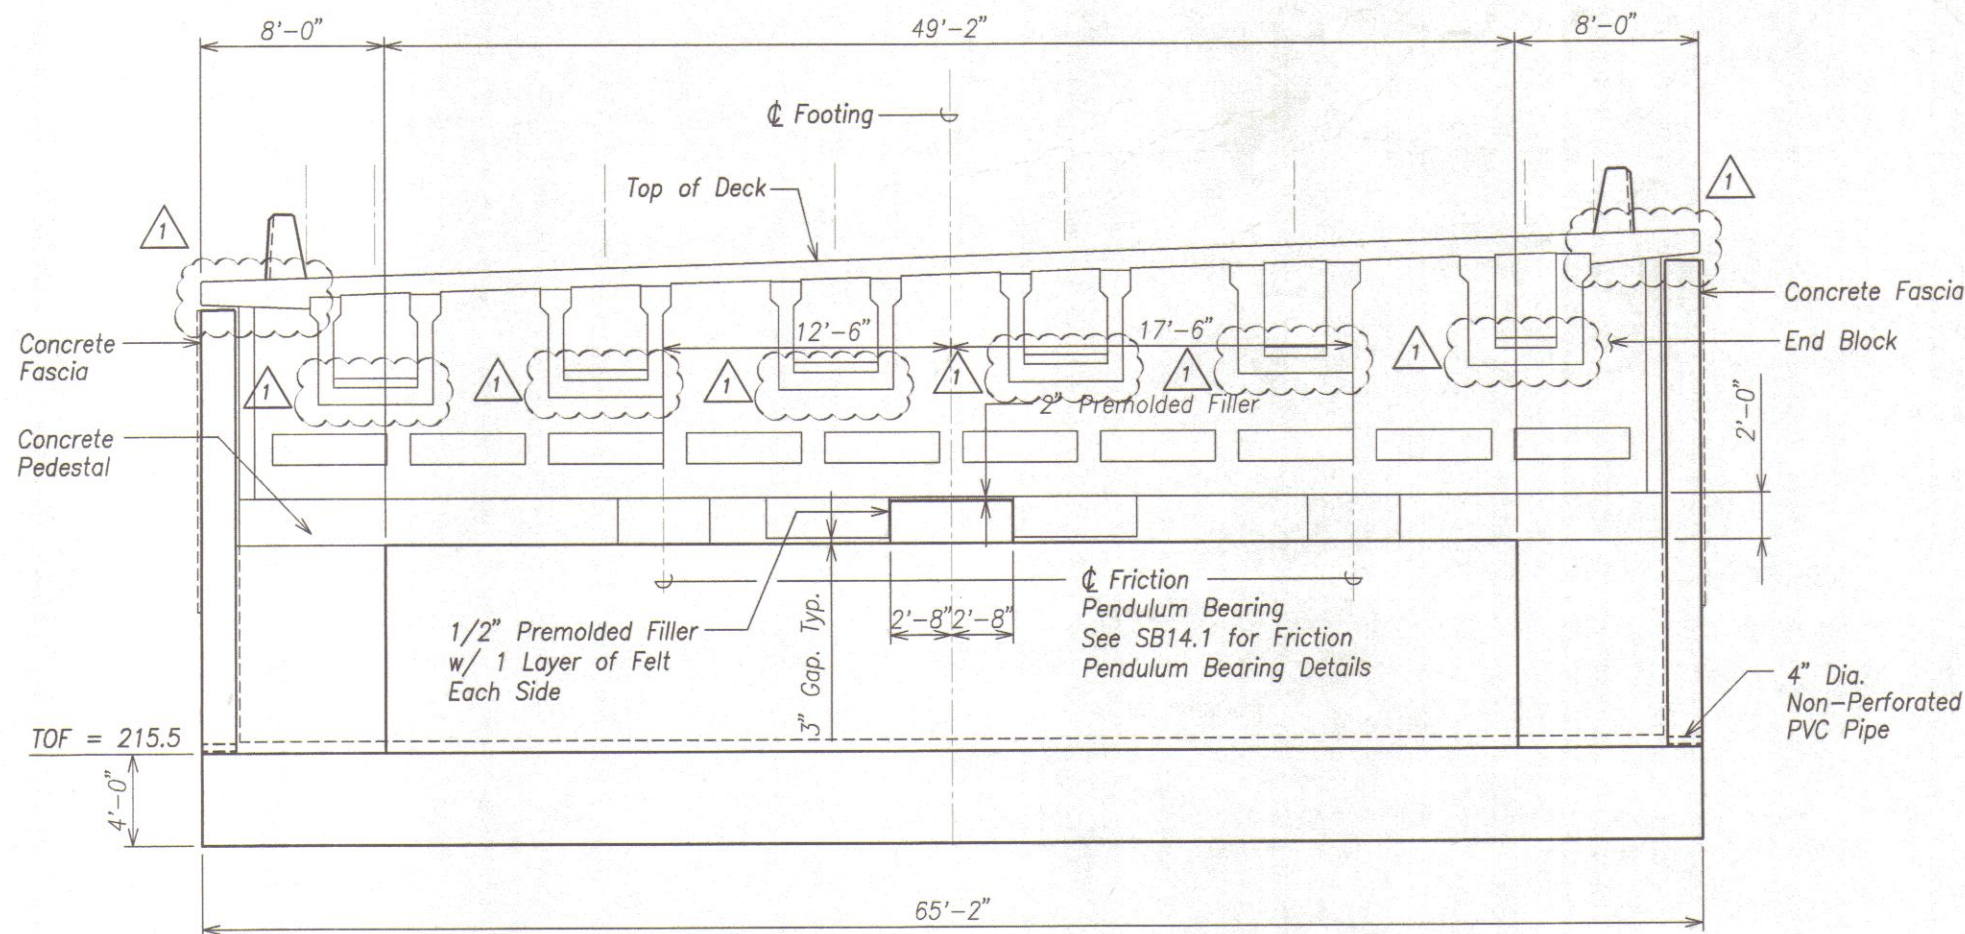

ELEVATION - ABUTMENT 1
Scale: 1/4" = 1'-0"

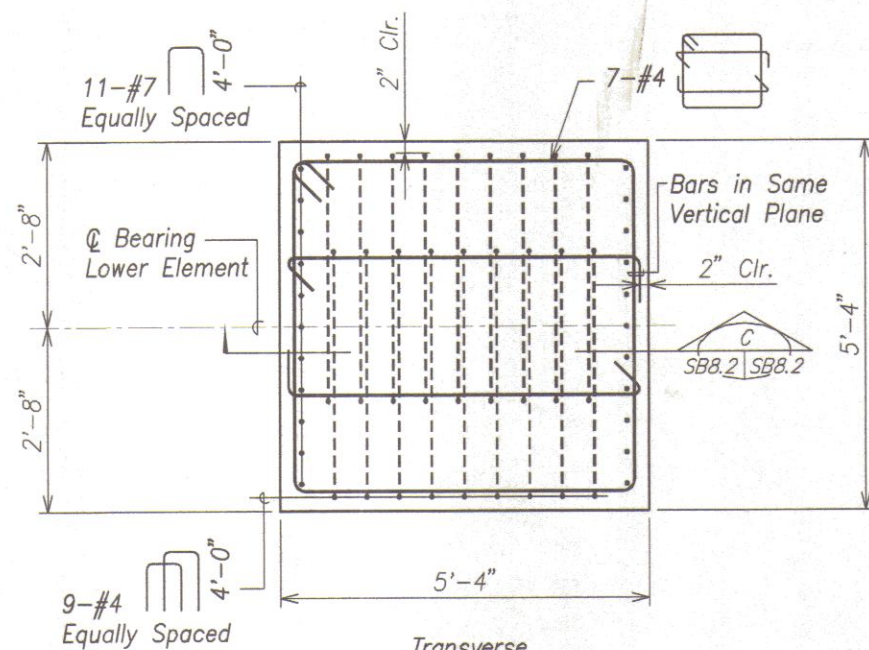


PLAN - CREEP BLOCK
SCALE: 3/4" = 1'-0"

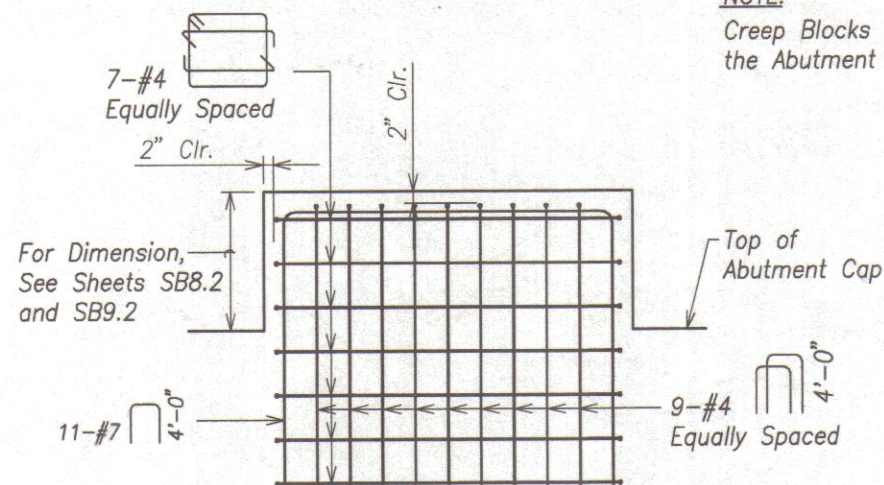

SECTION - CREEP BLOCK
SCALE: 3/4" = 1'-0"

NOTE:
Creep Blocks shall be poured monolithic with the Abutment Cap.

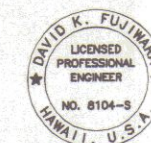


THIS WORK WAS PREPARED BY ME OR UNDER MY SUPERVISION.

APRIL 30, 2012
KSF, INC. LIC. EXP. DATE


STATE OF HAWAII DEPARTMENT OF TRANSPORTATION HIGHWAYS DIVISION
ABUTMENT 1 ELEVATION AND CREEP BLOCK PLAN AND SECTION
HONOAPIILANI HIGHWAY REALIGNMENT, PHASE 1A
Future Keawe St Extension to Lahainaluna Rd, Part B
Fed. Aid Proj. No. NH-030-1(35)R
Scale: As Noted Date: June, 2010
SHEET No. SB8.2 OF 6 SHEETS

2/01/11	1	Revisions
DATE	REVISION	


FED. ROAD DIST. NO.	STATE	FED. AID PROJ. NO.	FISCAL YEAR	SHEET NO.	TOTAL SHEETS
HAWAII	HAW.	NH-030-1(35)R	2009	325	383

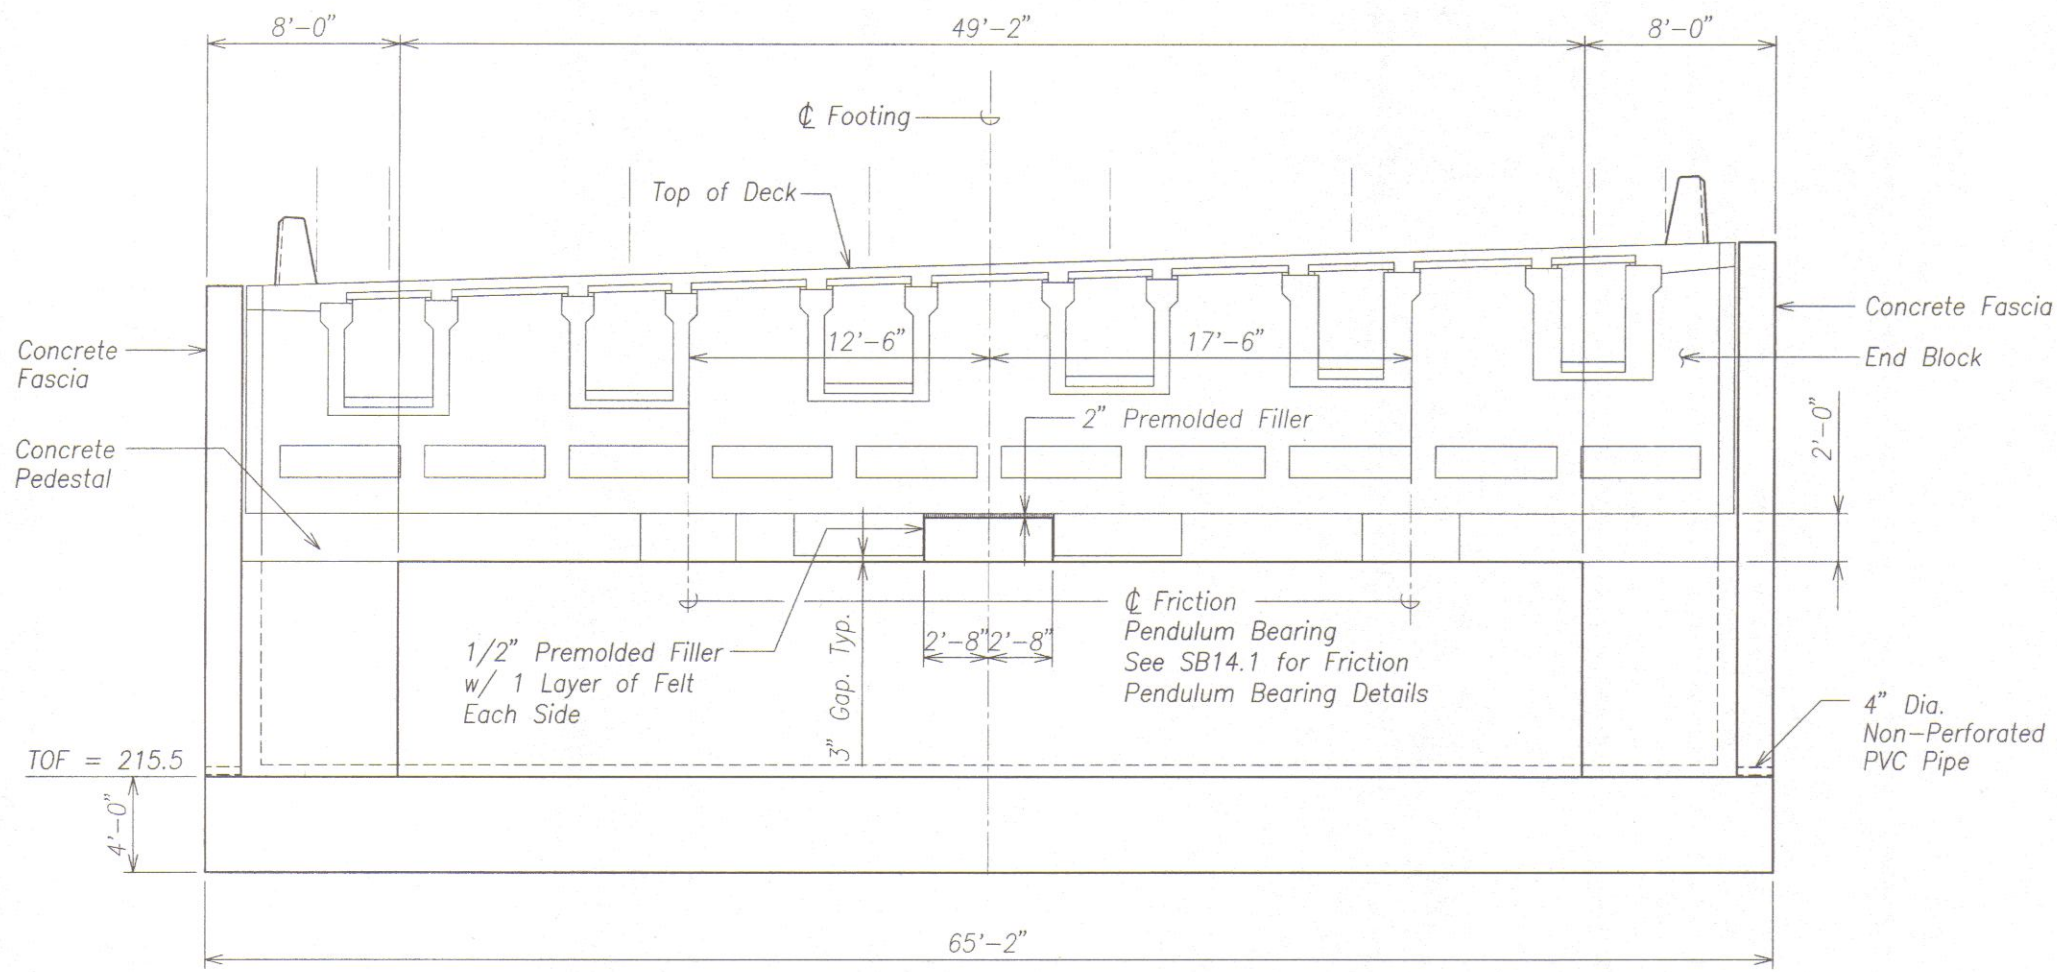

ELEVATION - ABUTMENT 1
Scale: 1/4" = 1'-0"

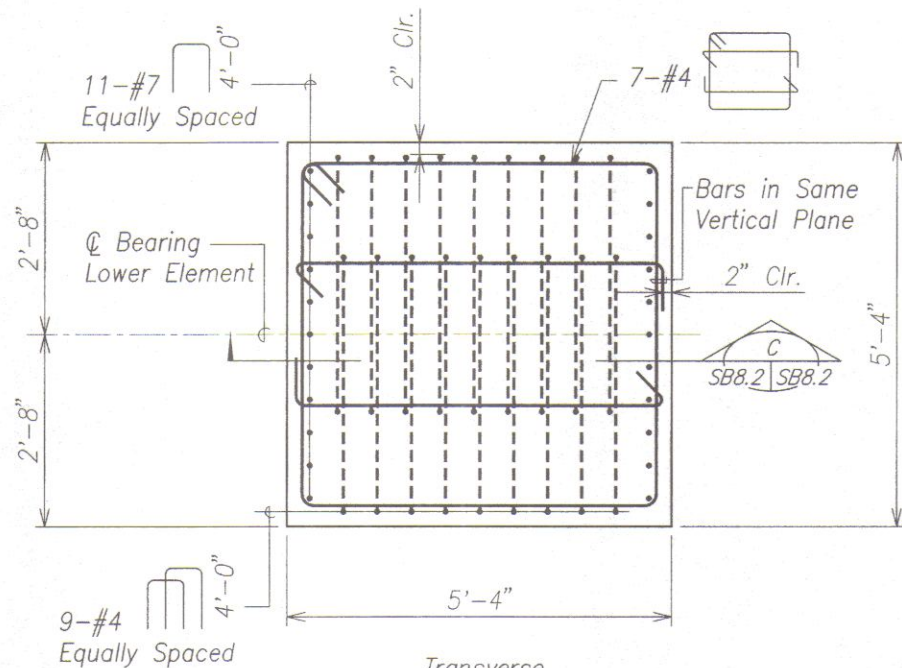

PLAN - CREEP BLOCK B
SCALE: 3/4" = 1'-0"

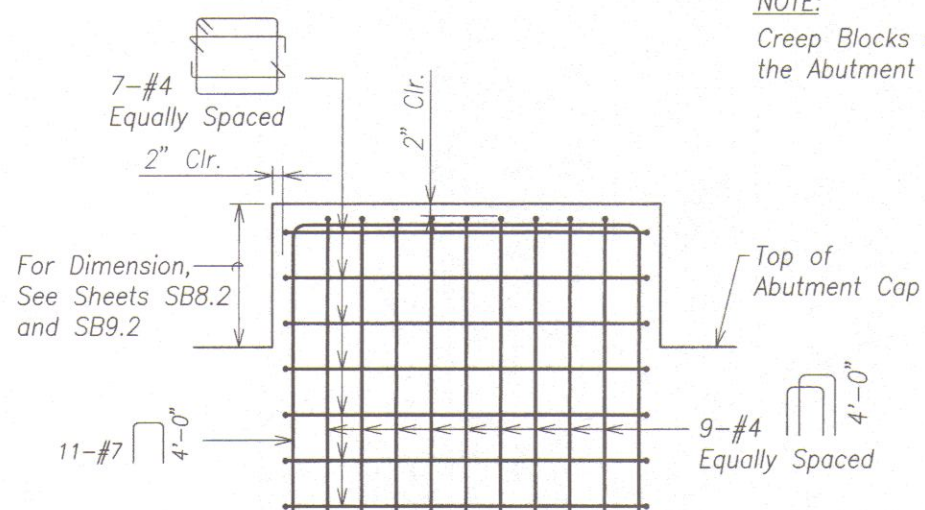

SECTION - CREEP BLOCK C
SCALE: 3/4" = 1'-0"

NOTE:
Creep Blocks shall be poured monolithic with the Abutment Cap.



THIS WORK WAS PREPARED BY ME OR UNDER MY SUPERVISION.
David K. Fujiwara
KSF, INC. APRIL 30, 2012
LIC. EXP. DATE

STATE OF HAWAII
DEPARTMENT OF TRANSPORTATION
HIGHWAYS DIVISION


ABUTMENT 1 ELEVATION AND CREEP BLOCK PLAN AND SECTION
HONOAPIILANI HIGHWAY REALIGNMENT, PHASE 1A
Future Keawe St Extension to Lahainaluna Rd, Part B
Fed. Aid Proj. No. NH-030-1(35)R

Scale: As Noted Date: June, 2010

SHEET No. SB8.2 OF 6 SHEETS


FINAL DESIGN 325

FED. ROAD DIST. NO.	STATE	FED. AID PROJ. NO.	FISCAL YEAR	SHEET NO.	TOTAL SHEETS
HAWAII	HAW.	NH-030-1(35)R	2009	326	383

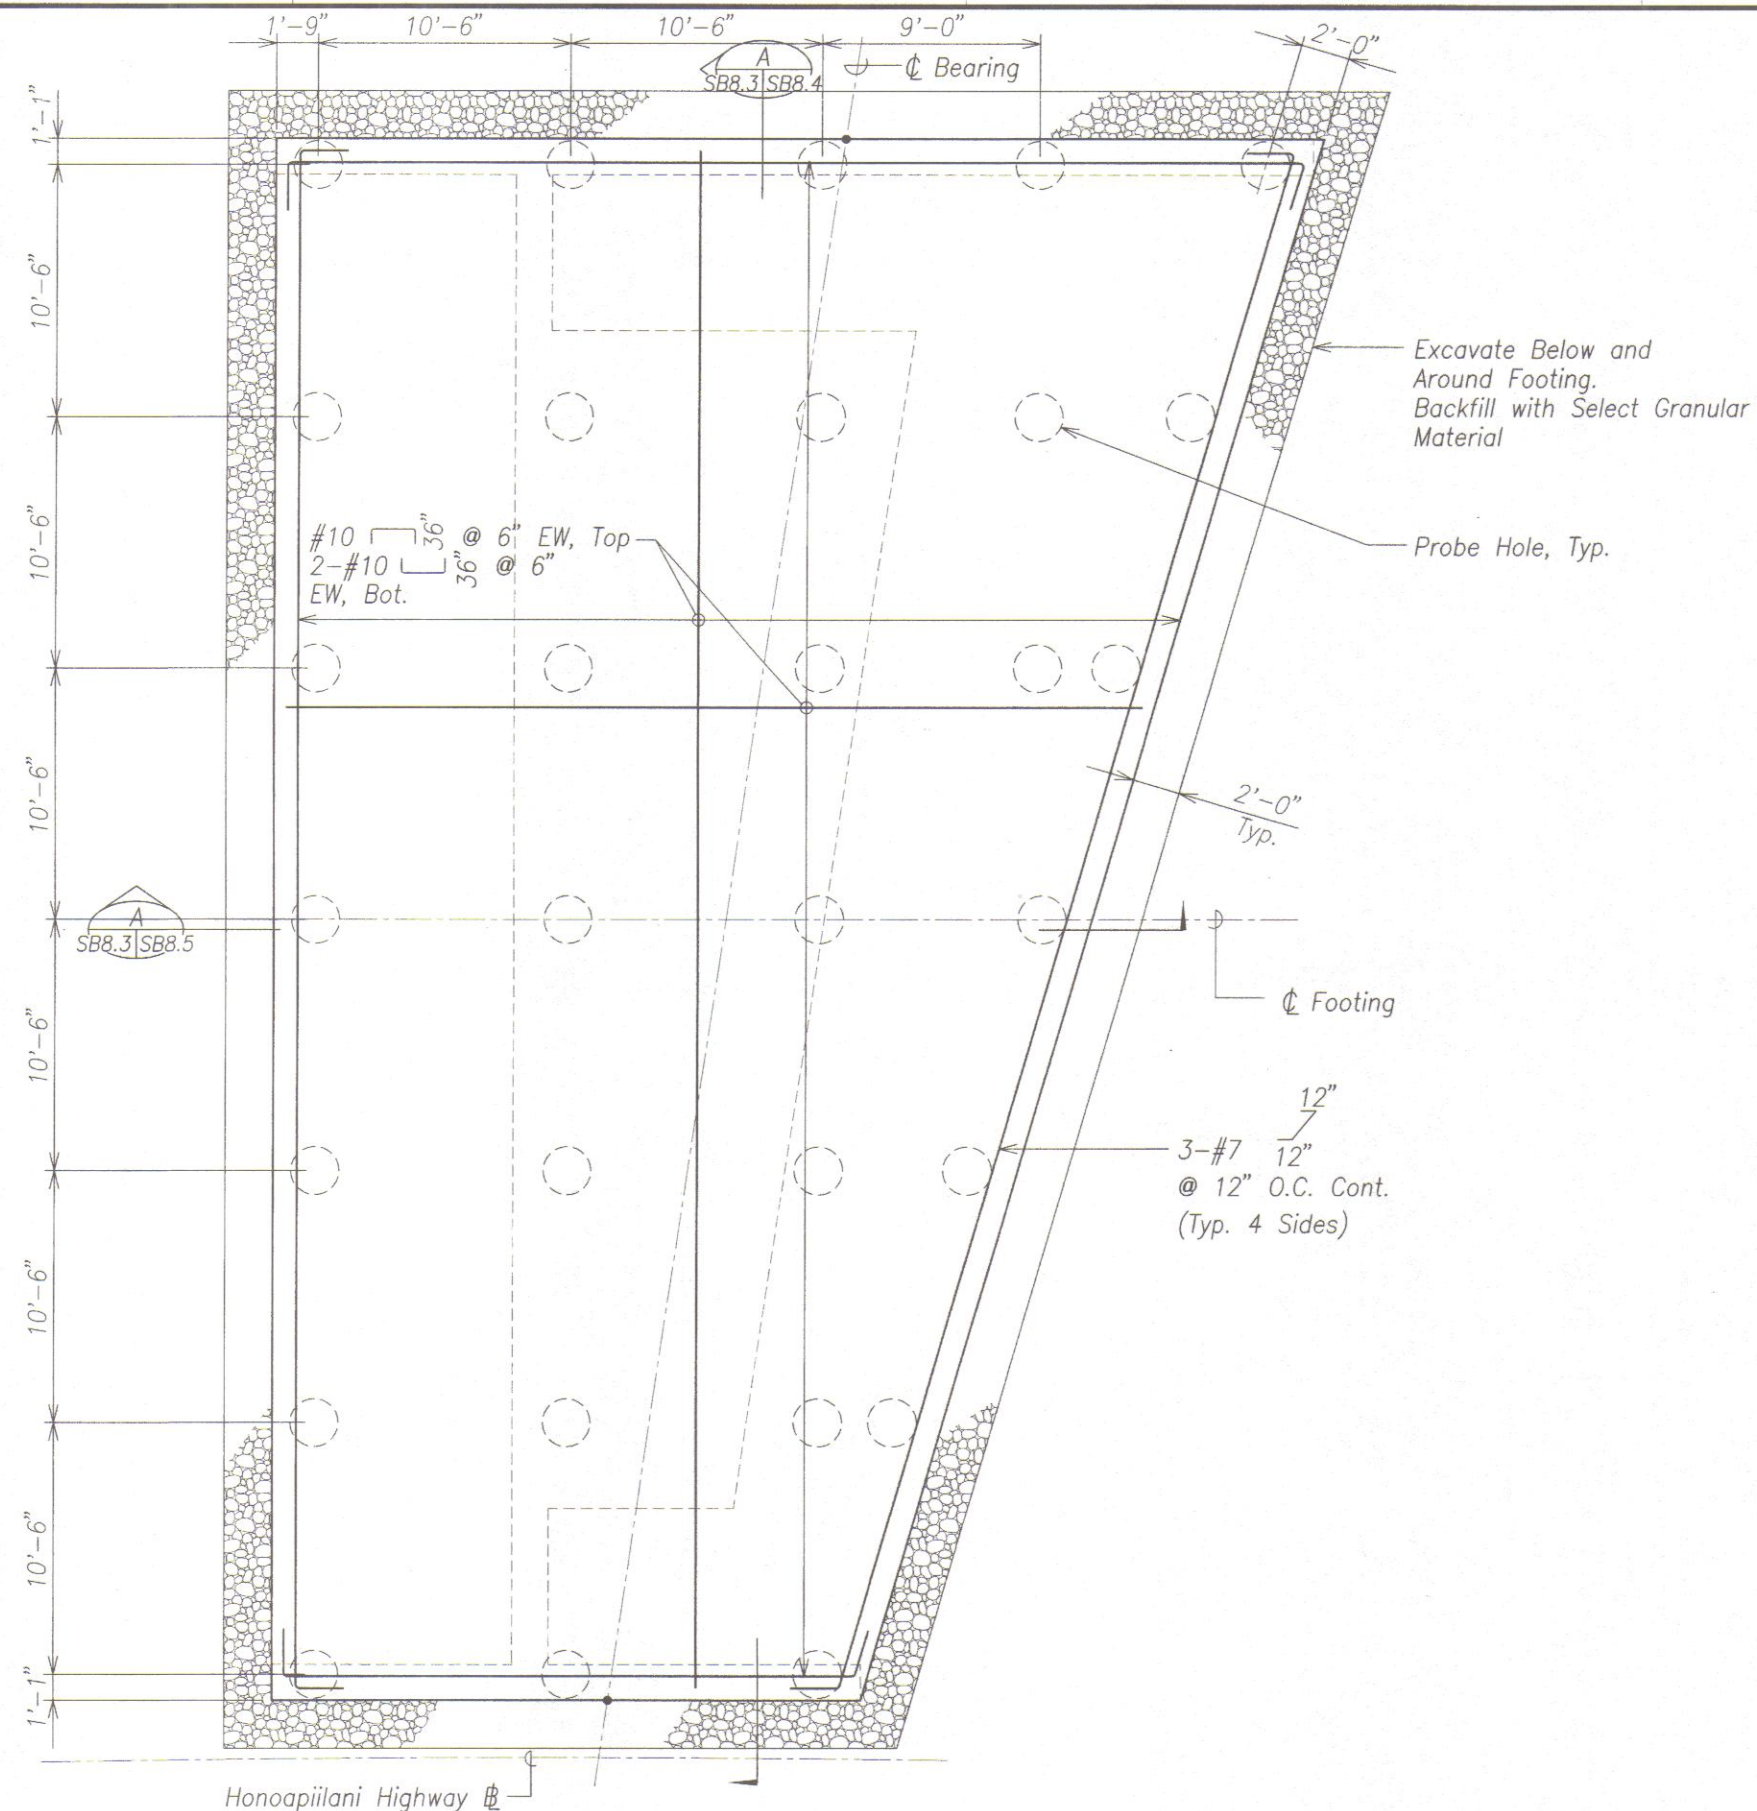

NOTE:

Ties shall have a 135° hook on one end and a 90° hook on the opposite end. Ties shall be placed so that 90° and 135° of adjacent ties, horizontally and vertically, shall be alternated.

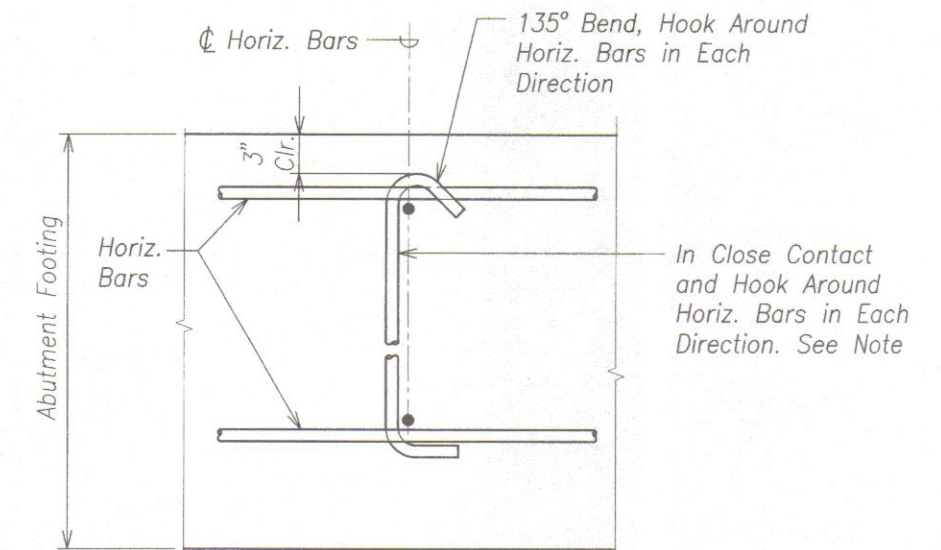

TIE BAR DETAIL
Scale: $1 \frac{1}{2}'' = 1'-0''$
SB8.5, SB9.4, SB9.5, 1 SB8.4 SB8.3



THIS WORK WAS PREPARED BY ME
OR UNDER MY SUPERVISION.

David K. Feyman APRIL 30, 2012
KSF, INC. LIC. EXP. DATE

STATE OF HAWAII
DEPARTMENT OF TRANSPORTATION
HIGHWAYS DIVISION
ABUTMENT 1
FOOTING REINFORCING PLAN AND DETAIL
HONOAPIILANI HIGHWAY REALIGNMENT, PHASE 1A
Future Keawe St Extension to Lahainaluna Rd, Part B
Fed. Aid Proj. No. NH-030-1(35)R

Scale: As Noted Date: June, 2010

SHEET No. SB8.3 OF 6 SHEETS

FINAL DESIGN 326

ORIGINAL PLAN	SURVEY PLOTTED BY _____ DATE _____
NOTE BOOK	DRAWN BY _____
	TRACED BY _____
	DESIGNED BY _____
	QUANTITIES BY _____
No. _____	CHECKED BY _____


DRAWING NAME: Z:\00 ONGOING\40019.0--HONCAPILLANI LAHAINA BYPASS--KAHOMA WO\06-15-10 COMBINE LAHAINA FINAL DESIGN\HH-SB801.DWG PLOT TIME: 06-14-10, 8:04 PM

FOOTING REINFORCING PLAN - ABUTMENT 1

Scale: $1/4" = 1'-0"$

SB8.3 SB8.3

FED. ROAD DIST. NO.	STATE	FED. AID PROJ. NO.	FISCAL YEAR	SHEET NO.	TOTAL SHEETS
HAWAII	HAW.	NH-030-1(35)R	2009	327	383

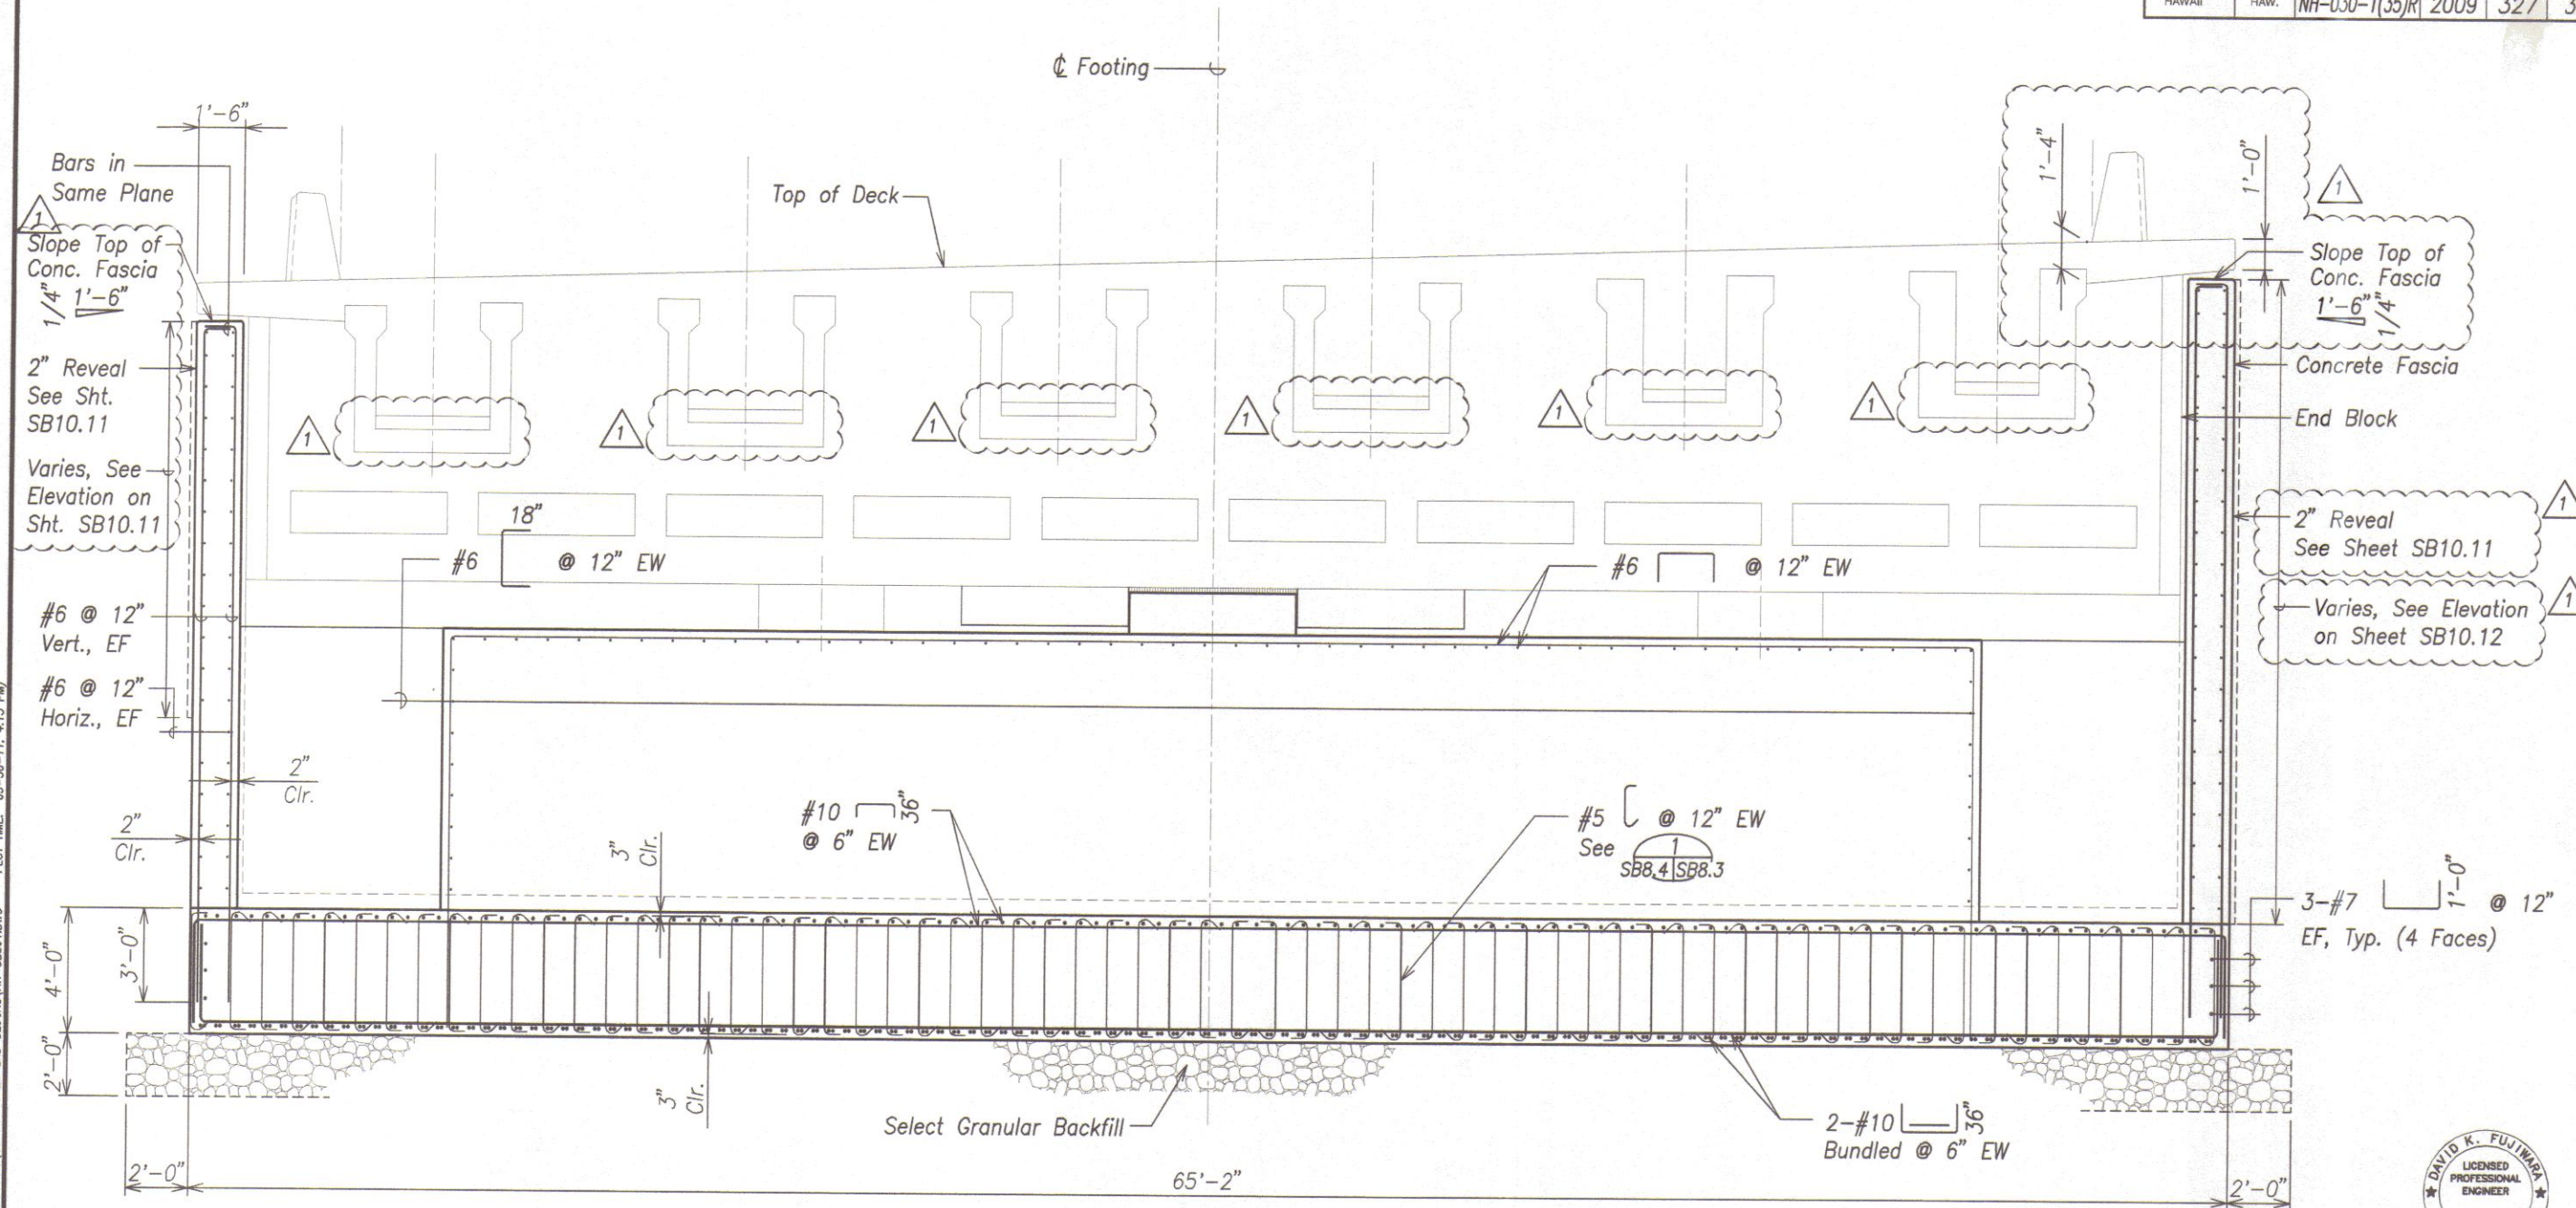

ELEVATION - ABUTMENT 1 A
Scale: 3/8" = 1'-0" SB8.3 SB8.4



THIS WORK WAS PREPARED BY ME
OR UNDER MY SUPERVISION.

KSF, INC. APRIL 30, 2012
LIC. EXP. DATE

STATE OF HAWAII DEPARTMENT OF TRANSPORTATION HIGHWAYS DIVISION	
ABUTMENT 1 ELEVATION	
HONOAPIILANI HIGHWAY REALIGNMENT, PHASE 1A Future Keawe St Extension to Lahainaluna Rd, Part B Fed. Aid Proj. No. NH-030-1(35)R	
Scale: As Noted	Date: June, 2010
SHEET No. SB8.4 OF 6 SHEETS	

2/01/11 1 Revisions


DATE REVISION

FINAL DESIGN 327

DESIGNED BY	DATE
CHECKED BY	
NOTED BY	
QUANTITIES BY	
CHECKED BY	

DRAWING NAME: Z:\00 ONGOING\001910-HONOAPIILANI LAHAINA BYPASS-KAHOMA WD\03-30-11 EW END BLOCKS\HH-SB801.DWG PLOT TIME: 03-30-11, 4:13 PM

FED. ROAD DIST. NO.	STATE	FED. AID PROJ. NO.	FISCAL YEAR	SHEET NO.	TOTAL SHEETS
HAWAII	HAW.	NH-030-1(35)R	2009	327	383

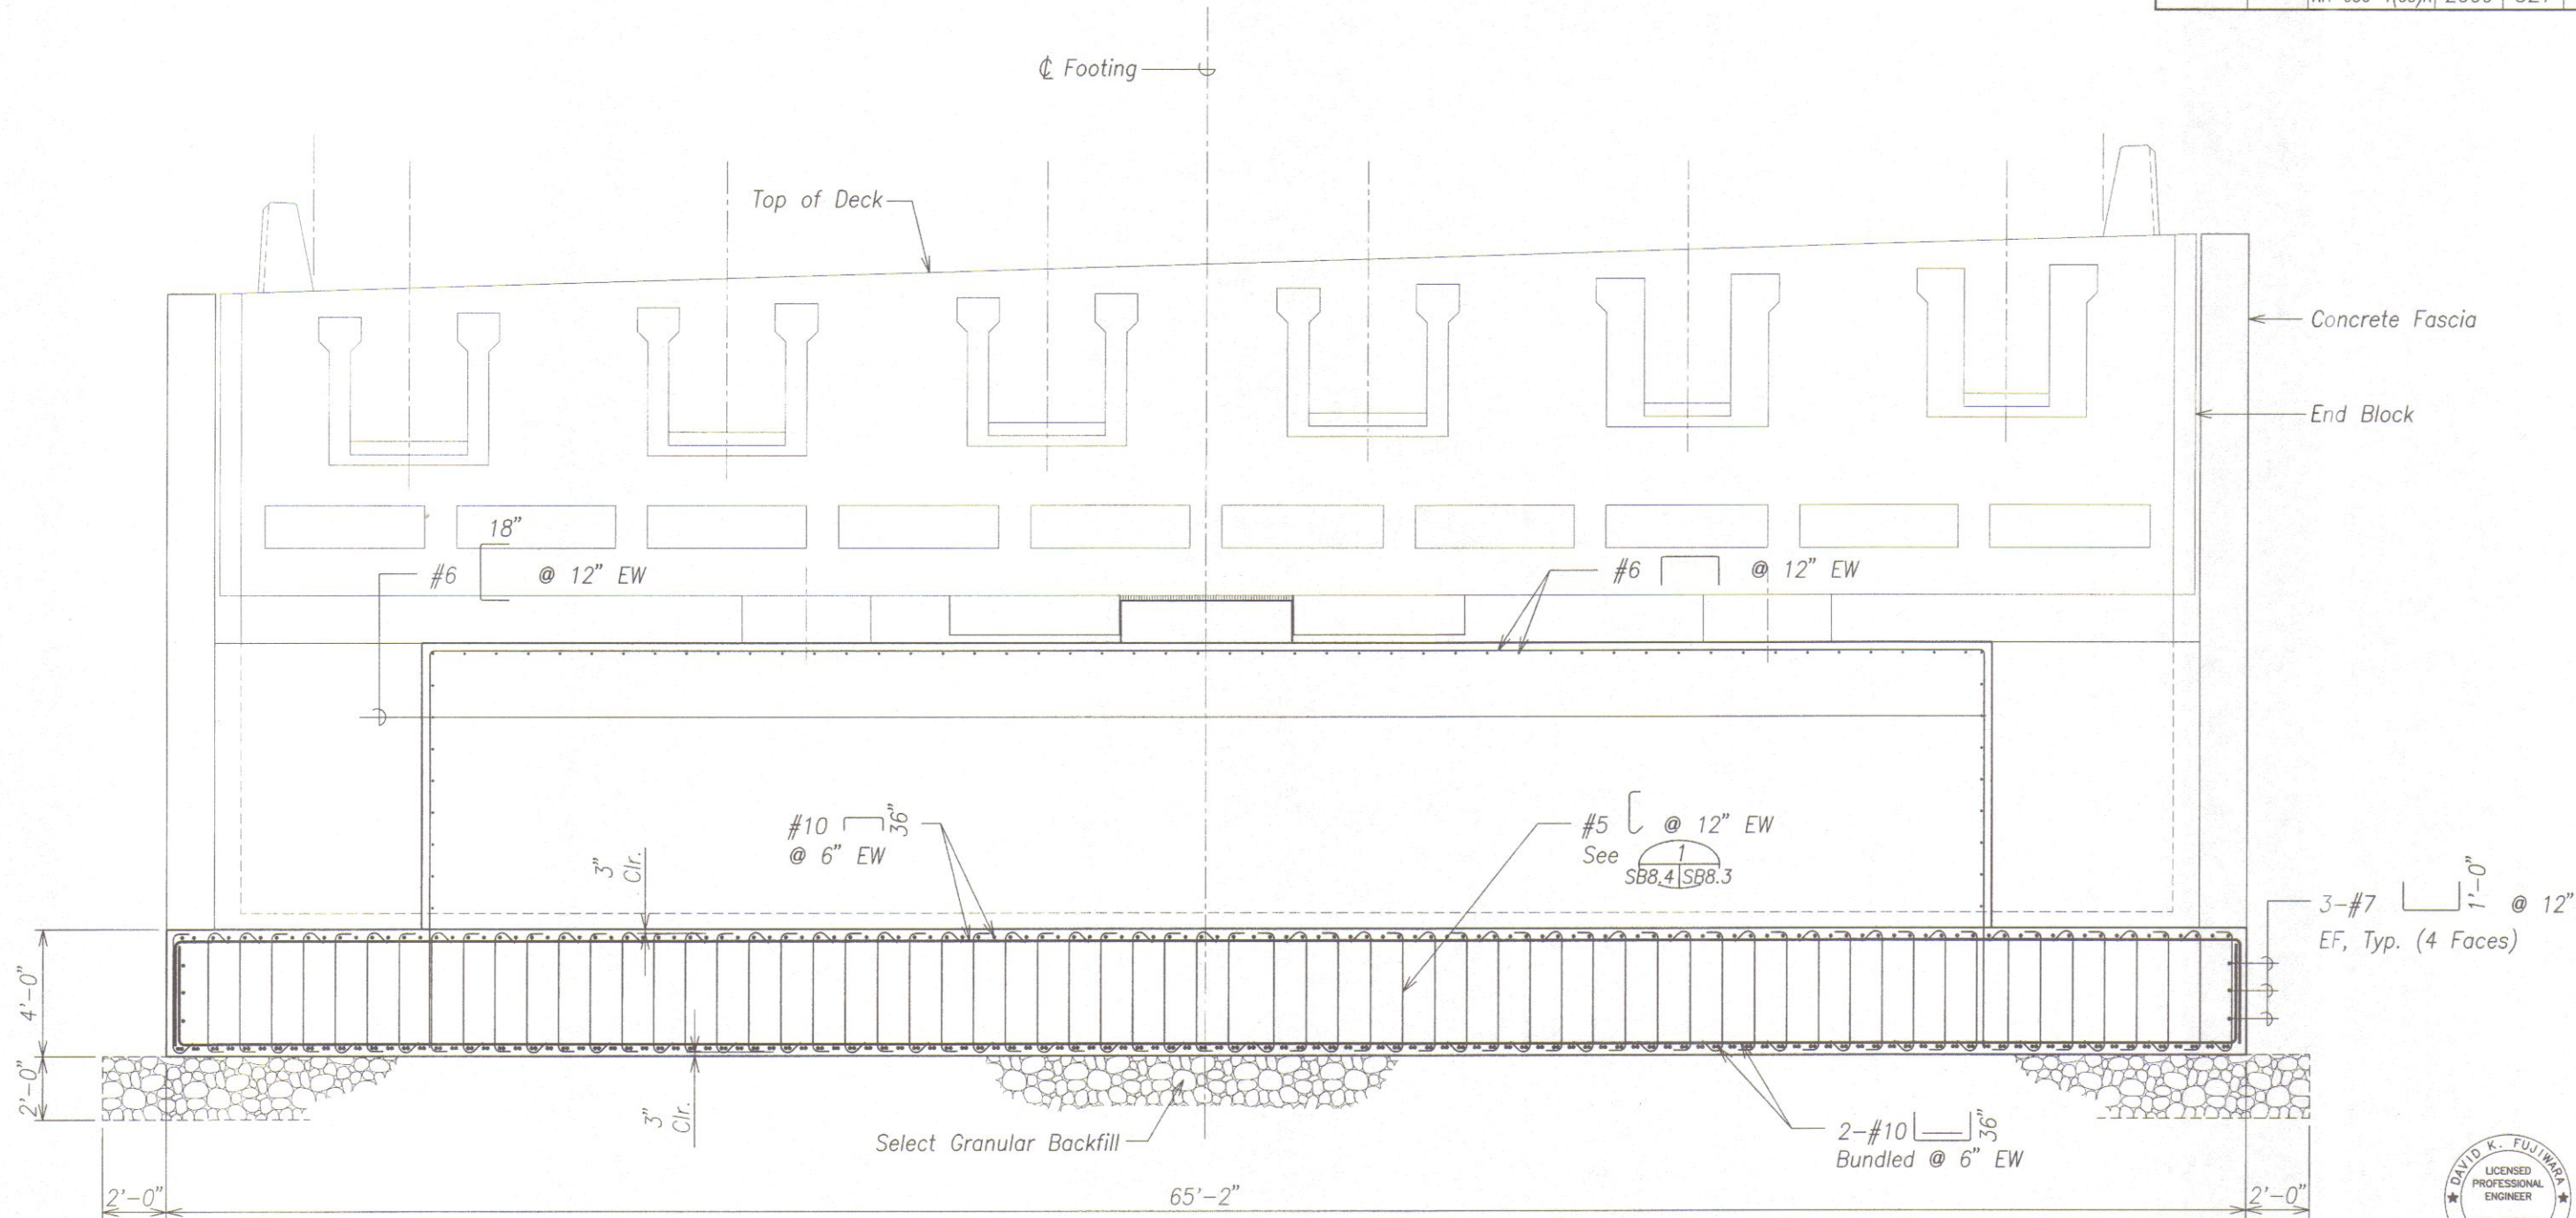

ELEVATION - ABUTMENT 1 A
Scale: 3/8" = 1'-0" SB8.3 SB8.4



THIS WORK WAS PREPARED BY ME
OR UNDER MY SUPERVISION.
David K. Fujiwara
KSF, INC. APRIL 30, 2012
LIC. EXP. DATE

SURVEY PLOTTED BY	DATE
DRAWN BY	
DESIGNED BY	
QUANTITIES BY	
CHECKED BY	
ORIGINAL PLAN	
NOTE BOOK	
No.	

DRAWING NAME: Z:\00 ONGOING\40019.0-HONOAPILANI LAHAINA BYPASS-KAHOMA WYO\06-15-10 COMBINE LAHAINA FINAL DESIGN\HH-SB801.DWG PLOT TIME: 06-14-10, 8:05 PM

STATE OF HAWAII
DEPARTMENT OF TRANSPORTATION
HIGHWAYS DIVISION

ABUTMENT 1 ELEVATION


HONOAPILANI HIGHWAY REALIGNMENT, PHASE 1A
Future Keawe St Extension to Lahainaluna Rd, Part B
Fed. Aid Proj. No. NH-030-1(35)R

Scale: As Noted Date: June, 2010

SHEET No. SB8.4 OF 6 SHEETS

FINAL DESIGN 327 Rev.

FED. ROAD DIST. NO.	STATE	FED. AID PROJ. NO.	FISCAL YEAR	SHEET NO.	TOTAL SHEETS
HAWAII	HAW.	NH-030-1(35)R	2009	328	383

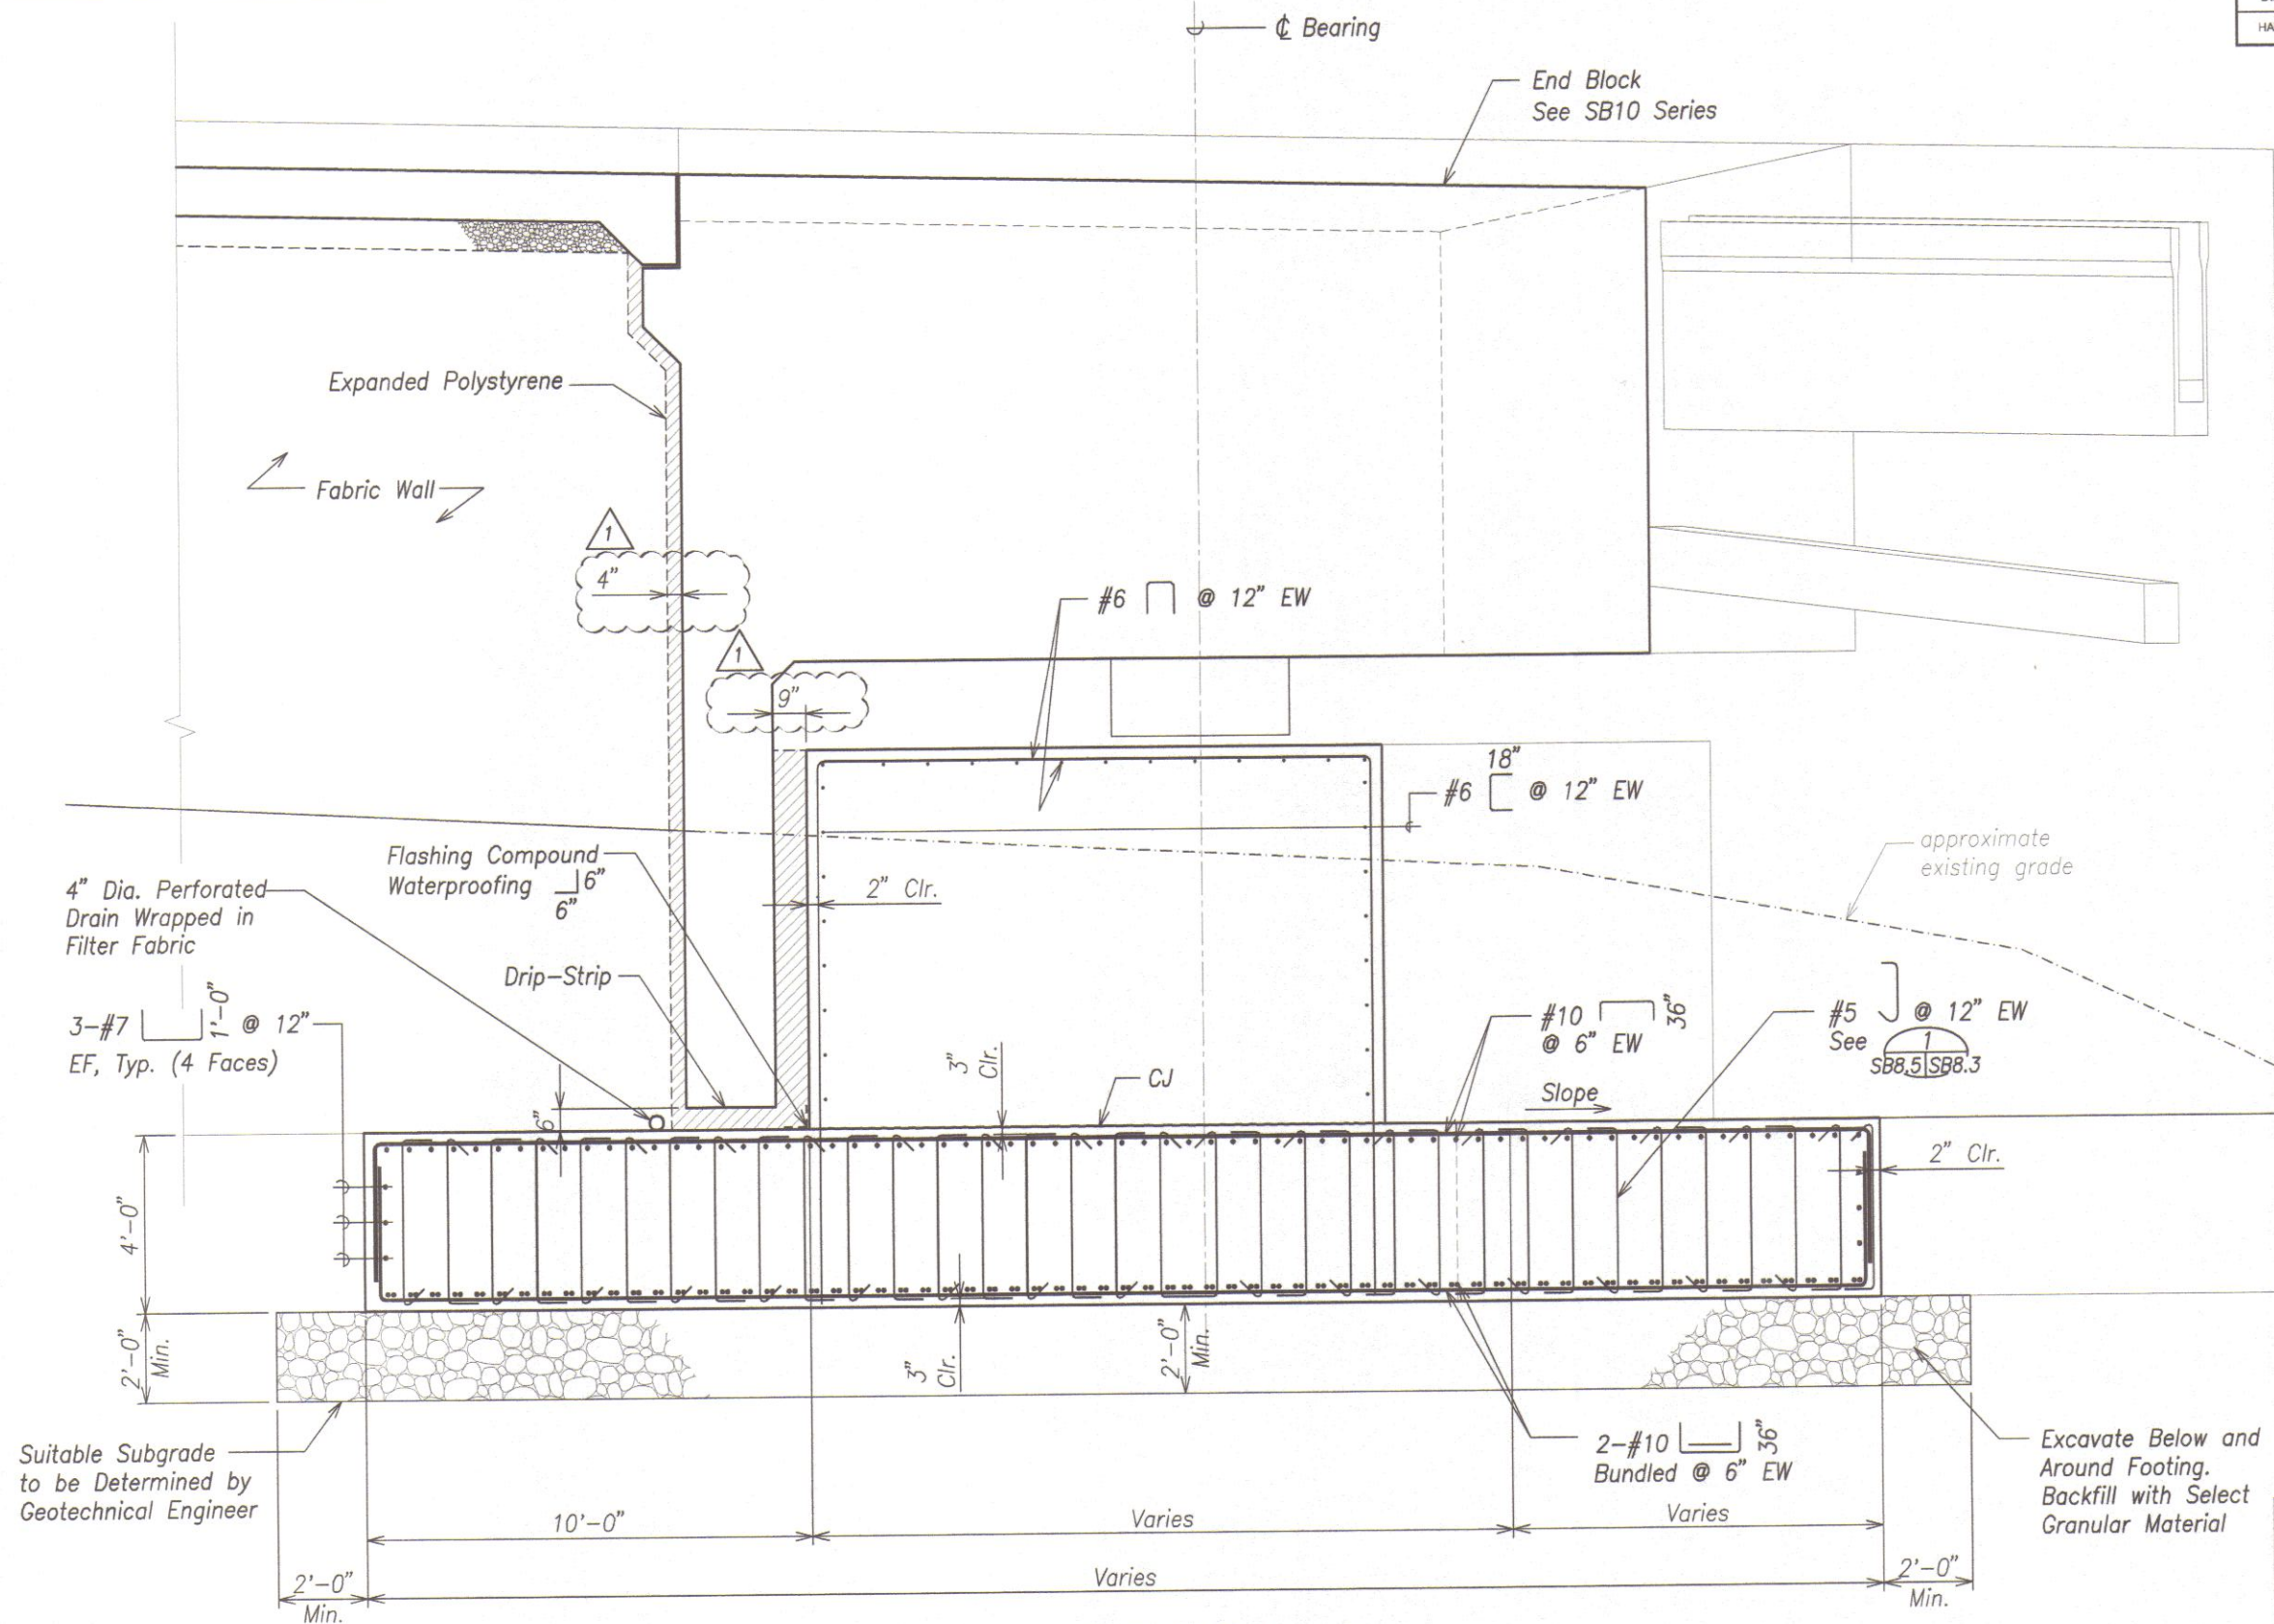

SECTION - ABUTMENT 1
Scale: 1/2" = 1'-0"
A
SB8.3 SB8.5

2/01/11 1 Revisions

DATE REVISION




THIS WORK WAS PREPARED BY ME OR UNDER MY SUPERVISION.

KSF, INC. APRIL 30, 2012 LIC. EXP. DATE

STATE OF HAWAII DEPARTMENT OF TRANSPORTATION HIGHWAYS DIVISION	
ABUTMENT 1	
SECTION	
HONOAPIILANI HIGHWAY REALIGNMENT, PHASE 1A	
Future Keawe St Extension to Lahainaluna Rd, Part B	
Fed. Aid Proj. No. NH-030-1(35)R	
Scale: As Noted	Date: June, 2010
SHEET No. SB8.5 OF 6	SHEETS

FED. ROAD DIST. NO.	STATE	FED. AID PROJ. NO.	FISCAL YEAR	SHEET NO.	TOTAL SHEETS
HAWAII	HAW.	NH-030-1(35)R	2009	328	383

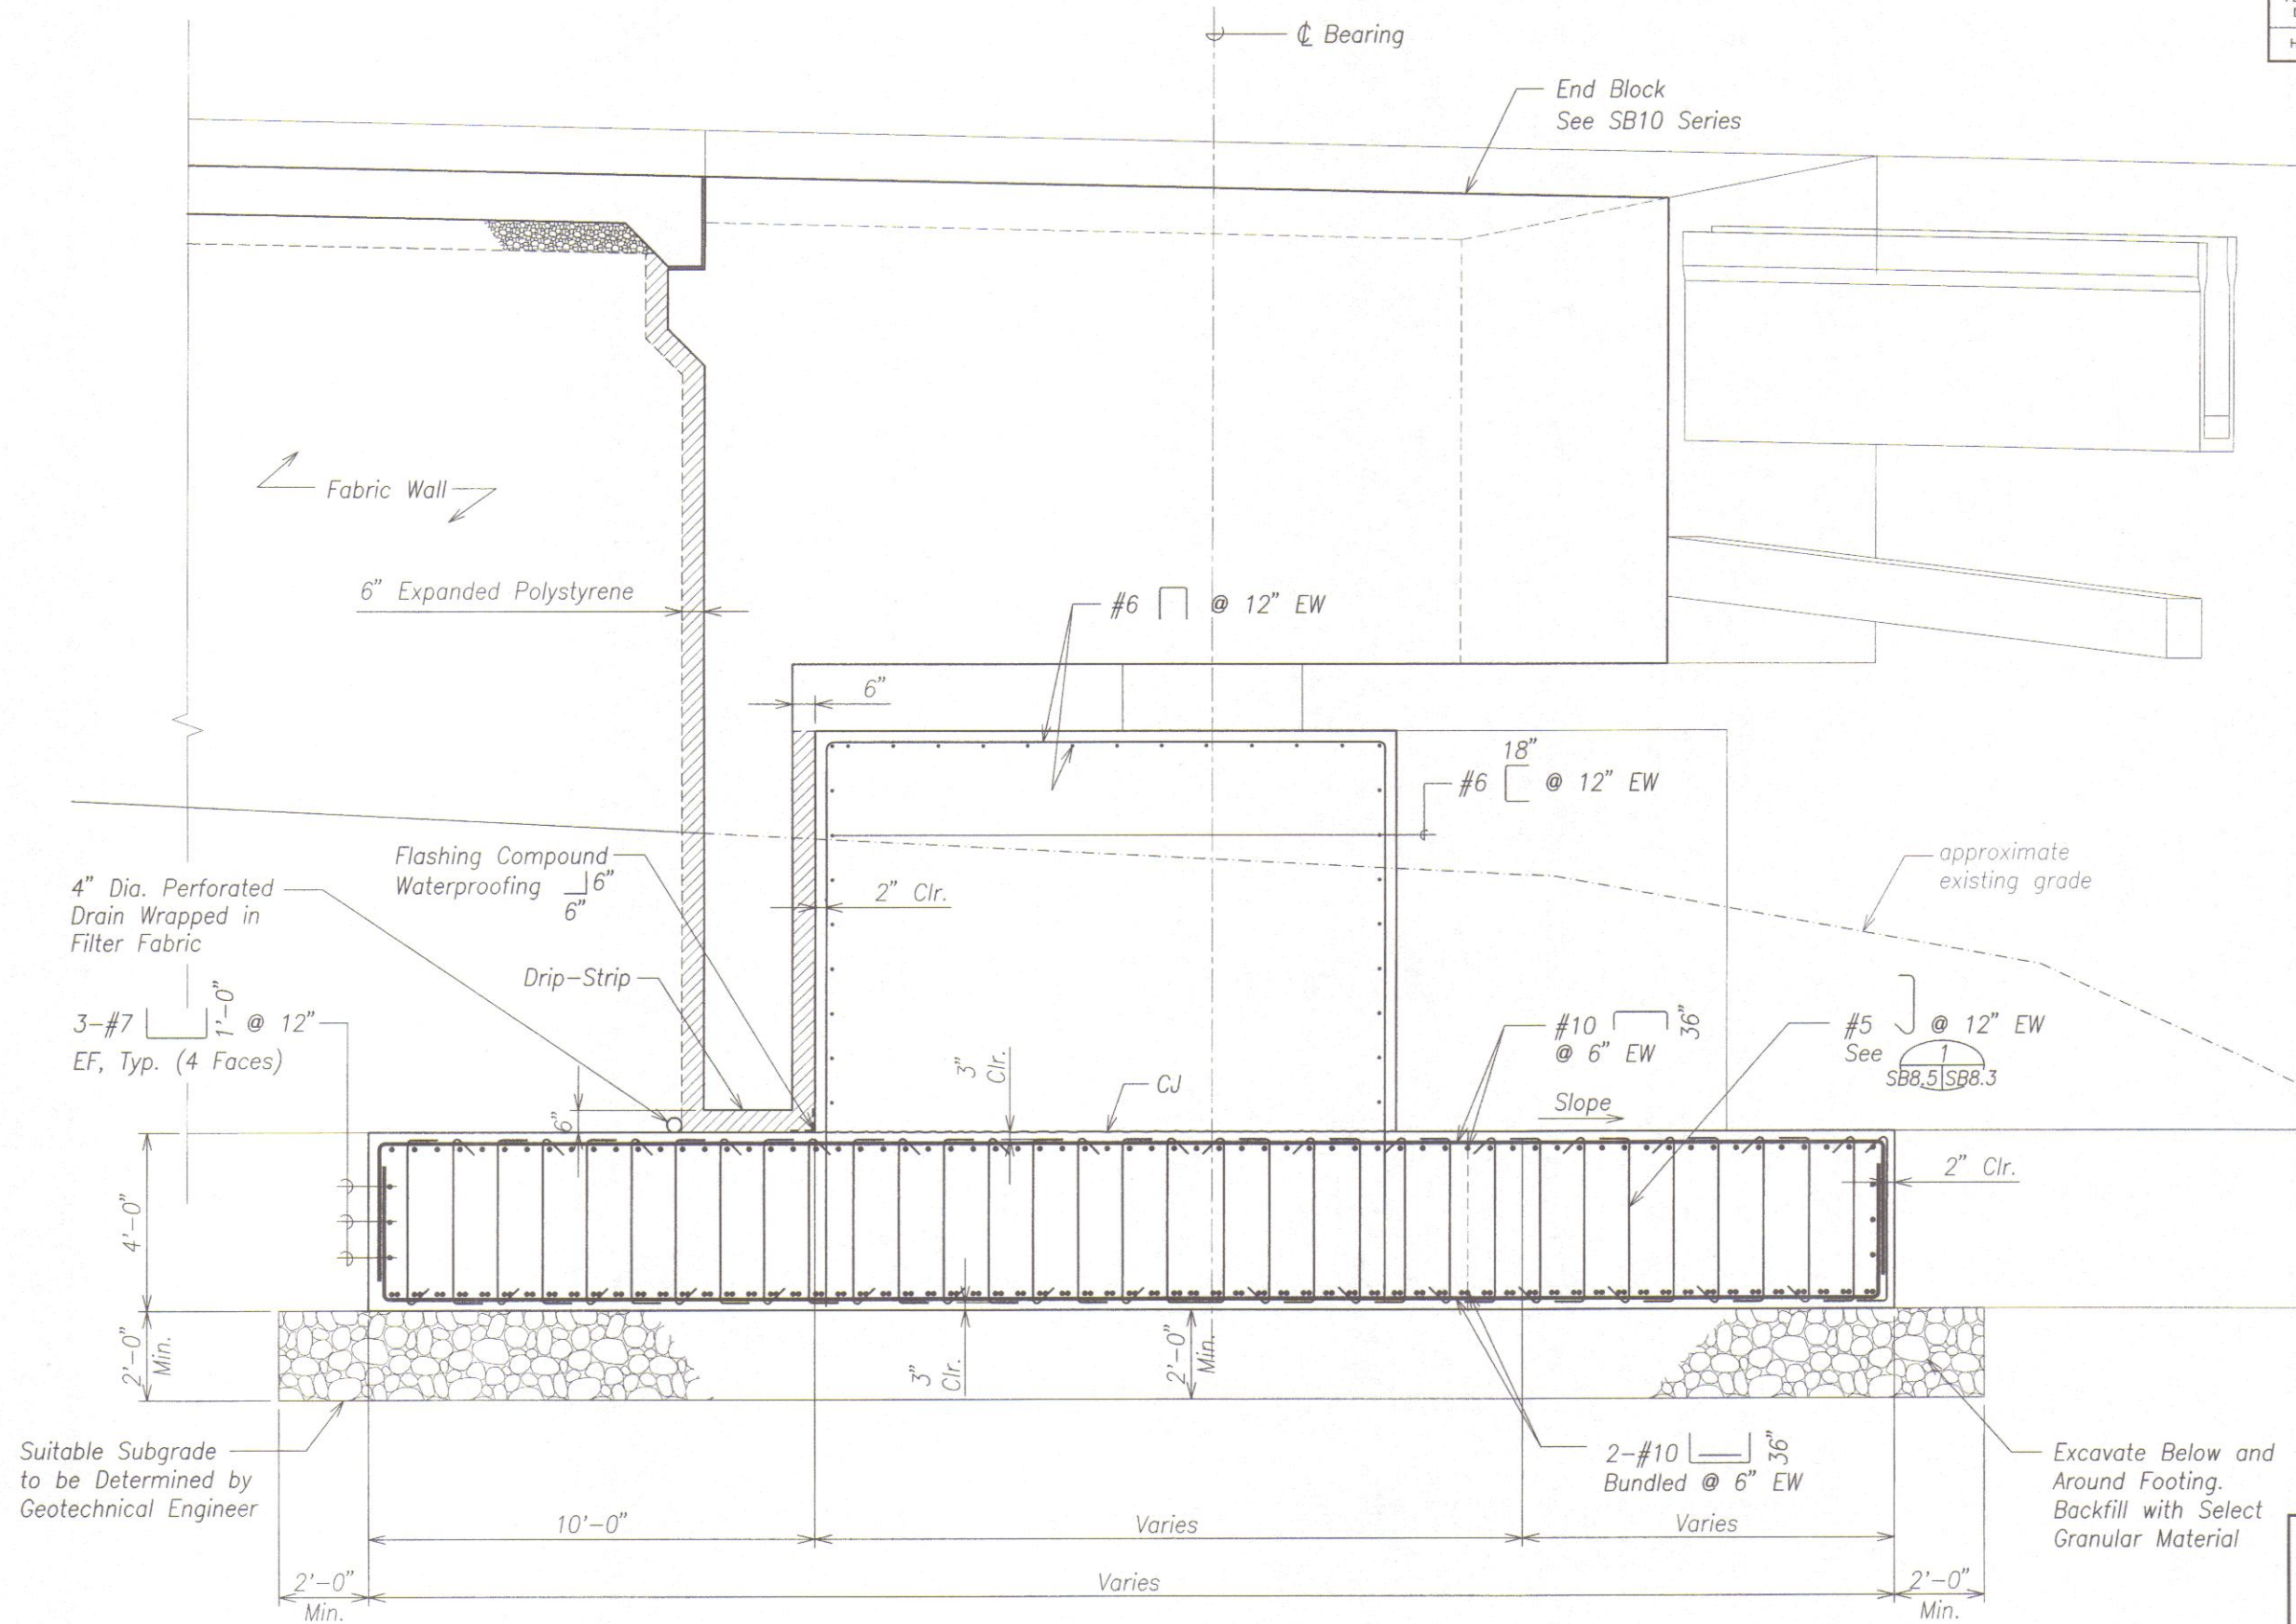

SECTION - ABUTMENT 1
 Scale: 1/2" = 1'-0"
 SB8.3 | SB8.5






THIS WORK WAS PREPARED BY ME OR UNDER MY SUPERVISION.
 David K. Fujiwara
 KSF, INC. APRIL 30, 2012
 L.C. EXP. DATE

STATE OF HAWAII
 DEPARTMENT OF TRANSPORTATION
 HIGHWAYS DIVISION
ABUTMENT 1
SECTION
 HONOAPIILANI HIGHWAY REALIGNMENT, PHASE 1A
 Future Keawe St Extension to Lahainaluna Rd, Part B
 Fed. Aid Proj. No. NH-030-1(35)R
 Scale: As Noted Date: June, 2010
 SHEET No. SB8.5 OF 6 SHEETS

ORIGINAL PLAN	DATE
NOTE BOOK	
QUANTITIES BY	
CHECKED BY	

DRAWING NAME: Z:\00 ONGOING\40019.0-HONOAPIILANI LAHAINA BYPASS-KAHOMA\06-15-10 COMBINE LAHAINA FINAL DESIGN\HH-SB801.DWG PLOT TIME: 06-14-10, 8:07 PM

FED. ROAD DIST. NO.	STATE	FED. AID PROJ. NO.	FISCAL YEAR	SHEET NO.	TOTAL SHEETS
HAWAII	HAW.	NH-030-1(35)R	2009	329	383

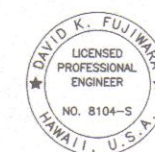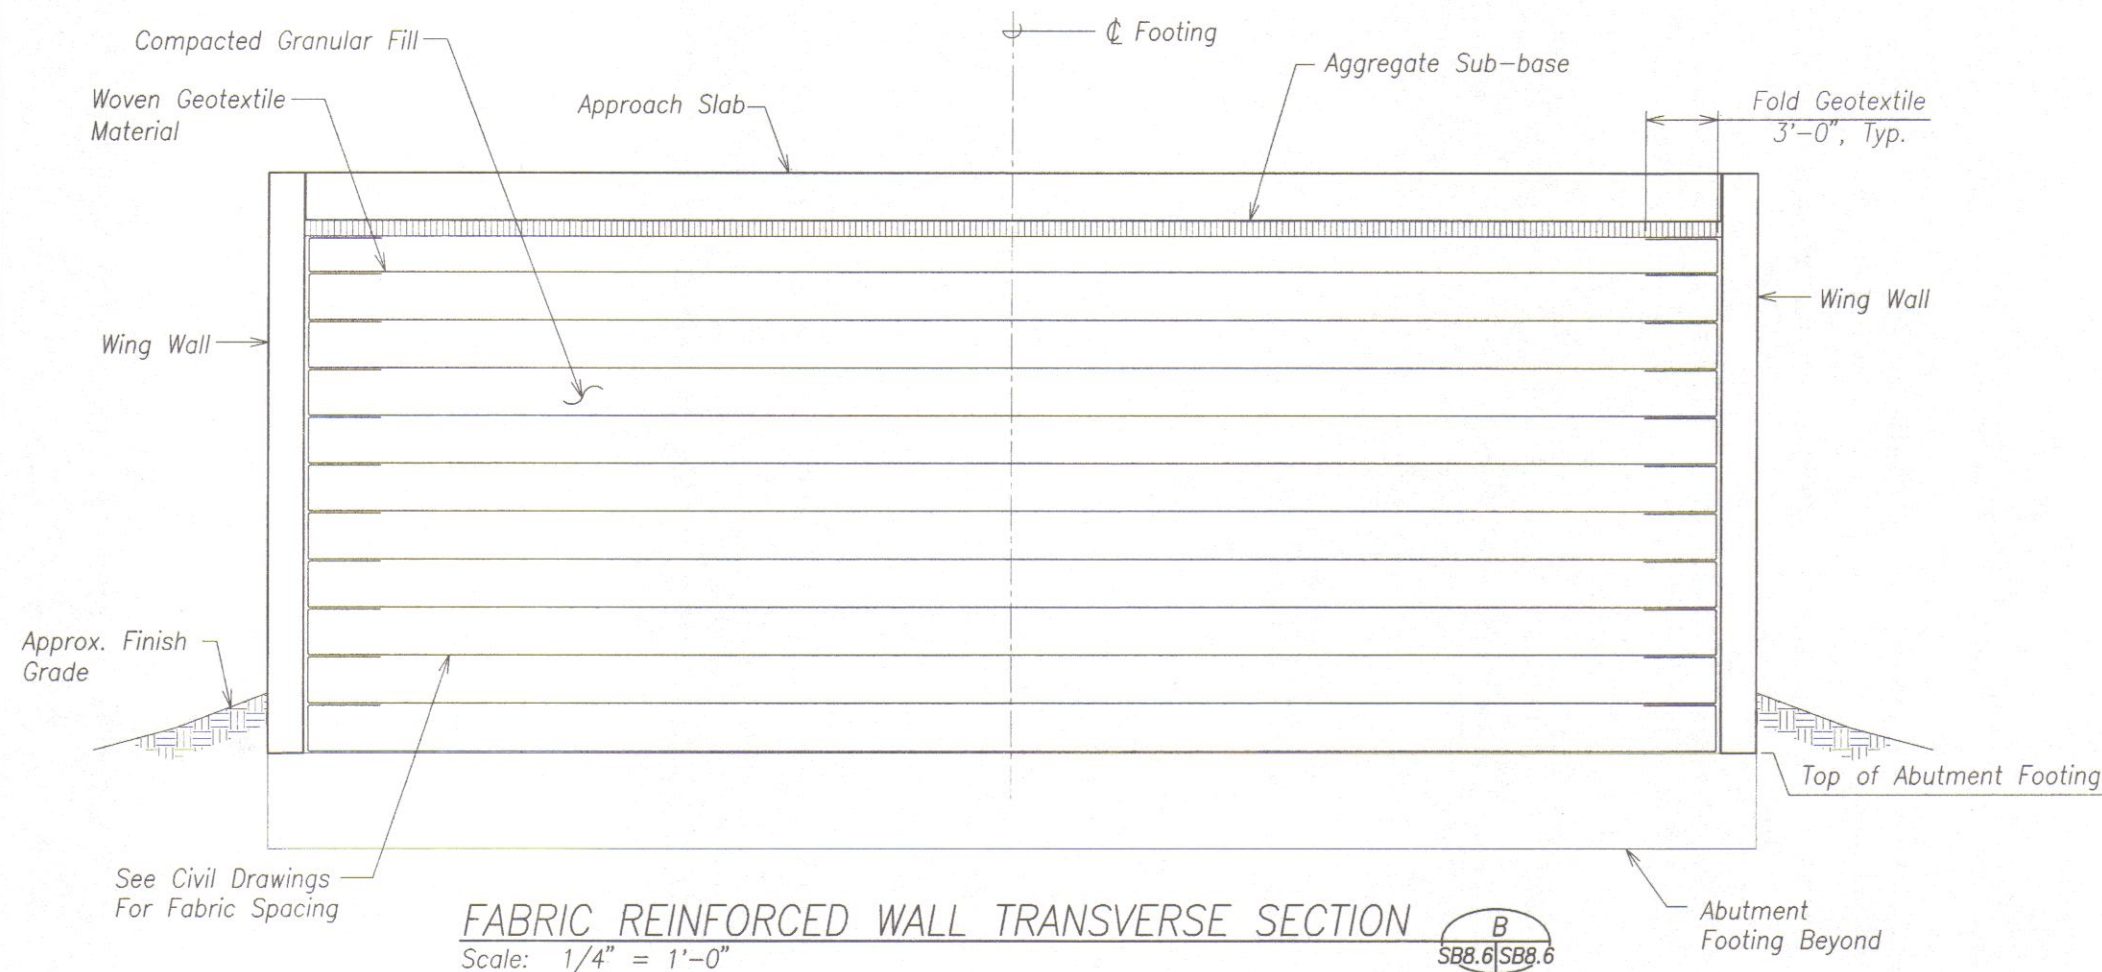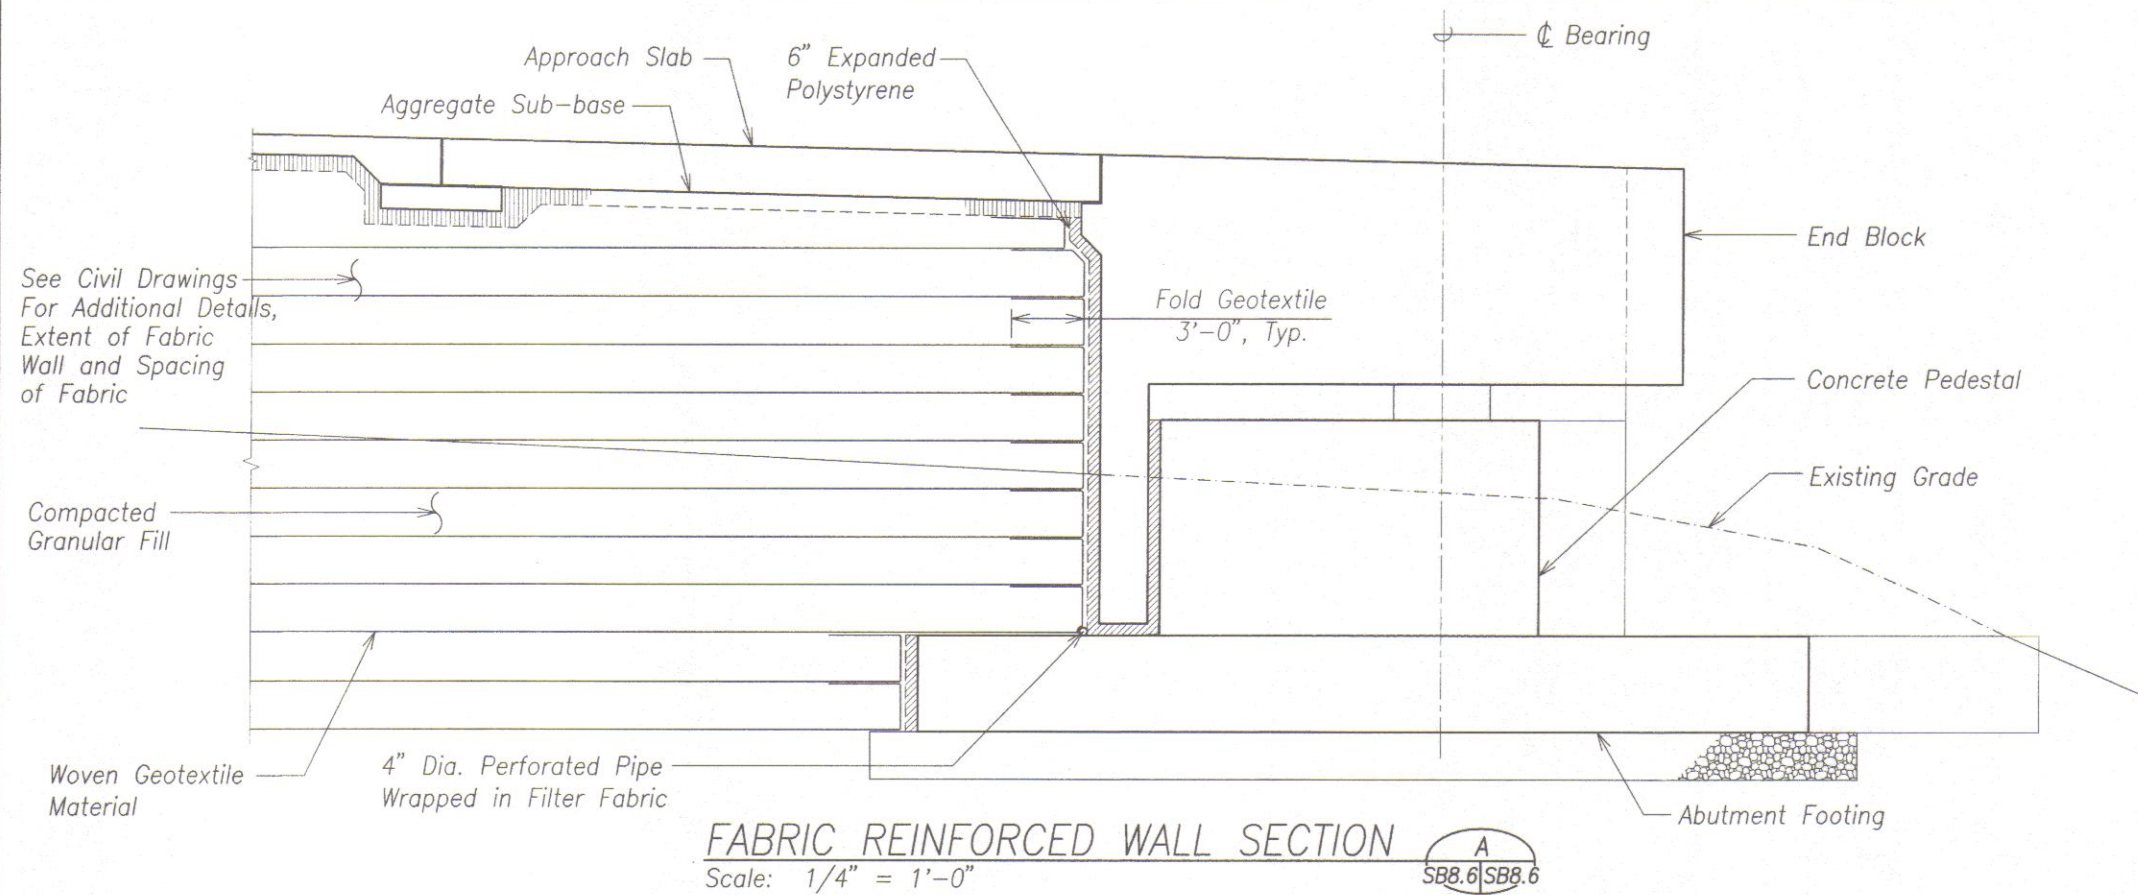

THIS WORK WAS PREPARED BY ME
OR UNDER MY SUPERVISION.
David K. Fujiwara
KSF, INC. APRIL 30, 2012
LIC. EXP. DATE

STATE OF HAWAII
DEPARTMENT OF TRANSPORTATION
HIGHWAYS DIVISION
**TYPICAL FABRIC REINFORCED
RETAINING WALL SECTIONS**
HONOAPIILANI HIGHWAY REALIGNMENT, PHASE 1A
Future Keawe St Extension to Lahainaluna Rd, Part B
Fed. Aid Proj. No. NH-030-1(35)R
Scale: As Noted Date: June, 2010
SHEET No. SB8.6 OF 6 SHEETS

FINAL DESIGN 329


DRAWING NAME: 21.00 ONGOING 40019.0-HONOAPIILANI LAHAINA BYPASS-KAHOMA WO 06-15-10 COMBINE LAHAINA FINAL DESIGN\H-SB8.6.DWG PLOT TIME: 06-14-10, 8:08 PM

ORIGINAL PLAN	DATE
SURVEY PLOTTED BY	
DRAWN BY	
TRACED BY	
DESIGNED BY	
QUANTITIES BY	
CHECKED BY	
No.	

FED. ROAD DIST. NO.	STATE	FED. AID PROJ. NO.	FISCAL YEAR	SHEET NO.	TOTAL SHEETS
HAWAII	HAW.	NH-030-1(35)R	2009	330	383

NOTE:

○ Probe Hole location, see Sht. SB9.3 for spacing.
See Special Provision Section 660.

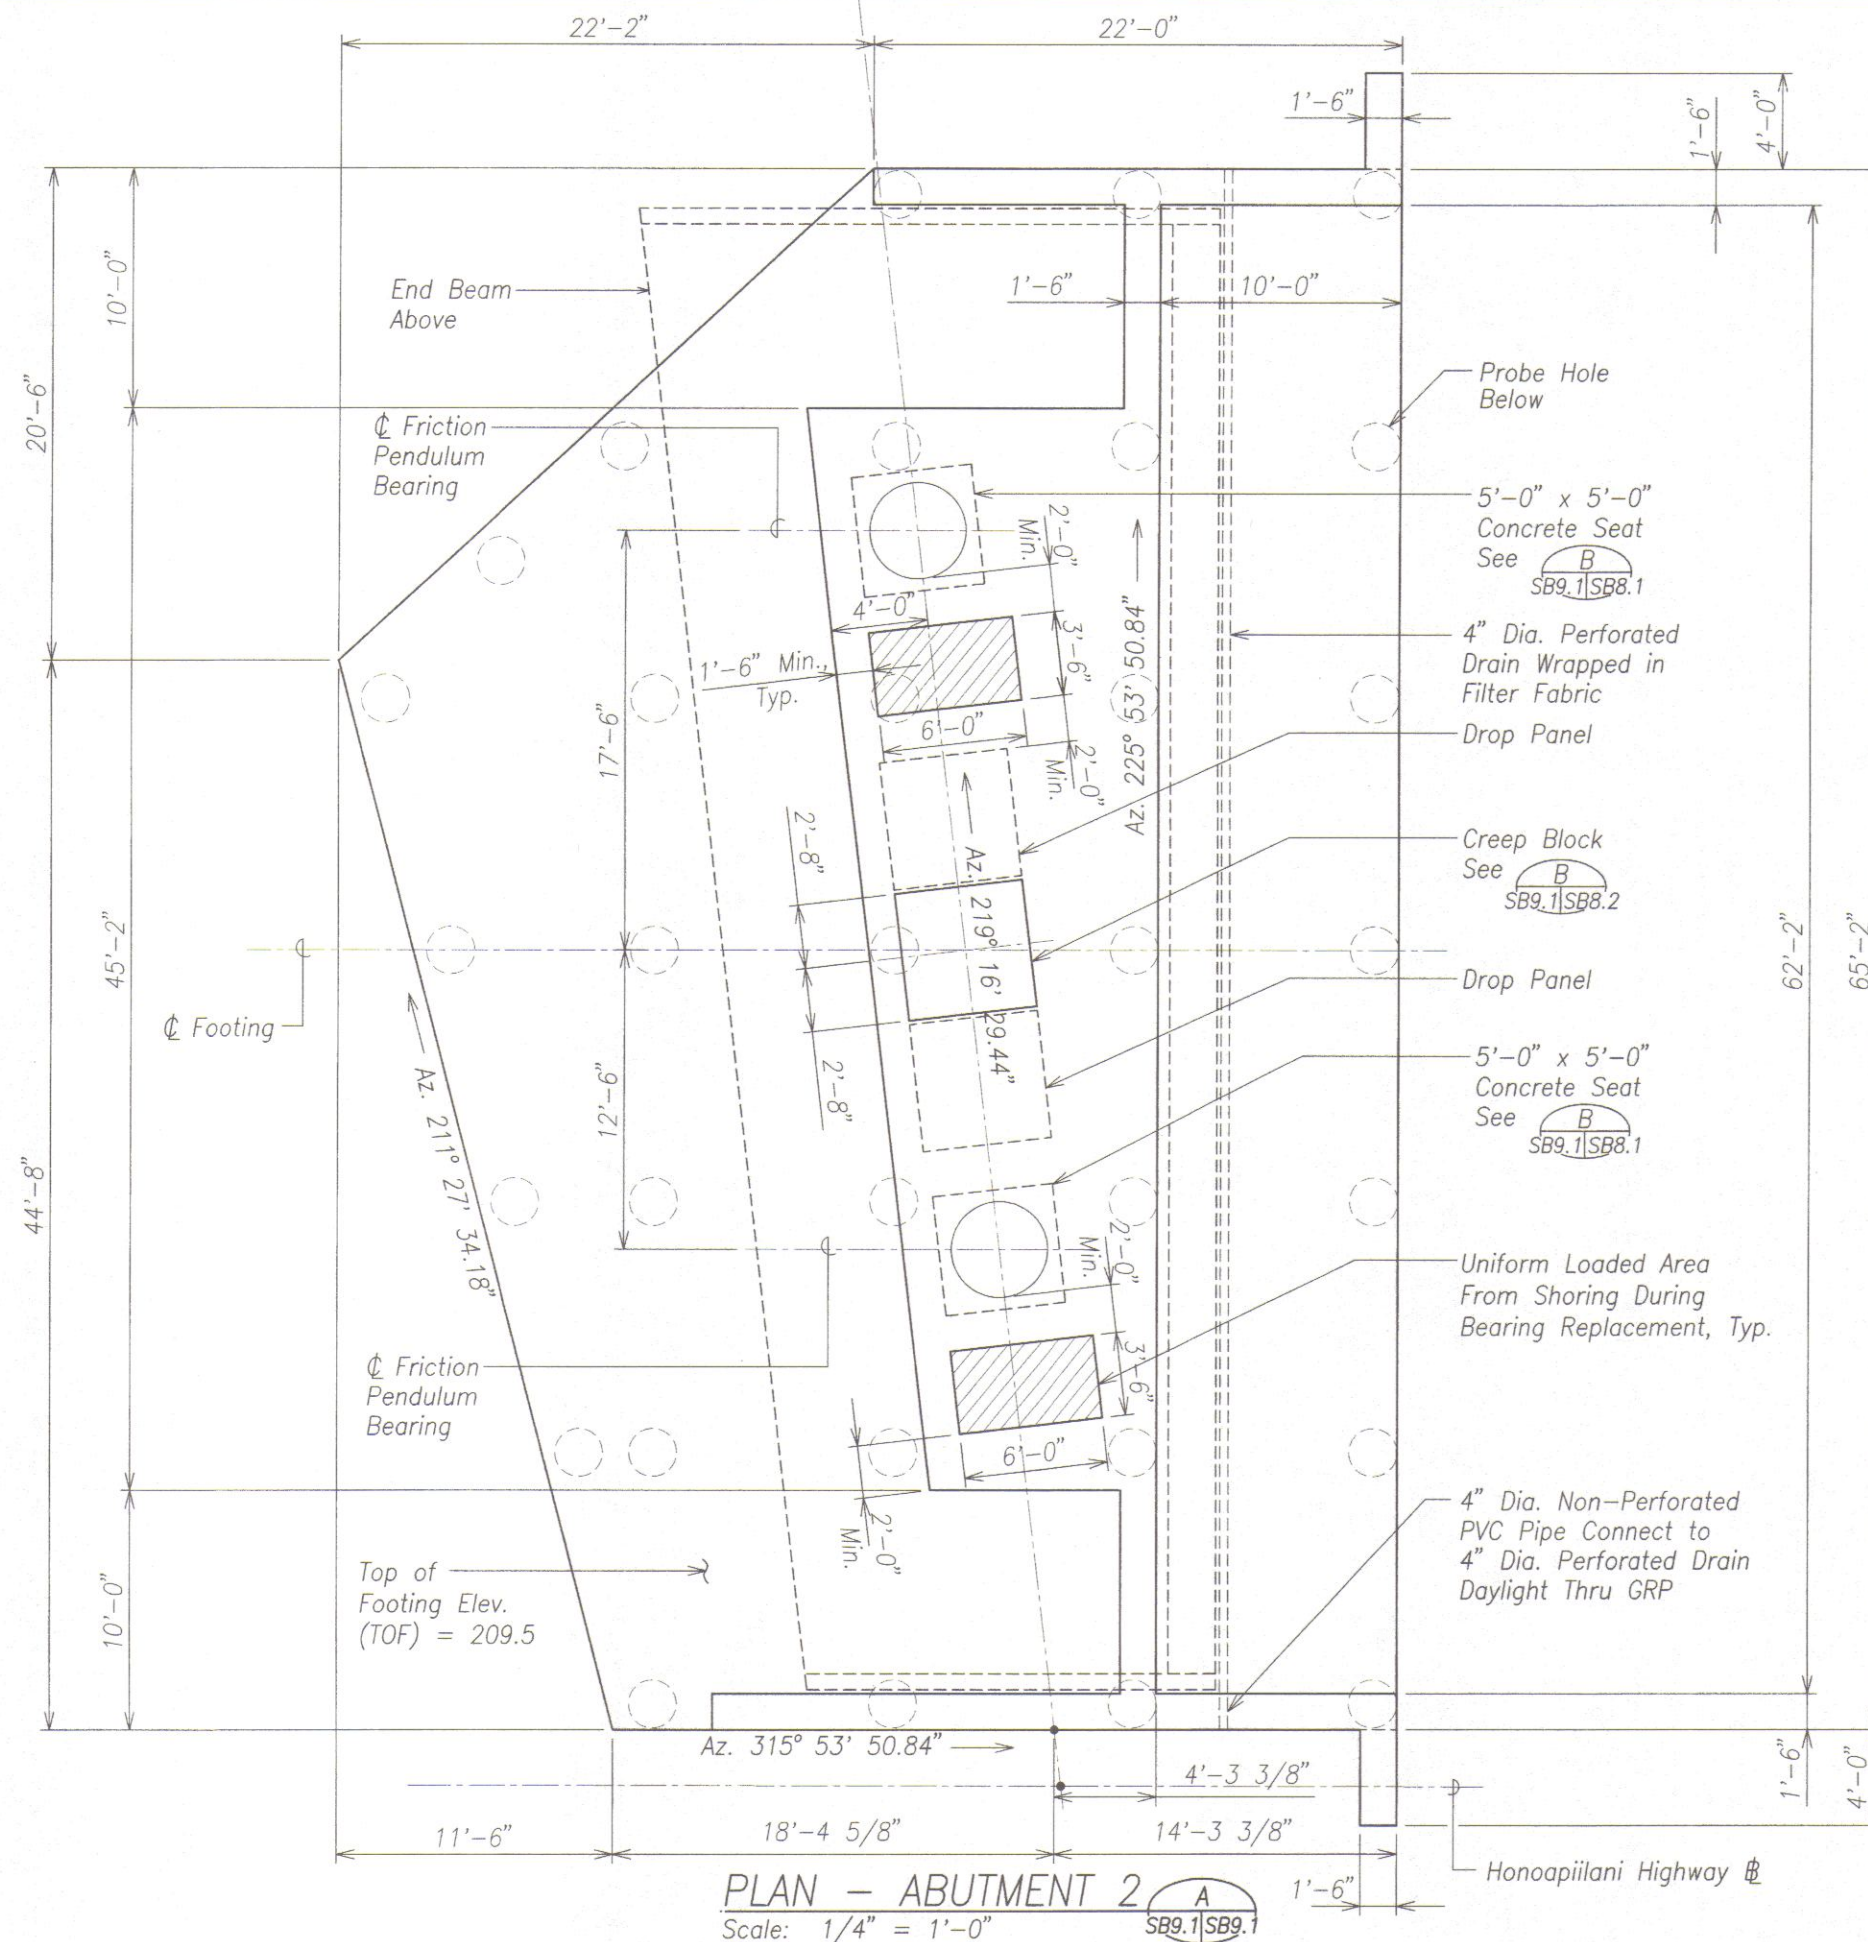

4" Dia. Non-Perforated
PVC Pipe Connect to
4" Dia. Perforated Drain
Daylight Thru GRP

— Honoapiilani Highway \$



THIS WORK WAS PREPARED BY ME
OR UNDER MY SUPERVISION.

David K. Fymora APRIL 30, 2012
KSF, INC. LIC. EXP. DATE

STATE OF HAWAII
DEPARTMENT OF TRANSPORTATION
HIGHWAYS DIVISION

ABUTMENT 2 PLAN

HONOAPIILANI HIGHWAY REALIGNMENT, PHASE 1A

Future Keawe St Extension to Lahainaluna Rd, Part B

Fed. Aid Proj. No. NH-030-1(35)R

Scale: As Noted

Date: June, 2010


SHEET No. *SB9.1* OF 5 SHEETS

FINAL DESIGN 330

ORIGINAL PLAN	SURVEY PLOTTED BY _____ DATE _____
NOTE BOOK	DRAWN BY _____
	TRACED BY _____
	DESIGNED BY _____
	QUANTITIES BY _____
No. _____	CHECKED BY _____

DRAWING NAME: Z:\00 ONGOING\40019.0--HONOA PILANI LAHAINA BYPASS--KAHOMA WO\06-15-10 COMBINE LAHAINA FINAL DESIGN\HH-SB901.DWG PLOT TIME: 06-14-10, 8:10 PM)

FED. ROAD DIST. NO.	STATE	FED. AID PROJ. NO.	FISCAL YEAR	SHEET NO.	TOTAL SHEETS
HAWAII	HAW.	NH-030-1(35)R	2009	331	383

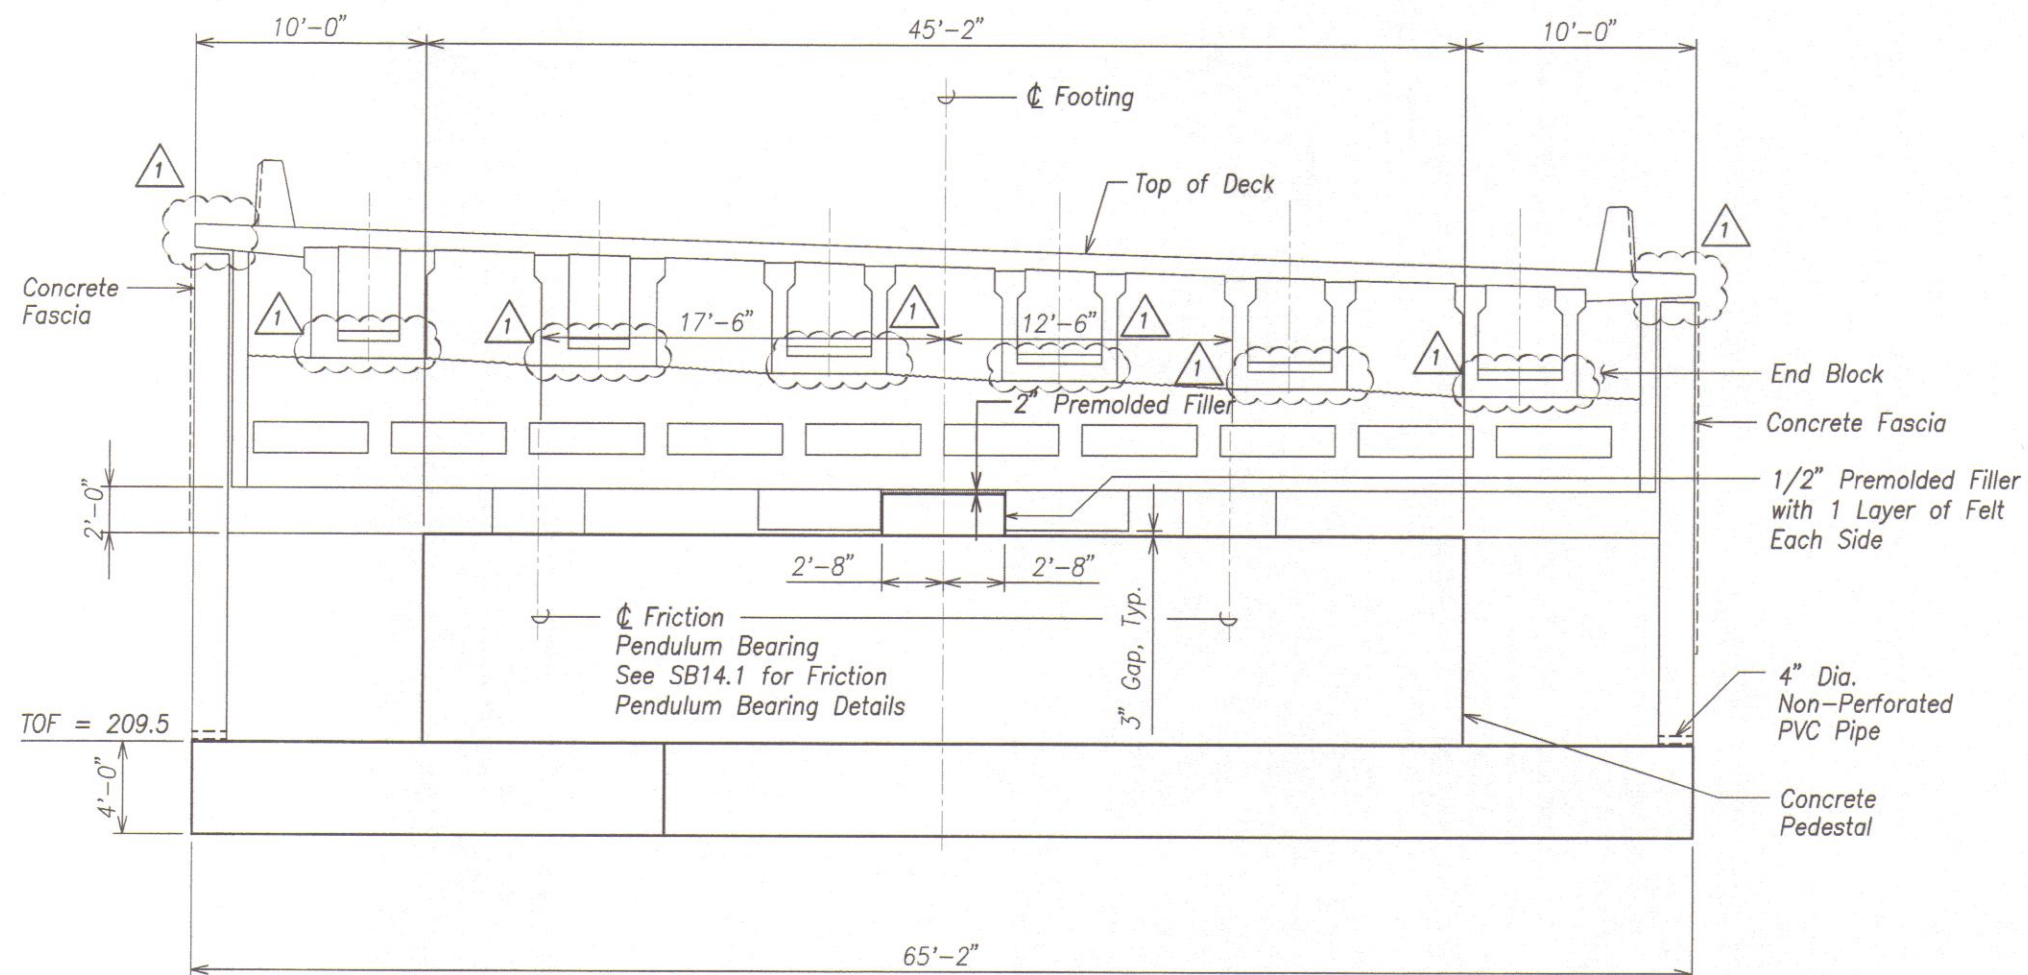

ELEVATION - ABUTMENT 2 A
 Scale: 1/4" = 1'-0" SB9.2 | SB9.2



THIS WORK WAS PREPARED BY ME
OR UNDER MY SUPERVISION.

KSF, INC. APRIL 30, 2012
L.C. EXP. DATE

STATE OF HAWAII
DEPARTMENT OF TRANSPORTATION
HIGHWAYS DIVISION

ABUTMENT 2 ELEVATION

HONOAPIILANI HIGHWAY REALIGNMENT, PHASE 1A
Future Keawe St Extension to Lahainaluna Rd, Part B
Fed. Aid Proj. No. NH-030-1(35)R


Scale: As Noted Date: June, 2010

SHEET No. SB9.2 OF 5 SHEETS

2/01/11 1 Revisions

DATE REVISION

FED. ROAD DIST. NO.	STATE	FED. AID PROJ. NO.	FISCAL YEAR	SHEET NO.	TOTAL SHEETS
HAWAII	HAW.	NH-030-1(35)R	2009	331	383

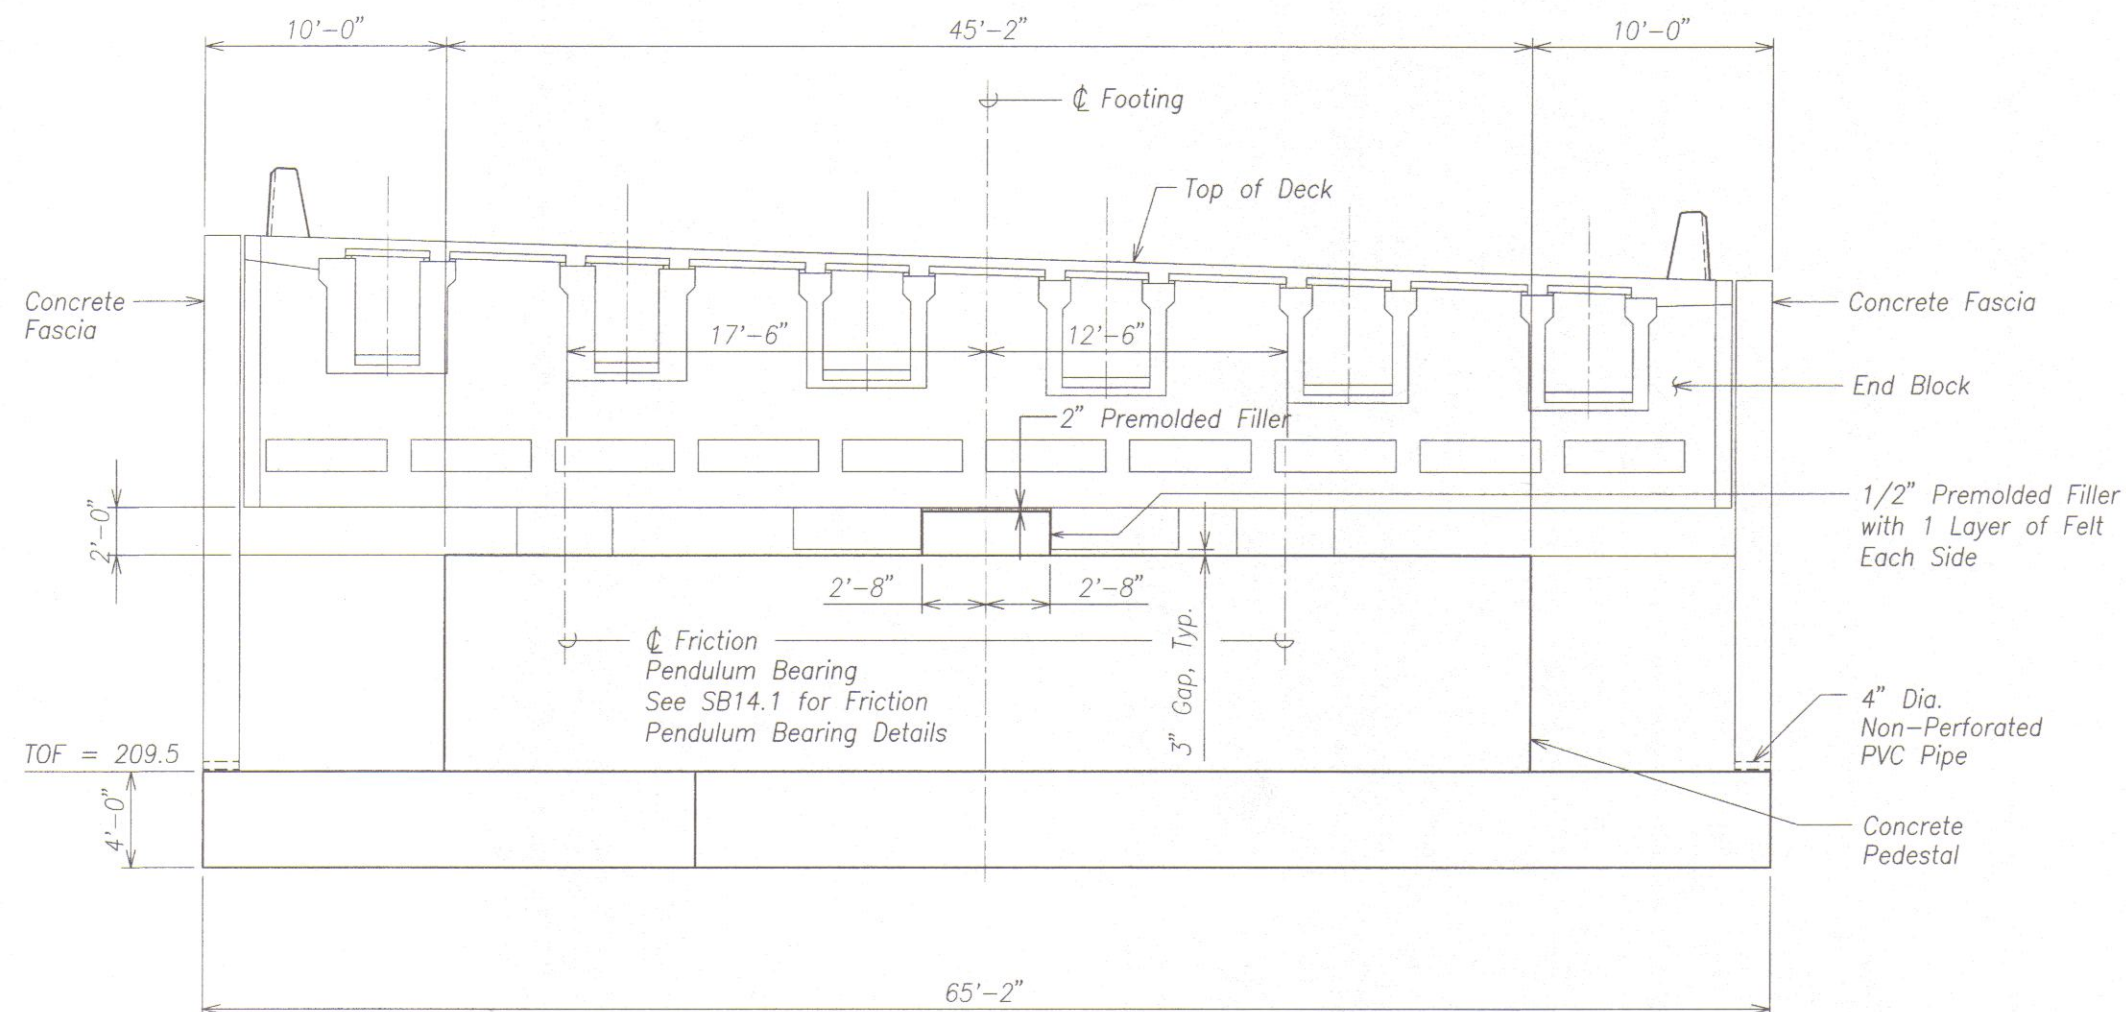

ELEVATION - ABUTMENT 2
 Scale: 1/4" = 1'-0"
 SB9.2 | SB9.2



THIS WORK WAS PREPARED BY ME
 OR UNDER MY SUPERVISION.
David K. Fujimura
 KSF, INC. APRIL 30, 2013
 LIC. EXP. DATE

STATE OF HAWAII
 DEPARTMENT OF TRANSPORTATION
 HIGHWAYS DIVISION

ABUTMENT 2 ELEVATION

HONOAPIILANI HIGHWAY REALIGNMENT, PHASE 1A
 Future Keawe St Extension to Lahainaluna Rd, Part B
 Fed. Aid Proj. No. NH-030-1(35)R

Scale: As Noted Date: June, 2010


SHEET No. SB9.2 OF 5 SHEETS

FINAL DESIGN 331 REV 4

ORIGINAL PLAN	DATE
SURVEY PLOTTED BY	
DRAWN BY	
DESIGNED BY	
QUANTITIES BY	
CHECKED BY	
NOTE BOOK	
No.	

DRAWING NAME: Z:\00 ONGOING\40019.0-HONOAPIILANI LAHAINA BYPASS-KAHOMA WD\06-15-10 COMBINE LAHAINA FINAL DESIGN\HH-SB901.DWG PLOT TIME: 06-14-10, 8:10 PM


FED. ROAD DIST. NO.	STATE	FED. AID PROJ. NO.	FISCAL YEAR	SHEET NO.	TOTAL SHEETS
HAWAII	HAW.	NH-030-1(35)R	2009	332	383

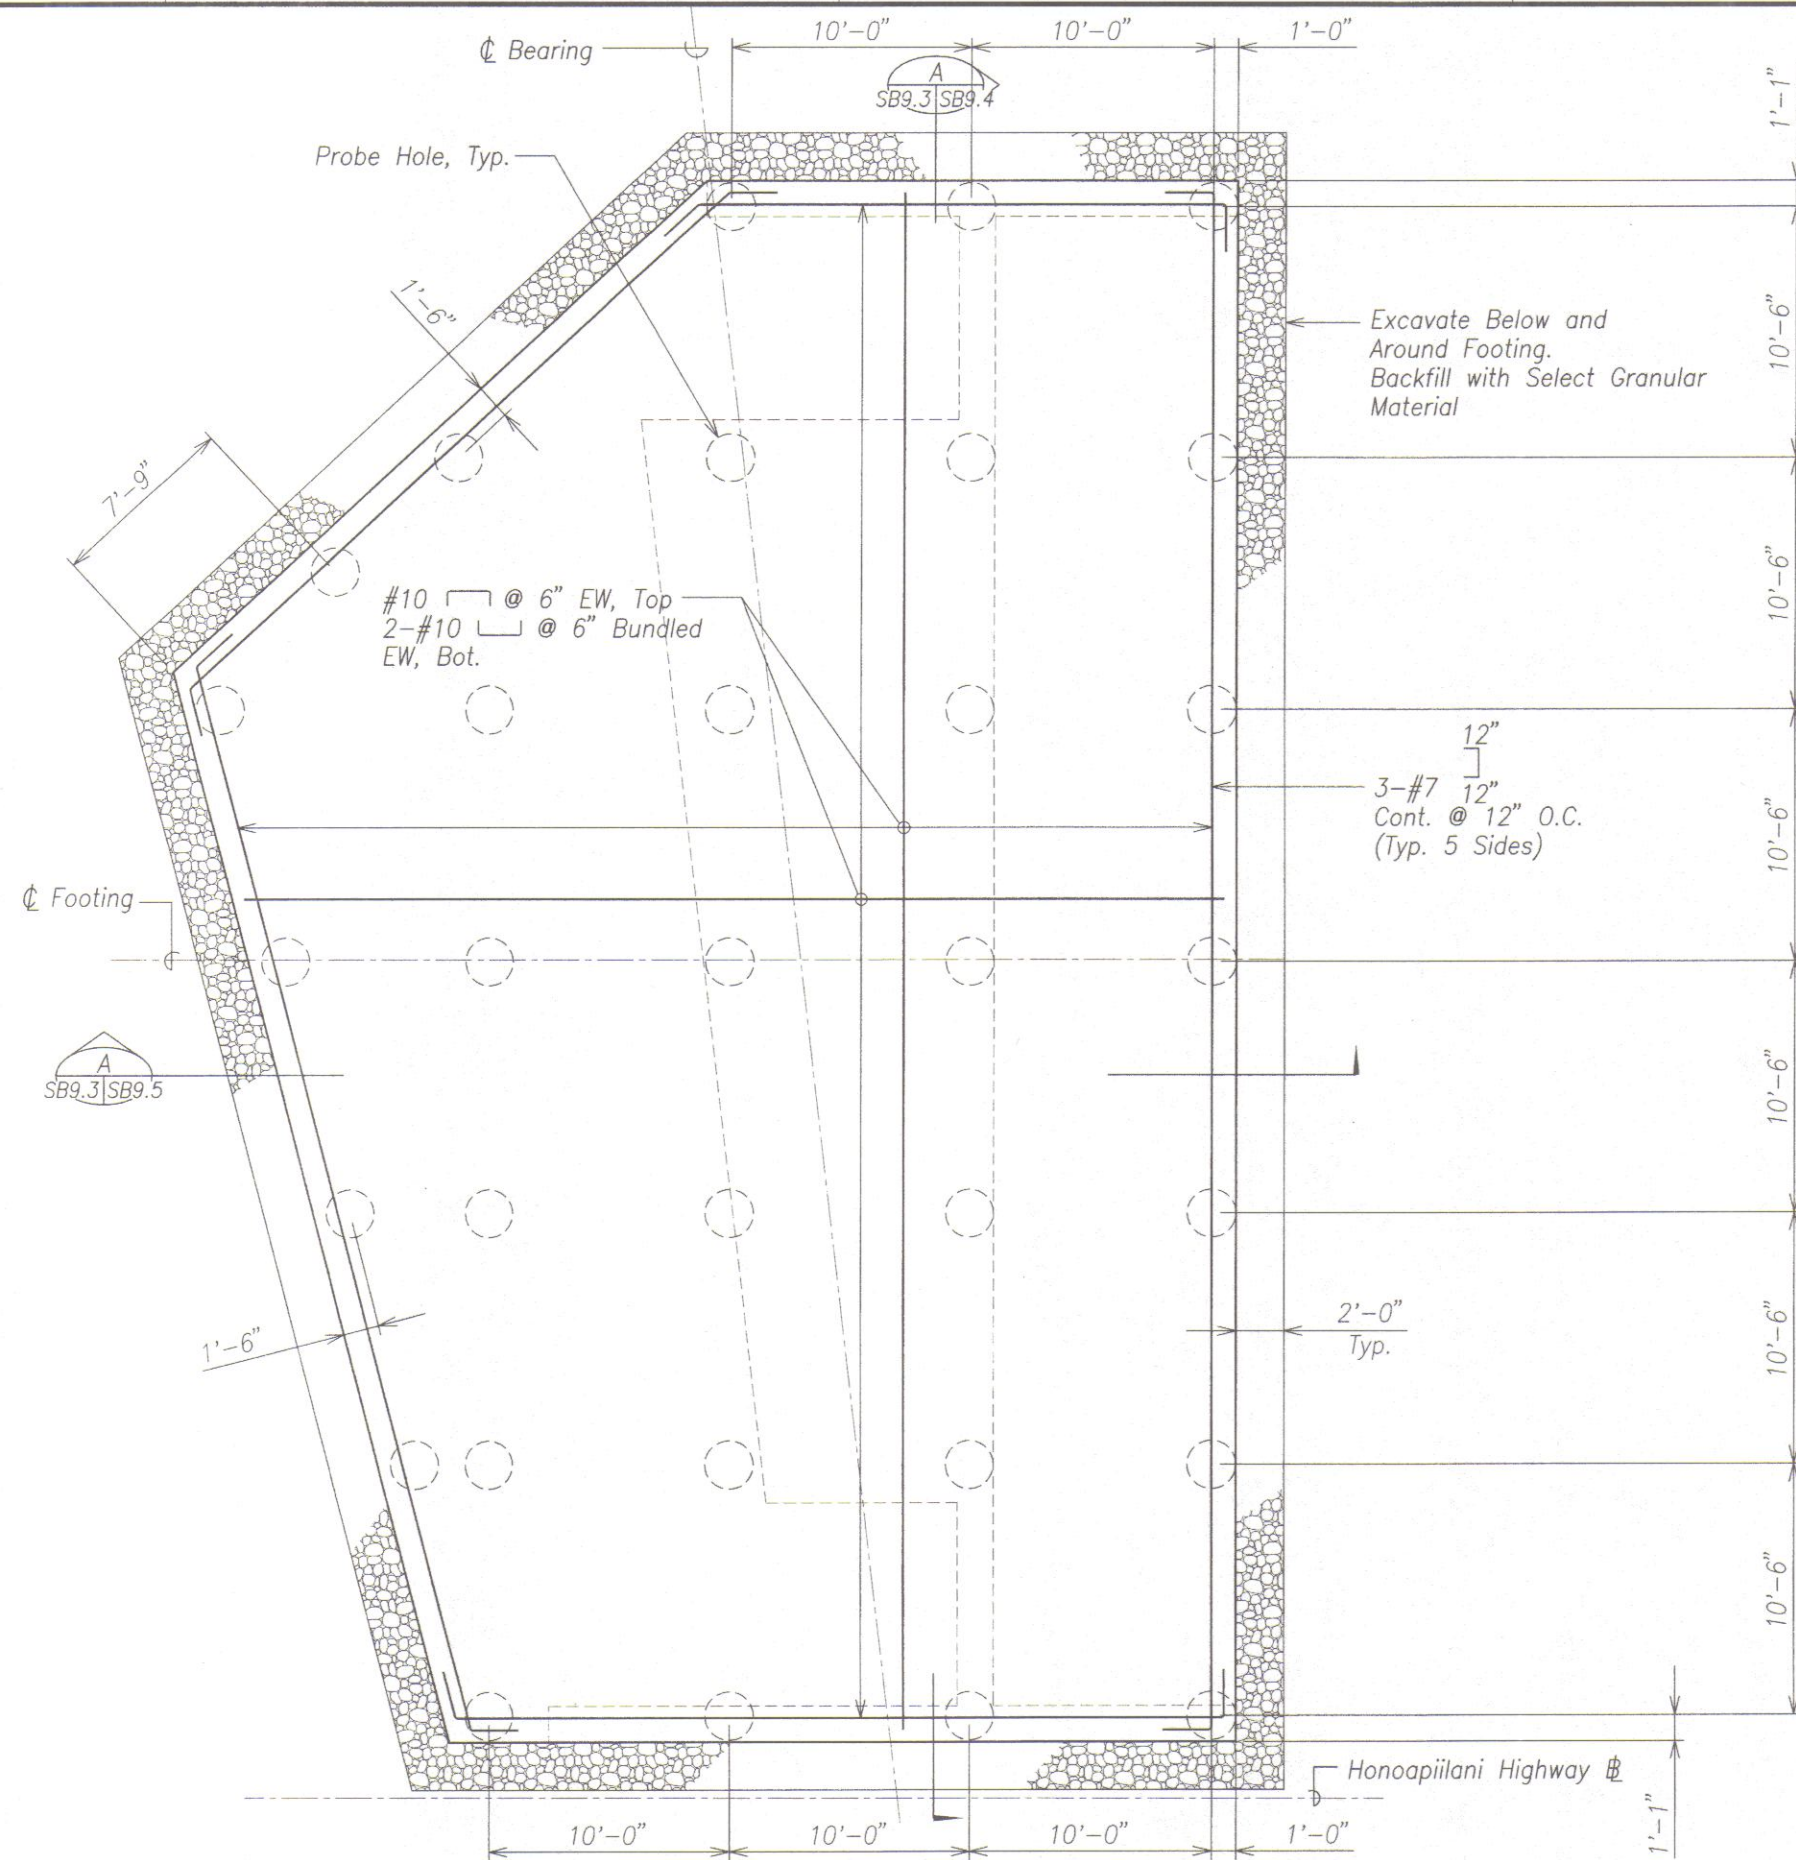

FOOTING REINFORCING PLAN - ABUTMENT 2

Scale: 1/4" = 1'-0"

SB9.3/SB9.3

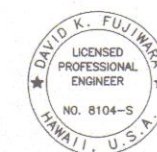

THIS WORK WAS PREPARED BY ME OR UNDER MY SUPERVISION.


David K. Fujiwara
KSF, INC. APRIL 30, 2012
LIC. EXP. DATE

STATE OF HAWAII
DEPARTMENT OF TRANSPORTATION
HIGHWAYS DIVISION
ABUTMENT 2
FOOTING REINFORCING PLAN
HONOAPIILANI HIGHWAY REALIGNMENT, PHASE 1A
Future Keawe St Extension to Lahainaluna Rd, Part B
Fed. Aid Proj. No. NH-030-1(35)R
Scale: As Noted Date: June, 2010
SHEET No. SB9.3 OF 5 SHEETS

DRAWING NAME: 2100 ONGOING\40019.D-HONOAPIILANI LAHAINA BYPASS-KAHOMA WD\06-15-10 COMBINE LAHAINA FINAL DESIGN\HH-SB901.DWG PLOT TIME: 06-14-10, 8:12 PM

ORIGINAL PLAN	DATE
SURVEY PLOTTED BY	
DRAWN BY	
TRACED BY	
DESIGNED BY	
NOTED BY	
CHECKED BY	
NO.	

FED. ROAD DIST. NO.	STATE	FED. AID PROJ. NO.	FISCAL YEAR	SHEET NO.	TOTAL SHEETS
HAWAII	HAW.	NH-030-1(35)R	2009	333	383

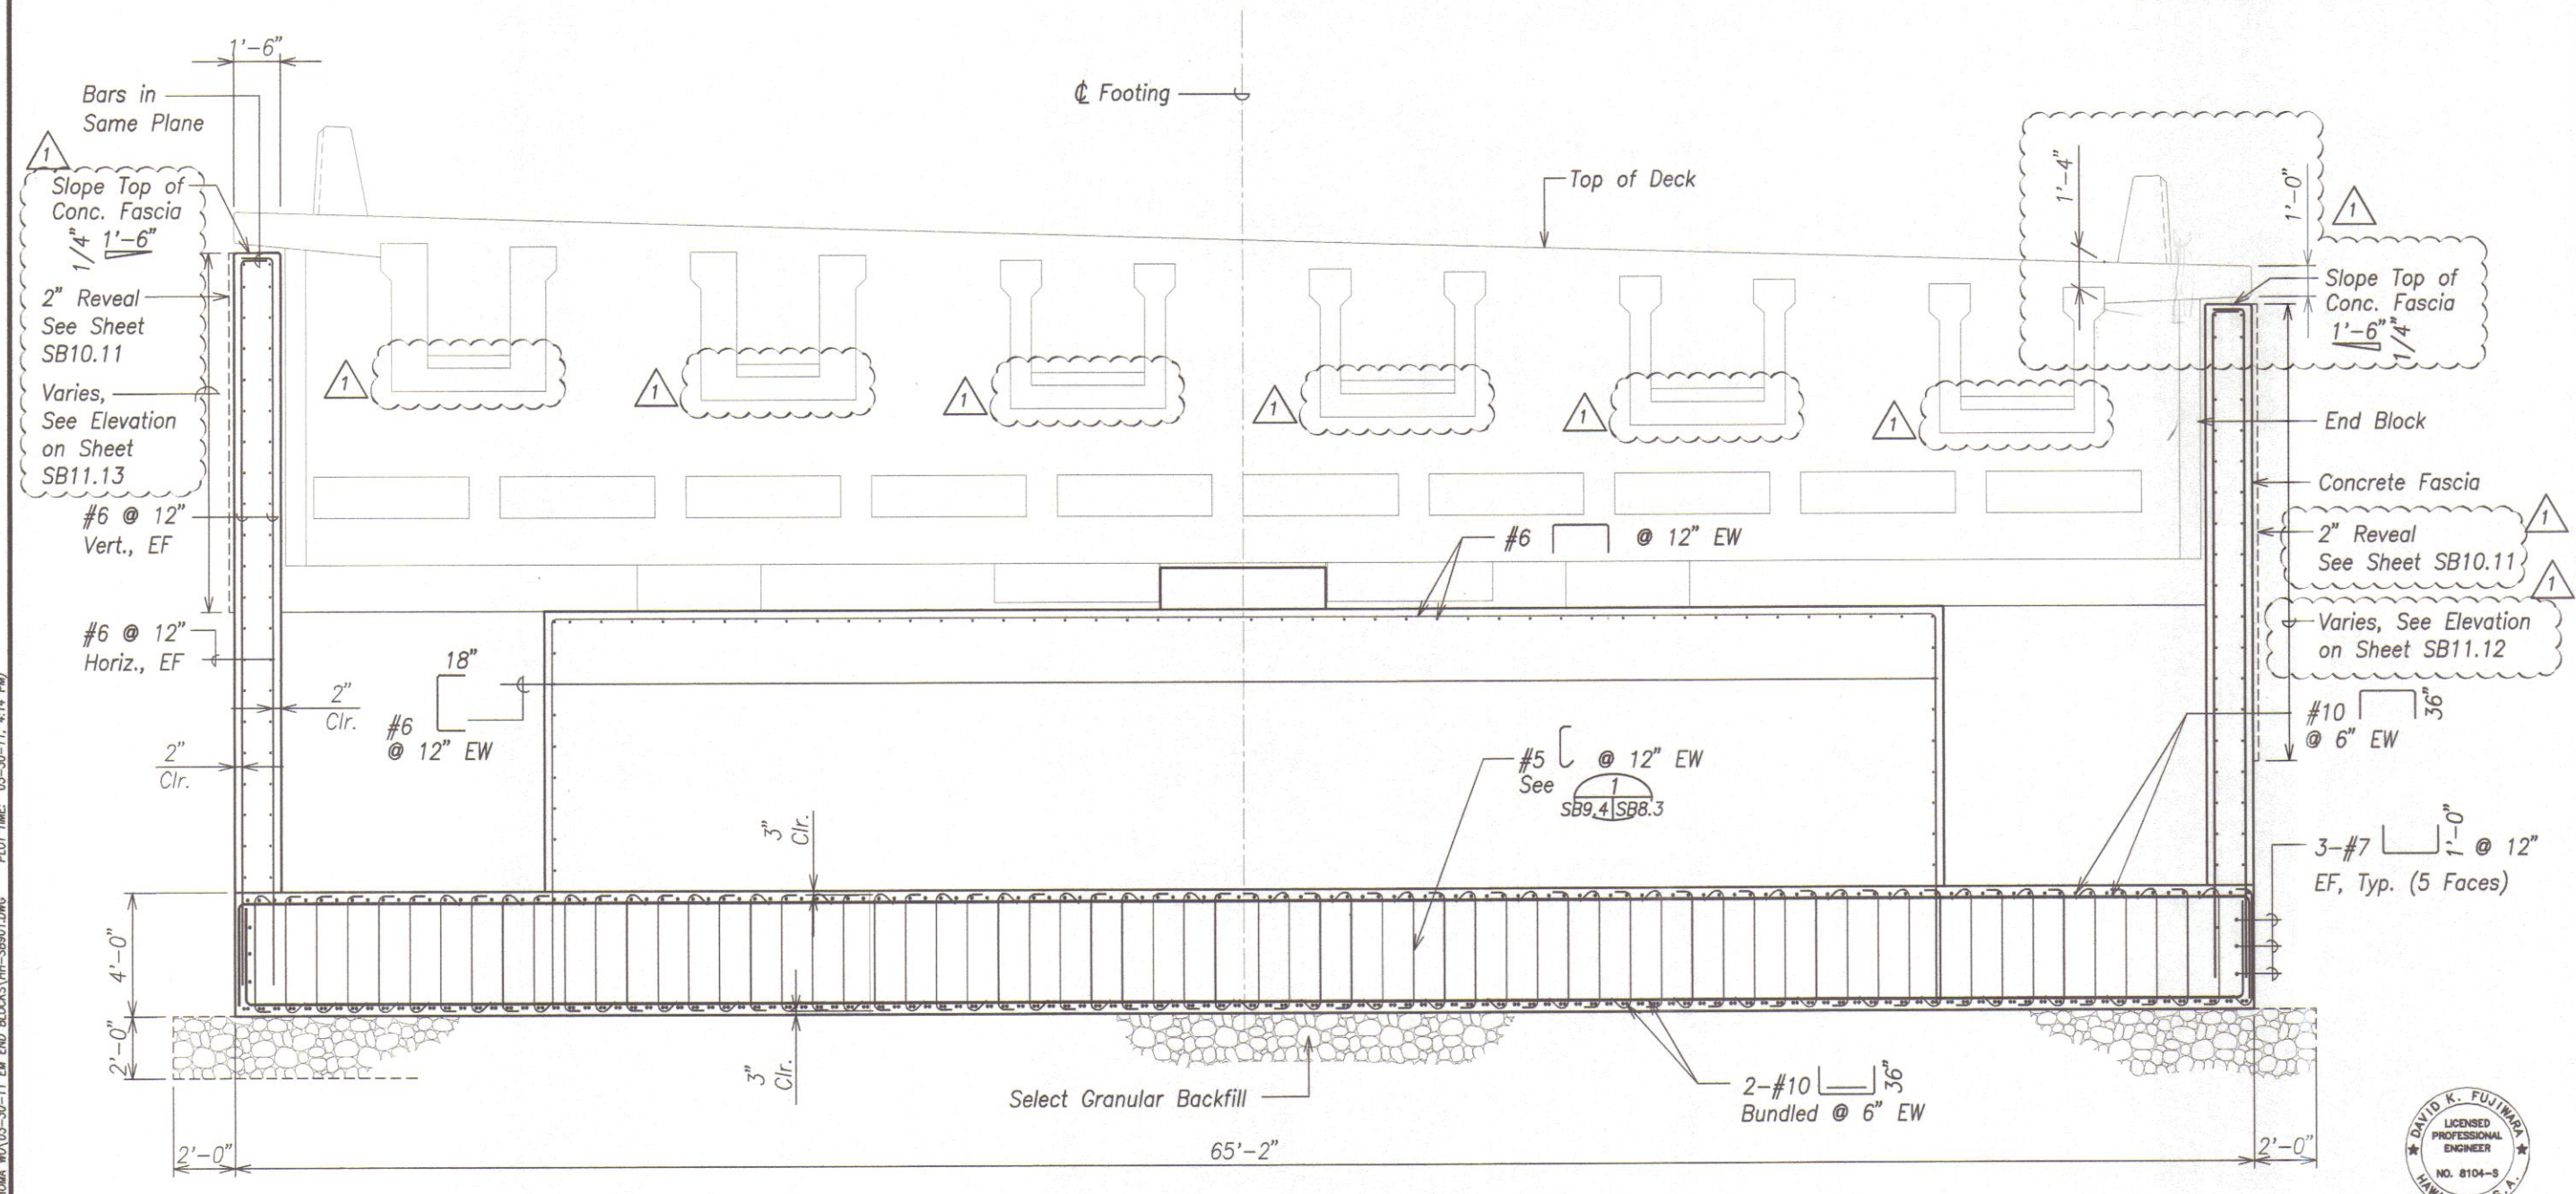

ELEVATION - ABUTMENT 2 A
Scale: 3/8" = 1'-0" SB9.3|SB9.4



THIS WORK WAS PREPARED BY ME
OR UNDER MY SUPERVISION.
KSF, INC. APRIL 30, 2012
LIC. EXP. DATE

DATE	_____
SURVEY PLOTTED BY	_____
DRAWN BY	_____
TRACED BY	_____
NOTED BY	_____
CHECKED BY	_____
ORIGINAL PLAN	_____
NOTE BOOK	_____
No.	_____

DRAWING NAME: Z:\00 ONGOING\40019.0-HONOLULU LAHAINA BYPASS-KAHOMA W\03-30-11 EM END BLOCKS\HH-SB901.DWG PLOT TIME: 03-30-11 4:14 PM

2/01/11	1	Revisions
DATE	REVISION	

STATE OF HAWAII
DEPARTMENT OF TRANSPORTATION
HIGHWAYS DIVISION


ABUTMENT 2 ELEVATION

HONOLULU HIGHWAY REALIGNMENT, PHASE 1A
Future Keawe St Extension to Lahainaluna Rd, Part B
Fed. Aid Proj. No. NH-030-1(35)R

Scale: As Noted Date: June, 2010

SHEET No. SB9.4 OF 5 SHEETS

FED. ROAD DIST. NO.	STATE	FED. AID PROJ. NO.	FISCAL YEAR	SHEET NO.	TOTAL SHEETS
HAWAII	HAW.	NH-030-1(35)R	2009	333	383

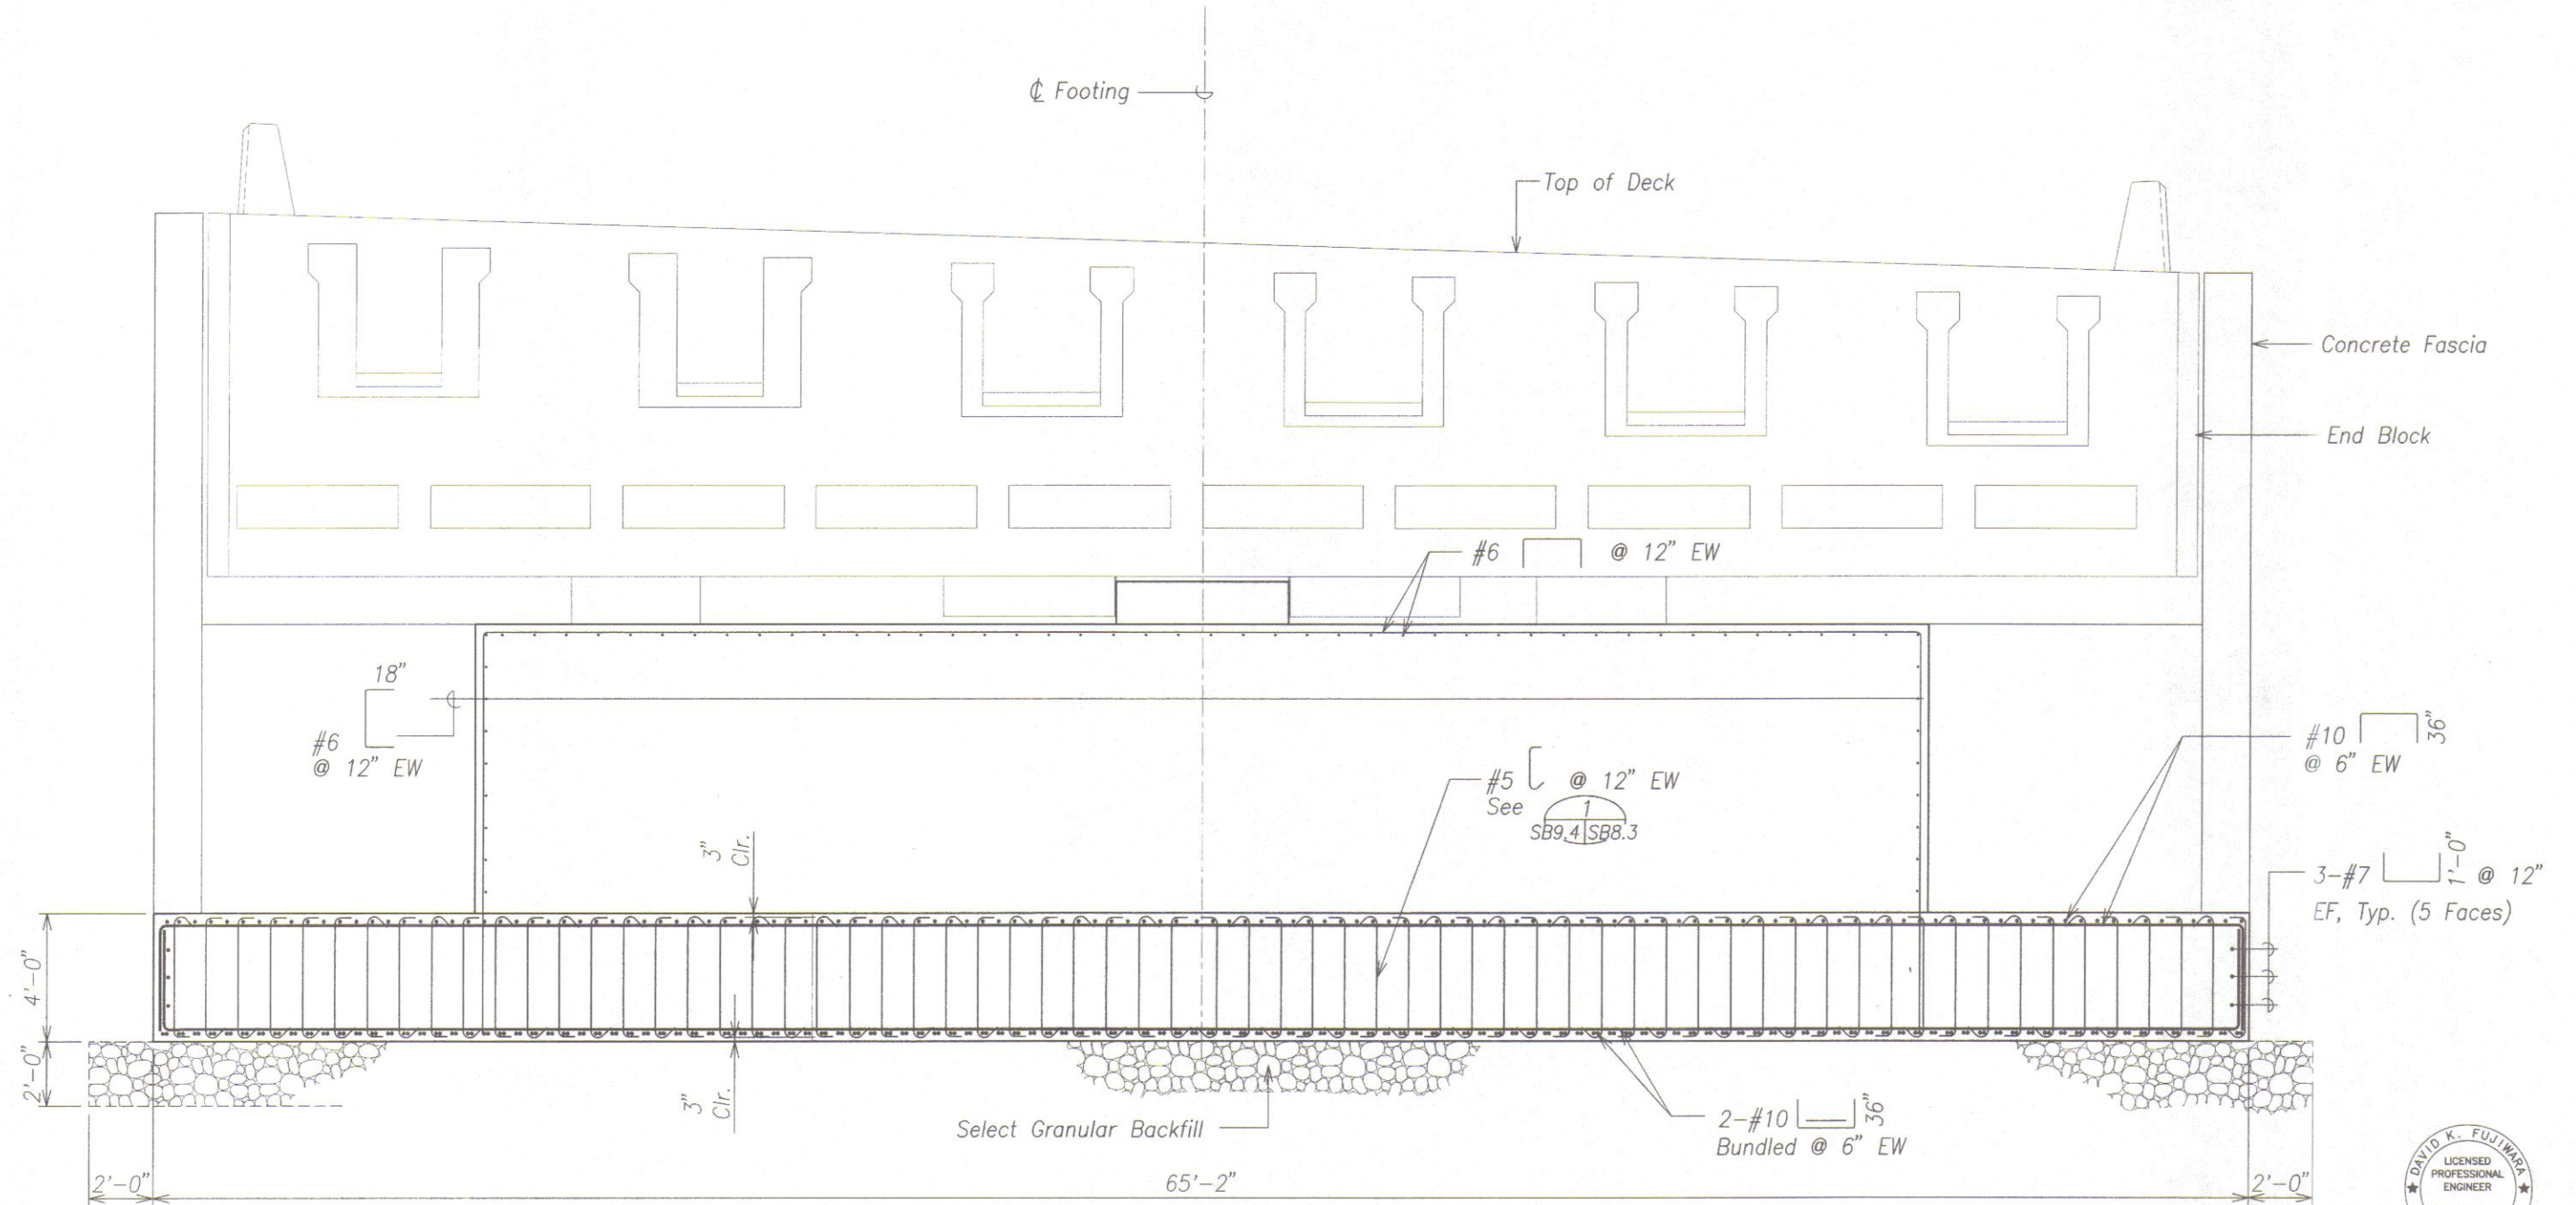

ELEVATION - ABUTMENT 2 A
Scale: 3/8" = 1'-0" SB9.3/SB9.4



THIS WORK WAS PREPARED BY ME
OR UNDER MY SUPERVISION.
David K. Fujiwara
KSF, INC. APRIL 30, 2012
LIC. EXP. DATE

STATE OF HAWAII
DEPARTMENT OF TRANSPORTATION
HIGHWAYS DIVISION

ABUTMENT 2 ELEVATION

HONOAPIILANI HIGHWAY REALIGNMENT, PHASE 1A
Future Keawe St Extension to Lahainaluna Rd, Part B
Fed. Aid Proj. No. NH-030-1(35)R

Scale: As Noted Date: June, 2010


SHEET No. SB9.4 OF 5 SHEETS

FINAL DESIGN 333 REV.

SURVEY PLOTTED BY	DATE
DRAWN BY	
TRACED BY	
DESIGNED BY	
QUANTITIES BY	
CHECKED BY	
No.	

DRAWING NAME: Z:\00 ONCING\40019.0-HONOAPIILANI LAHAINA BYPASS-KAHOMA WD\06-15-10 COMBINE LAHAINA FINAL DESIGN\HH-SB901.DWG PLOT TIME: 06-14-10, 8:12 PM

FED. ROAD DIST. NO.	STATE	FED. AID PROJ. NO.	FISCAL YEAR	SHEET NO.	TOTAL SHEETS
HAWAII	HAW.	NH-030-1(35)R	2009	334	383

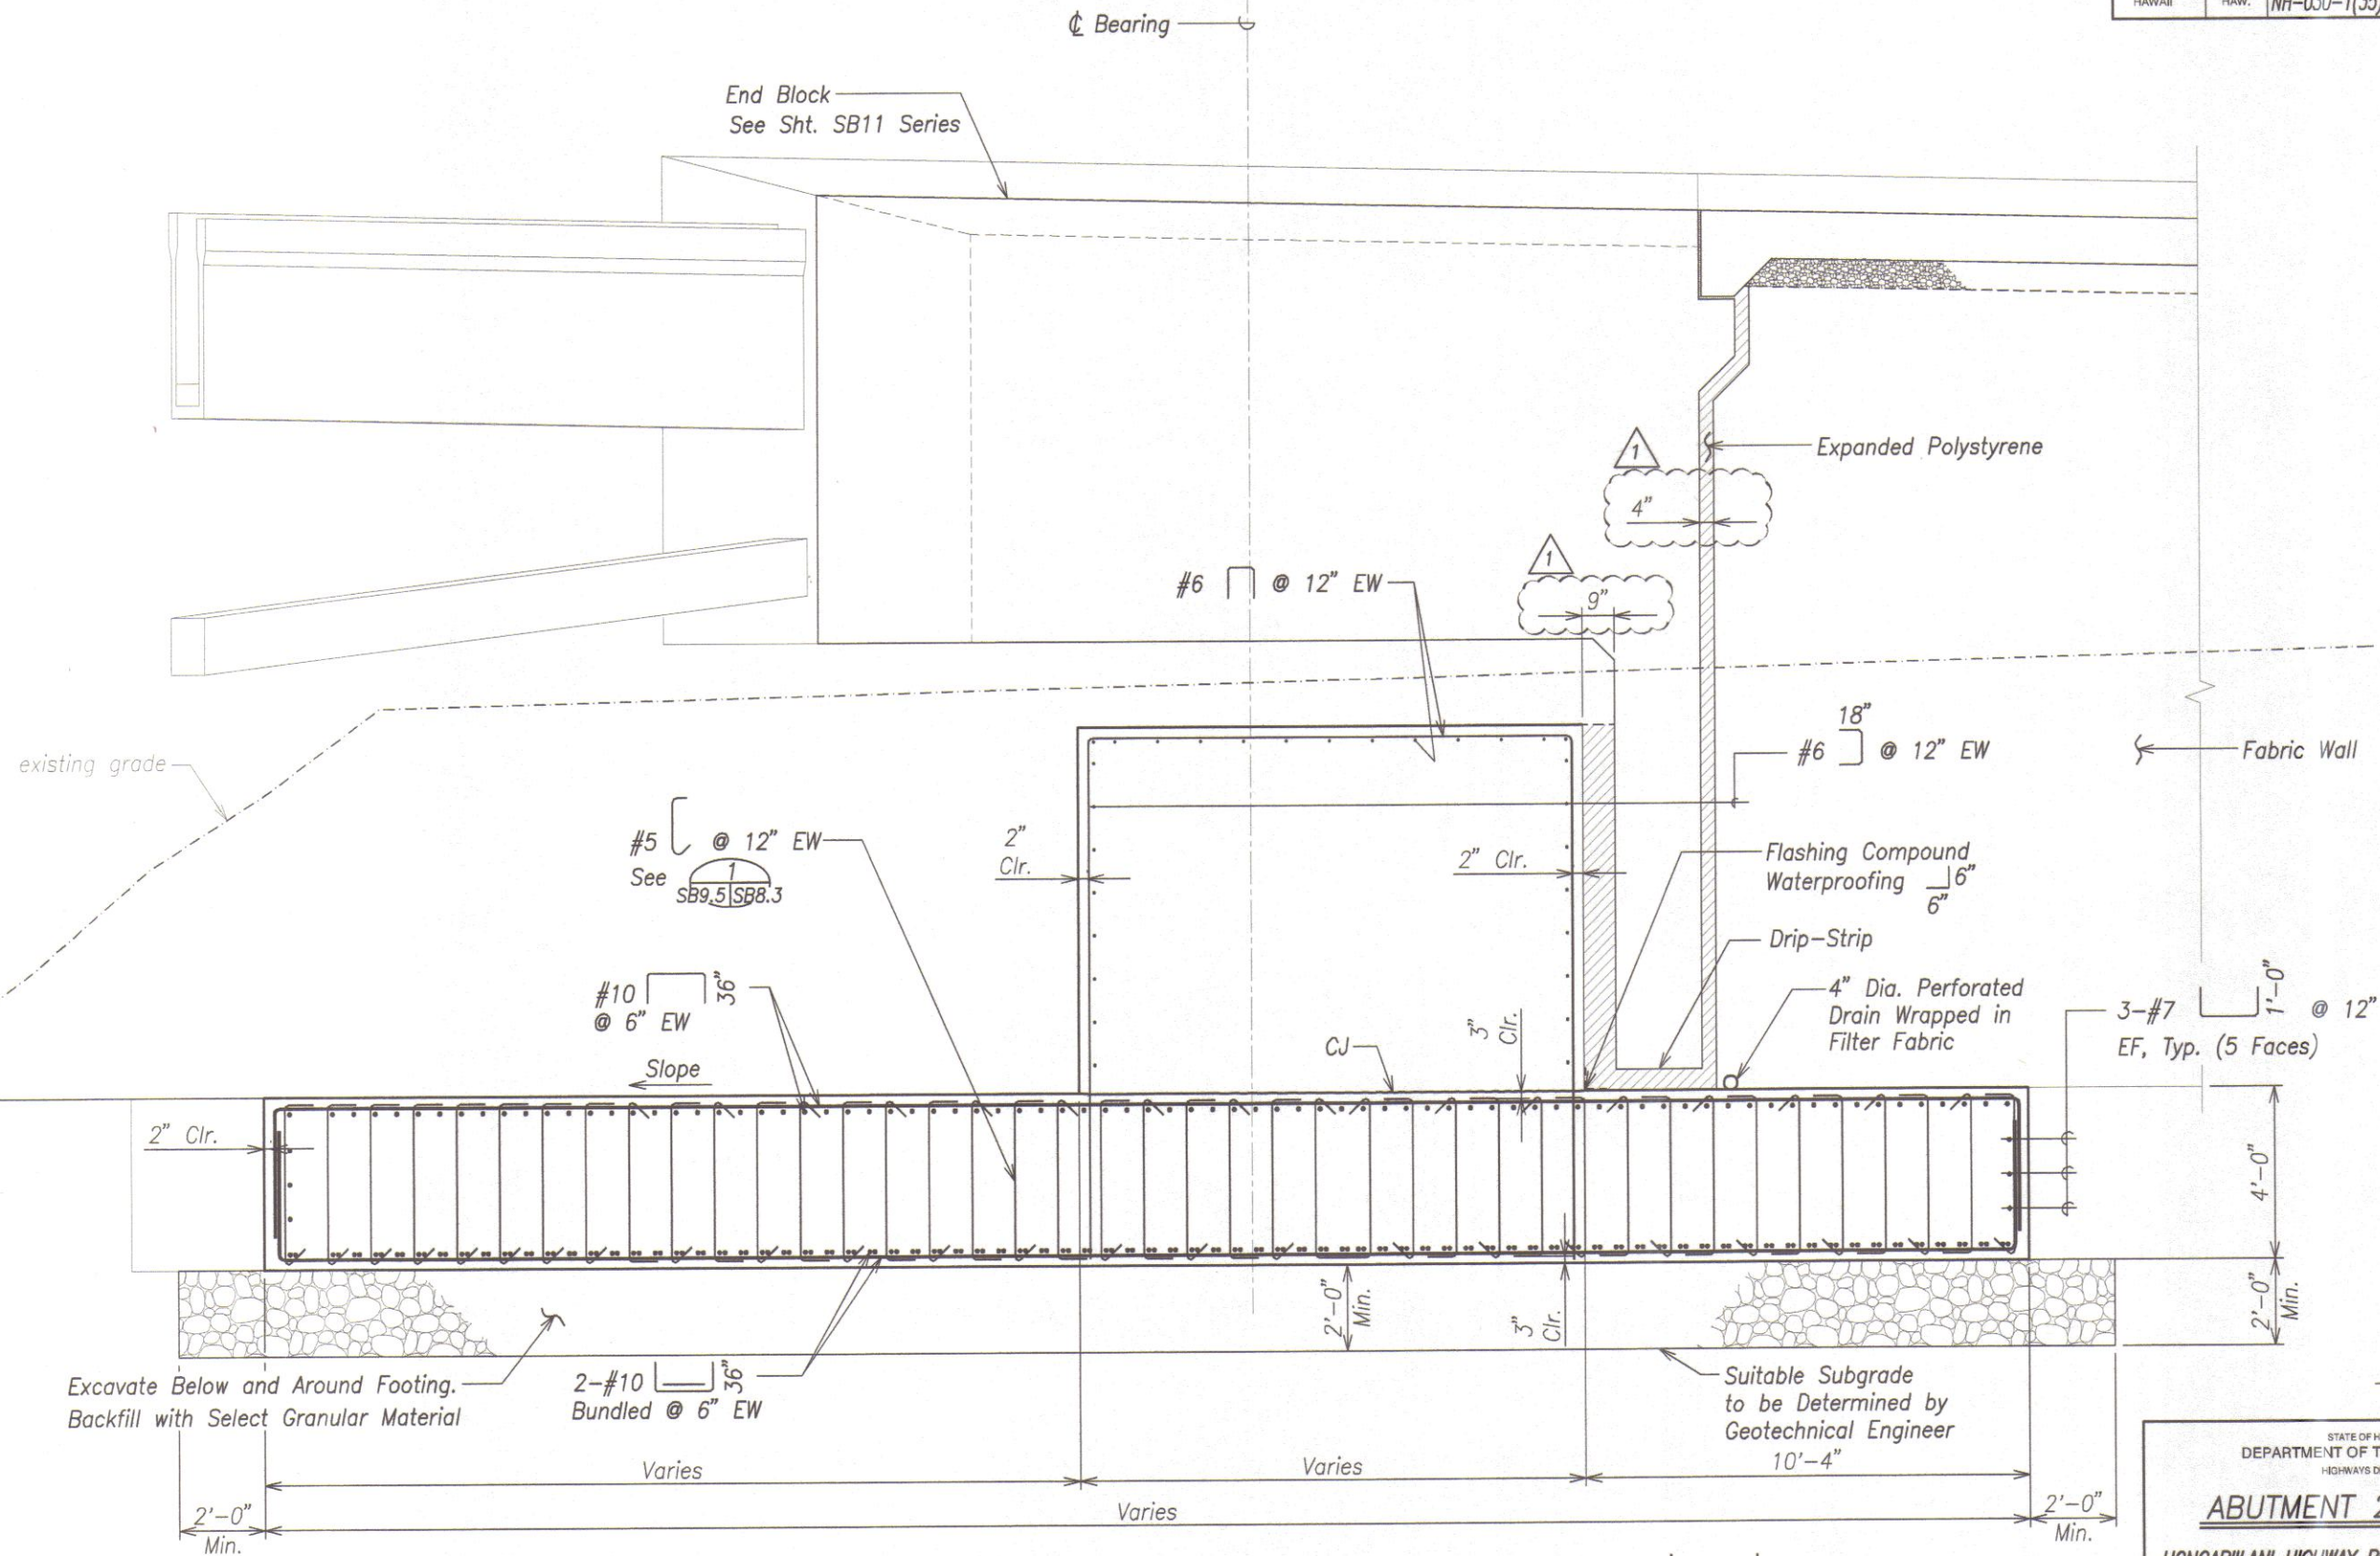

THIS WORK WAS PREPARED BY ME OR UNDER MY SUPERVISION.

KSF, INC. APRIL 30, 2012 LIC. EXP. DATE

SECTION - ABUTMENT 2
Scale: 1/2" = 1'-0"
SB9.3 | SB9.5

DATE	REVISION
2/01/11	1 Revisions

STATE OF HAWAII
DEPARTMENT OF TRANSPORTATION
HIGHWAYS DIVISION

ABUTMENT 2 SECTION

HONOAPIILANI HIGHWAY REALIGNMENT, PHASE 1A
Future Keawe St Extension to Lahainaluna Rd, Part B
Fed. Aid Proj. No. NH-030-1(35)R


Scale: As Noted Date: June, 2010

SHEET No. SB9.5 OF 5 SHEETS

DESIGNED BY	DATE
CHECKED BY	
NOTED BY	
QUANTITIES BY	
NO.	

DRAWING NAME: Z:\00 ONCONO\001910-HONOAPIILANI LAHAINA BYPASS-KAHONA WD\03-30-11 EM END BLOCKS\H-SB901.DWG PLOT TIME: 03-30-11, 4:15 PM

FED. ROAD DIST. NO.	STATE	FED. AID PROJ. NO.	FISCAL YEAR	SHEET NO.	TOTAL SHEETS
HAWAII	HAW.	NH-030-1(35)R	2009	334	383

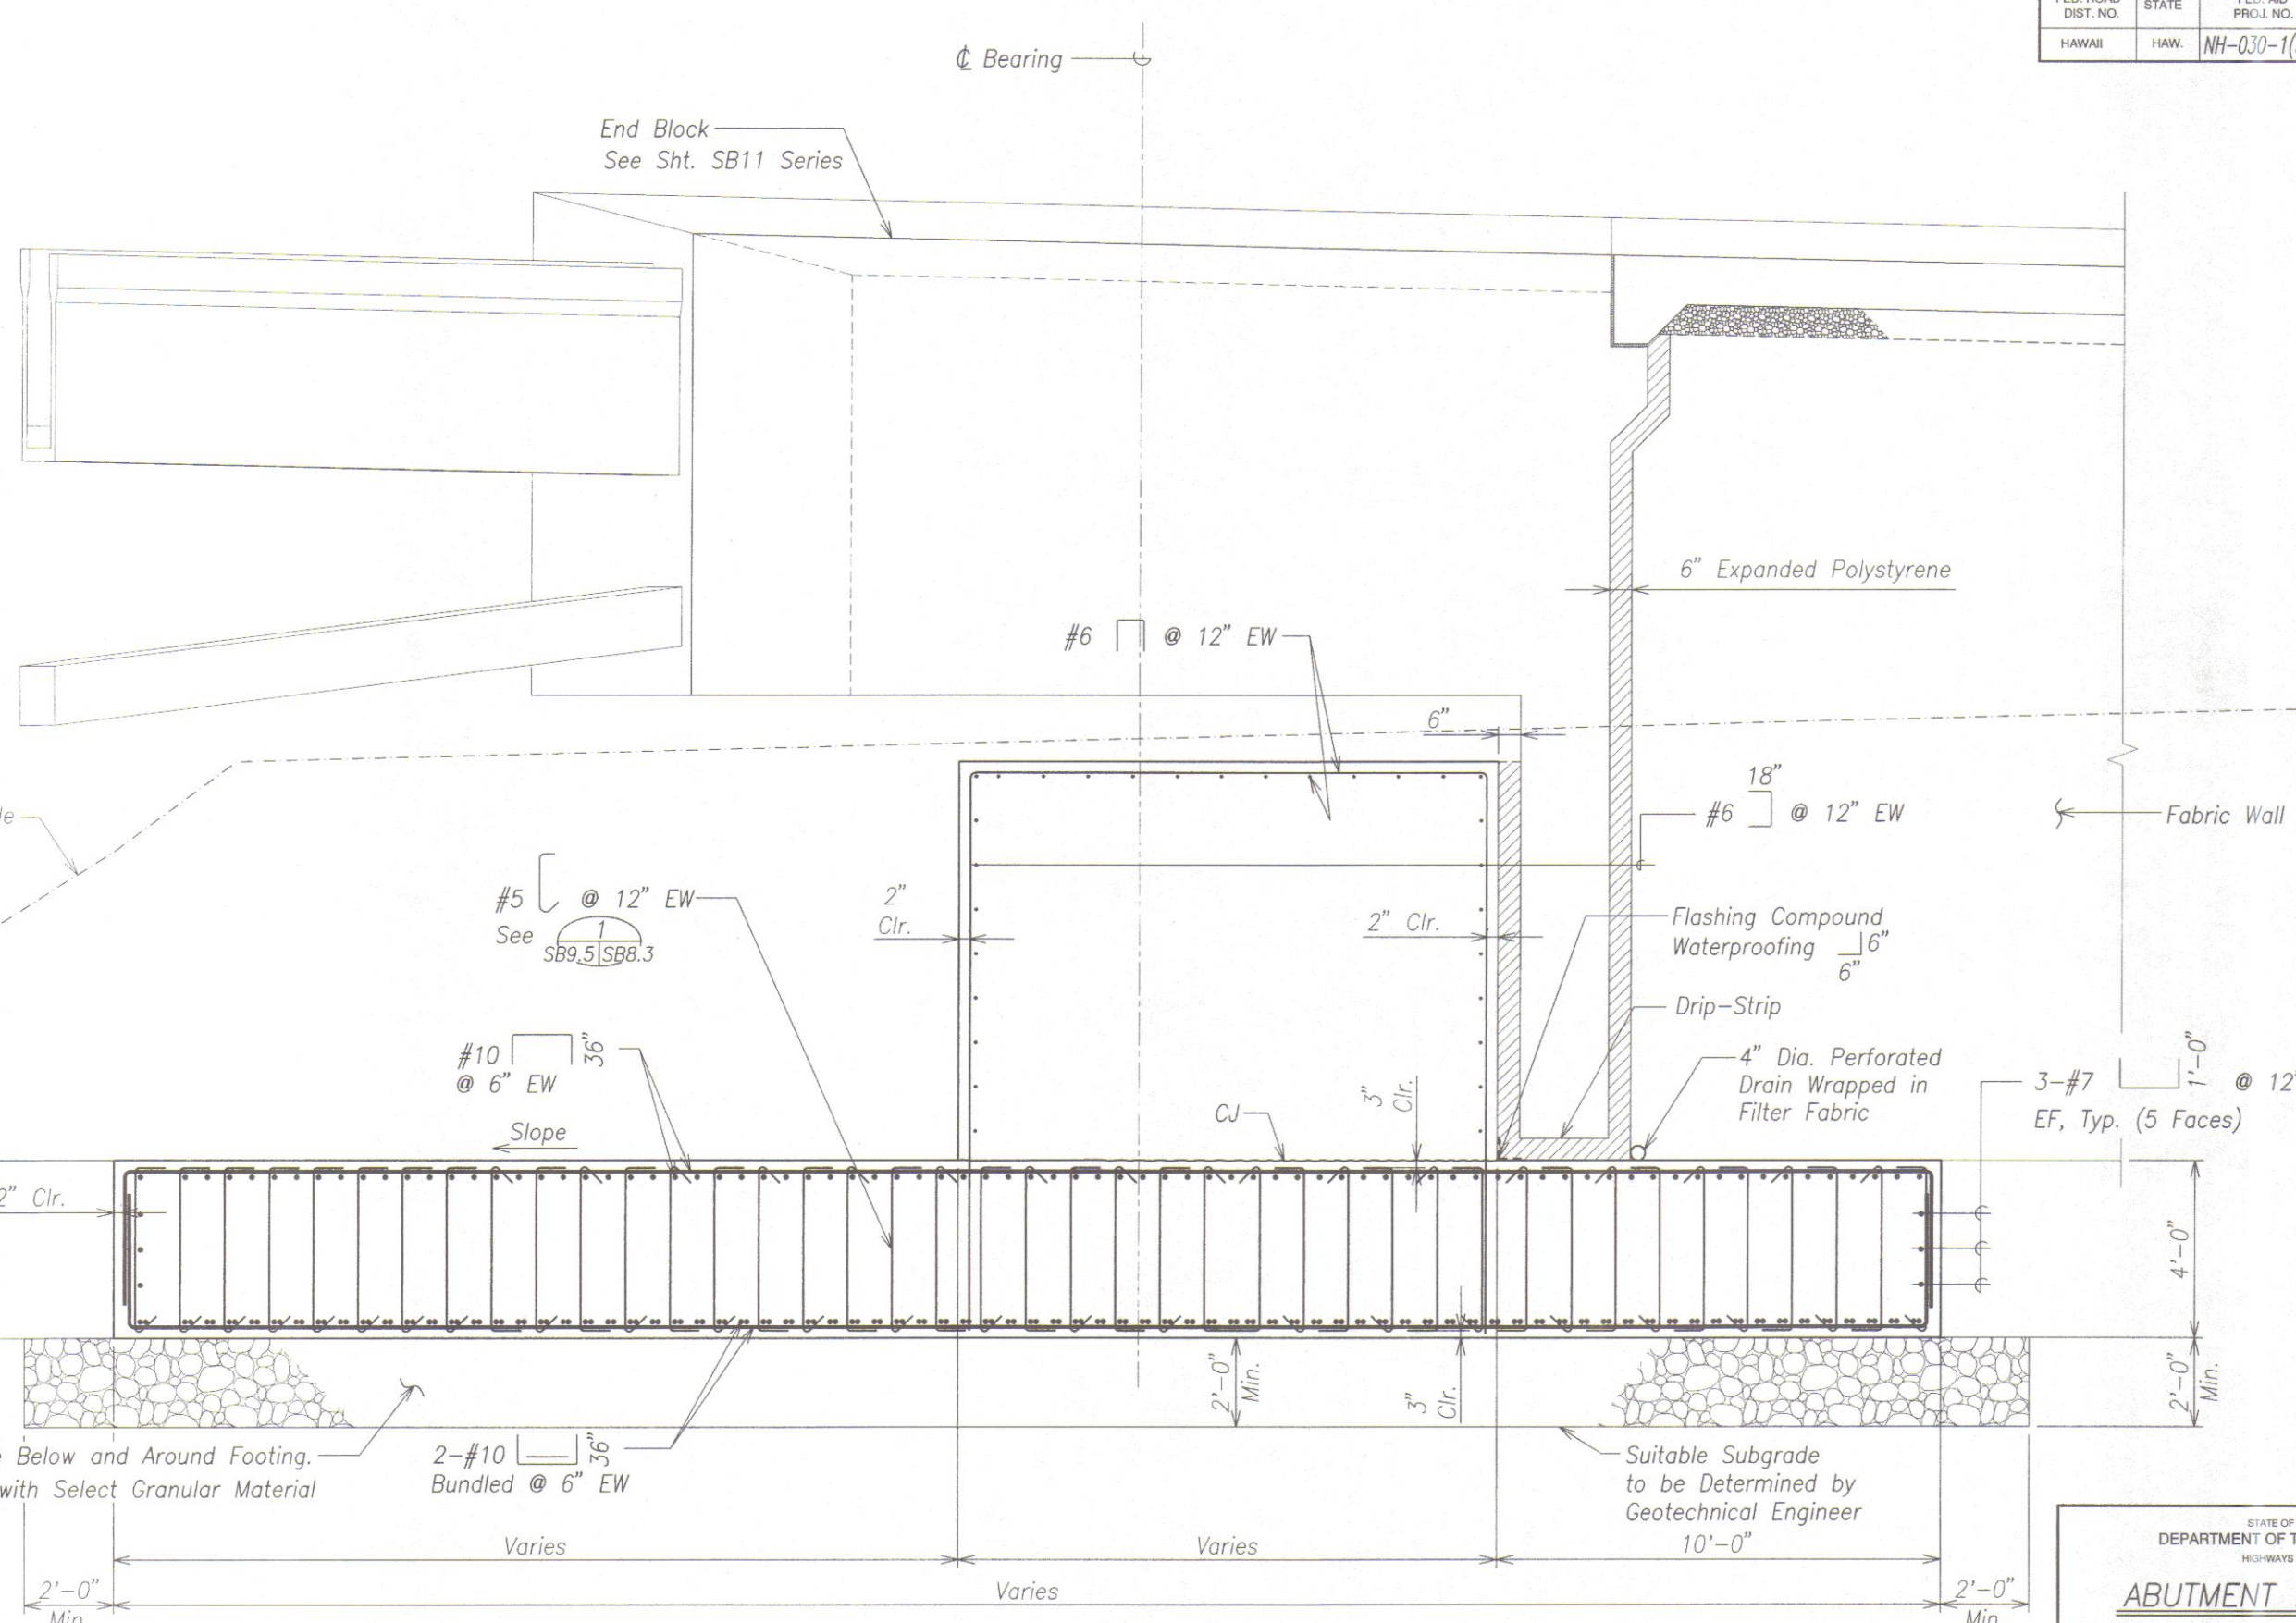

THIS WORK WAS PREPARED BY ME OR UNDER MY SUPERVISION.
David K. Fujiwara
 KSF, INC. APRIL 30, 2012
 LIC. EXP. DATE

STATE OF HAWAII
 DEPARTMENT OF TRANSPORTATION
 HIGHWAYS DIVISION

ABUTMENT 2 SECTION

HONOAPIILANI HIGHWAY REALIGNMENT, PHASE 1A
 Future Keawe St Extension to Lahainaluna Rd, Part B
 Fed. Aid Proj. No. NH-030-1(35)R

Scale: As Noted Date: June, 2010


SHEET No. SB9.5 OF 5 SHEETS

SECTION - ABUTMENT 2
 Scale: 1/2" = 1'-0"
 SB9.3/SB9.5

SURVEY PLOTTED BY	DATE
DRAWN BY	
DESIGNED BY	
QUANTITIES BY	
CHECKED BY	
NO.	

DRAWING NAME: Z:\00 ONGOING\40019.0-HONOAPIILANI LAHAINA BYPASS-KAHOMA WO\06-15-10 COMBINE LAHAINA FINAL DESIGN\HH-SB901.DWG PLOT TIME: 06-14-10, 8:14 PM

FED. ROAD DIST. NO.	STATE	FED. AID PROJ. NO.	FISCAL YEAR	SHEET NO.	TOTAL SHEETS
HAWAII	HAW.	NH-030-1(35)R	2009	335	383

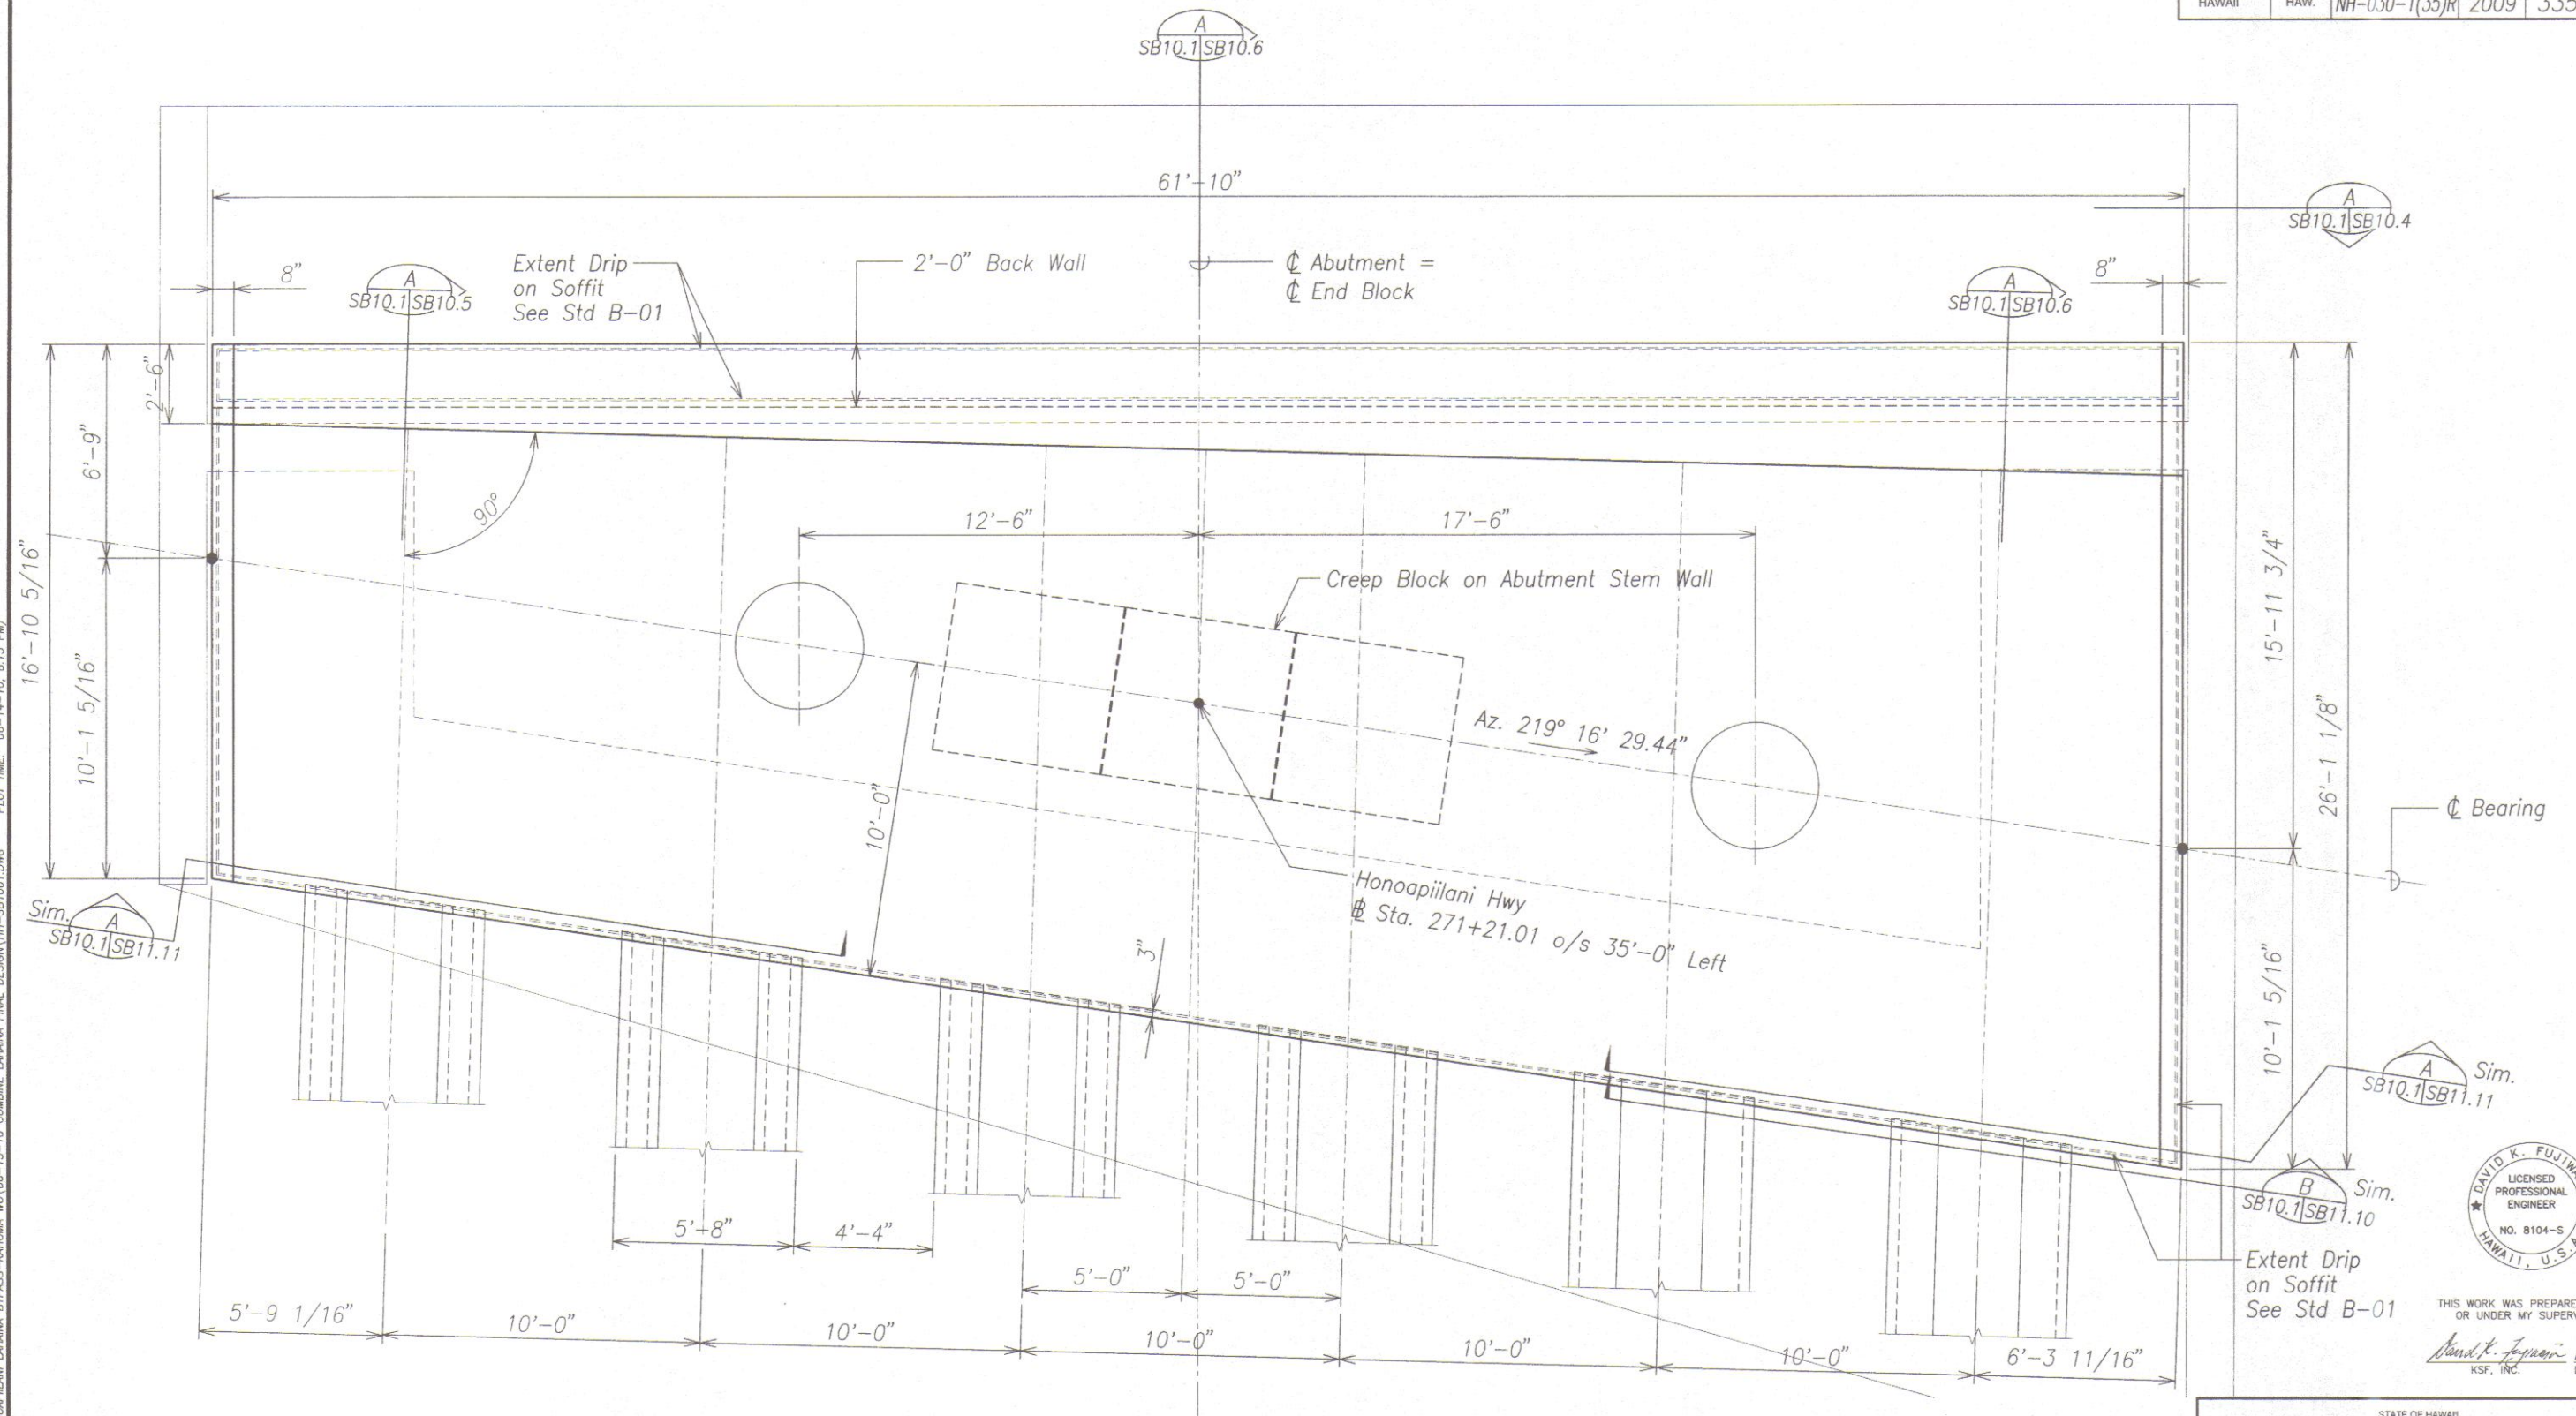

END BLOCK AT ABUTMENT 1 - PLAN

Scale: $3/8" = 1'-0"$

STATE OF HAWAII
DEPARTMENT OF TRANSPORTATION
HIGHWAYS DIVISION
END BLOCK AT ABUTMENT 1
PLAN
HONOAPIILANI HIGHWAY REALIGNMENT, PHASE 1A
Future Keawe St Extension to Lahainaluna Rd, Part B
Fed. Aid Proj. No. NH-030-1(35)R

Scale: As Noted Date: June, 2010


SHEET No. SB10.1 OF 10 SHEETS

FINAL DESIGN ~~335~~ Rev

ORIGINAL PLAN	SURVEY PLOTTED BY _____ DATE _____
NOTE BOOK	DRAWN BY _____
	TRACED BY _____
	DESIGNED BY _____
	QUANTITIES BY _____
No. _____	CHECKED BY _____

DRAWING NAME: Z:\00 ONGOING\40019.0-HONDAPIILANI LAHAINA BYPASS-KAHOMA WO\06-15-10 COMBINE LAHAINA FINAL DESIGN\HH-SB1001.DWG PLOT TIME: 06-14-10, 8:15 PM)

FED. ROAD DIST. NO.	STATE	FED. AID PROJ. NO.	FISCAL YEAR	SHEET NO.	TOTAL SHEETS
HAWAII	HAW.	NH-030-1(35)R	2009	336	383

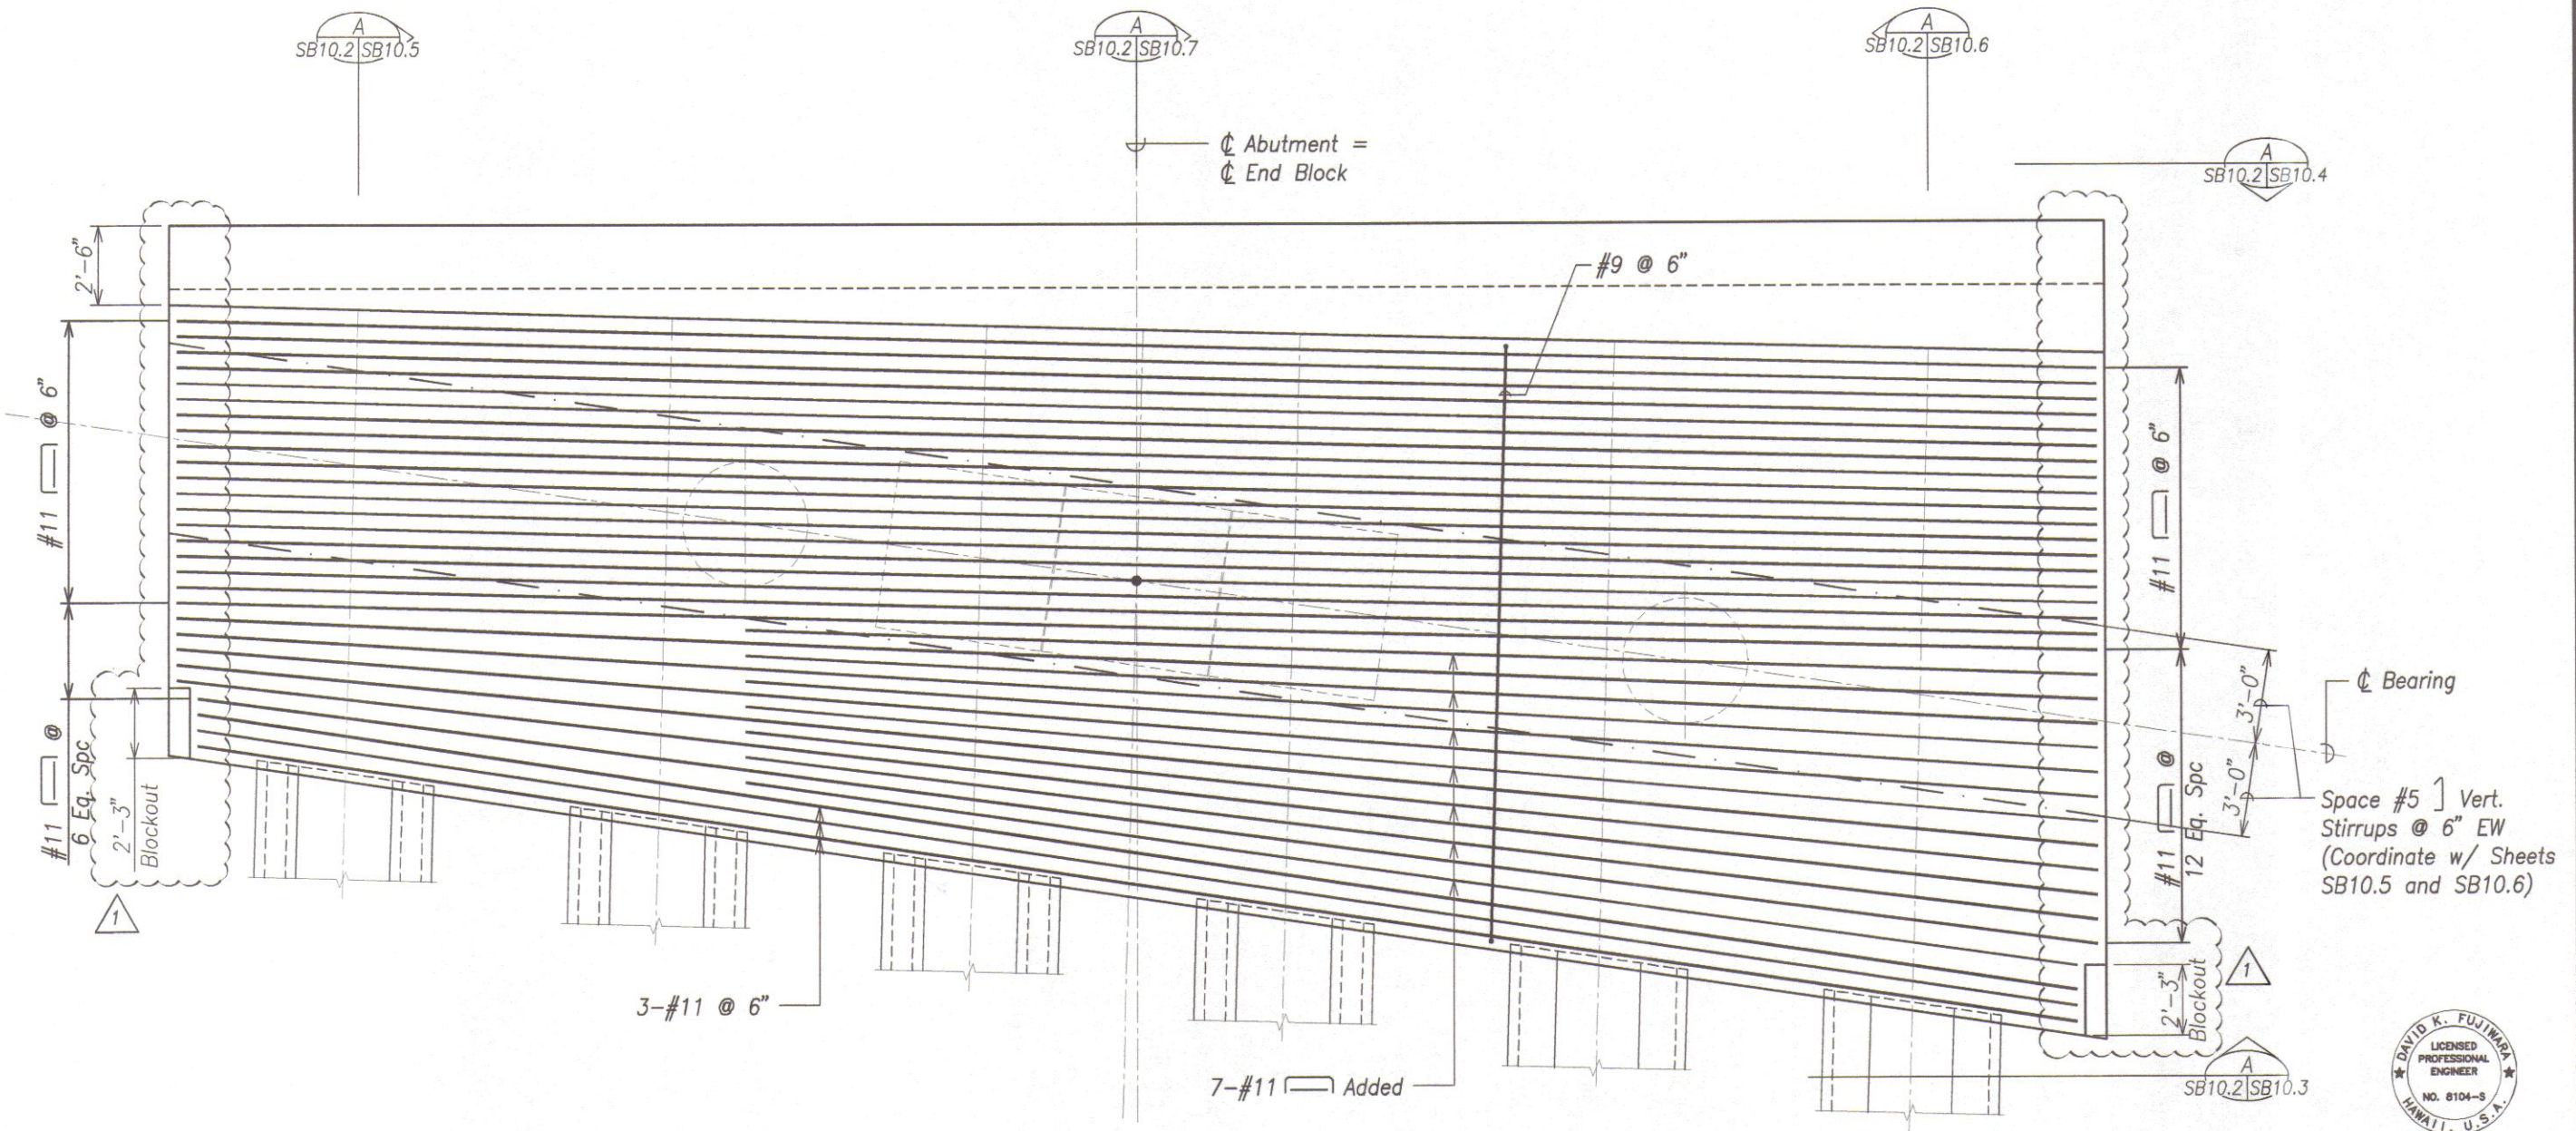

END BLOCK AT ABUTMENT 1 - REINFORCING
Scale: 3/8" = 1'-0"



THIS WORK WAS PREPARED BY ME OR UNDER MY SUPERVISION.

KSF, INC. APRIL 30, 2012 LIC. EXP. DATE

ORIGINAL PLAN	DATE
DESIGNED BY	
CHECKED BY	
NO.	

DRAWING NAME: Z:\00 ONGOING\40018.0-HONOAPILANI LAHAINA BYPASS-KAHOMA W\03-30-11 EM END BLOCKS\HH-SB1001.DWG PLOT TIME: 03-30-11, 4:16 PM

DATE	2/01/11	REVISION	1 Revisions
DATE		REVISION	

STATE OF HAWAII
DEPARTMENT OF TRANSPORTATION
HIGHWAYS DIVISION

END BLOCK AT ABUTMENT 1
PLAN - REINFORCING LAYOUT
HONOAPILANI HIGHWAY REALIGNMENT, PHASE 1A
Future Keawe St Extension to Lahainaluna Rd, Part B
Fed. Aid Proj. No. NH-030-1(35)R

Scale: As Noted
SHEET No. SB10.2 OF 10 SHEETS

Date: June, 2010

FED. ROAD DIST. NO.	STATE	FED. AID PROJ. NO.	FISCAL YEAR	SHEET NO.	TOTAL SHEETS
HAWAII	HAW.	NH-030-1(35)R	2009	336	383


SB10.2|SB10.5

SB10.2|SB10.7

SB10.2|SB10.6

SB10.2|SB10.4

Abutment =
End Block

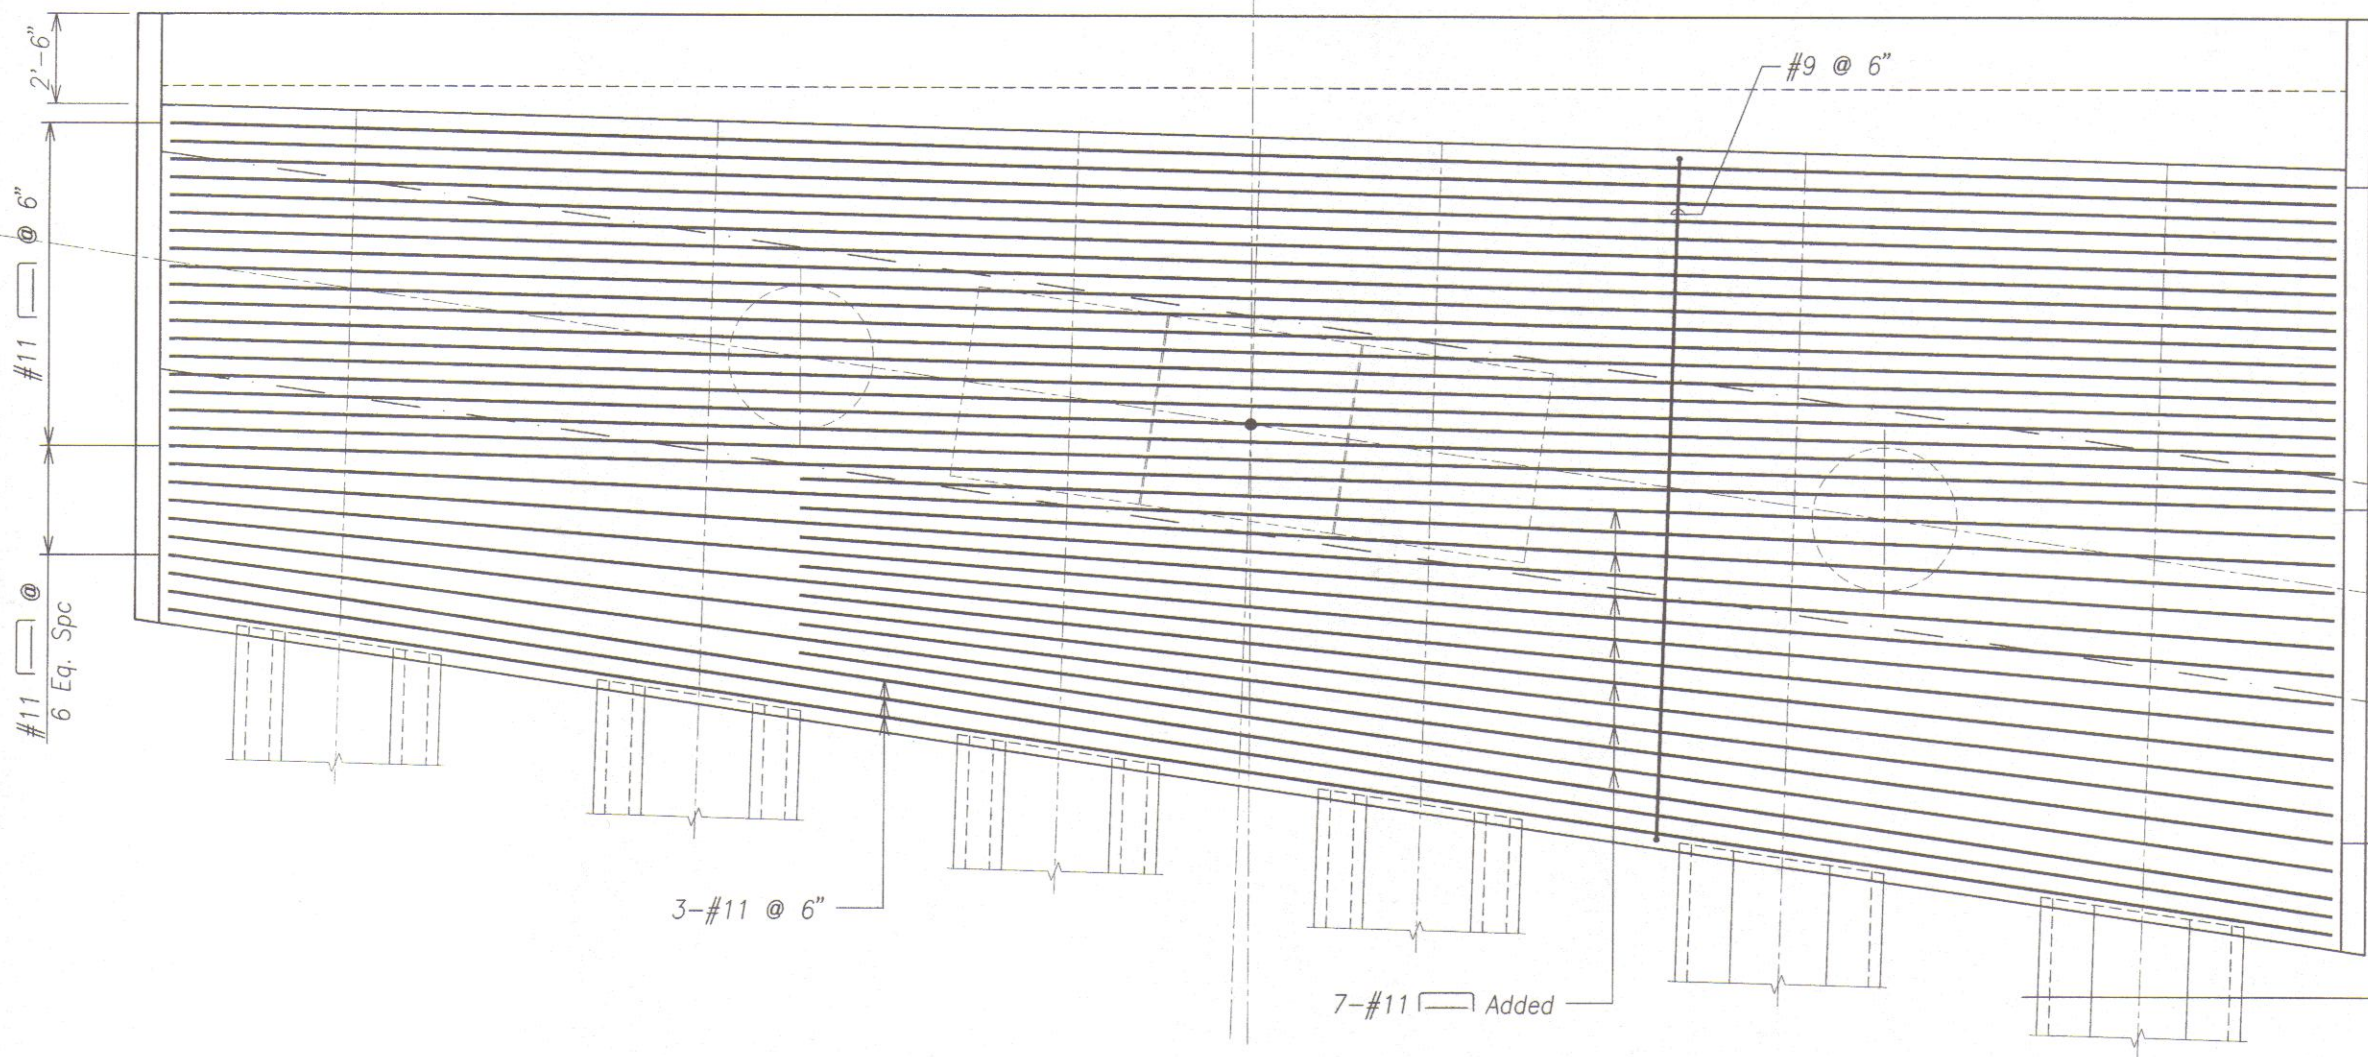

END BLOCK AT ABUTMENT 1 - REINFORCING
Scale: 3/8" = 1'-0"

SB10.2|SB10.2



THIS WORK WAS PREPARED BY ME
OR UNDER MY SUPERVISION.
David K. Fujiwara
KSF, INC. APRIL 30, 2012
LIC. EXP. DATE

STATE OF HAWAII
DEPARTMENT OF TRANSPORTATION
HIGHWAYS DIVISION

END BLOCK AT ABUTMENT 1
PLAN - REINFORCING LAYOUT

HONOAPIILANI HIGHWAY REALIGNMENT, PHASE 1A
Future Keawe St Extension to Lahainaluna Rd, Part B
Fed. Aid Proj. No. NH-030-1(35)R

Scale: As Noted Date: June, 2010


SHEET No. SB10.2 OF 10 SHEETS

FINAL DESIGN 336

ORIGINAL PLAN	DATE
NO. 1	
DESIGNED BY	
CHECKED BY	
QUANTITIES BY	
NOTED BY	
DATE	

DRAWING NAME: Z:\00 UNCONC\001910-HONOAPIILANI LAHANA BYPASS-KHOMA W\06-15-10 COMBINE LAHANA FINAL DESIGN\HH-SB1001.DWG PLOT TIME: 06-14-10, 8:15 PM


FED. ROAD DIST. NO.	STATE	FED. AID PROJ. NO.	FISCAL YEAR	SHEET NO.	TOTAL SHEETS
HAWAII	HAW.	NH-030-1(35)R	2009	337	383

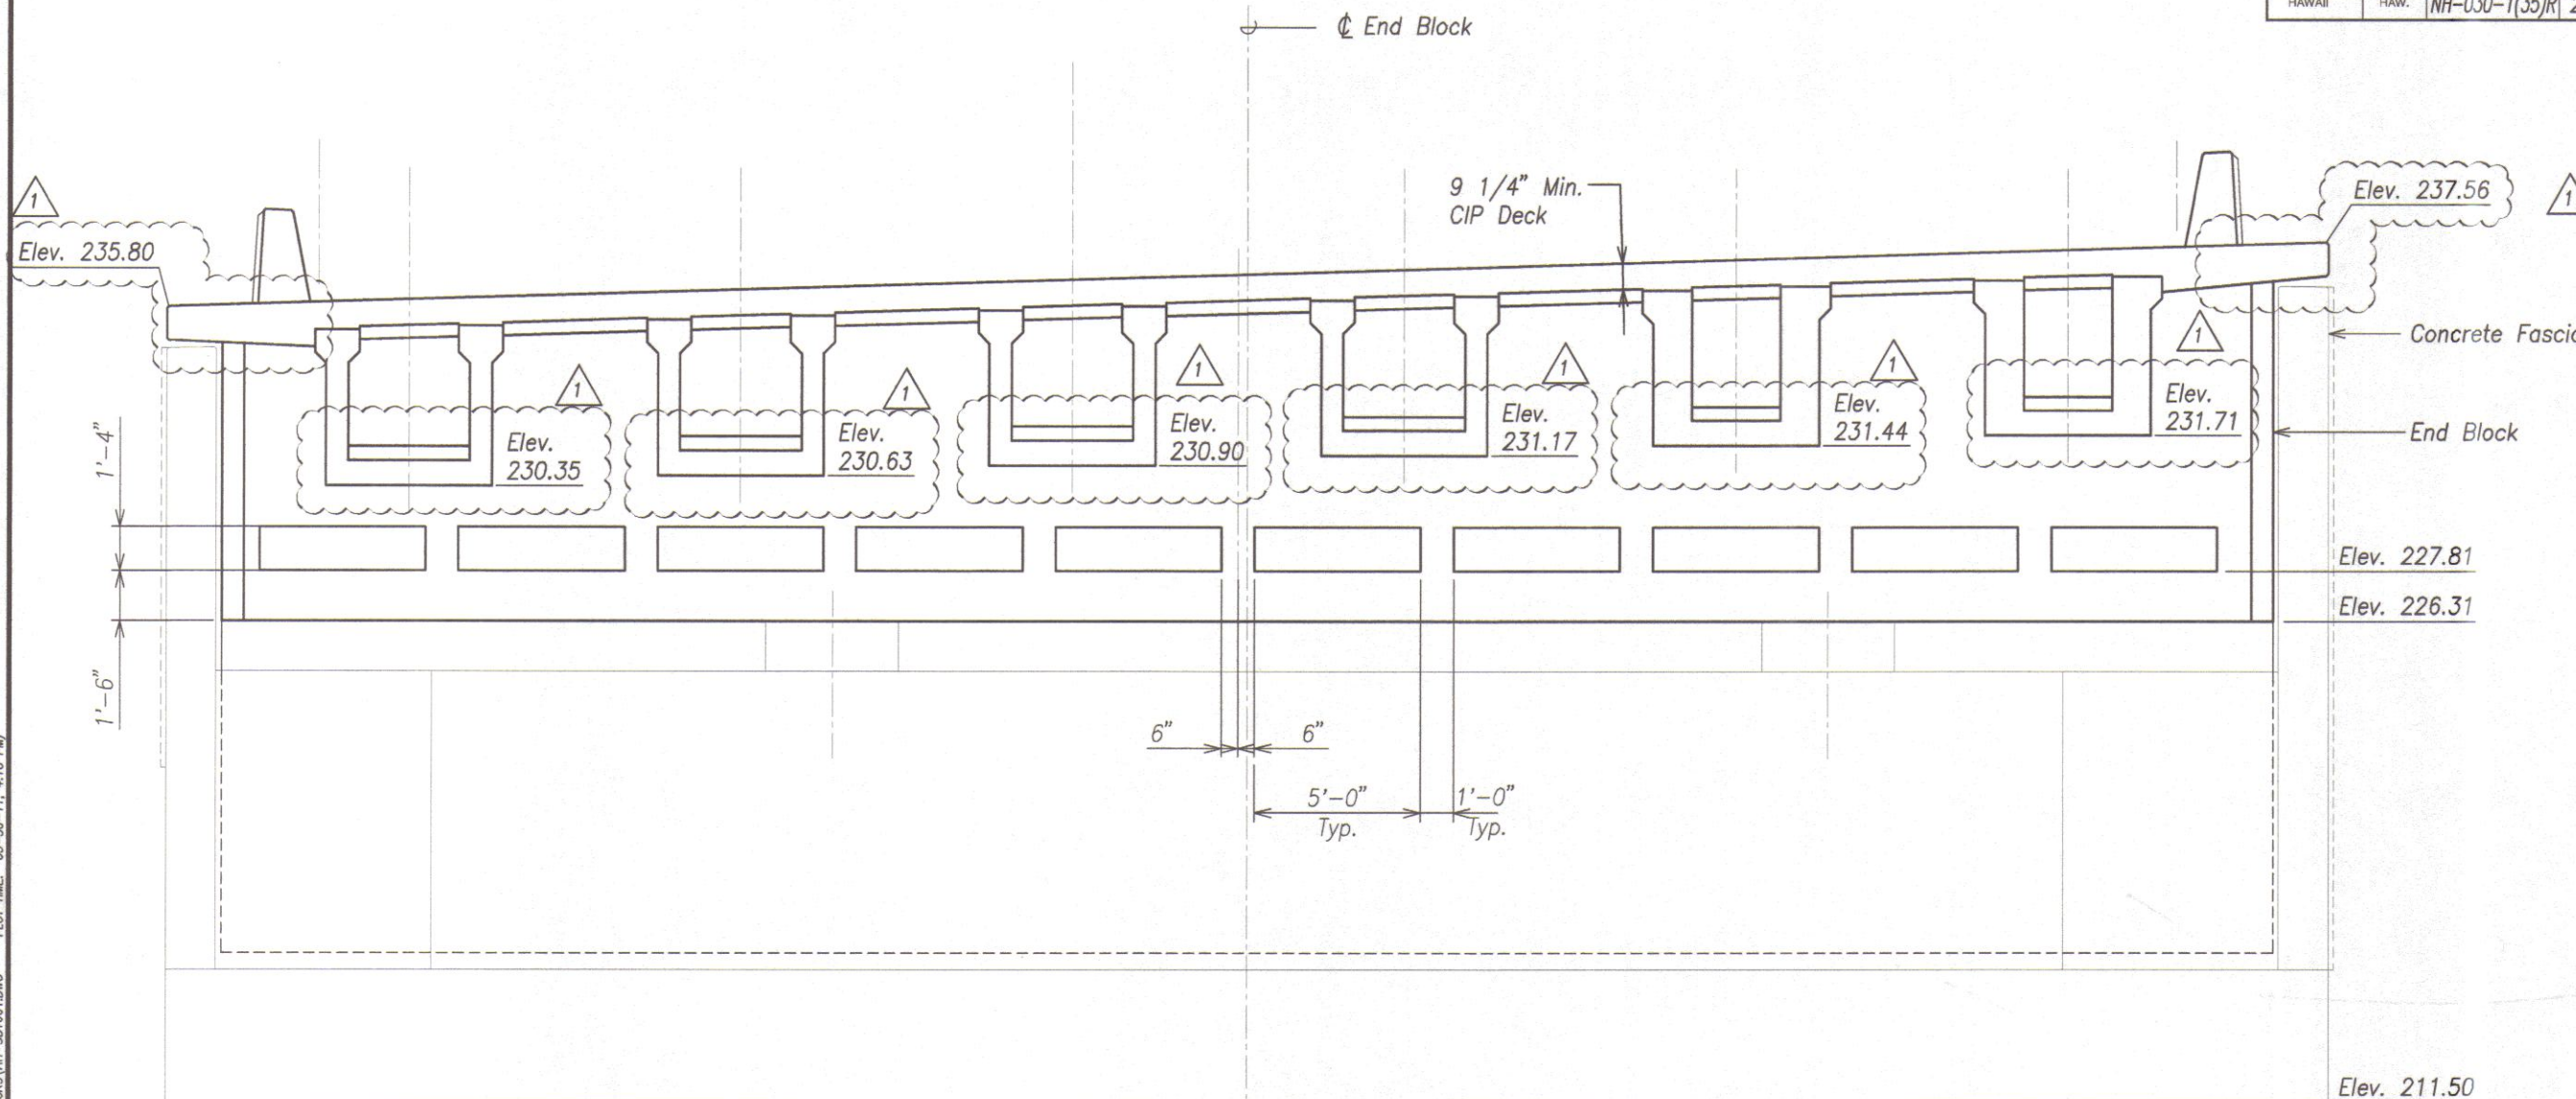

NOTES:

1. View shown is perpendicular to Girders and Precast Arch Tie Planks.
2. See Sheets SB11.10 and SB11.11 for similar reinforcing.

END BLOCK AT ABUTMENT 1 - FRONT ELEVATION
Scale: 3/8" = 1'-0"

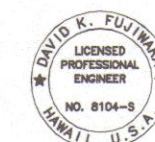

THIS WORK WAS PREPARED BY ME OR UNDER MY SUPERVISION.

KSF, INC. APRIL 30, 2012 LC. EXP. DATE

2/01/11 Revisions

DATE REVISION


STATE OF HAWAII
DEPARTMENT OF TRANSPORTATION
HIGHWAYS DIVISION
**END BLOCK AT ABUTMENT 1
FRONT ELEVATION**
HONOAIIANI HIGHWAY REALIGNMENT, PHASE 1A
Future Keawe St Extension to Lahainaluna Rd, Part B
Fed. Aid Proj. No. NH-030-1(35)R
Scale: As Noted Date: June, 2010
SHEET No. SB10.3 OF 10 SHEETS

FINAL DESIGN 337

DESIGNED BY	DATE
DRAWN BY	
CHECKED BY	
NOTED BY	
QUANTITIES BY	
NO.	

DRAWING NAME: Z:\00 ONCONG\40019.0-HONOAIIANI LAHANA BYPASS-KAHOMA WD\03-30-11 EM END BLOCKS\HH-SB1001.DWG PLOT TIME: 03-30-11, 4:16 PM

FED. ROAD DIST. NO.	STATE	FED. AID PROJ. NO.	FISCAL YEAR	SHEET NO.	TOTAL SHEETS
HAWAII	HAW.	NH-030-1(35)R	2009	337	383

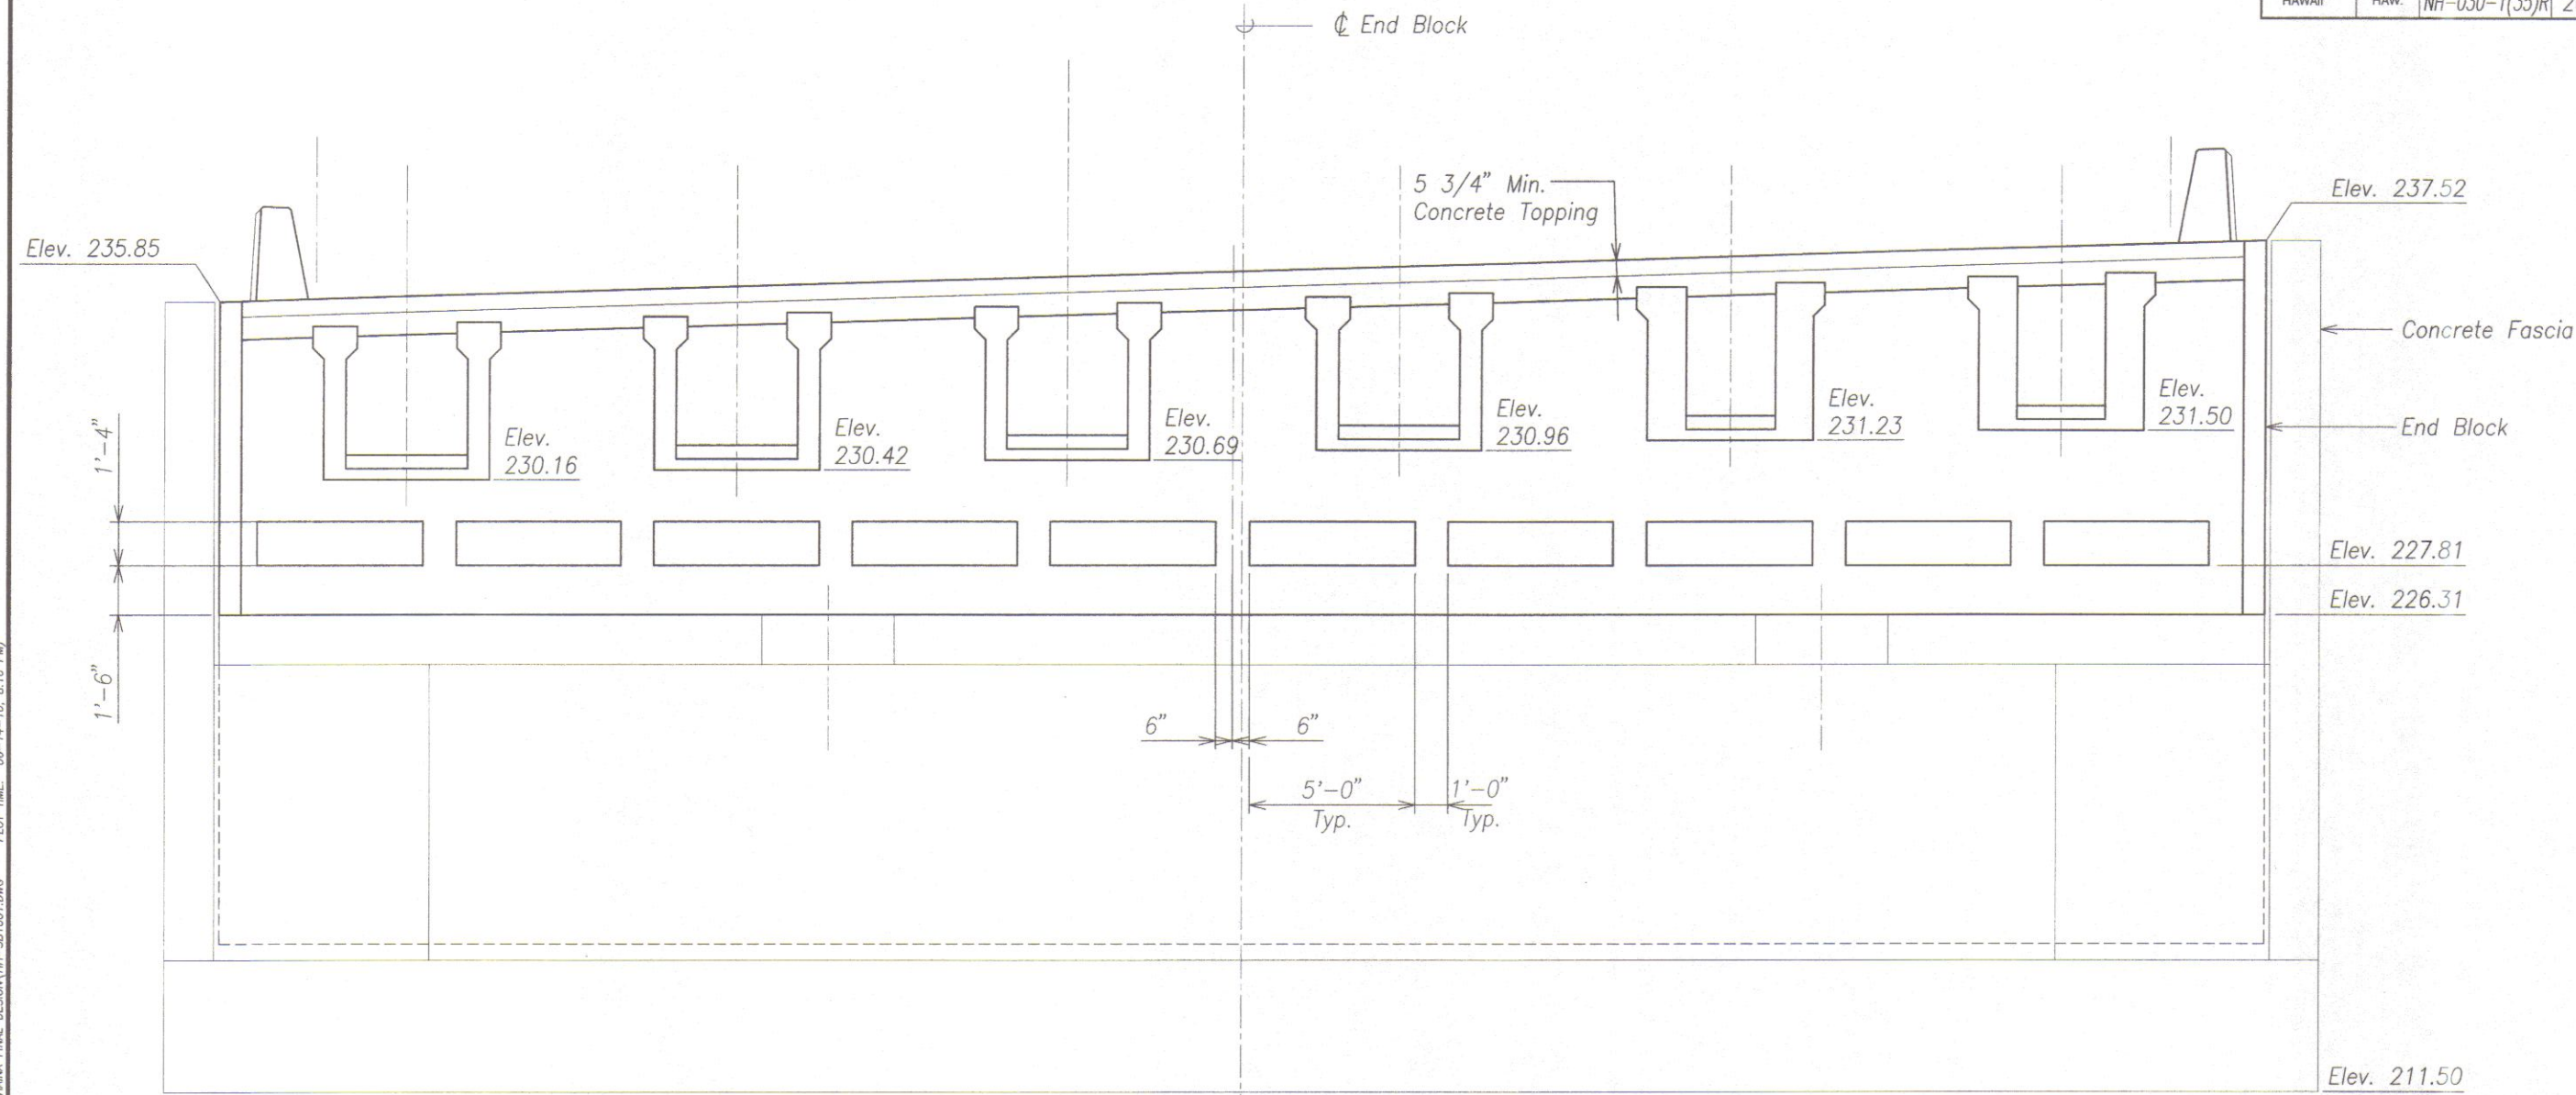

NOTES:

1. View shown is perpendicular to Girders and Precast Arch Tie Planks.
2. See Sheets SB11.10 and SB11.11 for similar reinforcing.

END BLOCK AT ABUTMENT 1 - FRONT ELEVATION
 Scale: 3/8" = 1'-0"
 SB10.1 | SB10.3




THIS WORK WAS PREPARED BY ME OR UNDER MY SUPERVISION.
David K. Fujiwara
 KSF, INC. APRIL 30, 2012 LIC. EXP. DATE

STATE OF HAWAII
 DEPARTMENT OF TRANSPORTATION
 HIGHWAYS DIVISION
END BLOCK AT ABUTMENT 1
FRONT ELEVATION
 HONOAPIILANI HIGHWAY REALIGNMENT, PHASE 1A
 Future Keawe St Extension to Lahainaluna Rd, Part B
 Fed. Aid Proj. No. NH-030-1(35)R
 Scale: As Noted Date: June, 2010
 SHEET No. SB10.3 OF 10 SHEETS

ORIGINAL PLAN	SURVEY PLOTTED BY	DATE
NOTE BOOK	DRAWN BY	
No.	DESIGNED BY	
	QUANTITIES BY	
	CHECKED BY	

DRAWING NAME: Z:\00 ONGOING\40019.0-HONOAPIILANI LAHAINA BYPASS-KAHOMA WO\06-15-10 COMBINE LAHAINA FINAL DESIGN\H-SB1001.DWG PLOT TIME: 06-14-10, 8:16 PM

FED. ROAD DIST. NO.	STATE	FED. AID PROJ. NO.	FISCAL YEAR	SHEET NO.	TOTAL SHEETS
HAWAII	HAW.	NH-030-1(35)R	2009	338	383

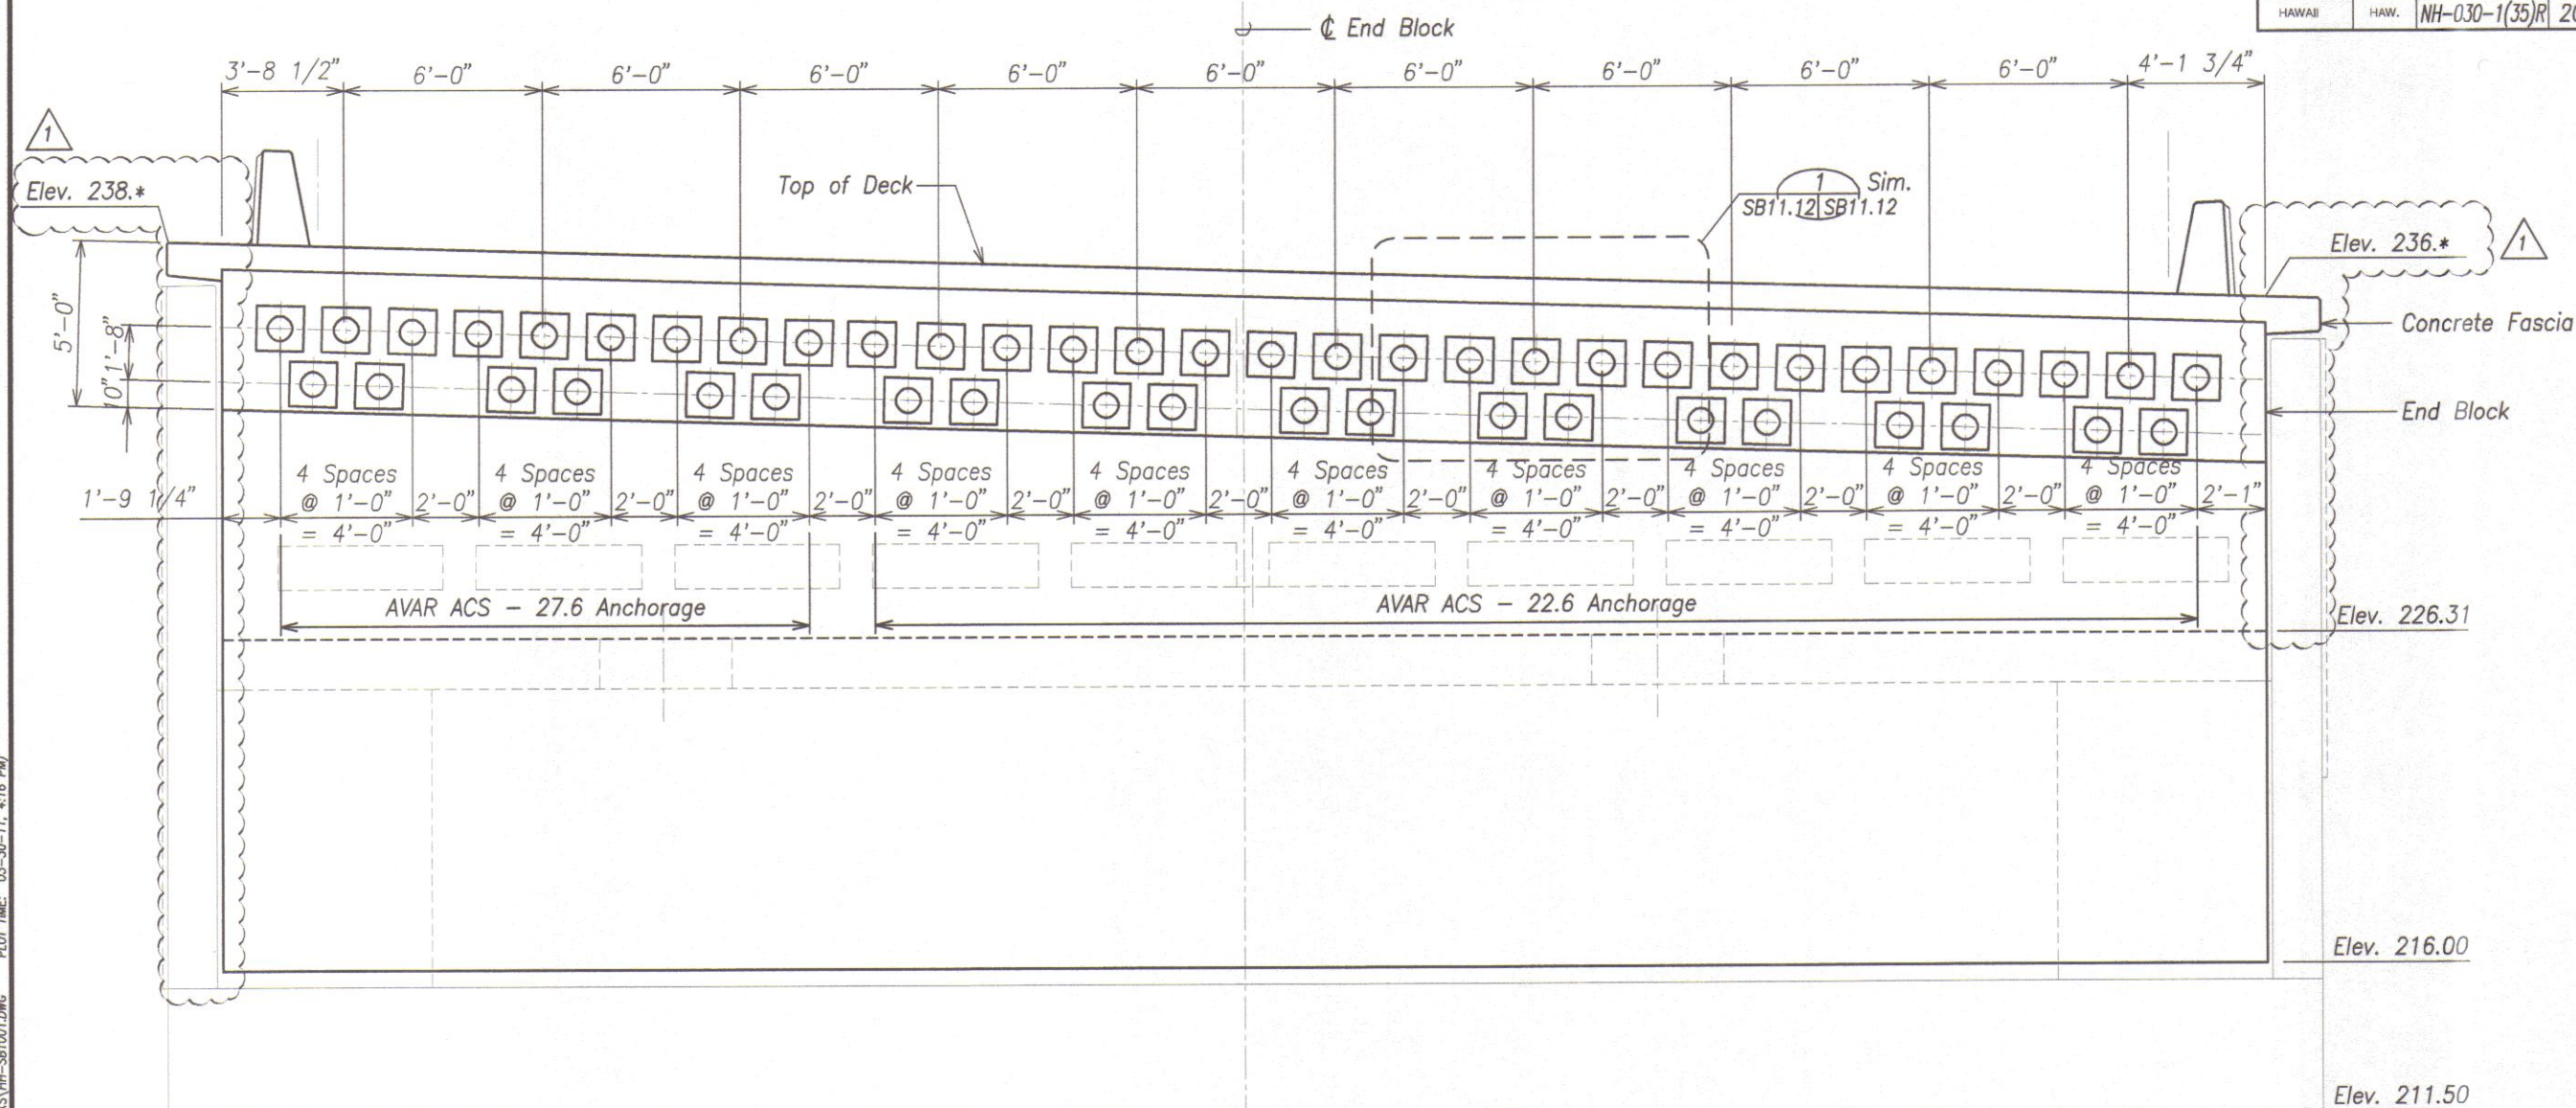

END BLOCK AT ABUTMENT 1 - BACK ELEVATION
 Scale: 3/8" = 1'-0"



THIS WORK WAS PREPARED BY ME
 OR UNDER MY SUPERVISION.

KSF, INC. APRIL 30, 2012
 LIC. EXP. DATE

STATE OF HAWAII
DEPARTMENT OF TRANSPORTATION
HIGHWAYS DIVISION

END BLOCK AT ABUTMENT 1
BACK ELEVATION
HONOAPIILANI HIGHWAY REALIGNMENT, PHASE 1A
Future Keawe St Extension to Lahainaluna Rd, Part B
Fed. Aid Proj. No. NH-030-1(35)R


Scale: As Noted
Date: June, 2010

SHEET No. SB10.4 OF 10 SHEETS

2/01/11 1 Revisions

DATE REVISION

FED. ROAD DIST. NO.	STATE	FED. AID PROJ. NO.	FISCAL YEAR	SHEET NO.	TOTAL SHEETS
HAWAII	HAW.	NH-030-1(35)R	2009	338	383

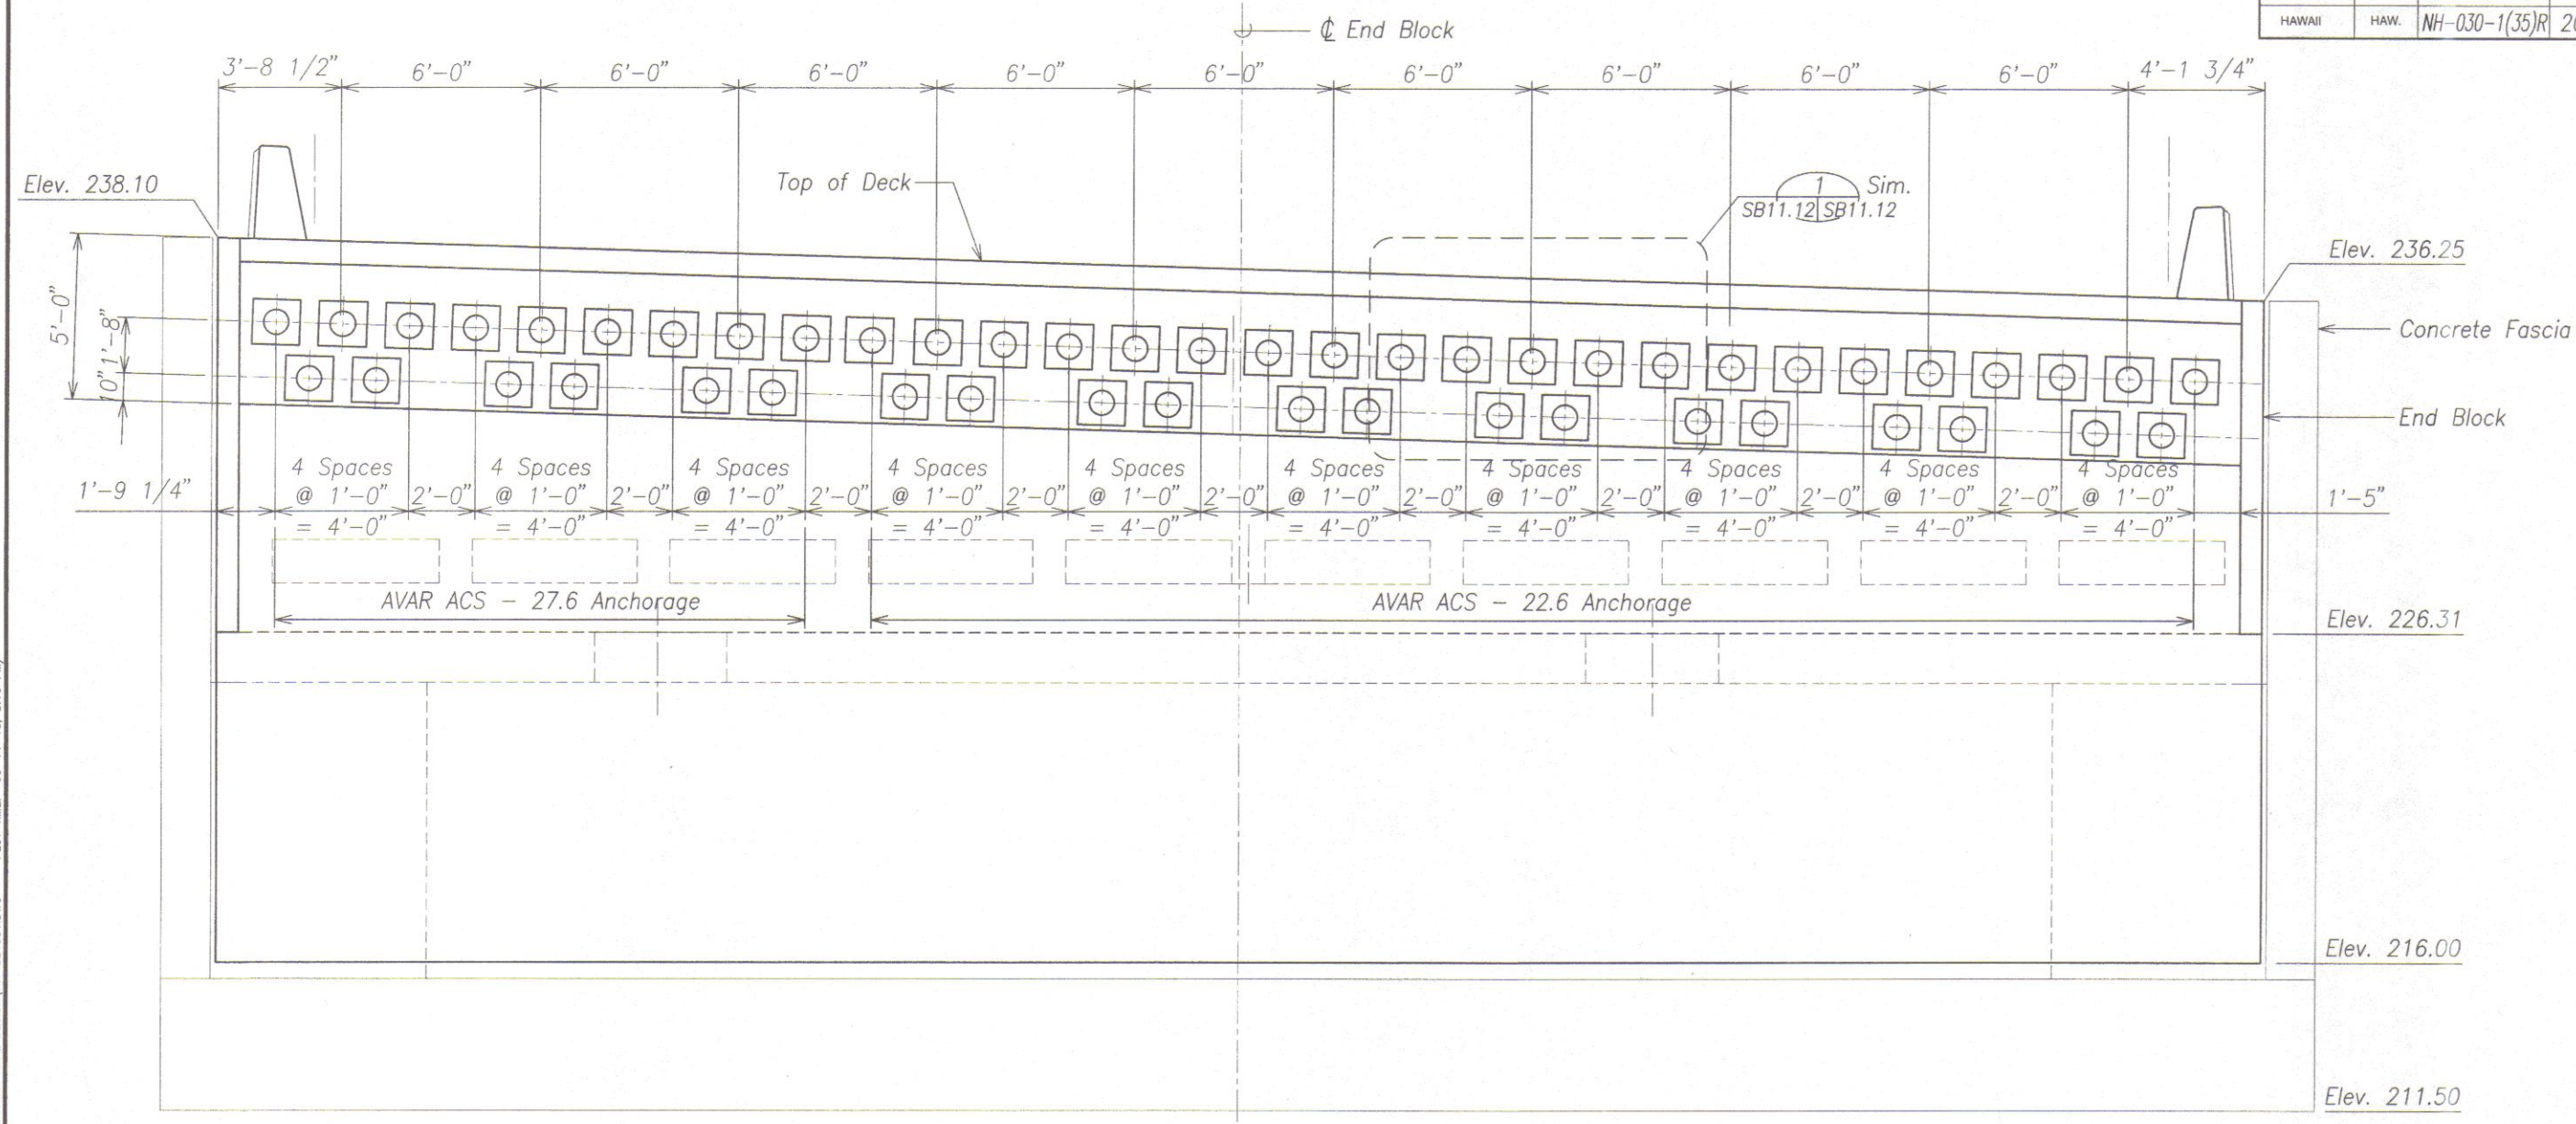

END BLOCK AT ABUTMENT 1 - BACK ELEVATION
 Scale: 3/8" = 1'-0"
 SB10.2 SB10.1 SB10.4



THIS WORK WAS PREPARED BY ME
 OR UNDER MY SUPERVISION.
David K. Fujiwara
 KSF, INC. APRIL 30, 2012
 LIC. EXP. DATE

STATE OF HAWAII
 DEPARTMENT OF TRANSPORTATION
 HIGHWAYS DIVISION
END BLOCK AT ABUTMENT 1
BACK ELEVATION
 HONOAPIILANI HIGHWAY REALIGNMENT, PHASE 1A
 Future Keawe St Extension to Lahainaluna Rd, Part B
 Fed. Aid Proj. No. NH-030-1(35)R
 Scale: As Noted Date: June, 2010
 SHEET No. SB10.4 OF 10 SHEETS


SURVEY DOTTED BY	DATE
DRAWN BY	
TRACED BY	
DESIGNED BY	
QUANTITIES BY	
CHECKED BY	
ORIGINAL PLAN	
NOTE BOOK	
No.	

DRAWING NAME: Z:\100 ONGOING\40019.0-HONOAPIILANI LAHAINA BYPASS-KAHOMA WO\08-15-10 COMBINE LAHAINA FINAL DESIGN\HH-SB1001.DWG PLOT TIME: 08-14-10, 8:16 PM

NOTES:

1. Rmin = 22' For 19-0.6" Strand Tendons
24' For 22-0.6" Strand Tendons
27' For 27-0.6" Strand Tendons
2. See Sheet SB10.2 for #5 (HRC555) spacing @ Bearing.
3. See Sheet SB10.10A for #5 HRC555 splice.

FED. ROAD DIST. NO.	STATE	FED. AID PROJ. NO.	FISCAL YEAR	SHEET NO.	TOTAL SHEETS
HAWAII	HAW.	NH-030-1(35)R	2009	339	383

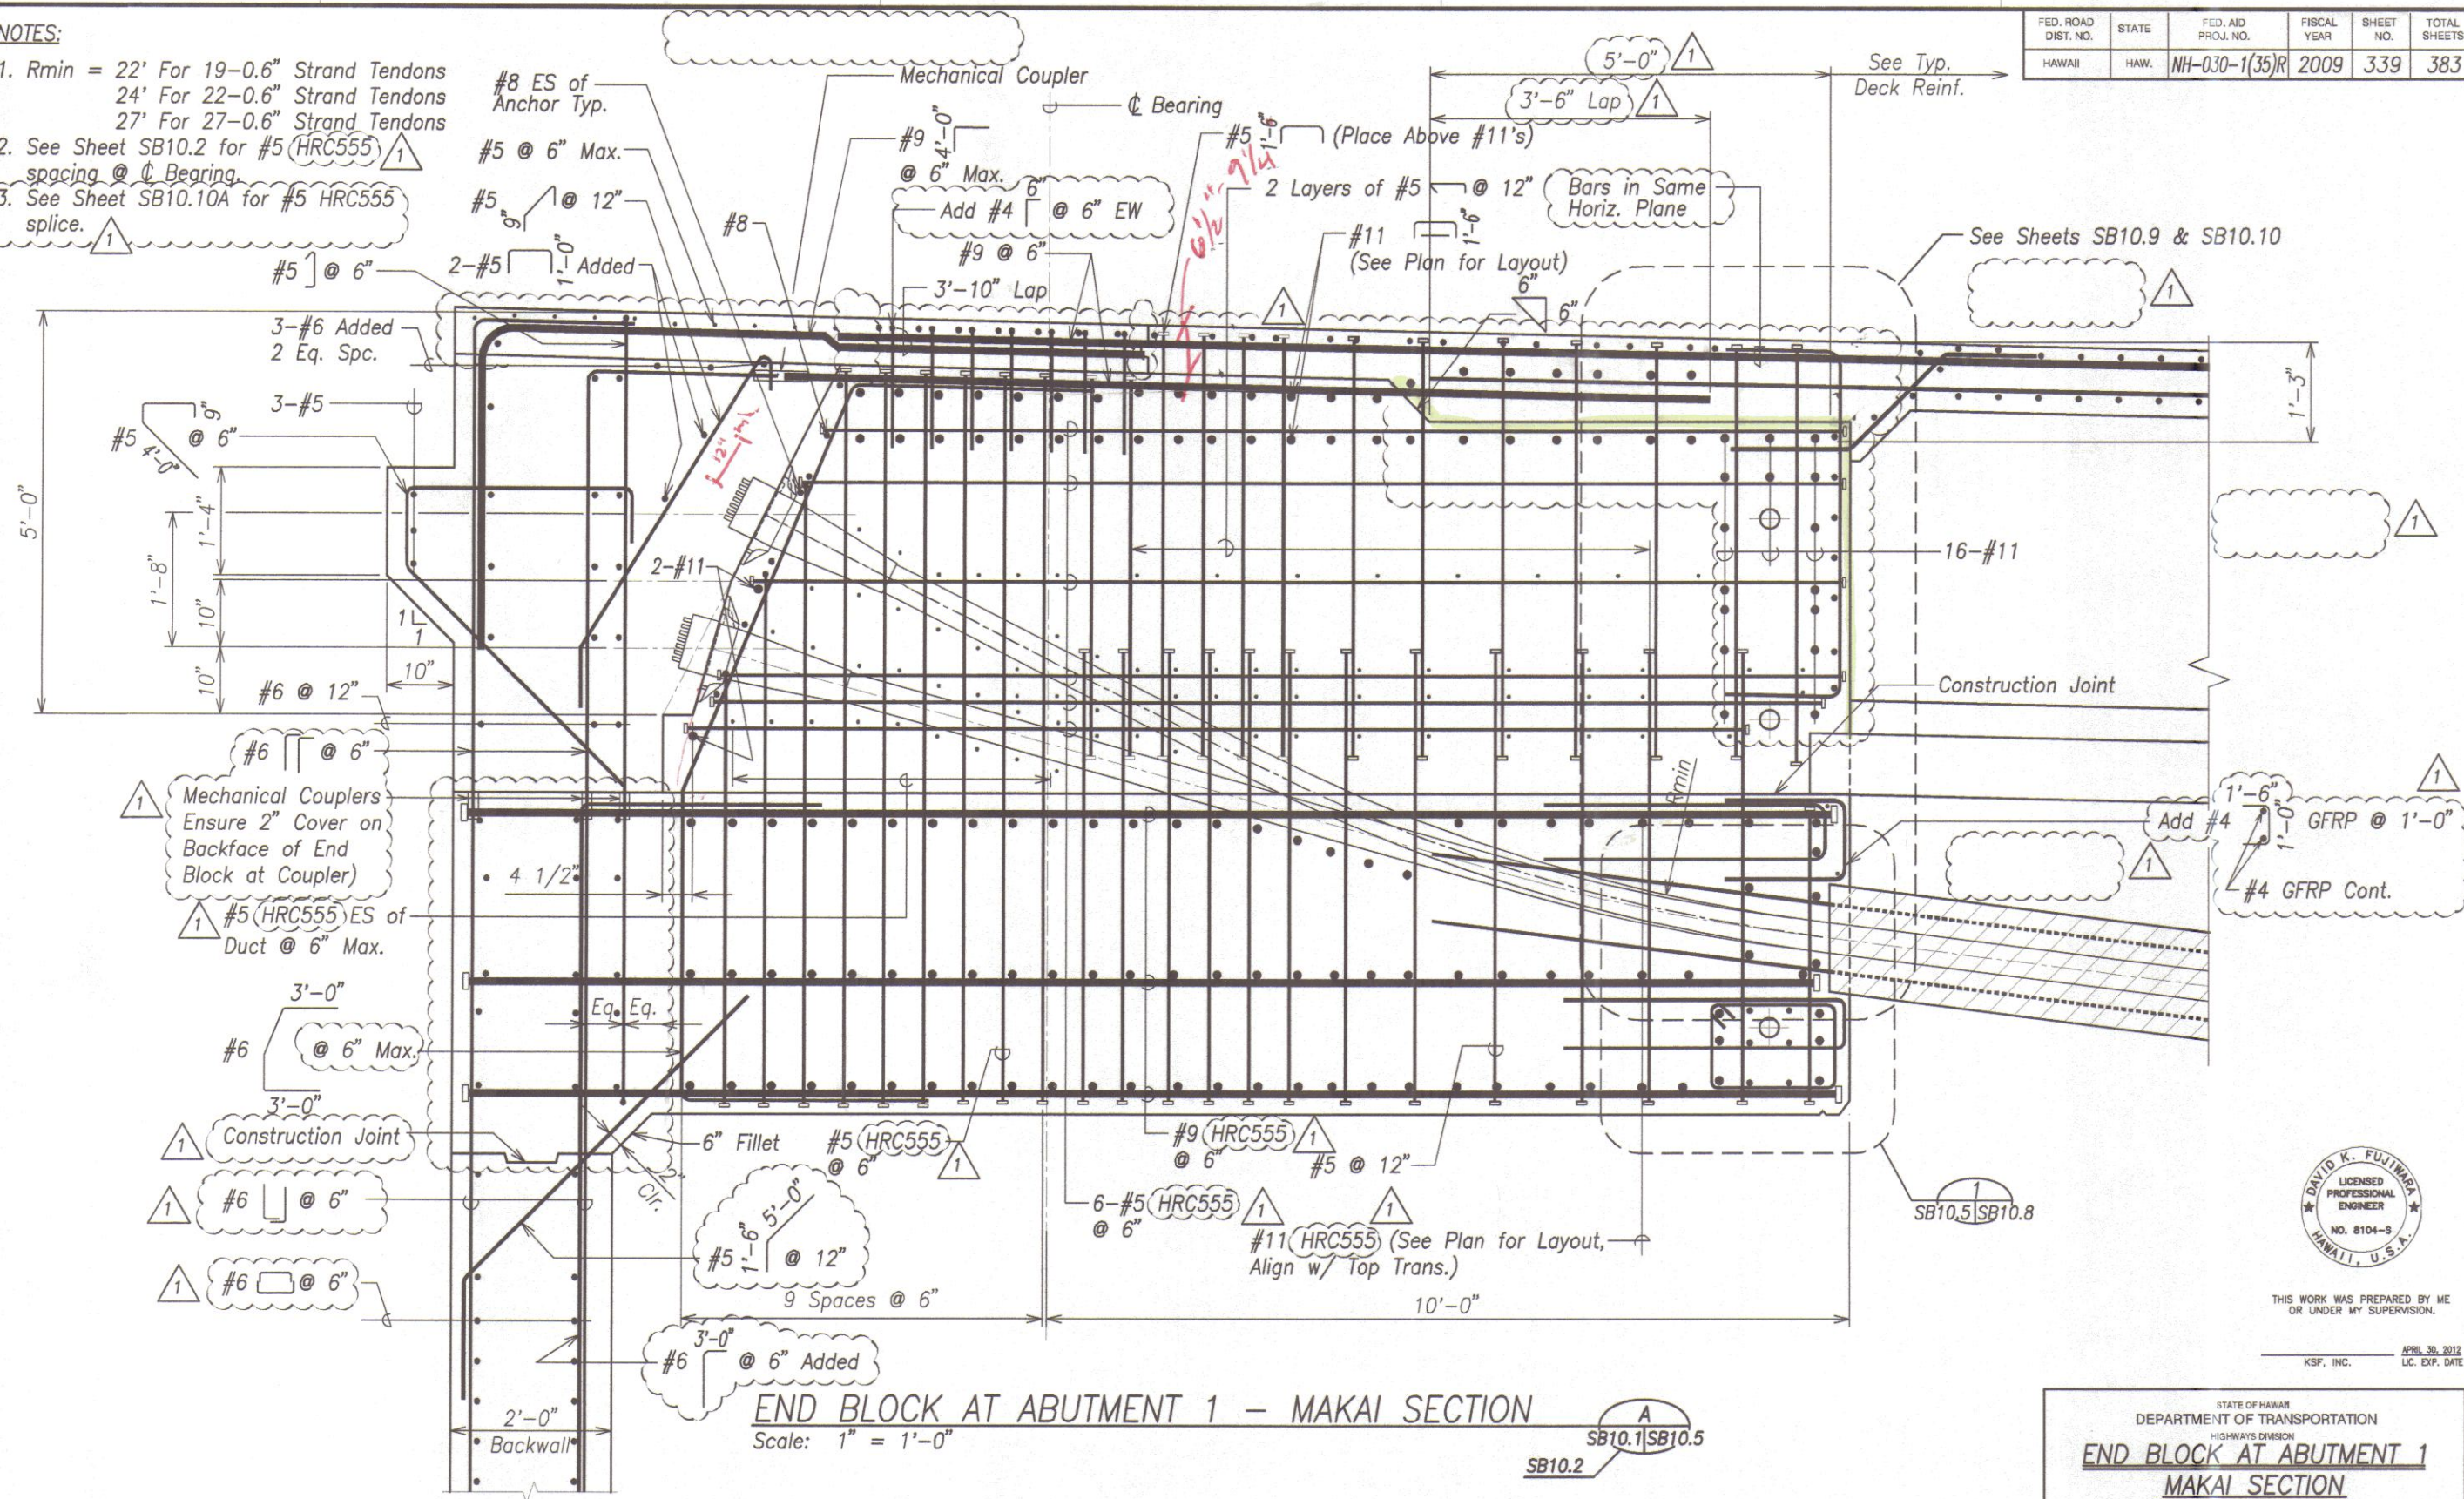

THIS WORK WAS PREPARED BY ME OR UNDER MY SUPERVISION.

KSF, INC. APRIL 30, 2012 LIC. EXP. DATE

STATE OF HAWAII
DEPARTMENT OF TRANSPORTATION
HIGHWAYS DIVISION

**END BLOCK AT ABUTMENT 1
MAKAI SECTION**

HONOAIPILANI HIGHWAY REALIGNMENT, PHASE 1A
Future Keawe St Extension to Lahainaluna Rd, Part B
Fed. Aid Proj. No. NH-030-1(35)R

Scale: As Noted Date: June, 2010

SHEET No. SB10.5 OF 10 SHEETS


2/01/11 1 Revisions

DATE	REVISION
------	----------

NOTES:

1. $R_{min} = 22'$ For 19-0.6" Strand Tendons
24' For 22-0.6" Strand Tendons
27' For 27-0.6" Strand Tendons
2. See Sheet SB10.2 for #5 spacing @ Bearing.

FED. ROAD DIST. NO.	STATE	FED. AID PROJ. NO.	FISCAL YEAR	SHEET NO.	TOTAL SHEETS
HAWAII	HAW.	NH-030-1(35)R	2009	339	383

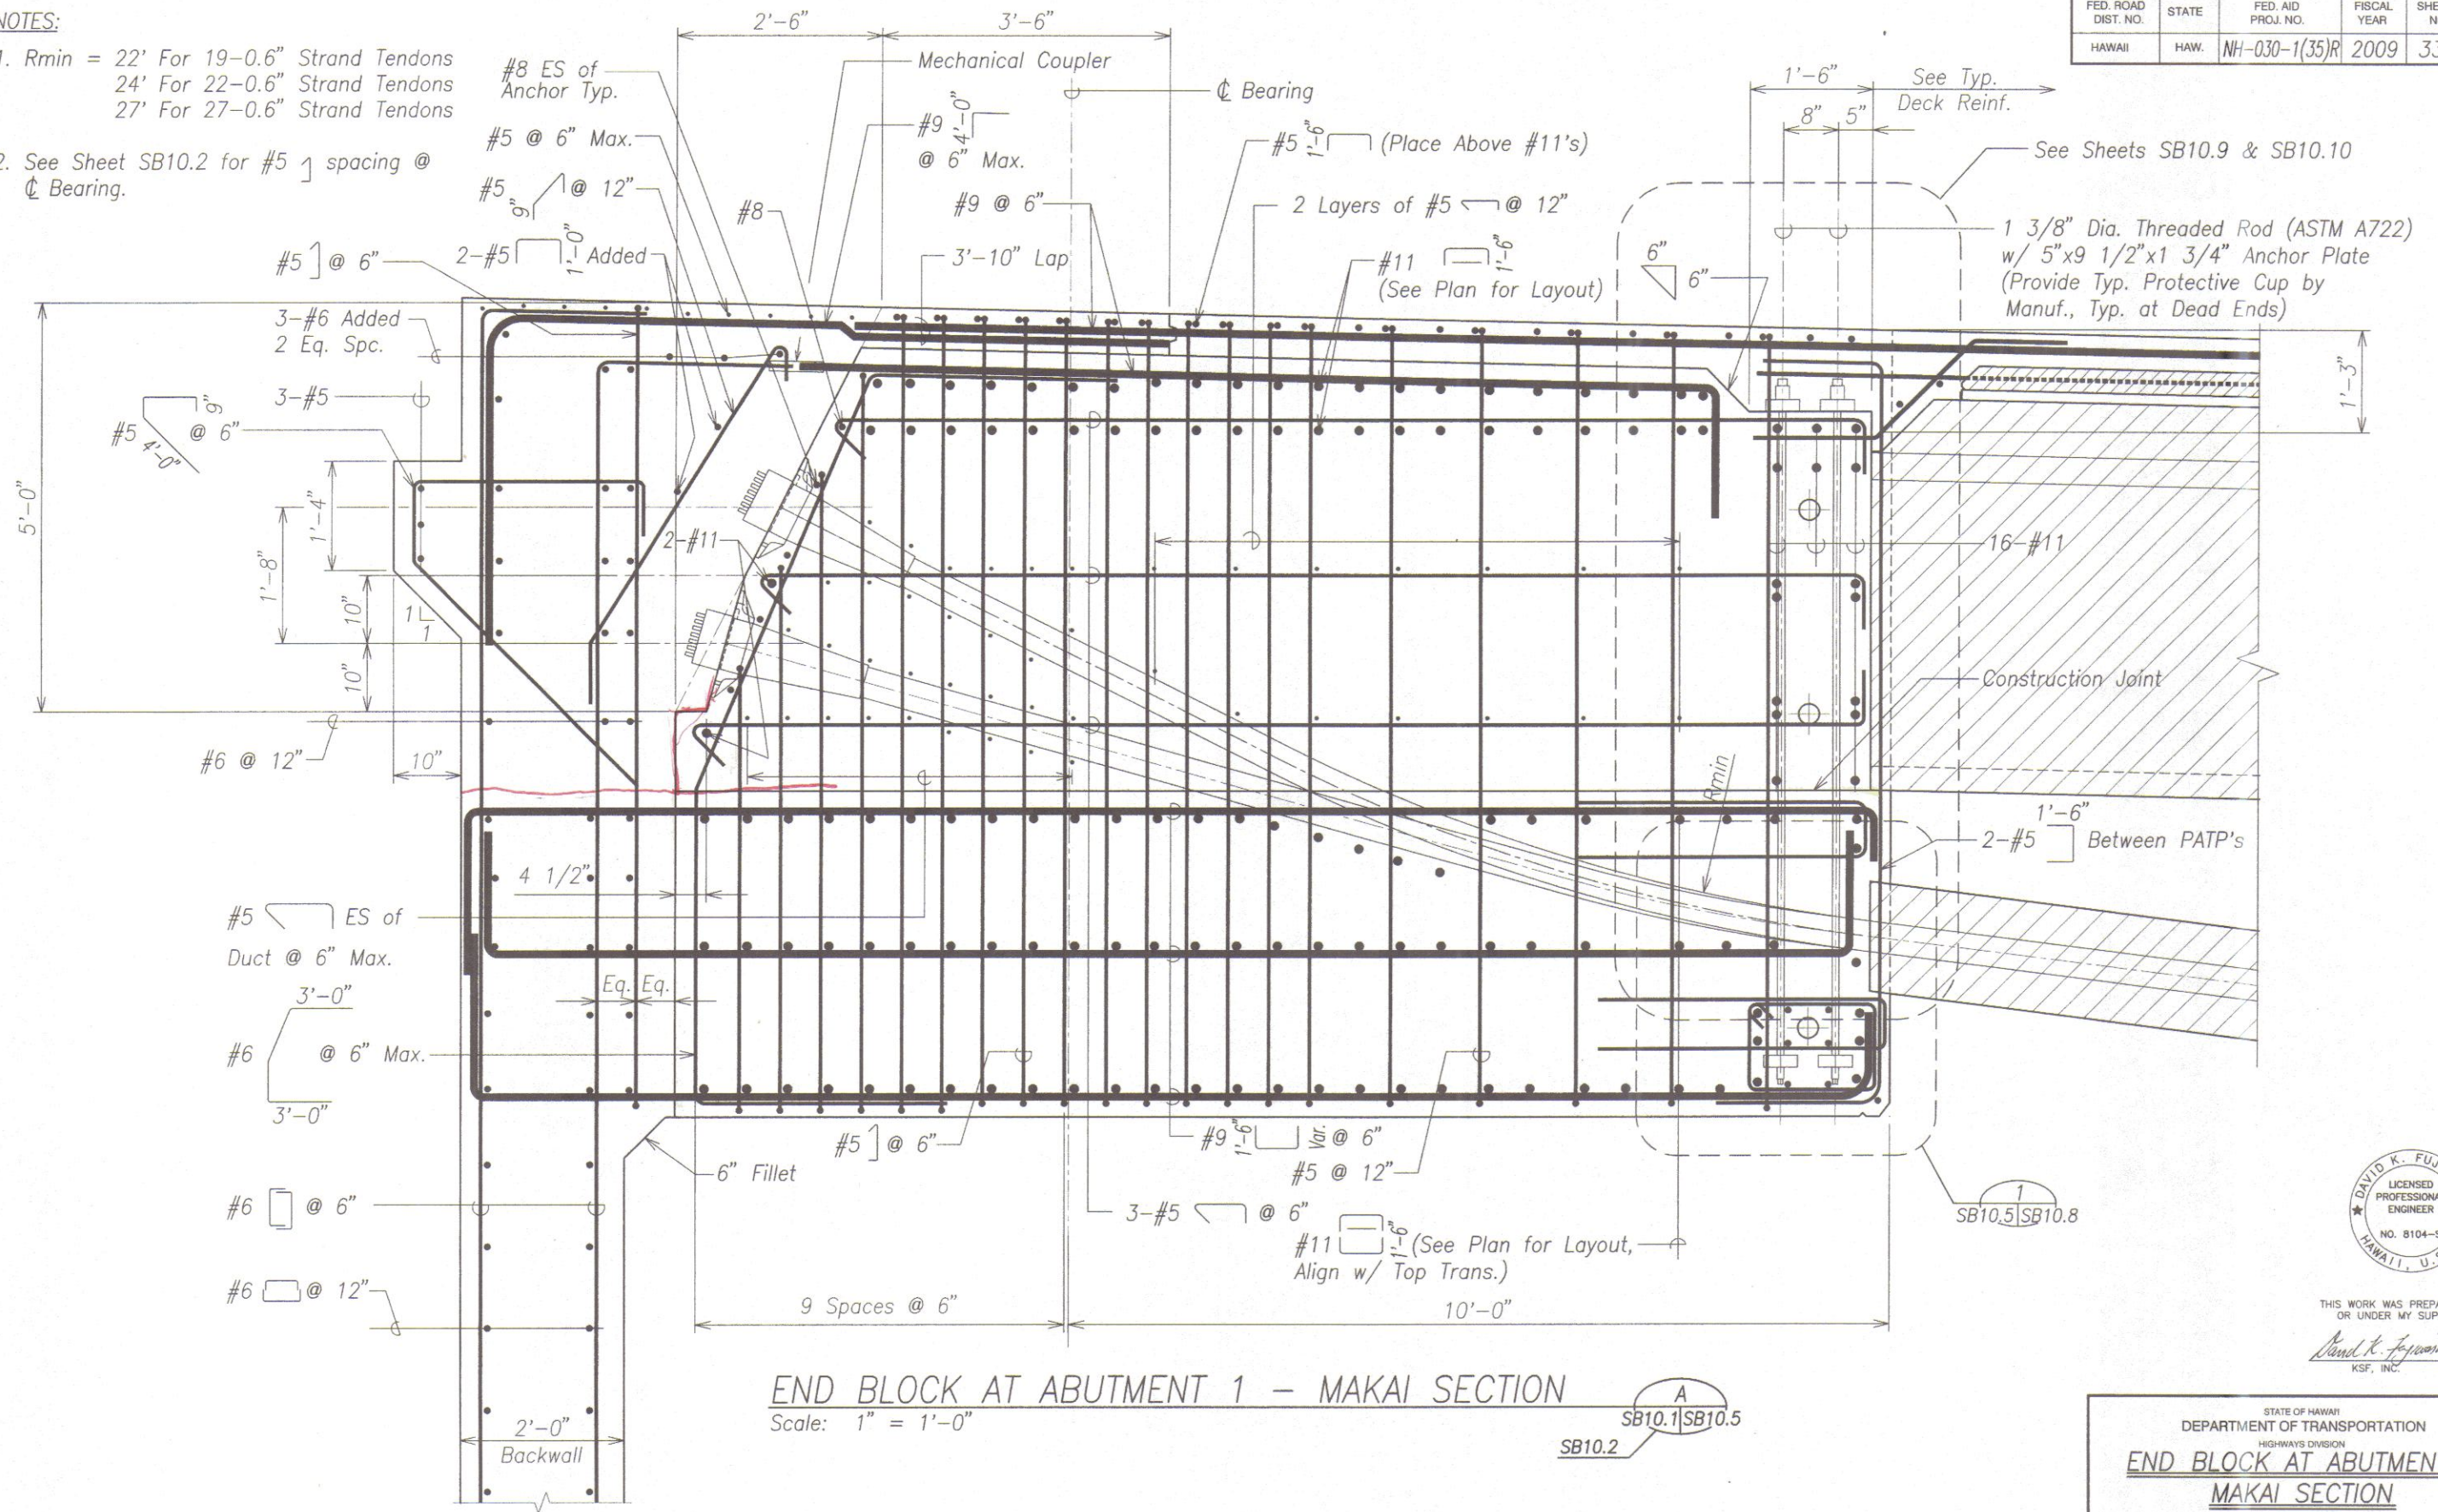

END BLOCK AT ABUTMENT 1 - MAKAI SECTION

Scale: 1" = 1'-0"

SB10.2
SB10.5
A



THIS WORK WAS PREPARED BY ME
OR UNDER MY SUPERVISION.
David K. Fujiwara
KSF, INC. APRIL 30, 2012
LIC. EXP. DATE


STATE OF HAWAII
DEPARTMENT OF TRANSPORTATION
HIGHWAYS DIVISION
END BLOCK AT ABUTMENT 1
MAKAI SECTION
HONOAPIILANI HIGHWAY REALIGNMENT, PHASE 1A
Future Keawe St Extension to Lahainaluna Rd, Part B
Fed. Aid Proj. No. NH-030-1(35)R
Scale: As Noted Date: June, 2010
SHEET No. SB10.5 OF 10 SHEETS

FINAL DESIGN 339

FED. ROAD DIST. NO.	STATE	FED. AID PROJ. NO.	FISCAL YEAR	SHEET NO.	TOTAL SHEETS
HAWAII	HAW.	NH-030-1(35)R	2009	-	383

Notes:

1. See sheet SB13.1 for additional reinforcing in corbel.
2. #6 ^{12"} as shown on SB13.1 shall be epoxy coated.
3. Top cover in approach slab shall be 2 1/2".

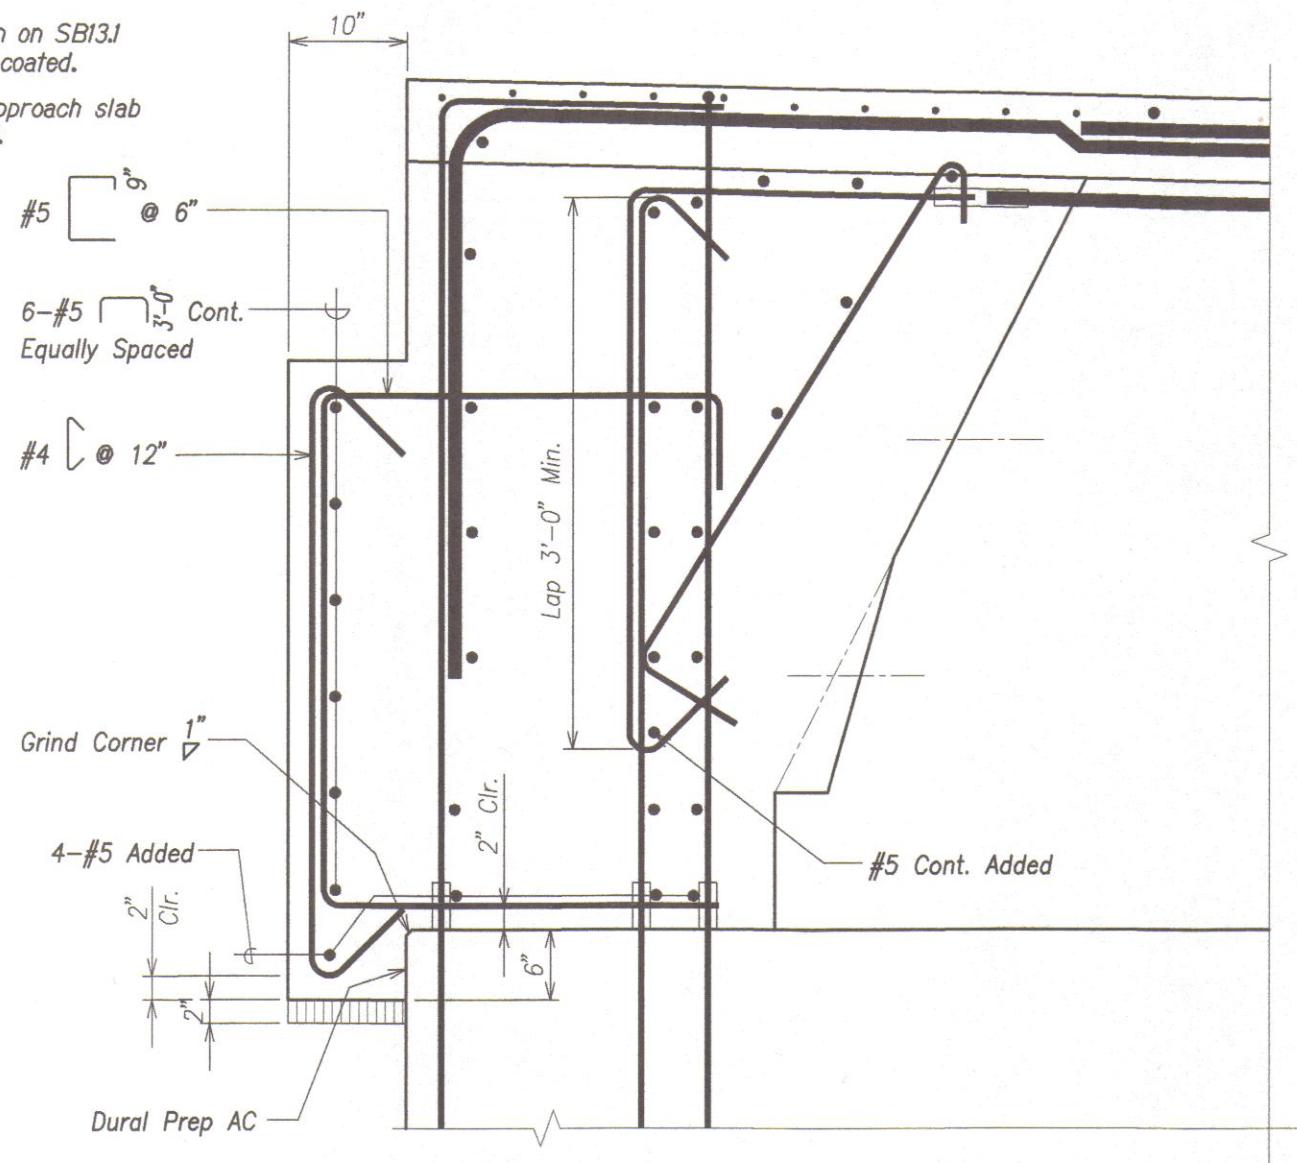

CORBEL REVISION AT ABUTMENT 1 (ABUTMENT 2 SIMILAR)
 Scale: 1 1/2" = 1'-0" A
SB10.5A/SB10.5A



THIS WORK WAS PREPARED BY ME
OR UNDER MY SUPERVISION.

KSF, INC. APRIL 30, 2012
LIC. EXP. DATE

ORIGINAL PLAN	DATE
NO. 1	
NO. 2	
NO. 3	
NO. 4	
NO. 5	
NO. 6	
NO. 7	
NO. 8	
NO. 9	
NO. 10	


DRAWING NAME: Z:\DO ONGOING\40019.0-HONOAPILANI LAHANA BTASS-KAHOMA - HDCC\10-01-12 REV ENDBLOCK\HH-SB1001.DWG PLOT TIME: 10-01-12, 11:36 AM

10/1/12	New sheet
DATE	REVISION

STATE OF HAWAII
DEPARTMENT OF TRANSPORTATION
HIGHWAYS DIVISION
CORBEL REVISION AT ABUTMENT 1
HONOAPILANI HIGHWAY REALIGNMENT, PHASE 1A
Future Keawe St Extension to Lahainaluna Rd, Part B
Fed. Aid Proj. No. NH-030-1(35)R
Scale: As Noted Date: August, 2010
SHEET No. SB10.5A OF 10 SHEETS

ADD FINAL DESIGN

FED. ROAD DIST. NO.	STATE	FED. AID PROJ. NO.	FISCAL YEAR	SHEET NO.	TOTAL SHEETS
HAWAII	HAW.	NH-030-1(35)R	2009	340	383

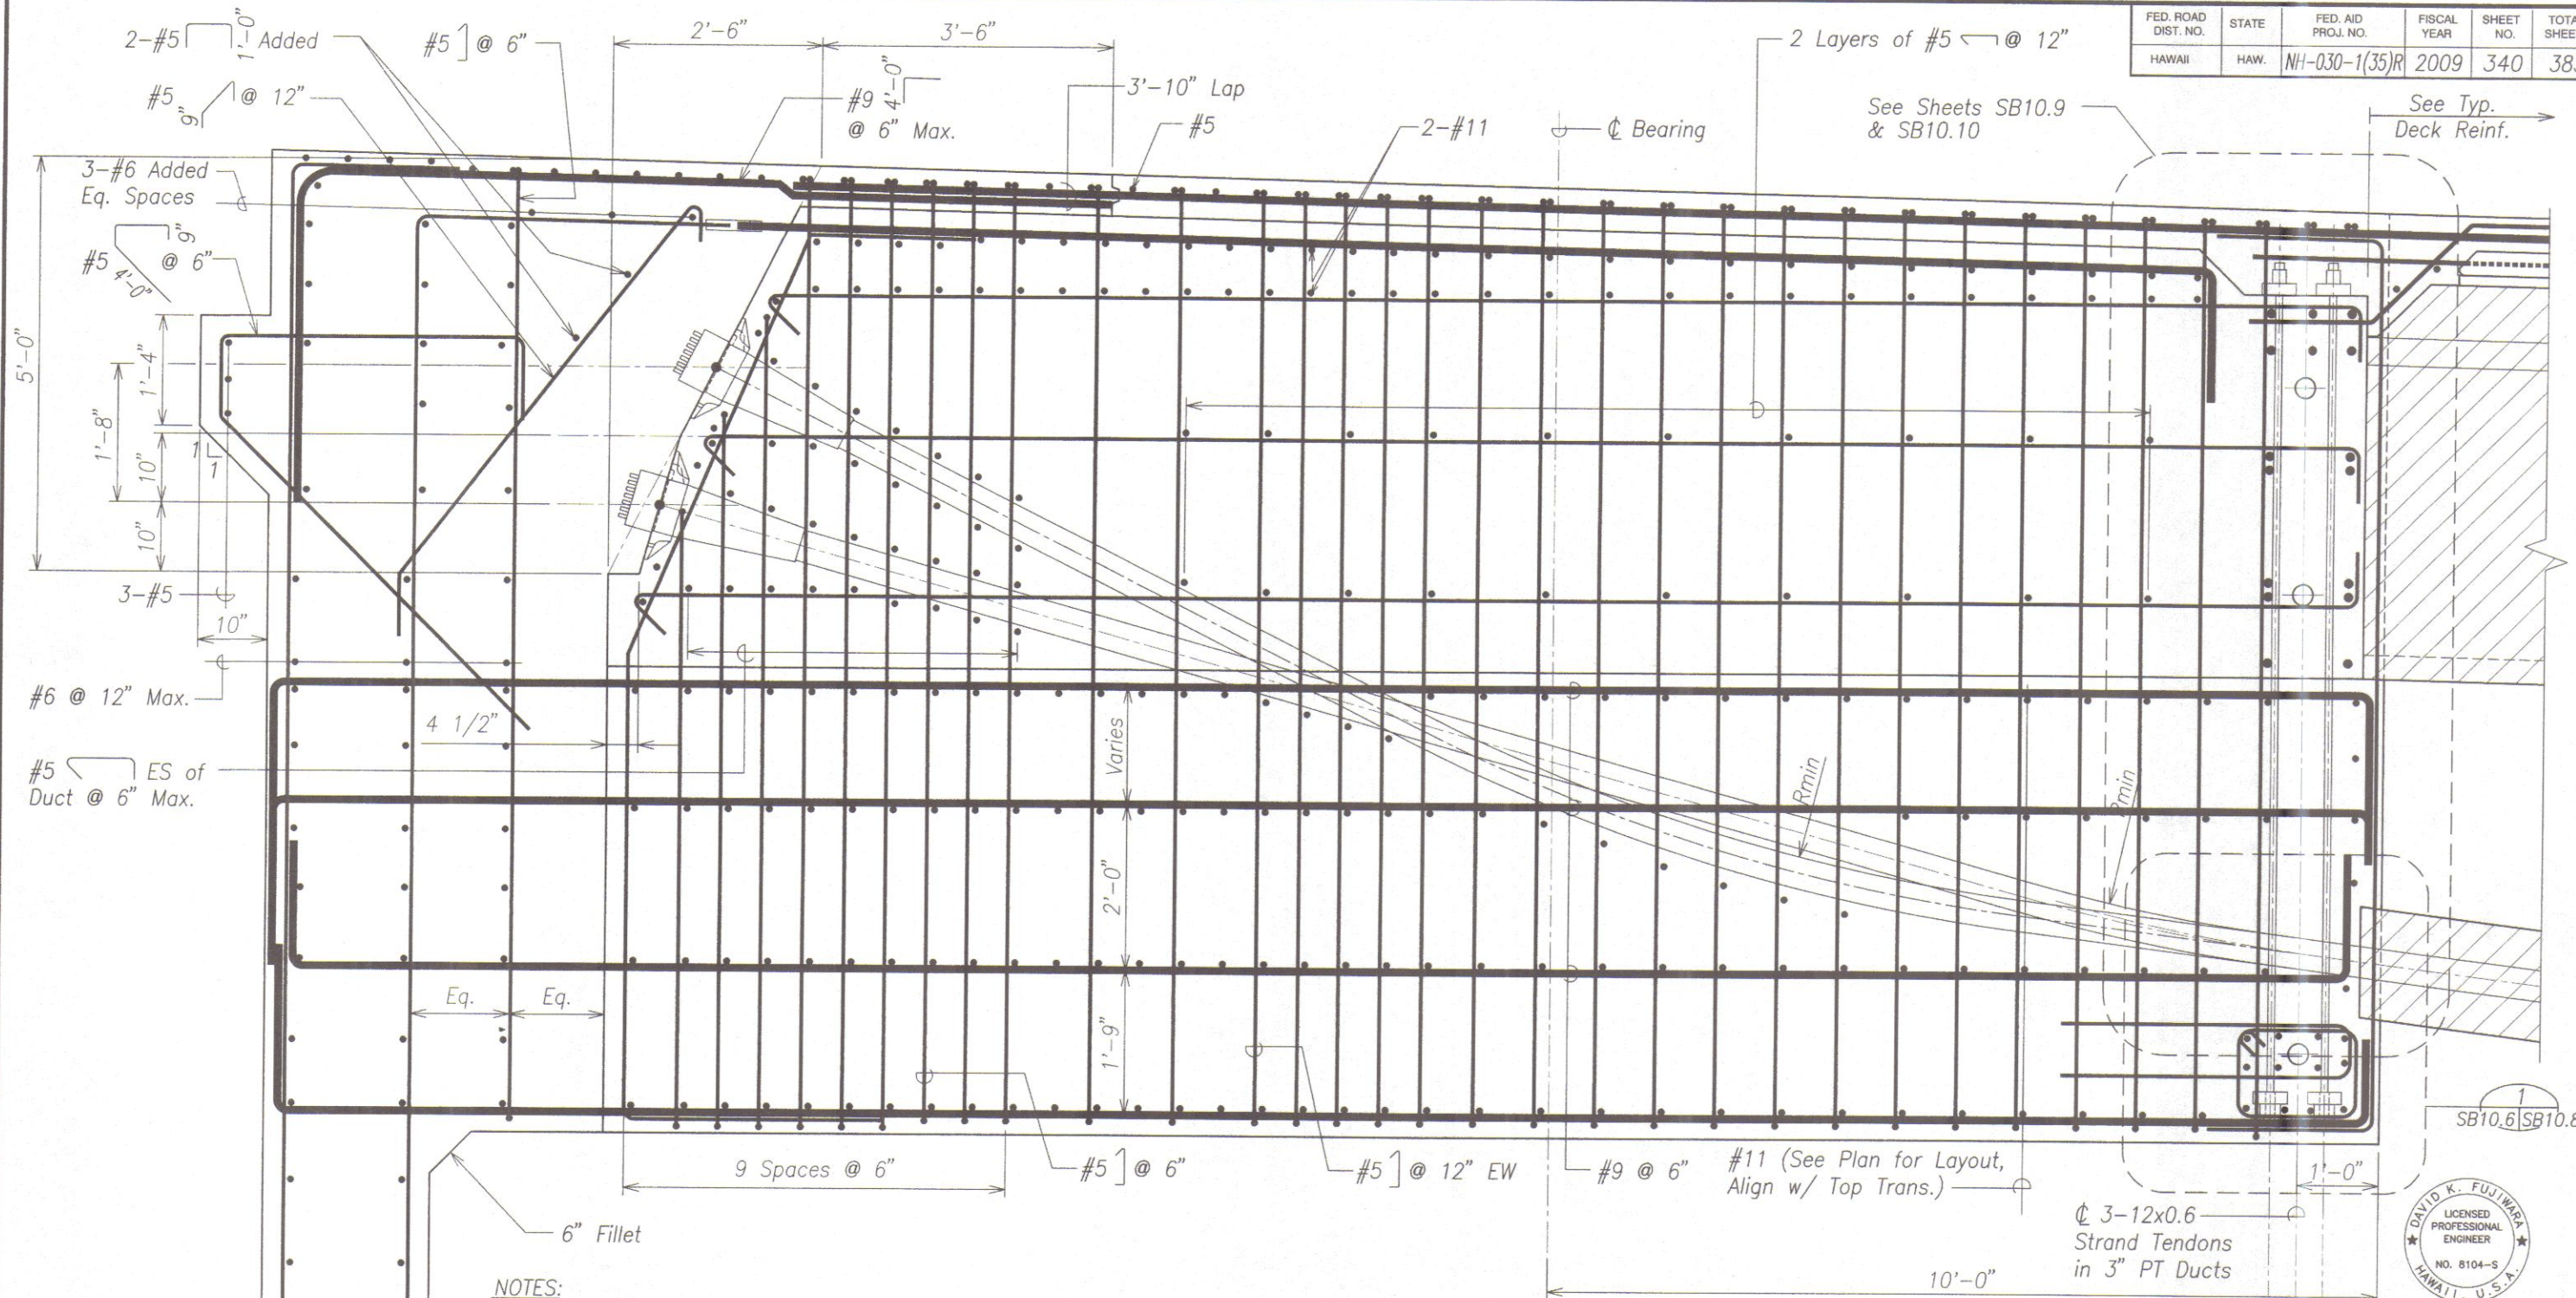

NOTES:

1. R_{min} = 22' For 19-0.6" Strand Tendons
24' For 22-0.6" Strand Tendons
27' For 27-0.6" Strand Tendons


2. See Sheet SB10.2 for #5 spacing @ Bearing.

3. See Sheet SB10.5 for additional information.

END BLOCK AT ABUTMENT 1 - MAUKA SECTION

Scale: 1" = 1'-0"

SB10.1A
SB10.6
SB10.1B

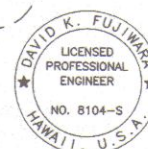



THIS WORK WAS PREPARED BY ME OR UNDER MY SUPERVISION.
David K. Fujiwara
KSF, INC. APRIL 30, 2012 LIC. EXP. DATE

STATE OF HAWAII
DEPARTMENT OF TRANSPORTATION
HIGHWAYS DIVISION
**END BLOCK AT ABUTMENT 1
MAUKA SECTION**
HONOAPIILANI HIGHWAY REALIGNMENT, PHASE 1A
Future Keawe St Extension to Lahainaluna Rd, Part B
Fed. Aid Proj. No. NH-030-1(35)R
Scale: As Noted Date: June, 2010
SHEET No. SB10.6 OF 10 SHEETS
FINAL DESIGN 340

ORIGINAL PLAN	SURVEY PLOTTED BY	DATE
NOTE BOOK	DRAWN BY	
	DESIGNED BY	
	QUANTITIES BY	
	CHECKED BY	

DRAWING NAME: Z:\00 ONGOING\40019.0-HONOAPIILANI LAHAINA BYPASS-KAHOMA WYO.06-15-10 COMBINE LAHAINA FINAL DESIGN\HH-SB1001.DWG PLOT TIME: 06-14-10, 8:16 PM

FED. ROAD DIST. NO.	STATE	FED. AID PROJ. NO.	FISCAL YEAR	SHEET NO.	TOTAL SHEETS
HAWAII	HAW.	NH-030-1(35)R	2009	341	383

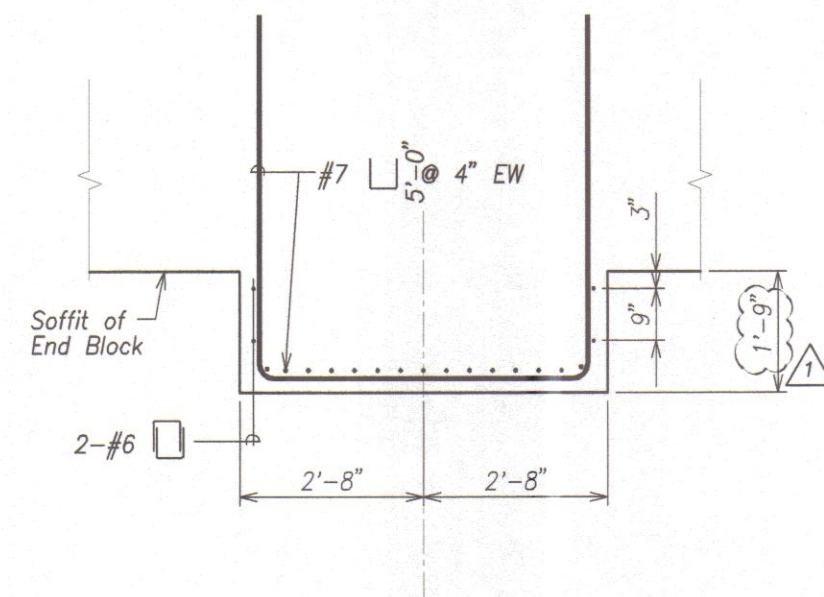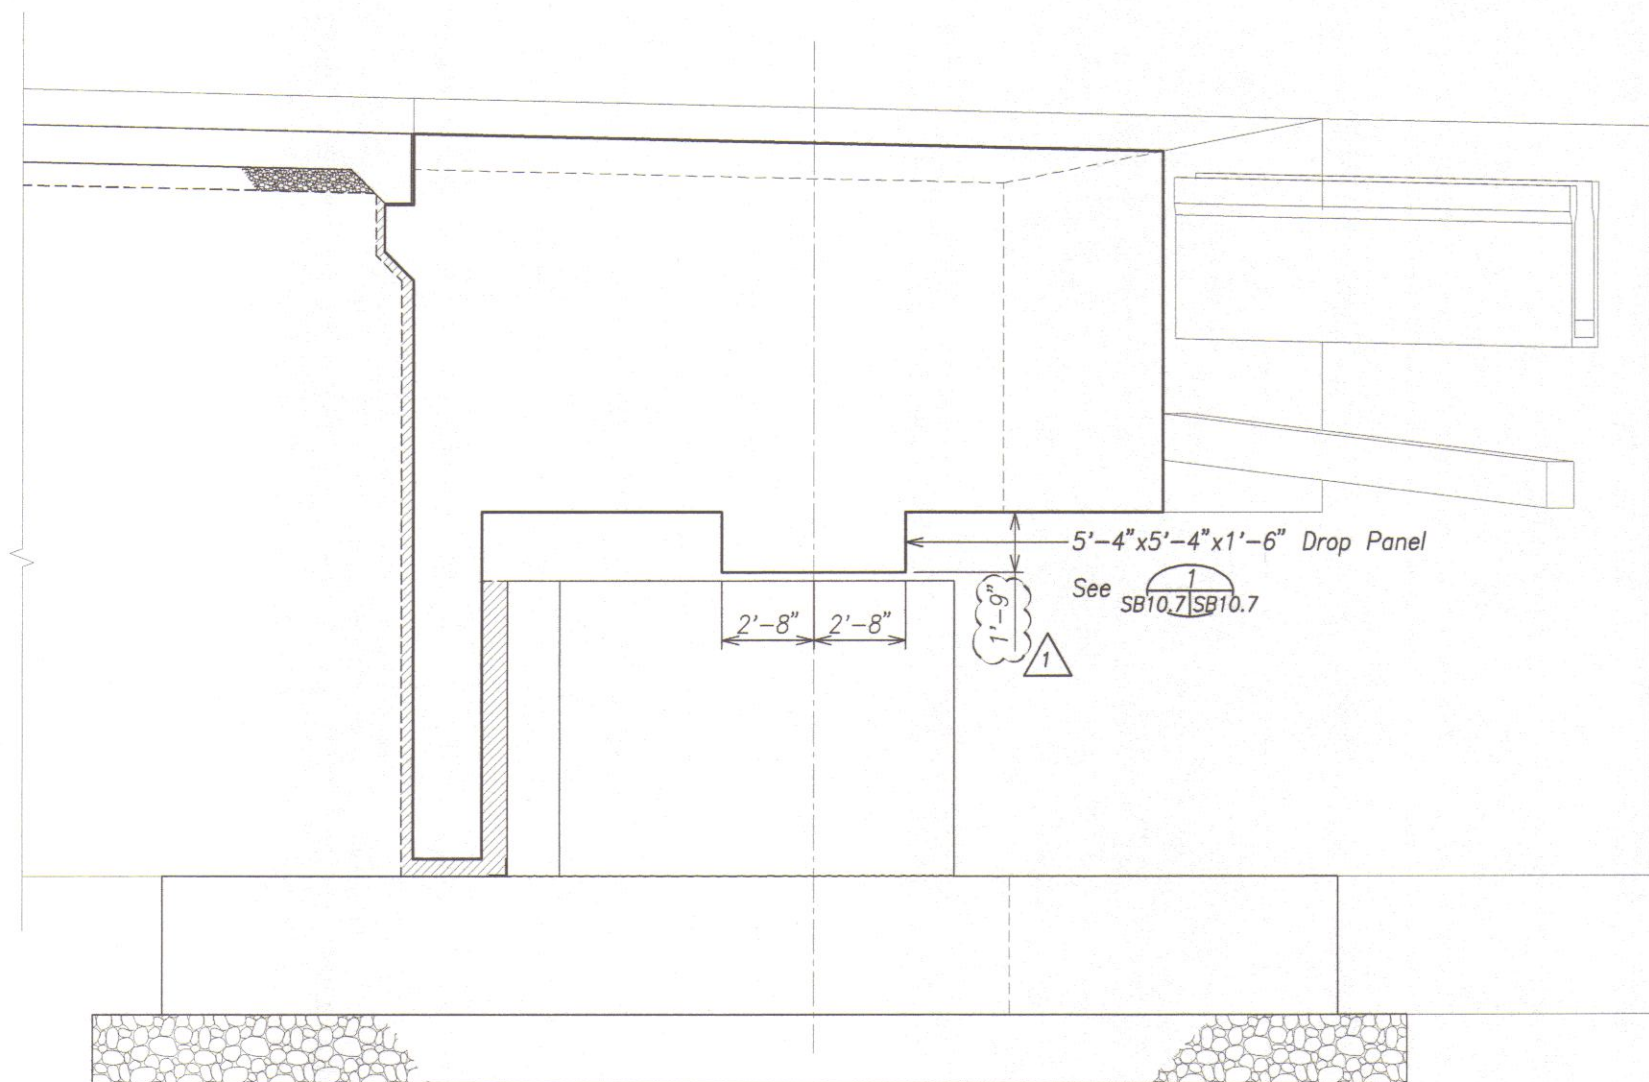

DROP PANEL
Scale: 3/4" = 1'-0" 1 SB10.7 | SB10.7

END BLOCK AT ABUTMENT 1 – SECTION AT DROP PANEL
Scale: 3/8" = 1'-0"

A
SB10.1 | SB10.7
SB10.2



THIS WORK WAS PREPARED BY ME
OR UNDER MY SUPERVISION.

KSF, INC. APRIL 30, 2012
LIC. EXP. DATE



2/01/11 1 Revisions

DATE REVISION

STATE OF HAWAII
DEPARTMENT OF TRANSPORTATION
HIGHWAYS DIVISION

END BLOCK AT ABUTMENT 1
SECTION AT DROP PANEL
HONOAPIILANI HIGHWAY REALIGNMENT, PHASE 1A
Future Keawe St Extension to Lahainaluna Rd, Part B
Fed. Aid Proj. No. NH-030-1(35)R
Scale: As Noted Date: June, 2010
SHEET No. SB10.7 OF 10 SHEETS

FED. ROAD DIST. NO.	STATE	FED. AID PROJ. NO.	FISCAL YEAR	SHEET NO.	TOTAL SHEETS
HAWAII	HAW.	NH-030-1(35)R	2009	341	383

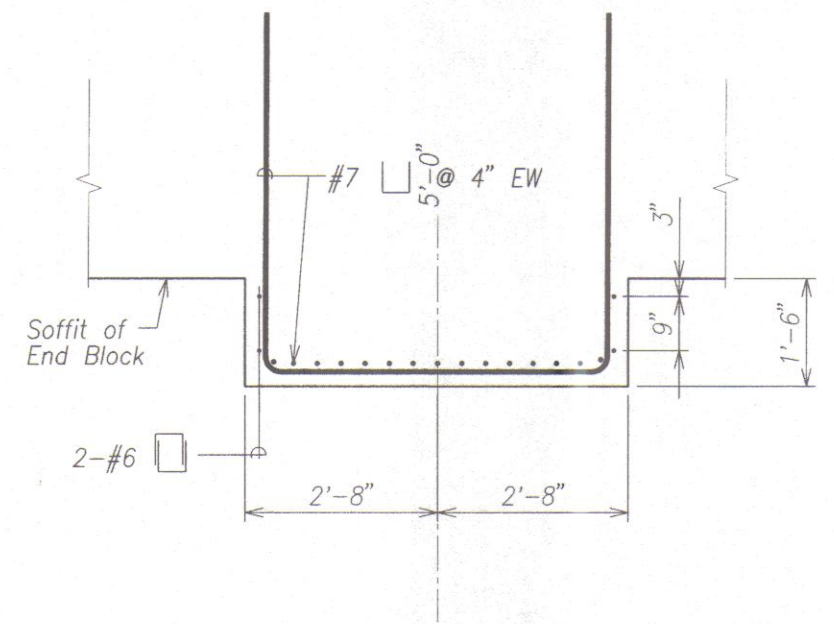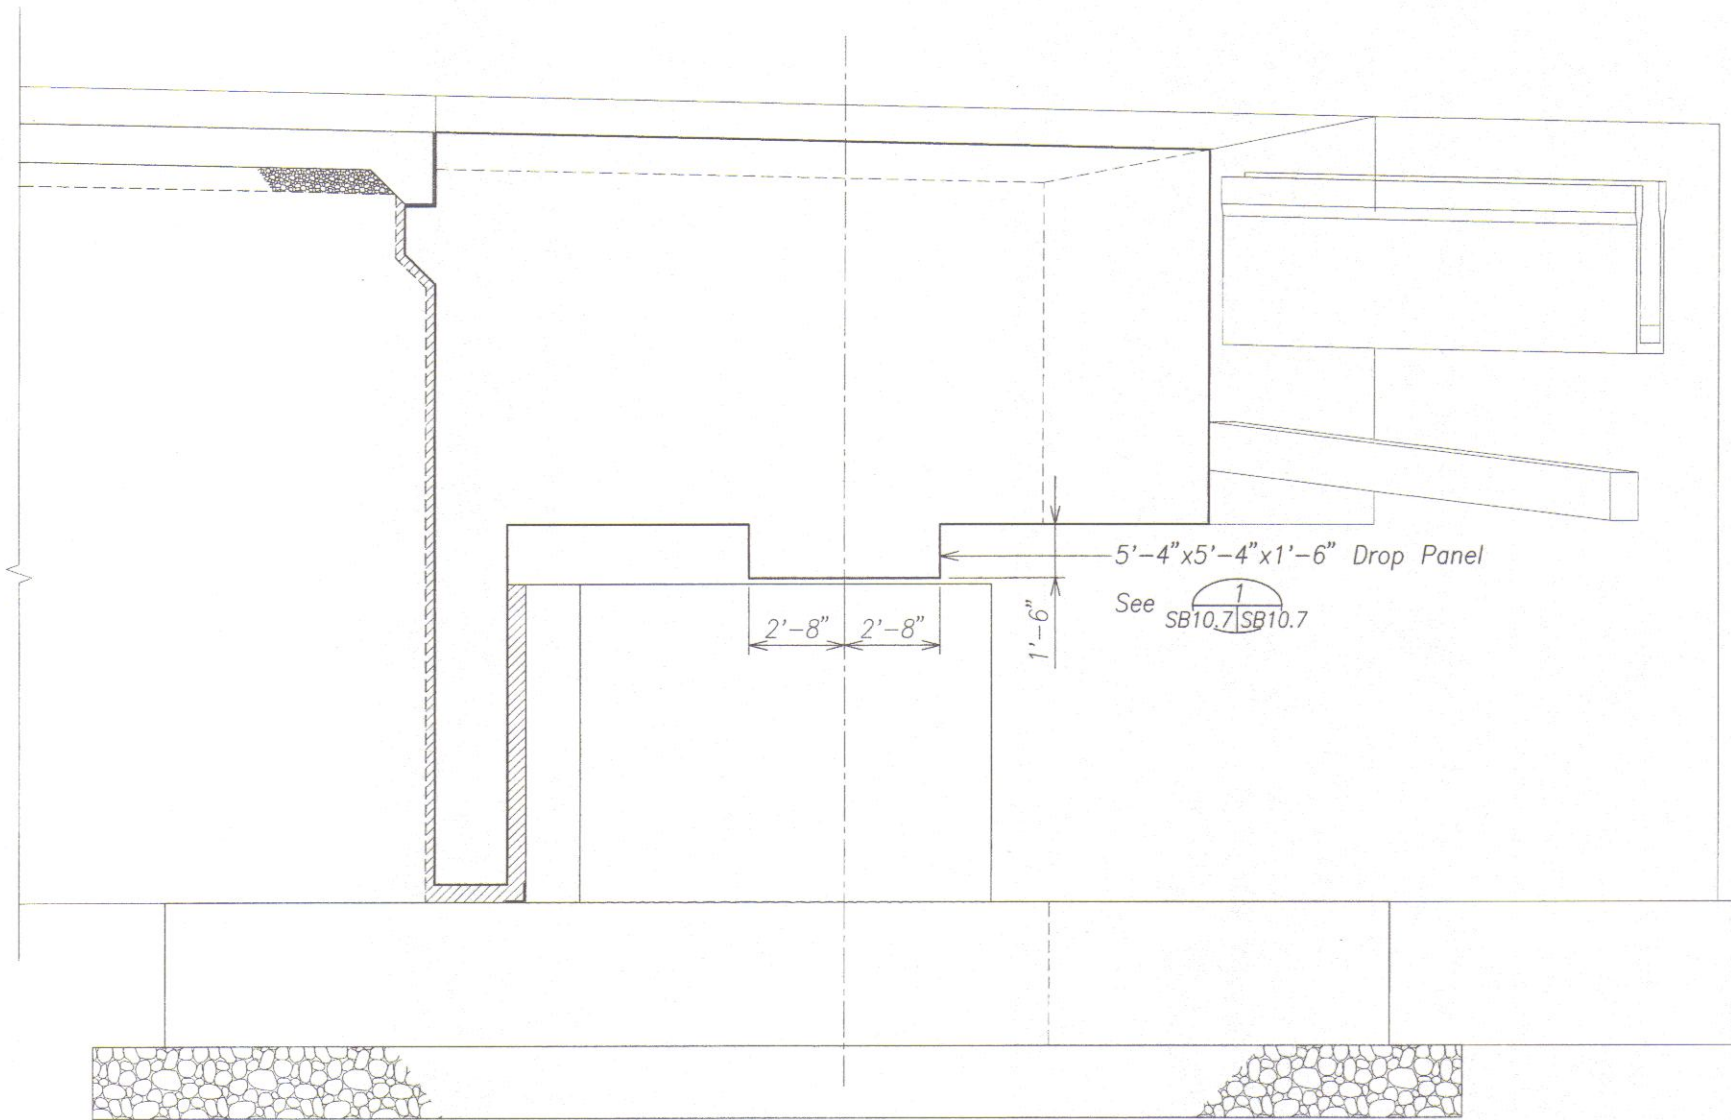

DROP PANEL
Scale: 3/4" = 1'-0" SB10.7

END BLOCK AT ABUTMENT 1 - SECTION AT DROP PANEL
Scale: 3/8" = 1'-0" SB10.2




THIS WORK WAS PREPARED BY ME
OR UNDER MY SUPERVISION.
David K. Fujiwara
KSF, INC. APRIL 30, 2012
LIC. EXP. DATE

STATE OF HAWAII
DEPARTMENT OF TRANSPORTATION
HIGHWAYS DIVISION

END BLOCK AT ABUTMENT 1
SECTION AT DROP PANEL
HONOAPIILANI HIGHWAY REALIGNMENT, PHASE 1A
Future Keawe St Extension to Lahainaluna Rd, Part B
Fed. Aid Proj. No. NH-030-1(35)R
Scale: As Noted Date: June, 2010
SHEET No. SB10.7 OF 10 SHEETS

FED. ROAD DIST. NO.	STATE	FED. AID PROJ. NO.	FISCAL YEAR	SHEET NO.	TOTAL SHEETS
HAWAII	HAW.	NH-030-1(35)R	2009	342	383

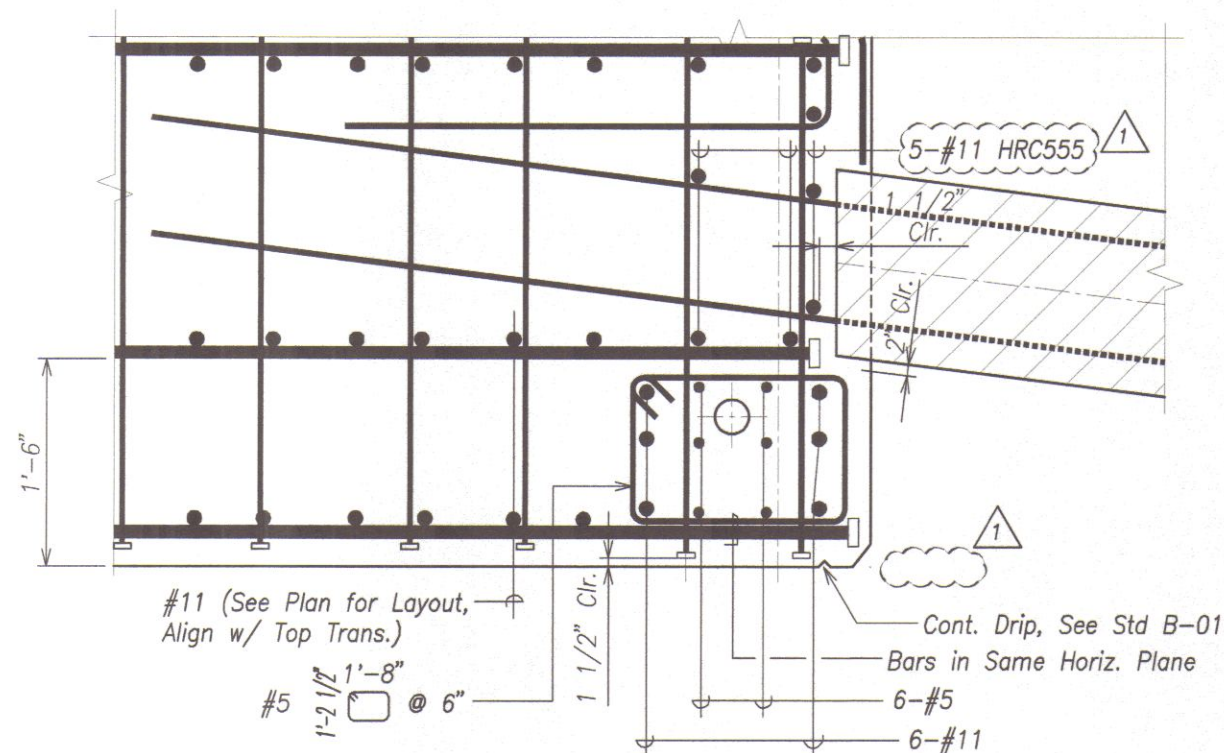

END BLOCK DETAIL
Scale: 1 1/2" = 1'-0"



THIS WORK WAS PREPARED BY ME
OR UNDER MY SUPERVISION.

KSF, INC. APRIL 30, 2012
LIC. EXP. DATE

ORIGINAL PLAN	SURVEY PLOTTED BY	DATE
NOTE BOOK	DRAWN BY	
No.	DESIGNED BY	
	CHECKED BY	

DRAWING NAME: Z:\00 ONGOING\40019.0-HONOAPIILANI LHAHANA BYPASS-KAHOMA WD\03-30-11 EM END BLOCKS\HH-SB1001.DWG PLOT TIME: 03-30-11, 4:18 PM

3/30/11	1 Revisions
DATE	REVISION

STATE OF HAWAII
DEPARTMENT OF TRANSPORTATION
HIGHWAYS DIVISION


END BLOCK DETAIL

HONOAPIILANI HIGHWAY REALIGNMENT, PHASE 1A
Future Keawe St Extension to Lahainaluna Rd, Part B
Fed. Aid Proj. No. NH-030-1(35)R

Scale: As Noted Date: June, 2010

SHEET No. SB10.8 OF 10 SHEETS

FED. ROAD DIST. NO.	STATE	FED. AID PROJ. NO.	FISCAL YEAR	SHEET NO.	TOTAL SHEETS
HAWAII	HAW.	NH-030-1(35)R	2009	342	383

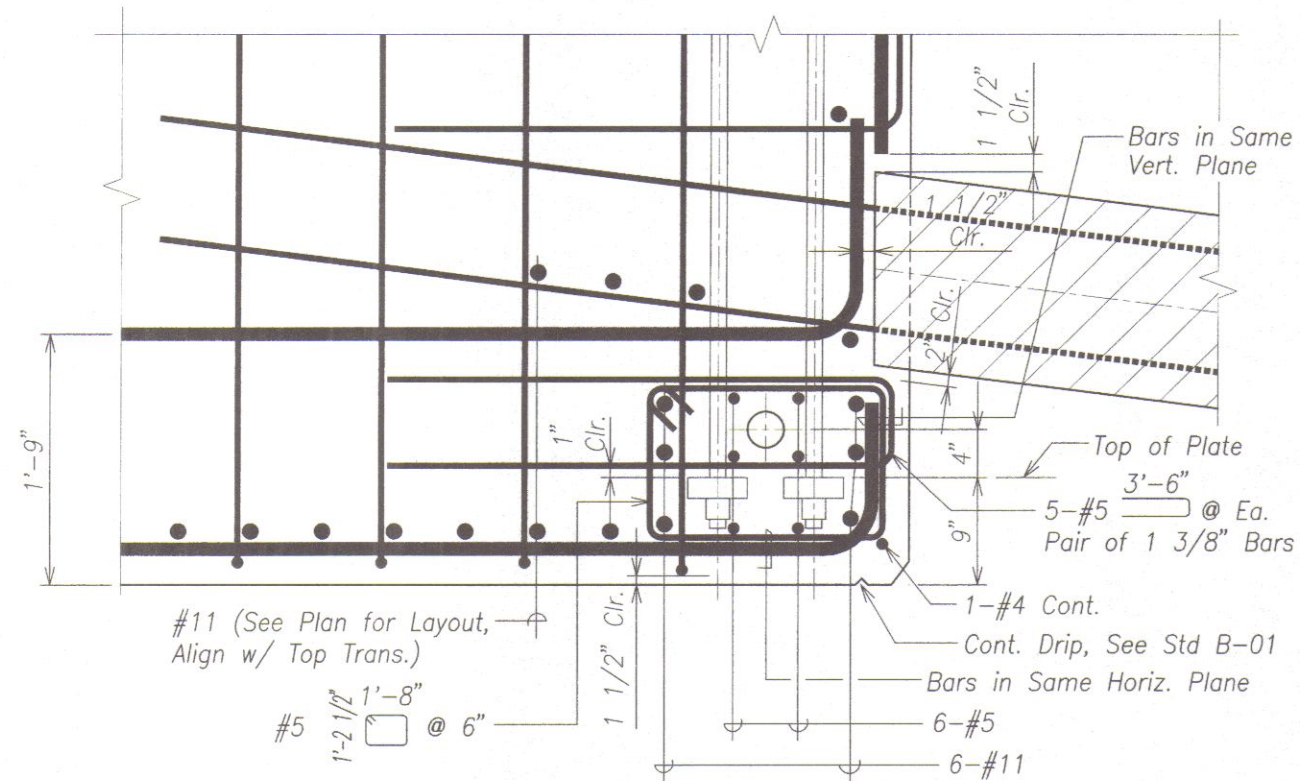

END BLOCK DETAIL
Scale: 1 1/2" = 1'-0"

SB10.5 SB10.8
SB10.6

ORIGINAL PLAN	SURVEY PLOTTED BY _____	DATE _____
NOTE BOOK	DRAWN BY _____	"
	TRACED BY _____	"
	DESIGNED BY _____	"
	QUANTITIES BY _____	"
No. _____	CHECKED BY _____	_____

DRAWING NAME: Z:\00 ONGOING\40019.0-HONCAPILANI LAHAINA BYPASS-KAHOMA WO\06-15-10 COMBINE LAHAINA FINAL DESIGN\HH-SB1001.DWG PLOT TIME: 06-14-10, 8:17 PM)



THIS WORK WAS PREPARED BY ME
OR UNDER MY SUPERVISION.

David K. Jaymar APRIL 30, 2012
KSF, INC. LIC. EXP. DATE

STATE OF HAWAII
DEPARTMENT OF TRANSPORTATION
HIGHWAYS DIVISION

END BLOCK DETAIL


HONOAHIILANI HIGHWAY REALIGNMENT, PHASE 1A
Future Keawe St Extension to Lahainaluna Rd, Part B
Fed. Aid Proj. No. NH-030-1(35)R

Scale: As Noted Date: June, 2010

SHEET No. SB10.8 OF 10 SHEETS

FINAL DESIGN ~~342~~ Rev.

FED. ROAD DIST. NO.	STATE	FED. AID PROJ. NO.	FISCAL YEAR	SHEET NO.	TOTAL SHEETS
HAWAII	HAW.	NH-030-1(35)R	2009	343	383

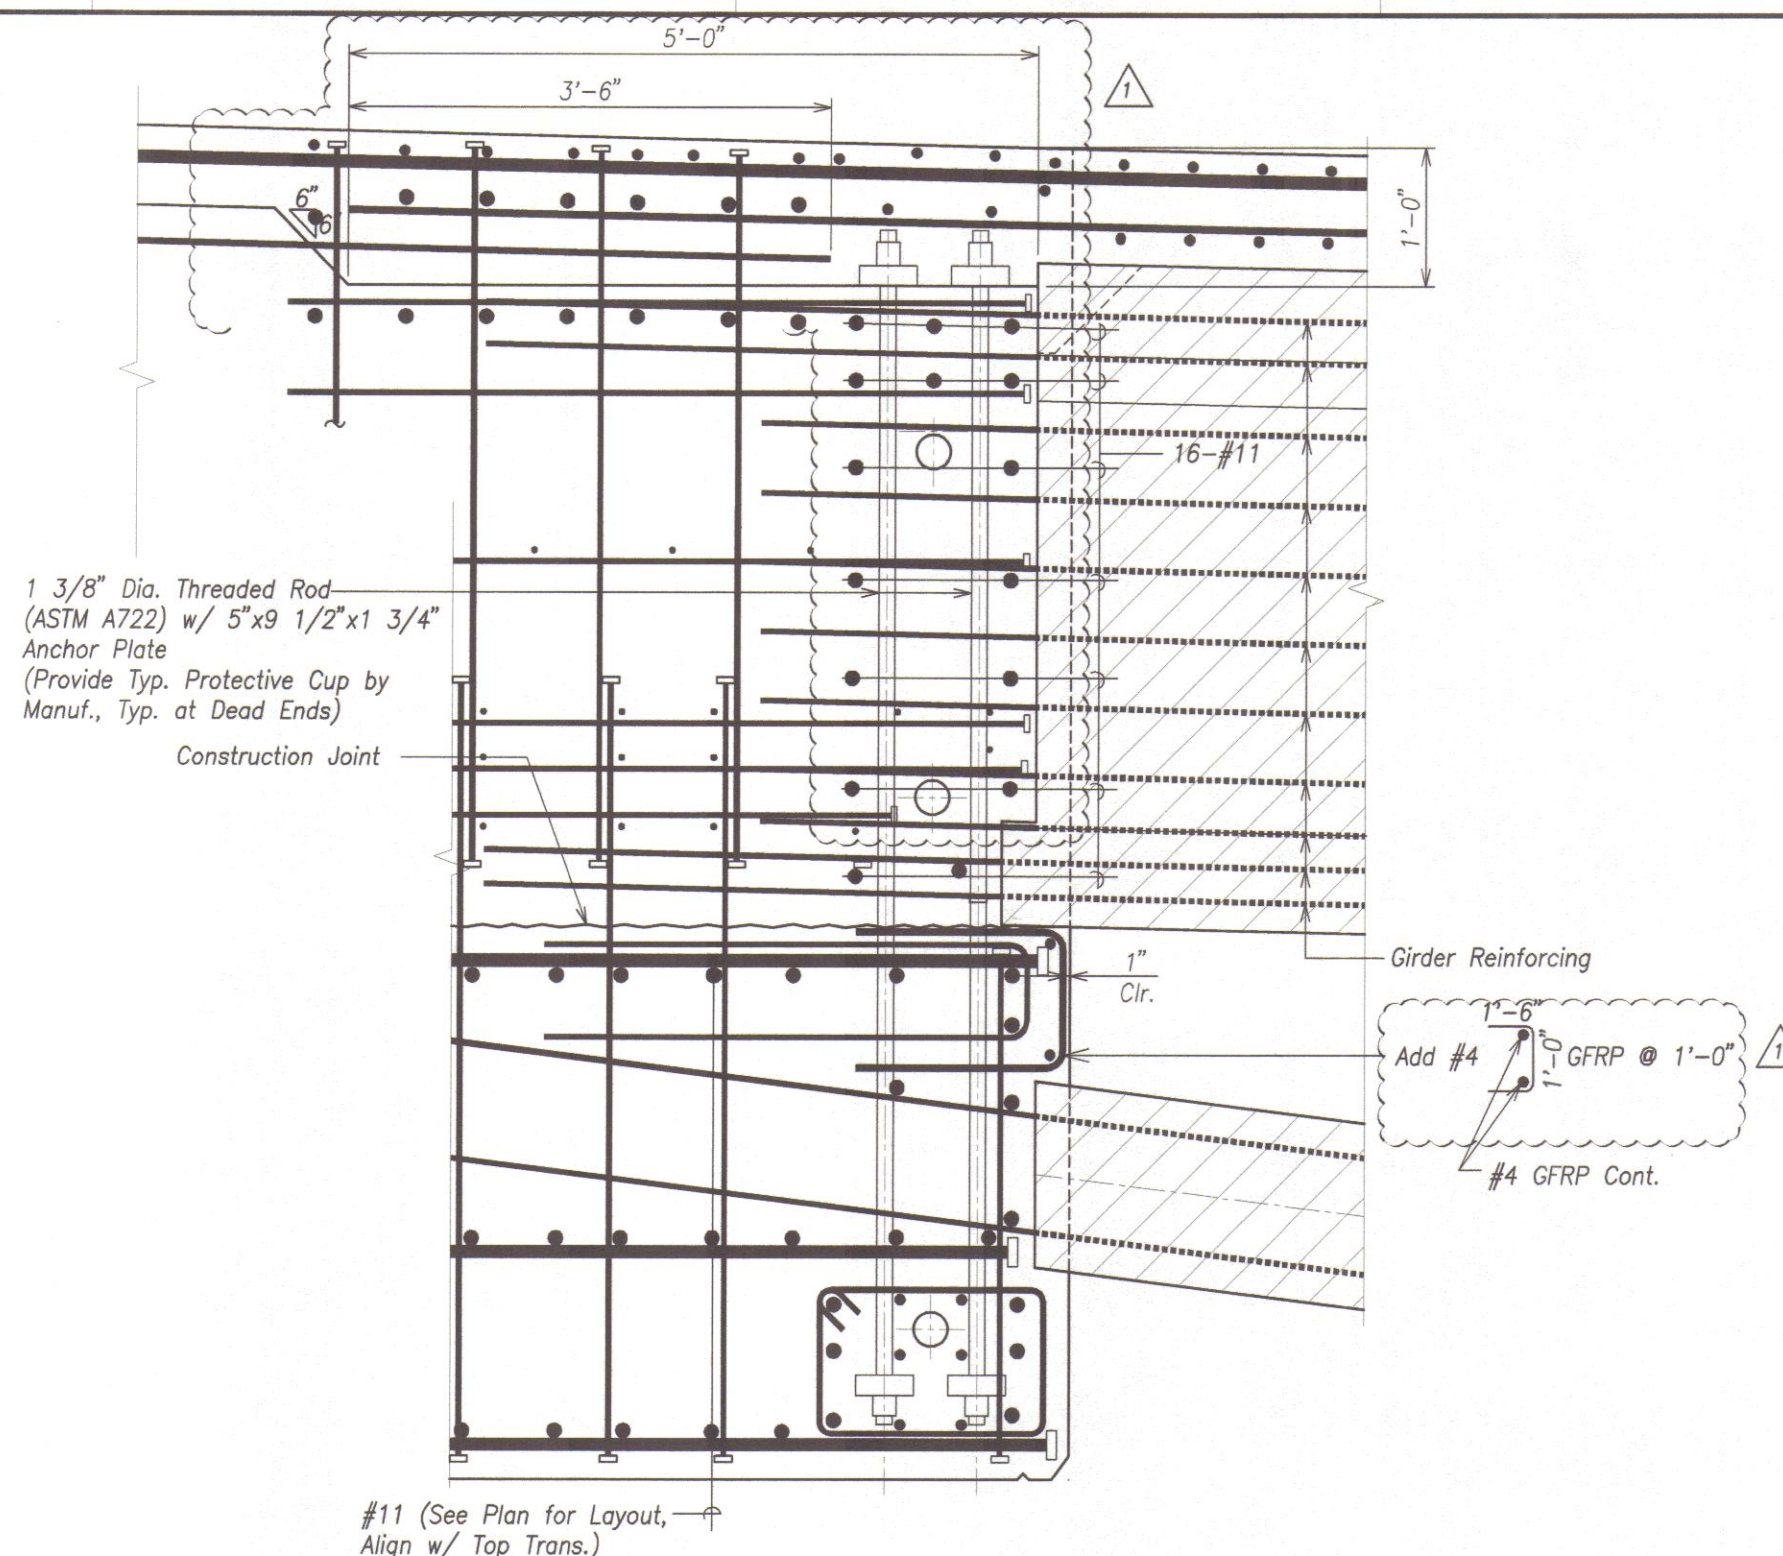

END BLOCK DETAIL AT GIRDER STEM

Scale: 1 1/2" = 1'-0"

SB10.5 SB10.9
SB10.6



THIS WORK WAS PREPARED BY ME
OR UNDER MY SUPERVISION.

KSF, INC. APRIL 30, 2012
LIC. EXP. DATE

STATE OF HAWAII
DEPARTMENT OF TRANSPORTATION
HIGHWAYS DIVISION

END BLOCK DETAIL

HONOPILANI HIGHWAY REALIGNMENT, PHASE 1A
Future Keawe St Extension to Lahainaluna Rd, Part B

Fed. Aid Proj. No. NH-030-1(35)R

Scale: As Noted

Date: June, 2010

SHEET No. SB10.9 OF 10 SHEETS

2/01/11 Revisions

DATE

REVISION


FINAL DESIGN

343

ORIGINAL PLAN	DATE
NOTE BOOK	
DESIGNED BY	
CHECKED BY	
NO.	

DRAWING NAME: Z:\00 ONCONING\40019.0-HONOPILANI LAHAINA BYPASS-KHOMA W03-30-11 EM END BLOCKS\HH-SB1001.DWG PLOT TIME: 03-31-11, 11:56 AM

FED. ROAD DIST. NO.	STATE	FED. AID PROJ. NO.	FISCAL YEAR	SHEET NO.	TOTAL SHEETS
HAWAII	HAW.	NH-030-1(35)R	2009	343	383

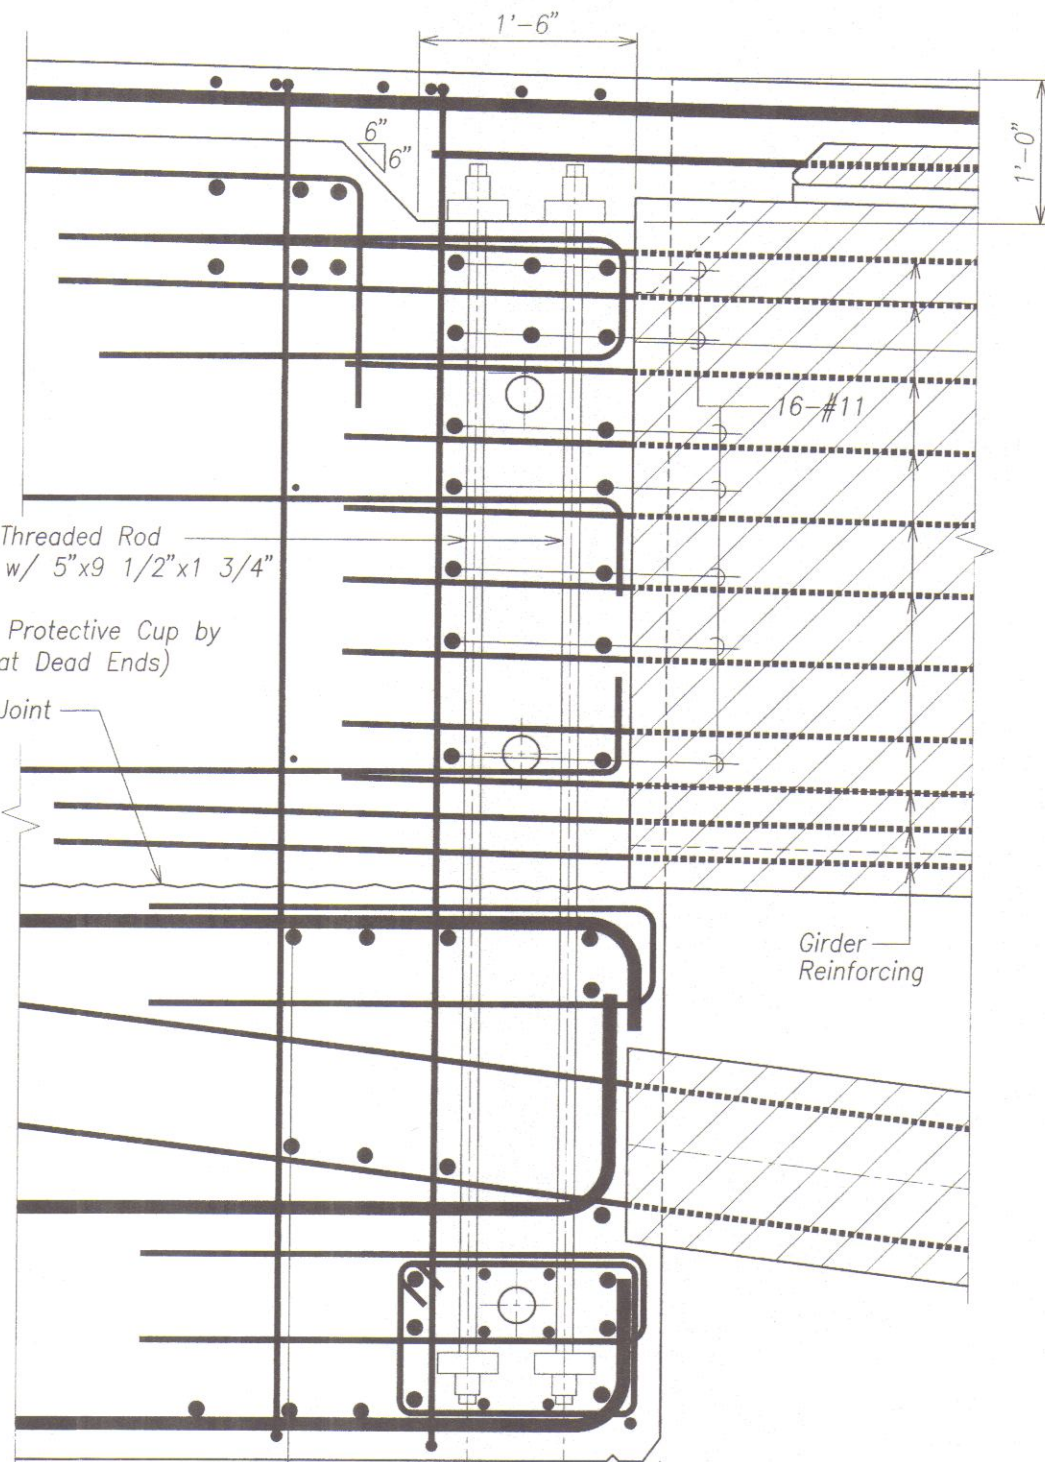

1 3/8" Dia. Threaded Rod
(ASTM A722) w/ 5"x9 1/2"x1 3/4"
Anchor Plate
(Provide Typ. Protective Cup by
Manuf., Typ. at Dead Ends)

Construction Joint

Girder
Reinforcing

#11 (See Plan for Layout, —
Align w/ Top Trans.)

END BLOCK DETAIL AT GIRDER STEM

Scale: 1 1/2" = 1'-0"

A
SB10.5 SB10.9
SB10.6



THIS WORK WAS PREPARED BY ME
OR UNDER MY SUPERVISION.

David K. Fujiwara
KSF, INC. APRIL 30, 2012
LIC. EXP. DATE

STATE OF HAWAII
DEPARTMENT OF TRANSPORTATION
HIGHWAYS DIVISION

END BLOCK DETAIL

HONOAPIILANI HIGHWAY REALIGNMENT, PHASE 1A

Future Keawe St Extension to Lahainaluna Rd, Part B

Fed. Aid Proj. No. NH-030-1(35)R

Scale: As Noted

Date: June, 2010


SHEET No. SB10.9 OF 10 SHEETS

FINAL DESIGN 343 RAN.

SURVEY PLOTTED BY	DATE
DRAWN BY	
DESIGNED BY	
QUANTITIES BY	
CHECKED BY	
ORIGINAL PLAN	
NOTE BOOK	
No.	


DRAWING NAME: Z:\00 ONGOING\40019.0-HONOAPIILANI LAHAINA BYPASS-KAHOMA WO\06-15-10 COMBINE LAHAINA FINAL DESIGN\HH-SB1001.DWG PLOT TIME: 06-14-10, 8:17 PM

FED. ROAD DIST. NO.	STATE	FED. AID PROJ. NO.	FISCAL YEAR	SHEET NO.	TOTAL SHEETS
HAWAII	HAW.	NH-030-1(35)R	2009	344	383

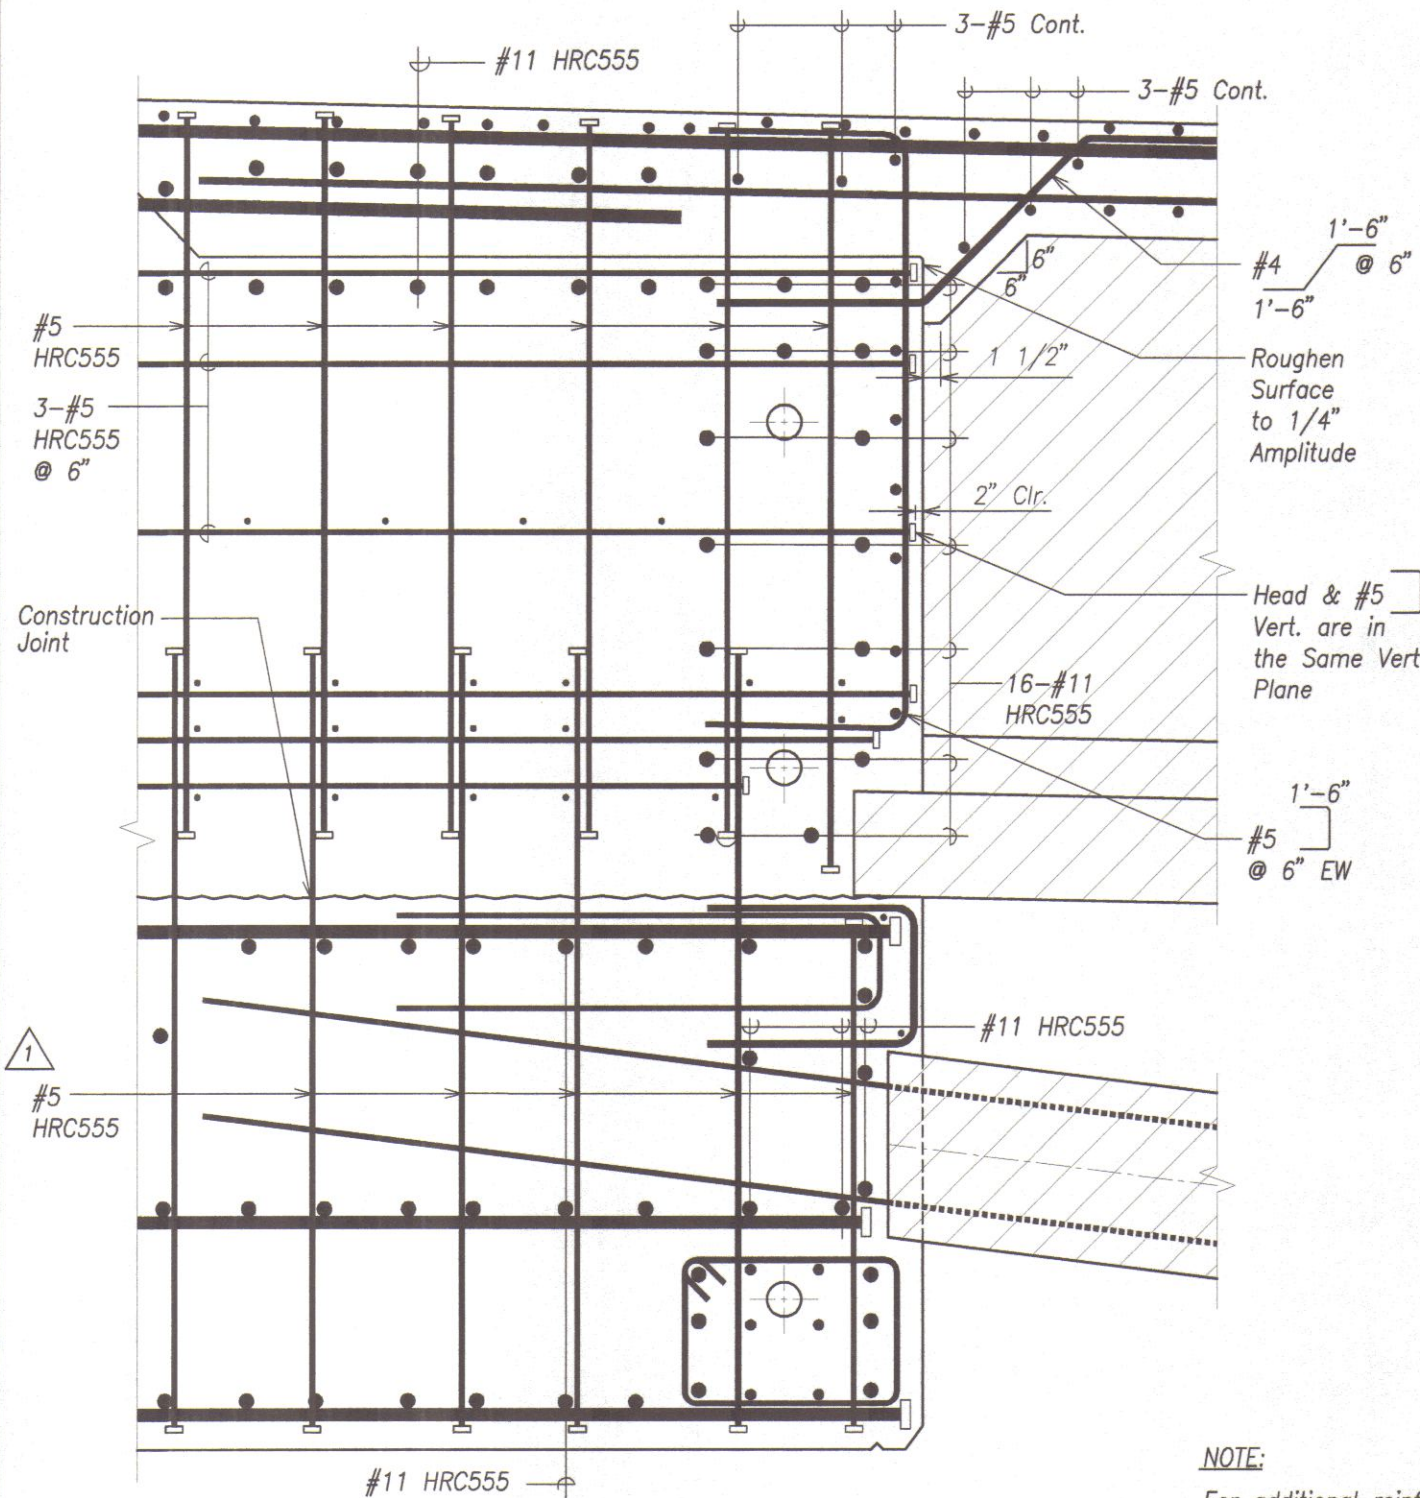

1 **AT TUB GIRDER BETWEEN STEMS** A
 Scale: 1 1/2" = 1'-0"
 SB10.5 SB10.10
 SB10.6

NOTE:
 For additional reinforcing at
 AVAR 12.6 Tendon Anchors,
 See Sheet SB11.6.

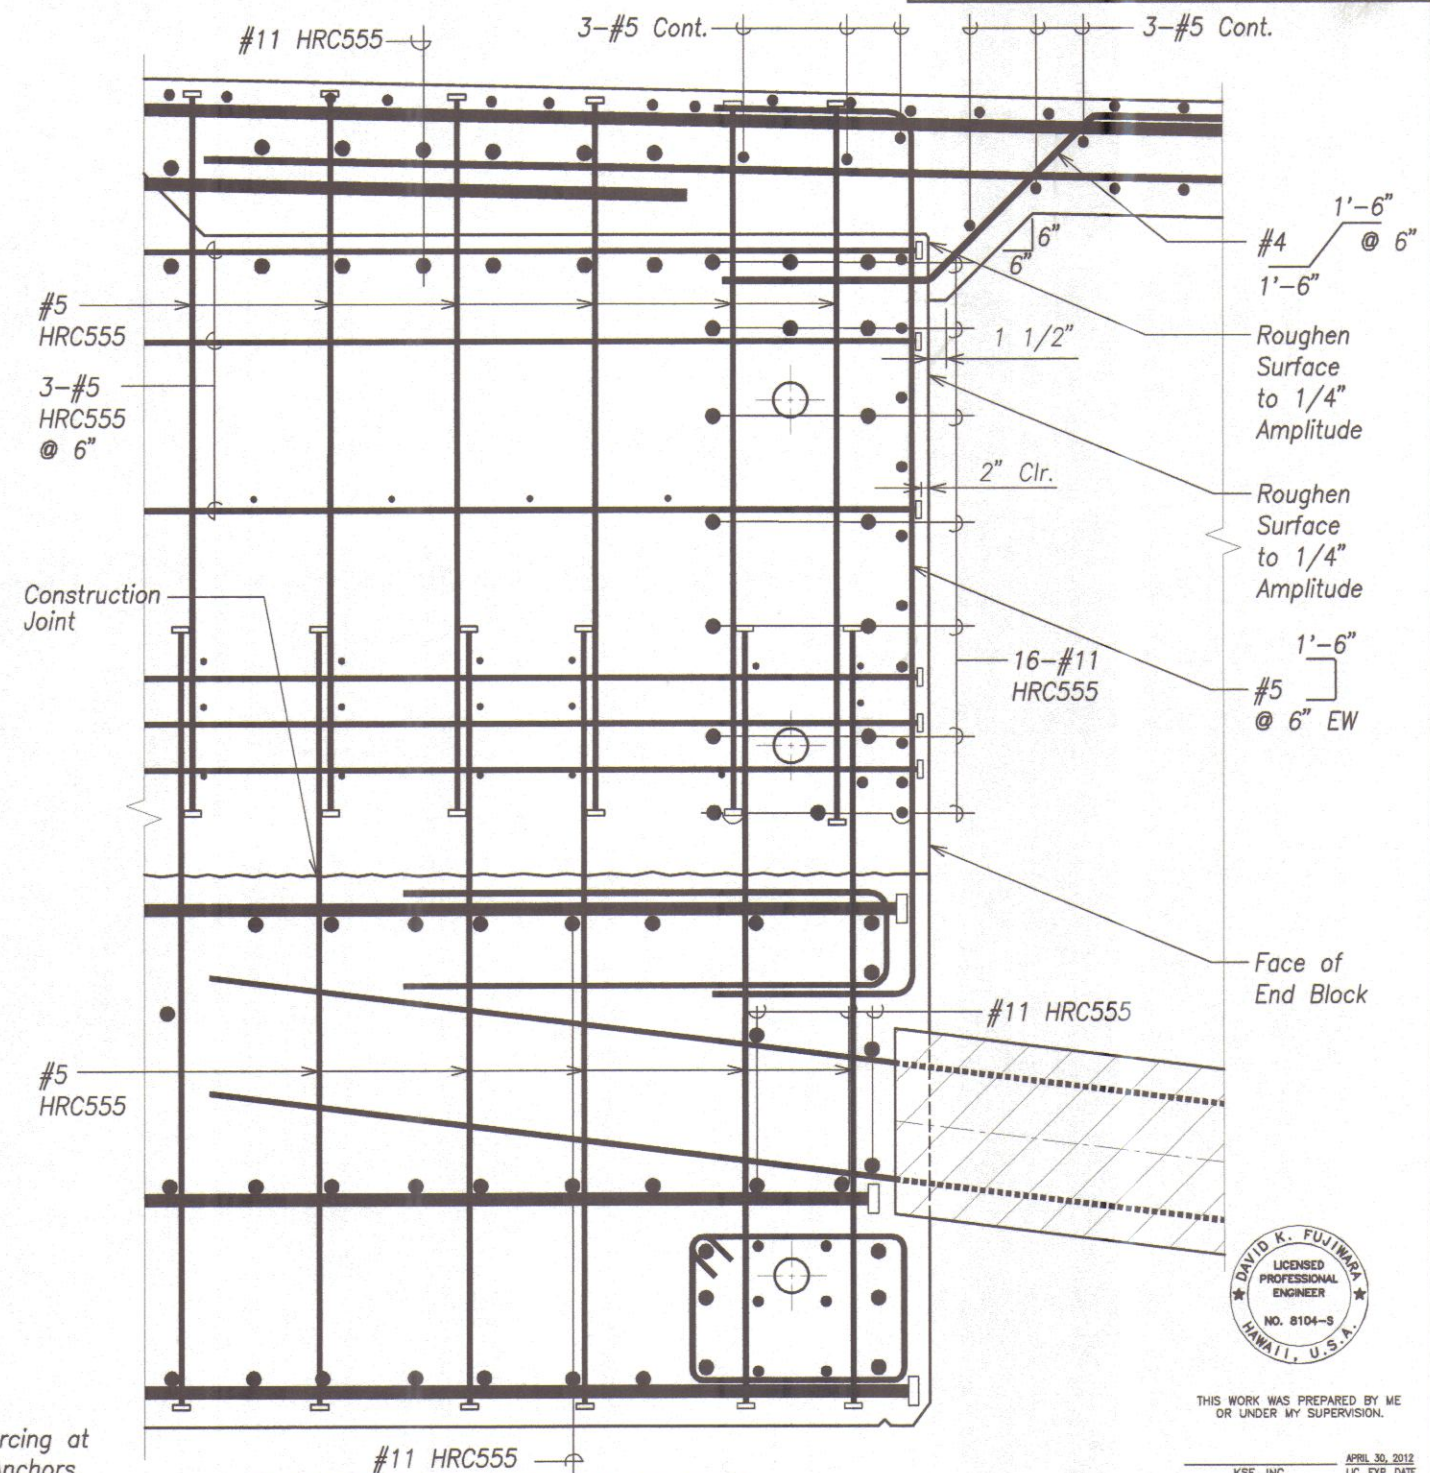

1 **BETWEEN TUBS** B
 Scale: 1 1/2" = 1'-0"
 SB10.10 SB10.10



THIS WORK WAS PREPARED BY ME
 OR UNDER MY SUPERVISION.


KSF, INC. APRIL 30, 2012
 LIC. EXP. DATE

STATE OF HAWAII
 DEPARTMENT OF TRANSPORTATION
 HIGHWAYS DIVISION
END BLOCK DETAIL
HONOAPIILANI HIGHWAY REALIGNMENT, PHASE 1A
Future Keawe St Extension to Lahainaluna Rd, Part B
Fed. Aid Proj. No. NH-030-1(35)R
 Scale: As Noted Date: June, 2010
 SHEET No. SB10.10 OF 10 SHEETS

2/01/11 1 Revisions


DATE REVISION

FED. ROAD DIST. NO.	STATE	FED. AID PROJ. NO.	FISCAL YEAR	SHEET NO.	TOTAL SHEETS
HAWAII	HAW.	NH-030-1(35)R	2009	344	383

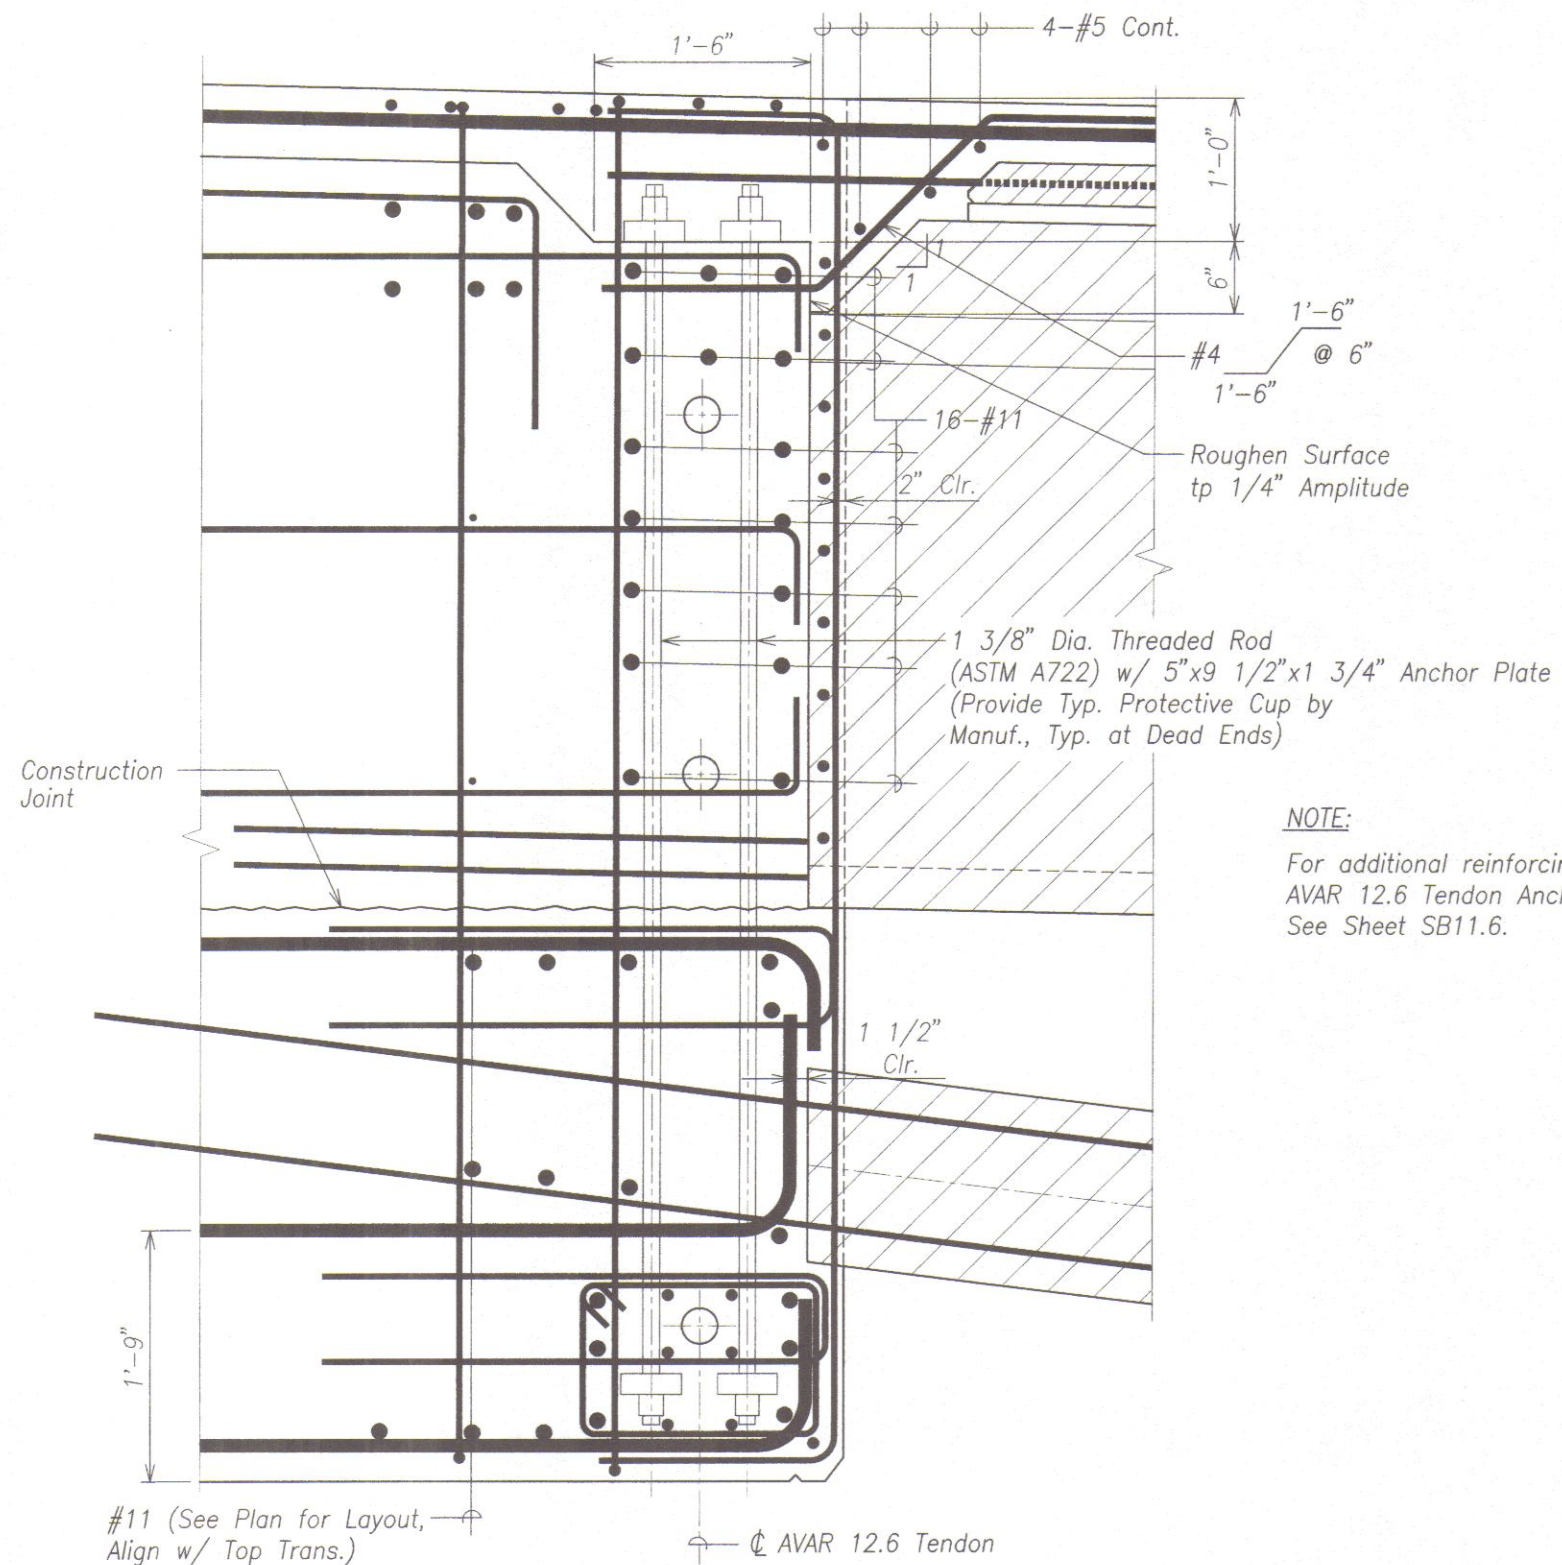

END BLOCK DETAIL BETWEEN GIRDERS
Scale: 1 1/2" = 1'-0"

SB10.5 SB10.10
SB10.6

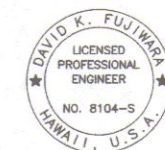

THIS WORK WAS PREPARED BY ME
OR UNDER MY SUPERVISION.
David K. Fujiwara
KSF, INC. APRIL 30, 2012
LIC. EXP. DATE

STATE OF HAWAII
DEPARTMENT OF TRANSPORTATION
HIGHWAYS DIVISION

END BLOCK DETAIL

HONOAPIILANI HIGHWAY REALIGNMENT, PHASE 1A
Future Keawe St Extension to Lahainaluna Rd, Part B
Fed. Aid Proj. No. NH-030-1(35)R

Scale: As Noted Date: June, 2010


SHEET No. SB10.10 OF 10 SHEETS

FINAL DESIGN 344 DW


ORIGINAL PLAN	SURVEY PLOTTED BY	DATE
NOTE BOOK	DRAWN BY	
	DESIGNED BY	
	CHECKED BY	
	NO.	

DRAWING NAME: Z:\00 ONGOING\40019.0-HONOAPIILANI LAHAINA BYPASS-KAHOMA WO\06-15-10 COMBINE LAHAINA FINAL DESIGN\HH-SB1001.DWG PLOT TIME: 06-14-10, 8:17 PM

FED. ROAD DIST. NO.	STATE	FED. AID PROJ. NO.	FISCAL YEAR	SHEET NO.	TOTAL SHEETS
HAWAII	HAW.	NH-030-1(35)R	2009	344S-1	383

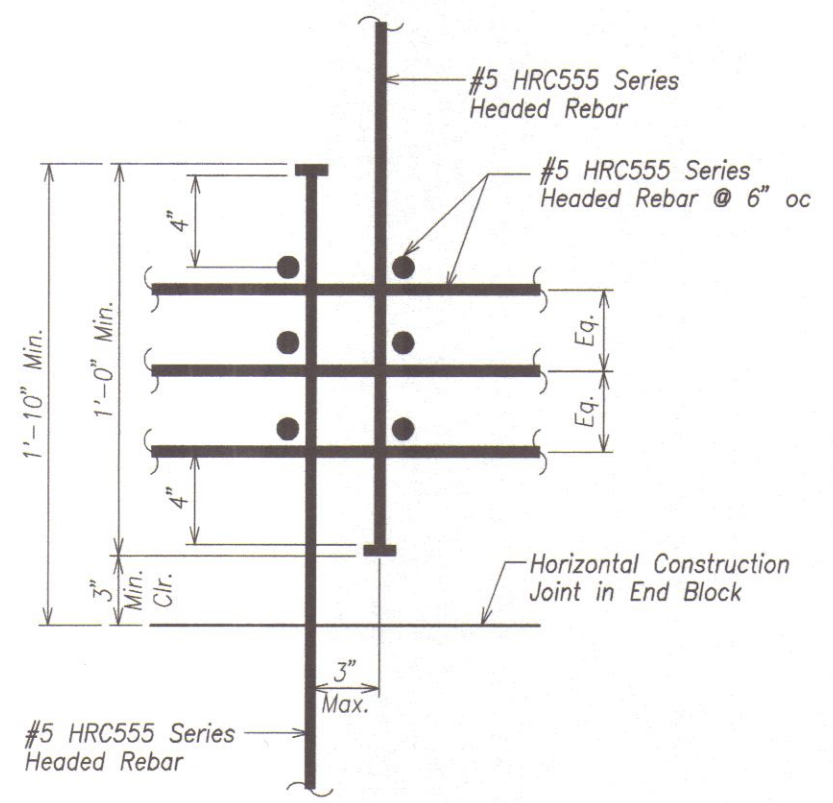

TYPICAL LAP SPLICE @
END BLOCK CONSTRUCTION JOINT A
Scale: 3" = 1'-0" SB10.10A SB10.10A

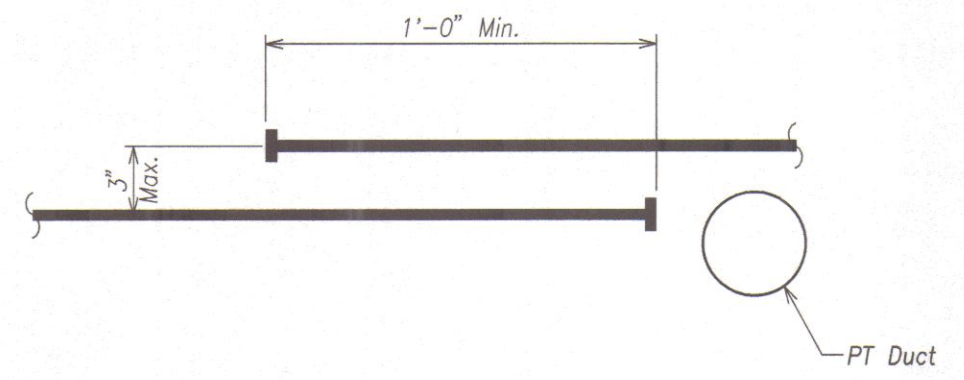

DETAIL OF #5 HEADED BAR @ PT DUCT B
Scale: 3" = 1'-0" SB10.10A SB10.10A

ORIGINAL PLAN	SURVEY PLOTTED BY	DATE
NOTE BOOK	DRAWN BY	
No.	DESIGNED BY	
	CHECKED BY	
	APPROVED BY	

DRAWING NAME: Z:\00 ONGOING\40019.0-HONOAPILANI LAHANA BYPASS-KAHOMA WD\03-30-11 EM END BLOCKS\HH-SB1001.DWG PLOT TIME: 03-30-11, 4:19 PM



THIS WORK WAS PREPARED BY ME
OR UNDER MY SUPERVISION.

APRIL 30, 2012
KSF, INC. L.C. EXP. DATE



2/01/11	 New Sheet
DATE	REVISION

STATE OF HAWAII
DEPARTMENT OF TRANSPORTATION
HIGHWAYS DIVISION

#5 HEADED REBAR DETAILS

HONOAPILANI HIGHWAY REALIGNMENT, PHASE 1A
Future Keawe St Extension to Lahainaluna Rd, Part B
Fed. Aid Proj. No. NH-030-1(35)R
Scale: As Noted Date: June, 2010
SHEET No. SB10.10A OF 10 SHEETS

FED. ROAD DIST. NO.	STATE	FED. AID PROJ. NO.	FISCAL YEAR	SHEET NO.	TOTAL SHEETS
HAWAII	HAW.	NH-030-1(35)R	2009	344S-2	383

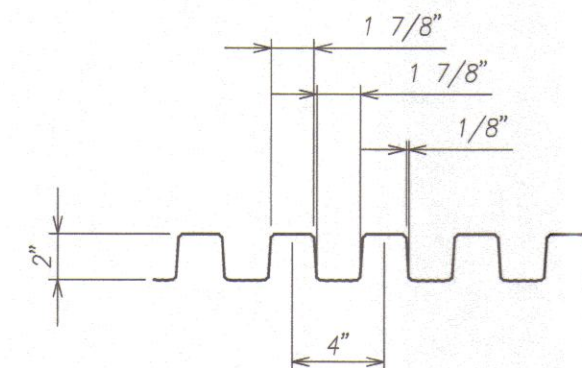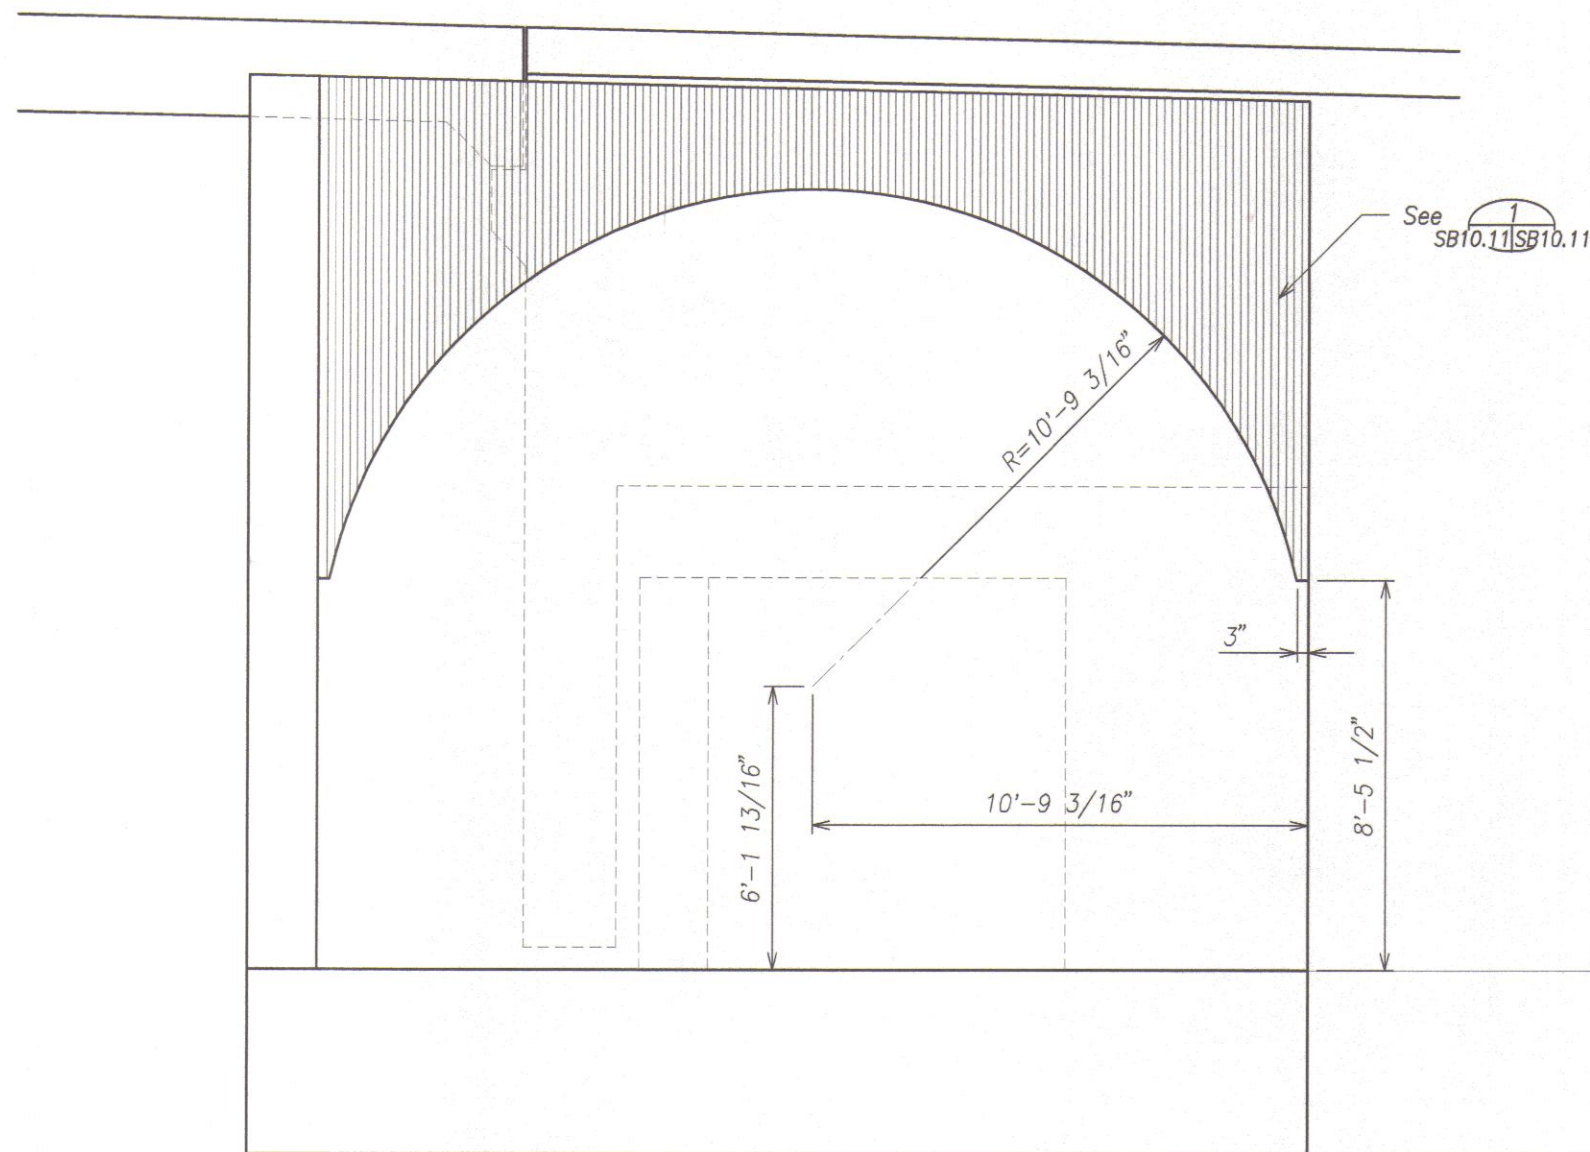

2" FLORIDA FIN REVEAL
FORMLINER DETAIL

Scale: 3" = 1'-0" SB10.11 SB10.11
SB10.12, SB11.12, SB11.13



THIS WORK WAS PREPARED BY ME
OR UNDER MY SUPERVISION.

KSF, INC. APRIL 30, 2012
LIC. EXP. DATE


FASCIA WALL ABUTMENT 1 - MAKAI SIDE
Scale: 1/2" = 1'-0" SB8.4 SB10.11

DATE	REVISION

STATE OF HAWAII DEPARTMENT OF TRANSPORTATION HIGHWAYS DIVISION	
ABUTMENT 1	
FASCIA WALL - MAKAI SIDE	
HONOAPIILANI HIGHWAY REALIGNMENT, PHASE 1A	
Future Keawe St Extension to Lahainaluna Rd, Part B	
Fed. Aid Proj. No. NH-030-1(35)R	
Scale: As Noted	Date: June, 2010
SHEET No. SB10.11 OF 6 SHEETS	

FINAL DESIGN 344S-2

FED. ROAD DIST. NO.	STATE	FED. AID PROJ. NO.	FISCAL YEAR	SHEET NO.	TOTAL SHEETS
HAWAII	HAW.	NH-030-1(35)R	2009	344S-3	38.3

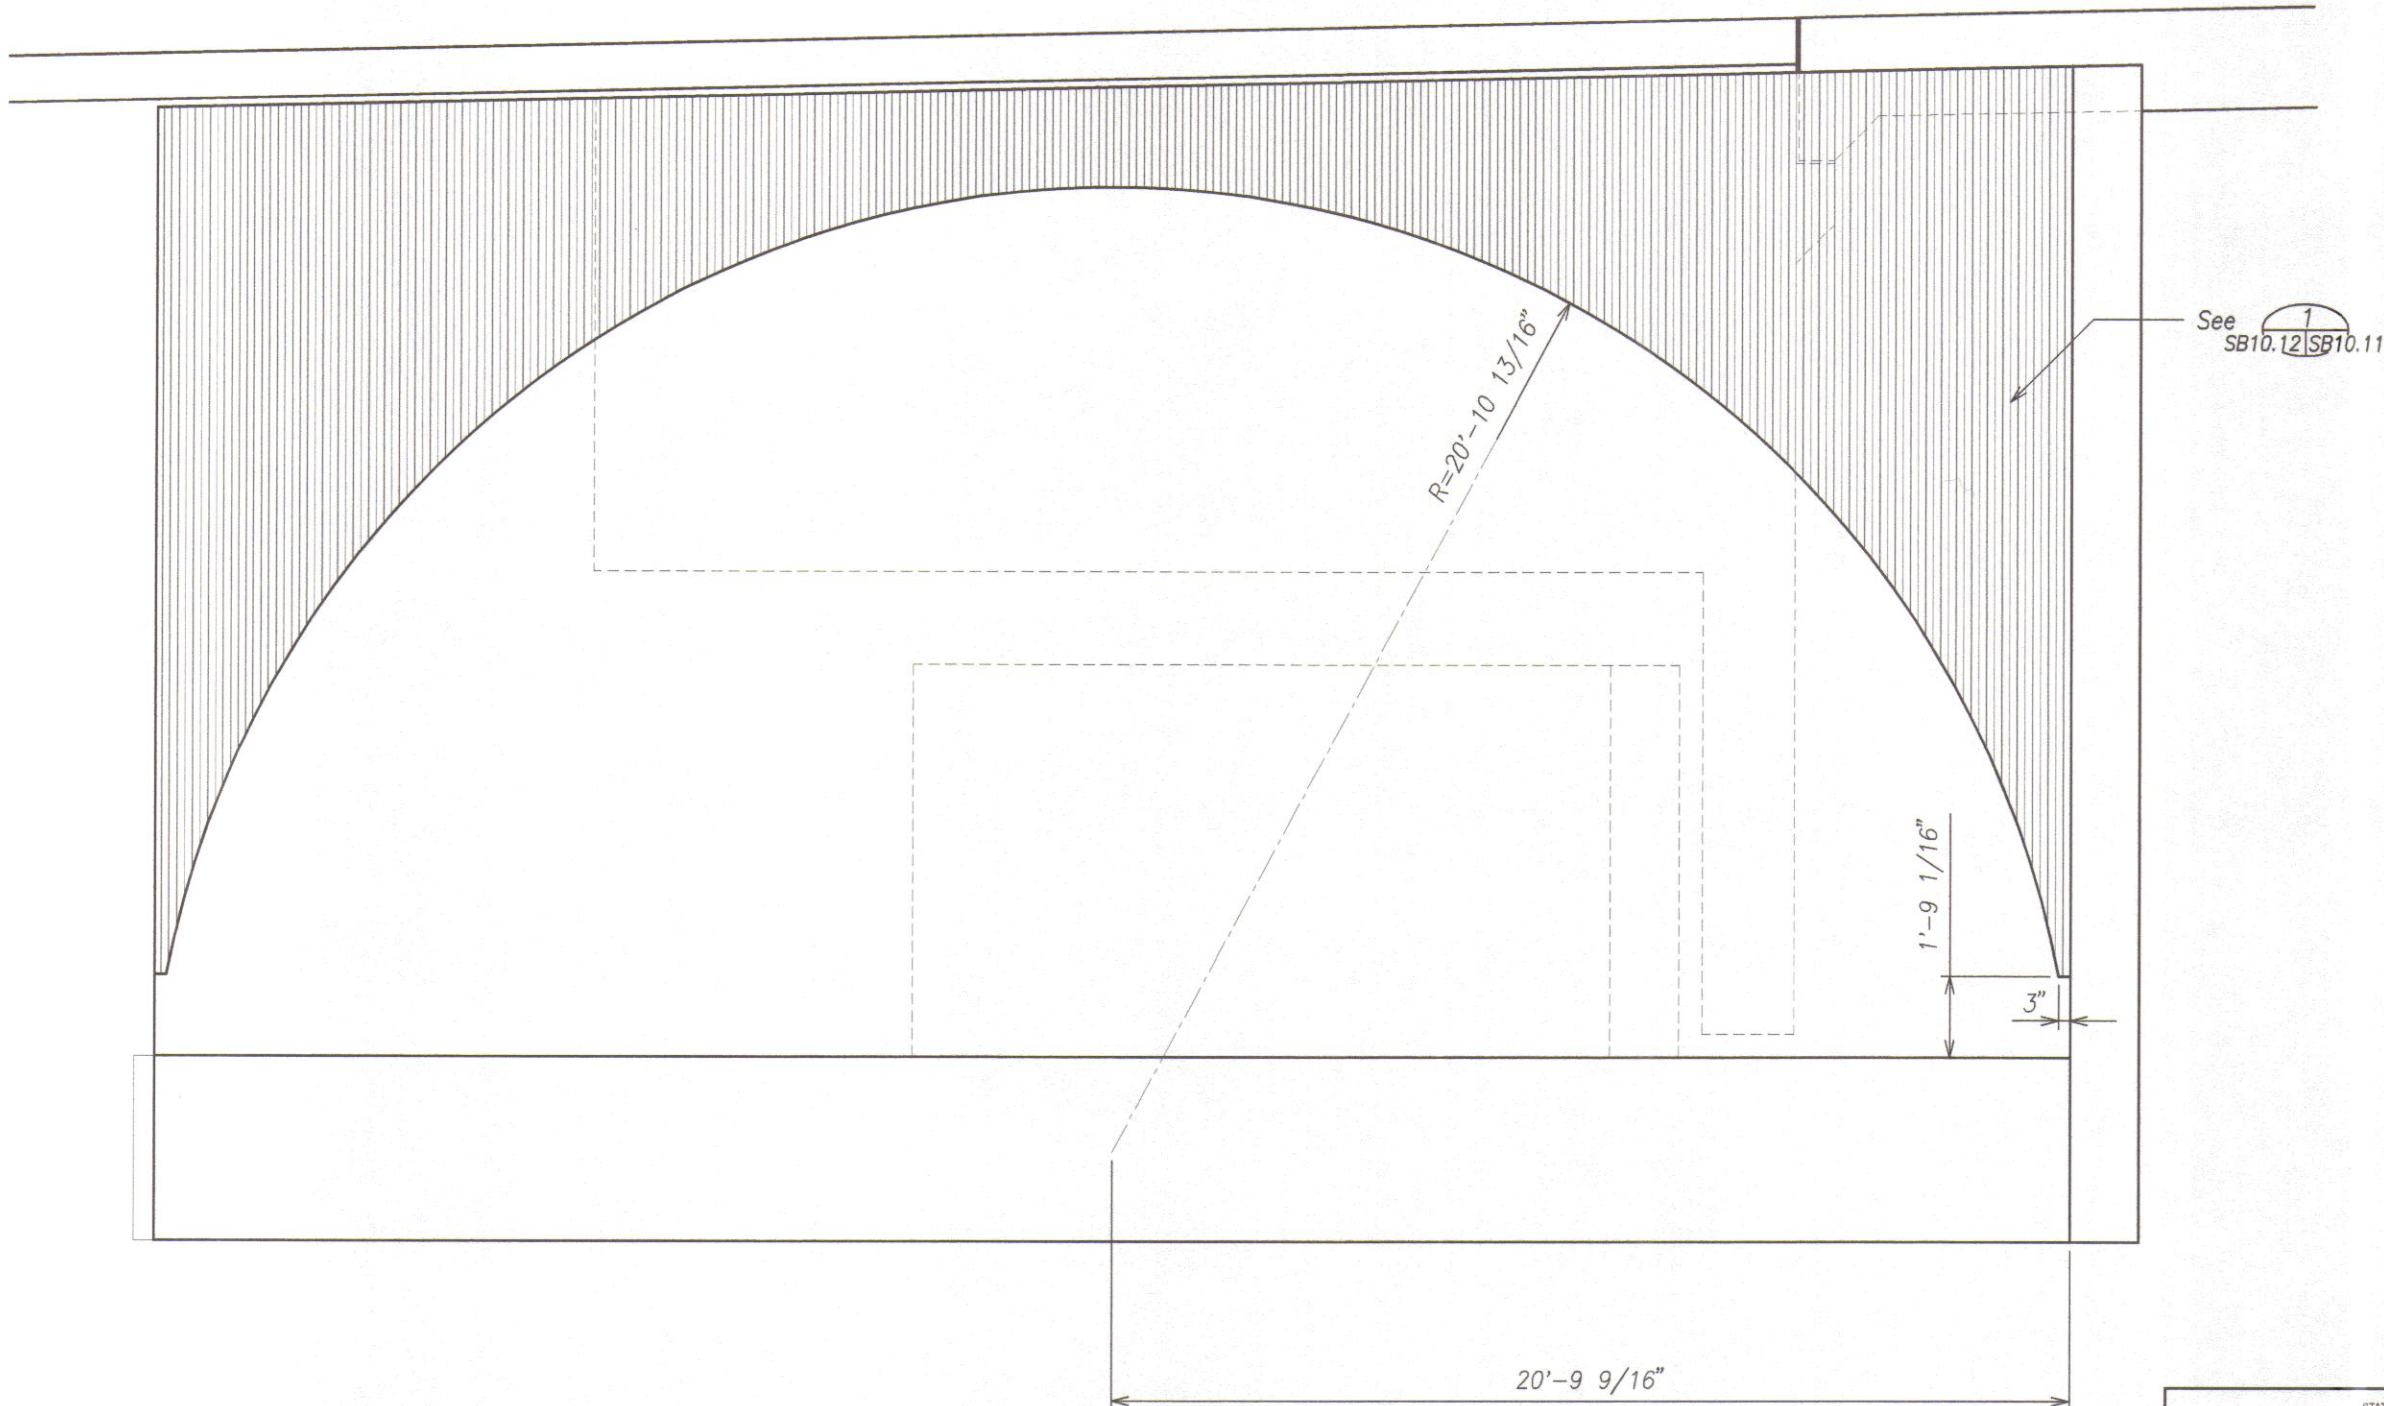

THIS WORK WAS PREPARED BY ME OR UNDER MY SUPERVISION.

KSF, INC. APRIL 30, 2012 LIC. EXP. DATE

FASCIA WALL ABUTMENT 1 - MAUKA SIDE
Scale: 1/2" = 1'-0"
SB8.4 | SB10.12

STATE OF HAWAII
DEPARTMENT OF TRANSPORTATION
HIGHWAYS DIVISION
ABUTMENT 1
FASCIA WALL - MAUKA SIDE
HONOAPIILANI HIGHWAY REALIGNMENT, PHASE 1A
Future Keawe St Extension to Lahainaluna Rd, Part B
Fed. Aid Proj. No. NH-030-1(35)R
Scale: As Noted Date: June, 2010
SHEET No. SB10.12 OF 6 SHEETS


ORIGINAL PLAN	SURVEY PLOTTED BY	DATE
NOTE BOOK	DRAWN BY	
No.	DESIGNED BY	
	CHECKED BY	

DRAWING NAME: Z:\00 ONECANG\40019.0-HONOAPIILANI LAHAINA BYPASS-KHOMA W03-30-11 EM END BLOCKS\HH-SB1011.DWG PLOT TIME: 03-30-11, 4:21 PM

DATE	REVISION

FED. ROAD DIST. NO.	STATE	FED. AID PROJ. NO.	FISCAL YEAR	SHEET NO.	TOTAL SHEETS
HAWAII	HAW.	NH-030-1(35)R	2009	345	383

Approx. Volume of End Block
Above Constr. Joint : 201 CY
Below Constr. Joint : 203 CY

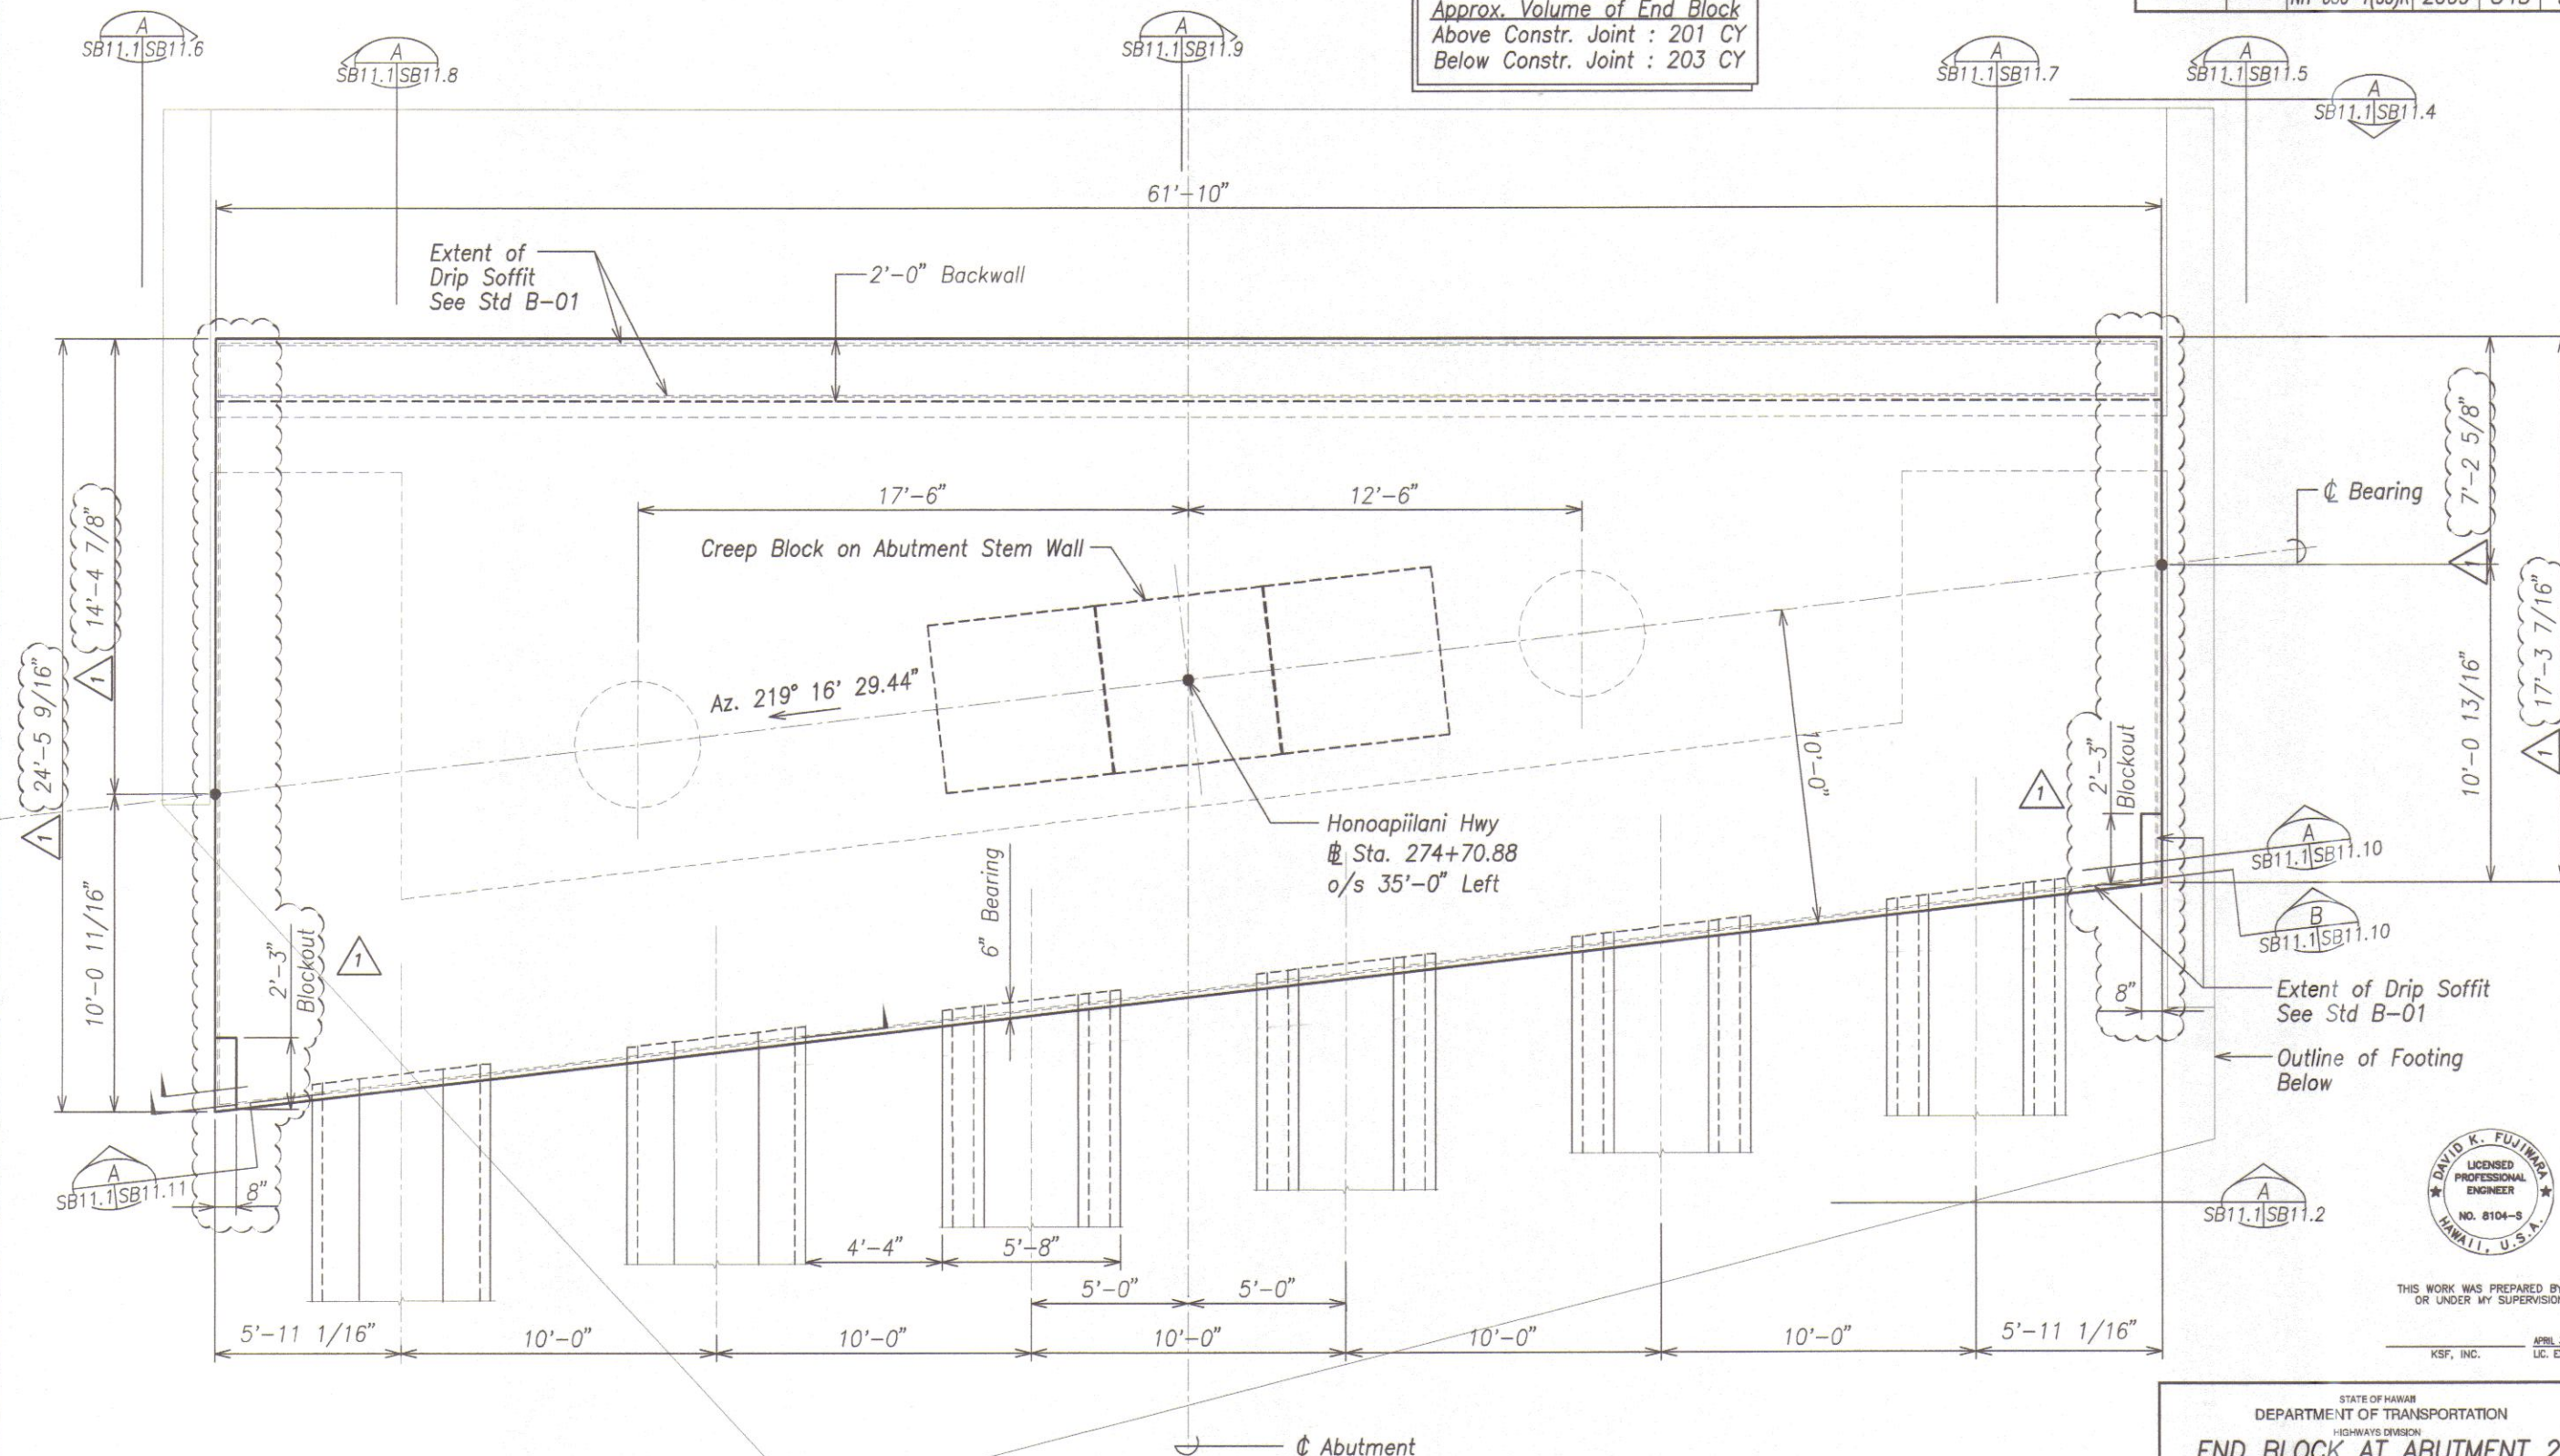

THIS WORK WAS PREPARED BY ME
OR UNDER MY SUPERVISION.

KSF, INC. APRIL 30, 2012
LIC. EXP. DATE

END BLOCK AT ABUTMENT 2 - PLAN

Scale: 3/8" = 1'-0"

SB11.1/SB11.1

2/01/11 Revisions

DATE REVISION

STATE OF HAWAII
DEPARTMENT OF TRANSPORTATION
HIGHWAYS DIVISION
END BLOCK AT ABUTMENT 2
PLAN
HONOAPIILANI HIGHWAY REALIGNMENT, PHASE 1A
Future Keawe St Extension to Lahaina Rd, Part B
Fed. Aid Proj. No. NH-030-1(35)R

Scale: As Noted Date: June, 2010


SHEET No. SB11.1 OF 11 SHEETS

FINAL DESIGN 345

DESIGNED BY	DATE
DRAWN BY	
CHECKED BY	
NOTED BY	
QUANTITIES BY	
CHECKED BY	

DRAWING NAME: 21.00 ONCING\400180-HONOAPIILANI LAHAINA BYPASS-KAHUNA W\03-30-11 EN END BLOCKS\HH-SB1101.DWG PLOT TIME: 03-30-11, 4:21 PM

FED. ROAD DIST. NO.	STATE	FED. AID PROJ. NO.	FISCAL YEAR	SHEET NO.	TOTAL SHEETS
HAWAII	HAW.	NH-030-1(35)R	2009	345	383

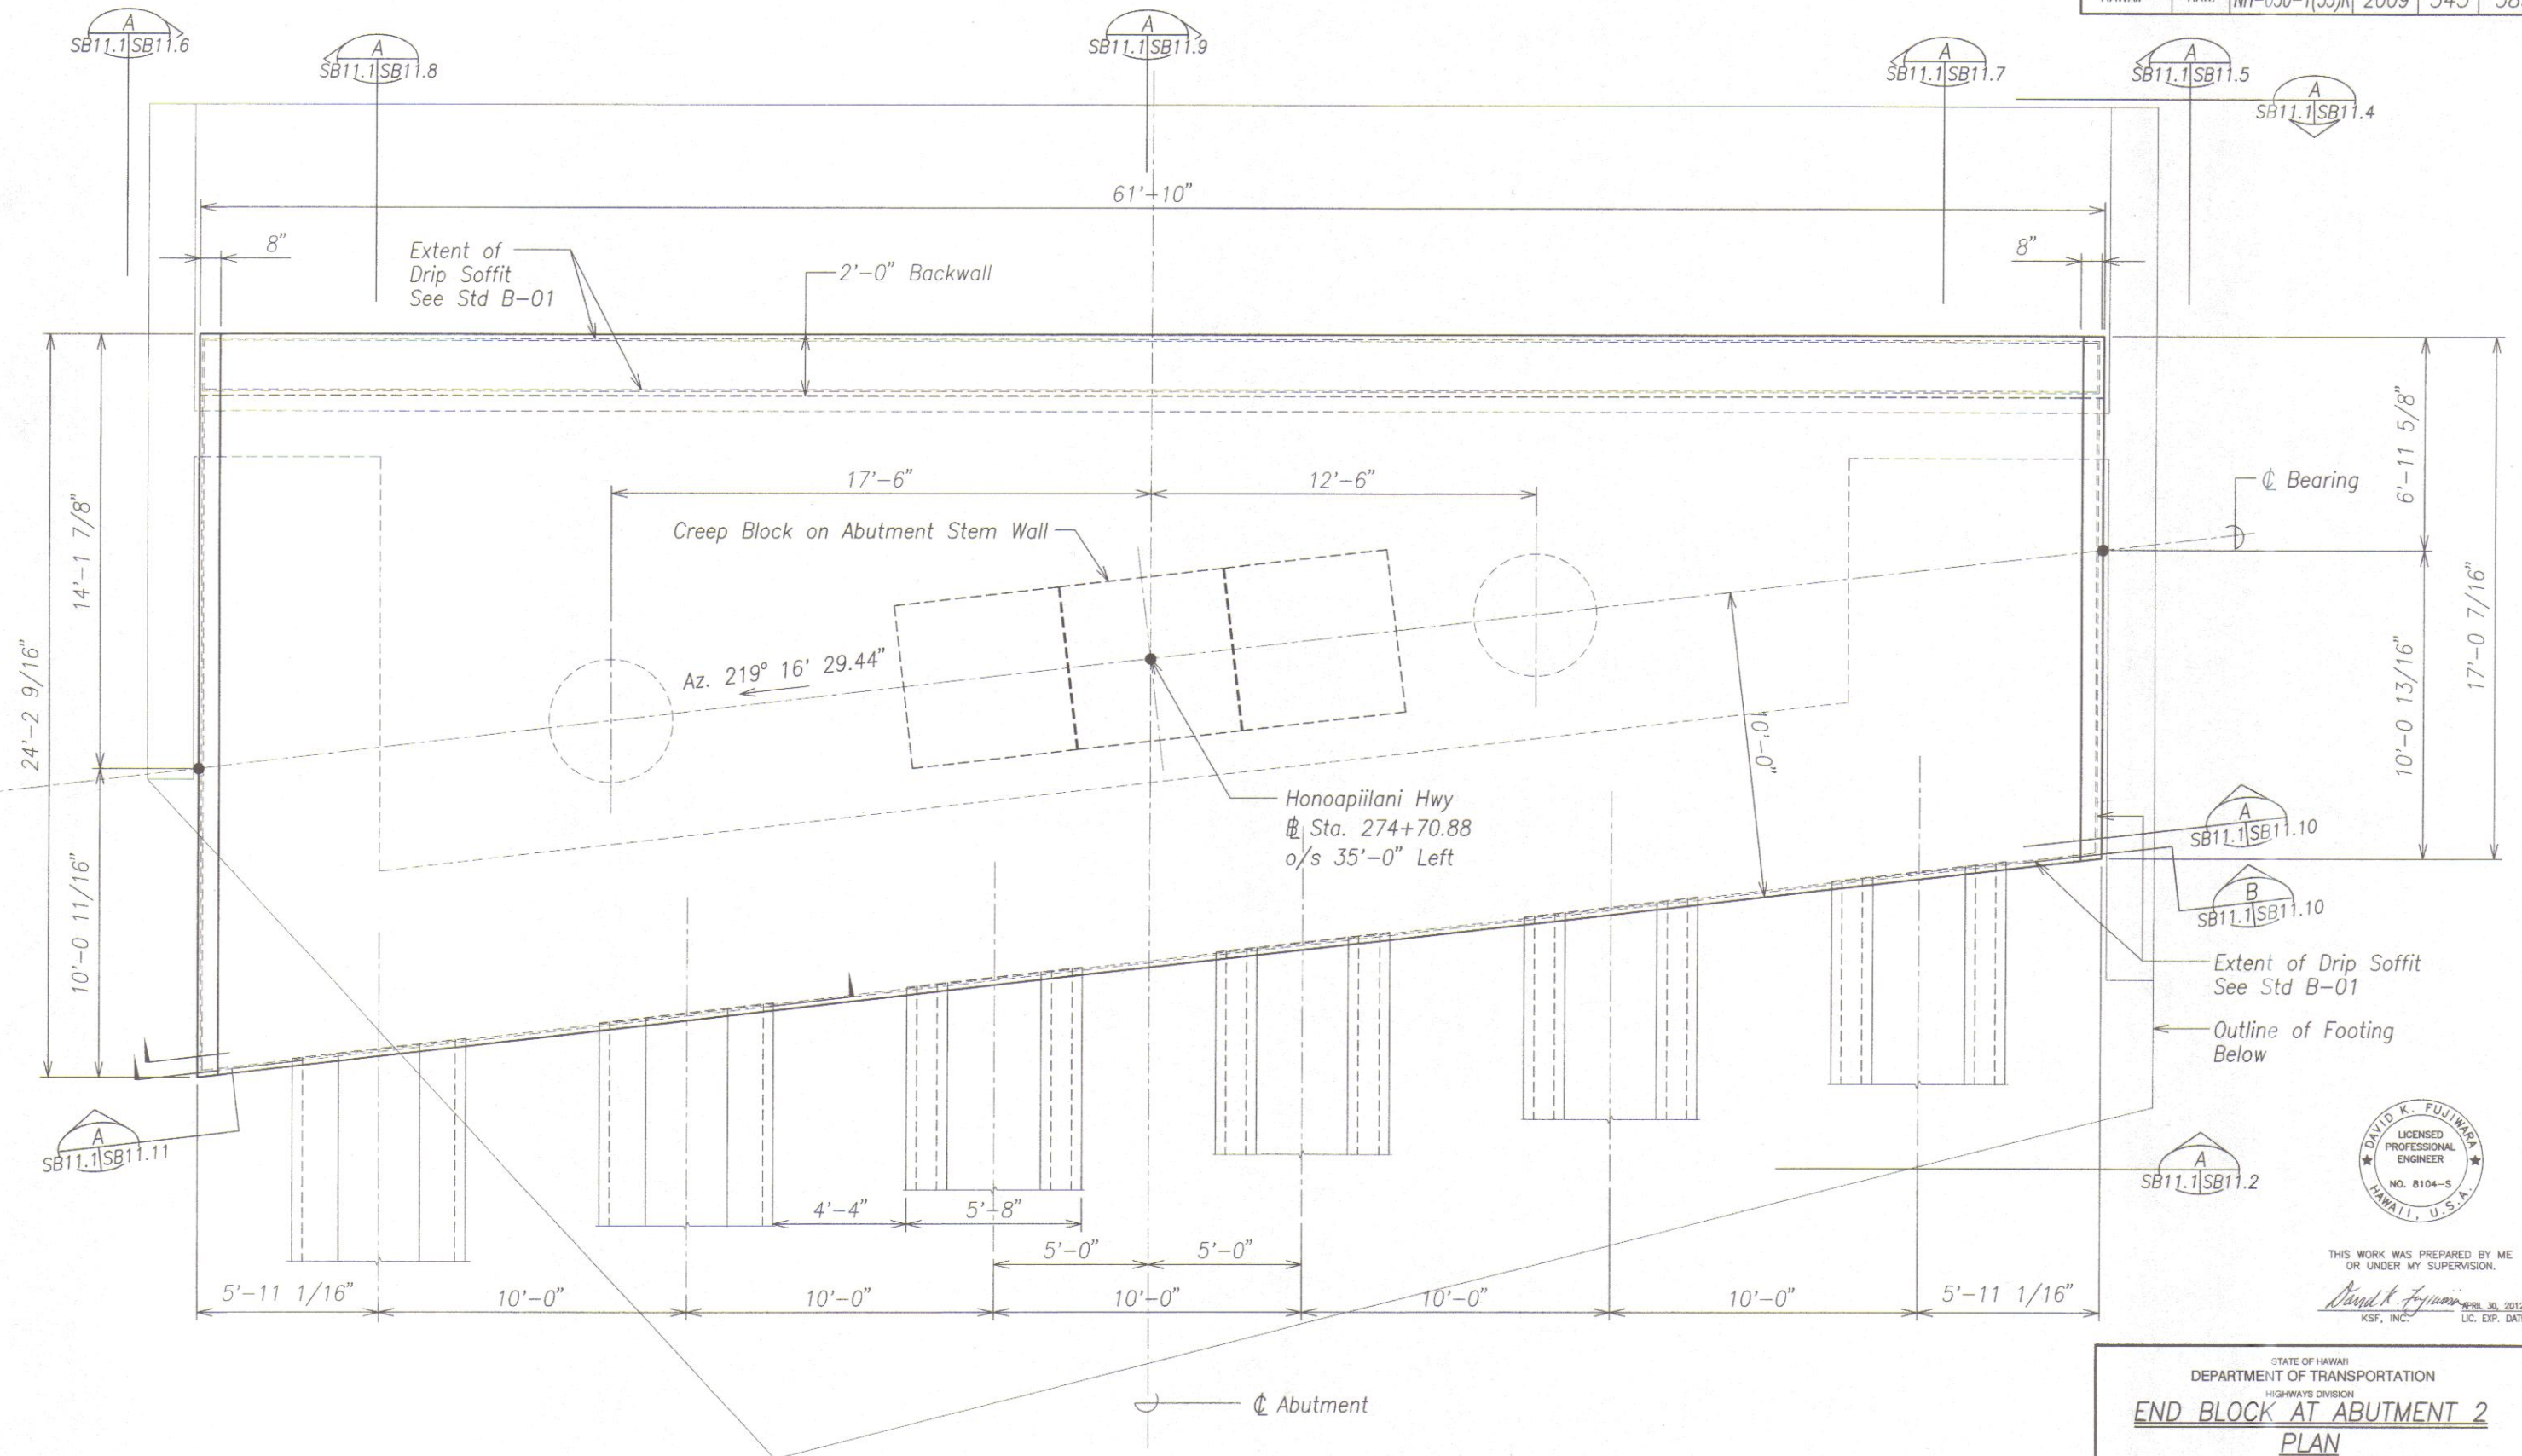

END BLOCK AT ABUTMENT 2 - PLAN
Scale: 3/8" = 1'-0"

A
SB11.1/SB11.1



THIS WORK WAS PREPARED BY ME
OR UNDER MY SUPERVISION.
David K. Fujiwara
KSF, INC. APRIL 30, 2012
LIC. EXP. DATE

STATE OF HAWAII
DEPARTMENT OF TRANSPORTATION
HIGHWAYS DIVISION
END BLOCK AT ABUTMENT 2
PLAN
HONOAPIILANI HIGHWAY REALIGNMENT, PHASE 1A
Future Keawe St Extension to Lahainaluna Rd, Part B
Fed. Aid Proj. No. NH-030-1(35)R
Scale: As Noted Date: June, 2010
SHEET No. SB11.1 OF 11 SHEETS

FINAL DESIGN 345

SURVEY PLOTTED BY	DATE
DRAWN BY	
TRACED BY	
DESIGNED BY	
QUANTITIES BY	
CHECKED BY	

DRAWING NAME: 21.00 ONGOING 40019.0-HONOAPIILANI LAHAINA BYPASS-KAHOMA WD 06-15-10 COMBINE LAHAINA FINAL DESIGN\HLS-SB11.01.DWG PLOT TIME: 06-14-10, 8:18 PM

FED. ROAD DIST. NO.	STATE	FED. AID PROJ. NO.	FISCAL YEAR	SHEET NO.	TOTAL SHEETS
HAWAII	HAW.	NH-030-1(35)R	2009	346	383

SB11.2|SB11.11

SB11.2|SB11.8

SB11.2|SB11.9

SB11.2|SB11.7

SB11.2|SB11.5

SB11.2|SB11.4

#9 @ 6"

Abutment =
End Block

Bearing

Space Extent of #5
Vertical Stirrups @ 6"
EW (Coordinate w/
Sheets SB11.7 and
SB11.8)

#11 @ 6"

#11 @
12 Eq. Spc

#11 @
6 Eq. Spc

2'-3"
Blockout

8"

2'-3"
Blockout

SB11.2|SB11.3

7-#11 Added

3-#11 @ 6"

Abutment

END BLOCK AT ABUTMENT 2 - REINFORCING

Scale: 3/8" = 1'-0"

SB11.2|SB11.2

2/01/11

Revisions

DATE

REVISION

STATE OF HAWAII
DEPARTMENT OF TRANSPORTATION
HIGHWAYS DIVISION

**END BLOCK AT ABUTMENT 2
PLAN - REINFORCING LAYOUT**

HONOAPIILANI HIGHWAY REALIGNMENT, PHASE 1A
Future Keawe St Extension to Lahainaluna Rd, Part B
Fed. Aid Proj. No. NH-030-1(35)R

Scale: As Noted Date: June, 2010

SHEET No. SB11.2 OF 11 SHEETS



THIS WORK WAS PREPARED BY ME
OR UNDER MY SUPERVISION.

KSF, INC. APRIL 30, 2012
LIC. EXP. DATE



FINAL DESIGN

346 RW.

ORIGINAL PLAN	DATE
DRAWN BY	
DESIGNED BY	
CHECKED BY	
NOTE BOOK	
No.	

DRAWING NAME: Z:\00 ONGOING\40019.0-HONOAPIILANI LAHAINA BYPASS-KAHOMA WY\03-30-11 EM END BLOCKS\11-SB11.01.DWG PLOT TIME: 03-30-11, 4:22 PM

FED. ROAD DIST. NO.	STATE	FED. AID PROJ. NO.	FISCAL YEAR	SHEET NO.	TOTAL SHEETS
HAWAII	HAW.	NH-030-1(35)R	2009	346	383

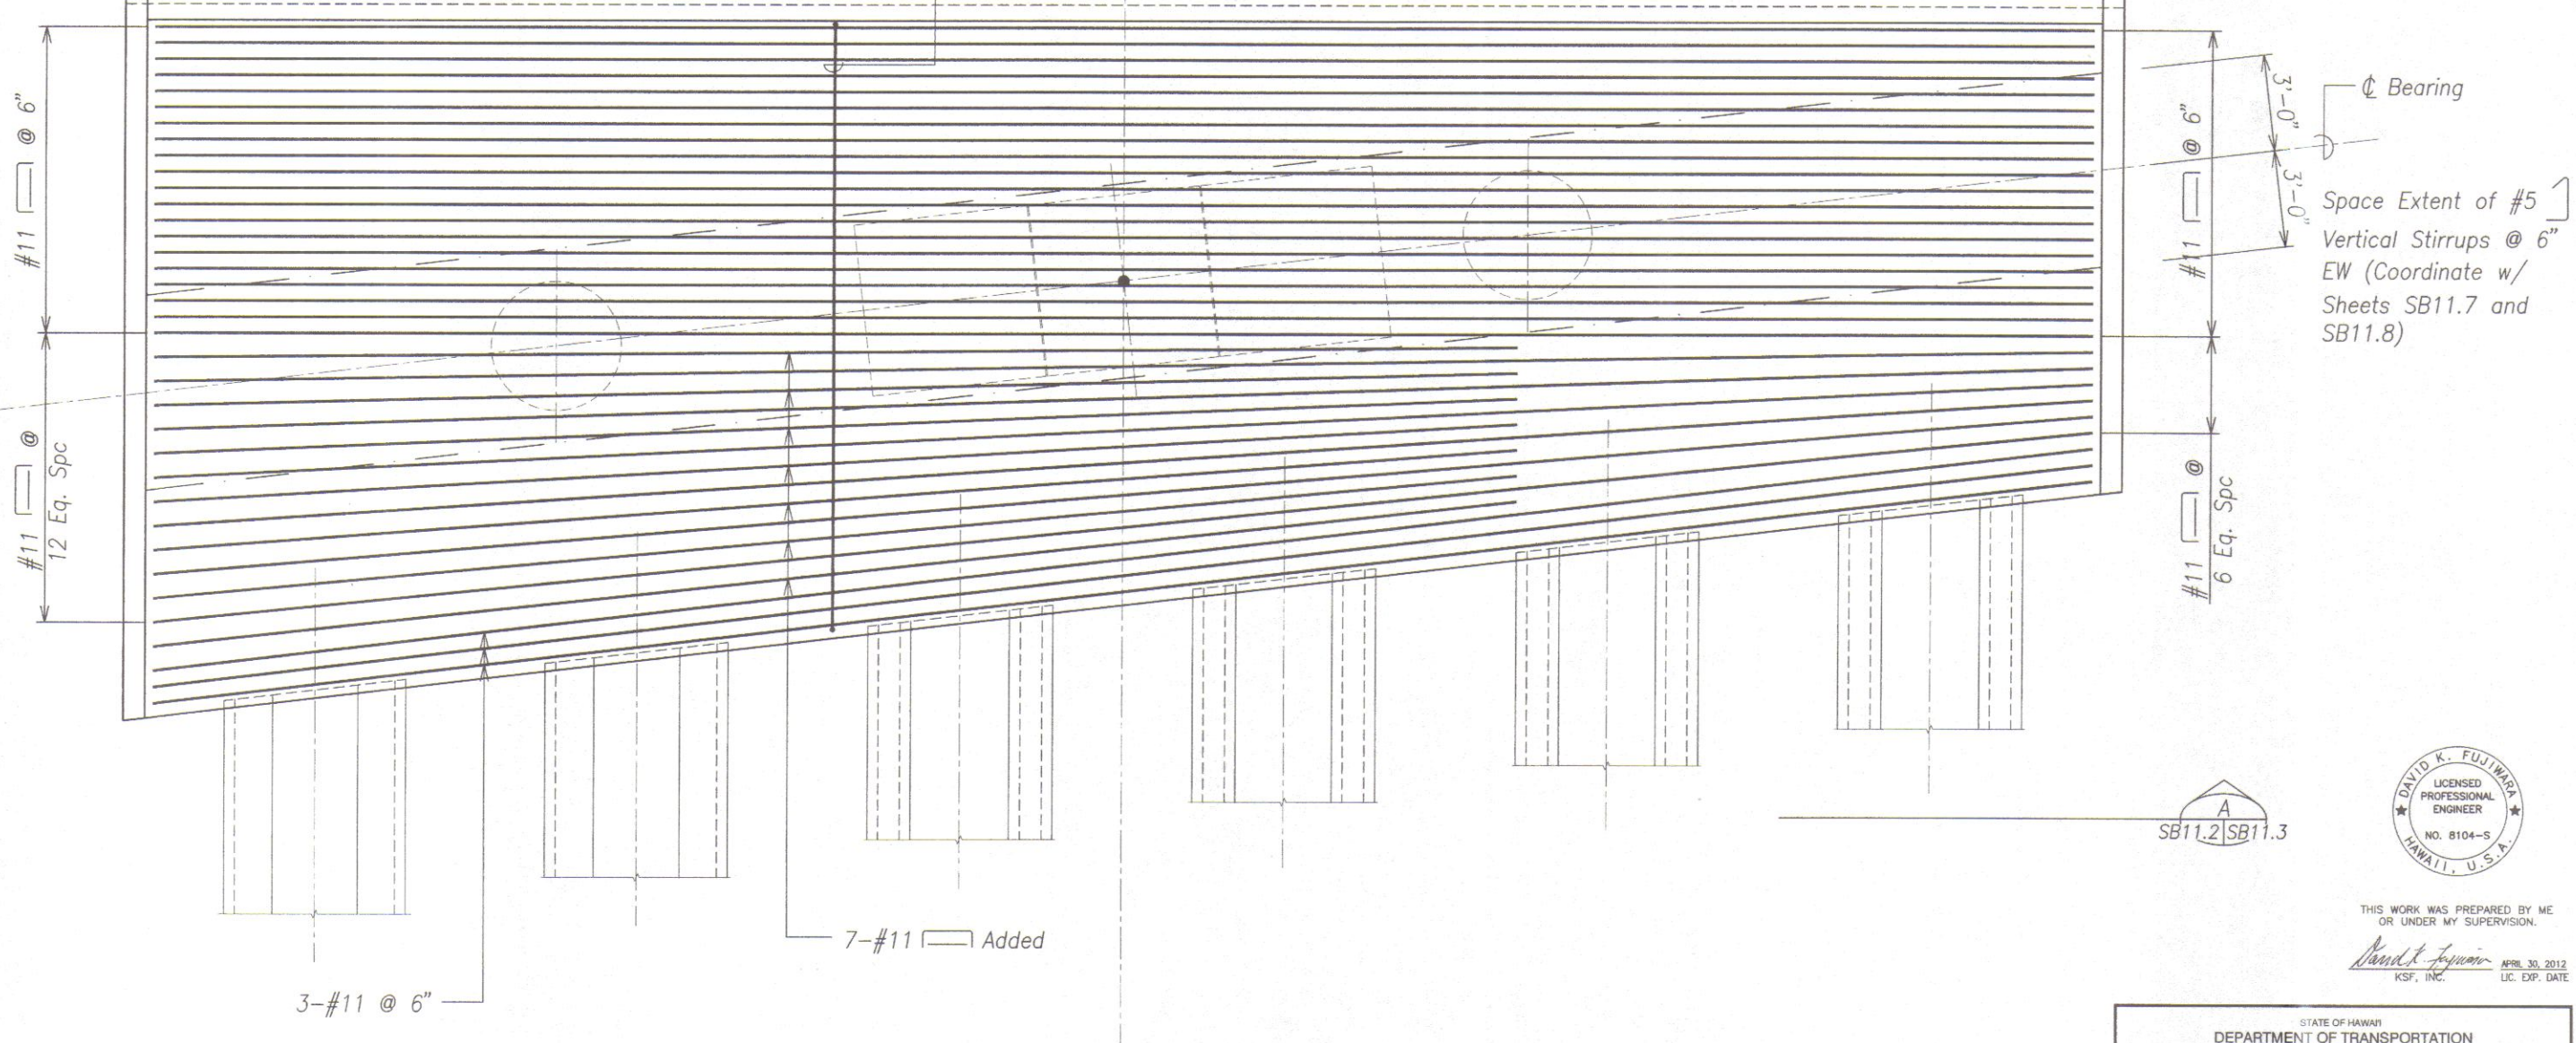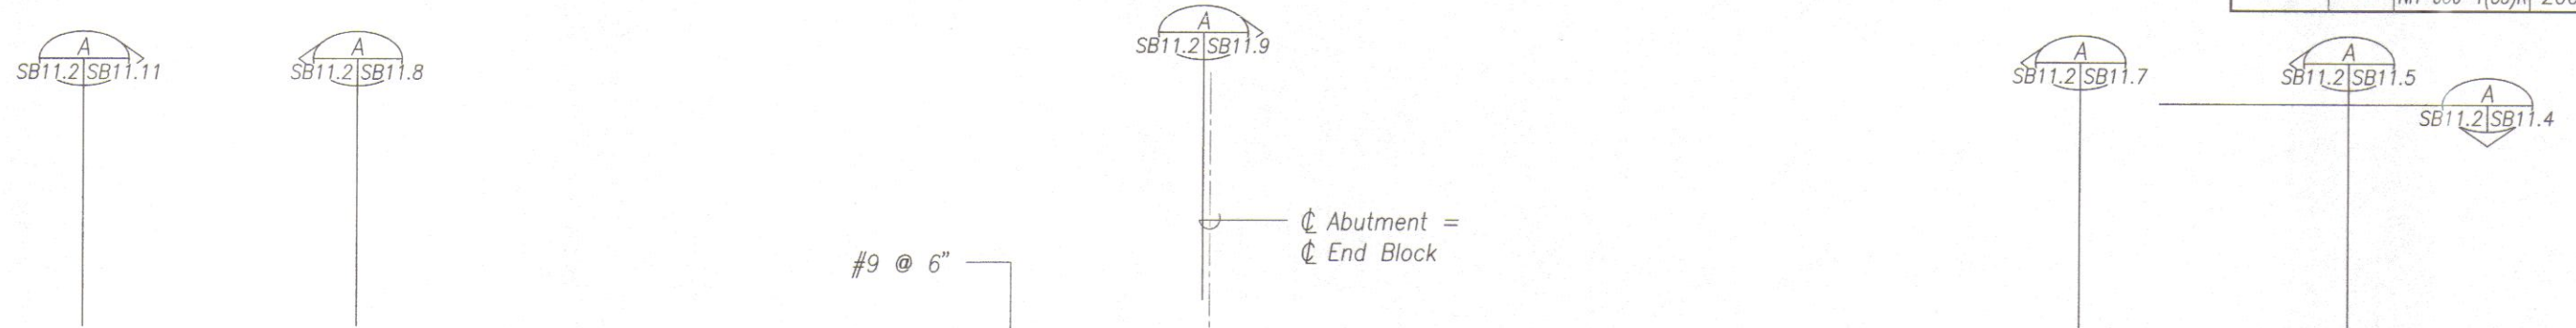

SURVEY PLATTED BY	DATE
DRAWN BY	
DESIGNED BY	
CHECKED BY	
ORIGINAL PLAN	
NOTE BOOK	
No.	

DRAWING NAME: Z:\00 ONGOING\10019.0-HONOAHIKANI LAHANA BYPASS-KAHOMA W06-15-10 COMBINE LAHANA FINAL DESIGN\HH-SB1101.DWG PLOT TIME: 06-14-10, 8:18 PM

END BLOCK AT ABUTMENT 2 - REINFORCING
Scale: 3/8" = 1'-0"




THIS WORK WAS PREPARED BY ME OR UNDER MY SUPERVISION.
David K. Fujimura
KSF, INC. APRIL 30, 2012 LIC. EXP. DATE

STATE OF HAWAII
DEPARTMENT OF TRANSPORTATION
HIGHWAYS DIVISION
END BLOCK AT ABUTMENT 2
PLAN - REINFORCING LAYOUT
HONOAHIKANI HIGHWAY REALIGNMENT, PHASE 1A
Future Keawe St Extension to Lahainaluna Rd, Part B
Fed. Aid Proj. No. NH-030-1(35)R
Scale: As Noted Date: June, 2010
SHEET No. SB11.2 OF 11 SHEETS

FINAL DESIGN 346

FED. ROAD DIST. NO.	STATE	FED. AID PROJ. NO.	FISCAL YEAR	SHEET NO.	TOTAL SHEETS
HAWAII	HAW.	NH-030-1(35)R	2009	347	383

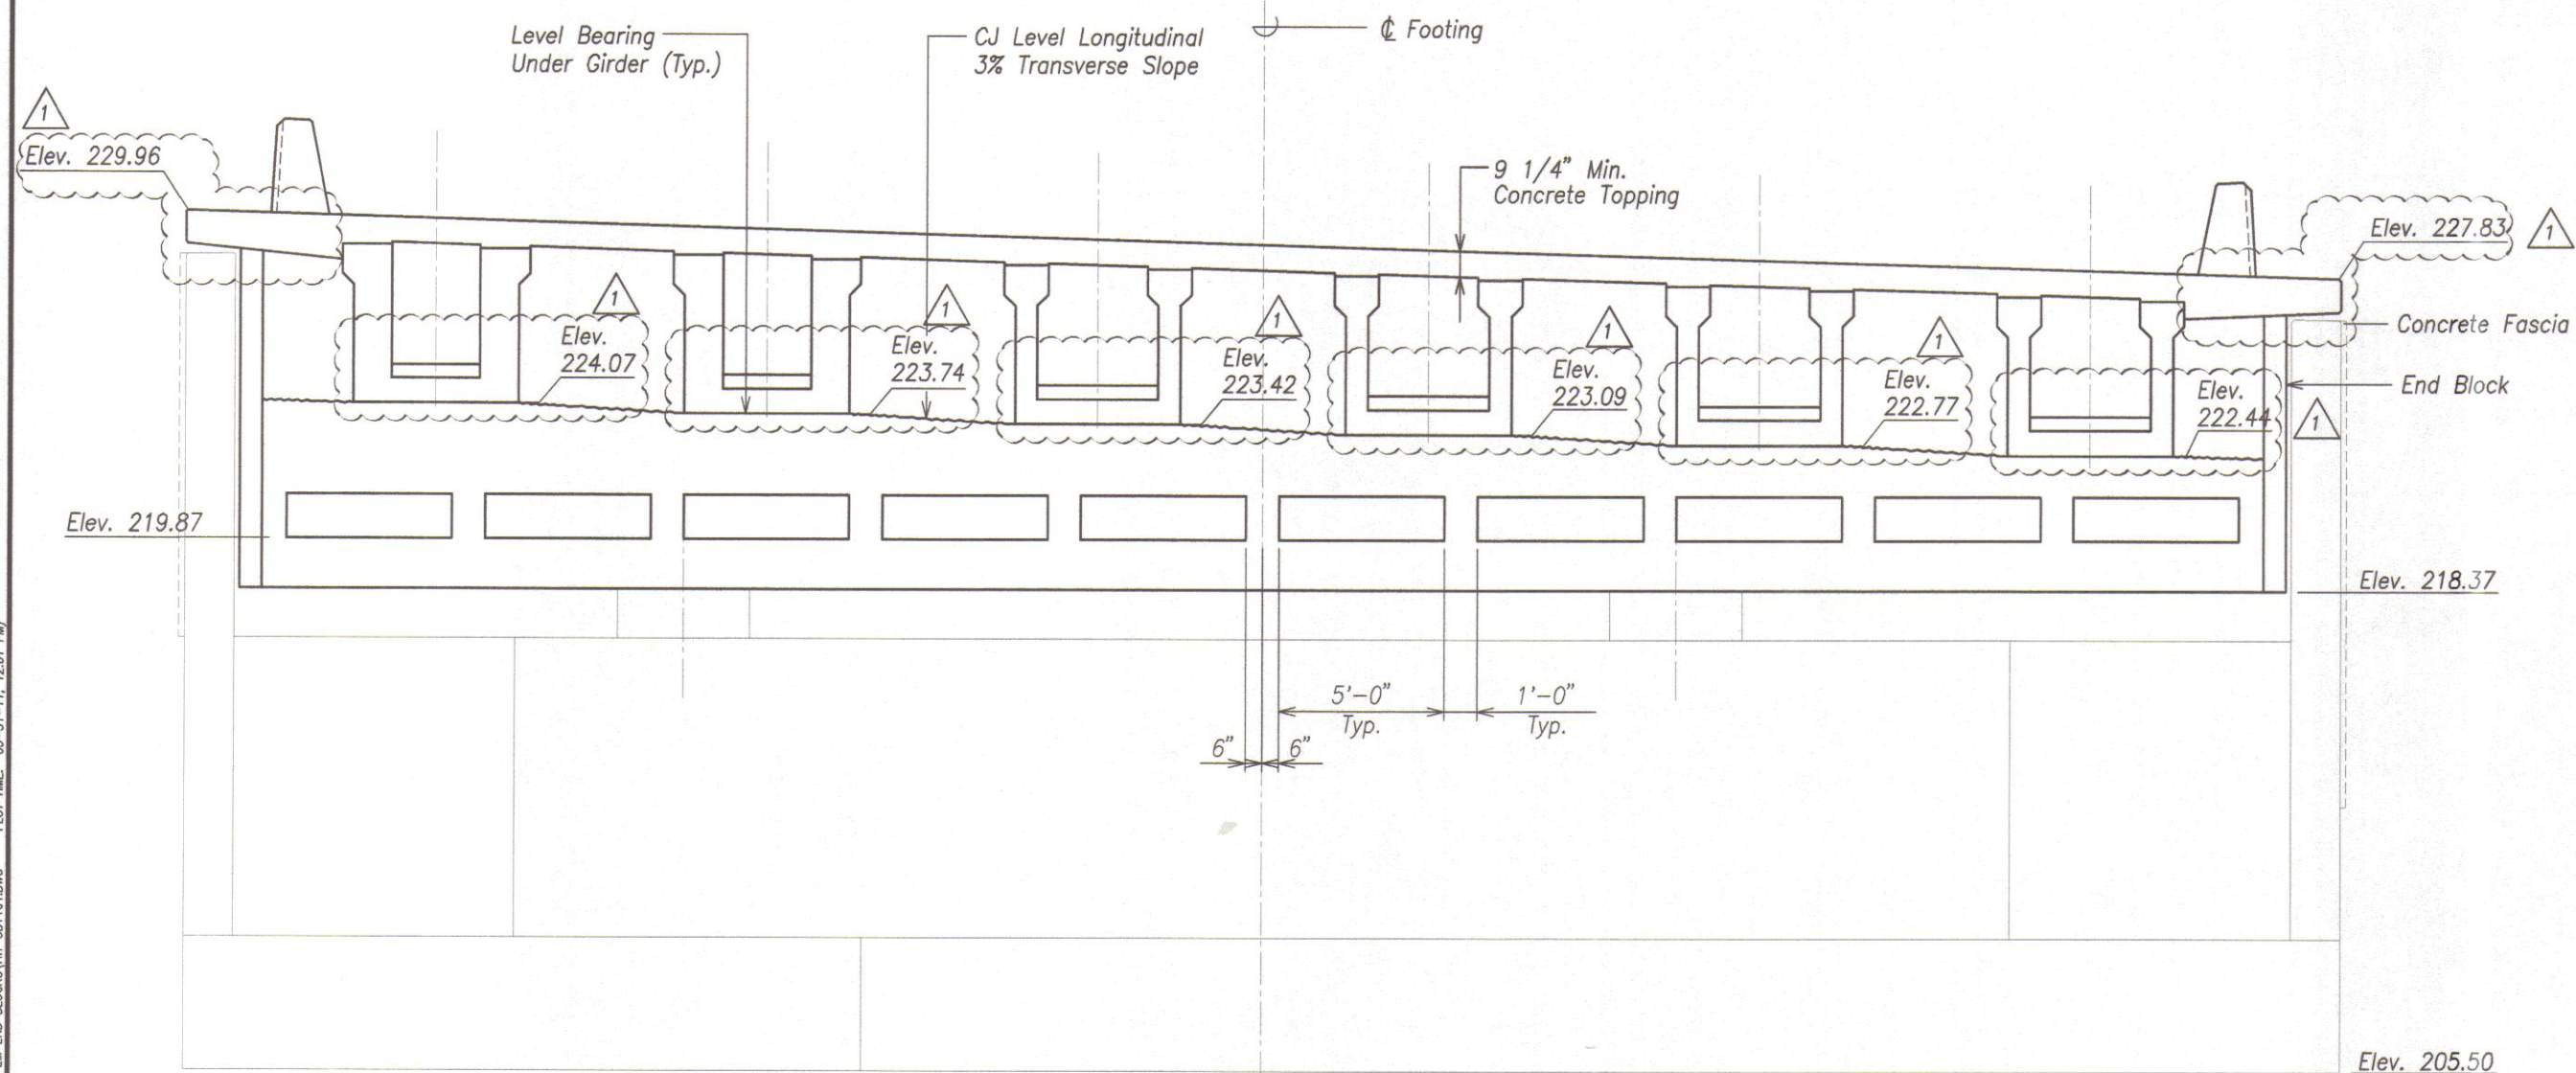

NOTE:

View shown is perpendicular to Girders and Precast Arch Tie Planks.

END BLOCK AT ABUTMENT 2 - FRONT ELEVATION
Scale: 3/8" = 1'-0"

SB11.2
A
SB11.1 SB11.3




THIS WORK WAS PREPARED BY ME OR UNDER MY SUPERVISION.

KSF, INC. APRIL 30, 2012 LIC. EXP. DATE

STATE OF HAWAII
DEPARTMENT OF TRANSPORTATION
HIGHWAYS DIVISION
END BLOCK AT ABUTMENT 2
FRONT ELEVATION
HONOAPIILANI HIGHWAY REALIGNMENT, PHASE 1A
Future Keawe St Extension to Lahainaluna Rd, Part B
Fed. Aid Proj. No. NH-030-1(35)R
Scale: As Noted Date: June, 2010
SHEET No. SB11.3 OF 11 SHEETS

DATE	REVISION
2/01/11	1 Revisions

FED. ROAD DIST. NO.	STATE	FED. AID PROJ. NO.	FISCAL YEAR	SHEET NO.	TOTAL SHEETS
HAWAII	HAW.	NH-030-1(35)R	2009	347	383

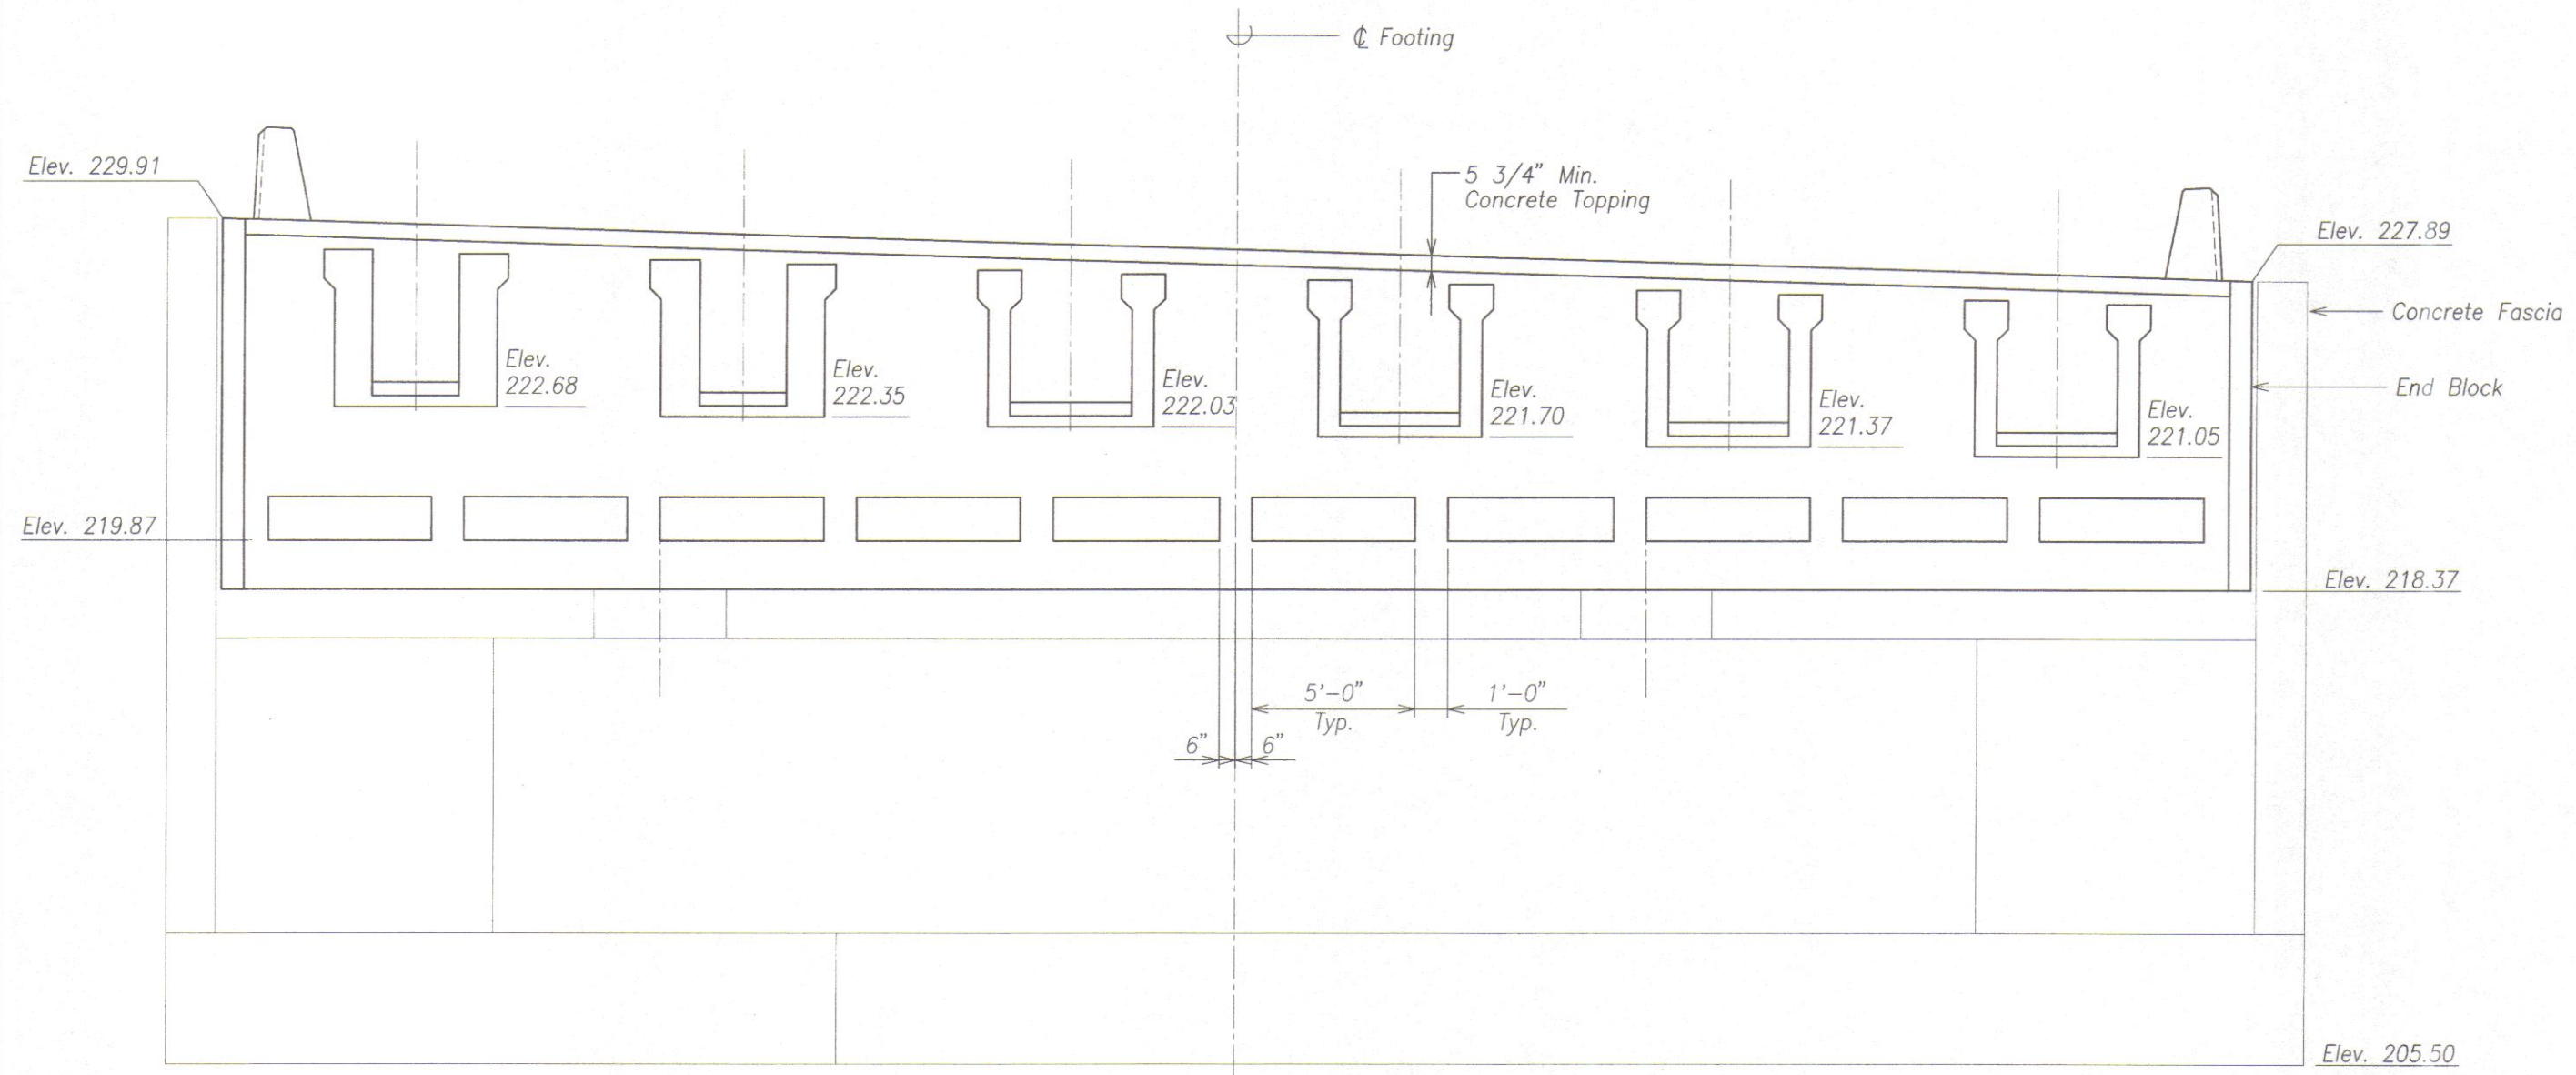

NOTE:

View shown is perpendicular to Girders and Precast Arch Tie Planks.

END BLOCK AT ABUTMENT 2 - FRONT ELEVATION

Scale: 3/8" = 1'-0"

SB11.2 A SB11.1 SB11.3



THIS WORK WAS PREPARED BY ME OR UNDER MY SUPERVISION.

David K. Fujiwara APRIL 30, 2012
KSF, INC. LIC. EXP. DATE

STATE OF HAWAII
DEPARTMENT OF TRANSPORTATION
HIGHWAYS DIVISION

**END BLOCK AT ABUTMENT 2
FRONT ELEVATION**

HONOAPIILANI HIGHWAY REALIGNMENT, PHASE 1A
Future Keawe St Extension to Lahainaluna Rd, Part B
Fed. Aid Proj. No. NH-030-1(35)R

Scale: As Noted Date: June, 2010


SHEET No. SB11.3 OF 11 SHEETS

FINAL DESIGN 347 Rev.

ORIGINAL PLAN	DATE
SURVEY PLOTTED BY	
DRAWN BY	
DESIGNED BY	
QUANTITIES BY	
CHECKED BY	
No.	

DRAWING NAME: Z:\00 ONGOING\40019.0-HONOAPIILANI LAHAINA BYPASS-KAHOMA WO\06-15-10 COMBINE LAHAINA FINAL DESIGN\11-SB11.01.DWG PLOT TIME: 06-14-10, 8:18 PM

FED. ROAD DIST. NO.	STATE	FED. AID PROJ. NO.	FISCAL YEAR	SHEET NO.	TOTAL SHEETS
HAWAII	HAW.	NH-030-1(35)R	2009	348	383

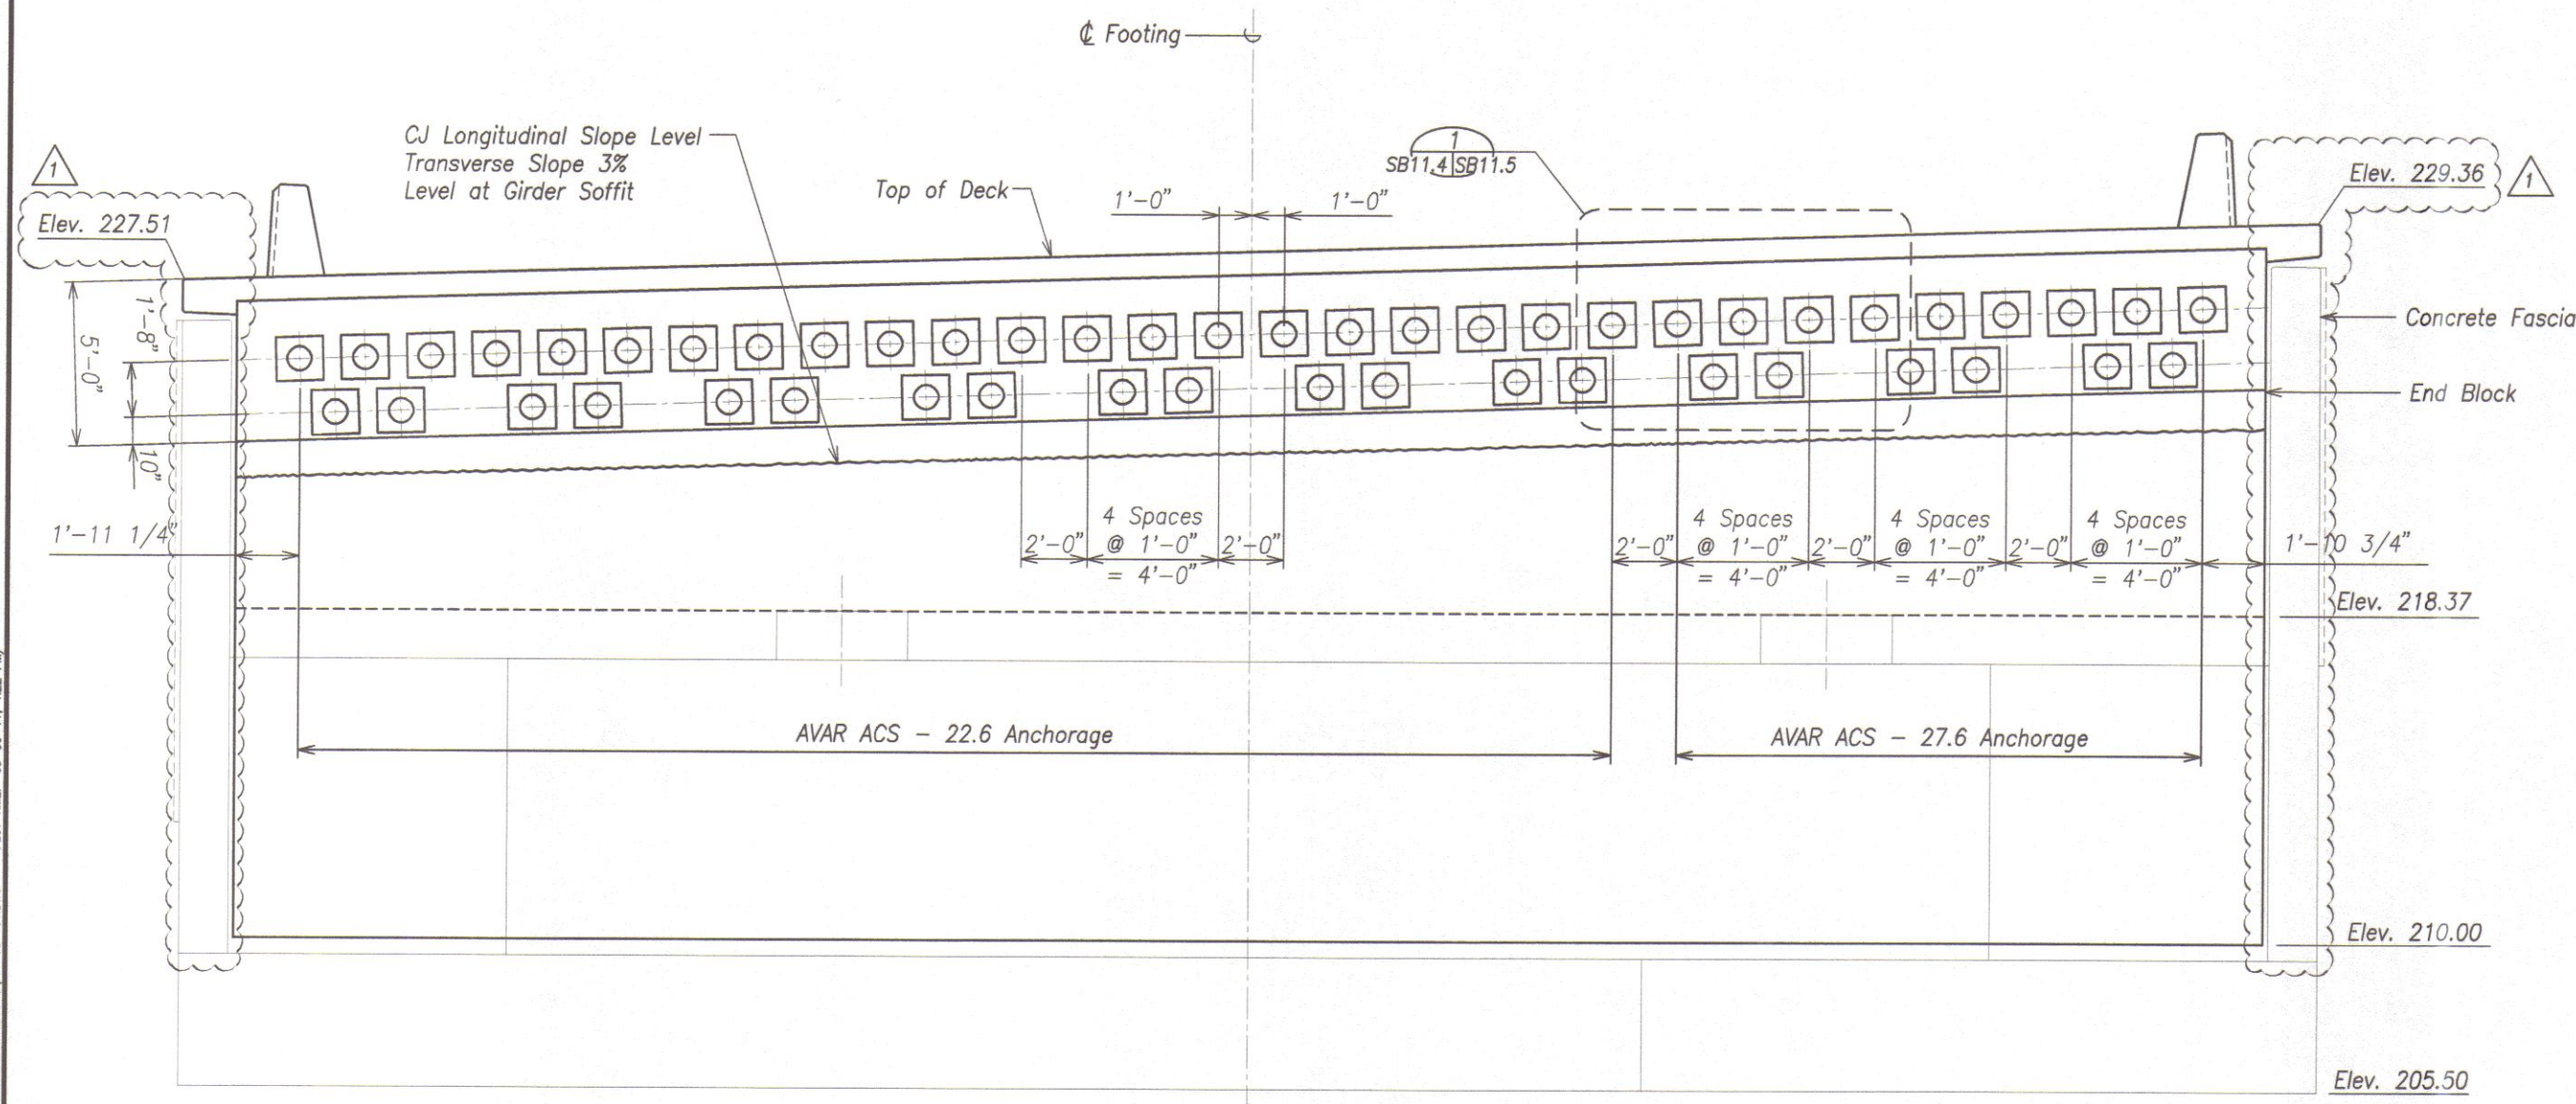

END BLOCK AT ABUTMENT 2 – BACK ELEVATION
 Scale: 3/8" = 1'-0"
 SB11.1|SB11.4



THIS WORK WAS PREPARED BY ME
 OR UNDER MY SUPERVISION.
 KSF, INC. APRIL 30, 2012
 LIC. EXP. DATE

DESIGNED BY	DATE
CHECKED BY	
NOTED BY	
ORIGINAL PLAN	


DRAWING NAME: Z:\00 ONGOING\0019.0-HONOPILANI LAHANA BYPASS-KAHOMA WD\03-30-11 EM END BLOCKS\HH-SB11.0.DWG PLOT TIME: 03-30-11, 4:22 PM

DATE	REVISION
2/01/11	1 Revisions


STATE OF HAWAII
 DEPARTMENT OF TRANSPORTATION
 HIGHWAYS DIVISION

END BLOCK AT ABUTMENT 2
BACK ELEVATION
 HONOPILANI HIGHWAY REALIGNMENT, PHASE 1A
 Future Keawe St Extension to Lahainaluna Rd, Part B
 Fed. Aid Proj. No. NH-030-1(35)R
 Scale: As Noted Date: June, 2010
 SHEET No. SB11.4 OF 11 SHEETS

FED. ROAD DIST. NO.	STATE	FED. AID PROJ. NO.	FISCAL YEAR	SHEET NO.	TOTAL SHEETS
HAWAII	HAW.	NH-030-1(35)R	2009	348	383

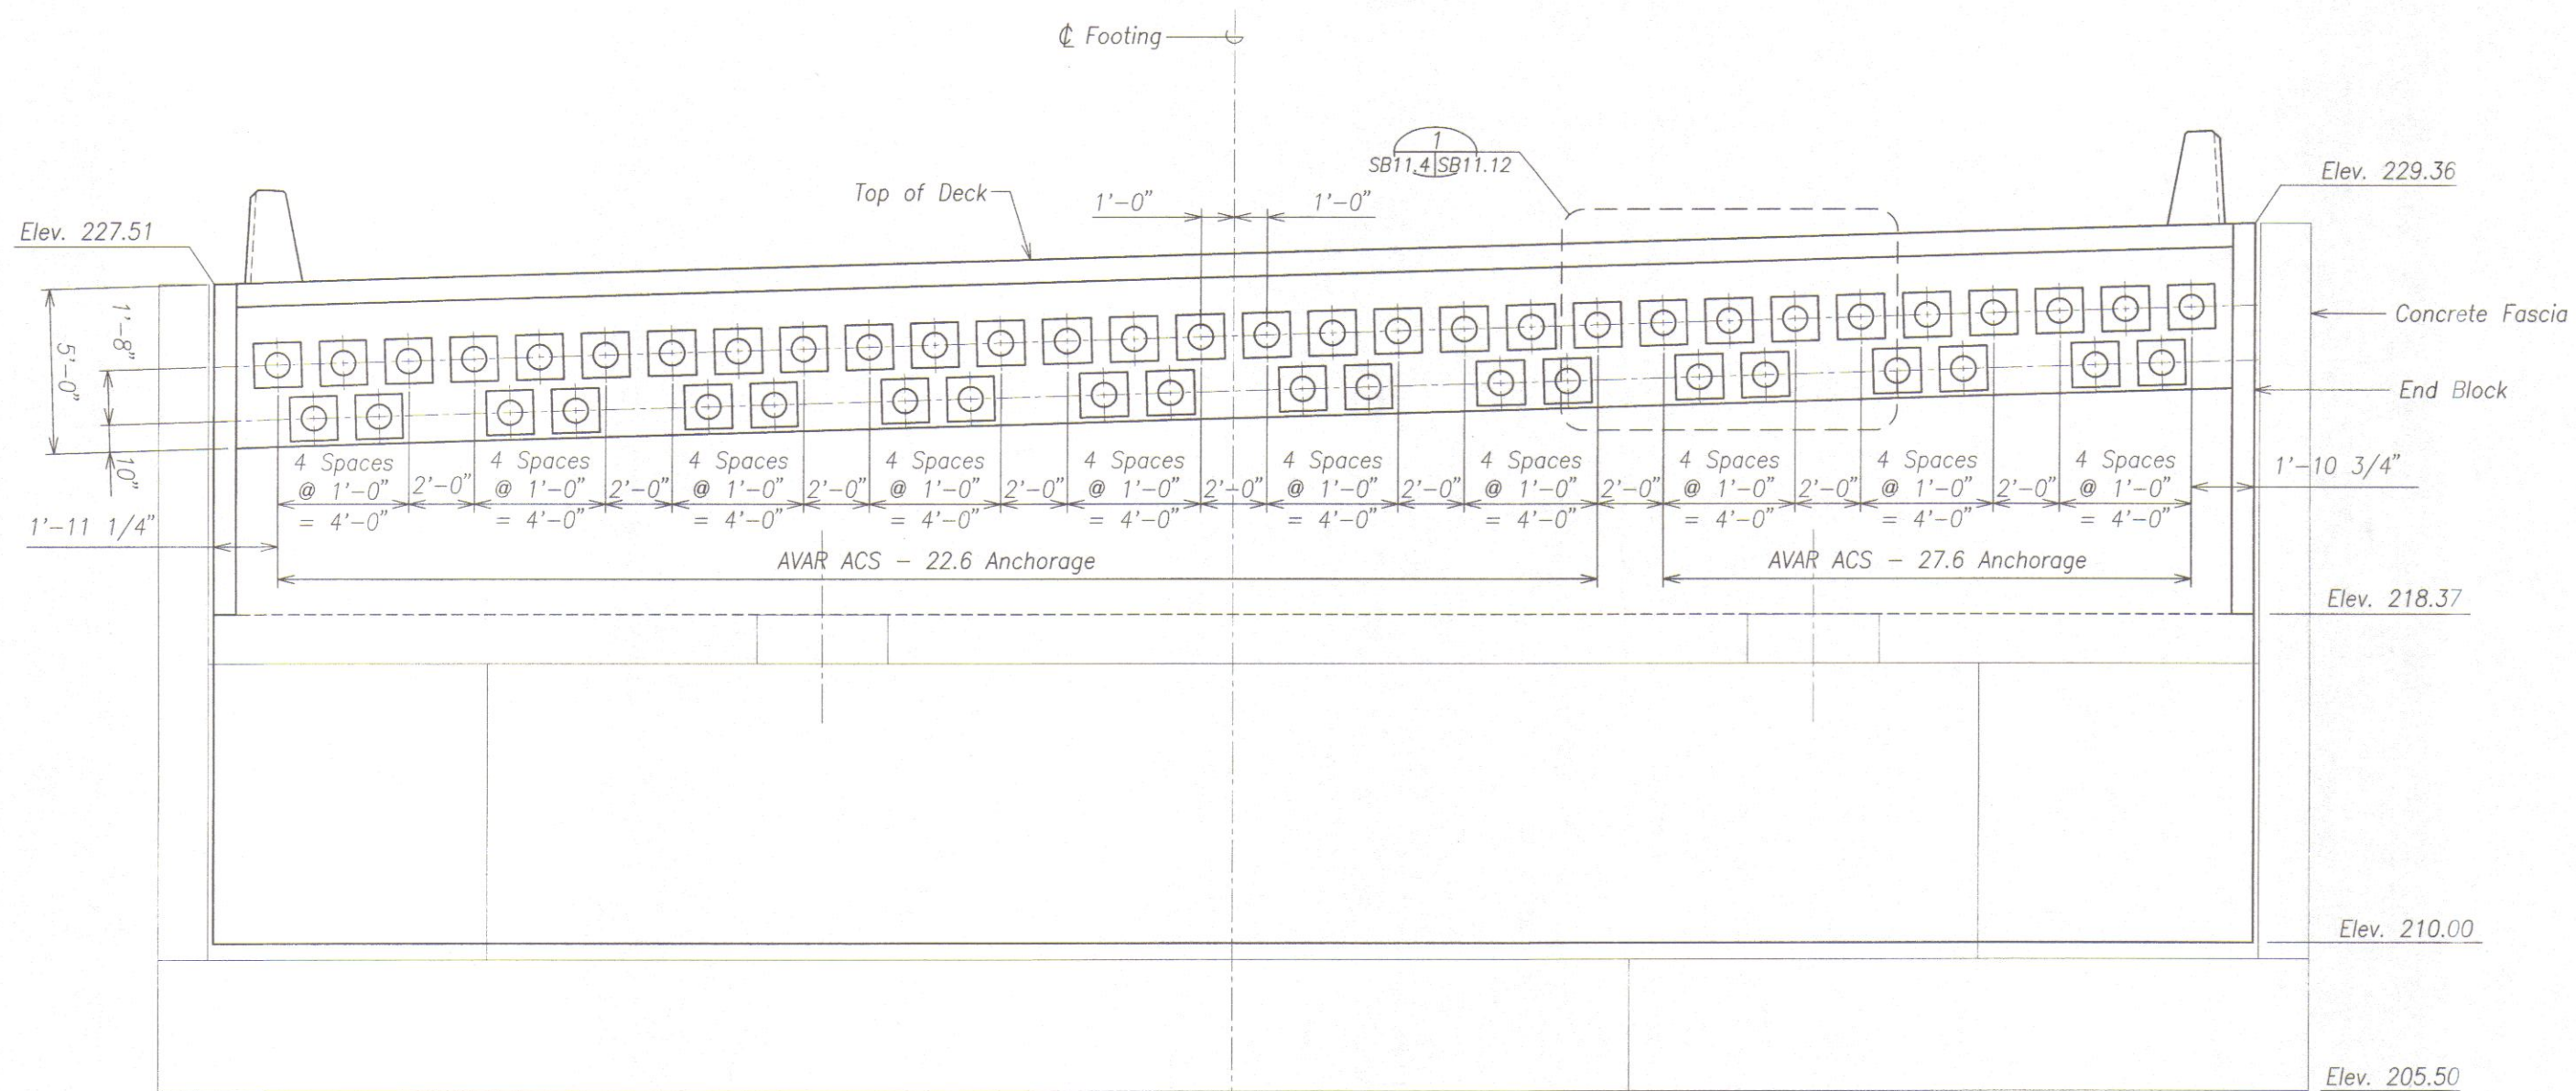

END BLOCK AT ABUTMENT 2 - BACK ELEVATION
Scale: 3/8" = 1'-0"

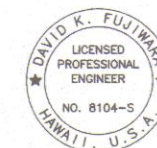

THIS WORK WAS PREPARED BY ME
OR UNDER MY SUPERVISION.

David K. Fujiwara
KSF, INC. APRIL 30, 2012
LIC. EXP. DATE


STATE OF HAWAII DEPARTMENT OF TRANSPORTATION HIGHWAYS DIVISION	
END BLOCK AT ABUTMENT 2 BACK ELEVATION	
HONOAPIILANI HIGHWAY REALIGNMENT, PHASE 1A Future Keawe St Extension to Lahainaluna Rd, Part B Fed. Aid Proj. No. NH-030-1(35)R	
Scale: As Noted	Date: June, 2010
SHEET No. SB11.4 OF 11 SHEETS	

FINAL DESIGN 348 *rev.*

ORIGINAL PLAN	SURVEY PLOTTED BY	DATE
NOTE BOOK	DRAWN BY	
No.	DESIGNED BY	
	CHECKED BY	

DRAWING NAME: 2:00 ONCONG\40019.0-HONOAPIILANI LAHAINA BYPASS-KAHOMA WO\06-15-10 COMBINE LAHAINA FINAL DESIGN\HH-SB11.01.DWG PLOT TIME: 06-14-10, 8:19 PM

FED. ROAD DIST. NO.	STATE	FED. AID PROJ. NO.	FISCAL YEAR	SHEET NO.	TOTAL SHEETS
HAWAII	HAW.	NH-030-1(35)R	2009	349	383

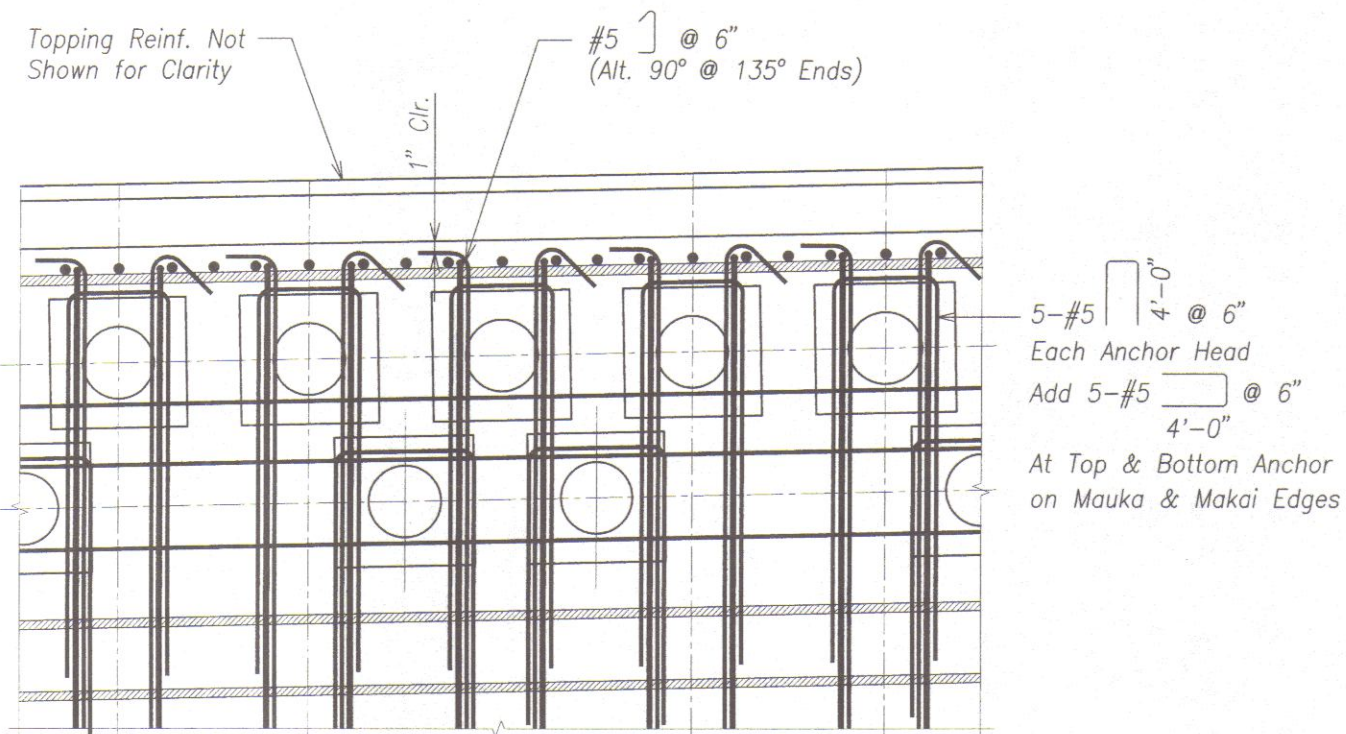

DETAIL
Scale: 1" = 1'-0" SB11.4 SB11.5

ORIGINAL PLAN	SURVEY PLOTTED BY	DATE
NOTE BOOK	DRAWN BY	
No.	DESIGNED BY	
	QUANTITIES BY	
	CHECKED BY	

DRAWING NAME: Z:\00 ONGOING\40019.0-HONOAPIILANI LAHAINA BYPASS-KAHOMA WO\06-15-10 COMBINE LAHAINA FINAL DESIGN\HH-SB1105.DWG PLOT TIME: 06-14-10, 8:19 PM




THIS WORK WAS PREPARED BY ME
OR UNDER MY SUPERVISION.

David K. Fujiwara
KSF, INC. APRIL 30, 2012
LIC. EXP. DATE

STATE OF HAWAII DEPARTMENT OF TRANSPORTATION HIGHWAYS DIVISION
END BLOCK AT ABUTMENT 2
DETAIL
HONOAPIILANI HIGHWAY REALIGNMENT, PHASE 1A
Future Keawe St Extension to Lahainaluna Rd, Part B
Fed. Aid Proj. No. NH-030-1(35)R
Scale: As Noted Date: June, 2010
SHEET No. SB11.5 OF 11 SHEETS

FINAL DESIGN 349

FED. ROAD DIST. NO.	STATE	FED. AID PROJ. NO.	FISCAL YEAR	SHEET NO.	TOTAL SHEETS
HAWAII	HAW.	NH-030-1(35)R	2009	350	383

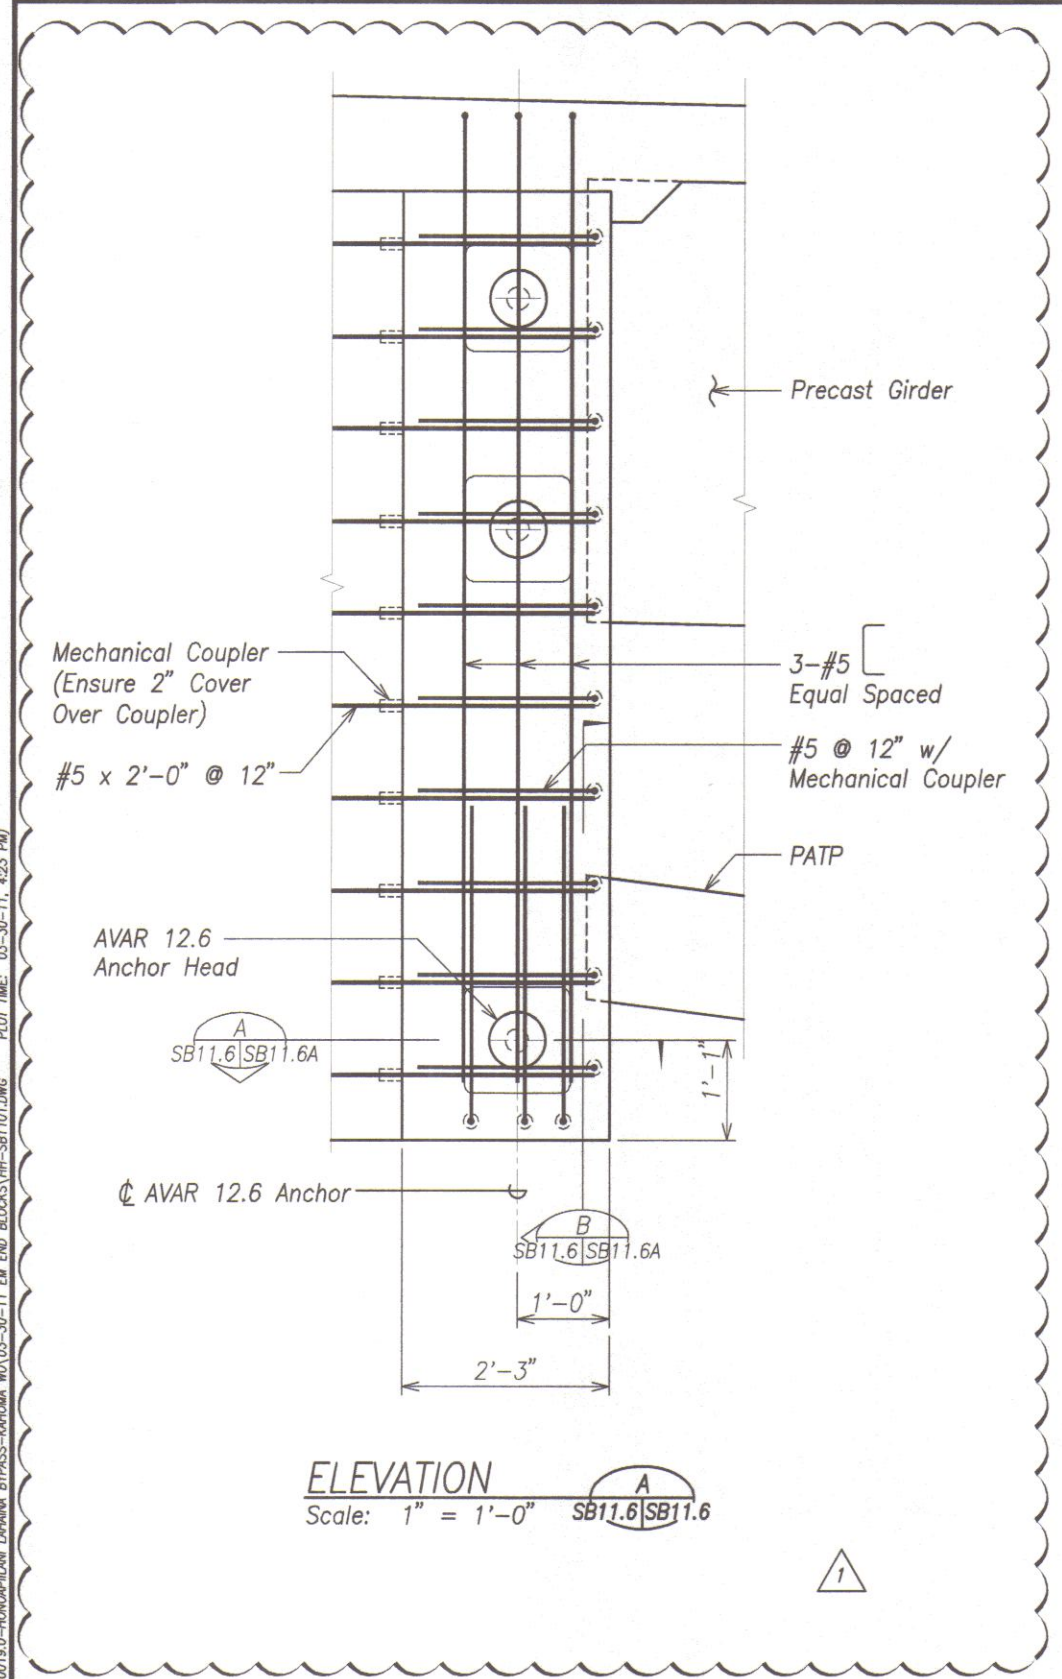

SURVEY PLOTTED BY	DATE
DRAWN BY	
TRACED BY	
NOTE BOOK	
QUANTITIES BY	
CHECKED BY	

DRAWING NAME: 21.00 ONCONING 40019.0-HONOAPILANI LAHAINA BYPASS-KAHOMA WD 03-30-11 EM END BLOCKS\HH-SB1101.DWG PLOT TIME: 03-30-11, 4:23 PM



THIS WORK WAS PREPARED BY ME OR UNDER MY SUPERVISION.


KSF, INC. APRIL 30, 2012 LC. EXP. DATE

STATE OF HAWAII
DEPARTMENT OF TRANSPORTATION
HIGHWAYS DIVISION

SECTION AT 12x0.6 PT ANCHORS
HONOAPILANI HIGHWAY REALIGNMENT, PHASE 1A
Future Keawe St Extension to Lahainaluna Rd, Part B
Fed. Aid Proj. No. NH-030-1(35)R
Scale: As Noted Date: June, 2010
SHEET No. SB11.6 OF 11 SHEETS

2/01/11	1 Revisions
DATE	REVISION

FED. ROAD DIST. NO.	STATE	FED. AID PROJ. NO.	FISCAL YEAR	SHEET NO.	TOTAL SHEETS
HAWAII	HAW.	NH-030-1(35)R	2009	350	383

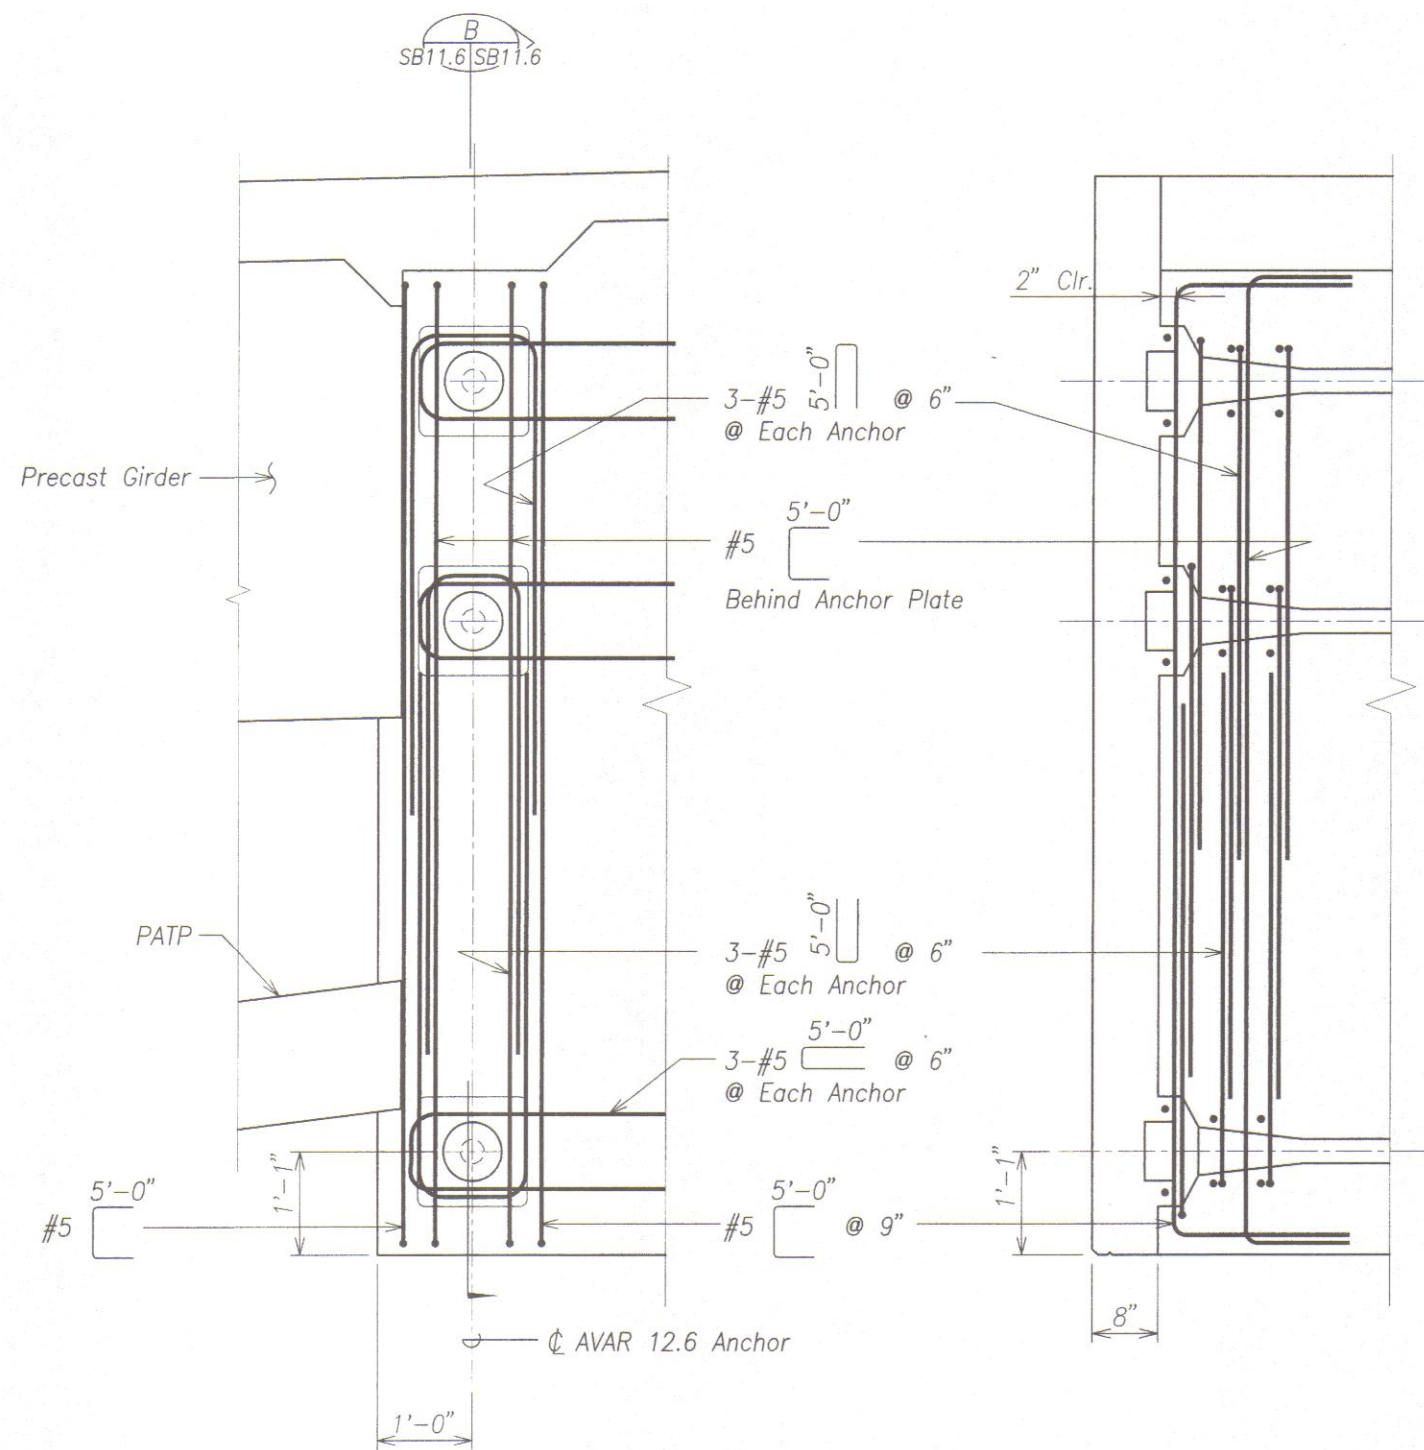

ELEVATION
Scale: 1" = 1'-0" SB11.6 SB11.6

SECTION
Scale: 1" = 1'-0" SB11.6 SB11.6



THIS WORK WAS PREPARED BY ME OR UNDER MY SUPERVISION.

David K. Fujiwara
KSF, INC. APRIL 30, 2012
LIC. EXP. DATE

STATE OF HAWAII
DEPARTMENT OF TRANSPORTATION
HIGHWAYS DIVISION

SECTION AT 12x0.6 PT ANCHORS

HONOLULU HIGHWAY REALIGNMENT, PHASE 1A
Future Keawe St Extension to Lahaina Rd, Part B
Fed. Aid Proj. No. NH-030-1(35)R

Scale: As Noted Date: June, 2010



SHEET No. SB11.6 OF 11 SHEETS

FINAL DESIGN 350 Rev.

ORIGINAL PLAN	SURVEY PLOTTED BY	DATE
NOTE BOOK	DRAWN BY	
No.	DESIGNED BY	
	CHECKED BY	

DRAWING NAME: 2100 ONCONING 40019.0-HONOLULU HIGHWAY REALIGNMENT, PHASE 1A, BYPASS-KAHUNA RD 06-15-10 COMBINE LANAHA FINAL DESIGN (HAWAII) SB11.6.DWG PLOT TIME: 06-14-10, 8:20 PM

FED. ROAD DIST. NO.	STATE	FED. AID PROJ. NO.	FISCAL YEAR	SHEET NO.	TOTAL SHEETS
HAWAII	HAW.	NH-030-1(35)R	2009	350S-1	383

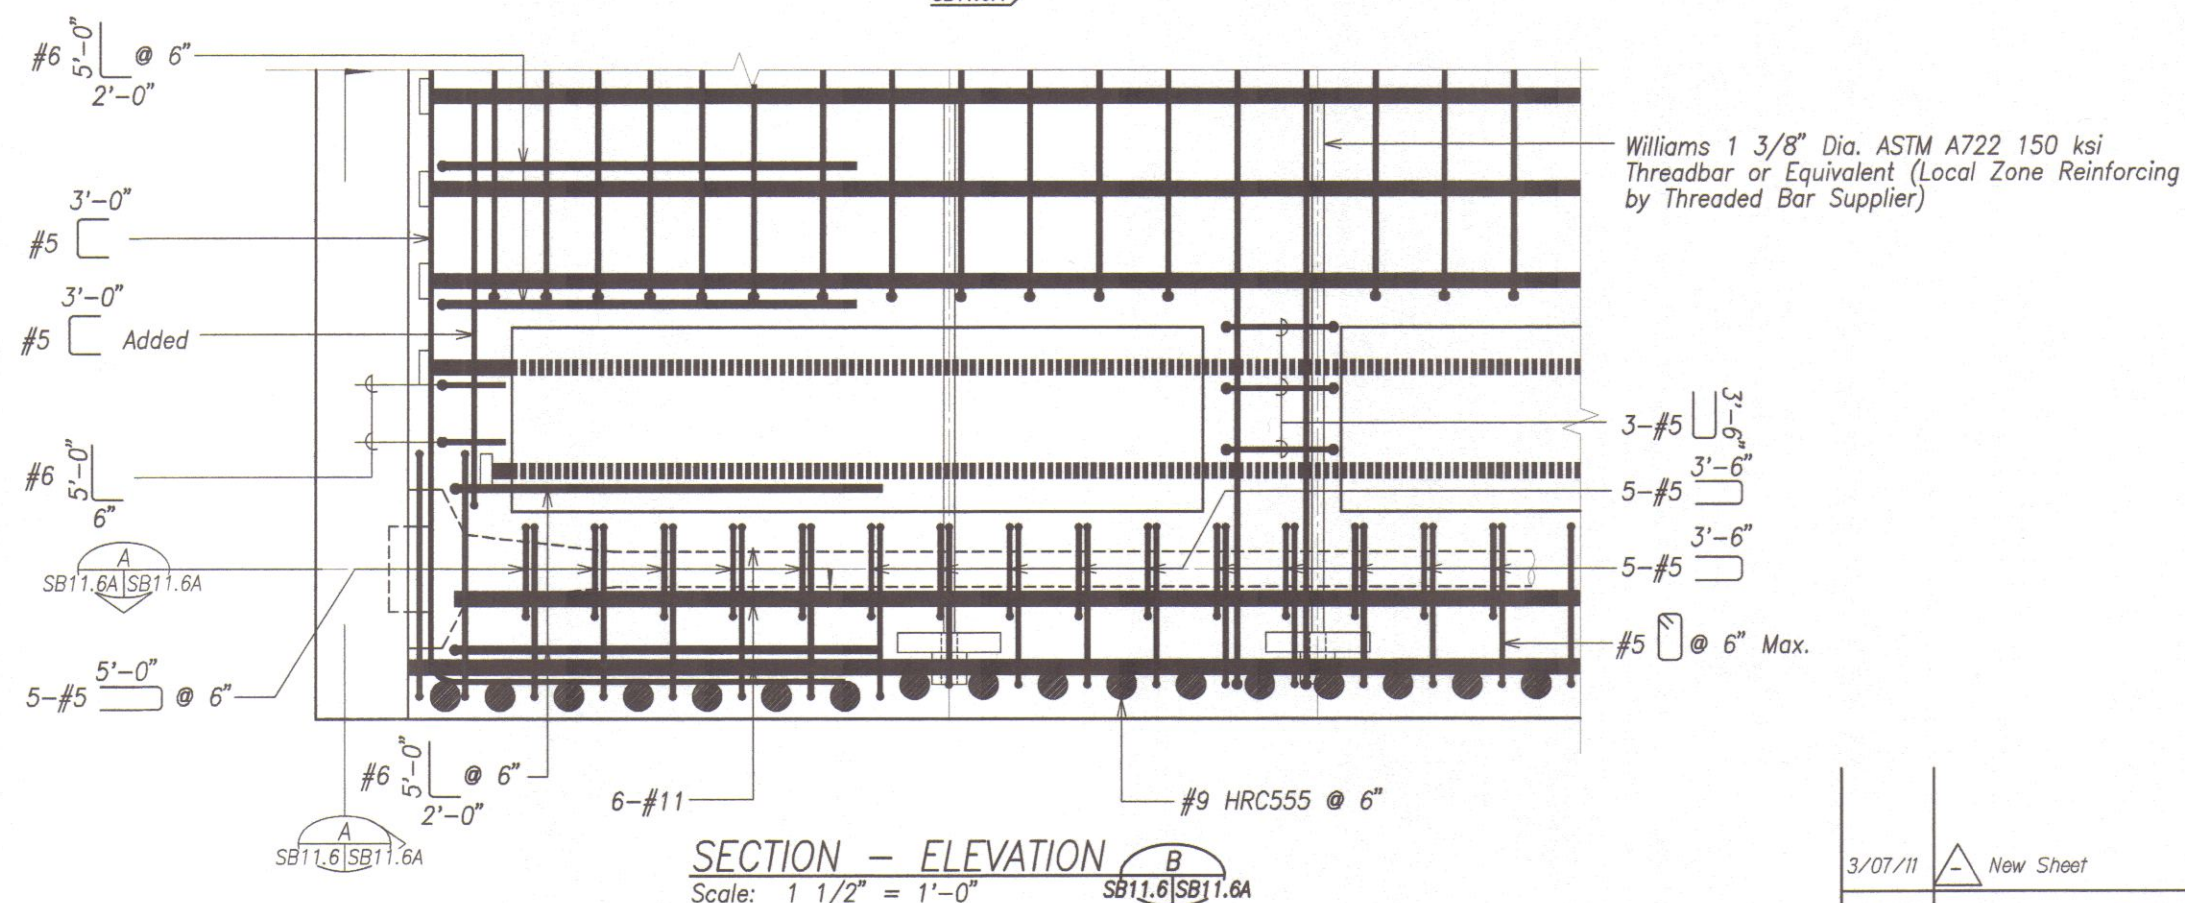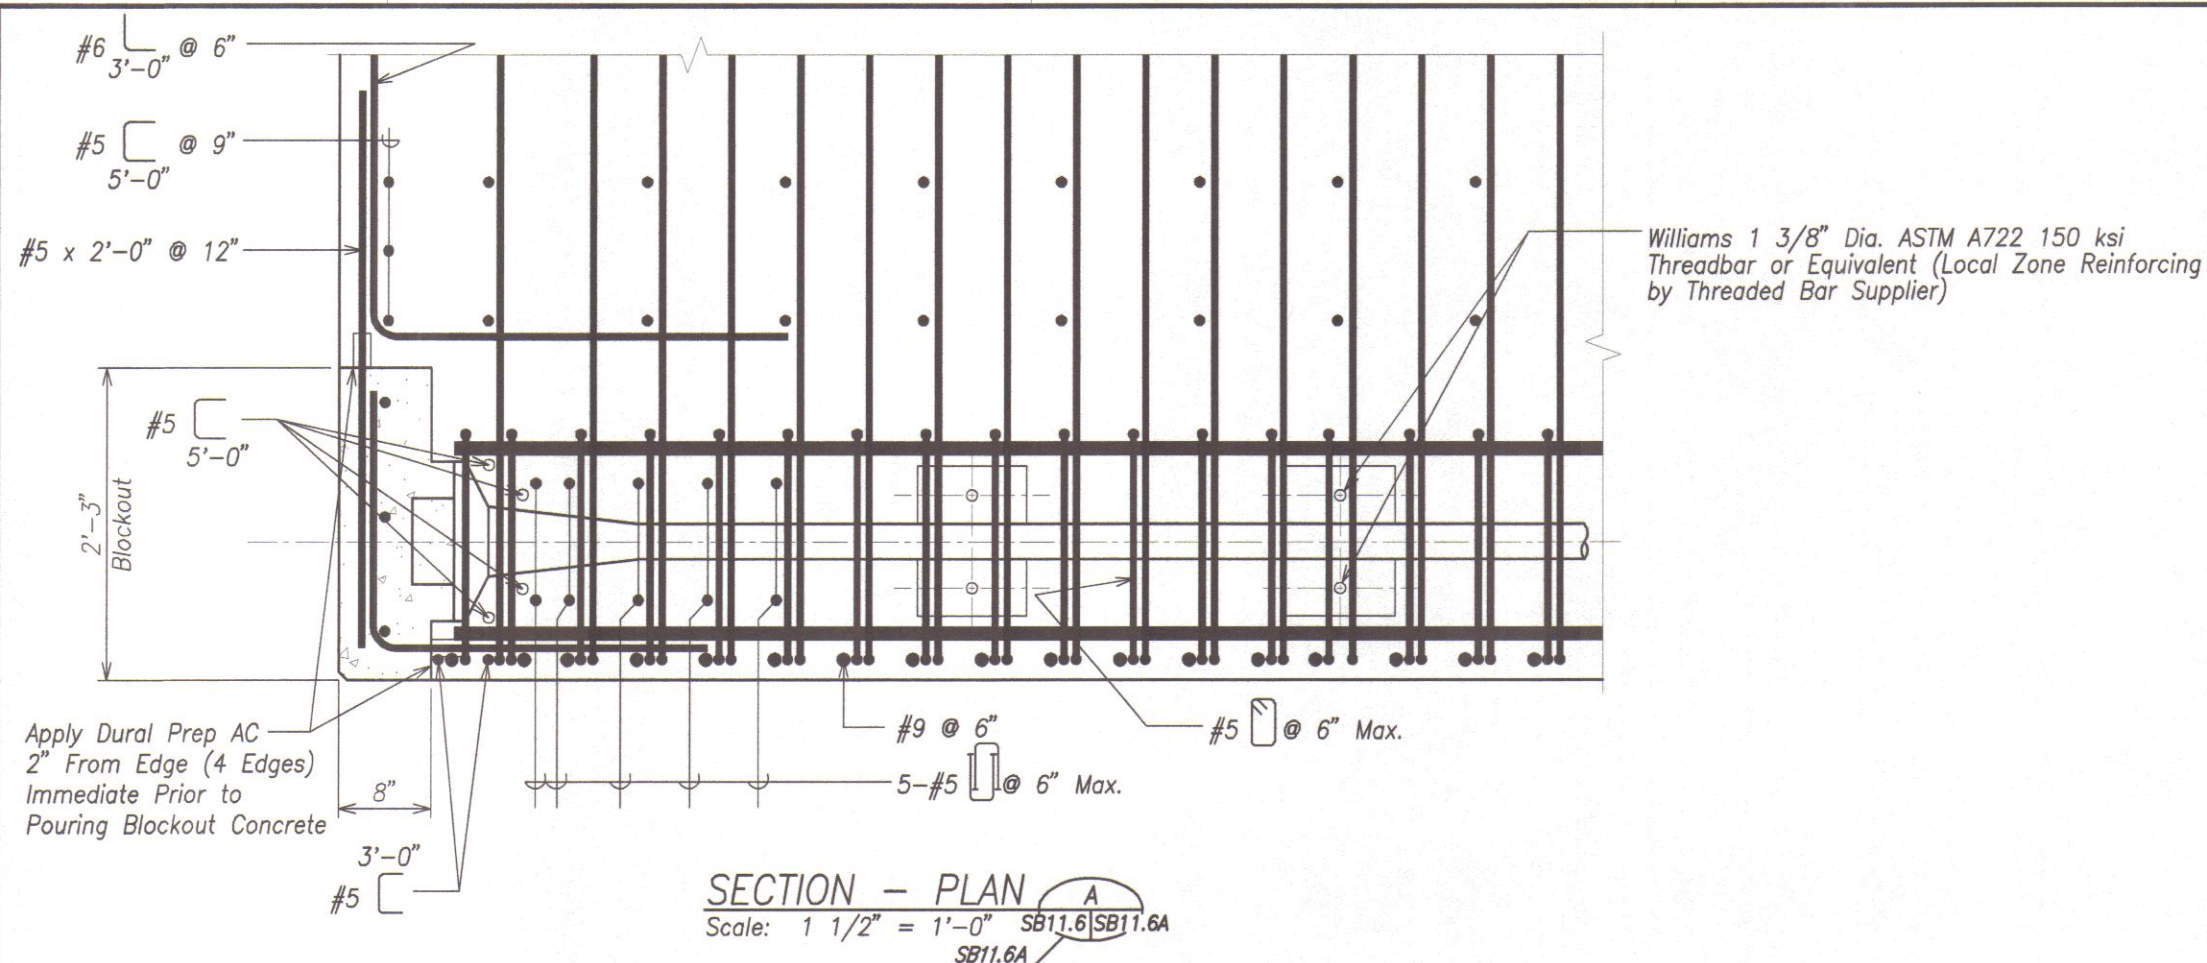

THIS WORK WAS PREPARED BY ME OR UNDER MY SUPERVISION.

KSF, INC. APRIL 30, 2012 LIC. EXP. DATE

STATE OF HAWAII DEPARTMENT OF TRANSPORTATION HIGHWAYS DIVISION	
SECTION AT 12x0.6 PT ANCHORS	
HONOAPILANI HIGHWAY REALIGNMENT, PHASE 1A Future Keawe St Extension to Lahainaluna Rd, Part B Fed. Aid Proj. No. NH-030-1(35)R	
Scale: As Noted	Date: June, 2010
SHEET No. SB11.6A OF 11 SHEETS	

3/07/11 New Sheet


DATE REVISION

FINAL DESIGN 350S-1

SURVEY PLOTTED BY	DATE
DESIGNED BY	
NOTED BY	
CHECKED BY	
NO.	


DRAWING NAME: 21.00 ONGOING 40013.0-HONOAPILANI LAHAINA BYPASS-KAHOOLA W/03-30-11 EM END BLOCKS\HH-SB1101.DWG PLOT TIME: 03-30-11, 4:24 PM

FED. ROAD DIST. NO.	STATE	FED. AID PROJ. NO.	FISCAL YEAR	SHEET NO.	TOTAL SHEETS
HAWAII	HAW.	NH-030-1(35)R	2009	351	383

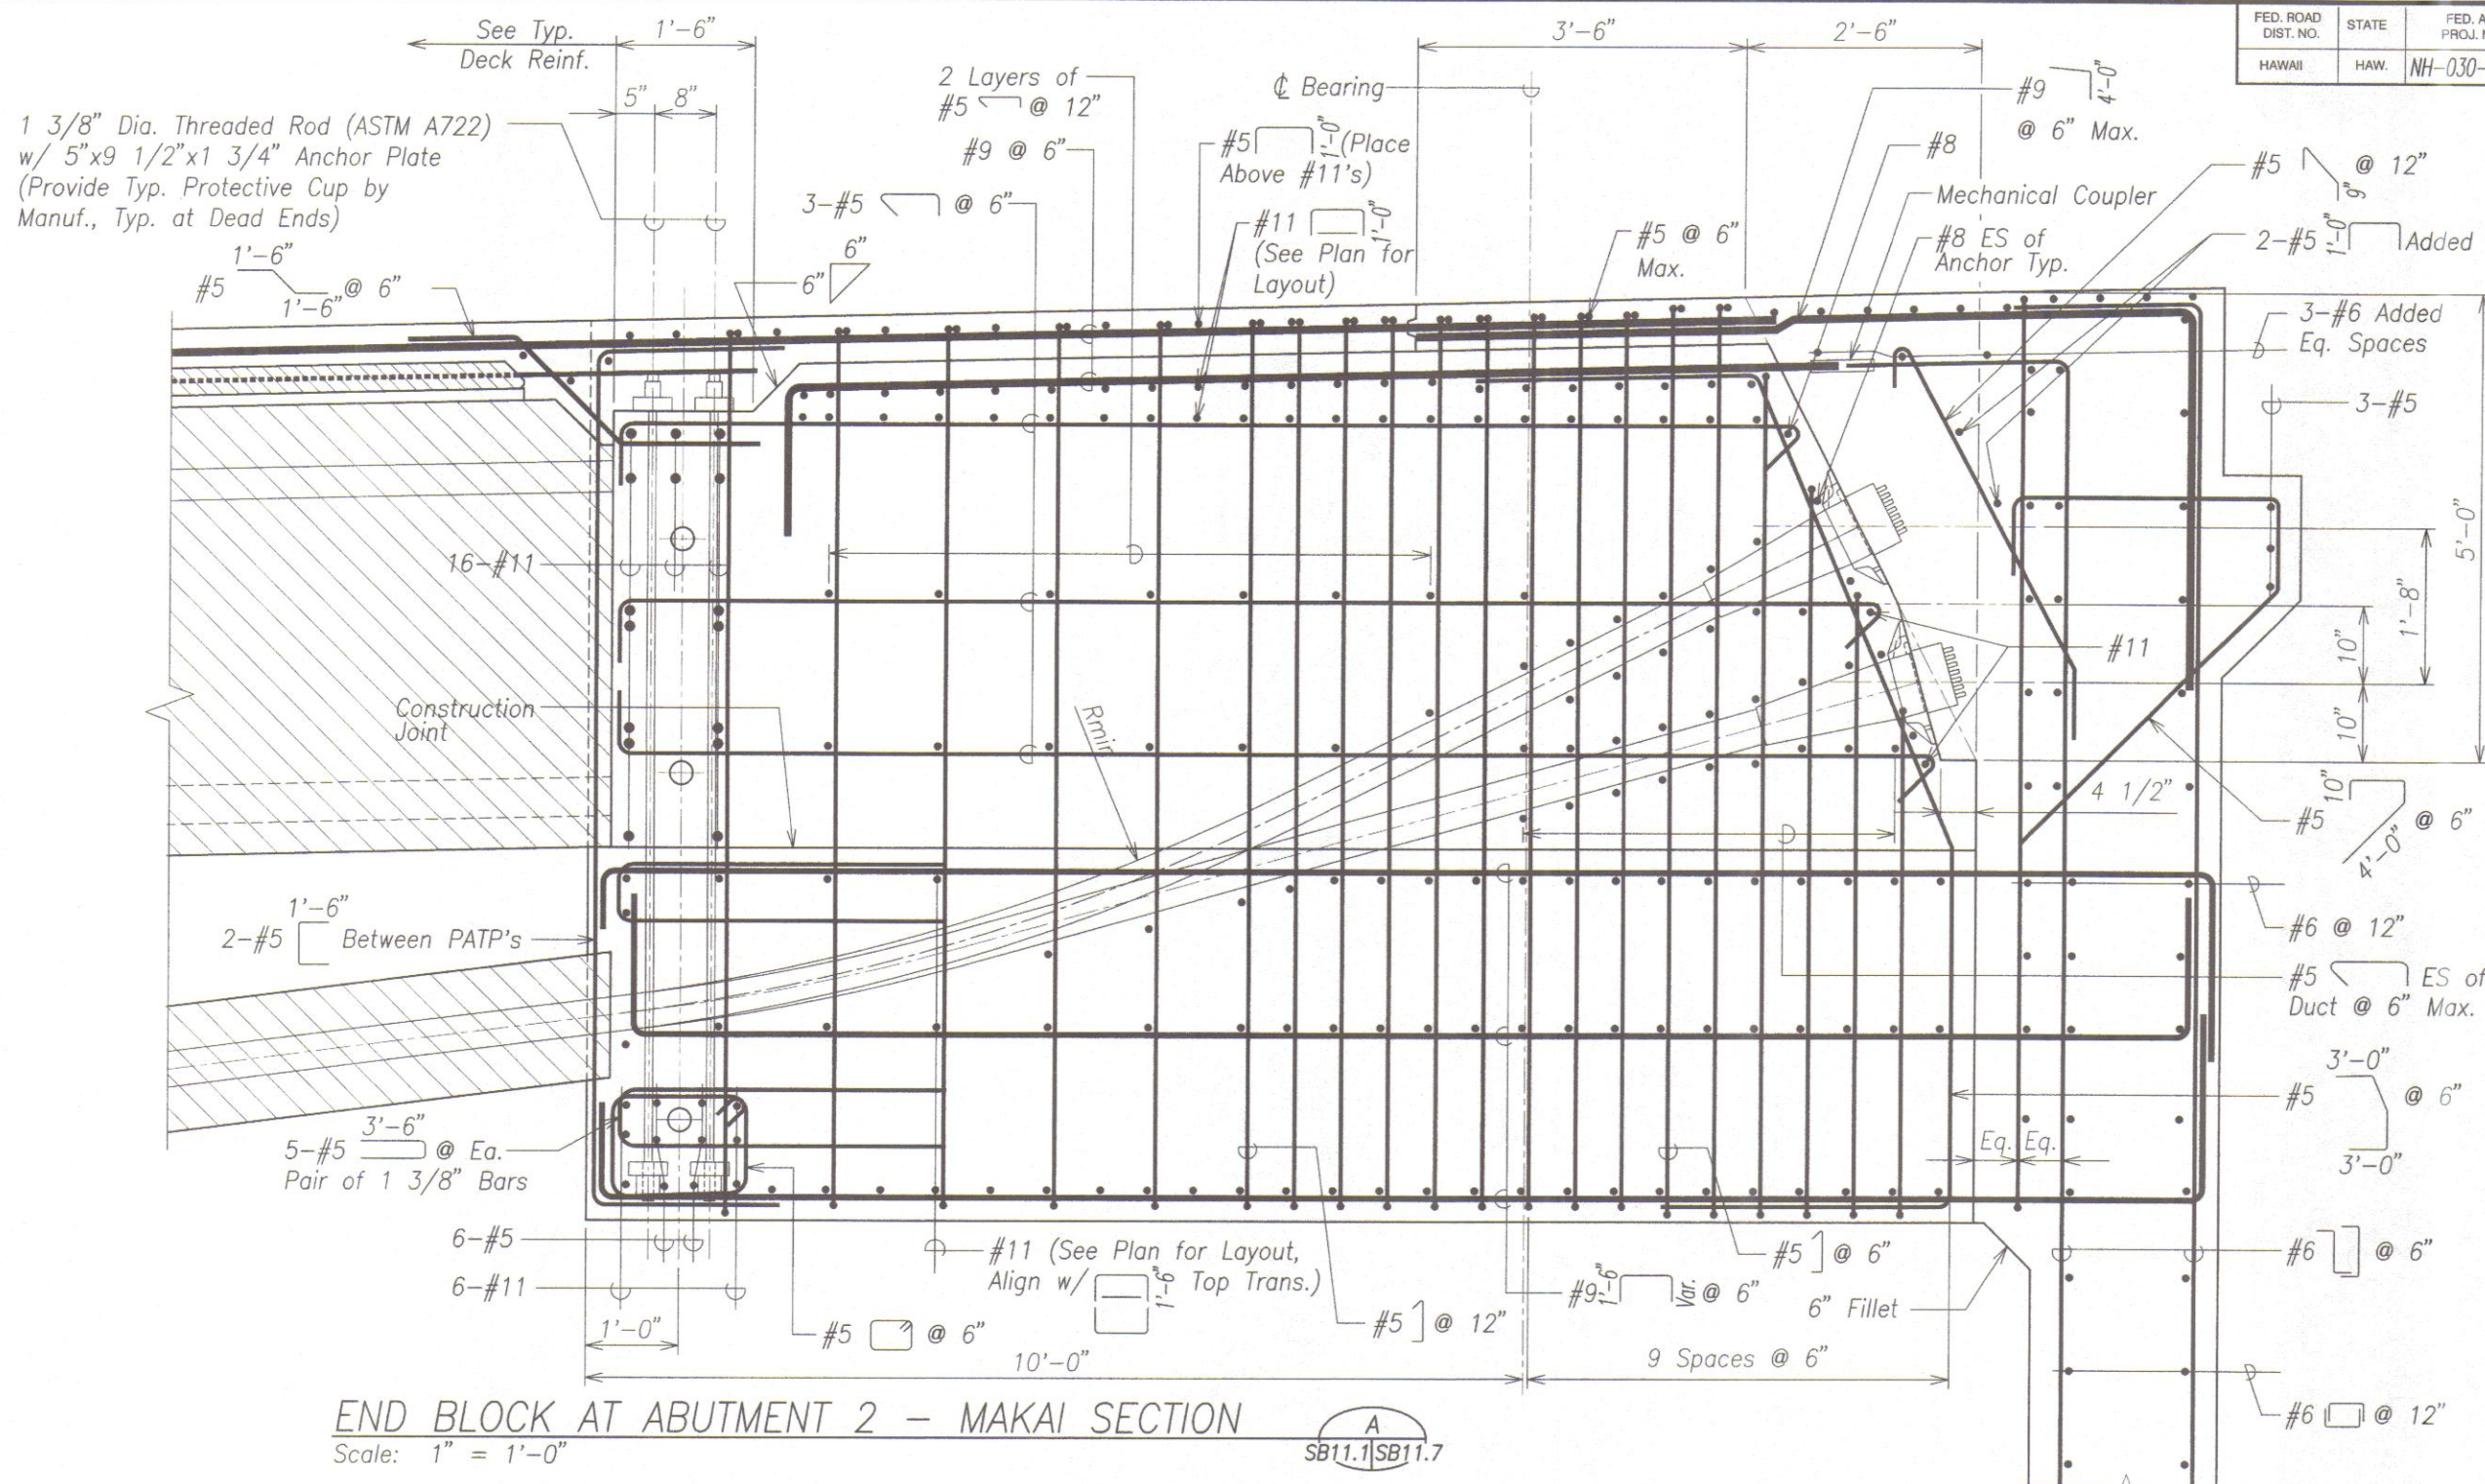

END BLOCK AT ABUTMENT 2 - MAKAI SECTION
 Scale: 1" = 1'-0"
 SB11.1 | SB11.7

- NOTES:
- Rmin = 22' For 19-0.6" Strand Tendons
 24' For 22-0.6" Strand Tendons
 27' For 27-0.6" Strand Tendons
 - See Sheet SB11.2 for #5 spacing at Bearing.

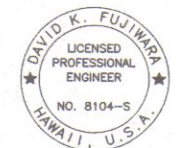


THIS WORK WAS PREPARED BY ME OR UNDER MY SUPERVISION.
David K. Fujiwara
 KSF, INC. APRIL 30, 2012 LIC. EXP. DATE

STATE OF HAWAII
DEPARTMENT OF TRANSPORTATION
HIGHWAYS DIVISION

END BLOCK AT ABUTMENT 2
MAKAI SECTION
 HONOAPIILANI HIGHWAY REALIGNMENT, PHASE 1A
 Future Keawe St Extension to Lahainaluna Rd, Part B
 Fed. Aid Proj. No. NH-030-1(35)R
 Scale: As Noted Date: June, 2010
 SHEET No. SB11.7 OF 11 SHEETS

FED. ROAD DIST. NO.	STATE	FED. AID PROJ. NO.	FISCAL YEAR	SHEET NO.	TOTAL SHEETS
HAWAII	HAW.	NH-030-1(35)R	2009	352	383

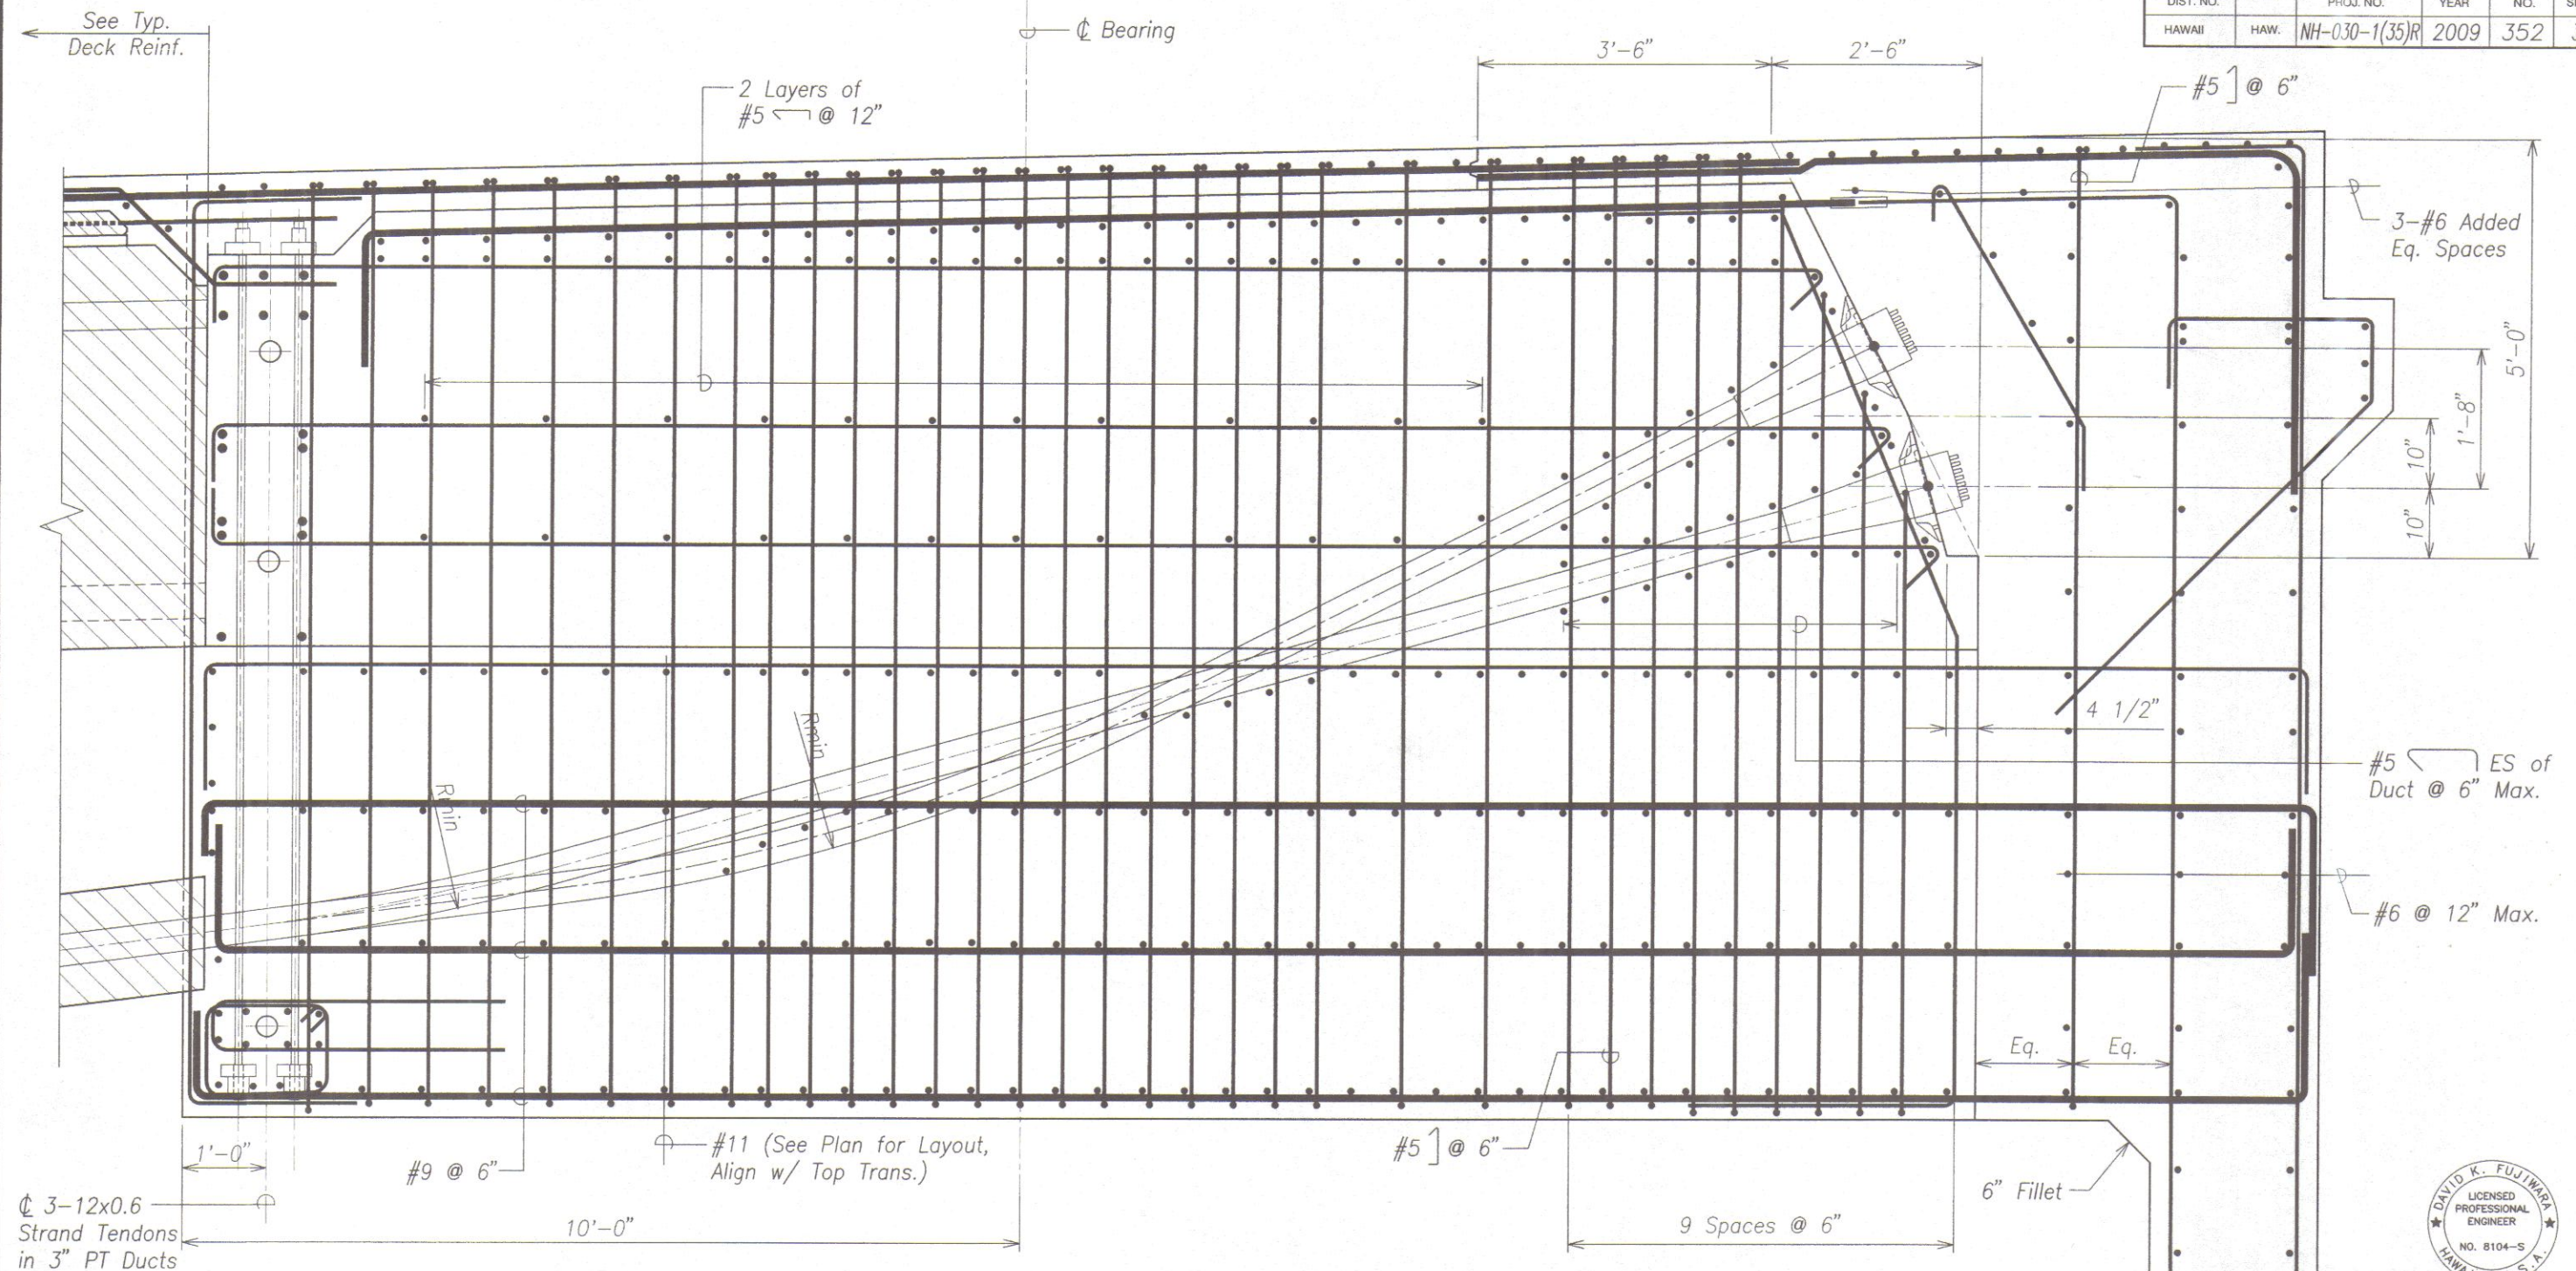

END BLOCK AT ABUTMENT 2 - MAUKA SECTION

Scale: $1'' = 1'-0''$



THIS WORK WAS PREPARED BY ME
OR UNDER MY SUPERVISION.

Sand L. Fujiwara APRIL 30, 2012
KSF, INC. LIC. EXP. DATE

NOTES:

1. $R_{min} = 22'$ For 19-0.6" Strand Tendons
 $24'$ For 22-0.6" Strand Tendons
 $27'$ For 27-0.6" Strand Tendons
2. See Sheet SB11.1B for #5 $\lceil$ spacing at ϕ Bearing.
3. See Sheet SB11.7 for additional information.



STATE OF HAWAII
DEPARTMENT OF TRANSPORTATION
HIGHWAYS DIVISION
END BLOCK AT ABUTMENT 2
MAUKA SECTION
HONOAPIILANI HIGHWAY REALIGNMENT, PHASE 1A
Future Keawe St Extension to Lahainaluna Rd, Part B
Fed. Aid Proj. No. NH-030-1(35)R
Scale: As Noted Date: June, 2010
SHEET No. SB11.8 OF 11 SHEETS

FINAL DESIGN 352

ORIGINAL PLAN	SURVEY PLOTTED BY _____ DATE _____
NOTE BOOK	DRAWN BY _____
	TRACED BY _____
	DESIGNED BY _____
	QUANTITIES BY _____
No. _____	CHECKED BY _____

DRAWING NAME: Z:\00 ONGOING\40019.0-HONOAPIILANI LAHAINA BYPASS-KAHOMA WO\06-15-10 COMBINE LAHAINA FINAL DESIGN\HH-SB1101.DWG PLOT TIME: 06-14-10, 8:20 PM)

FED. ROAD DIST. NO.	STATE	FED. AID PROJ. NO.	FISCAL YEAR	SHEET NO.	TOTAL SHEETS
HAWAII	HAW.	NH-030-1(35)R	2009	353	383

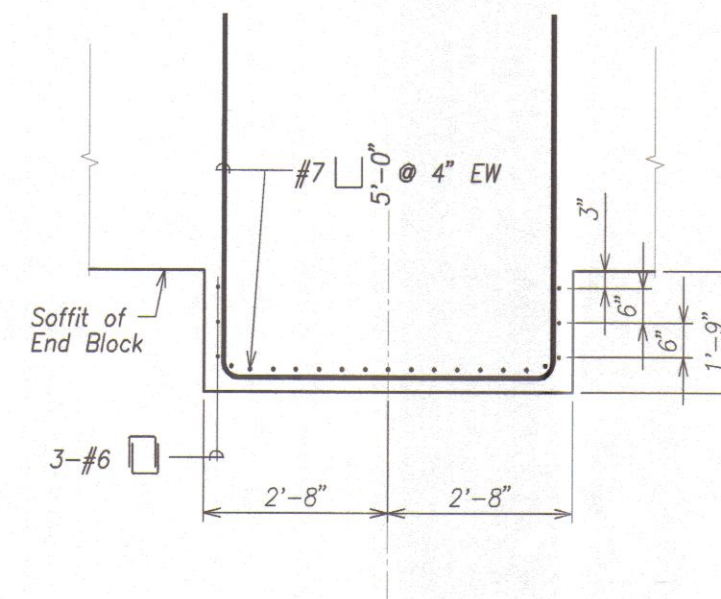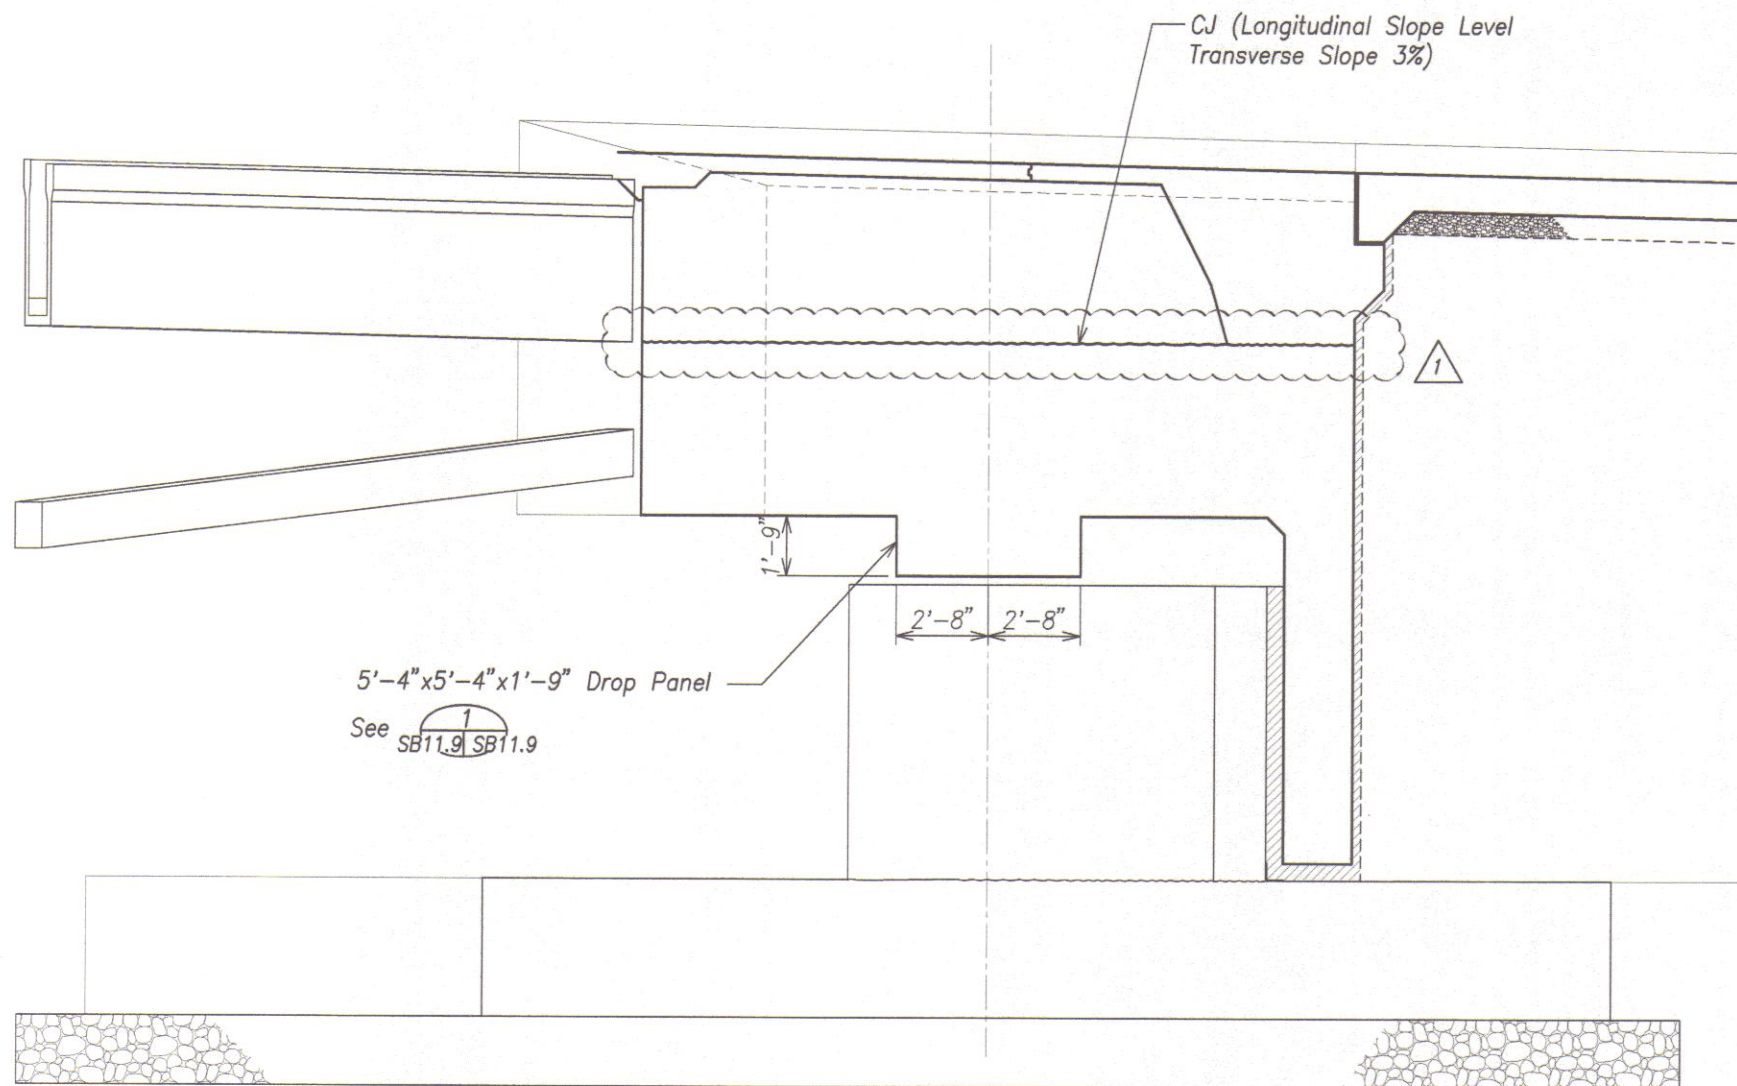

DROP PANEL
Scale: $\frac{3}{4}'' = 1'-0''$ SB11.9 SB11.9

END BLOCK AT ABUTMENT 2 – SECTION AT DROP PANEL
Scale: $\frac{3}{8}'' = 1'-0''$

A
SB11.1 SB11.9



THIS WORK WAS PREPARED BY ME
OR UNDER MY SUPERVISION.



APRIL 30, 2012
KSF, INC. U.C. EXP. DATE

STATE OF HAWAII
DEPARTMENT OF TRANSPORTATION
HIGHWAYS DIVISION

END BLOCK AT ABUTMENT 2
SECTION AT DROP PANEL
HONOAPIILANI HIGHWAY REALIGNMENT, PHASE 1A
Future Keawe St Extension to Lahainaluna Rd, Part B
Fed. Aid Proj. No. NH-030-1(35)R
Scale: As Noted Date: June, 2010
SHEET No. SB11.9 OF 11 SHEETS

DATE	REVISION
2/01/11	1 Revisions

FED. ROAD DIST. NO.	STATE	FED. AID PROJ. NO.	FISCAL YEAR	SHEET NO.	TOTAL SHEETS
HAWAII	HAW.	NH-030-1(35)R	2009	353	383

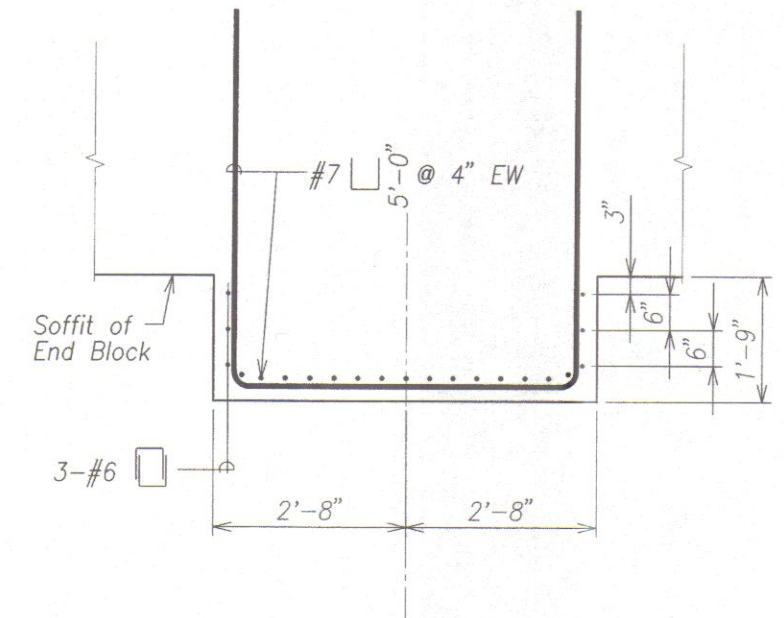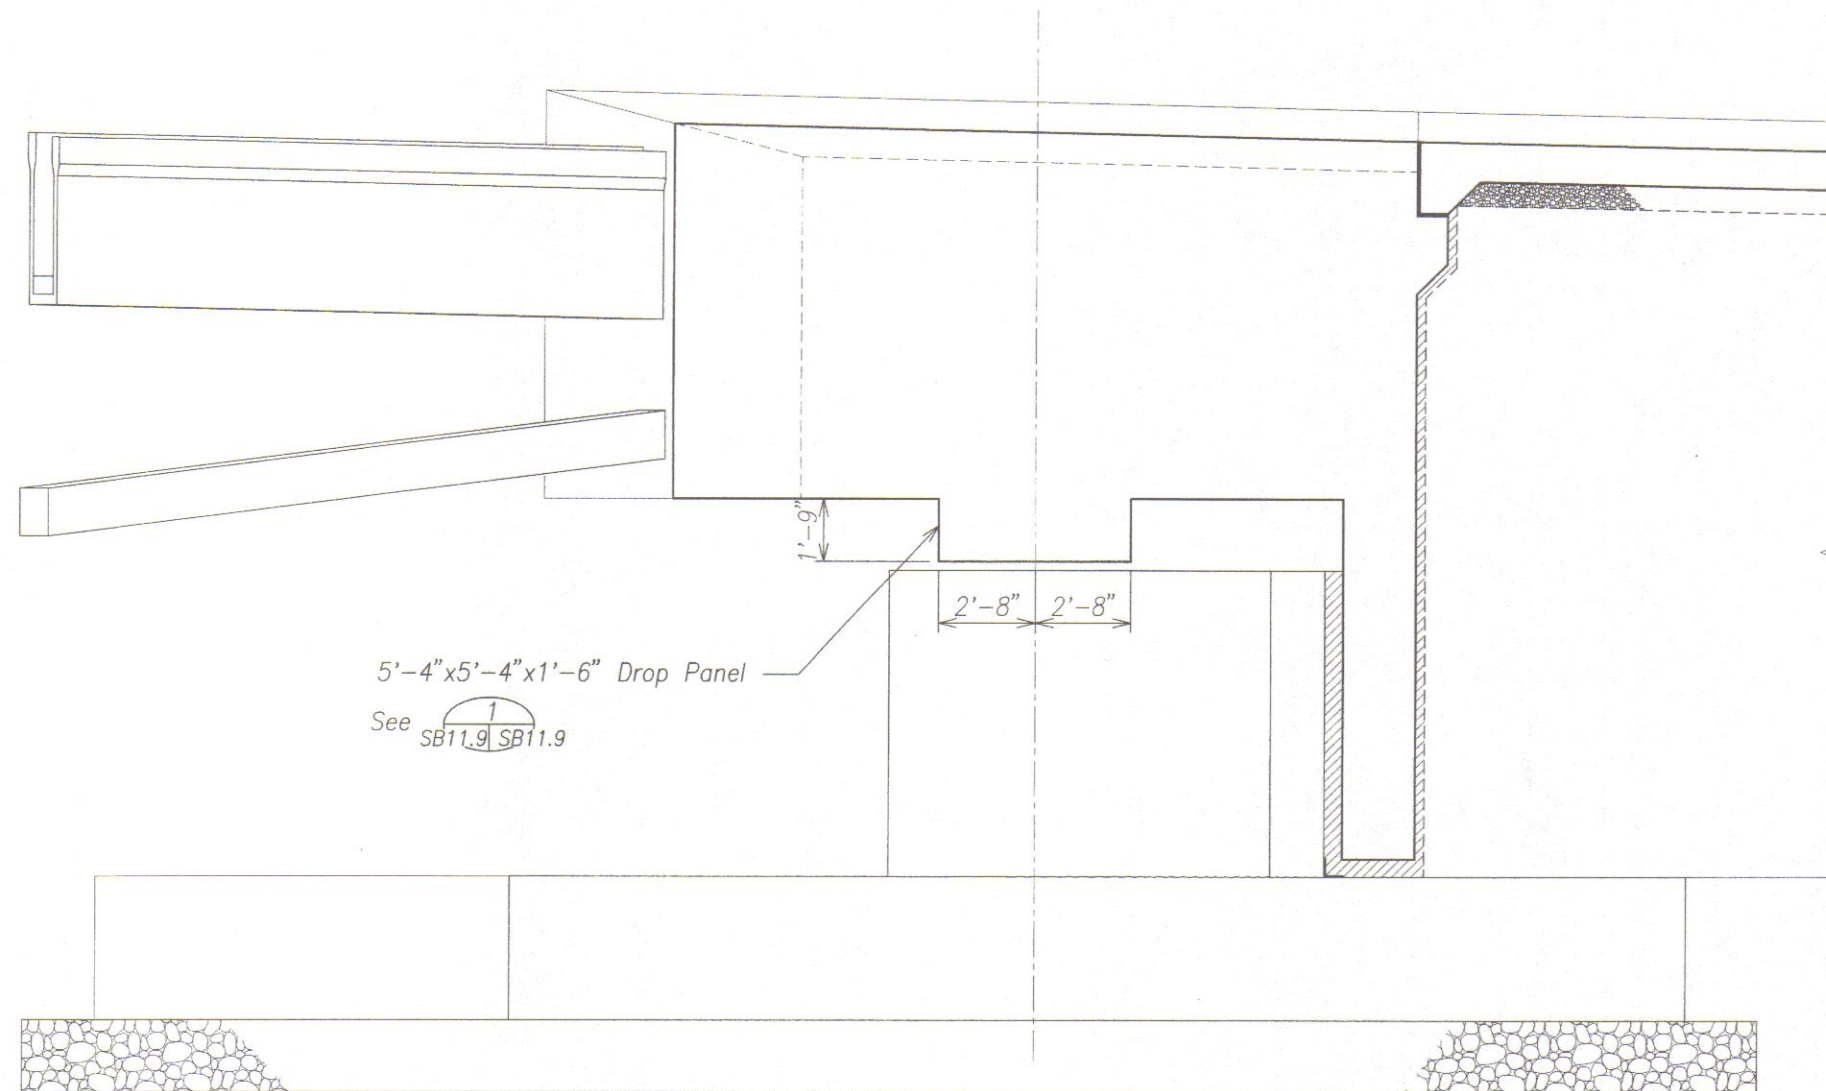

DROP PANEL
Scale: $3/4" = 1'-0"$ 1 SB11.9 SB11.9

END BLOCK AT ABUTMENT 2 - SECTION AT DROP PANEL
Scale: $3/8" = 1'-0"$

A
SB11.1 SB11.9



THIS WORK WAS PREPARED BY ME
OR UNDER MY SUPERVISION.

David K. Fujiwara
KSF, INC. APRIL 30, 2012
LIC. EXP. DATE

STATE OF HAWAII
DEPARTMENT OF TRANSPORTATION
HIGHWAYS DIVISION

END BLOCK AT ABUTMENT 2
SECTION AT DROP PANEL

HONOAPIILANI HIGHWAY REALIGNMENT, PHASE 1A
Future Keawe St Extension to Lahainaluna Rd, Part B
Fed. Aid Proj. No. NH-030-1(35)R

Scale: As Noted Date: June, 2010


SHEET No. SB11.9 OF 11 SHEETS

FINAL DESIGN 353 *rw*

ORIGINAL PLAN	SURVEY PLOTTED BY	DATE
NOTE BOOK	DESIGNED BY	
	QUANTITIES BY	
	CHECKED BY	

DRAWING NAME: Z:\00 ONGOING\6019.0-HONOAPIILANI LAHANA BYPASS-KAHOMA WO\06-15-10 COMBINE LAHANA FINAL DESIGN\HH-SB1101.DWG PLOT TIME: 06-14-10, 8:20 PM

FED. ROAD DIST. NO.	STATE	FED. AID PROJ. NO.	FISCAL YEAR	SHEET NO.	TOTAL SHEETS
HAWAII	HAW.	NH-030-1(35)R	2009	354	383

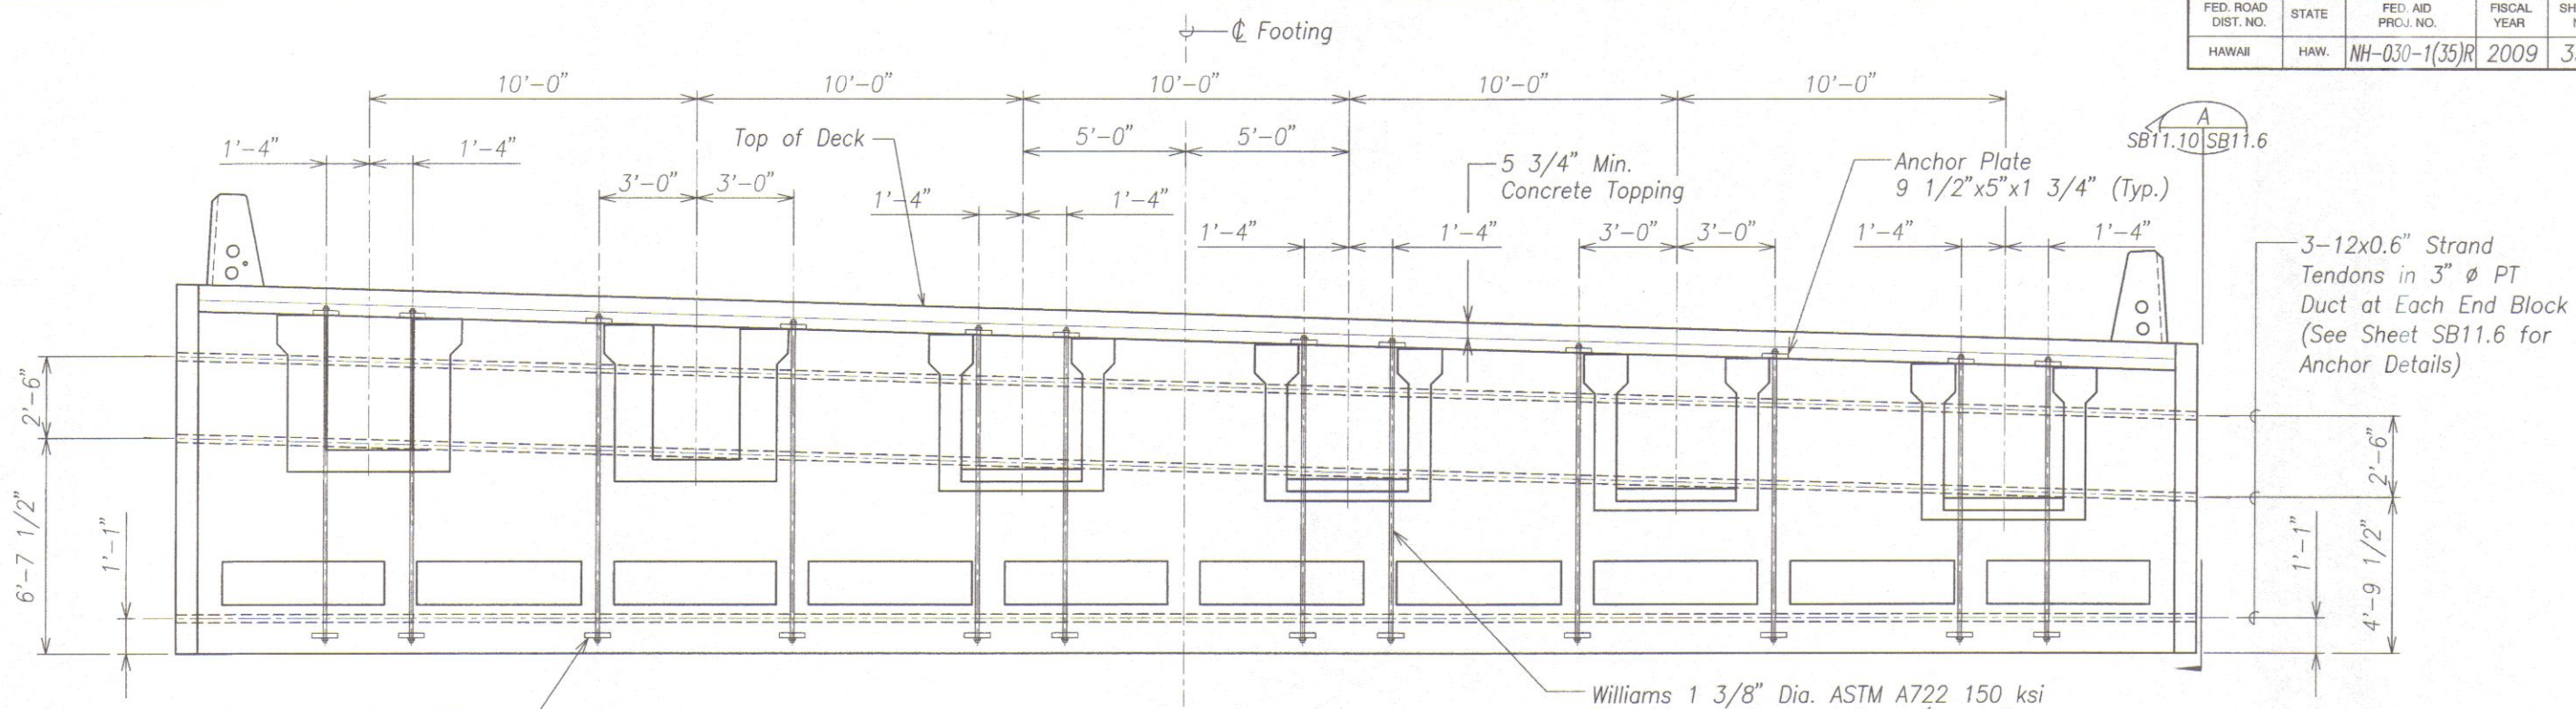


Anchor Plate ASTM A36 or ASTM S572
9 1/2"x5"x1 3/4" Coat Anchor Plate,
Bar and Accessories at Both Ends w/
CORTEC VpCI391

Williams 1 3/8" Dia. ASTM A722 150 ksi
Threadbar or Approved Equal (Local Zone
Reinforcing by Threaded Bar Supplier)
Stress to 142k.

END BLOCK AT ABUTMENT 2 - SECTION A
Scale: 3/8" = 1'-0"
SB11.10/SB11.10

NOTE:
View shown is perpendicular to Girders
and Precast Arch Tie Planks.

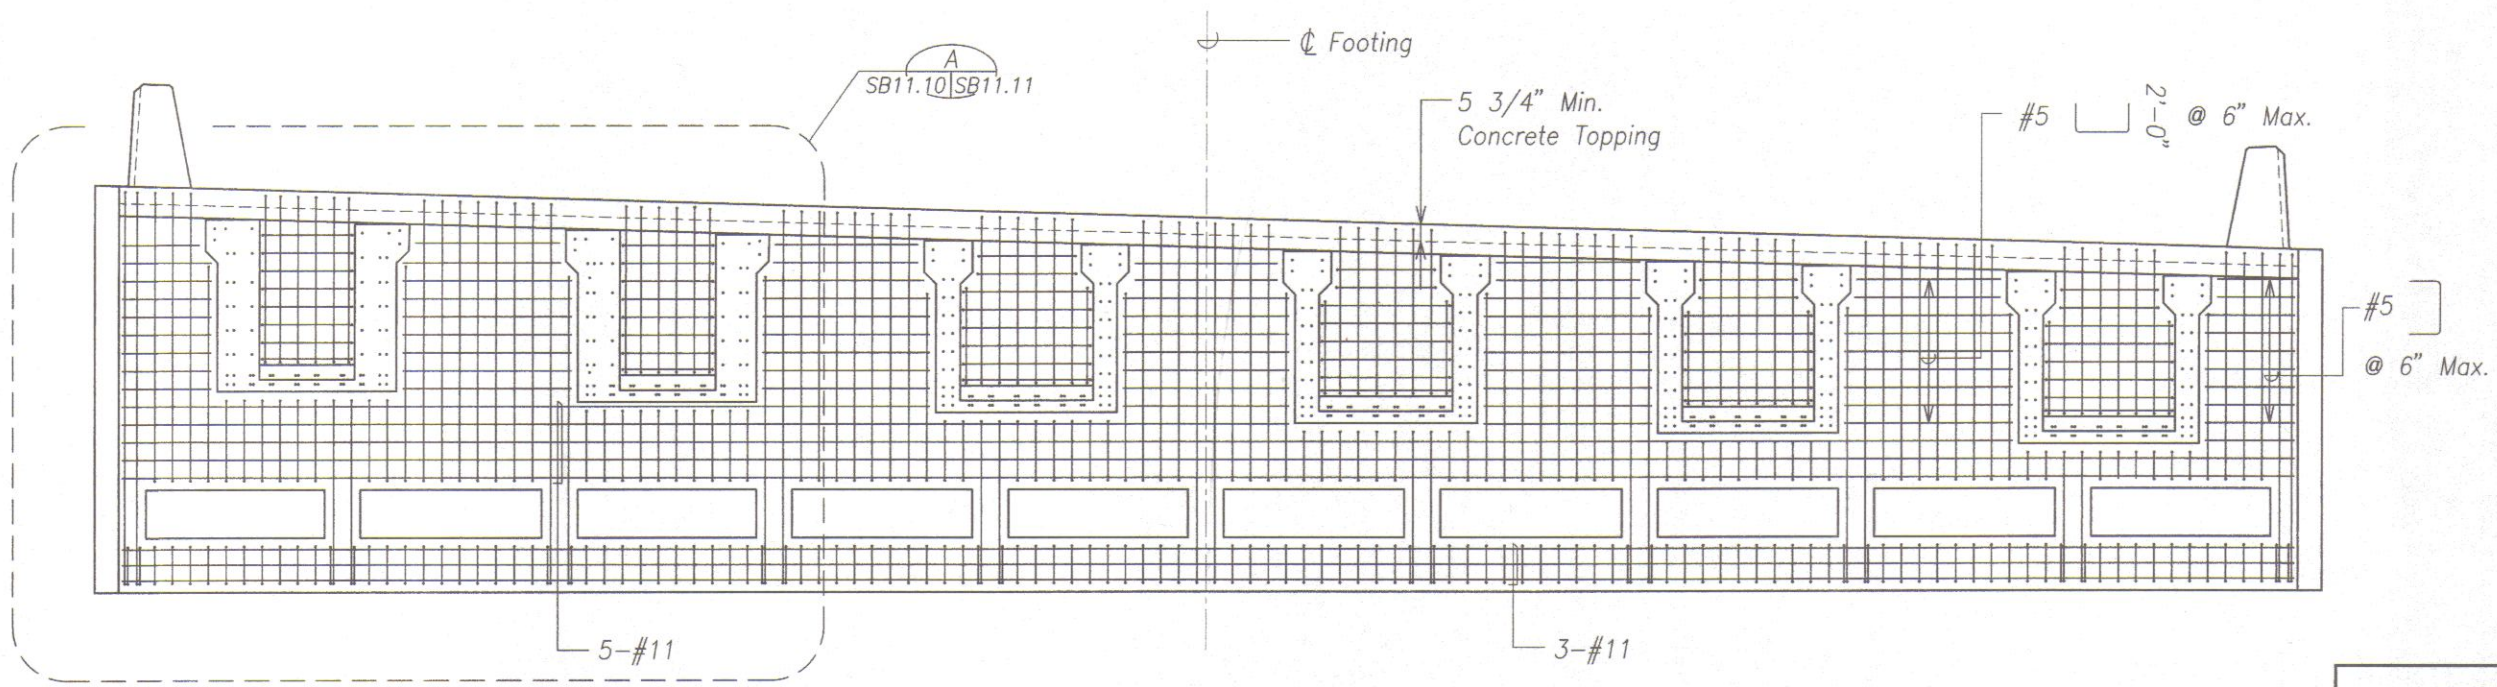

END BLOCK AT ABUTMENT 2 - SECTION B
Scale: 3/8" = 1'-0"
SB11.10/SB11.10




THIS WORK WAS PREPARED BY ME
OR UNDER MY SUPERVISION.
David K. Fujiwara
KSF, INC. APRIL 30, 2012
LIC. EXP. DATE

STATE OF HAWAII
DEPARTMENT OF TRANSPORTATION
HIGHWAYS DIVISION
END BLOCK AT ABUTMENT 2
SECTIONS
HONOAPIILANI HIGHWAY REALIGNMENT, PHASE 1A
Future Keawe St Extension to Lahainaluna Rd, Part B
Fed. Aid Proj. No. NH-030-1(35)R
Scale: As Noted Date: June, 2010
SHEET No. SB11.10 OF 11 SHEETS

ORIGINAL PLAN	DATE
DESIGNED BY	
CHECKED BY	
NOTED BY	
QUANTITIES BY	
CHECKED BY	
No.	

DRAWING NAME: 2:00 ONGOING 40019.0-HONOAPIILANI LAHAINA BYPASS-KAHOMA WD 06-15-10 COMBINE LAHAINA FINAL DESIGN\HH-SB11.10.DWG PLOT TIME: 06-14-10, 8:21 PM

FED. ROAD DIST. NO.	STATE	FED. AID PROJ. NO.	FISCAL YEAR	SHEET NO.	TOTAL SHEETS
HAWAII	HAW.	NH-030-1(35)R	2009	355	383

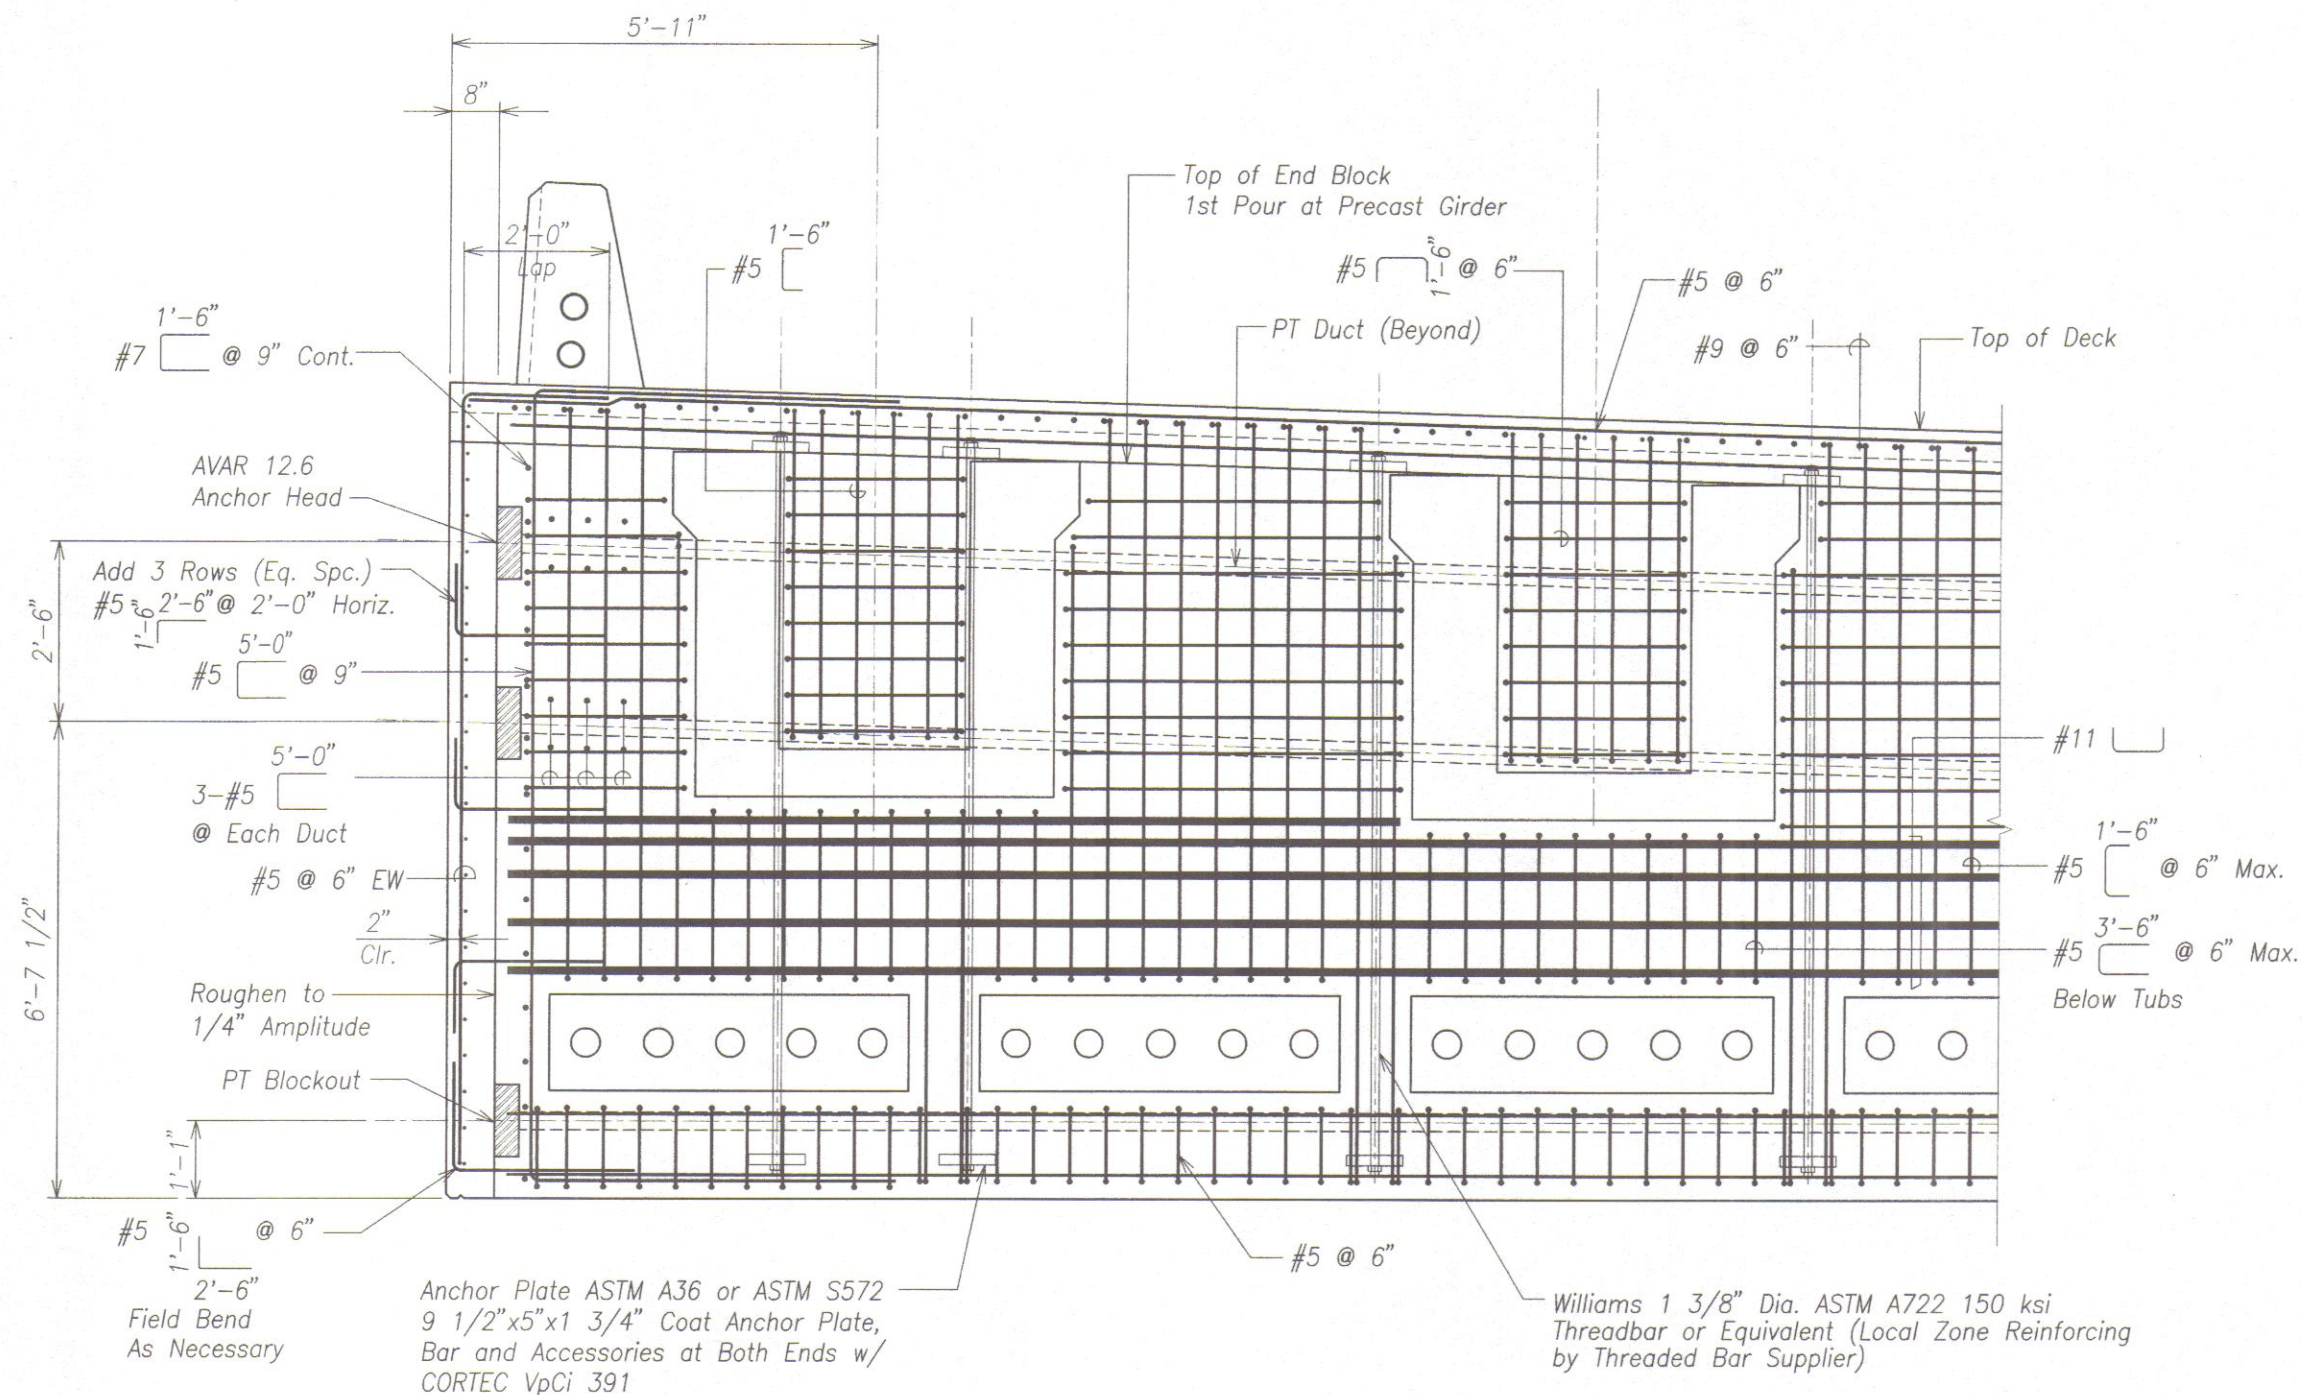

END BLOCK AT ABUTMENT 2 - SECTION A
Scale: 3/4" = 1'-0"
SB11.1, SB11.10 SB10.2 SB11.11



THIS WORK WAS PREPARED BY ME
OR UNDER MY SUPERVISION.
David K. Fujiwara APRIL 30, 2012
KSF, INC. LIC. EXP. DATE

STATE OF HAWAII
DEPARTMENT OF TRANSPORTATION
HIGHWAYS DIVISION

**END BLOCK AT ABUTMENT 2
SECTION**

HONOAPIILANI HIGHWAY REALIGNMENT, PHASE 1A
Future Keawe St Extension to Lahainaluna Rd, Part B
Fed. Aid Proj. No. NH-030-1(35)R

Scale: As Noted Date: June, 2010


SHEET No. SB11.11 OF 11 SHEETS

FINAL DESIGN 355

ORIGINAL PLAN	DATE
DRAWN BY	
DESIGNED BY	
QUANTITIES BY	
CHECKED BY	

DRAWING NAME: Z:\00 ONGOING\40019.0-HONOAPIILANI LAHAINA BYPASS-KAHOMA WO\06-15-10 COMBINE LAHAINA FINAL DESIGN\HH-SB1111.DWG PLOT TIME: 06-14-10, 8:22 PM

FED. ROAD DIST. NO.	STATE	FED. AID PROJ. NO.	FISCAL YEAR	SHEET NO.	TOTAL SHEETS
HAWAII	HAW.	NH-030-1(35)R	2009	355S-1	383

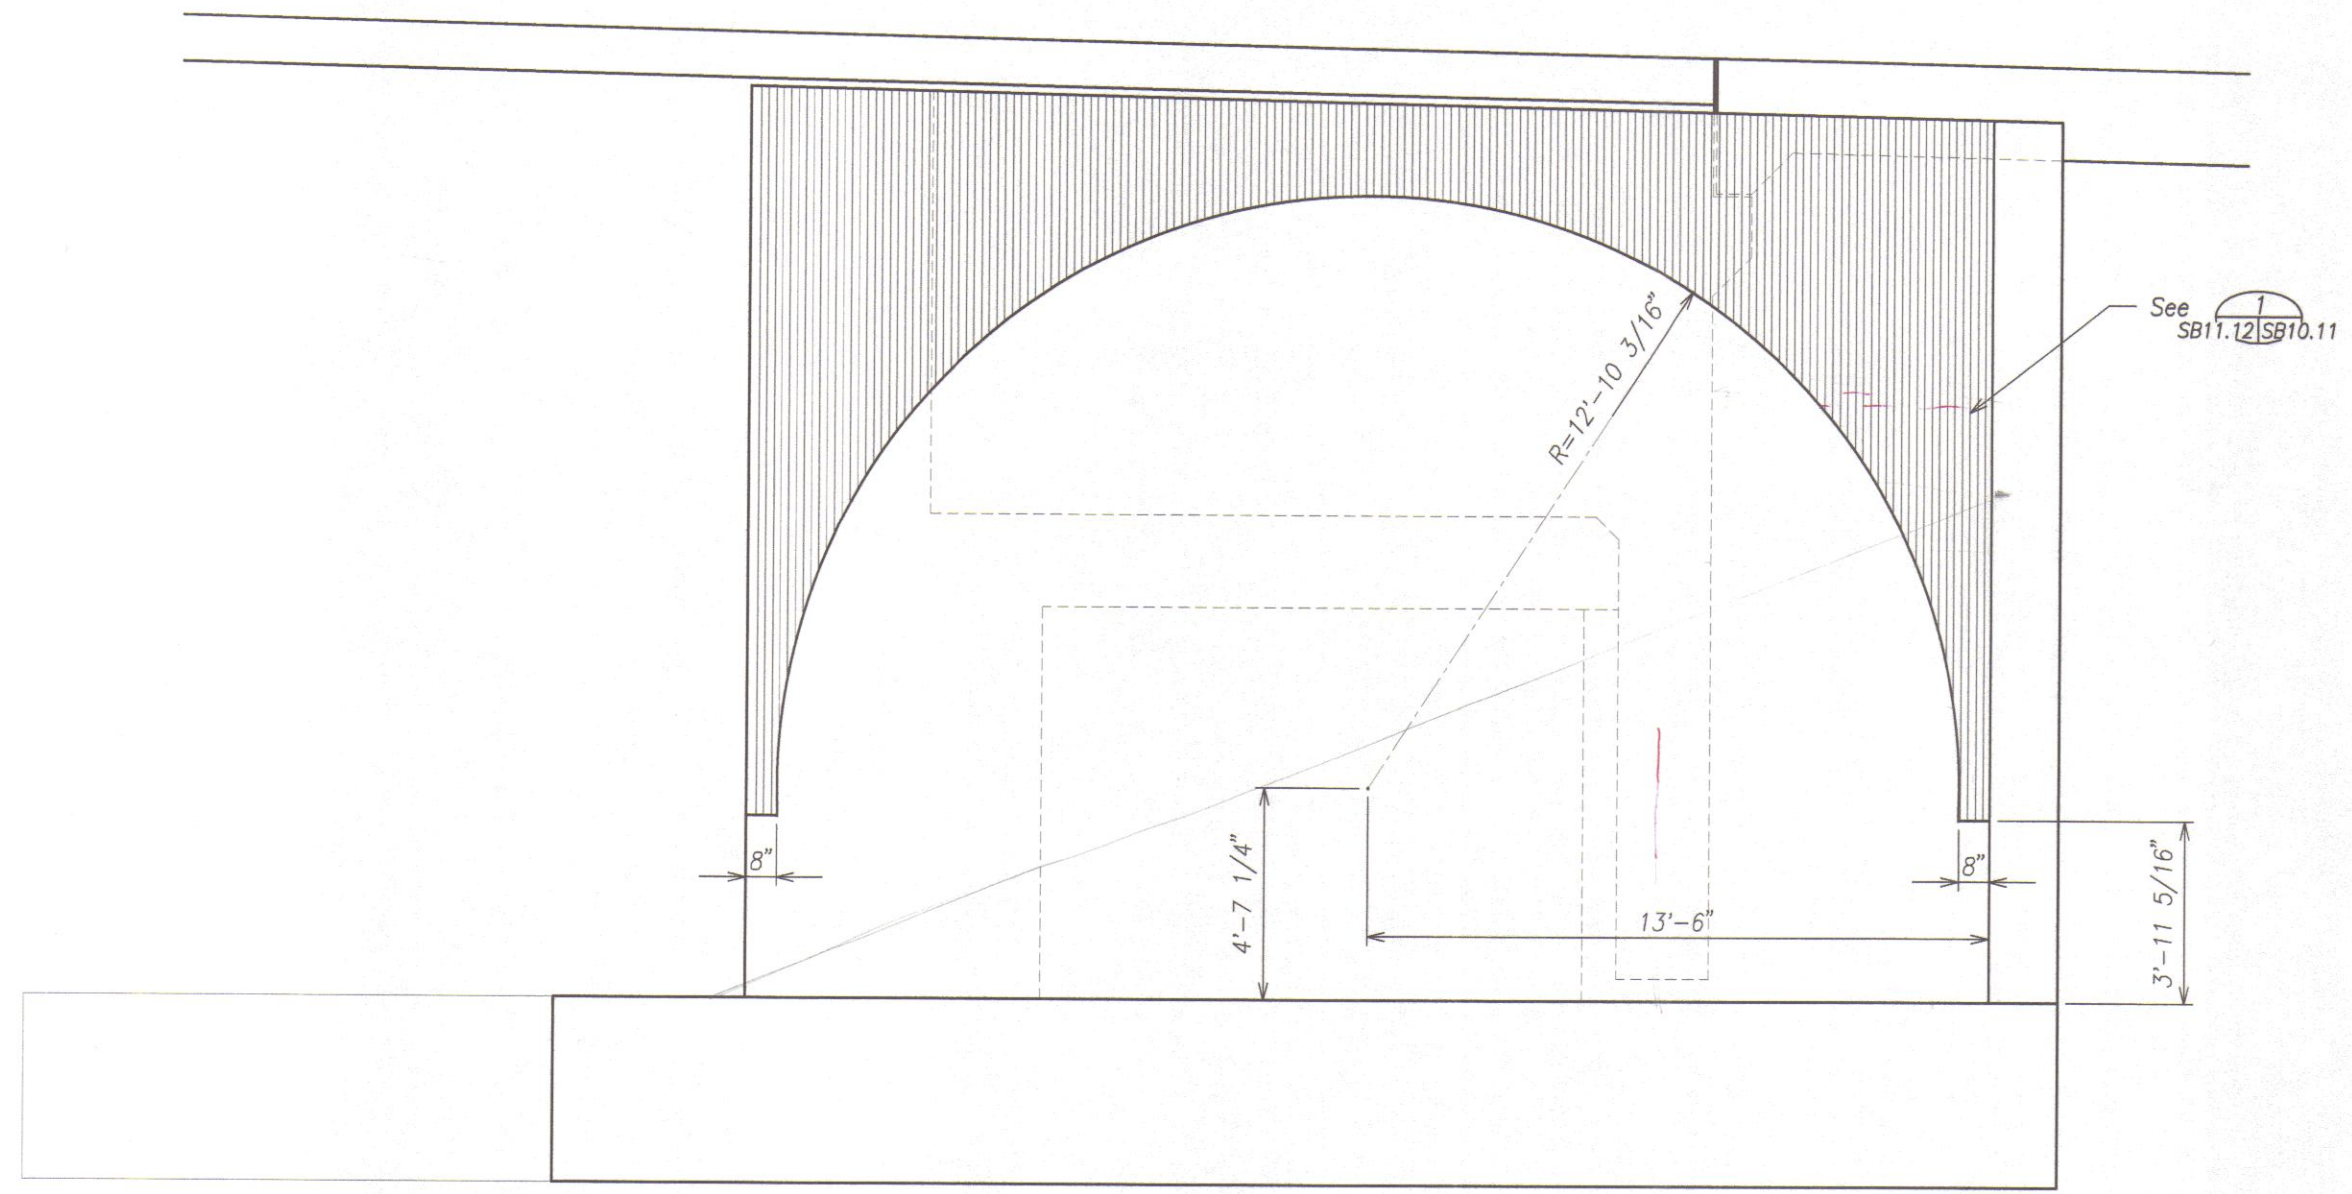

THIS WORK WAS PREPARED BY ME
OR UNDER MY SUPERVISION.

KSF, INC. APRIL 30, 2012
LIC. EXP. DATE

FASCIA WALL ABUTMENT 2 - MAKAI SIDE
Scale: 1/2" = 1'-0" A
SB9.4/SB11.12

STATE OF HAWAII
DEPARTMENT OF TRANSPORTATION
HIGHWAYS DIVISION
ABUTMENT 2
FASCIA WALL - MAKAI SIDE
HONOAPIILANI HIGHWAY REALIGNMENT, PHASE 1A
Future Keawe St Extension to Lahainaluna Rd, Part B
Fed. Aid Proj. No. NH-030-1(35)R
Scale: As Noted Date: June, 2010
SHEET No. SB11.12 OF 5 SHEETS


DATE	REVISION

FINAL DESIGN 355S-1

ORIGINAL PLAN	SURVEY PLOTTED BY	DATE
NOTE BOOK	DRAWN BY	
	TRACED BY	
	QUANTITIES BY	
	CHECKED BY	

DRAWING NAME: Z:\00 ONGOING\40019.0-HONOAPIILANI LAHAINA BYPASS-KAHOMA\03-30-11 EM END BLOCKS\HH-SB11.12.DWG PLOT TIME: 03-30-11, 4:25 PM

FED. ROAD DIST. NO.	STATE	FED. AID PROJ. NO.	FISCAL YEAR	SHEET NO.	TOTAL SHEETS
HAWAII	HAW.	NH-030-1(35)R	2009	355S-2	383

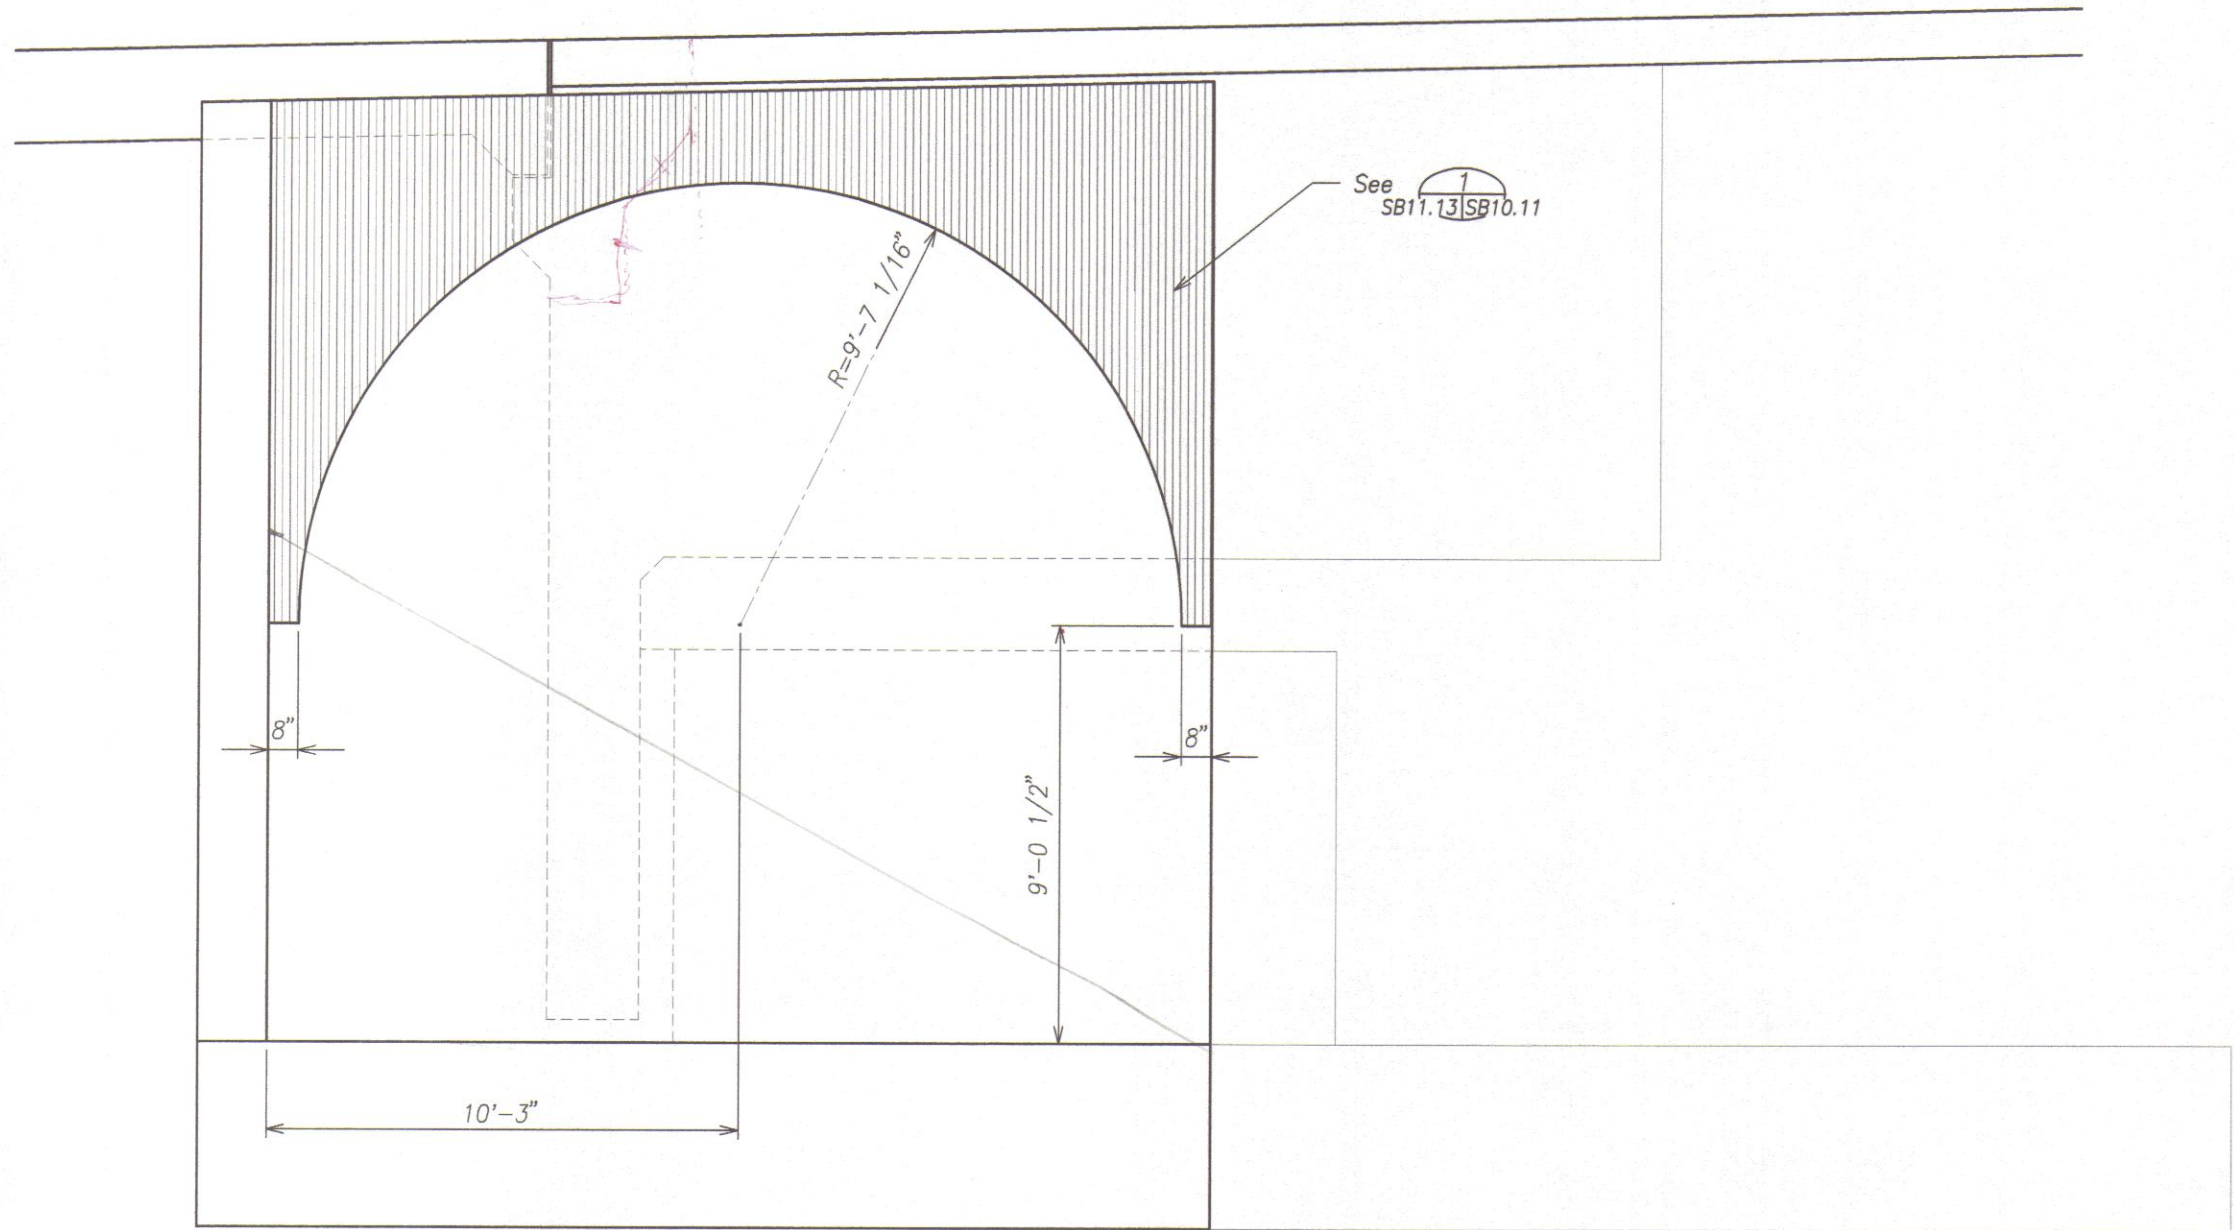

ORIGINAL PLAN	DATE
NO. 1	DATE
NO. 2	DATE
NO. 3	DATE
NO. 4	DATE
NO. 5	DATE
NO. 6	DATE
NO. 7	DATE
NO. 8	DATE
NO. 9	DATE
NO. 10	DATE

DRAWING NAME: 2:00 ONGOING 400150-HONOAPILANI LAHAINA BYPASS-KAHOMA WD 03-30-11 EM END BLOCKS HH-SB1112.DWG PLOT TIME: 03-30-11, 4:26 PM

FASCIA WALL ABUTMENT 2 - MAUKA SIDE
Scale: 1/2" = 1'-0"
A
SB9.4 | SB11.13



THIS WORK WAS PREPARED BY ME OR UNDER MY SUPERVISION.


KSF, INC. APRIL 30, 2012 LIC. EXP. DATE

STATE OF HAWAII
DEPARTMENT OF TRANSPORTATION
HIGHWAYS DIVISION
ABUTMENT 2
FASCIA WALL - MAUKA SIDE
HONOAPILANI HIGHWAY REALIGNMENT, PHASE 1A
Future Keawe St Extension to Lahainaluna Rd, Part B
Fed. Aid Proj. No. NH-030-1(35)R
Scale: As Noted Date: June, 2010
SHEET No. SB11.13 OF 5 SHEETS

DATE	REVISION

DRAWING NAME: Z:\00 ONGOING\40019.0-HONOAPIILANI LAHANA BYPASS-KAHOMA - HDD\12-14-12 BARRIER PULLBOX\HH-SB1201BARRIER PULLBOX.DWG PLOT TIME: 12-14-12, 6:32 PM

Refr. Dwg SB12.1

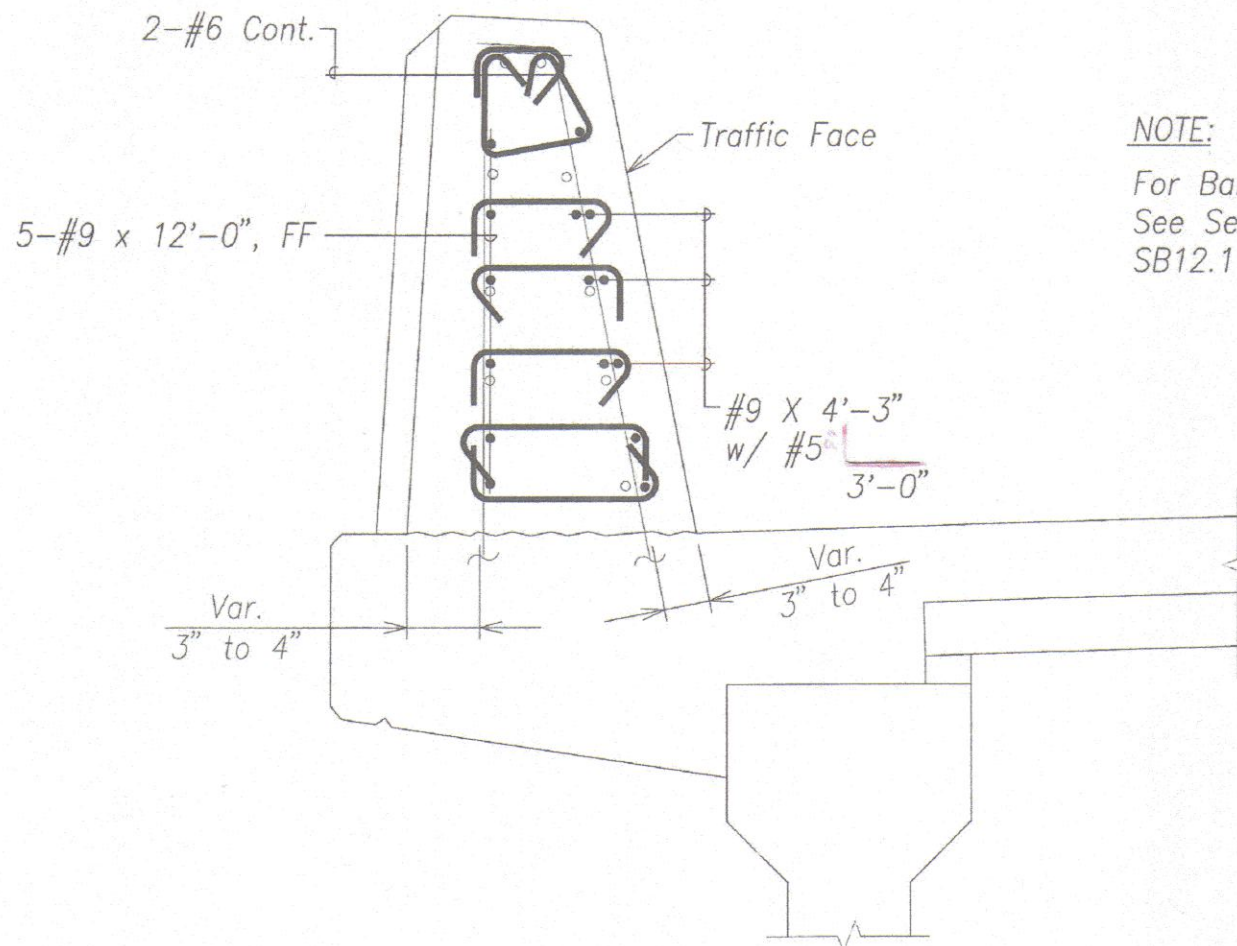

NOTE:

For Balance of Reinforcing
See Section A on Sheet
SB12.1

TYPICAL BARRIER SECTION (OCEAN SIDE SHOWN)

Scale: 1 1/2" = 1'-0"


SK-BR02 SK-BR02

PROJECT
HONOAPIILANI HIGHWAY REALIGNMENT, PHASE 1A

DRAWING TITLE
TYPICAL BARRIER SECTION AT PULLBOX

DATE:
SHEET
SK-BR02
SCALE: AS SHOWN

DRAWING NAME: Z:\00 ONGOING\40019.0-HONOAPIILANI LAHANA BYPASS-KAHOMA - HDCC\12-14-12-BARRIER PULLBOX\HH-SB1201BARRIER PULLBOX.DWG PLOT TIME: 12-14-12, 6:32 PM

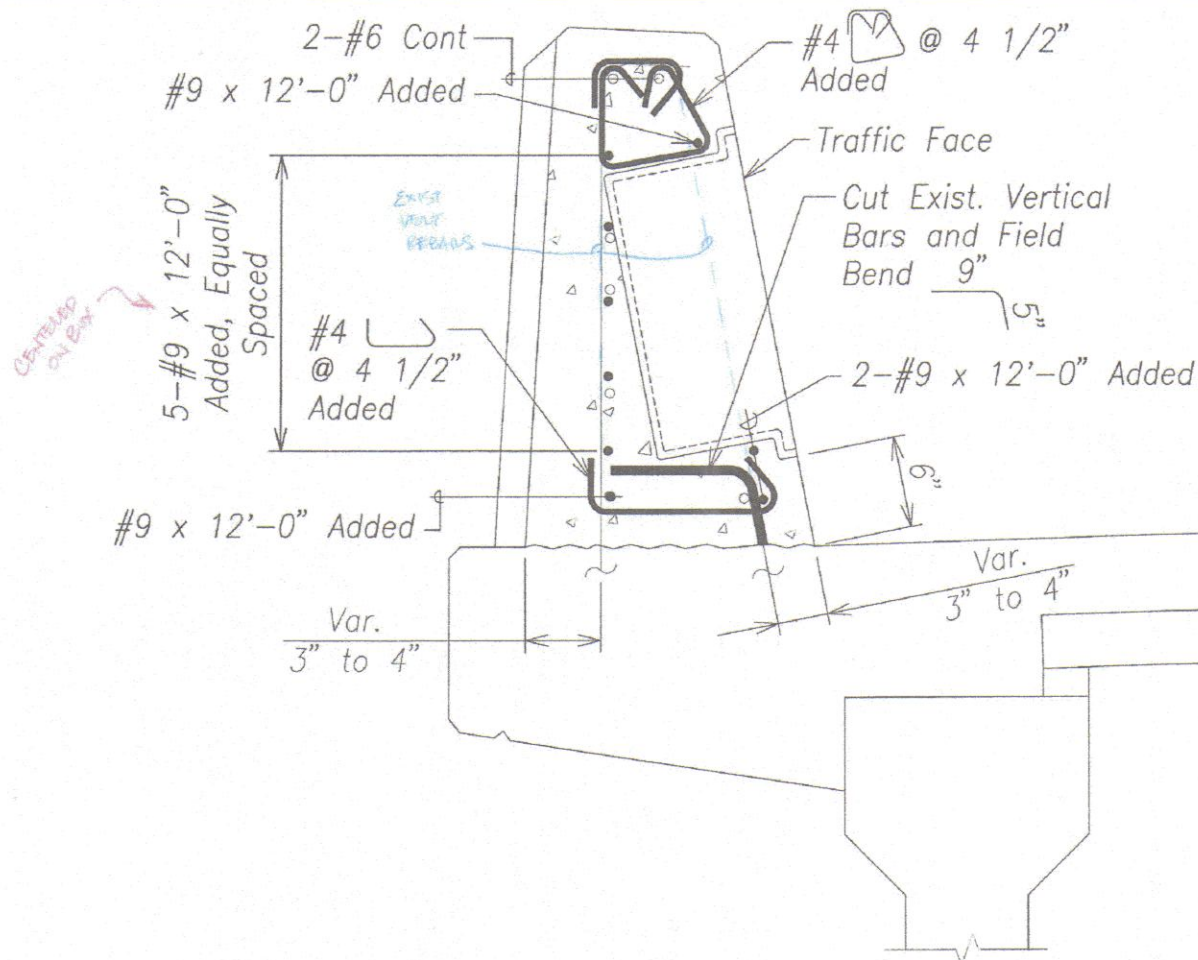

Refr. Dwg SB12.1

NOTE:

For Balance of Reinforcing
See Section A on Sheet
SB12.1

TYPICAL BARRIER SECTION (OCEAN SIDE SHOWN)


Scale: $1 \frac{1}{2}'' = 1'-0''$

A
SK-BR01 SK-BR01

PROJECT
HONOAPIILANI HIGHWAY REALIGNMENT, PHASE 1A

DRAWING TITLE
TYPICAL BARRIER SECTION AT PULLBOX

DATE:
SHEET
SK-BR01
SCALE: AS SHOWN

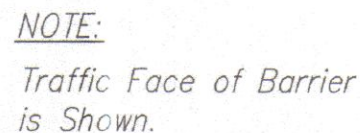

DRAWING TITLE


CONDUIT PULLBOX AT RAILING

SHEET

SK0.2

SCALE: $1 \frac{1}{2}" = 1'-0"$

FED. ROAD DIST. NO.	STATE	FED. AID PROJ. NO.	FISCAL YEAR	SHEET NO.	TOTAL SHEETS
HAWAII	HAW.	NH-030-1(35)R	2009	356	383

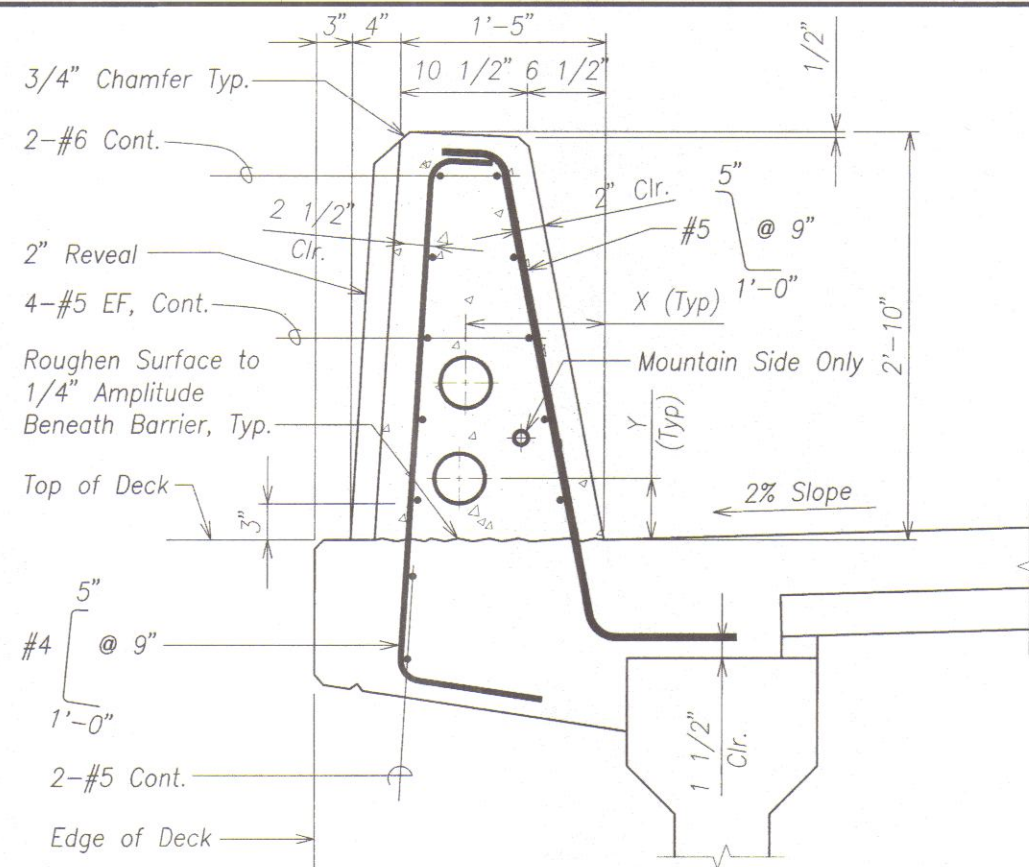

CONDUIT PLACEMENT			
DIA.	TYPE	X	Y
1"	HL	7"	9"
4"	C	1'-0"	5"
4"	C	1'-0"	1'-1"


NOTES:

1. Work this drawing with Sheet SB12.2.
2. See Sheet SB3.3 for Deck reinforcing.

TYPICAL BARRIER SECTION (OCEAN SIDE SHOWN)

Scale: 1 1/2" = 1'-0"



A
SB12.1|SB12.1

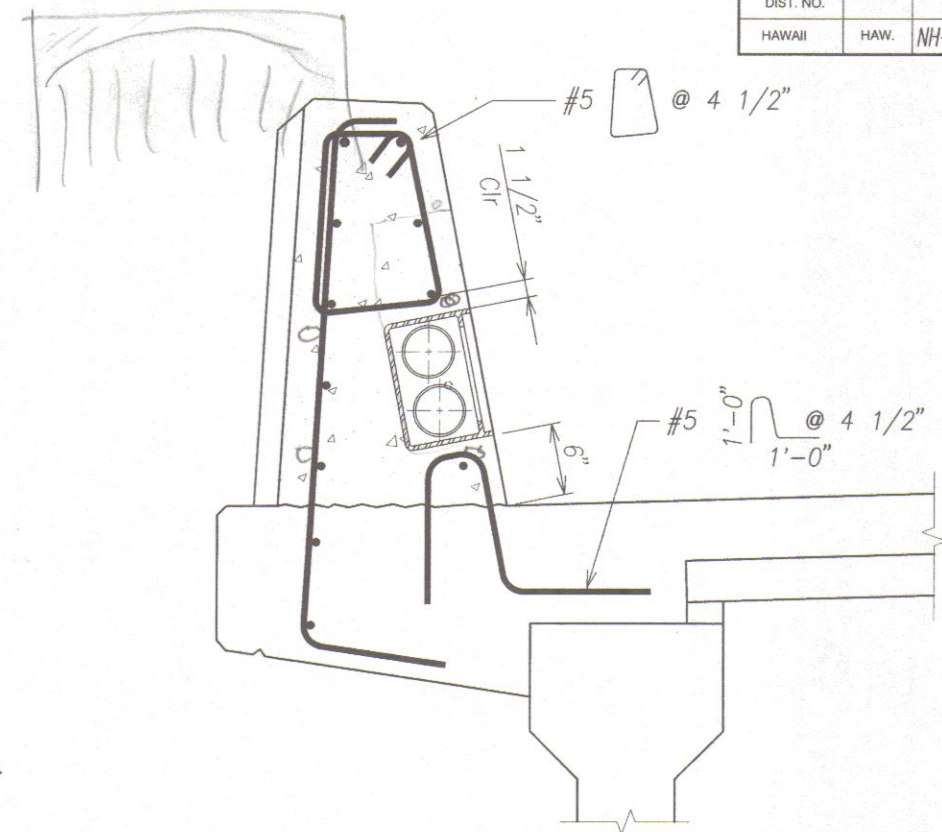

SECTION COMMUNICATION JUNCTION BOX

Scale: 1 1/2" = 1'-0"

B
SB12.1|SB12.1

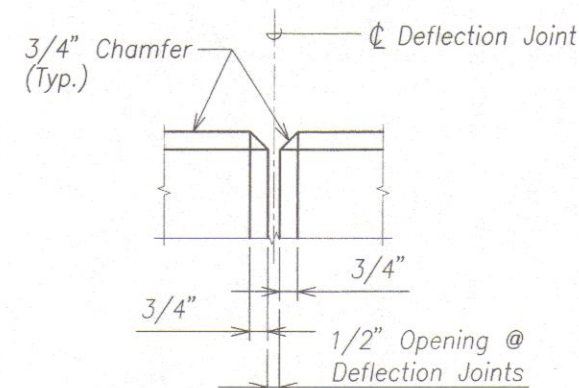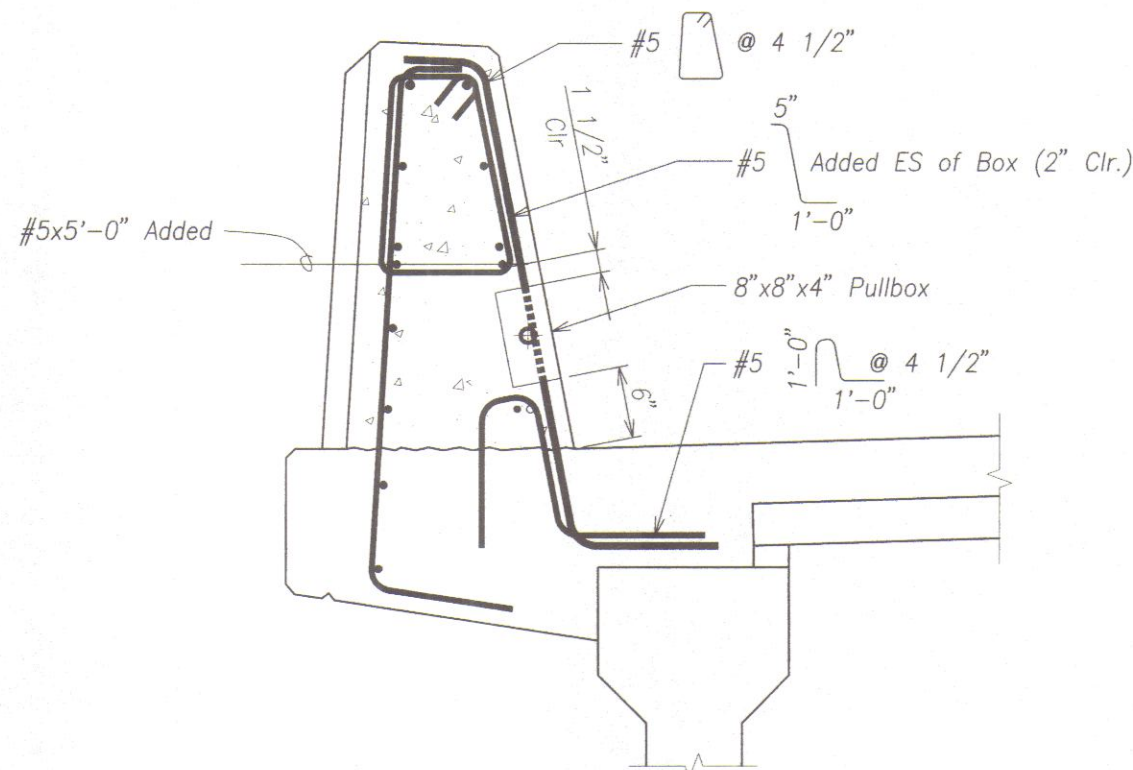

DEFLECTION JOINT DETAIL

Scale: 3" = 1'-0"

1
SB12.1|SB12.1

SECTION AT HIGHWAY LIGHTING PULLBOX

Scale: 1 1/2" = 1'-0"

C
SB12.1|SB12.1



THIS WORK WAS PREPARED BY ME OR UNDER MY SUPERVISION.

David K. Fujiwara
KSF, INC.
APRIL 30, 2012
LIC. EXP. DATE

STATE OF HAWAII
DEPARTMENT OF TRANSPORTATION
HIGHWAYS DIVISION

CONCRETE RAILING SECTIONS AND DETAIL

HONOAPIILANI HIGHWAY REALIGNMENT, PHASE 1A

Future Keawe St Extension to Lahainaluna Rd, Part B

Fed. Aid Proj. No. NH-030-1(35)R

Scale: As Noted

Date: June, 2010


SHEET No. SB12.1 OF 4 SHEETS

FINAL DESIGN 356


SURVEY PLOTTED BY	DATE
DRAWN BY	
TRACED BY	
DESIGNED BY	
QUANTITIES BY	
CHECKED BY	
ORIGINAL PLAN	
NOTE BOOK	
No.	

DRAWING NAME: Z:\00 ONGOING\40019.0-HONOAPIILANI LAHAINA BYPASS-KAHOMA WO\06-15-10 COMBINE LAHAINA FINAL DESIGN\H-SB1201.DWG PLOT TIME: 06-14-10, 8:22 PM


FED. ROAD DIST. NO.	STATE	FED. AID PROJ. NO.	FISCAL YEAR	SHEET NO.	TOTAL SHEETS
HAWAII	HAW.	NH-030-1(35)R	2009		383

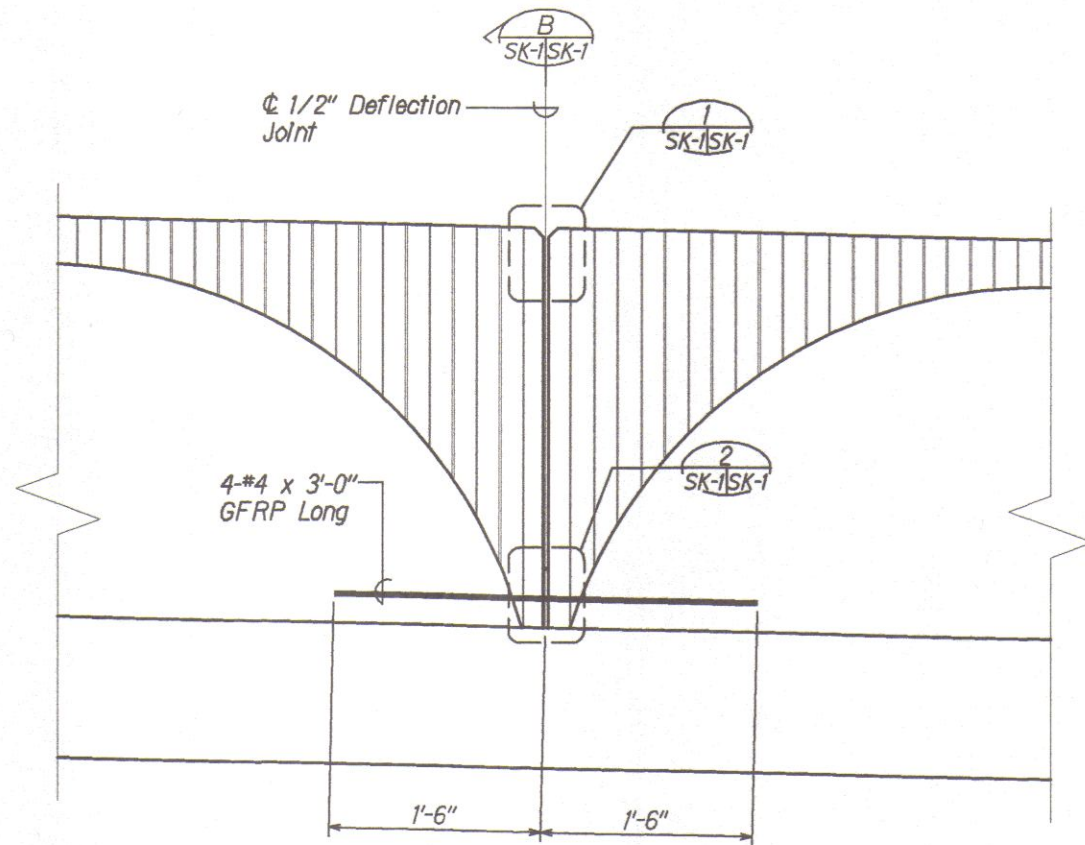


RAILING ELEVATION AT DEFLECTION JOINT
Scale: 1 1/2" = 1'-0"
A SK-1 SK-1

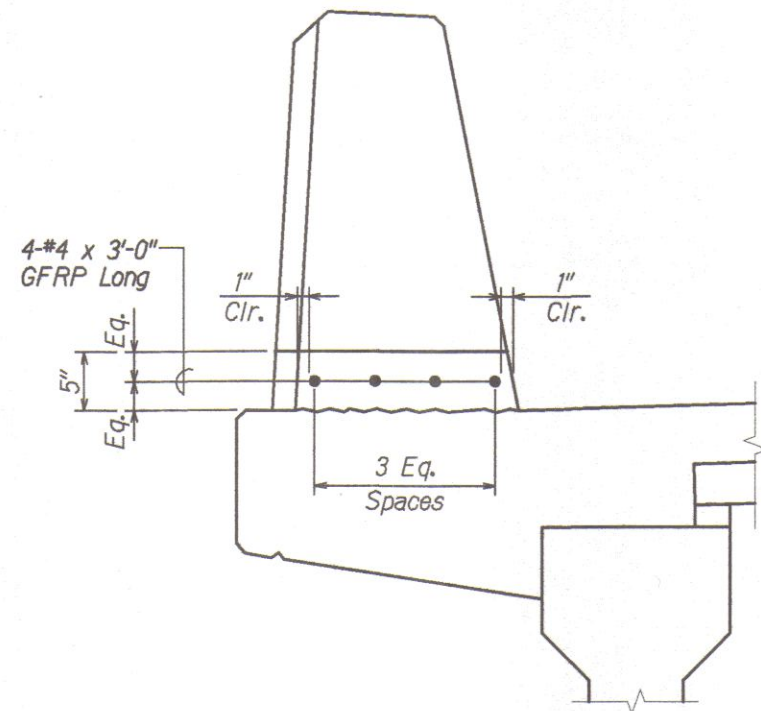

SECTION AT DEFLECTION JOINT
Scale: 1 1/2" = 1'-0"
B SK-1/SK-1

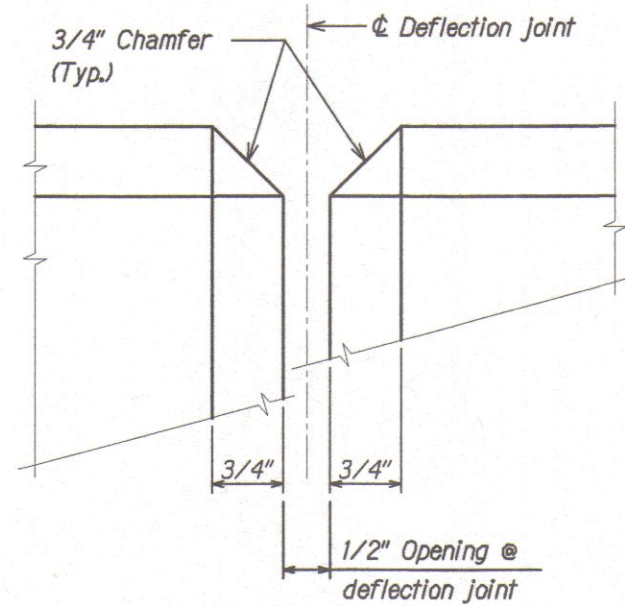

JOINT DETAIL 1
Scale: 12" = 1'-0"
SK-1 SK-1

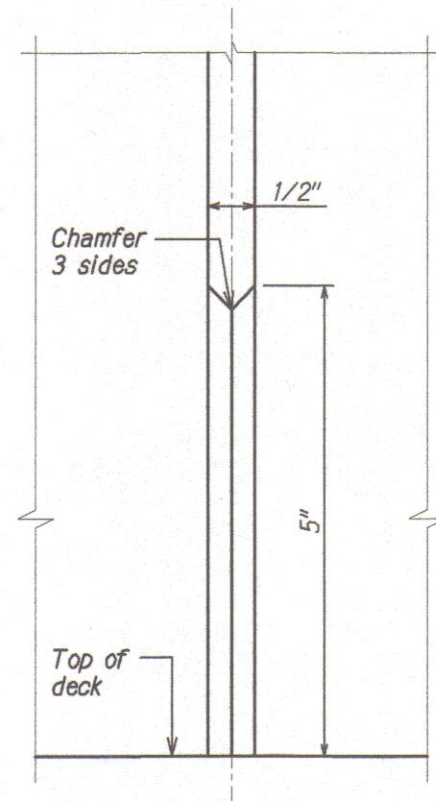

JOINT DETAIL 2
Scale: 12" = 1'-0"
SK-1 SK-1

THIS WORK WAS PREPARED BY ME
OR UNDER MY SUPERVISION.

KSF, INC. APRIL 30, 2012
LIC. EXP. DATE

STATE OF HAWAII DEPARTMENT OF TRANSPORTATION HIGHWAYS DIVISION	
KAHOMA STREAM BRIDGE	
DEFLECTION JOINT DETAILS	
HONOPILANI HIGHWAY REALIGNMENT, PHASE 1A	
Future Keawe St Extension to Lahainaluna Rd, Part B	
Fed. Aid Proj. No. NH-030-1(35)R	
Scale: As Noted	Date: Sept. 18, 2012
SHEET No. SK-01 OF	SHEETS


DATE	REVISION

ADDOGO.

DESIGNED BY	DATE
CHECKED BY	
IN CHARGE	
PROJECT NO.	
PROJECT NAME	


DRAWING NAME: 21-00 ONGOING\40019.0-HONOPILANI LAHAINA BYPASS-KAHOMA - HCCC\09-27-12 REV ENDBLOCK\HH-SB1200 FORM LINER.DWG PLOT TIME: 09-27-12, 2:53 PM

FED. ROAD DIST. NO.	STATE	PROJ. NO.	FISCAL YEAR	SHEET NO.	TOTAL SHEETS
HAWAII	HAW.	NH-030-1(38)	2010	00	-

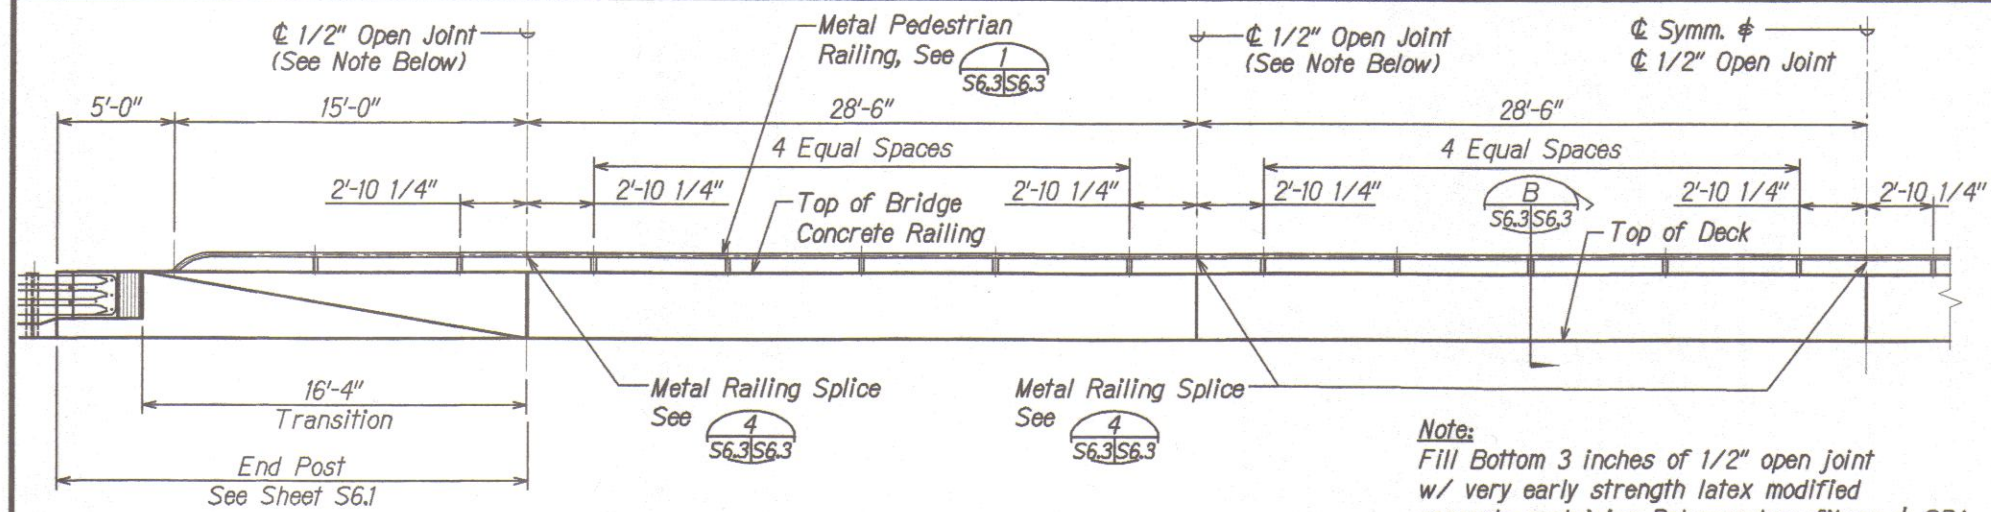


TYPICAL RAILING ELEVATION (A)
Scale: 1/4" = 1'-0"
S6.3 S6.3

Note:
Fill Bottom 3 inches of 1/2" open joint w/ very early strength latex modified concrete containing Polypropylene fibers & SRA.

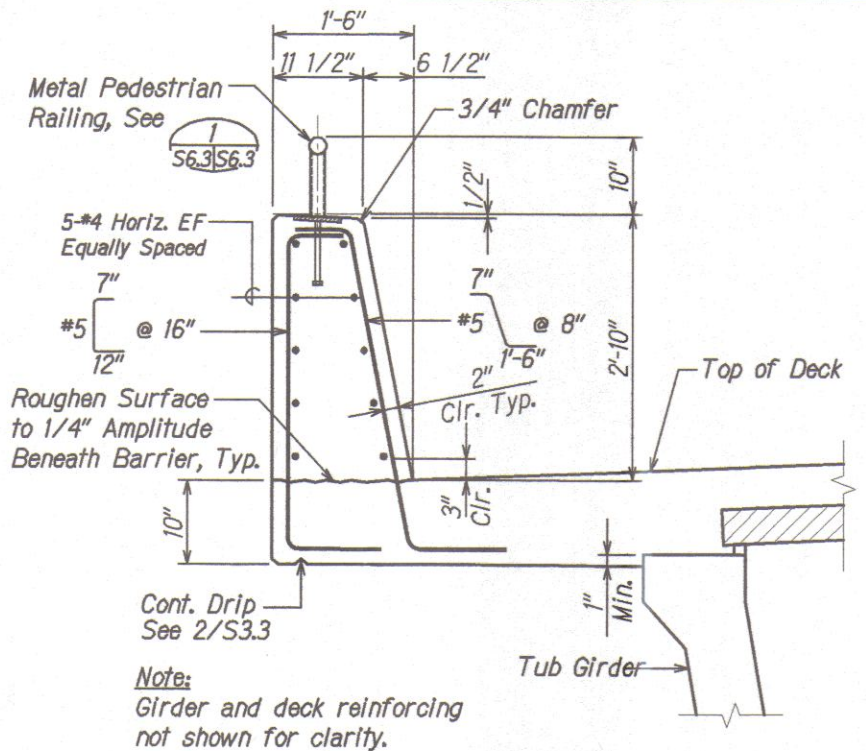


TYPICAL RAILING SECTION (B)
Scale: 1" = 1'-0"
S6.3 S6.3

Note:
Girder and deck reinforcing not shown for clarity.

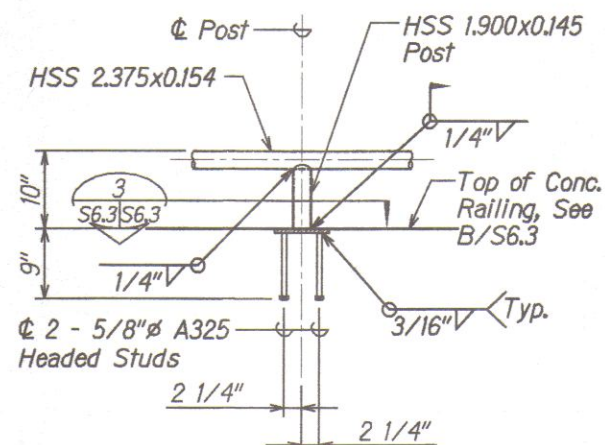


TYPICAL RAILING POST CONNECTION (1)
Scale: 1" = 1'-0"
S6.3 S6.3

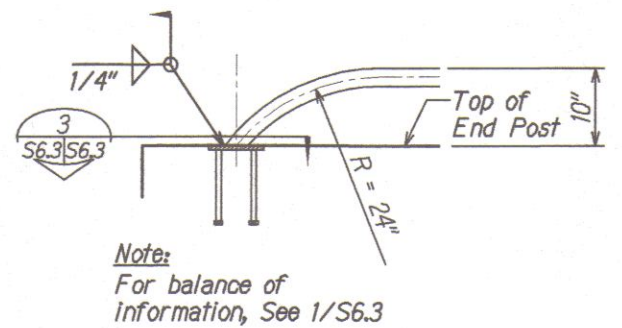


TYPICAL RAILING POST CONNECTION AT END POST (2)
Scale: 1" = 1'-0"
S6.3 S6.3

Note:
For balance of Information, See 1/S6.3

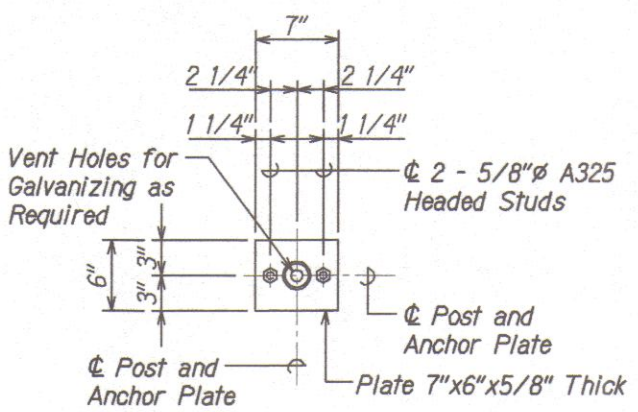

TYPICAL RAILING ANCHOR PLATE DETAIL (3)
Scale: 1 1/2" = 1'-0"
S6.3 S6.3

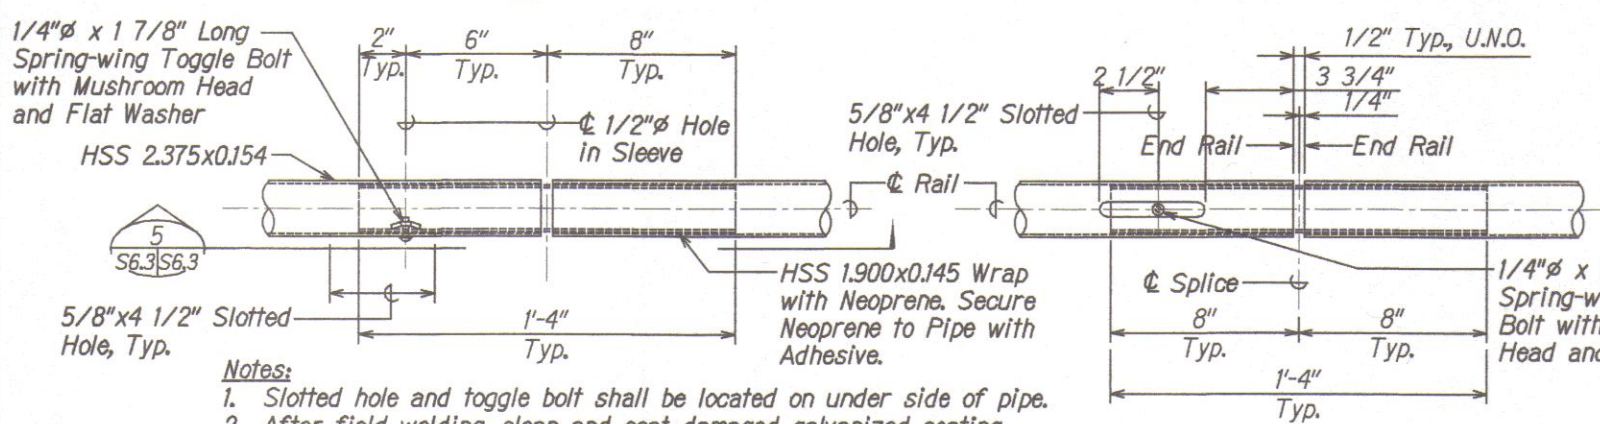


SECTION 5
Scale: 3" = 1'-0"
S6.3 S6.3

- Notes:**
1. Slotted hole and toggle bolt shall be located on under side of pipe.
 2. After field welding, clean and coat damaged galvanized coating according to Specs. Sect. 501.03 (GX2).
 3. Metal pedestrian railing shall be painted according to paint schedule and notes, See original contract documents on plan sheet 114 (Sheet No, S1.1 of 54 sheets)



TYPICAL RAILING ANCHOR PLATE DETAIL (4)
Scale: 3" = 1'-0"
S6.3 S6.3

STATE OF HAWAII
DEPARTMENT OF TRANSPORTATION
HIGHWAYS DIVISION
BRIDGE RAILING ELEVATION, SECTIONS AND DETAILS
HONOLULU HIGHWAY REALIGNMENT PHASE 1B-1
Lahaina Rd. to Hukiloko Pl.
Federal Aid Project No. NH-030-1(38)
Scale: As Shown Date: Dec. 28, 2011
SHEET No. **S6.3** OF SHEETS

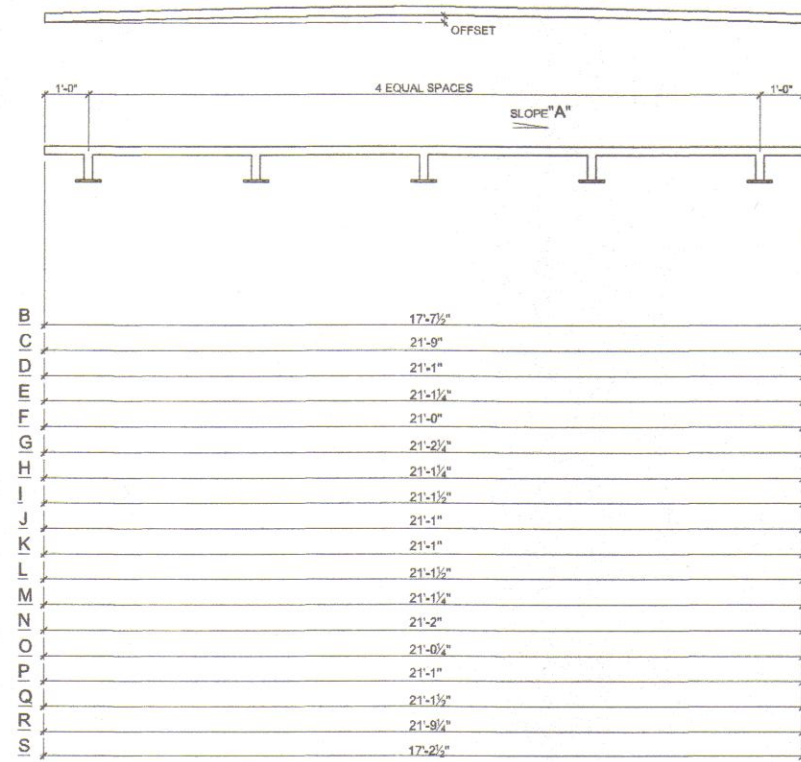


B	17'-7 1/2"
C	21'-9"
D	21'-1"
E	21'-1 1/4"
F	21'-0"
G	21'-2 1/4"
H	21'-1 1/4"
I	21'-1 1/2"
J	21'-1"
K	21'-1"
L	21'-1 1/2"
M	21'-1 1/4"
N	21'-2"
O	21'-0 1/4"
P	21'-1"
Q	21'-1 1/2"
R	21'-9 1/4"
S	17'-2 1/2"


SLOPE - 12"		
"A"	"B"	OFFSET
1/4"	3/8"	1/4"
1/4"	1/2"	3/4"
1/4"	5/8"	5/8"
1/4"	3/4"	3/4"
1/4"	7/8"	3/8"
1/4"	1"	1/4"
1/4"	1 1/8"	3/8"
1/4"	1 1/4"	1/2"
1/4"	1 1/2"	3/4"
1/4"	1 3/4"	1"
1/4"	2"	1 1/4"
1/4"	2 1/4"	1 1/2"
1/4"	2 1/2"	1 3/4"
1/4"	2 3/4"	2"
1/4"	3"	2 1/4"
1/4"	3 1/4"	2 1/2"
1/4"	3 1/2"	2 3/4"
1/4"	3 3/4"	3"
1/4"	4"	3 1/4"
1/4"	4 1/4"	3 1/2"
1/4"	4 1/2"	3 3/4"
1/4"	4 3/4"	4"
1/4"	5"	4 1/4"
1/4"	5 1/4"	4 1/2"
1/4"	5 1/2"	4 3/4"
1/4"	5 3/4"	5"
1/4"	6"	5 1/4"
1/4"	6 1/4"	5 1/2"
1/4"	6 1/2"	5 3/4"
1/4"	6 3/4"	6"
1/4"	7"	6 1/4"
1/4"	7 1/4"	6 1/2"
1/4"	7 1/2"	6 3/4"
1/4"	7 3/4"	7"
1/4"	8"	7 1/4"
1/4"	8 1/4"	7 1/2"
1/4"	8 1/2"	7 3/4"
1/4"	8 3/4"	8"
1/4"	9"	8 1/4"
1/4"	9 1/4"	8 1/2"
1/4"	9 1/2"	8 3/4"
1/4"	9 3/4"	9"
1/4"	10"	9 1/4"
1/4"	10 1/4"	9 1/2"
1/4"	10 1/2"	9 3/4"
1/4"	10 3/4"	10"
1/4"	11"	10 1/4"
1/4"	11 1/4"	10 1/2"
1/4"	11 1/2"	10 3/4"
1/4"	11 3/4"	11"
1/4"	12"	11 1/4"
1/4"	12 1/4"	11 1/2"
1/4"	12 1/2"	11 3/4"
1/4"	12 3/4"	12"
1/4"	13"	12 1/4"
1/4"	13 1/4"	12 1/2"
1/4"	13 1/2"	12 3/4"
1/4"	13 3/4"	13"
1/4"	14"	13 1/4"
1/4"	14 1/4"	13 1/2"
1/4"	14 1/2"	13 3/4"
1/4"	14 3/4"	14"
1/4"	15"	14 1/4"
1/4"	89 3/4"	89"
1/4"	90"	89 1/4"
1/4"	90 1/4"	89 1/2"
1/4"	90 1/2"	89 3/4"
1/4"	90 3/4"	90"
1/4"	91"	90 1/4"
1/4"	91 1/4"	90 1/2"
1/4"	91 1/2"	90 3/4"
1/4"	91 3/4"	91"
1/4"	92"	91 1/4"
1/4"	92 1/4"	91 1/2"
1/4"	92 1/2"	91 3/4"
1/4"	92 3/4"	92"
1/4"	93"	92 1/4"
1/4"	93 1/4"	92 1/2"
1/4"	93 1/2"	92 3/4"
1/4"	93 3/4"	93"
1/4"	94"	93 1/4"
1/4"	94 1/4"	93 1/2"
1/4"	94 1/2"	93 3/4"
1/4"	94 3/4"	94"
1/4"	95"	94 1/4"
1/4"	95 1/4"	94 1/2"
1/4"	95 1/2"	94 3/4"
1/4"	95 3/4"	95"
1/4"	96"	95 1/4"
1/4"	96 1/4"	95 1/2"
1/4"	96 1/2"	95 3/

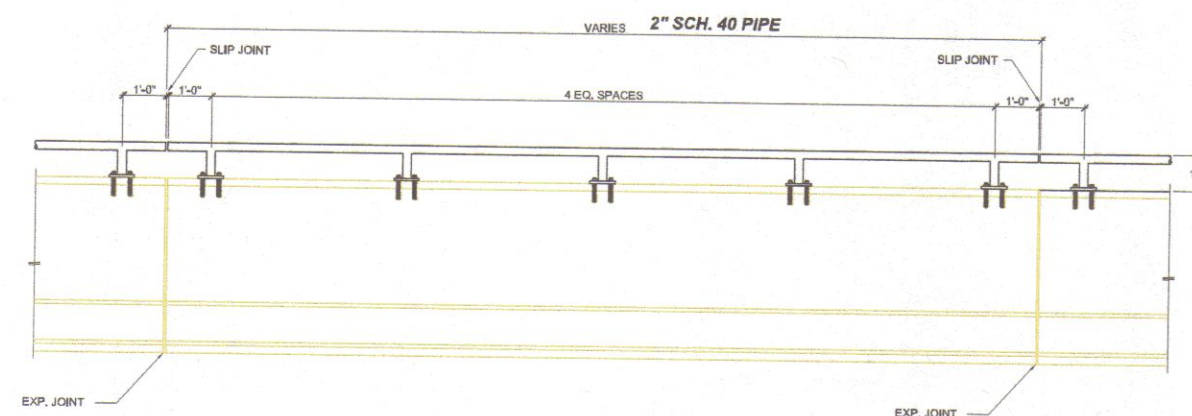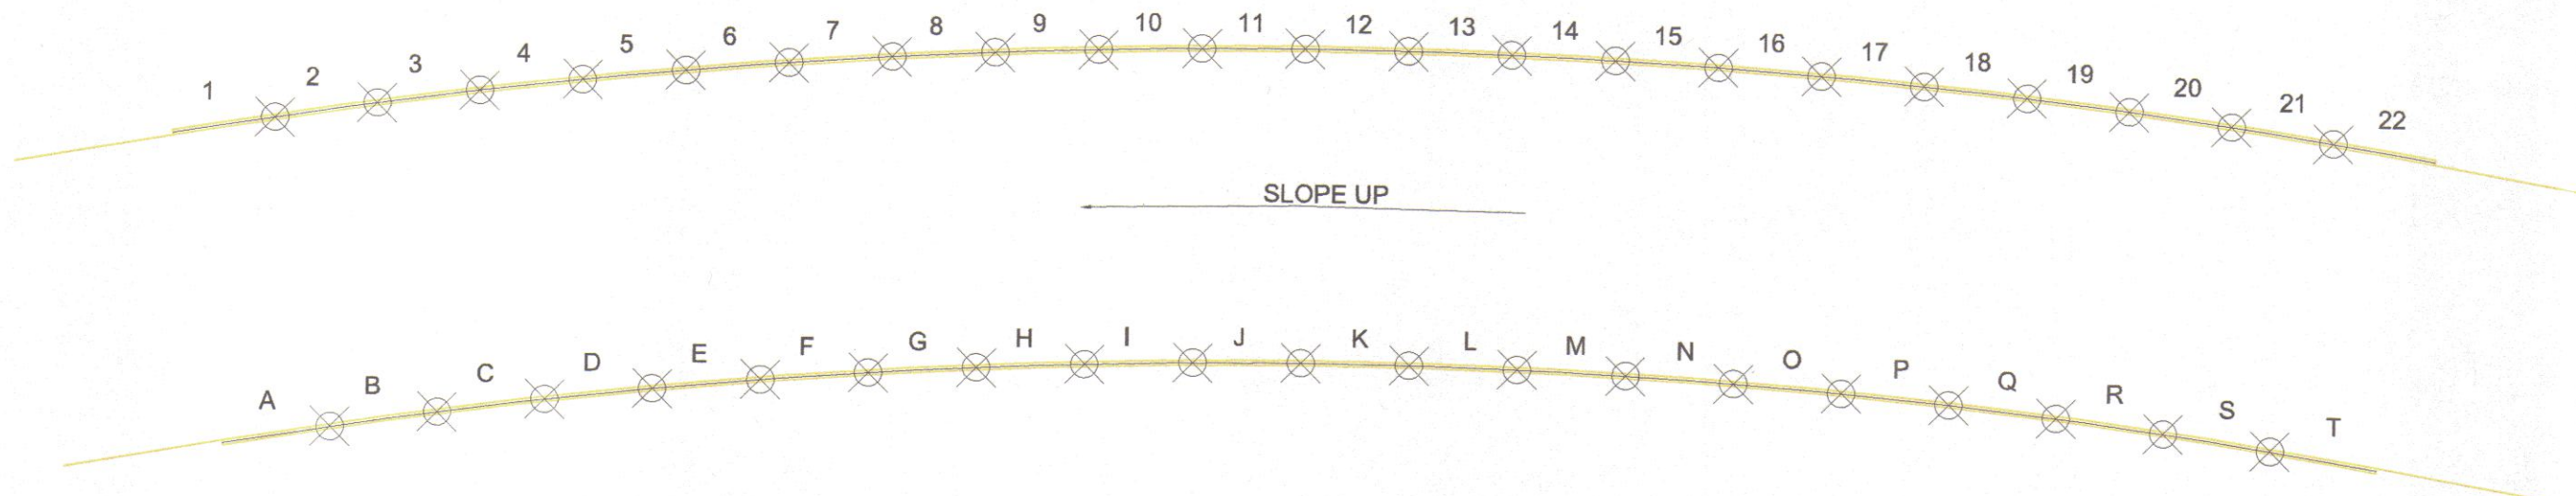


TYPICAL RAILING ELEVATION
1/2" = 1'-0"

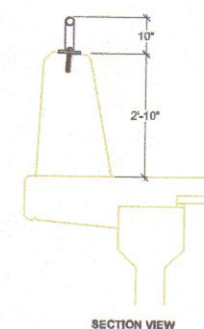


GALVANIZED AFTER FABRICATION

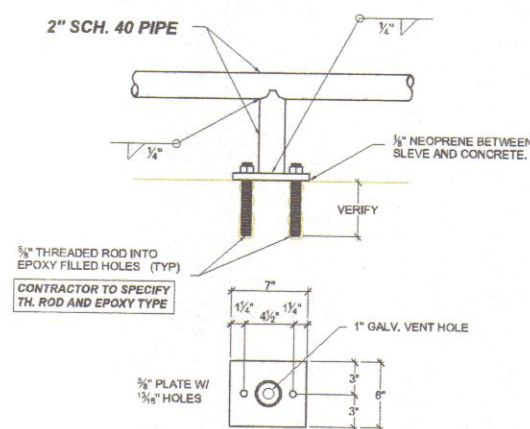

TYPICAL RAILING POST DETAILS
1/2" = 1'-0"

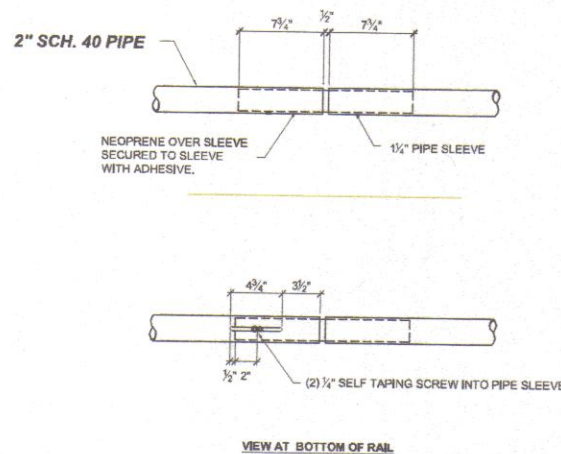

TYPICAL RAILING SPLICE DETAILS AT SLIP JOINT
1/2" = 1'-0"

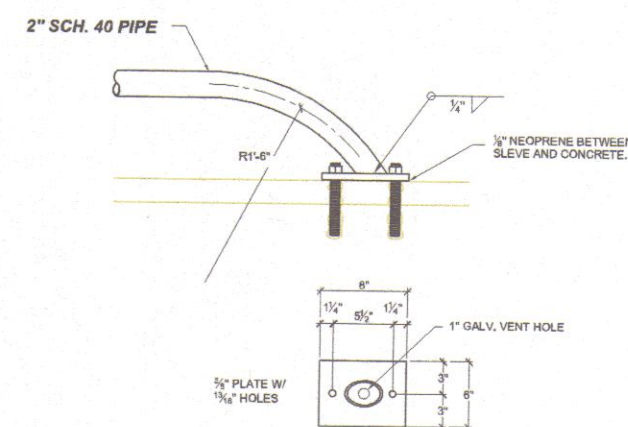


TYPICAL RAILING END DETAILS
1/2" = 1'-0"

430 Holes/bats
3/4" x 8" max.

MAUI BRIDGE RAIL

HONOPILANI HIGHWAY


KWL SERVICES, INC.
94-092 LEOKANE STREET WAIPAHU, HAWAII 96797
PHONE NO. 676-1808 FAX NO. 677-4081

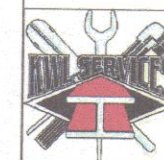

DESIGNED BY: D.H.
DATE: APRIL 13, 2013
SCALE: 1/2" = 1'-0"

A1


FED. ROAD DIST. NO.	STATE	FED. AID PROJ. NO.	FISCAL YEAR	SHEET NO.	TOTAL SHEETS
HAWAII	HAW.	NH-030-1(35)R	2009	357	383

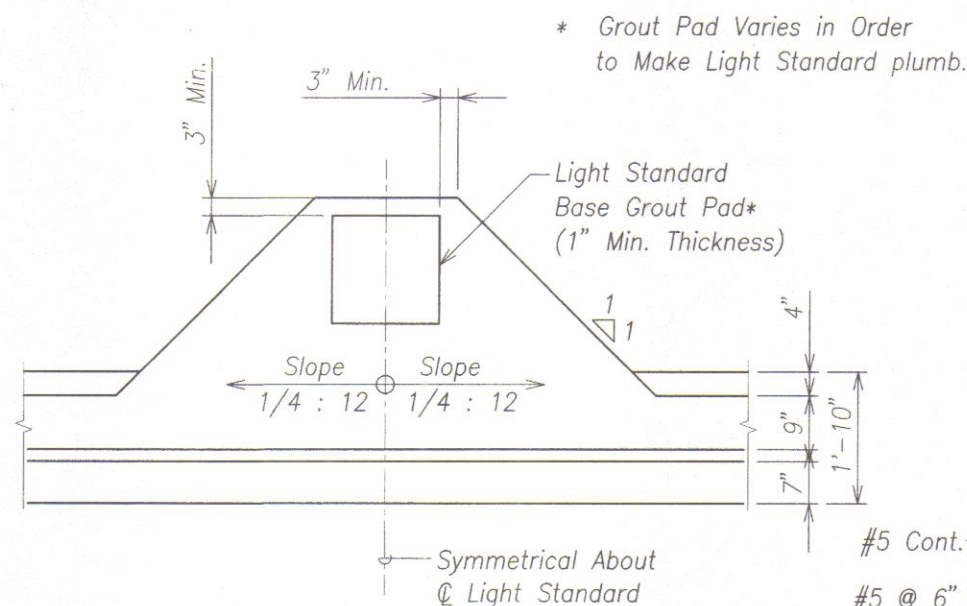

PLAN - THICKENED PARAPET AT LIGHT STANDARD

Scale: 3/4" = 1'-0"

A
SB12.2|SB12.2

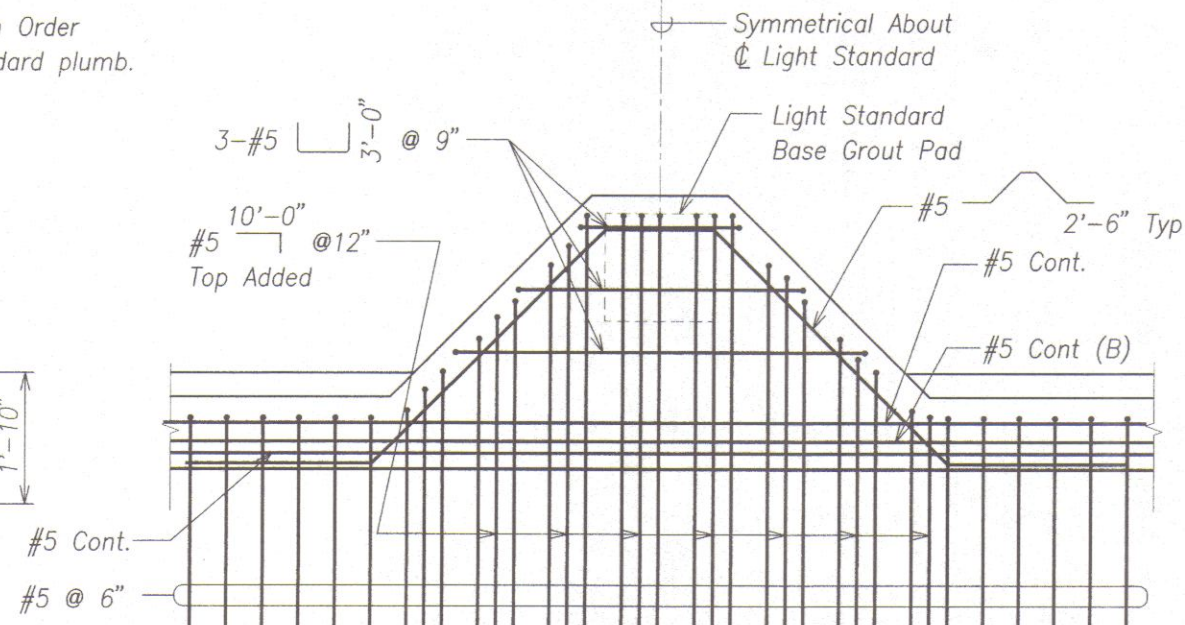


DECK REINFORCING AT LIGHT STANDARD

Scale: 3/4" = 1'-0"

B
SB12.2|SB12.2


NOTE:
#4 @ 6" not shown for clarity.

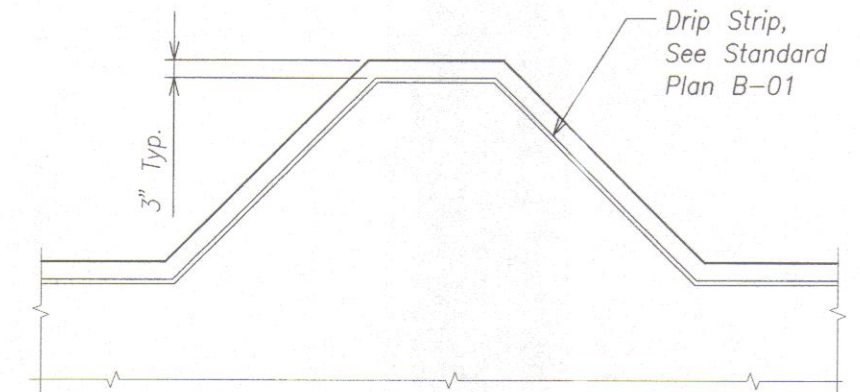

DRIP STRIP DETAIL AT LIGHT STANDARD (LOOKING AT SOFFIT)

Scale: 3/4" = 1'-0"


C
SB12.2|SB12.2

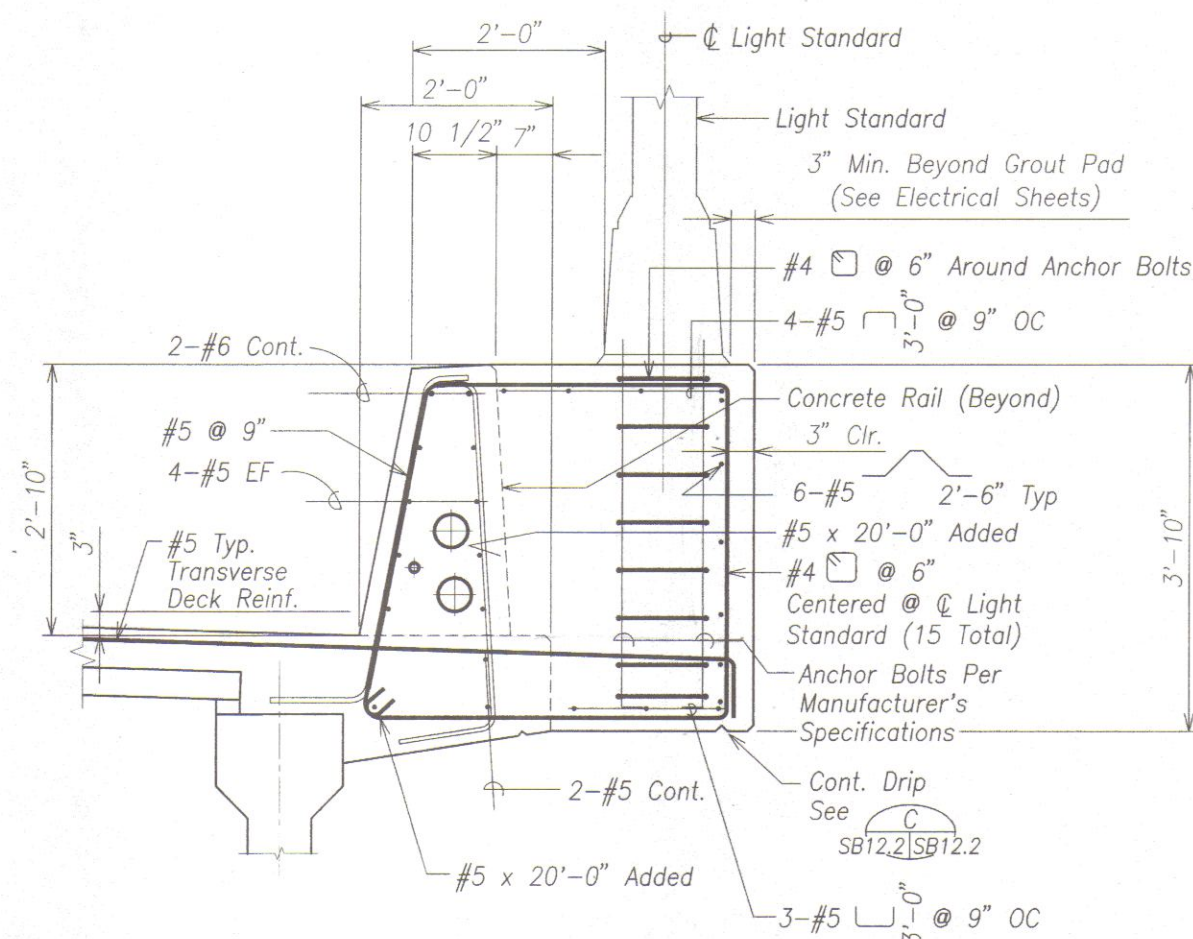

PARAPET THICKENED PARAPET AT LIGHT STANDARD

Scale: 1/2" = 1'-0"

D
SB12.2|SB12.2

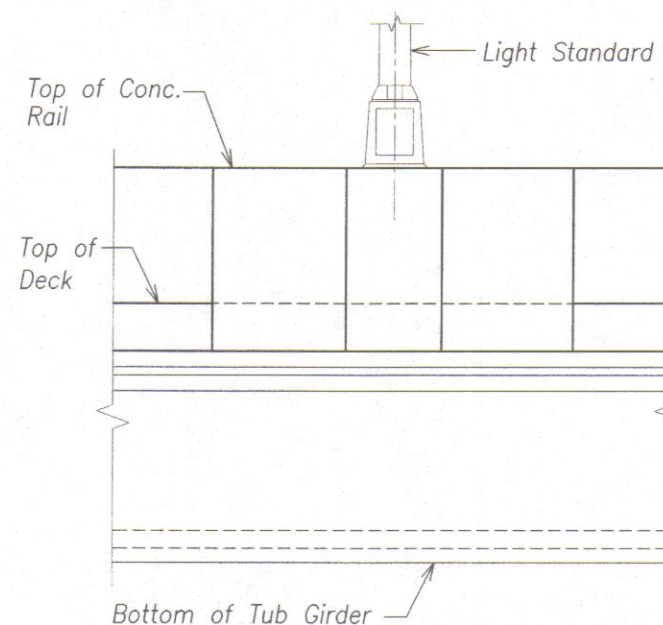

ELEVATION - THICKENED PARAPET AT LIGHT STANDARD

Scale: 1/2" = 1'-0"

E
SB12.2|SB12.2

TYPICAL NOTE:
Deck reinforcing not shown for clarity.




THIS WORK WAS PREPARED BY ME OR UNDER MY SUPERVISION.
David K. Fujiwara
KSF, INC. APRIL 30, 2012
LIC. EXP. DATE

STATE OF HAWAII
DEPARTMENT OF TRANSPORTATION
HIGHWAYS DIVISION
THICKENED PARAPET AT LIGHT STANDARD SECTIONS
HONOAPIILANI HIGHWAY REALIGNMENT, PHASE 1A
Future Keawe St Extension to Lahainaluna Rd, Part B
Fed. Aid Proj. No. NH-030-1(35)R
Scale: As Noted Date: June, 2010
SHEET No. SB12.20F 4 SHEETS

DRAWING NAME: 21.00 ONCONG\10019.0-HONOAPIILANI LAHAINA BYPASS-KAHOMA WD\06-15-10 COMBINE LAHAINA FINAL DESIGN\WH-SB1202.DWG PLOT TIME: 06-14-10, 8:23 PM

ORIGINAL PLAN	DATE
SURVEY OBTAINED BY	DATE
DRAWN BY	DATE
DESIGNED BY	DATE
QUANTITIES BY	DATE
CHECKED BY	DATE


FED. ROAD DIST. NO.	STATE	FED. AID PROJ. NO.	FISCAL YEAR	SHEET NO.	TOTAL SHEETS
HAWAII	HAW.	NH-030-1(35)R	2009	358	383

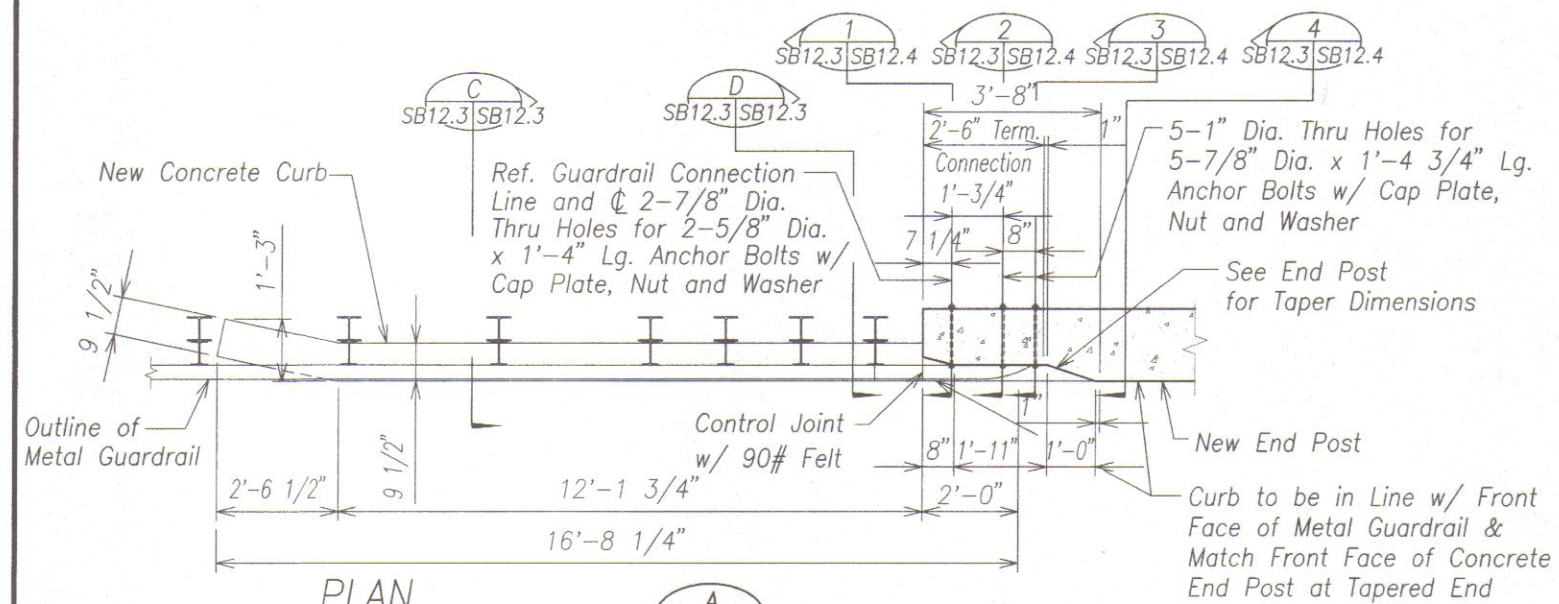

PLAN

Scale: 1/2" = 1'-0"


SB12.3|SB12.3

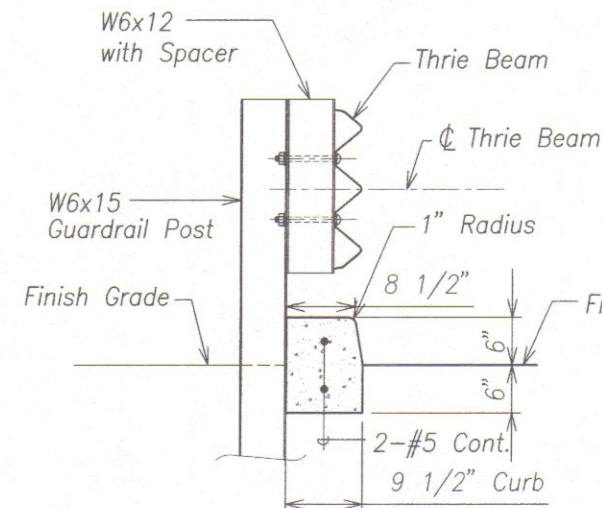

SECTION C

Scale: 1" = 1'-0"


SB12.3|SB12.3

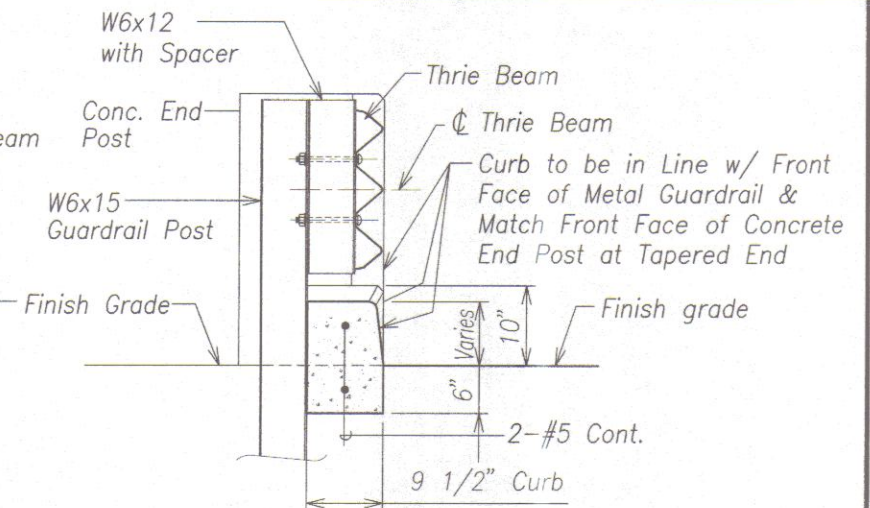

SECTION D

Scale: 1" = 1'-0"


SB12.3|SB12.3

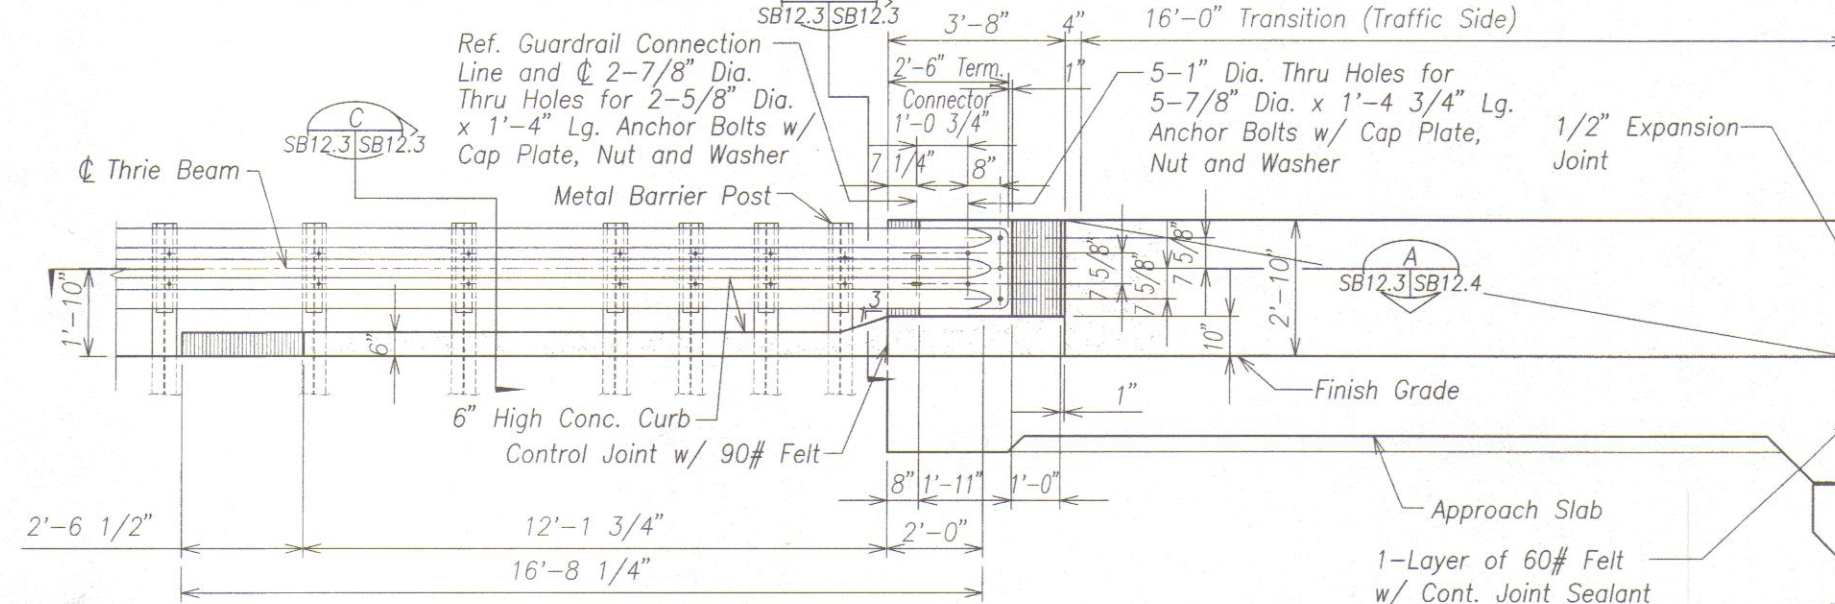

ELEVATION

Scale: 1/2" = 1'-0"


SB12.3|SB12.3

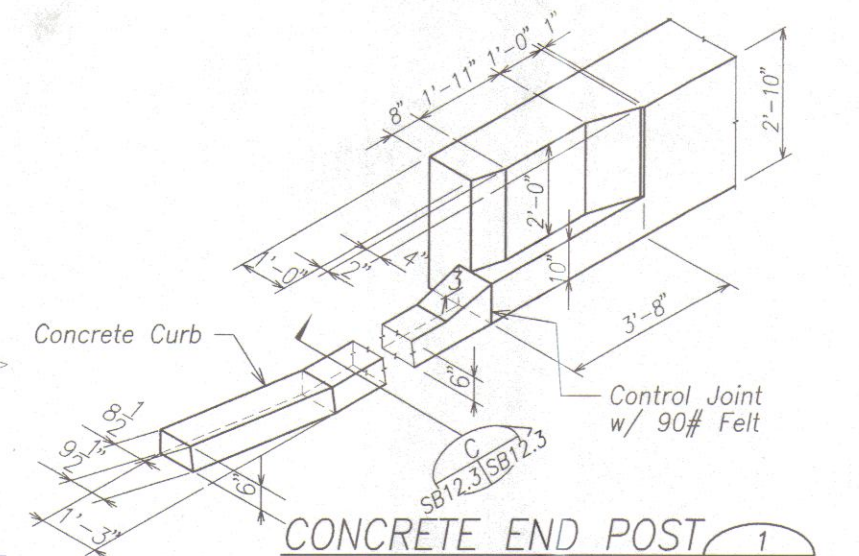

CONCRETE END POST

Scale: Not to scale

SB12.3|SB12.3

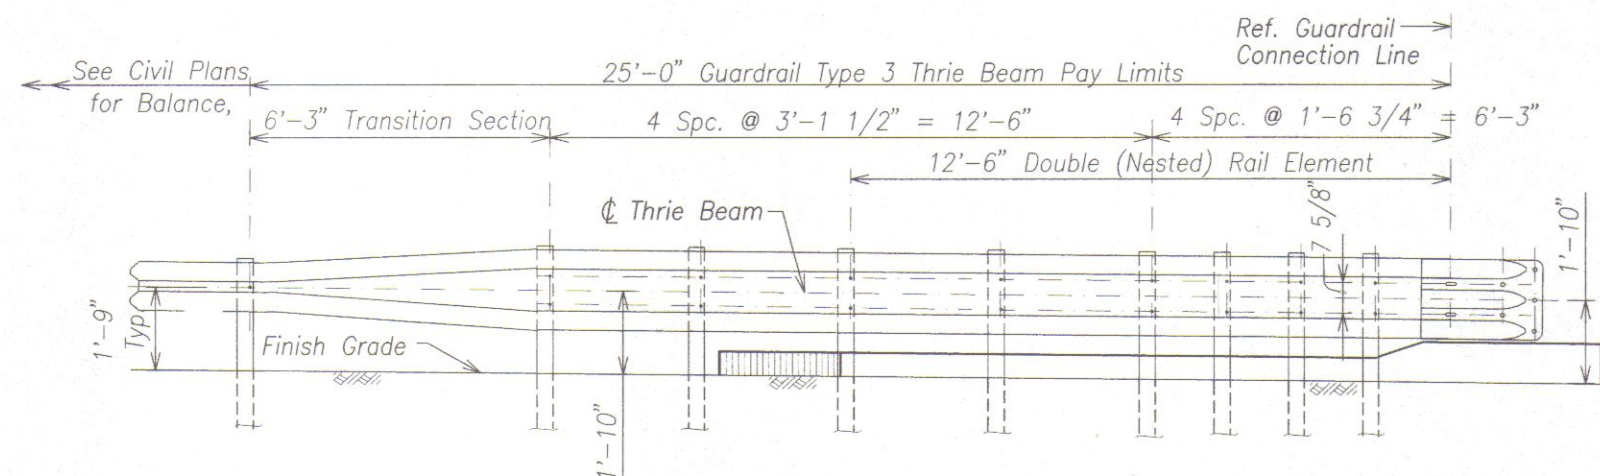

TYPICAL TYPE 3 THRIE BEAM METAL GUARDRAIL FOR END POST ELEVATION

Scale: 1/2" = 1'-0"

SB12.3|SB12.3




THIS WORK WAS PREPARED BY ME OR UNDER MY SUPERVISION.
David K. Fujiwara
KSF, INC. APRIL 30, 2012
LIC. EXP. DATE

STATE OF HAWAII
DEPARTMENT OF TRANSPORTATION
HIGHWAYS DIVISION
**GUARD RAIL AND END POST - PLAN
ELEVATION, SECTIONS AND DETAILS**
HONOAPIILANI HIGHWAY REALIGNMENT, PHASE 1A
Future Keawe St Extension to Lahainaluna Rd, Part B
Fed. Aid Proj. No. NH-030-1(35)R
Scale: As Noted Date: June, 2010
SHEET No. SB12.3 OF 4 SHEETS


DRAWING NAME: 2A.00 ONCONG 10019.0-HONOAPIILANI LAHAINA BYPASS-KAHOMA WD 06-15-10 COMBINE LAHAINA FINAL DESIGN\HAW-SB1203.DWG PLOT TIME: 06-14-10, 8:24 PM

DATE	
SURVEY PROVIDED BY	
DESIGNED BY	
TRACED BY	
NOTE BOOK	
QUANTITIES BY	
CHECKED BY	
No.	


FED. ROAD DIST. NO.	STATE	FED. AID PROJ. NO.	FISCAL YEAR	SHEET NO.	TOTAL SHEETS
HAWAII	HAW.	NH-030-1(35)R	2009	359	383

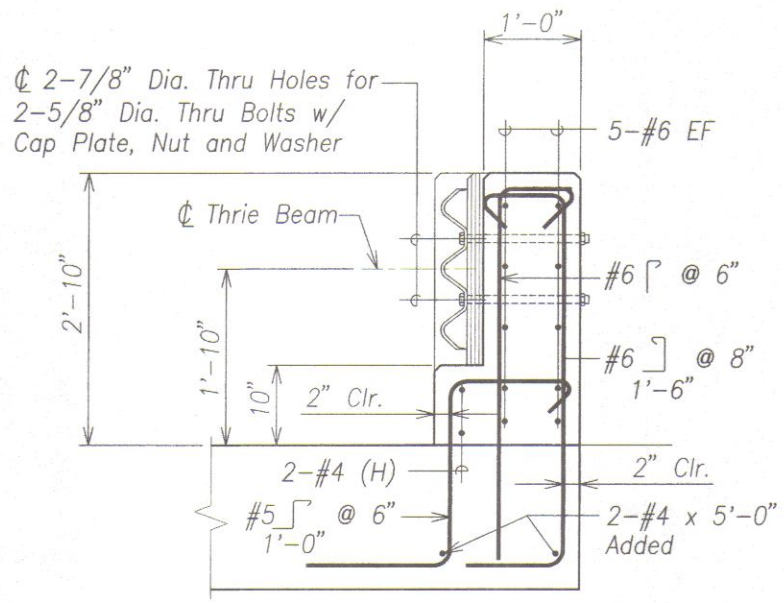


SECTION 1
Scale: 1" = 1'-0" SB12.3 SB12.4

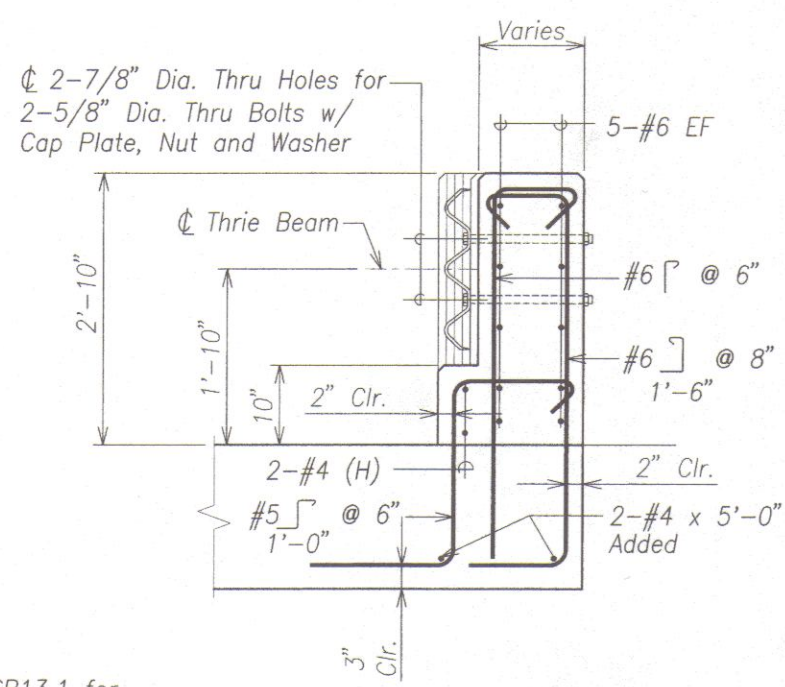


SECTION 2
Scale: 1" = 1'-0" SB12.3 SB12.4

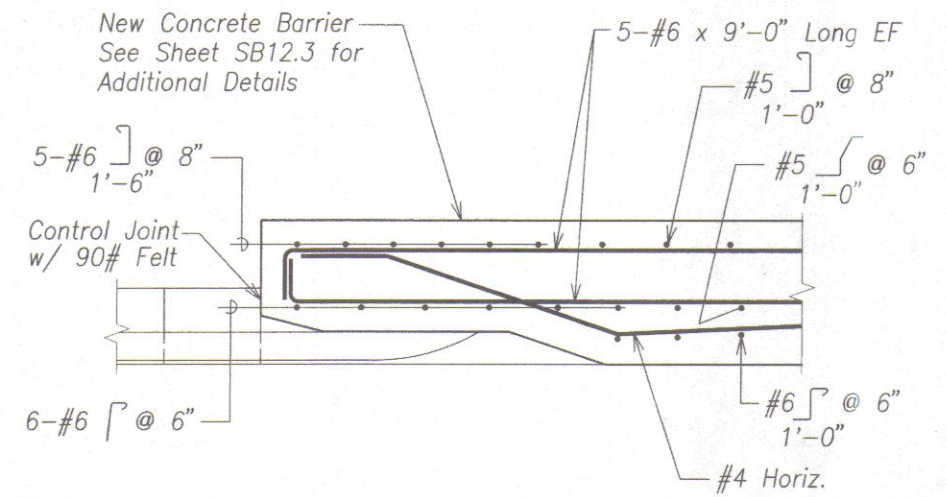


PLAN A
Scale: 1" = 1'-0" SB12.3 SB12.4

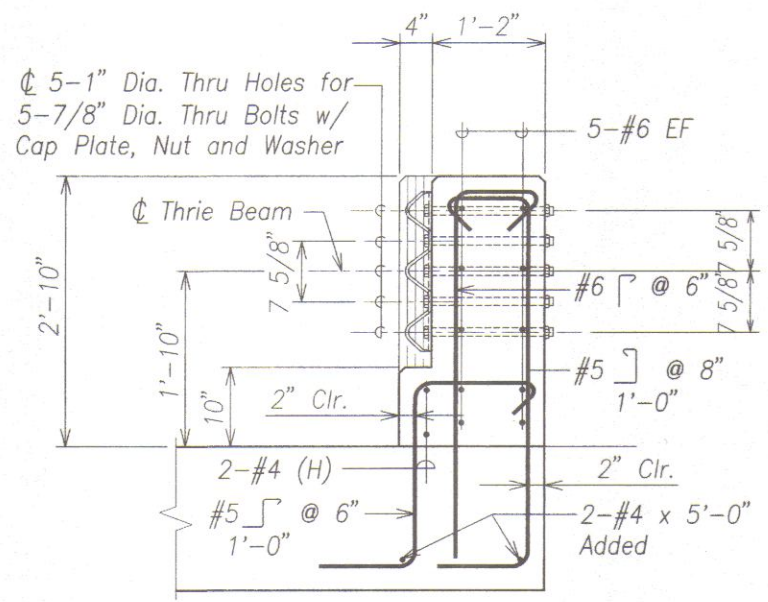

SECTION 3
Scale: 1" = 1'-0" SB12.3 SB12.4

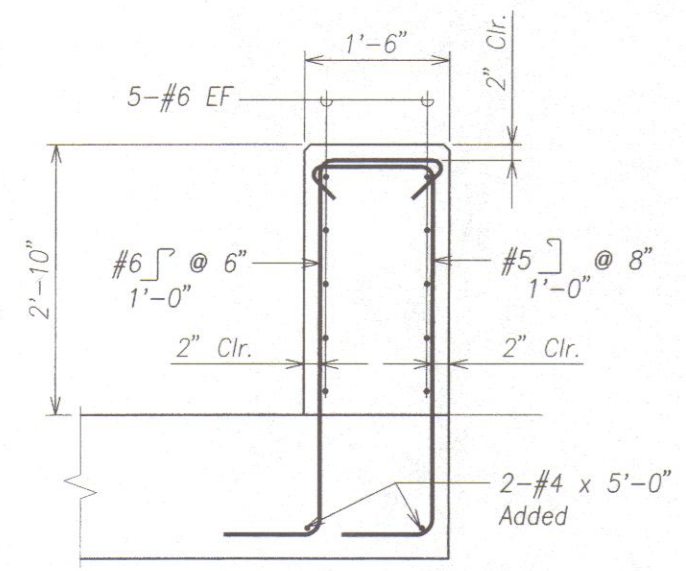

SECTION 4
Scale: 1" = 1'-0" SB12.3 SB12.4

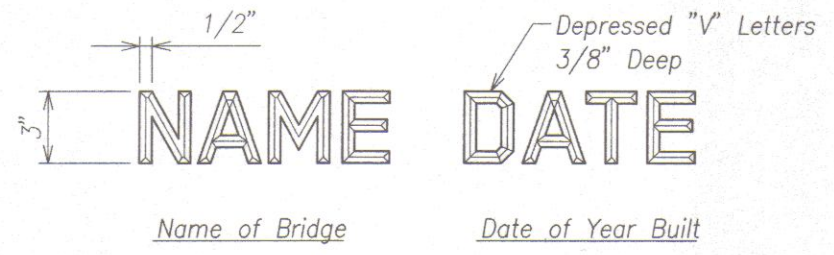

- NOTES:
- Exact details and spacing of letter and figures and location shall be as directed by the Engineer. Gothic letters and figures approximating the dimensions shown will be acceptable if approved by the Engineer.
 - Name & date shall be place on the trailing (exit) end post on each side of bridge.
 - Unless otherwise directed by the Engineer, The name of the bridge shall be "KAHOMA STREAM BRIDGE". The date shall be 2011.

TYPICAL DETAIL OF LETTERS AND FIGURES
BRIDGE IDENTIFICATION DETAIL 1
Scale: 3" = 1'-0" SB12.4 SB12.4




THIS WORK WAS PREPARED BY ME OR UNDER MY SUPERVISION.
David K. Fujiwara
KSF, INC. APRIL 30, 2012 LIC. EXP. DATE

STATE OF HAWAII
DEPARTMENT OF TRANSPORTATION
HIGHWAYS DIVISION

END POST SECTIONS
HONOAPIILANI HIGHWAY REALIGNMENT, PHASE 1A
Future Keawe St Extension to Lahainaluna Rd, Part B
Fed. Aid Proj. No. NH-030-1(35)R
Scale: As Noted Date: June, 2010
SHEET No. SB12.4 OF 4 SHEETS

FED. ROAD DIST. NO.	STATE	FED. AID PROJ. NO.	FISCAL YEAR	SHEET NO.	TOTAL SHEETS
HAWAII	HAW.	NH-030-1(35)R	2009	360	383

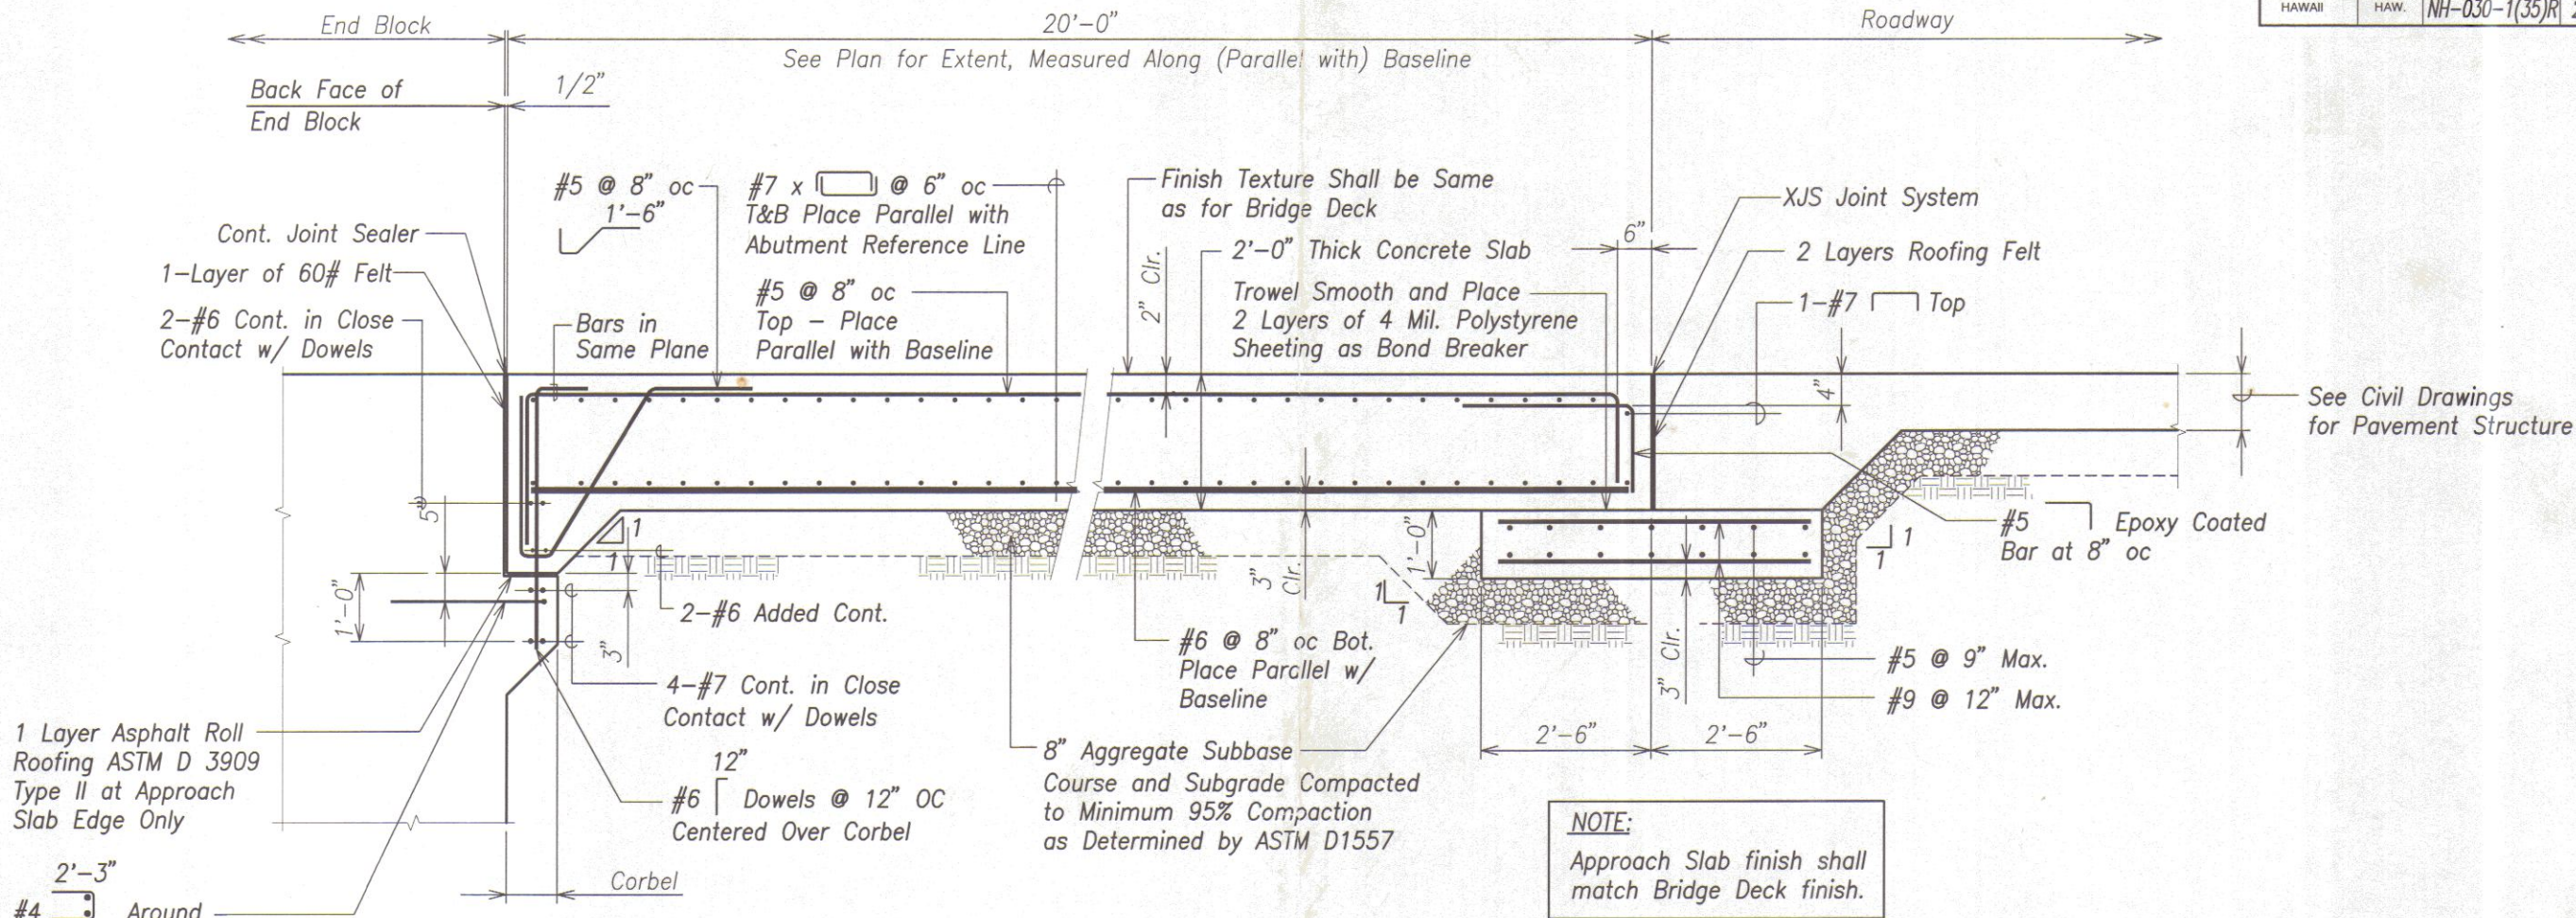

TYPICAL APPROACH SLAB SECTION A
Scale: 3/4" = 1'-0" SB12.4 SB13.1

ORIGINAL	DATE
PLAN	
NOTE BOOK	
DESIGNED BY	
QUANTITIES BY	
CHECKED BY	
No.	

DRAWING NAME: Z:\00 ONGOING\40019.0-HONOPILANI LAHANA BYPASS-KAHOMA - HDCC\11-06-12 REV APPROCH SLAB\HH-SB1301.DWG PLOT TIME: 11-07-12, 10:40 AM



THIS WORK WAS PREPARED BY ME OR UNDER MY SUPERVISION.

KSF, INC. APRIL 30, 2012 LIC. EXP. DATE

STATE OF HAWAII
DEPARTMENT OF TRANSPORTATION
HIGHWAYS DIVISION

APPROACH SLAB


HONOPILANI HIGHWAY REALIGNMENT, PHASE 1A
Future Keawe St Extension to Lahainaluna Rd, Part B
Fed. Aid Proj. No. NH-030-1(35)R

Scale: As Noted Date: August, 2010

SHEET No. SB13.1 OF 1 SHEETS

11-07-2012 - REV.

FED. ROAD DIST. NO.	STATE	FED. AID PROJ. NO.	FISCAL YEAR	SHEET NO.	TOTAL SHEETS
HAWAII	HAW.	NH-030-1(35)R	2009	360	383

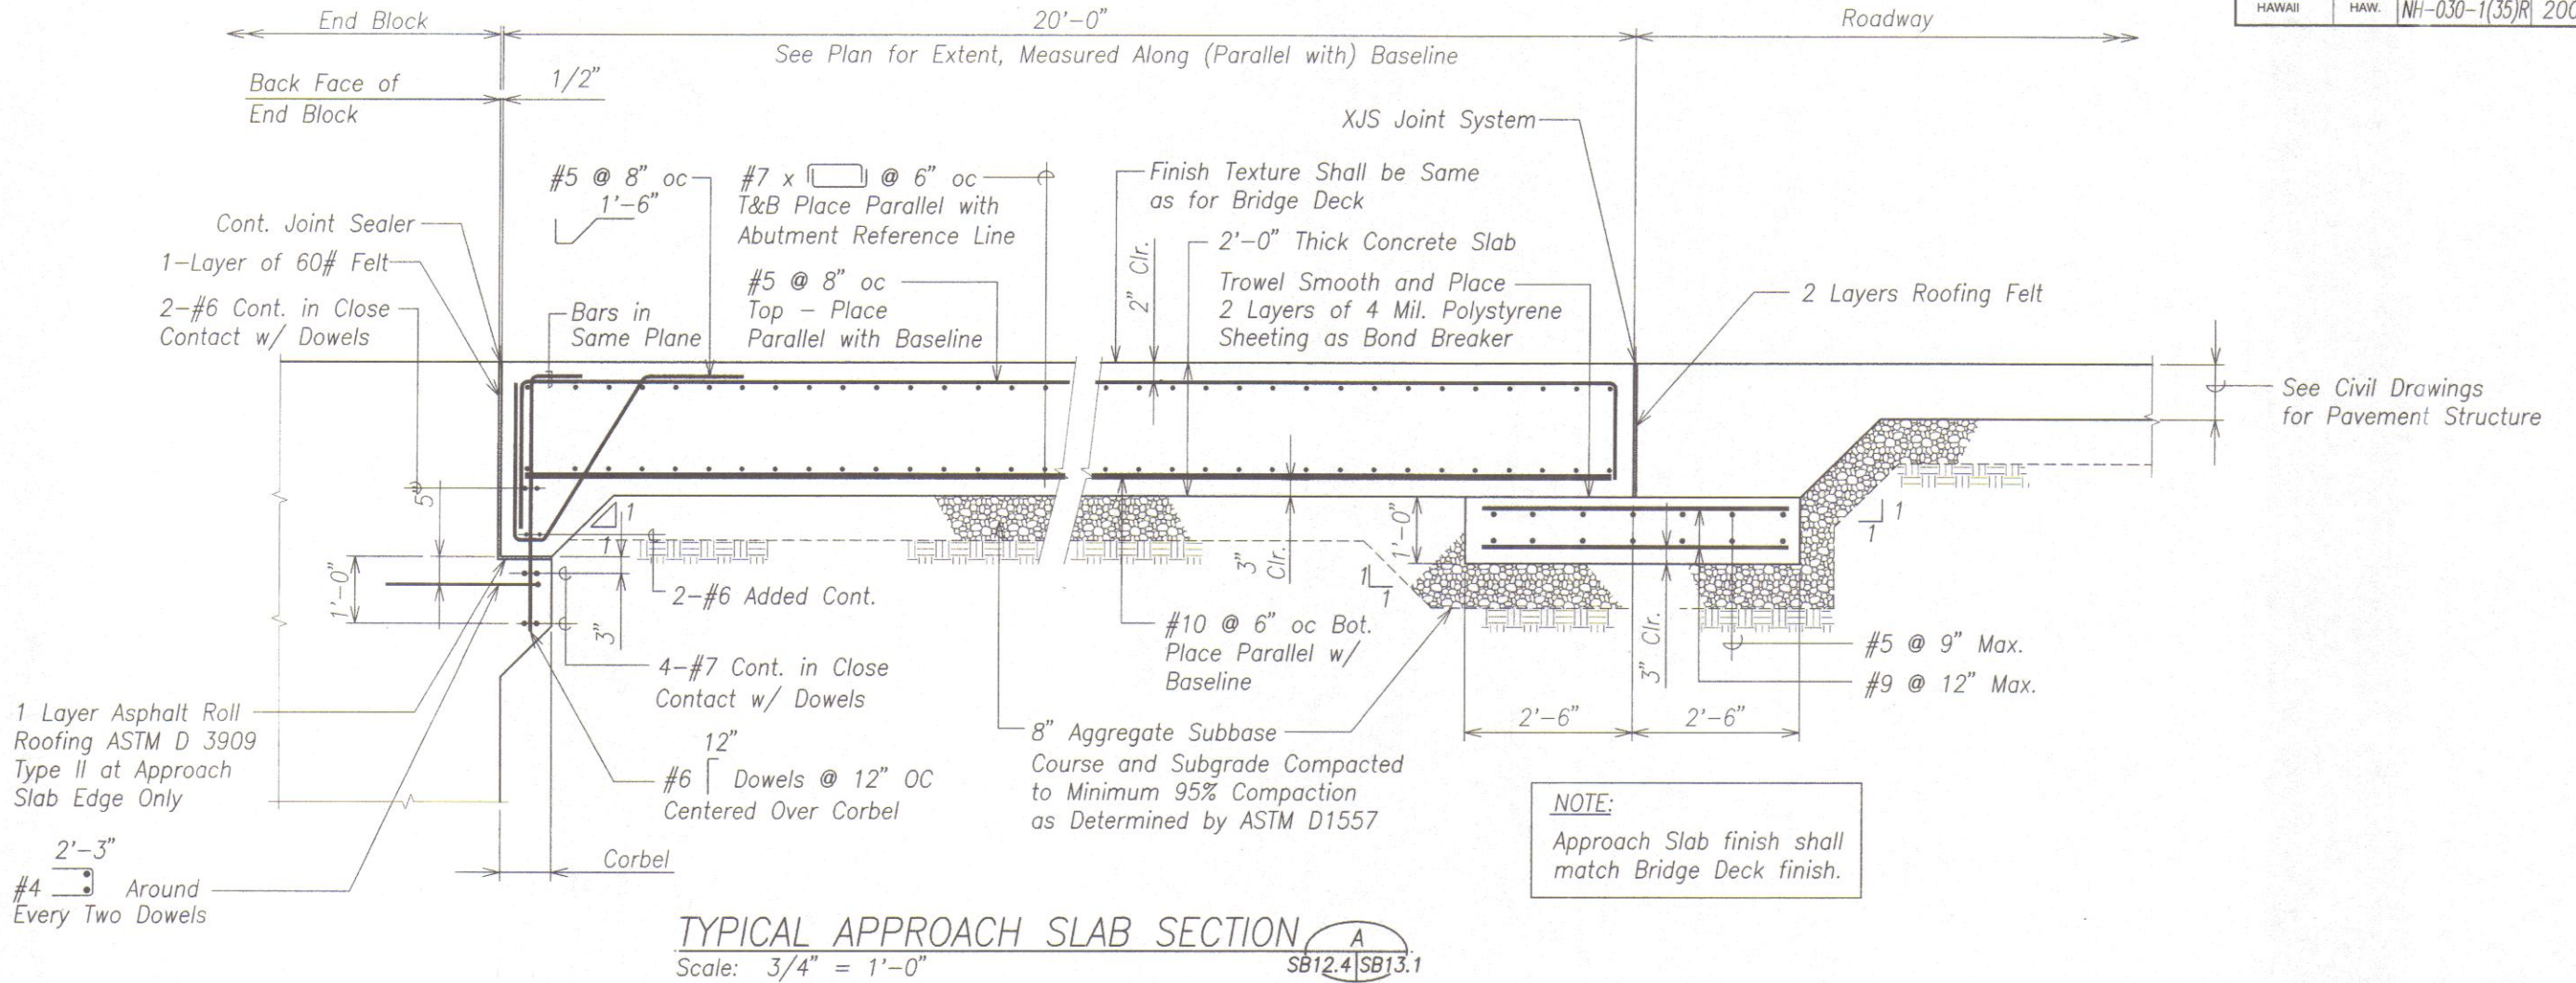

ORIGINAL PLAN	DATE
SURVEY PLOTTED BY	
DESIGNED BY	
QUANTITIES BY	
CHECKED BY	
NOTE BOOK	
No.	

DRAWING NAME: Z:\00 ONGOING\4019.0-HONOLULU LAHANA BYPASS-KAHOMA WD\06-15-10 COMBINE LAHANA FINAL DESIGN\HH-SB1301.DWG PLOT TIME: 06-14-10, 8:25 PM




THIS WORK WAS PREPARED BY ME
OR UNDER MY SUPERVISION.
David K. Fujiwara
KSF, INC. APRIL 30, 2012
LIC. EXP. DATE

STATE OF HAWAII
DEPARTMENT OF TRANSPORTATION
HIGHWAYS DIVISION


APPROACH SLAB

HONOLULU HIGHWAY REALIGNMENT, PHASE 1A
Future Keawe St Extension to Lahainaluna Rd, Part B
Fed. Aid Proj. No. NH-030-1(35)R
Scale: As Noted Date: June, 2010


FED. ROAD DIST. NO.	STATE	FED. AID PROJ. NO.	FISCAL YEAR	SHEET NO.	TOTAL SHEETS
HAWAII	HAW.	NH-030-1(35)R	2009	361	383

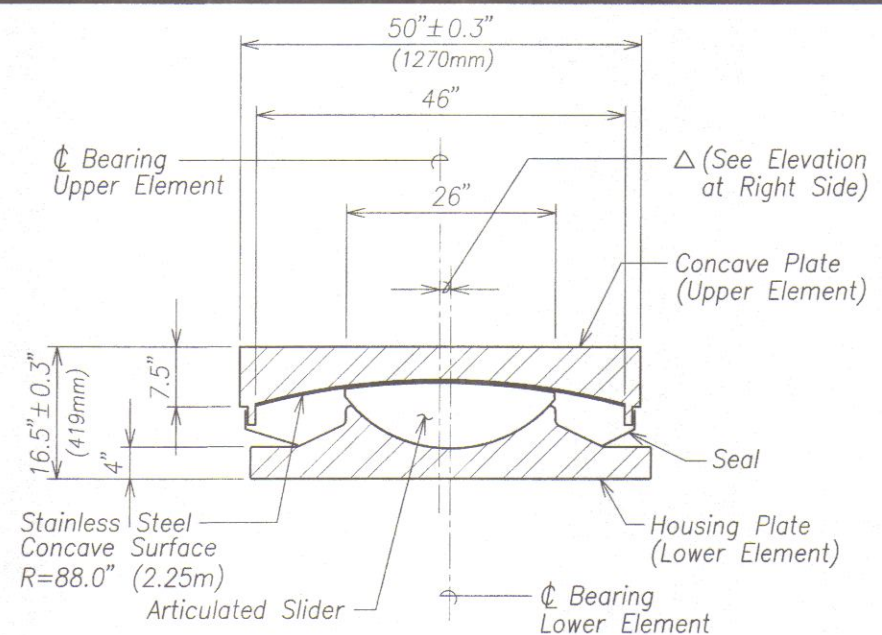


SECTION
Scale: 1" = 1'-0"

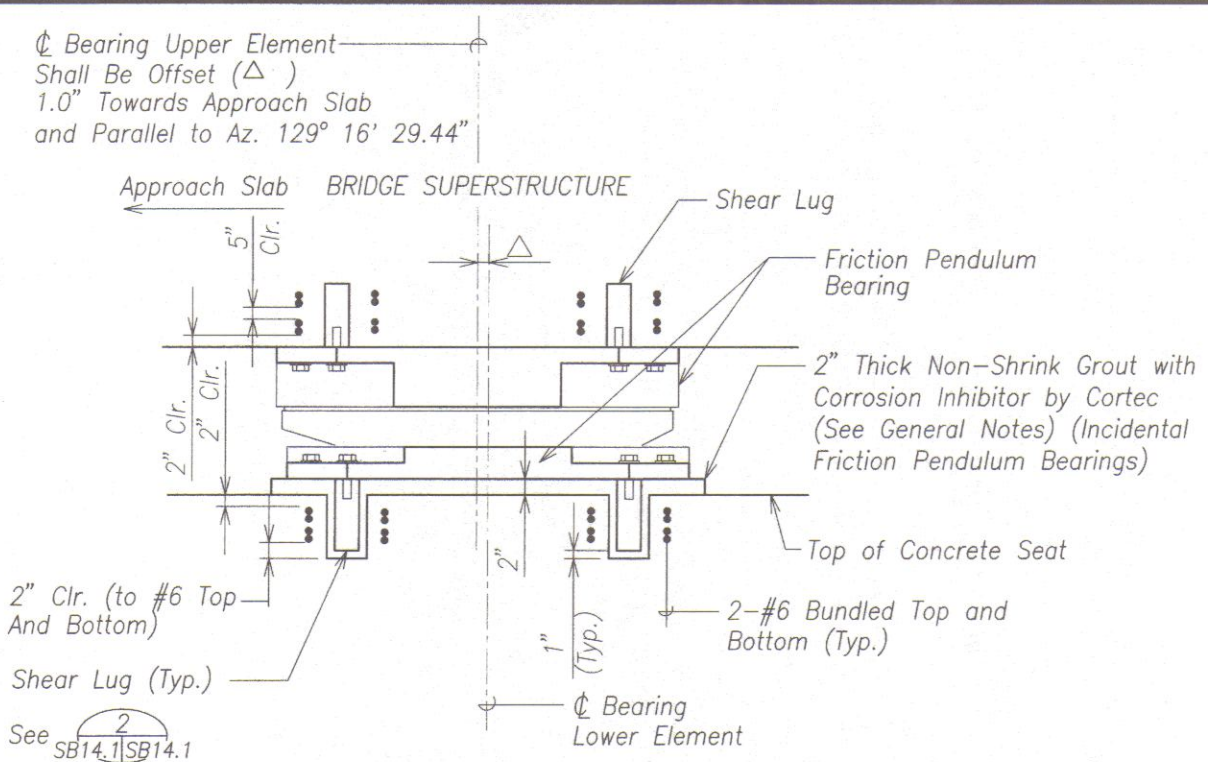


ELEVATION
Scale: 1" = 1'-0"

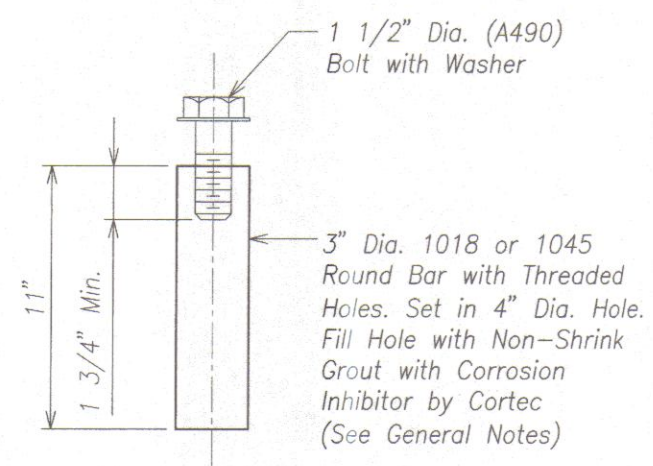

SHEAR LUG DETAIL
Scale: 3" = 1'-0"

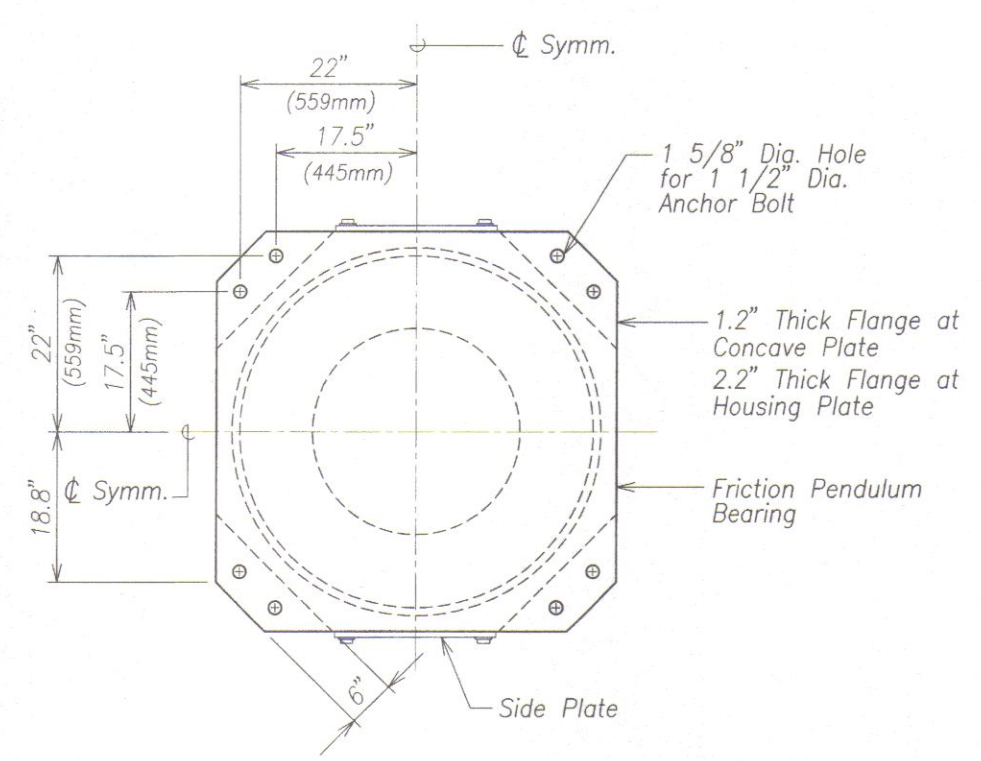

PLAN
Scale: 1" = 1'-0"

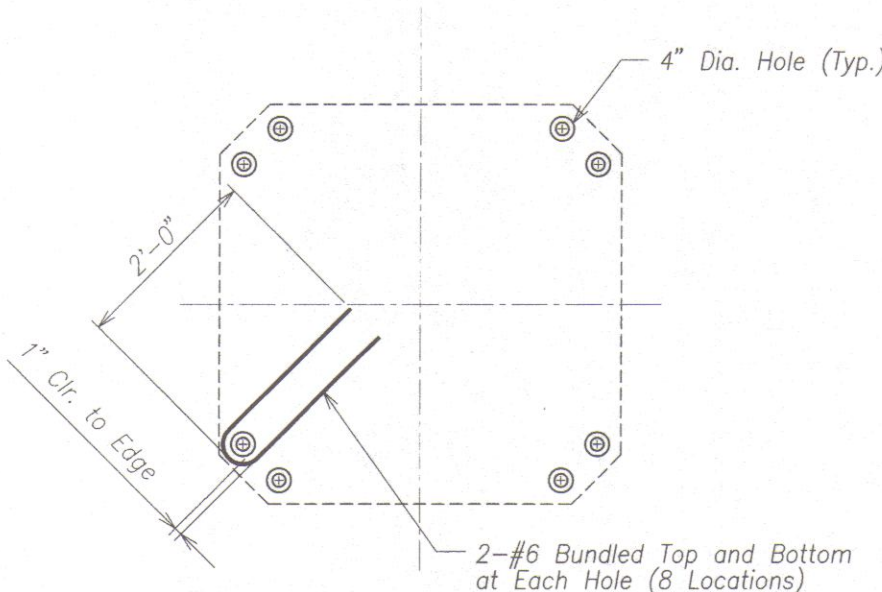

SECTION - PLAN
Scale: 1" = 1'-0"

Period = 3.0 ($r = 88.0$ " (2.25m))
Displacement Capacity: 10 in. (254mm)
Service Vertical Load Capacity $[d+(l+i)] = 5,000$ kips
Ultimate Vertical Load Capacity $[d+(l+i)+e] = 10,000$ kips
Static Friction = .04
Kinematic Friction = .05

FRICION PENDULUM BEARING AT PIER
Scale: 1" = 1'-0"



THIS WORK WAS PREPARED BY ME
OR UNDER MY SUPERVISION.
David K. Fujiwara
KSF, INC. April 30, 2012
U.C. EXP. DATE

STATE OF HAWAII
DEPARTMENT OF TRANSPORTATION
HIGHWAYS DIVISION

FRICION PENDULUM BEARING DETAILS

HONOAPIILANI HIGHWAY REALIGNMENT, PHASE 1A
Future Keawe St Extension to Lahainaluna Rd, Part B
Fed. Aid Proj. No. NH-030-1(35)R


Scale: As Noted Date: June, 2010

SHEET No. SB14.10F 1 SHEETS

ORIGINAL PLAN	DATE
DESIGNED BY	
CHECKED BY	
NOTED BY	
QUANTITIES BY	
NO.	

DRAWING NAME: 21.00 ONGOING 40019.0-HONOAPIILANI LAHAINA BYPASS-KAHOMA WO 06-15-10 COMBINE LAHAINA FINAL DESIGN\NH-SB1401.DWG PLOT TIME: 06-14-10, 8:25 PM

FED. ROAD DIST. NO.	STATE	FED. AID PROJ. NO.	FISCAL YEAR	SHEET NO.	TOTAL SHEETS
HAWAII	HAW.	NH-030-1(35)R	2009	362	383

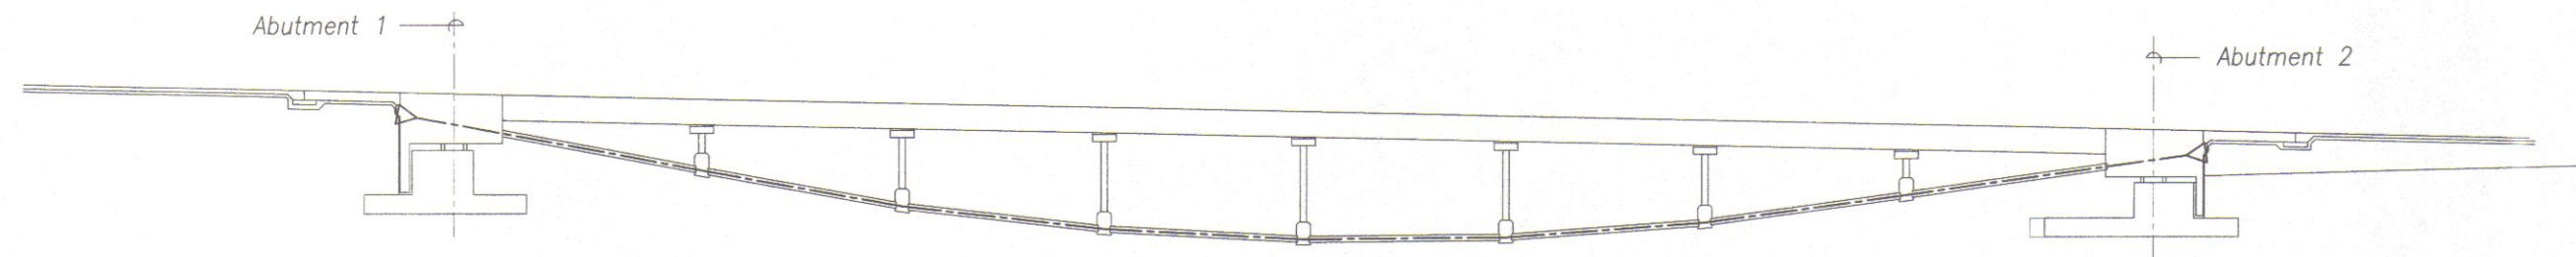

ELEVATION
Scale: 1" = 20'-0" SB15.1 SB15.1

POST TENSIONING NOTES:

1. Post-Tensioning Ducts shall be
4 3/8" O.D. (for PATP line numbers 4-10) &
4 3/4" O.D. (for PATP line numbers 1-3)
Spiro-Type Semi-Rigid galvanized.
2. After post-tensioning, Tendons shall be pressure grouted w/ Masterflow 1205 Cable Grout or Sika Grout 300 PT or equal. Ducts shall have grouting vents at anchorage and at each high point along the Tendon profile.
3. Duct shall be secured to prevent misalignment during concreting.
4. A minimum compressive strength of 8000 PSI shall be obtained in the PATP before the application of post-tensioning.
5. Post-Tensioned Strands shall be 7 wire 0.6 dia. Low Relaxation Steel Strands (Area = 0.217 in.) with an ultimate tensile strength of 270 ksi. For properties, see "Special Provisions".
6. The post-tensioning design assumptions are as follows:
Curve Friction Coefficient 0.18
Wobble Friction Coefficient 0.0002/ft.
Anchor Set 3/8"
7. The design jacking force at end of each Tendon:
1186k for PATP Line numbers 1 through 3
967k for PATP Line numbers 4 through 7
835k for PATP Line numbers 8 through 10

The maximum stress in the Strand before anchor set in is 75% of the guaranteed ultimate strength. Each Tendon will be stressed in two stages at each end of bridge. Stage 1 = 50% of Pjack Stage 2 = 100%. Therefore, each Tendon will be stressed a total of four times.
8. Post-Tensioning Anchors shall be AVAR ACS 27 x 6 or equal for PATP Line numbers 1 through 3.
Post-Tensioning Anchors shall be AVAR ACS 22 x 6 or equal for PATP Line numbers 4 through 10.
9. Jacking symbols are as follows:
▷ Jacking end
10. Post-tensioning shall comply with AASHTO LRFD Bridge Construction Specifications including the latest interim revisions.



THIS WORK WAS PREPARED BY ME
OR UNDER MY SUPERVISION.
David K. Fujiwara
KSF, INC. APRIL 30, 2012
LIC. EXP. DATE

STATE OF HAWAII
DEPARTMENT OF TRANSPORTATION
HIGHWAYS DIVISION
**PRECAST ARCH TIE PLANK
POST-TENSIONING**
HONOAPIILANI HIGHWAY REALIGNMENT, PHASE 1A
Future Keawe St Extension to Lahainaluna Rd, Part B
Fed. Aid Proj. No. NH-030-1(35)R
Scale: As Noted Date: June, 2010
SHEET No. SB15.1 OF 1 SHEETS

SURVEY PLOTTED BY	DATE
DESIGNED BY	
TRACED BY	
NOTED BY	
QUANTITIES BY	
CHECKED BY	
No.	

DRAWING NAME: 2:00 ONGOING 40019.0-HONOAPIILANI LAHAINA BYPASS-KAHOMA WOL06-15-10 COMBINE LAHAINA FINAL DESIGN NH-SB1501.DWG PLOT TIME: 06-14-10, 8:28 PM

FED. ROAD DIST. NO.	STATE	FED. AID PROJ. NO.	FISCAL YEAR	SHEET NO.	TOTAL SHEETS
HAWAII	HAW.	NH-030-1(35)R	2009	363	383

CONSTRUCTION SEQUENCE:

STAGE

1 Site cast PATP's (Precast Arch Tie Plank), PG's (Precast Girders), PDP's (Precast Deck Planks).

2 Probe and grout at Abutments.

3 Install Falsework at Bents.

NOTE: Stage 4 may be done concurrently with Stages 5, 6, 7, 8, and 9.

4 Construct Abutment except Backwall.

5 Erect PATP's.

6 Construct Cast-in-Place Stiffener Beam between ends of PATP's.

7 Construct CIP Bent at least seven (7) days after the concrete pour in Stage 6 or until the concrete in Stage 6 has attained a compressive strength of 6000 psi, whichever occurs later.

8 Erect PG's at least seven (7) days after the concrete pour in Stage 7 or until the concrete in Stage 7 has attained a compressive strength of 6000 psi, whichever occurs later.

9 Install reinforcing above bottom slab of Precast Girder.

10 Construct Beams over Bent Caps.

11 Pour topping above bottom slab of Precast Girder.

12 Cast In-Span Diaphragms.

13 Install Bearings at least seven (7) days after the concrete pour in Stage 4 or until the concrete in Stage 4 has attained a compressive strength of 6000 psi, whichever occurs later.

14 Construct End Blocks.

15 Post-tension vertical High Strength Threadbars in End Blocks after concrete has attained a compressive strength of 6,000 psi.

16 Post-tension transverse Tendons in End Blocks.

17 Erect PDP's at least seven (7) days after the concrete pour in Stage 14.

18 Pour Deck topping over PDP's and End Blocks.

19 Post-tension longitudinal Tendons at least 21 days after Deck topping pour or after Deck topping concrete has attained a compressive strength of 8,000 psi whichever occurs later.

20 Pour Anchorage blockouts covering longitudinal Tendons.

STAGE

21 Remove Falsework at least four (4) days after grouting the longitudinal Tendons or until the grout has attained a compressive strength of 7000 psi, whichever occurs later, and the concrete in Stage 20 has attained a compressive strength of 6000 psi.

22 Construct Backwall of Abutment, End Posts and Railings.

23 Backfill Abutments.

24 Construct Approach Slab and install Expansion Joints.

25 Bridge may be opened for traffic after the following compressive strengths have been attained or at least 7 days after the newest pour, whichever occurs later:

Railings and Concrete Barriers = 4,000 psi
Approach Slab = 4,000 psi
Concrete in Expansion Joint Blockouts = 8,000 psi



THIS WORK WAS PREPARED BY ME
OR UNDER MY SUPERVISION.

David K. Fujiwara
KSF, INC. APRIL 30, 2012
LIC. EXP. DATE

STATE OF HAWAII
DEPARTMENT OF TRANSPORTATION
HIGHWAYS DIVISION

CONSTRUCTION SEQUENCE

HONOAPIILANI HIGHWAY REALIGNMENT, PHASE 1A

Future Keawe St Extension to Lahainaluna Rd, Part B

Fed. Aid Proj. No. NH-030-1(35)R

Scale: As Noted

Date: June, 2010


SHEET No. SB16.1 OF 1 SHEETS

FINAL DESIGN 363

ORIGINAL PLAN	SURVEY PLOTTED BY	DATE
NOTE BOOK	DRAWN BY	
No.	TRACED BY	
	CHECKED BY	

DRAWING NAME: Z:\00 ONGOING\40019.0-HONOAPIILANI LAHAINA BYPASS-KAHOMA W\06-15-10 COMBINE LAHAINA FINAL DESIGN\HH-SB1601.DWG PLOT TIME: 06-14-10, 8:26 PM

FED. ROAD DIST. NO.	STATE	FED. AID PROJ. NO.	FISCAL YEAR	SHEET NO.	TOTAL SHEETS
1-AWAI	HAW.	NH-030-1(35)R	2009	00	379

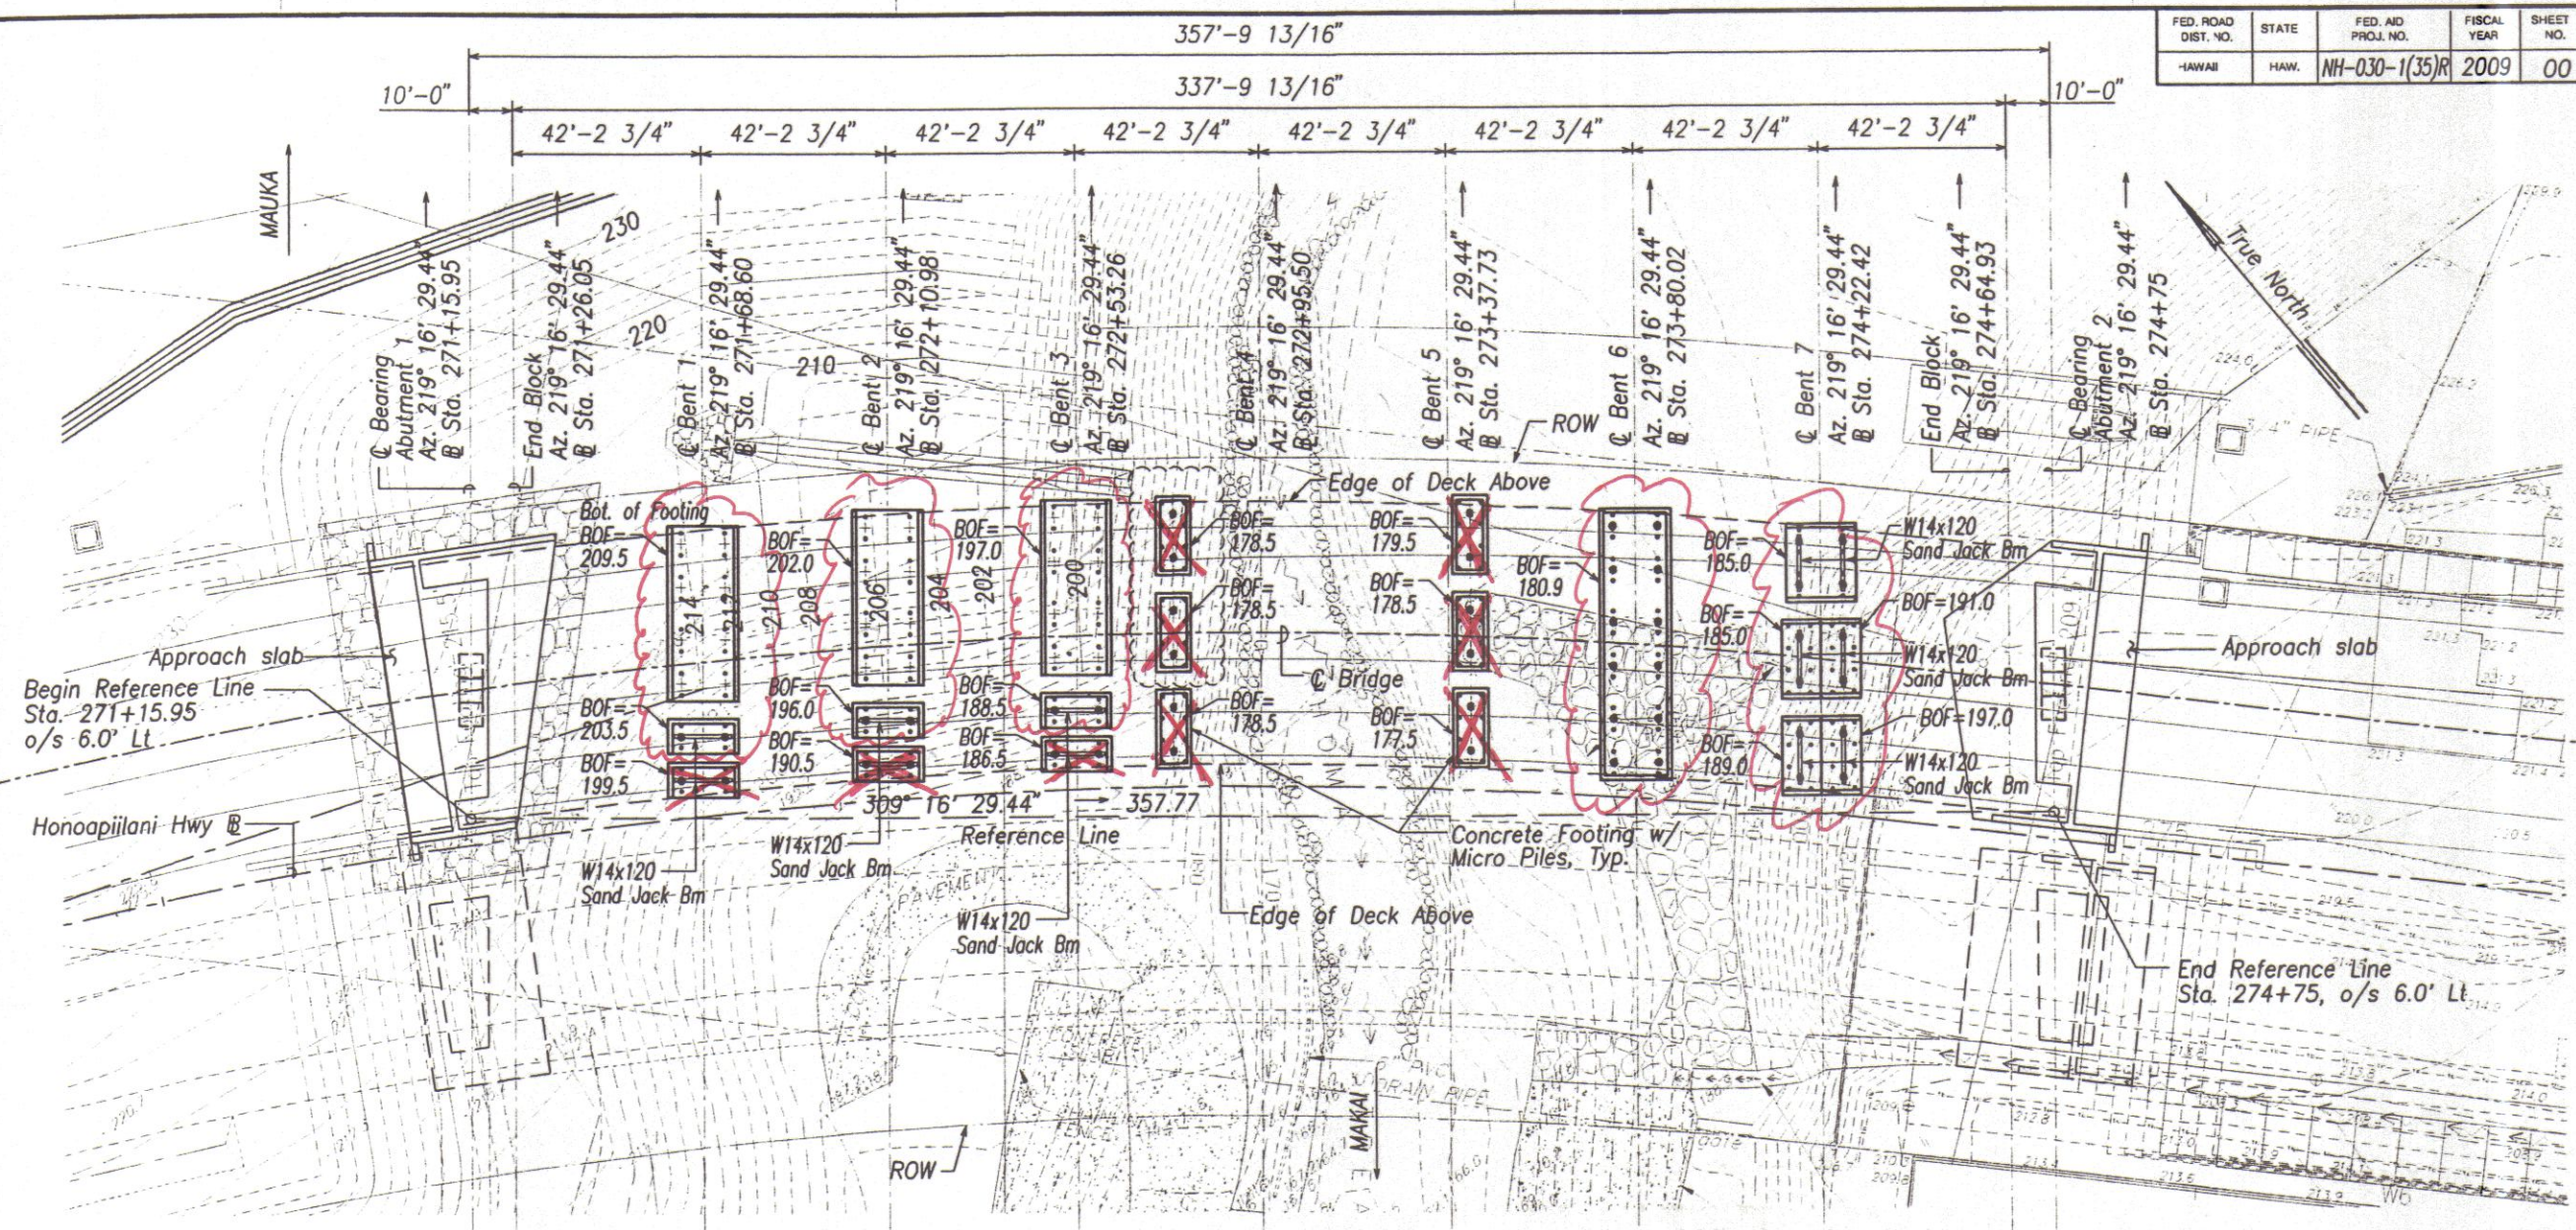

FALSEWORK FOUNDATION PLAN Scale: 1" = 20'-0"

- Legend:**
- Micro Pile By HDCC
 - 12" Dia. X-STR Pile Columns

X = FOOTING TO REMOVE

☼ = FOOTING TO REMAIN
*** STEM WALL REMOVED**
Backfilled with Native Material

FOR HDCC
08-03-2010



THIS WORK WAS PREPARED BY ME OR UNDER MY SUPERVISION.
KSF, INC. APR. 30, 2010 LIC. EXP. DATE

STATE OF HAWAII
DEPARTMENT OF TRANSPORTATION
HIGHWAYS DIVISION

FALSEWORK FOUNDATION PLAN


HONOAPIILANI HIGHWAY REALIGNMENT, PHASE 1A
Future Keawe St Extension to Lahainaluna Rd, Part B
Fed. Aid Proj. No. NH-030-1(35)R

Scale: As Noted Date: March, 2010
SHEET No. FW1.1 OF 00 SHEETS


DESIGNED BY	DATE
DRAWN BY	
CHECKED BY	
NOTED BY	
DATE	

DRAWING NAME: 21.00 OHCING/040119.0-HONOAPIILANI LANAHA BYPASS-KAHOMA WD-08-03-10 FALSEWORK FH-FW1.01.LWG PLOT TIME: 08-03-10 2:02 PM

FED. ROAD DIST. NO.	STATE	FED. AID PROJ. NO.	FISCAL YEAR	SHEET NO.	TOTAL SHEETS
HAWAII	HAW.	NH-030-1(35)R	2009	00	379

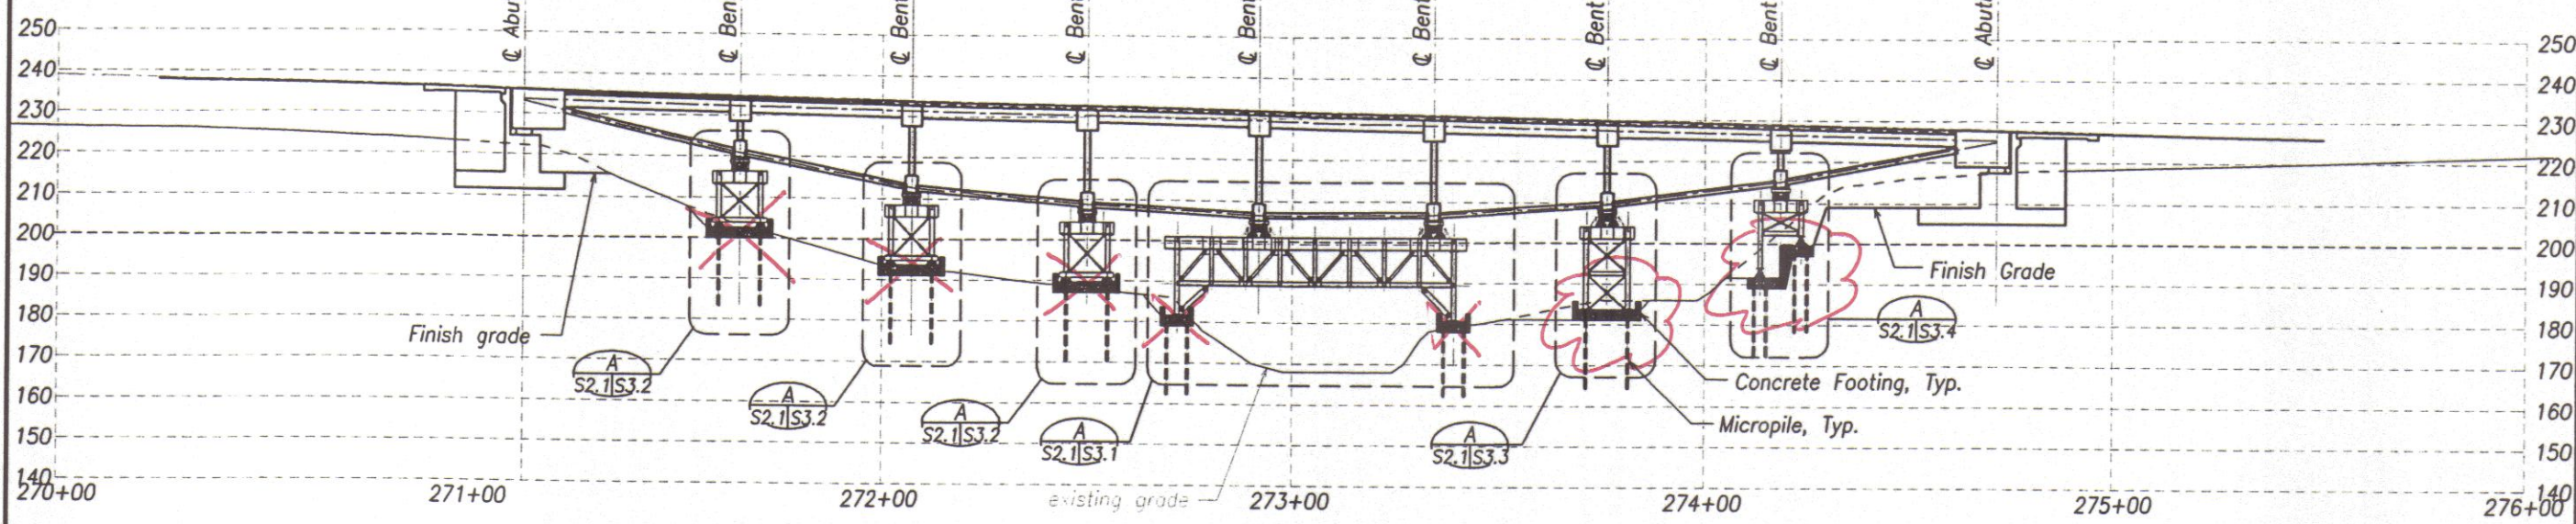


MAKAI SECTION - ALONG MAUKA BRIDGE
Scale: 1" = 20'

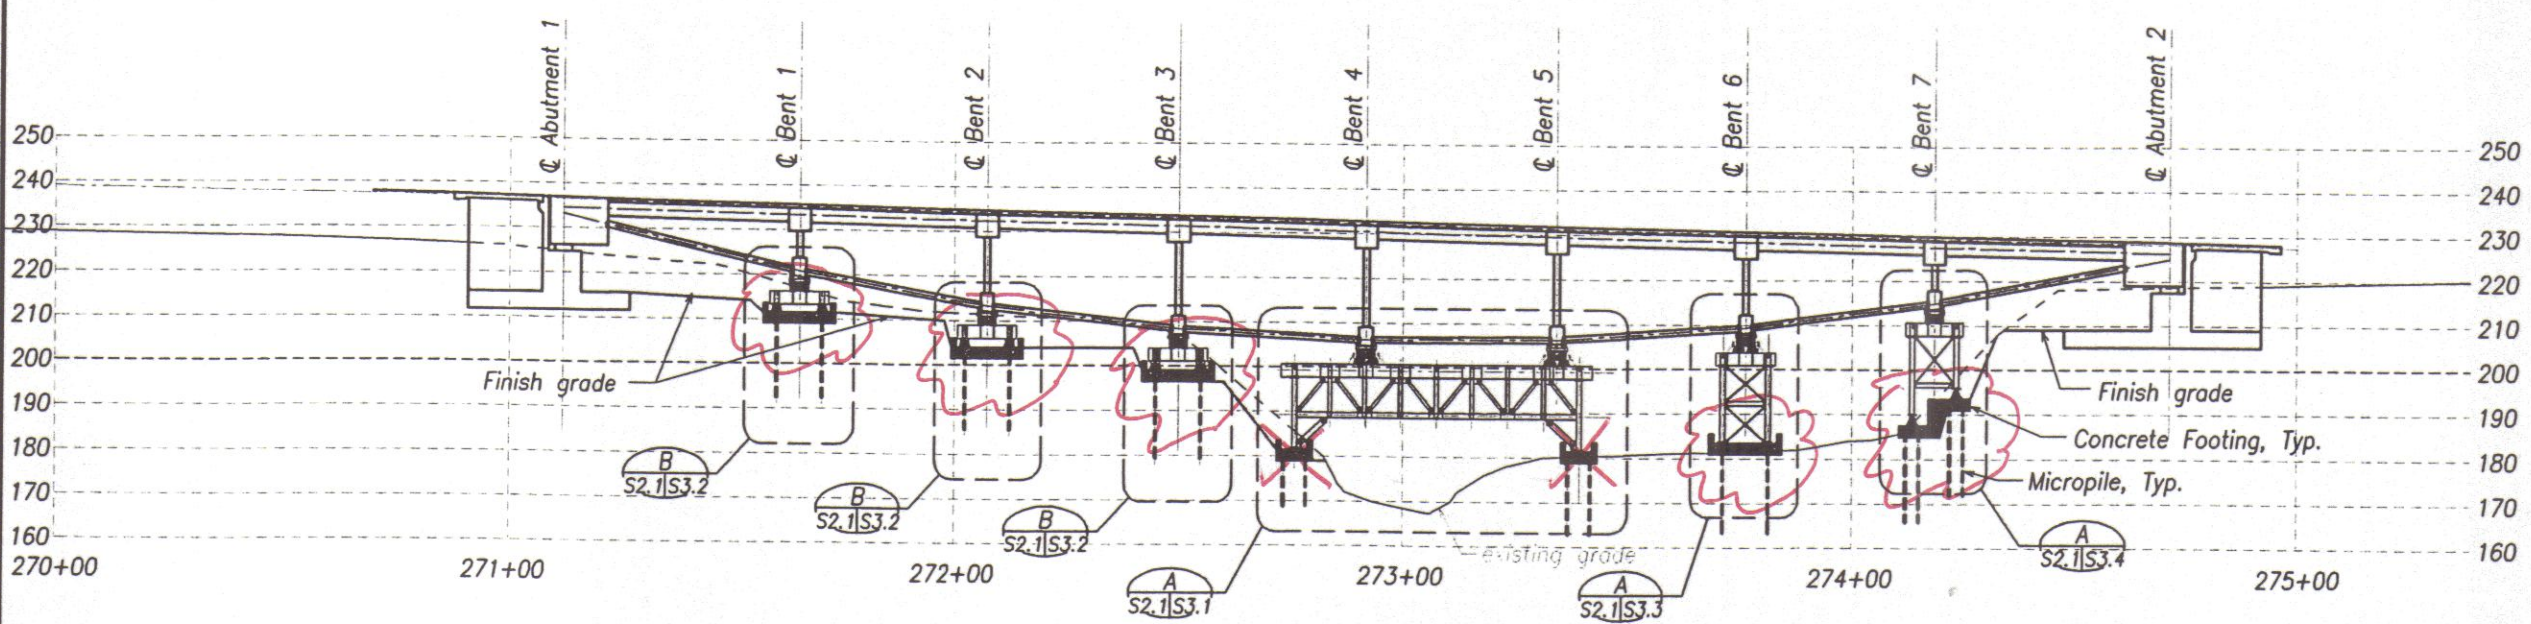

CENTERLINE SECTION - ALONG MAUKA BRIDGE
Scale: 1" = 20'

X = FOOTING TO REMOVE
(cloud) = FOOTING TO REMAIN

FOR HDCC
08-03-2010

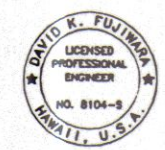

THIS WORK WAS PREPARED BY ME OR UNDER MY SUPERVISION.

KSF, INC. APRIL 30, 2010 LIC. EXP. DATE

STATE OF HAWAII
DEPARTMENT OF TRANSPORTATION
HIGHWAYS DIVISION

FALSEWORK SECTIONS

HONOAPIILANI HIGHWAY REALIGNMENT, PHASE 1A
Future Keawe St Extension to Lahainaluna Rd, Part B
Fed. Aid Proj. No. NH-030-1(35)R


Scale: As Noted Date: March, 2010

SHEET No. FW2.1 OF 00 SHEETS

DESIGNED BY	DATE
CHECKED BY	
IN CHARGE	
APPROVED BY	

DRAWING NAME: Z:\DO ONGOING\10019.0-HONOAPIILANI LAYANA BYPASS-KAHUNA WD 08-03-10 FALSEWORK HW-PW201.DWG PLOT TIME: 08-03-10, 2:05 PM

FED. ROAD DIST. NO.	STATE	FED. AID PROJ. NO.	FISCAL YEAR	SHEET NO.	TOTAL SHEETS
HAWAII	HAW.	NH-030-1(35)R	2009	00	379

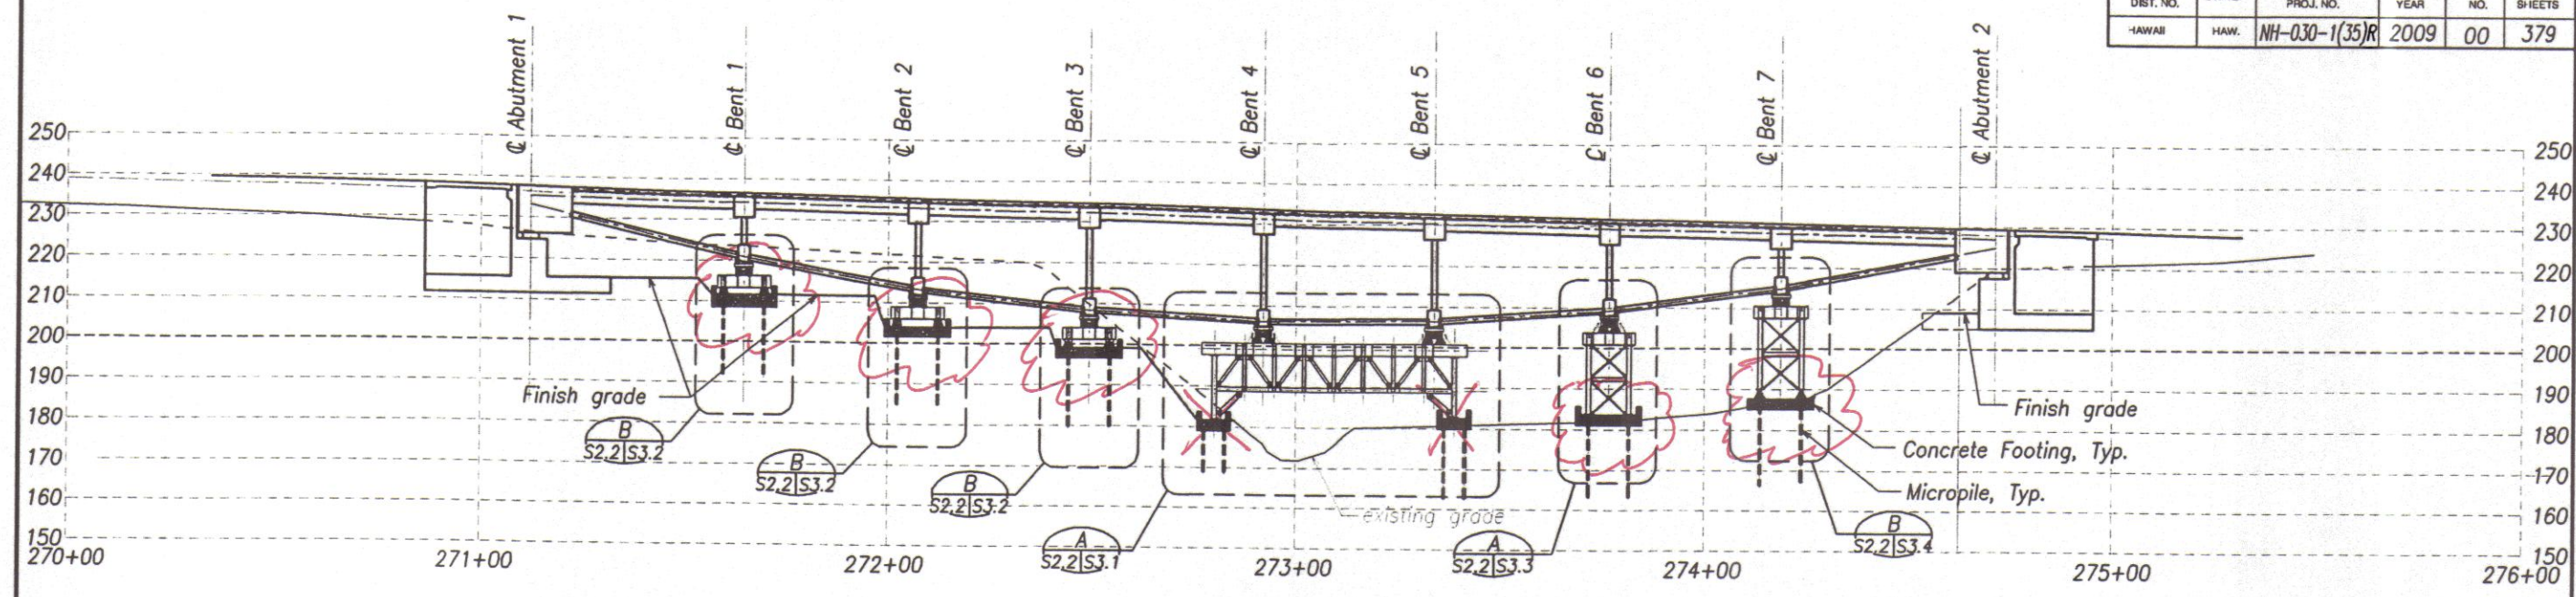

MAUKA SECTION - ALONG MAUKA BRIDGE
 Scale: 1" = 20'

X = FOOTING TO REMOVE

☁ = FOOTING TO REMAIN.

FOR HDCC
 08-03-2010



THIS WORK WAS PREPARED BY ME OR UNDER MY SUPERVISION.

KSF, INC. APRIL 30, 2010 LIC. EXP. DATE

STATE OF HAWAII
 DEPARTMENT OF TRANSPORTATION
 HIGHWAYS DIVISION

FALSEWORK SECTION

HONOLULU HIGHWAY REALIGNMENT, PHASE 1A
 Future Keawe St Extension to Lahainaluna Rd, Part B
 Fed. Aid Proj. No. NH-030-1(35)R

Scale: As Noted Date: March, 2010

SHEET No. FW2.2 OF 00 SHEETS

DRAWING NAME: Z:\00 ONCONC\001910-HONOLULU LAYMANA BYPASS-KAHOMA WO\08-03-10 FALSEWORK\HW-FW201.DWG PLOT TIME: 08-03-10, 2:05 PM

DESIGNED BY: DATE: _____
 DRAWN BY: _____
 CHECKED BY: _____
 NO. _____