



FED. ROAD DIST. NO.	STATE	FED. AID PROJ. NO.	FISCAL YEAR	SHEET NO.	TOTAL SHEETS
HAWAII	HAW.	NH-030-1(35)R	2006	74	79

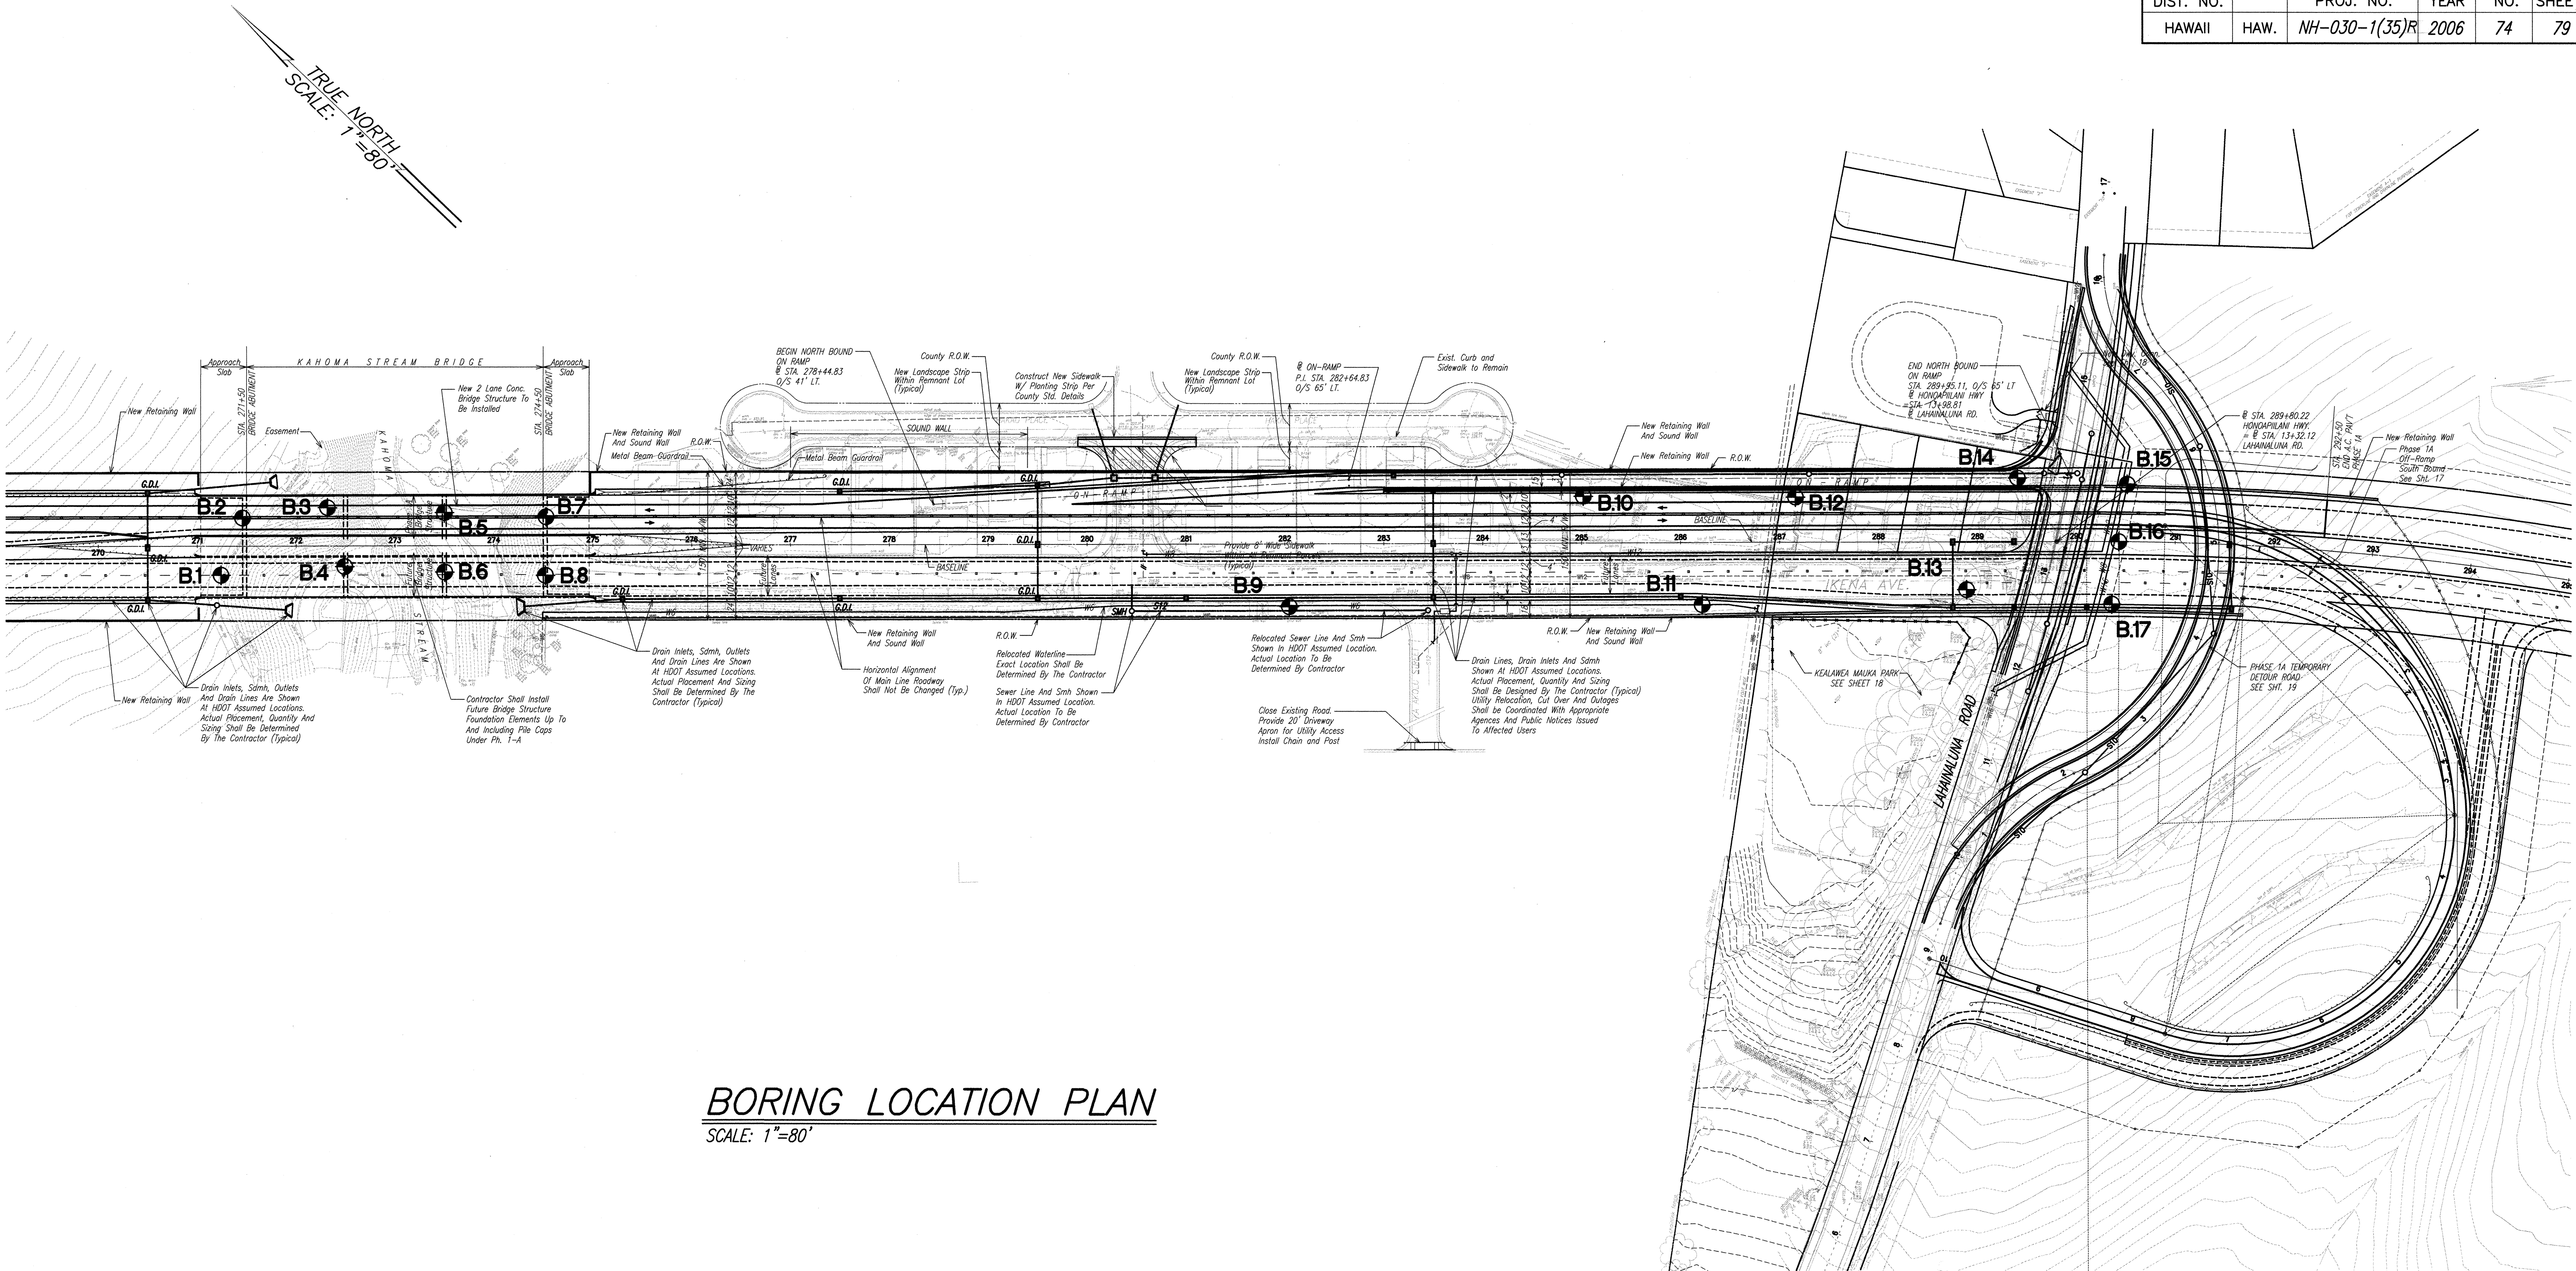

BORING LOCATION PLAN
SCALE: 1"=80'

LEGEND

B.7 BORING NUMBER AND APPROXIMATE BORING LOCATION

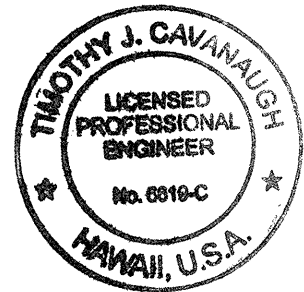

THIS WORK WAS PREPARED BY ME
OR UNDER MY SUPERVISION
Signature: [Signature] Exp. APRIL 30, 2008

STATE OF HAWAII
DEPARTMENT OF TRANSPORTATION
HIGHWAYS DIVISION

BORING LOCATION PLAN
HONOAPIILANI HIGHWAY REALIGNMENT, PHASE 1A
Future Keawe Street Extension
to Lahainaluna Road
Federal Aid Project No. NH-030-1(35)R
Scale: As Noted Date: January 2005

SHEET No. 1 OF 6 SHEETS