



FED. ROAD DIST. NO.	STATE	FED. AID PROJ. NO.	FISCAL YEAR	SHEET NO.	TOTAL SHEETS
HAWAII	HAW.	NH-030-1(35)R	2006	30	79

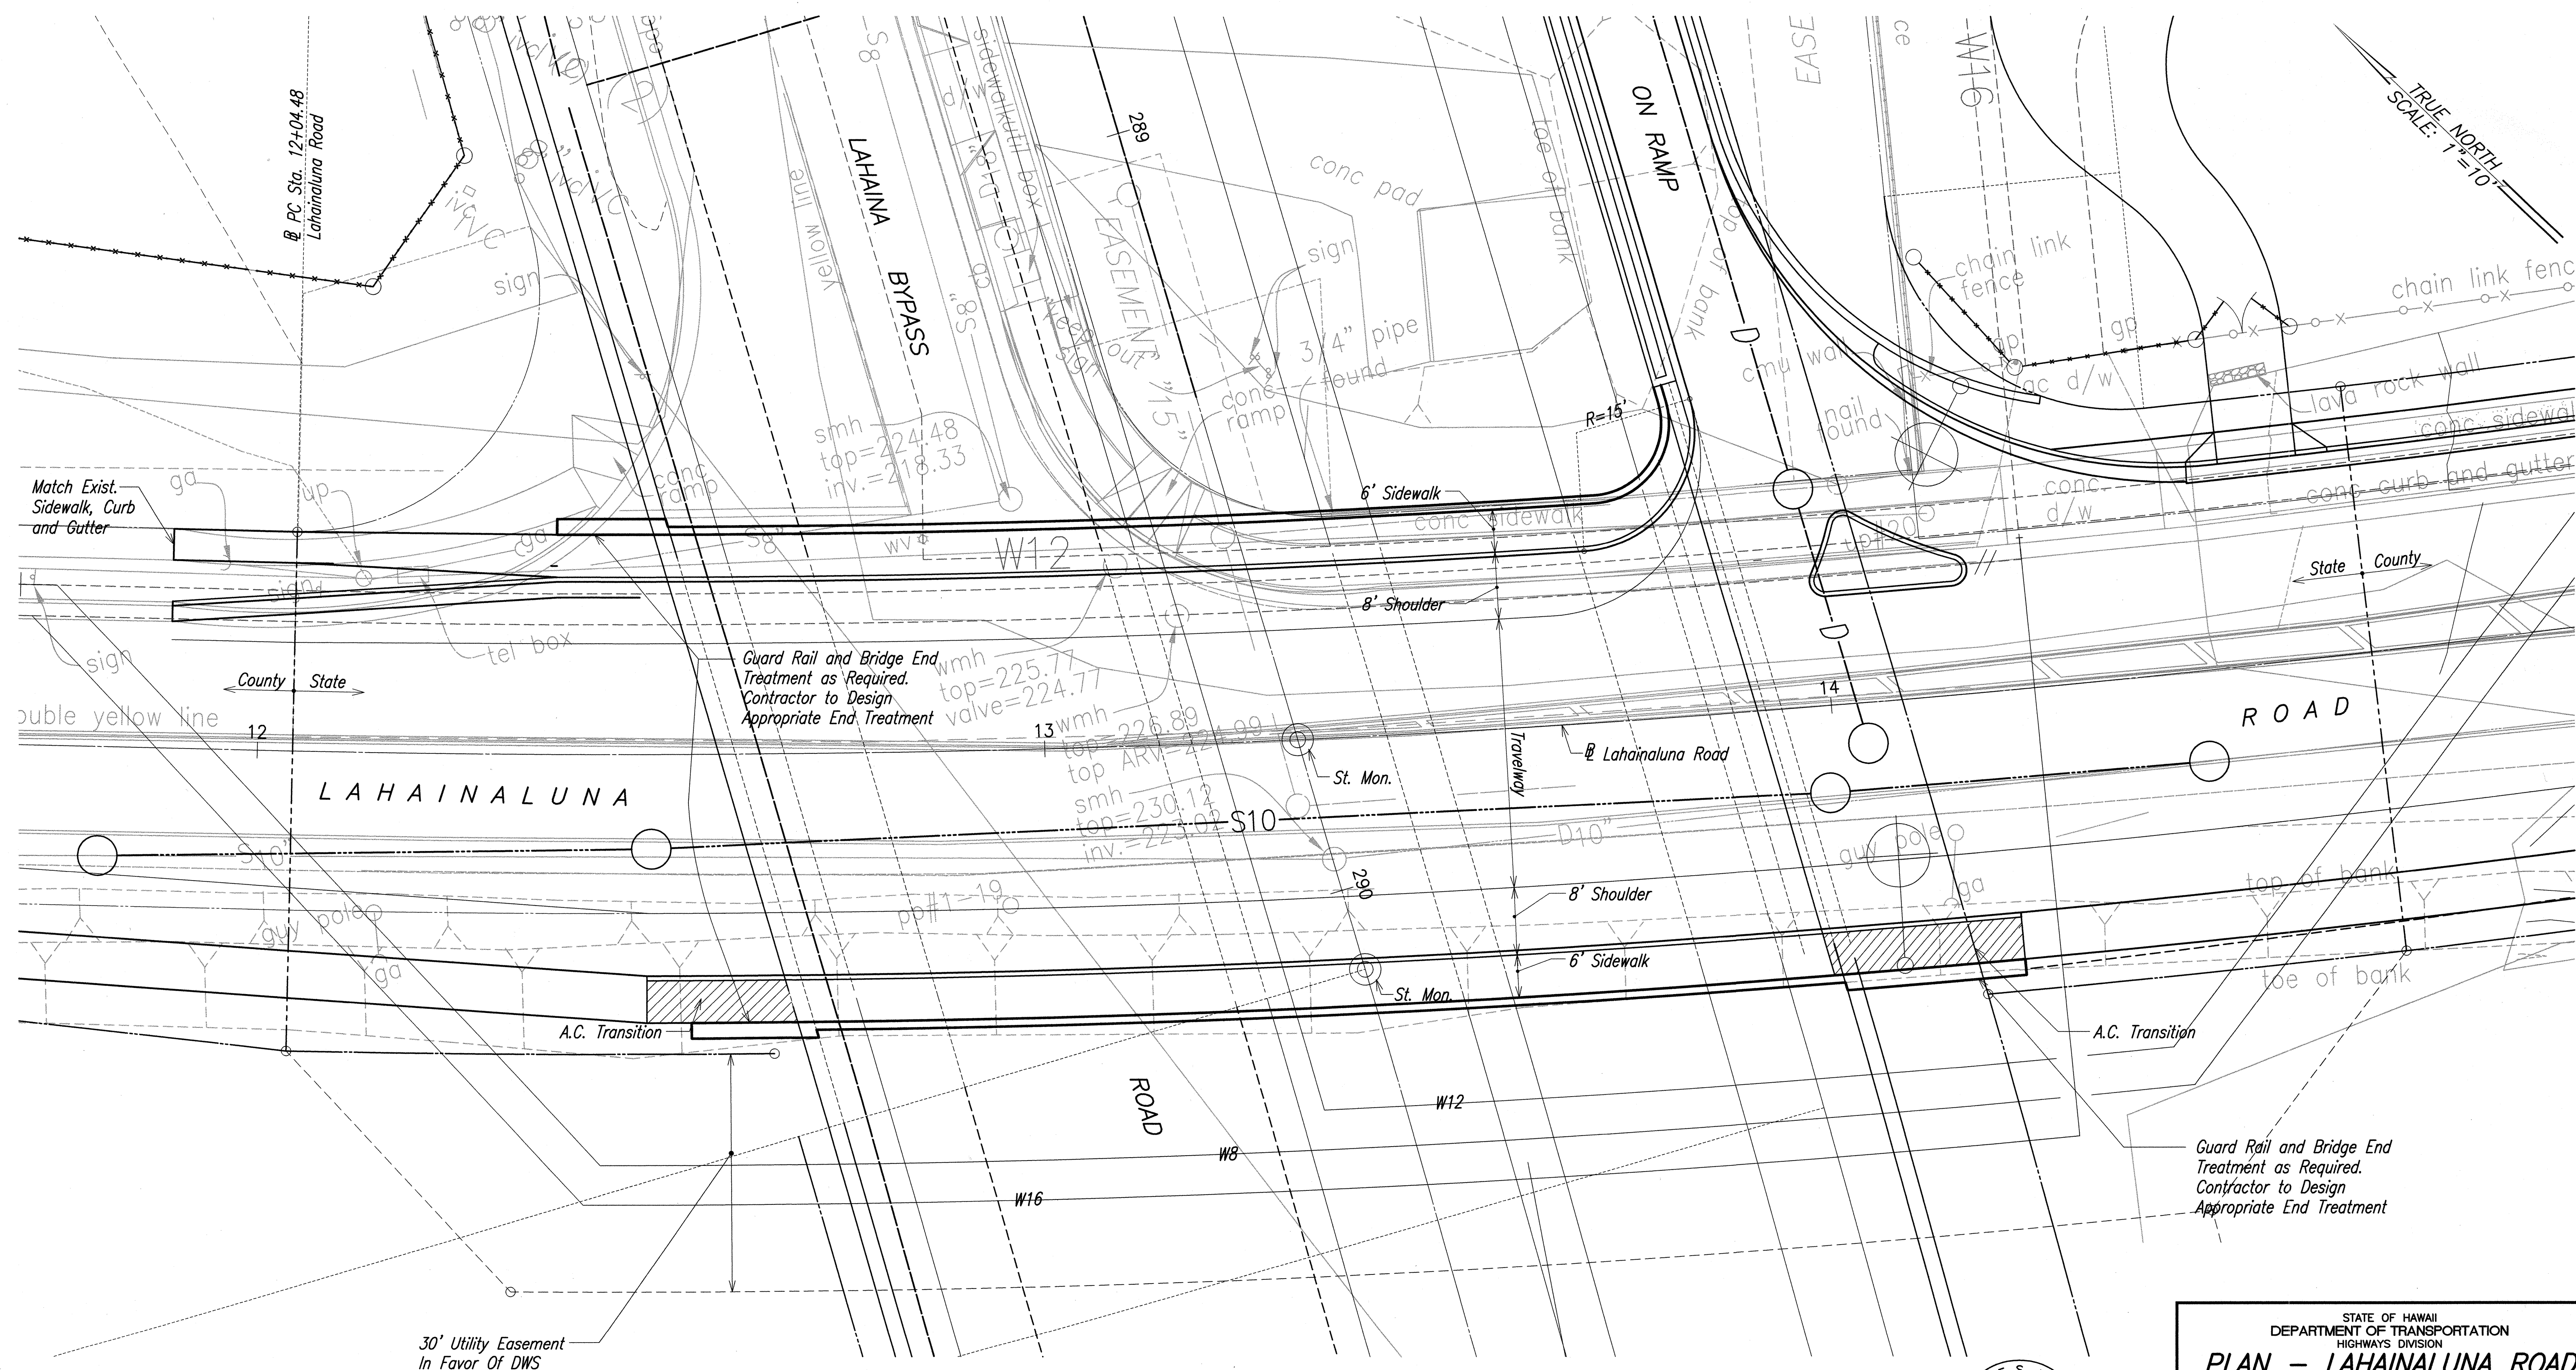

Note: Approach Slabs Shall be Provided at Both Ends of Lahainaluna Grade Separation Structure

PLAN-LAHAINALUNA ROAD GRADE SEPARATION STRUCTURE SCALE: 1"=10'

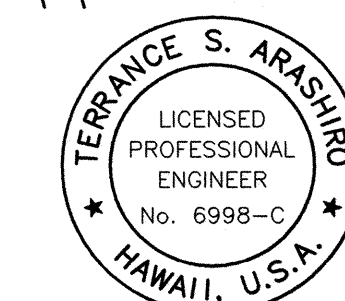

THIS WORK WAS PREPARED BY ME OR UNDER MY SUPERVISION
Signature
EXPIRATION DATE OF LICENSE: APRIL 30, 2008

STATE OF HAWAII
DEPARTMENT OF TRANSPORTATION
HIGHWAYS DIVISION

PLAN - LAHAINALUNA ROAD
GRADE SEPARATION STRUCTURE
HONOAPIILANI HIGHWAY REALIGNMENT, PHASE 1A
Future Keawe Street Extension to Lahainaluna Road
Federal Aid Project No. NH-030-1(35)R
Scale: As Noted Date: April 2006

SHEET No. 1 OF 1 SHEETS