
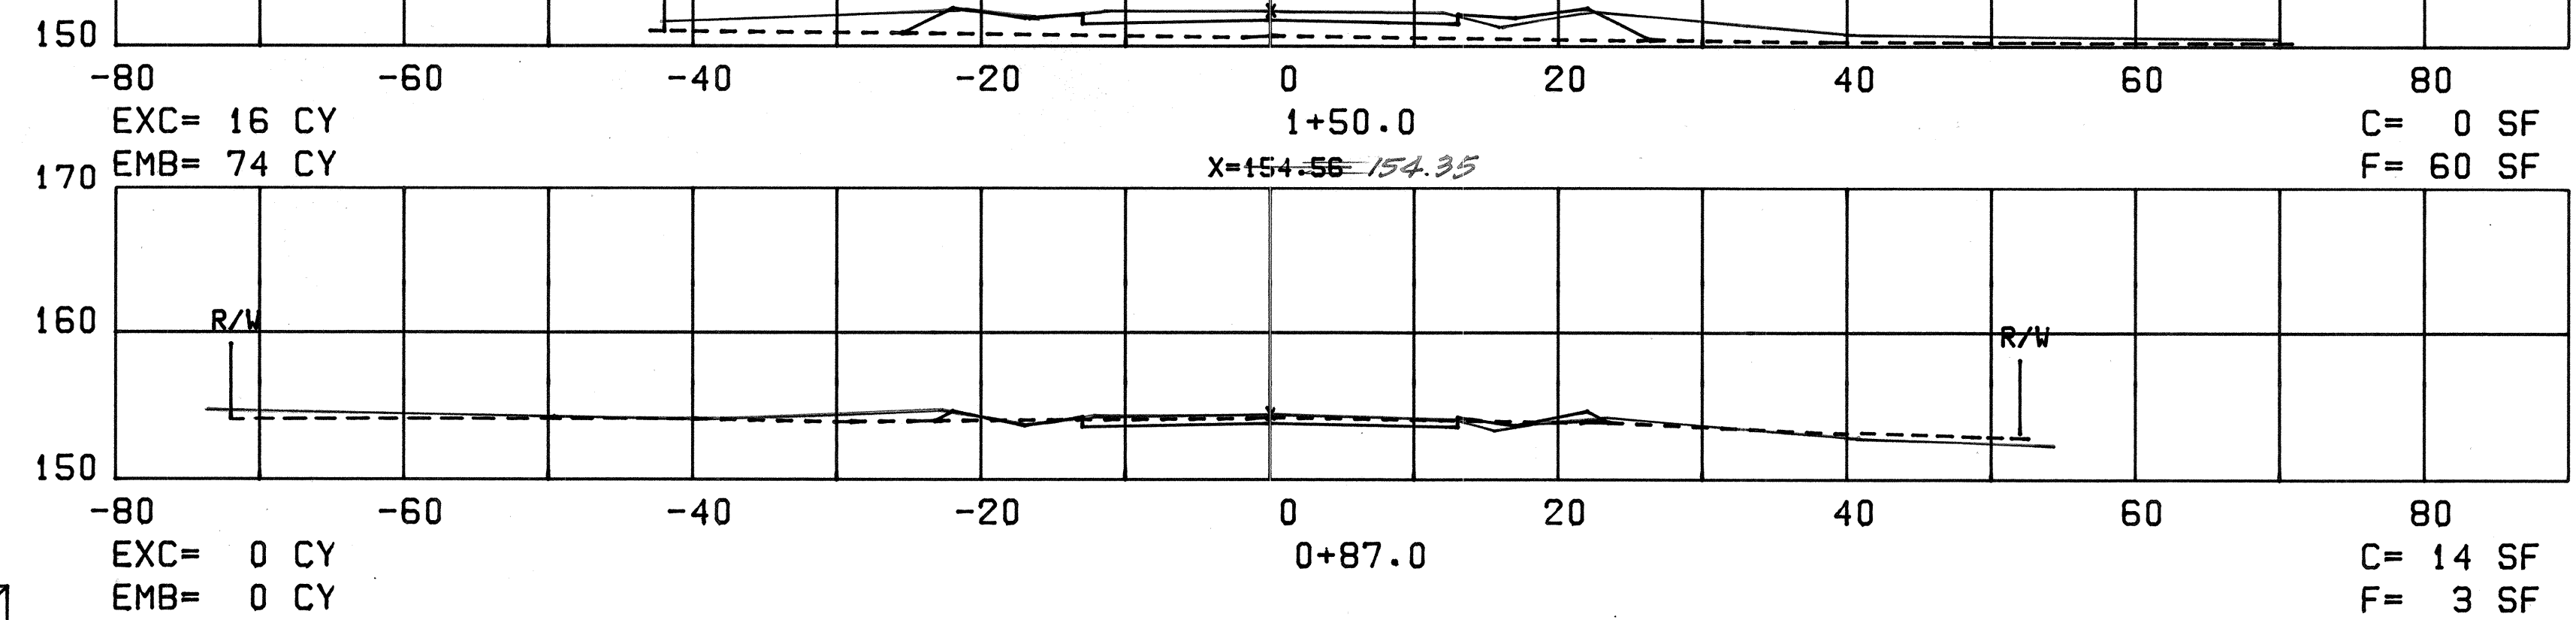
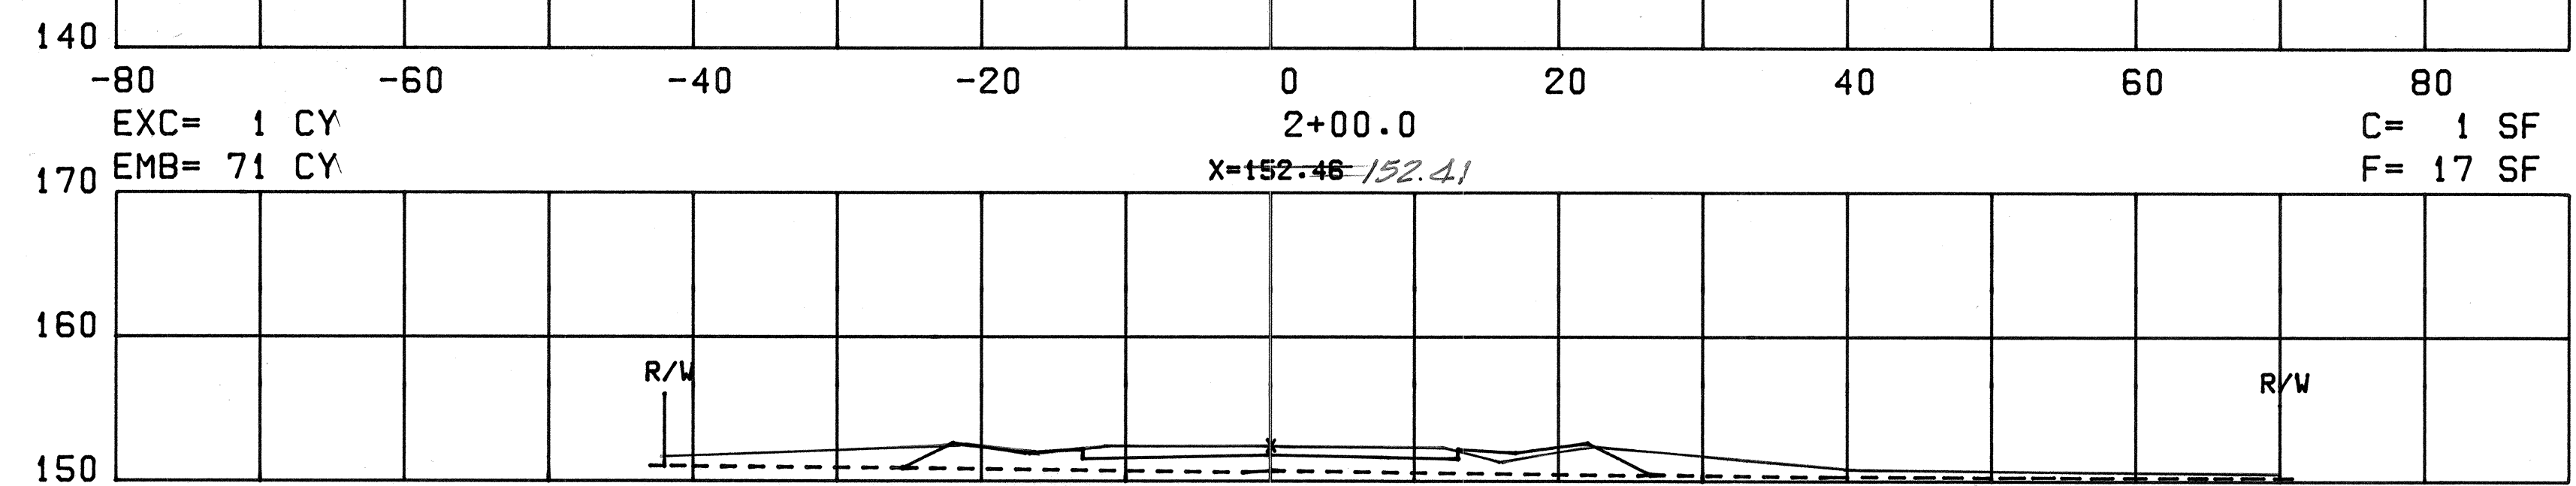
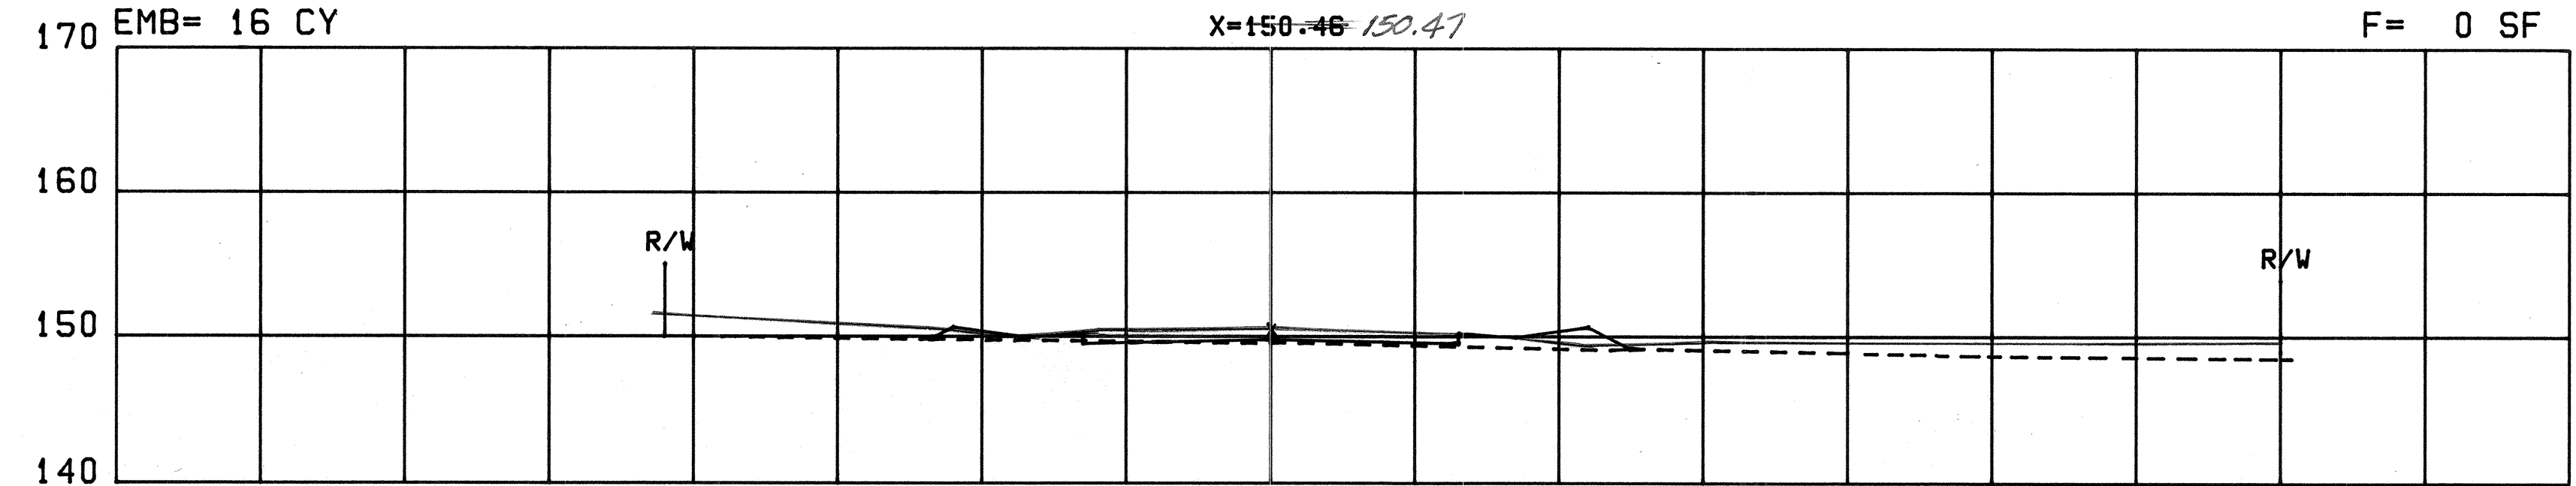
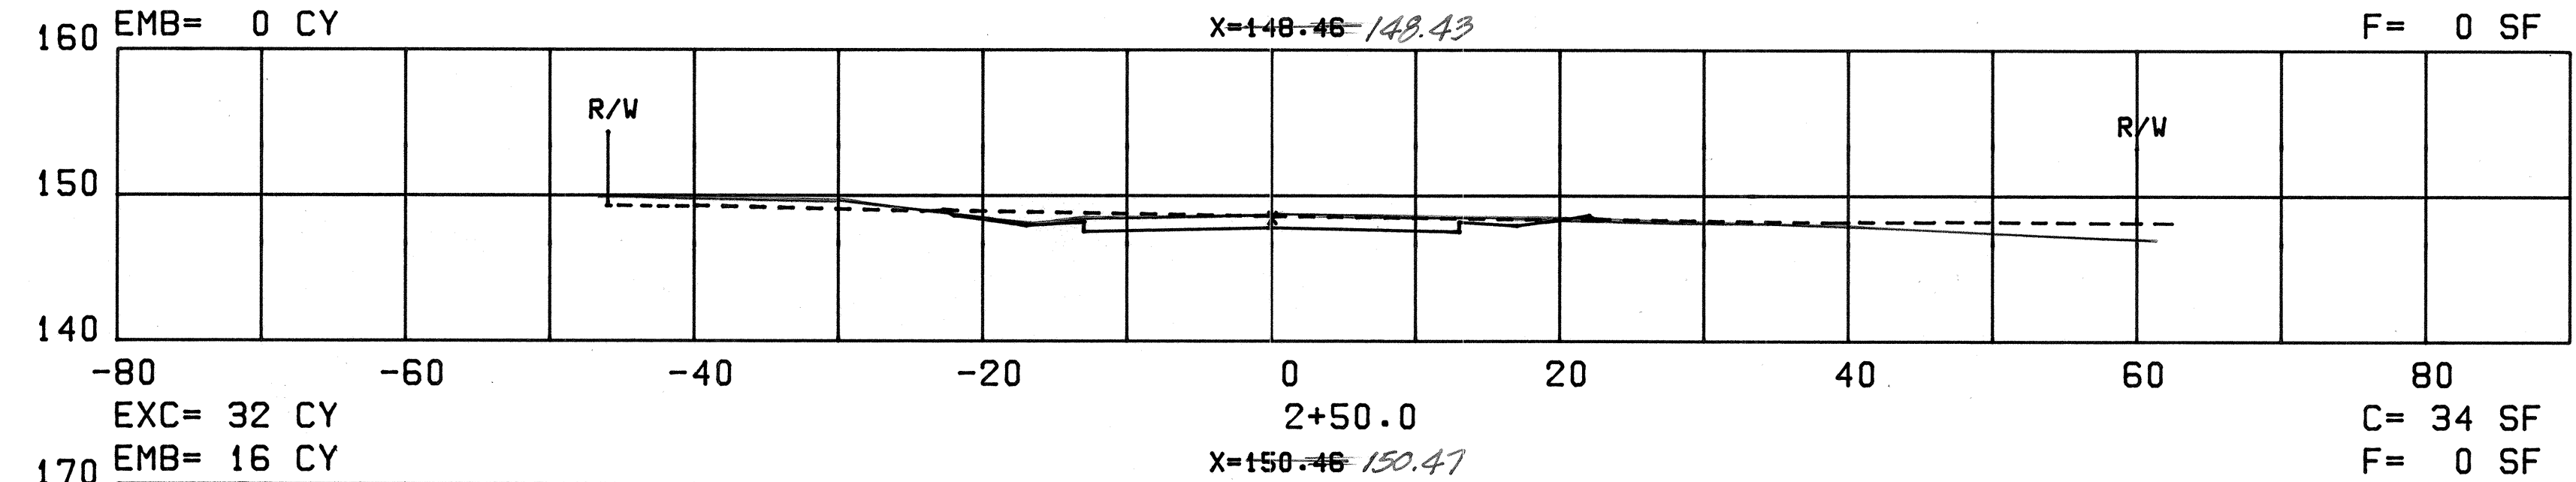
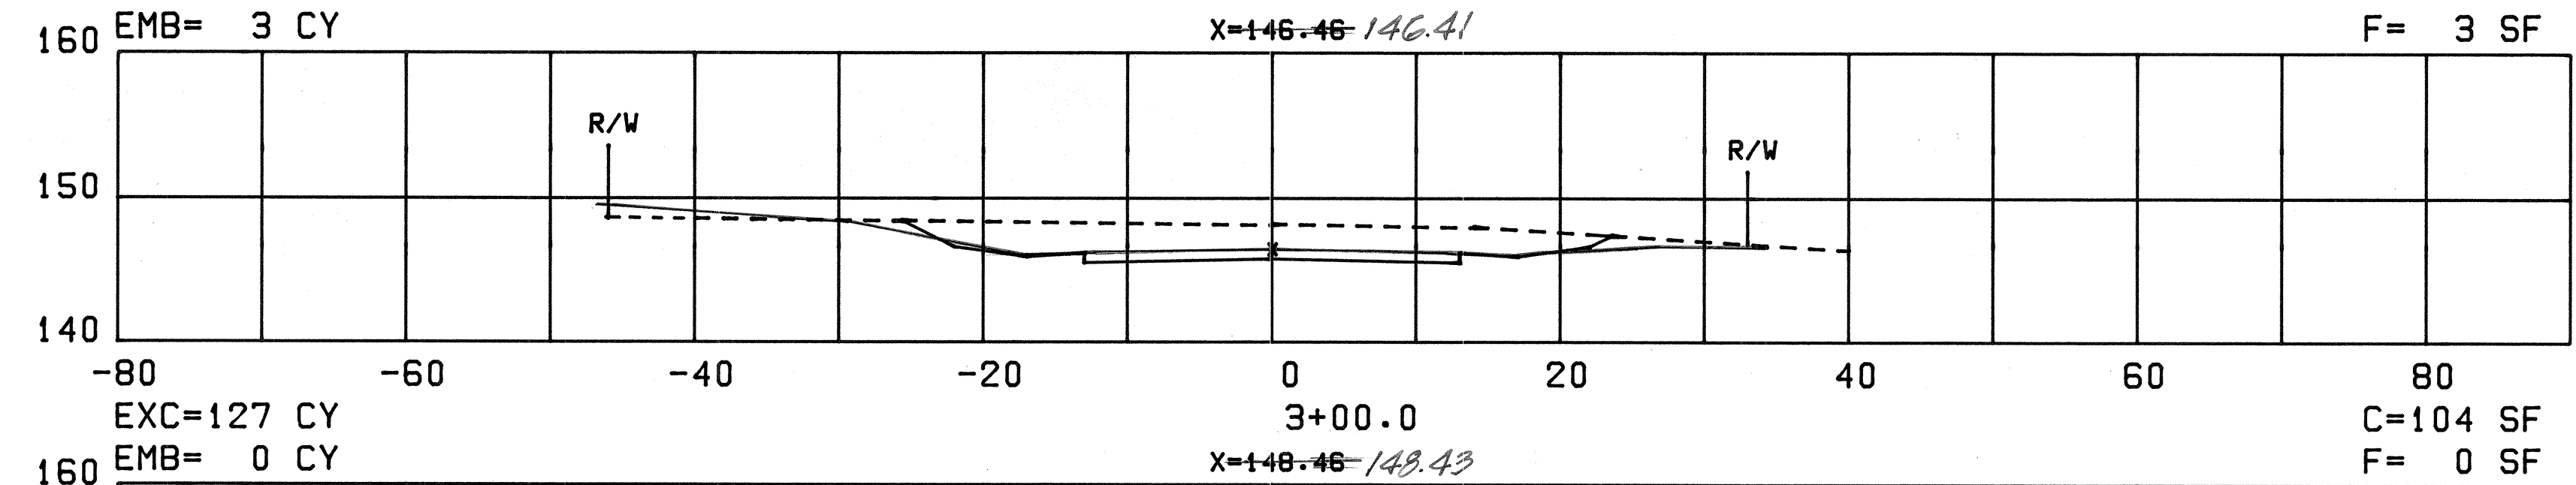


FED. ROAD DIST. NO.	STATE	FED. AID PROJ. NO.	FISCAL YEAR	SHEET NO.	TOTAL SHEETS
HAWAII	HAW.	F-RF-031-1(6)	1978	152	158

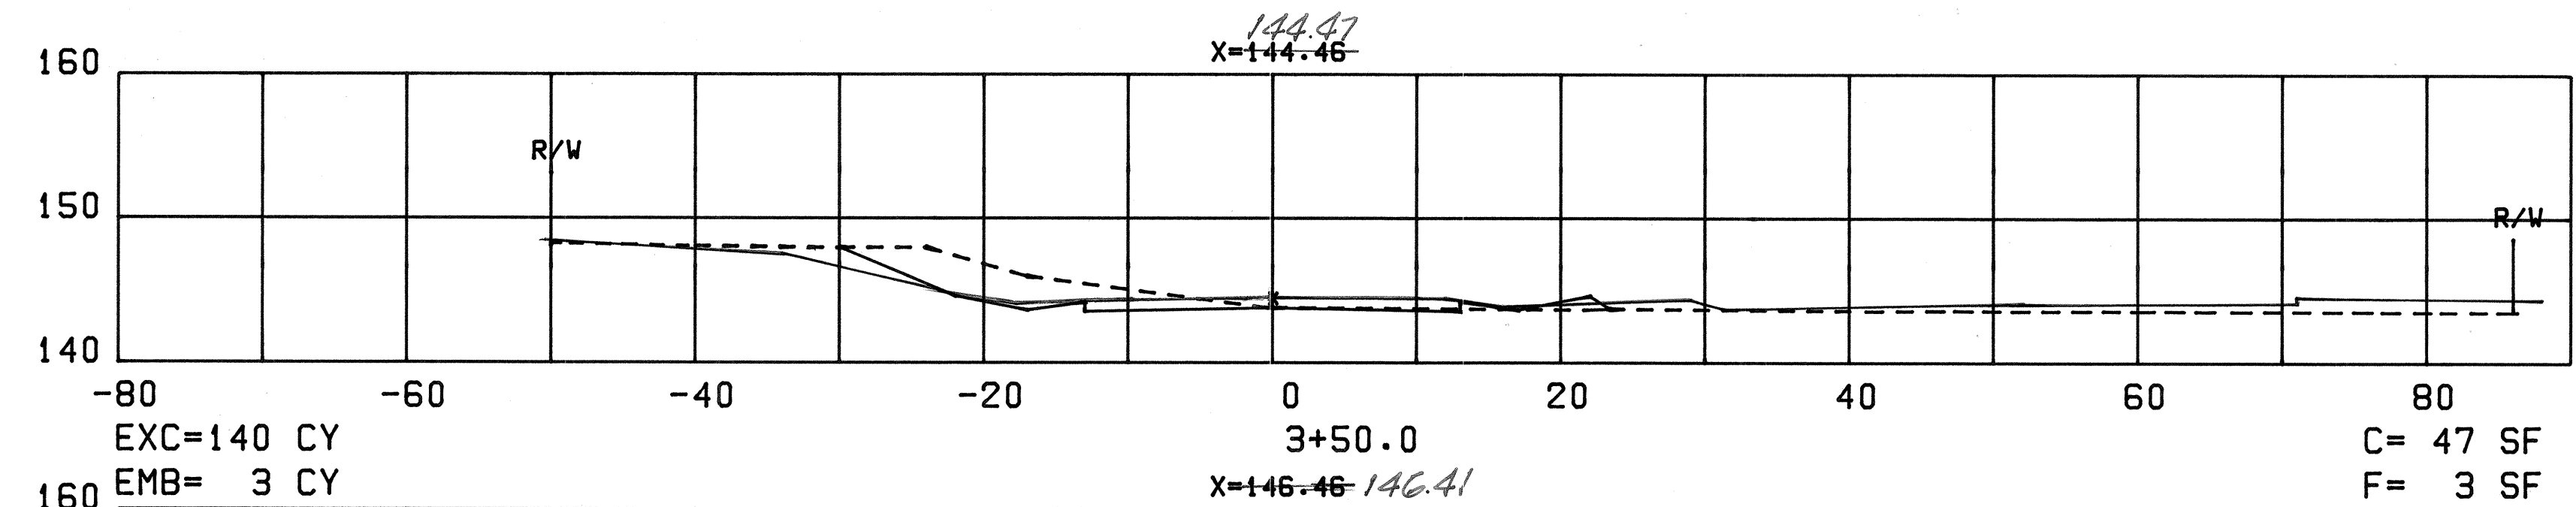


ROAD "N" - KEONEKAI ROAD


SHEET No. 152 OF 158 SHEETS

ORIGINAL PLAN	DATE
SURVEY PLOTTED BY	
DRAWN BY	
CHECKED BY	
DESIGNED BY	
QUANTITIES BY	
CHECKED BY	


FED. ROAD DIST. NO.	STATE	FED. AID PROJ. NO.	FISCAL YEAR	SHEET NO.	TOTAL SHEETS
HAWAII	HAW.	F.R.P. 031-1(6)	1978	153	158

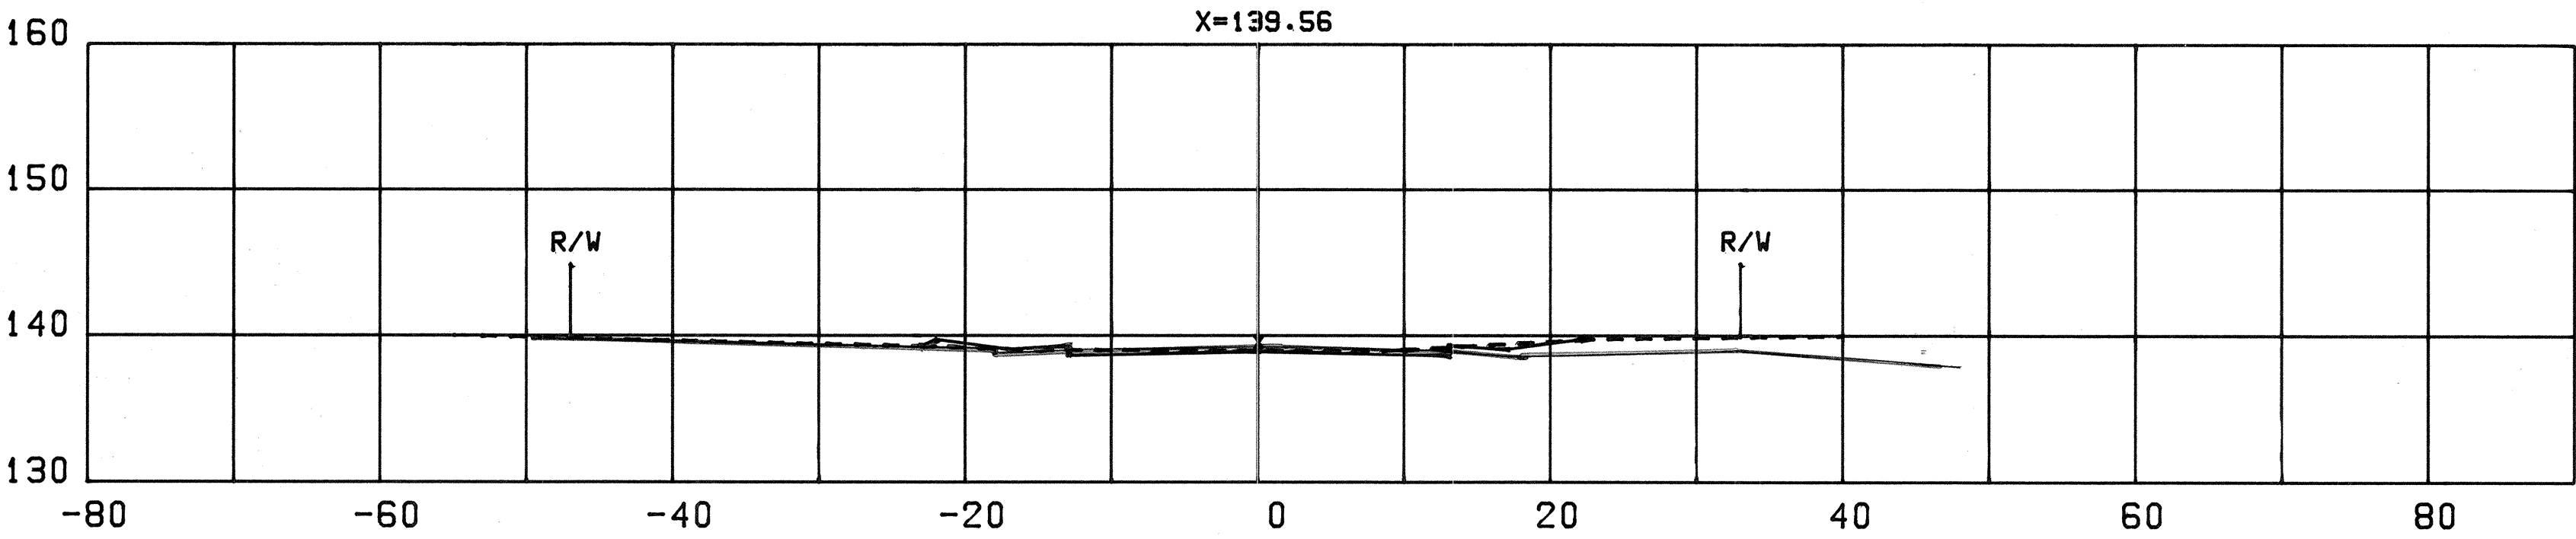


EXC= 60 CY 5+45.0 C= 8 SF
 EMB= 2 CY X=140.45 F= 2 SF

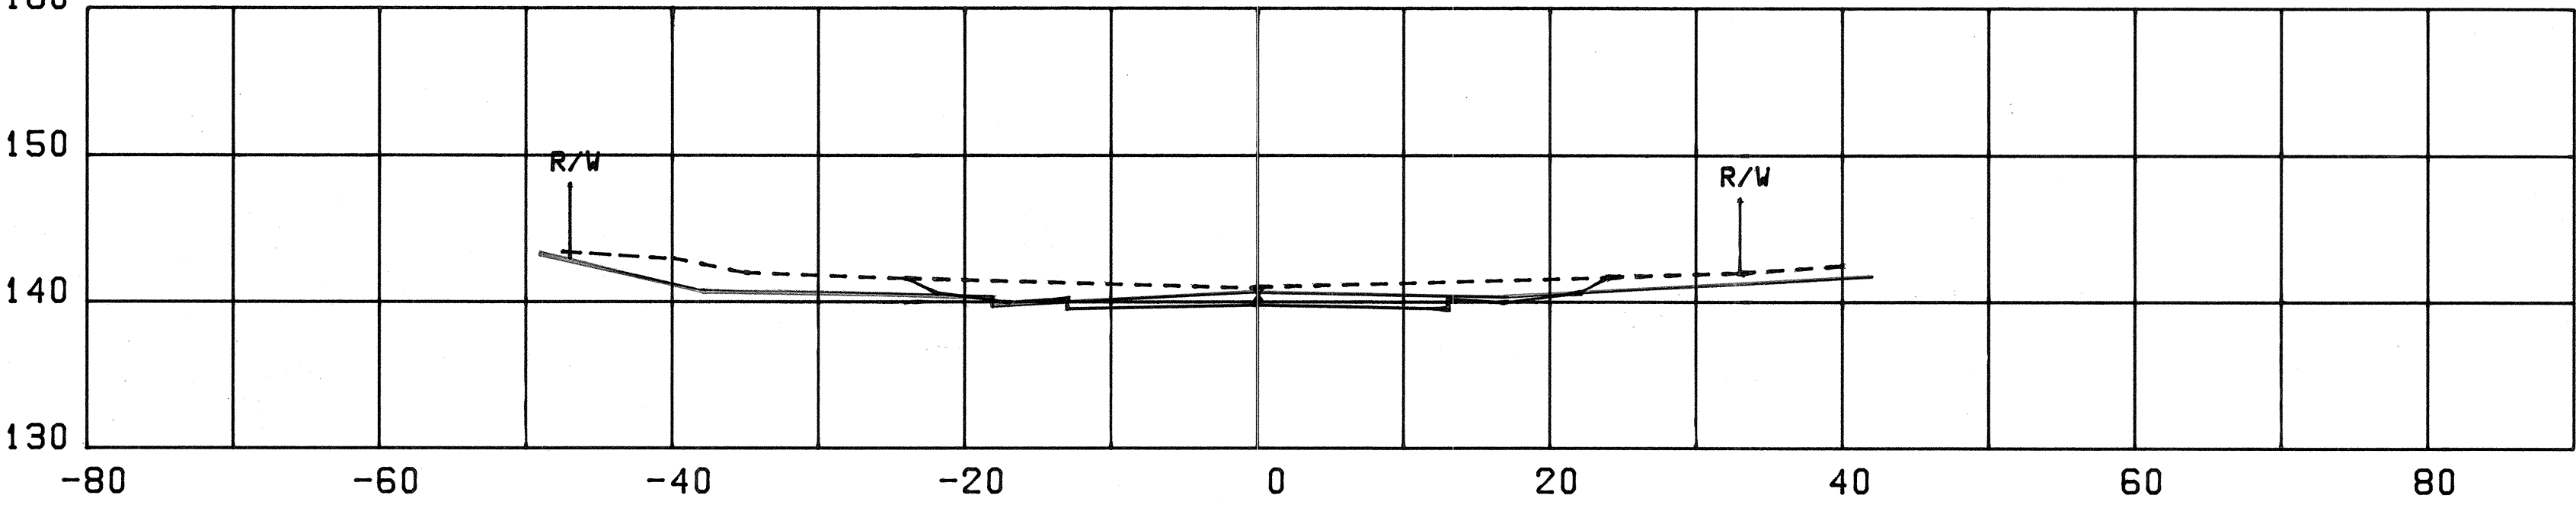

EXC= 87 CY 5+00.0 C= 64 SF
 EMB= 0 CY X=141.46 F= 0 SF

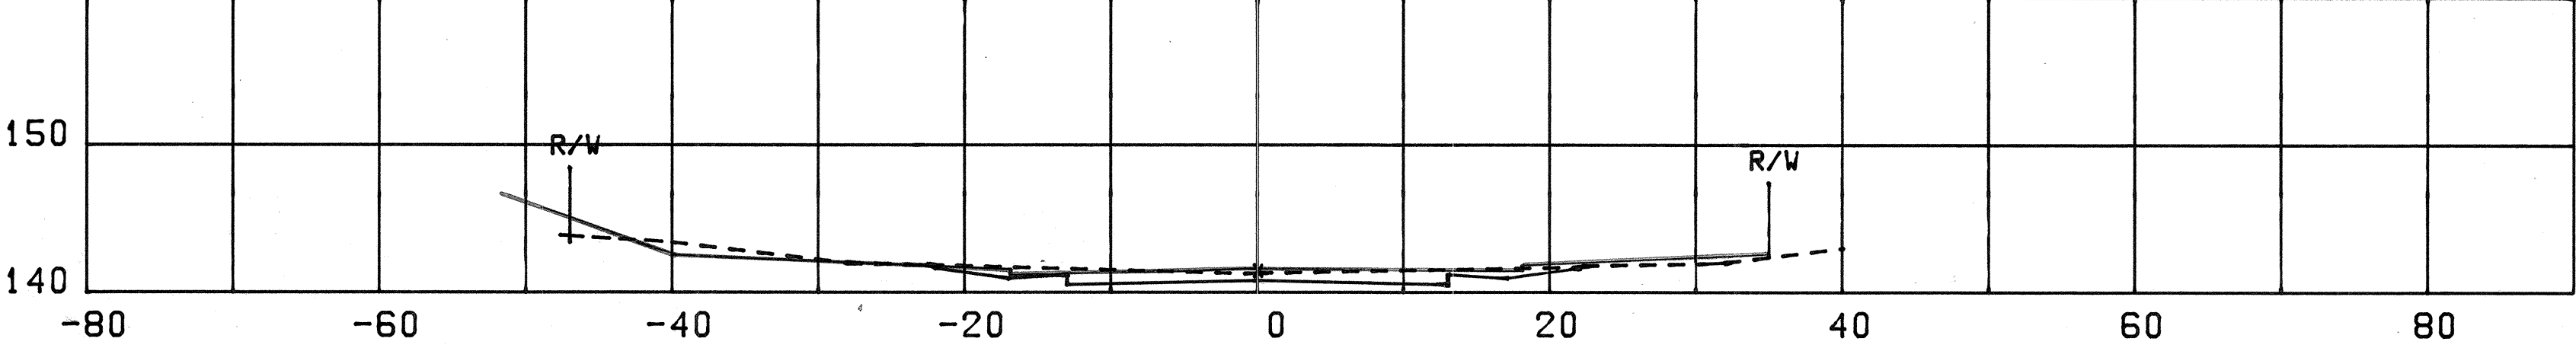

EXC= 55 CY 4+50.0 C= 30 SF
 EMB= 0 CY X=142.47 F= 0 SF

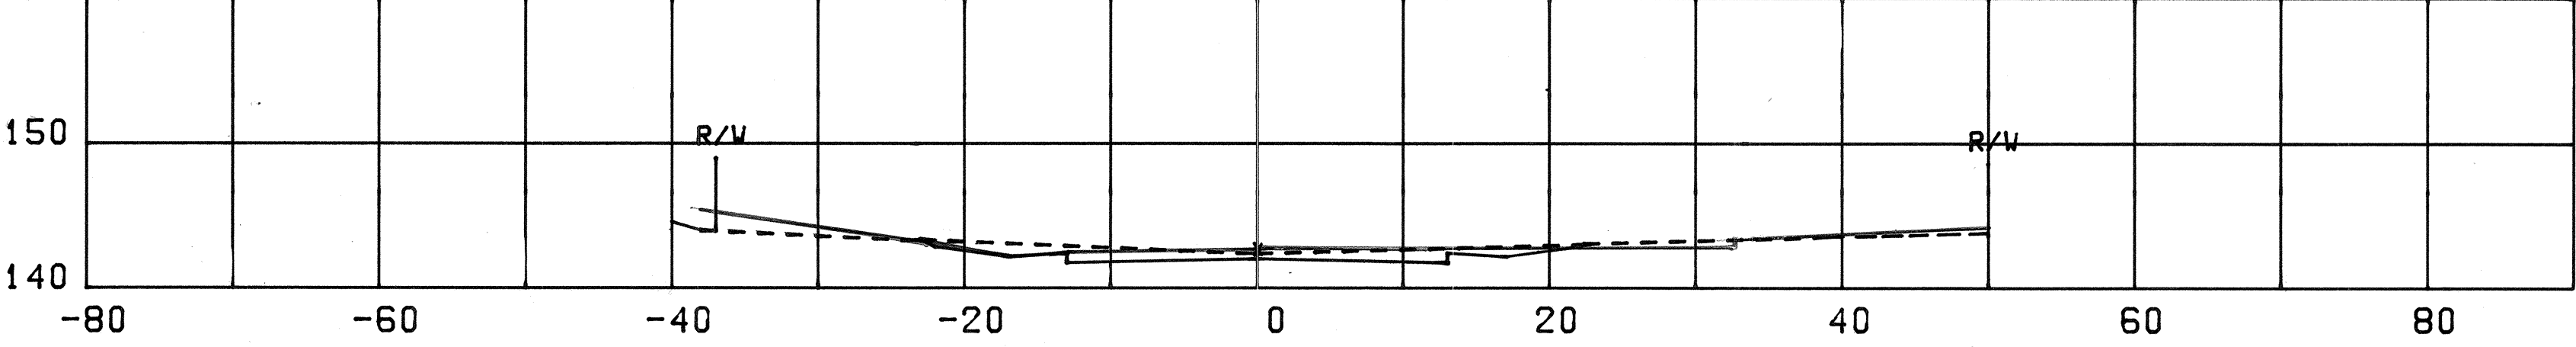

EXC= 71 CY 4+00.0 C= 30 SF
 EMB= 3 CY X=142.47 F= 0 SF

ROAD "N" - KEONEKAI ROAD

ORIGINAL PLAN	SURVEY PLOTTED BY	DATE
DESIGNED BY	DESIGNED BY	
NOTE BOOK	DESIGNED BY	
QUANTITIES BY	DESIGNED BY	
CHECKED BY	DESIGNED BY	
No.	DESIGNED BY	