


FED. ROAD DIST. NO.	STATE	FED. AID PROJ. NO.	FISCAL YEAR	SHEET NO.	TOTAL SHEETS
HAWAII	HAW.	F-RF-031-1(6)	1978	143	158

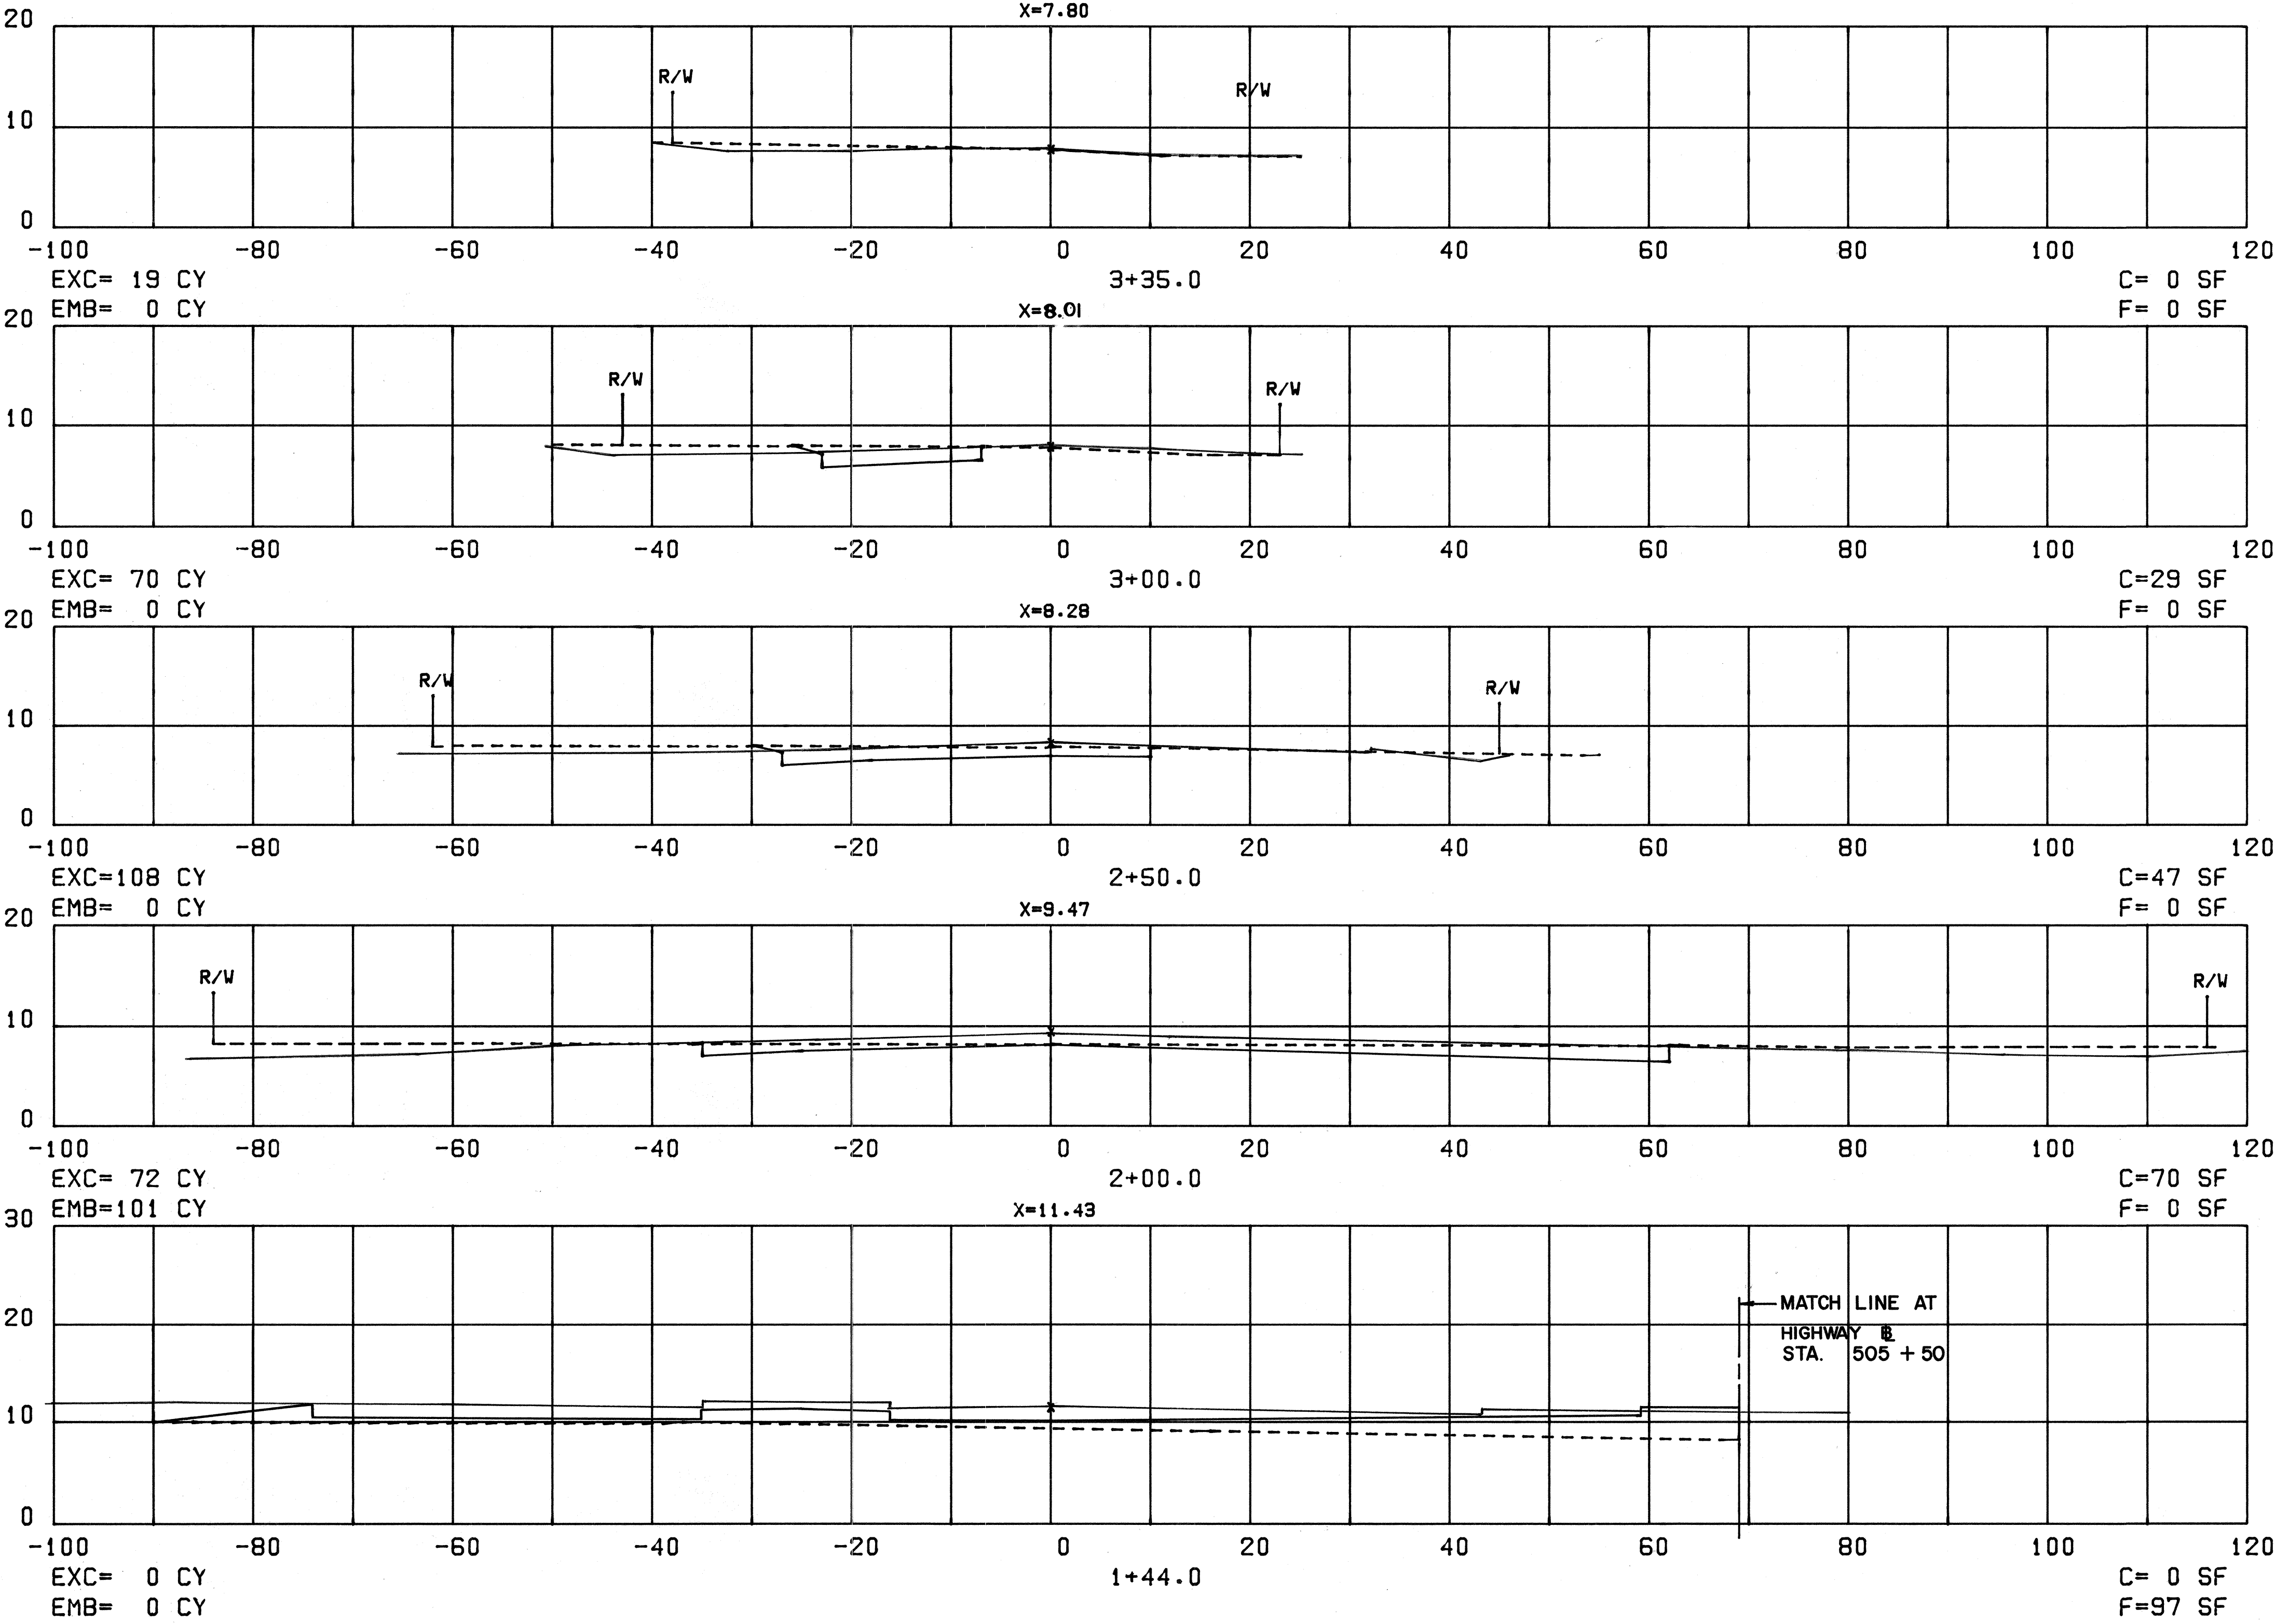

ROAD "A" - KIHAI ROAD