

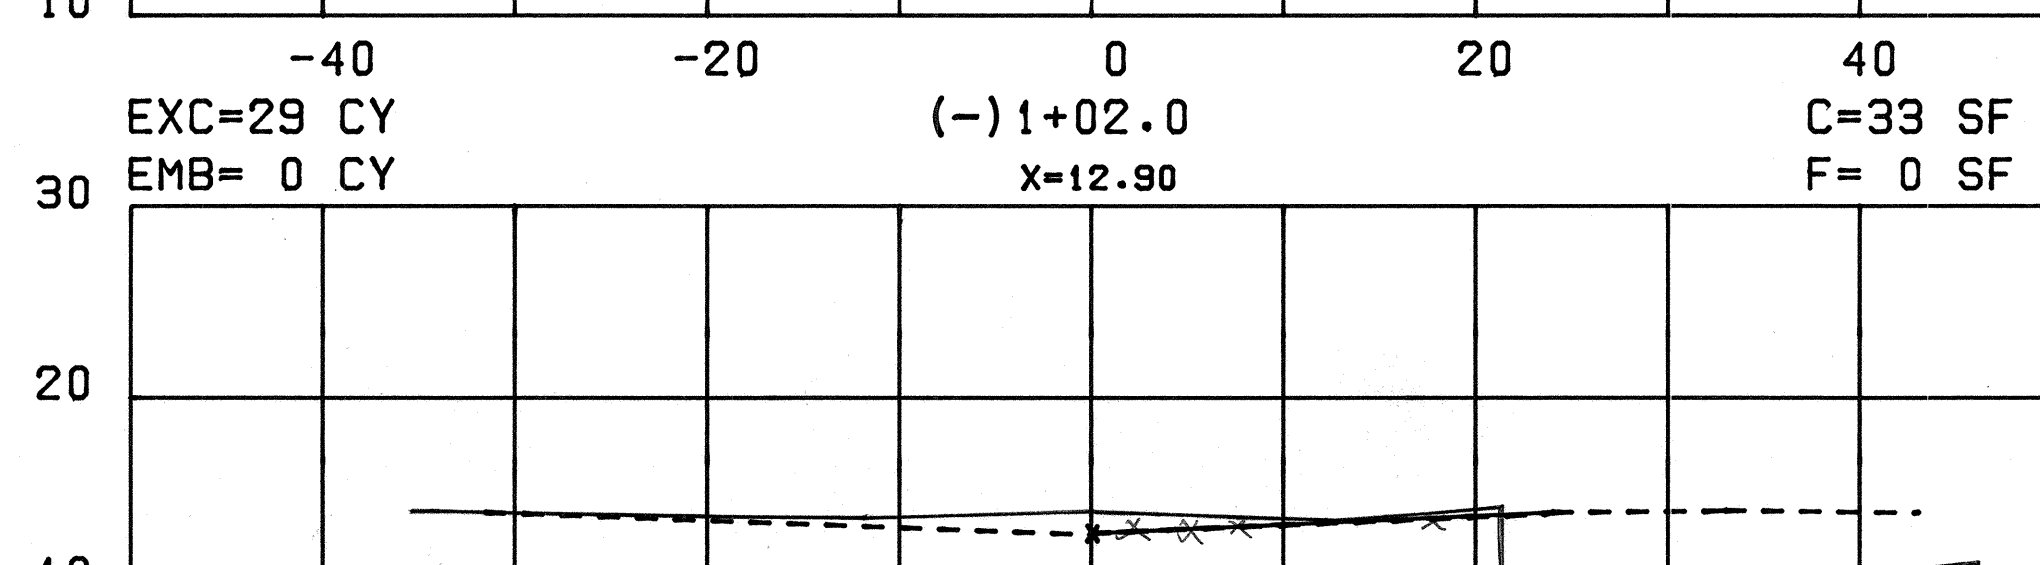
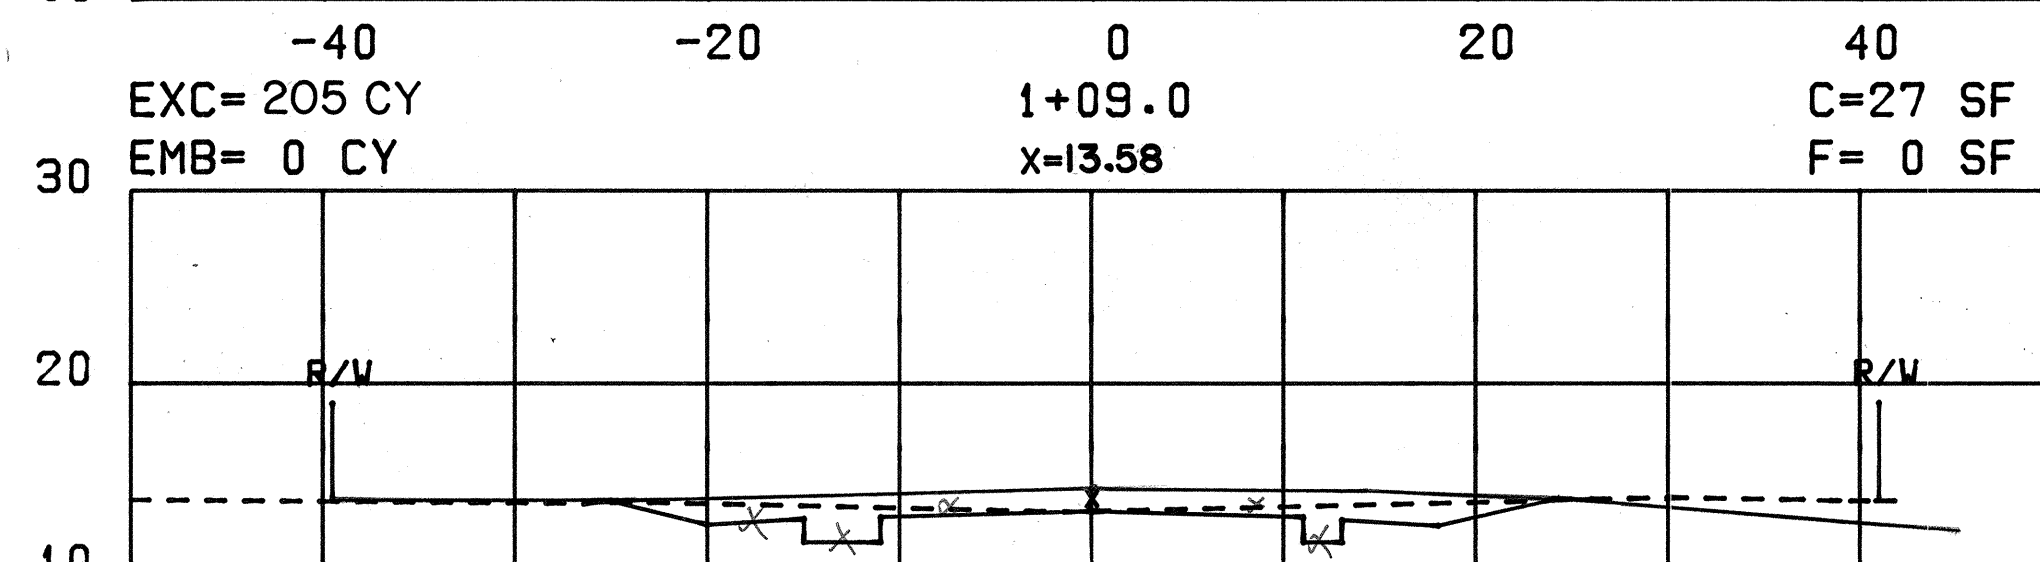
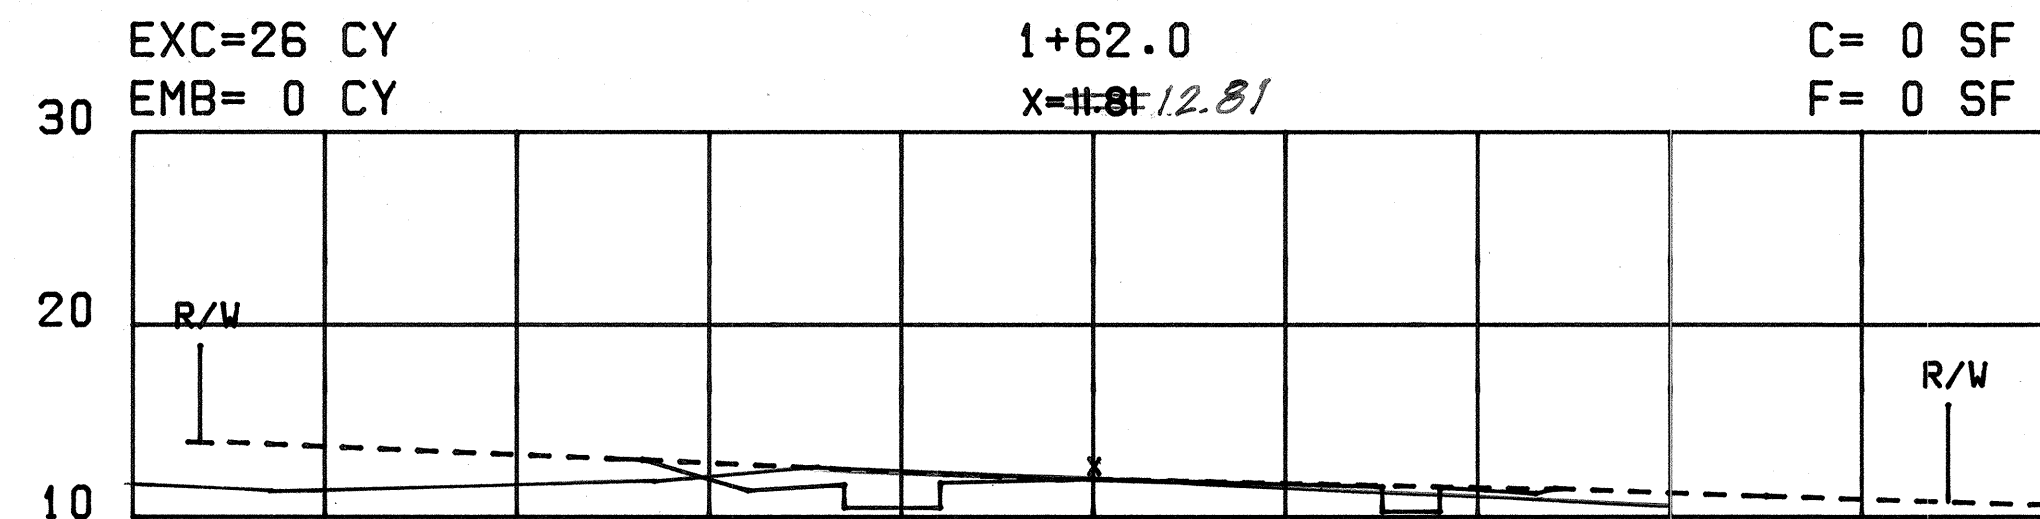
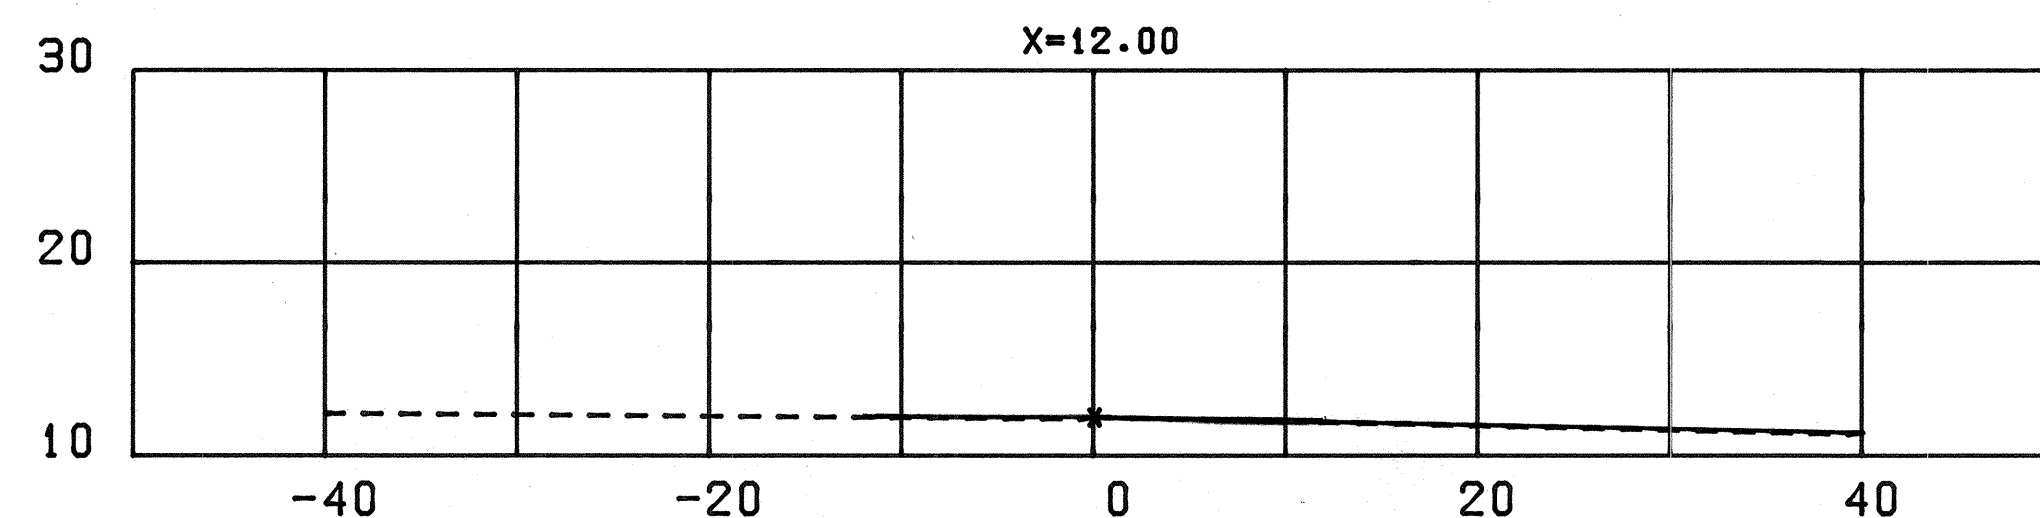


FED. ROAD DIST. NO.	STATE	FED. AID PROJ. NO.	FISCAL YEAR	SHEET NO.	TOTAL SHEETS
HAWAII	HAW.	F.RF-031-1(6)	1978	144	158

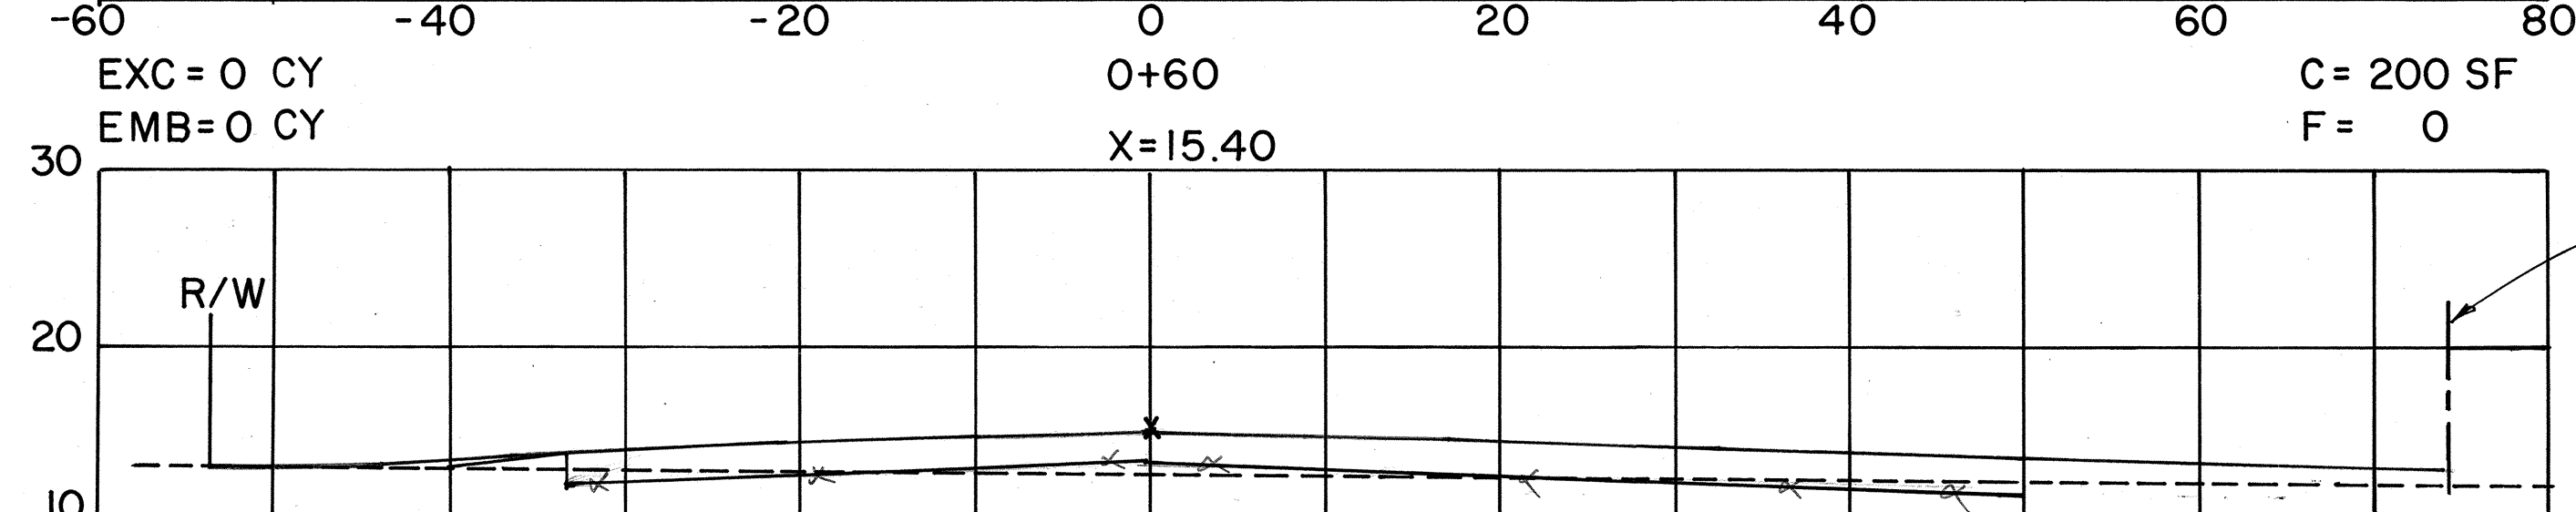

Note: Base Course to sta. 0+65.13
 Ref. C.O. 219-1

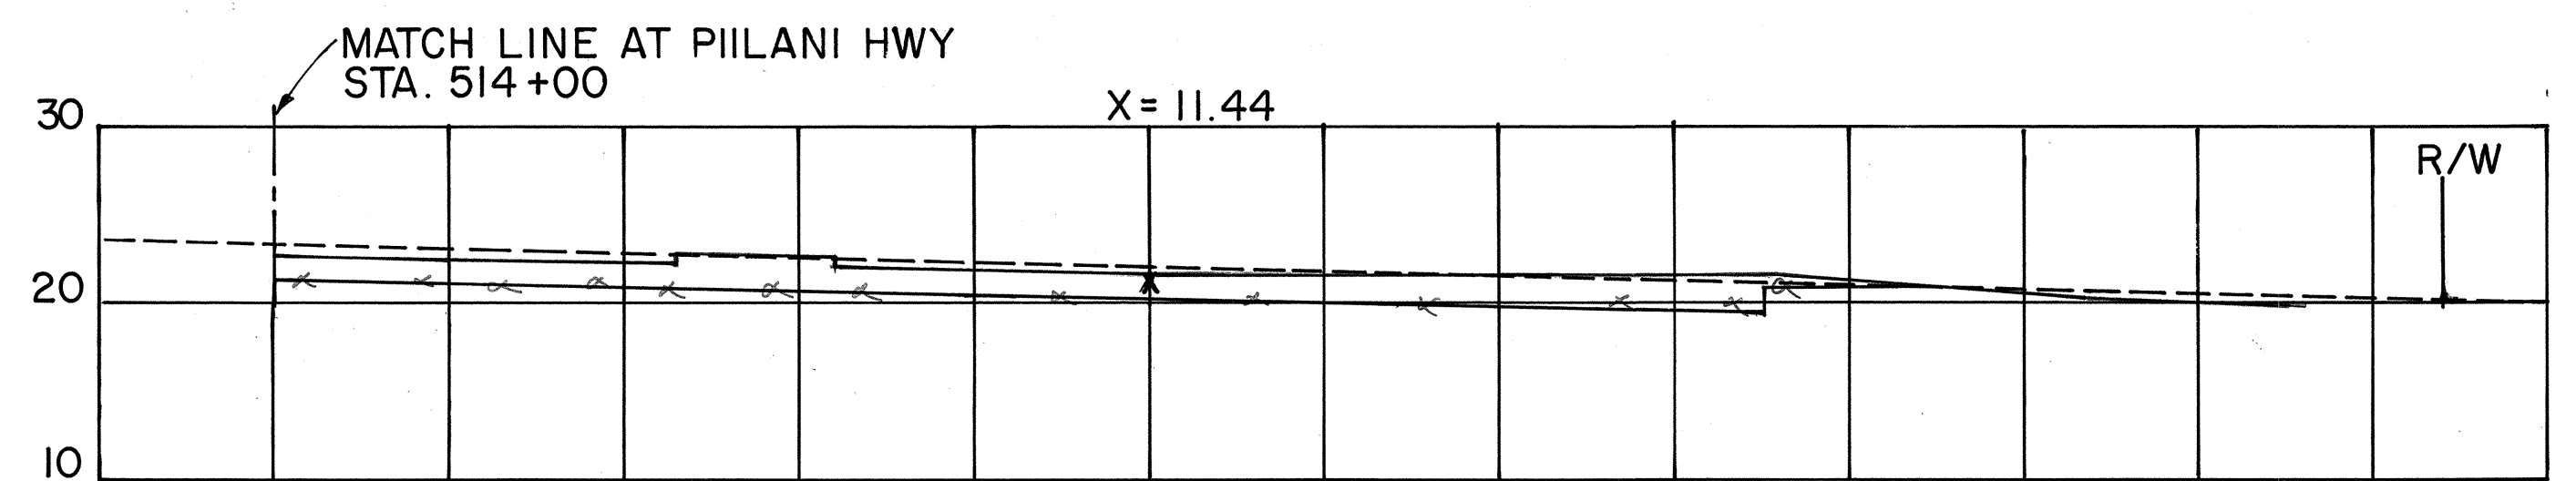

MATCH LINE AT
 PIILANI HWY
 STA. 512+50

ROAD "B" - MOKULELE
 HIGHWAY

SHEET No. 144 OF 158 SHEETS

ORIGINAL PLAN	DATE
DESIGNED BY	
TRACED BY	
NOTED BY	
CHECKED BY	
NO.	