

INDEX TO DRAWINGS	
SHEET NO	DESCRIPTION
1	TITLE SHEET
2-5	TYPICAL SECTIONS
6-19	PLAN & PROFILE
20-27	PLAN & PROFILE - ACCESS ROAD
28-32	SUPERELEVATION DIAGRAMS
33-37	BORING LOGS
38-62	DETAIL PLAN OF ROADWAY
63-78	ROADWAY - MISC. & STD. DETAILS
79-82	CONSTRUCTION PHASING & TEMPORARY SIGNING
83-107	DRAINAGE PLAN
108-157	DRAINAGE DETAILS
158-160	WATER & SEWER UTILITIES PLAN
161-196	SIGNING & PAVEMENT MARKING
197	TRAFFIC SIGNAL CONDUIT LAYOUT PLAN
198-203	IRRIGATION PLAN
204	PLANTING PLAN
205-223	EROSION CONTROL PLAN
224-252	WAIAKOA GULCH, KULANIHAKOI GULCH, WAIPULANI GULCH & KEOKEA GULCH BRIDGE PLANS
253-262	MISC. STRUCTURAL DETAILS
	ADDITIONAL SHEETS - 153A, 160A

① C.O. 215-S-1, C.O. 215-S-2, C.O. 265-S-1,
 ② C.O. 475-S-1, ③ C.O. 1005-S-1,
 ④ 1315-S-1, ADD 153A, 156 S-1
 ⑤ ADD 158 S-1, ADD 160A, ADD 160 S-1,
 ⑥ C.O. 1705-S-1, C.O. 175 S-1, C.O. 194 S-1,
 C.O. 195 S-1, ⑦ C.O. 214 S-1, ARE
 SUPPLEMENT SHEETS TO THE
 CONTRACT PLANS.
 NEW TOTAL = 278 SHEETS.

STATE OF HAWAII
 DEPARTMENT OF TRANSPORTATION
 LAND TRANSPORTATION FACILITIES DIVISION
 HONOLULU, HAWAII

"AS BUILT"
 PLANS OF
PIILANI HIGHWAY


VICINITY OF MOKULELE HIGHWAY TO
 VICINITY OF KILOHANA STREET
 F. A. PROJECT NO. TQF-RF-031-I(6)
 DISTRICTS OF WAILUKU AND MAKAWAO
 ISLAND OF MAUI

SCALES

PLANS 1"=100'
 PROFILES HOR. 1"=100'
 VERT. 1"=10'
 DETAIL ROADWAY PLANS 1"=50'

NOTE


WHEREVER THE PROJECT NOS. F-031-I(6)
 AND F-RF-031-I(6) APPEARS ON THESE PLANS,
 IT SHALL BE AMENDED TO READ
 "TQF-RF-031-I(6)"

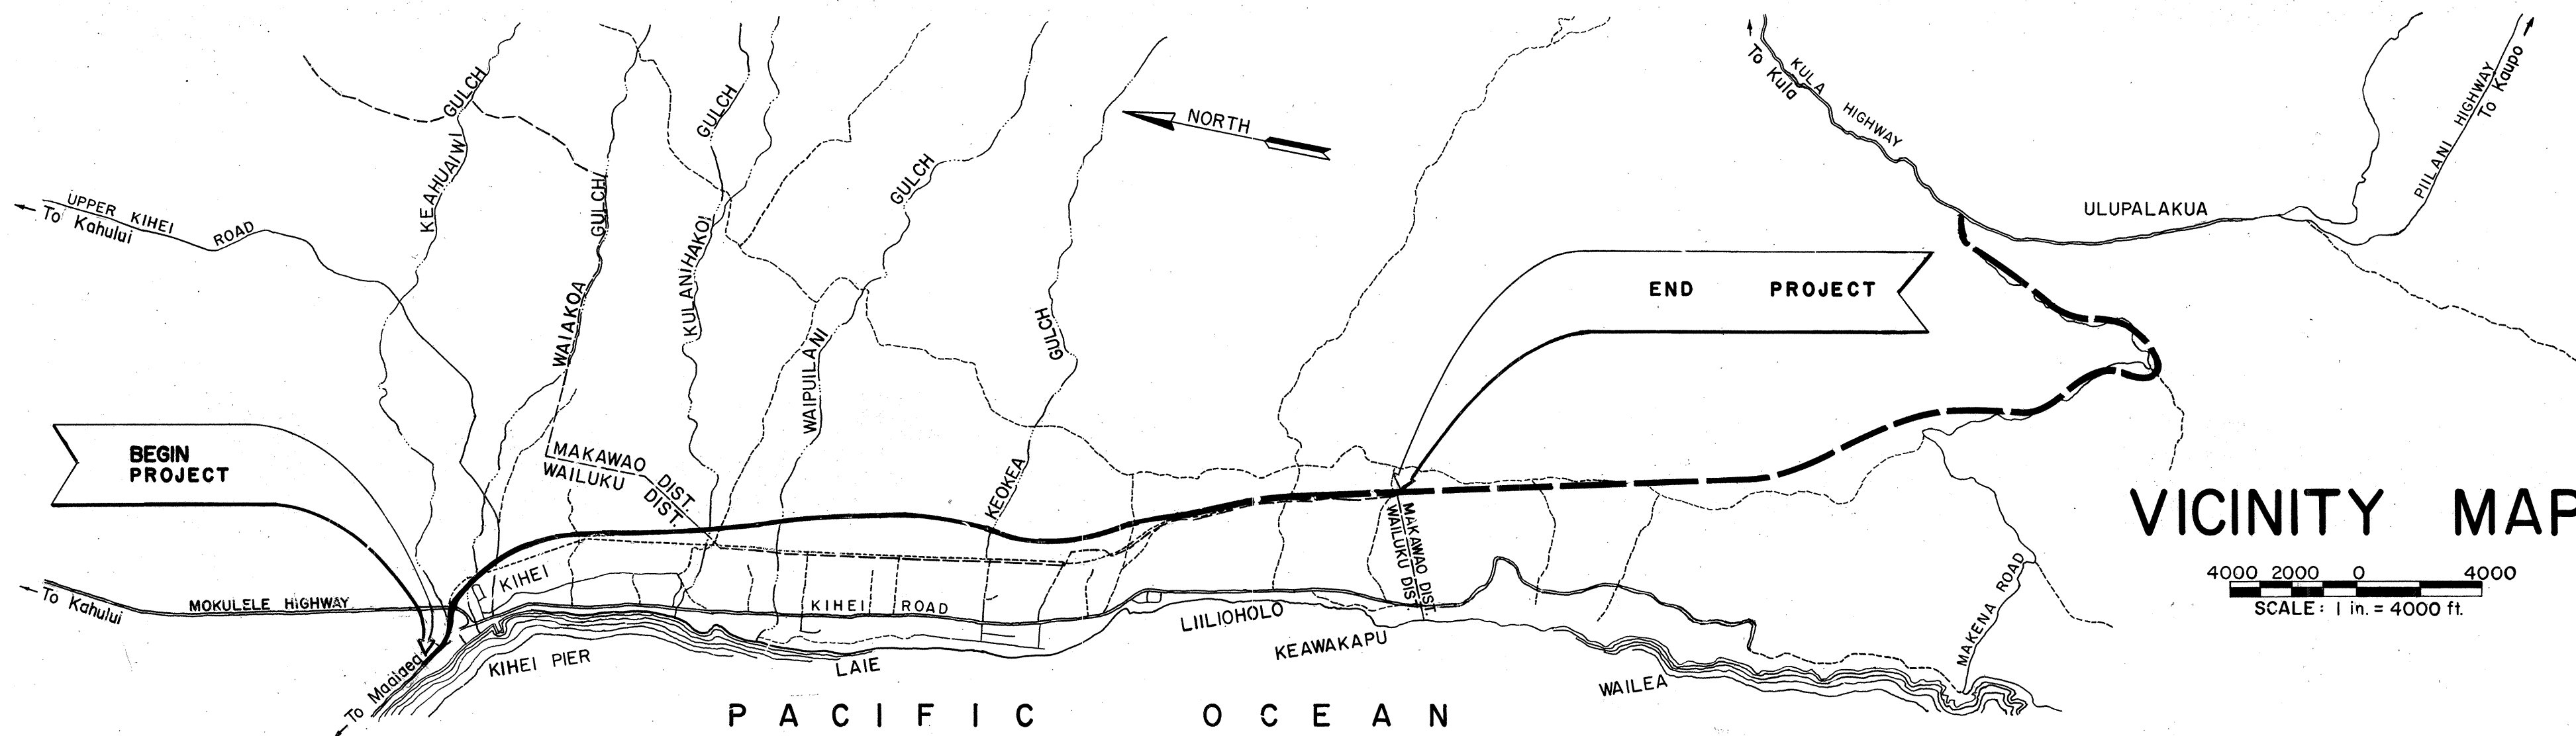

VICINITY MAP

4000 2000 0 4000
 SCALE: 1 in. = 4000 ft.

FED. ROAD DIST. NO.	STATE	FED. AID PROJ. NO.	FISCAL YEAR	SHEET NO.	TOTAL SHEETS
HAWAII	HAW.	TQF-RF-031-I(6)	1978	1	262

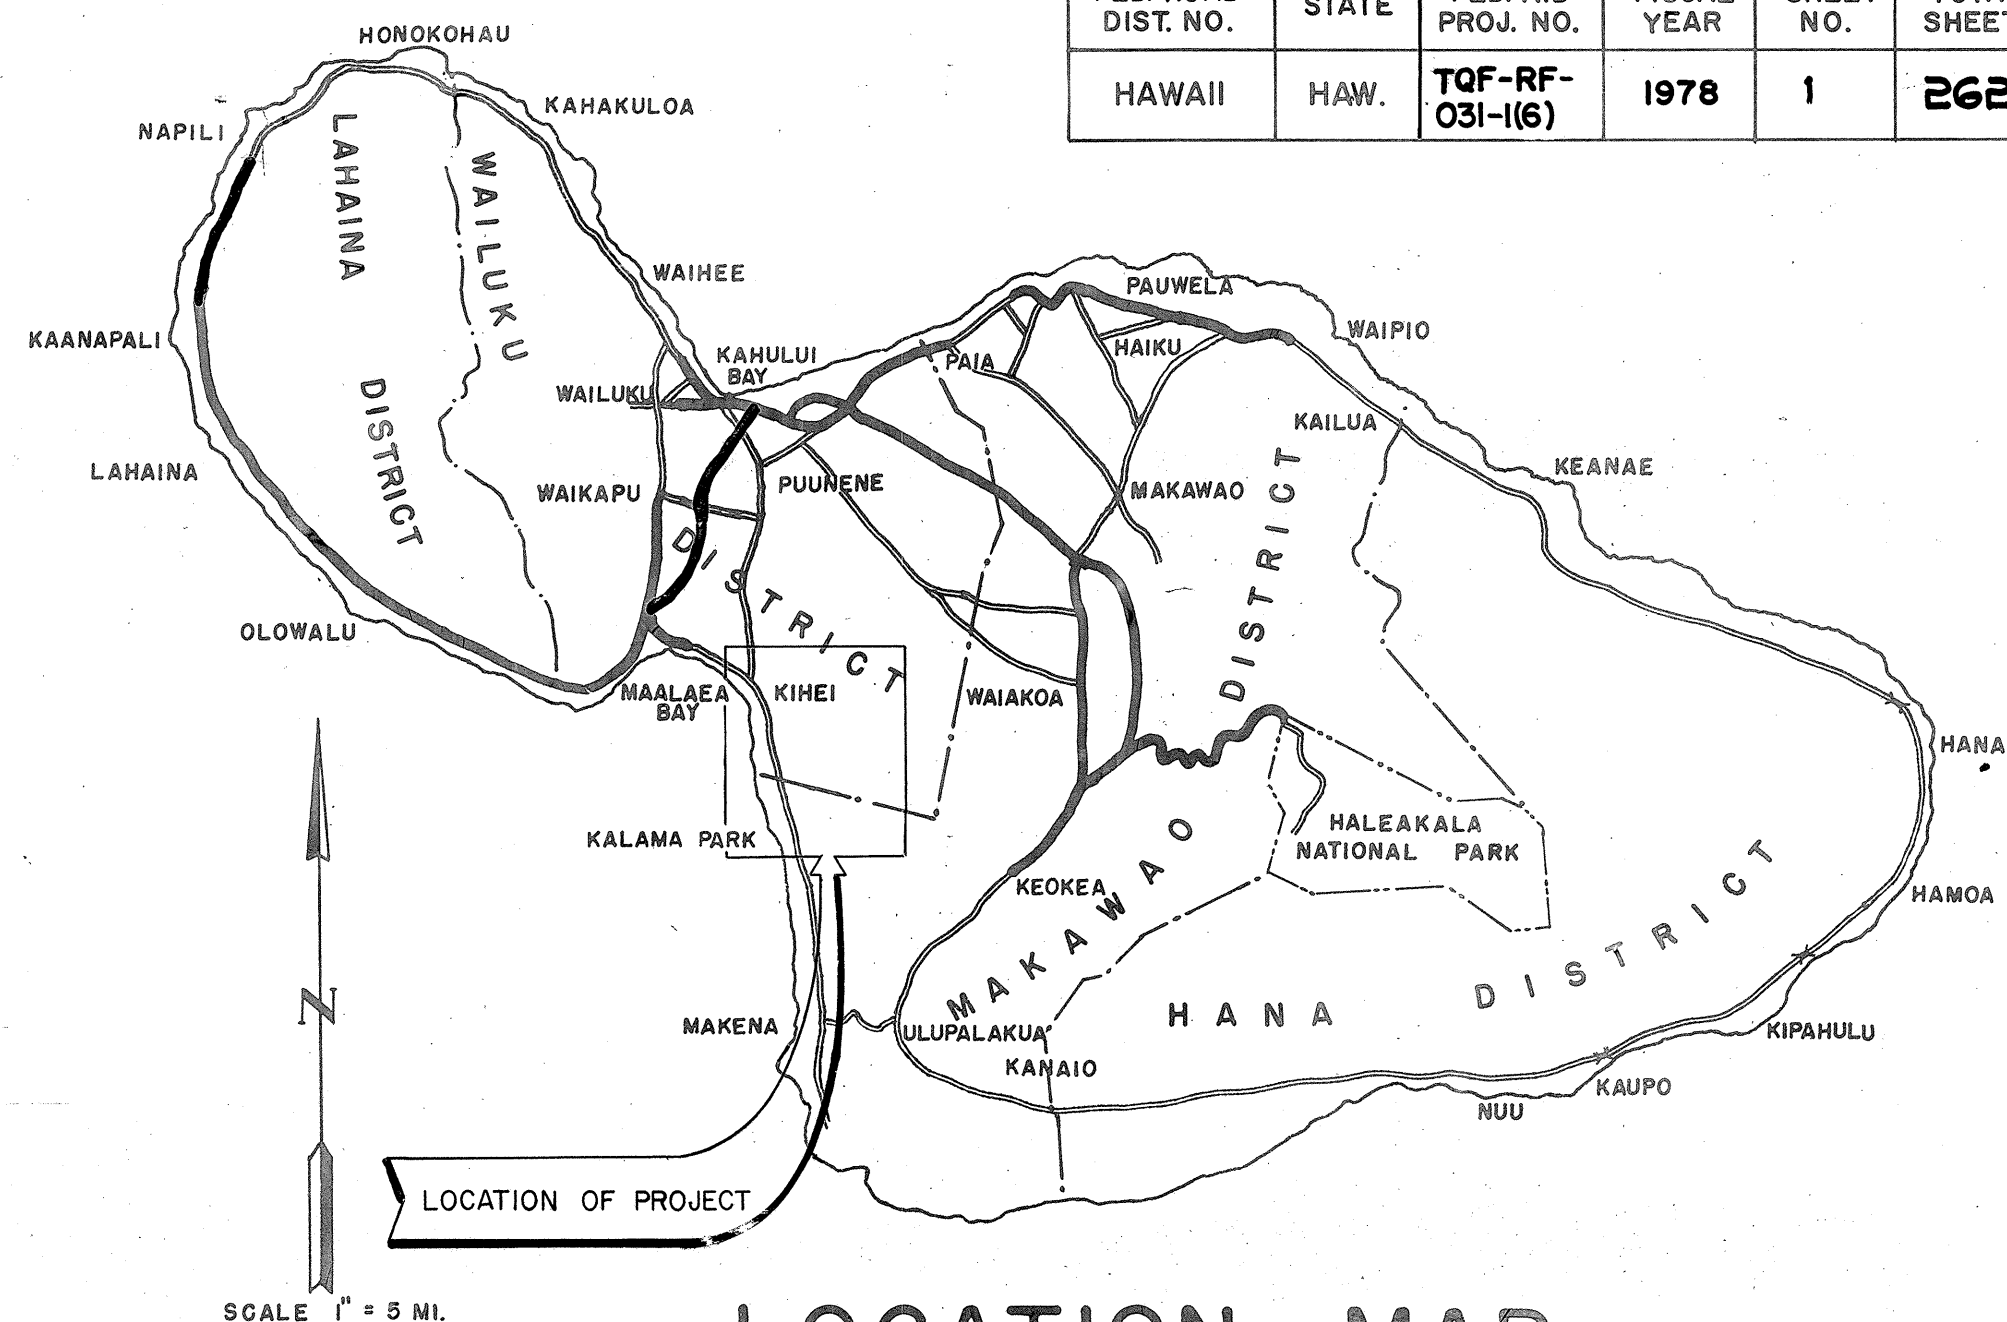

LOCATION MAP

— FEDERAL AID PROJECTS PREVIOUSLY CONSTRUCTED OR UNDER CONSTRUCTION

DESIGN DESIGNATION

ADT(1977) _____ 11,100
 ADT(1997) _____ 13,600
 DHV _____ 1,360
 D _____ 60/40
 T _____ 2.5%
 T₂₄ _____ 2%
 V _____ 50 MPH

GROSS LENGTH OF PROJECT 6.559 MILES
 BRIDGES OVER 20 FEET SPAN 0.091 MILES
 NET LENGTH OF ROADWAYS 6.468 MILES

ALL CHANGES MADE DURING CONSTRUCTION HAVE BEEN INCORPORATED ON THESE PLANS IN RED EXCEPT CHANGES IN THE ORIGINAL THEORETICAL QUANTITIES. FOR ACTUAL QUANTITIES, REFER TO PROJECT LEDGER AND/OR COMPUTATION BOOK.

James F. Kato
 RESIDENT ENGINEER

4/26/84
 DATE

DEPARTMENT OF TRANSPORTATION
 FEDERAL HIGHWAY ADMINISTRATION
 APPROVED: *Barry J. ...* 9/28/78
 DIVISION ADMINISTRATOR DATE

DEPARTMENT OF TRANSPORTATION
 STATE OF HAWAII
 APPROVED: *Ryosuke Higashinaka* 9/15/78
 DIR. OF TRANSPORTATION DATE