
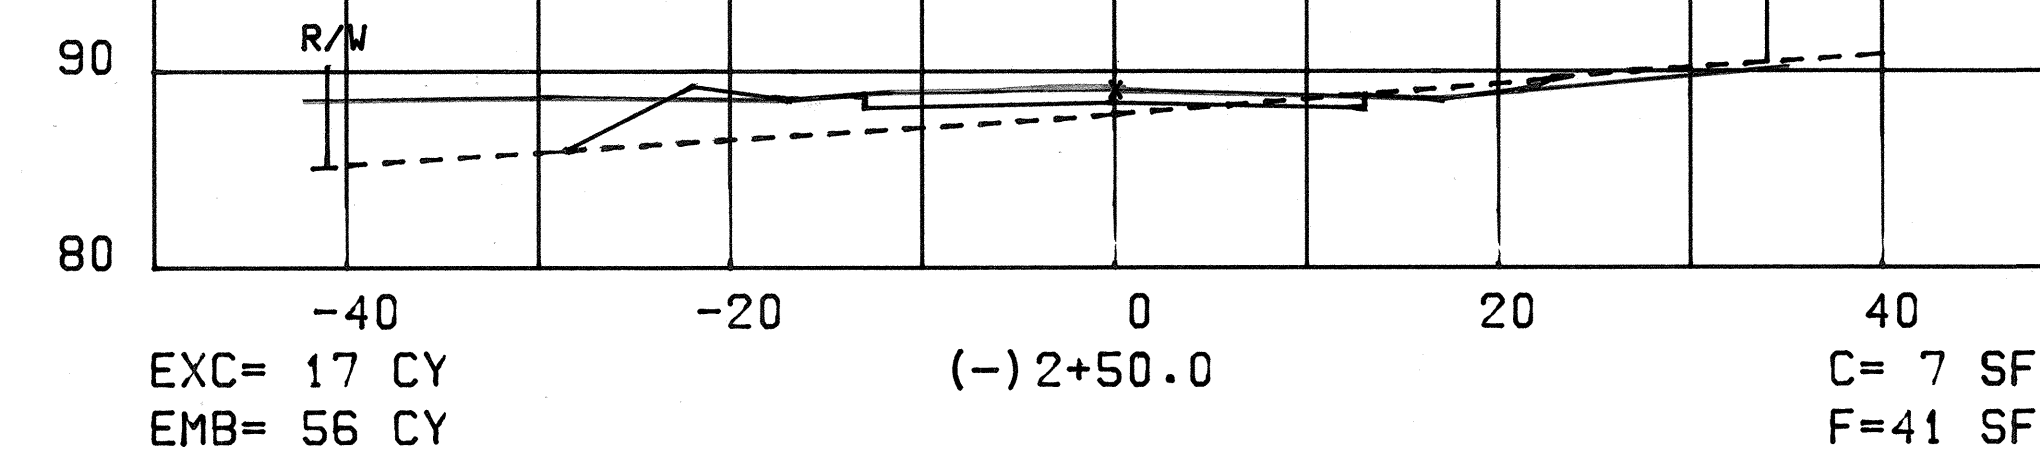
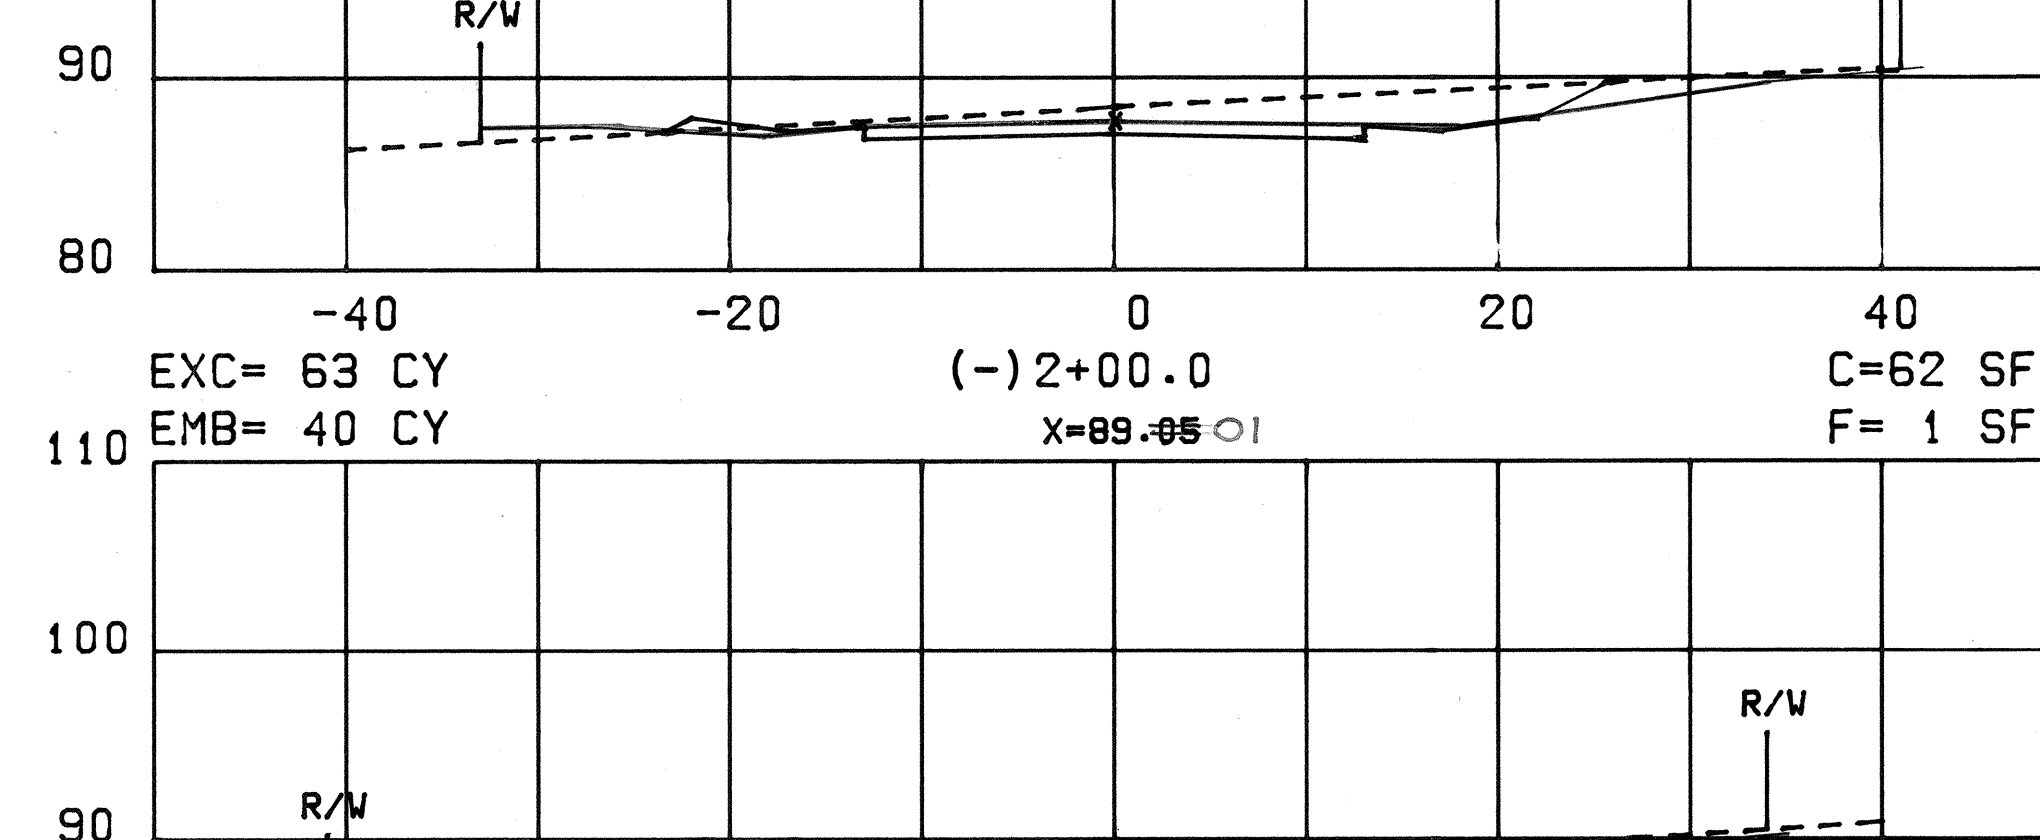
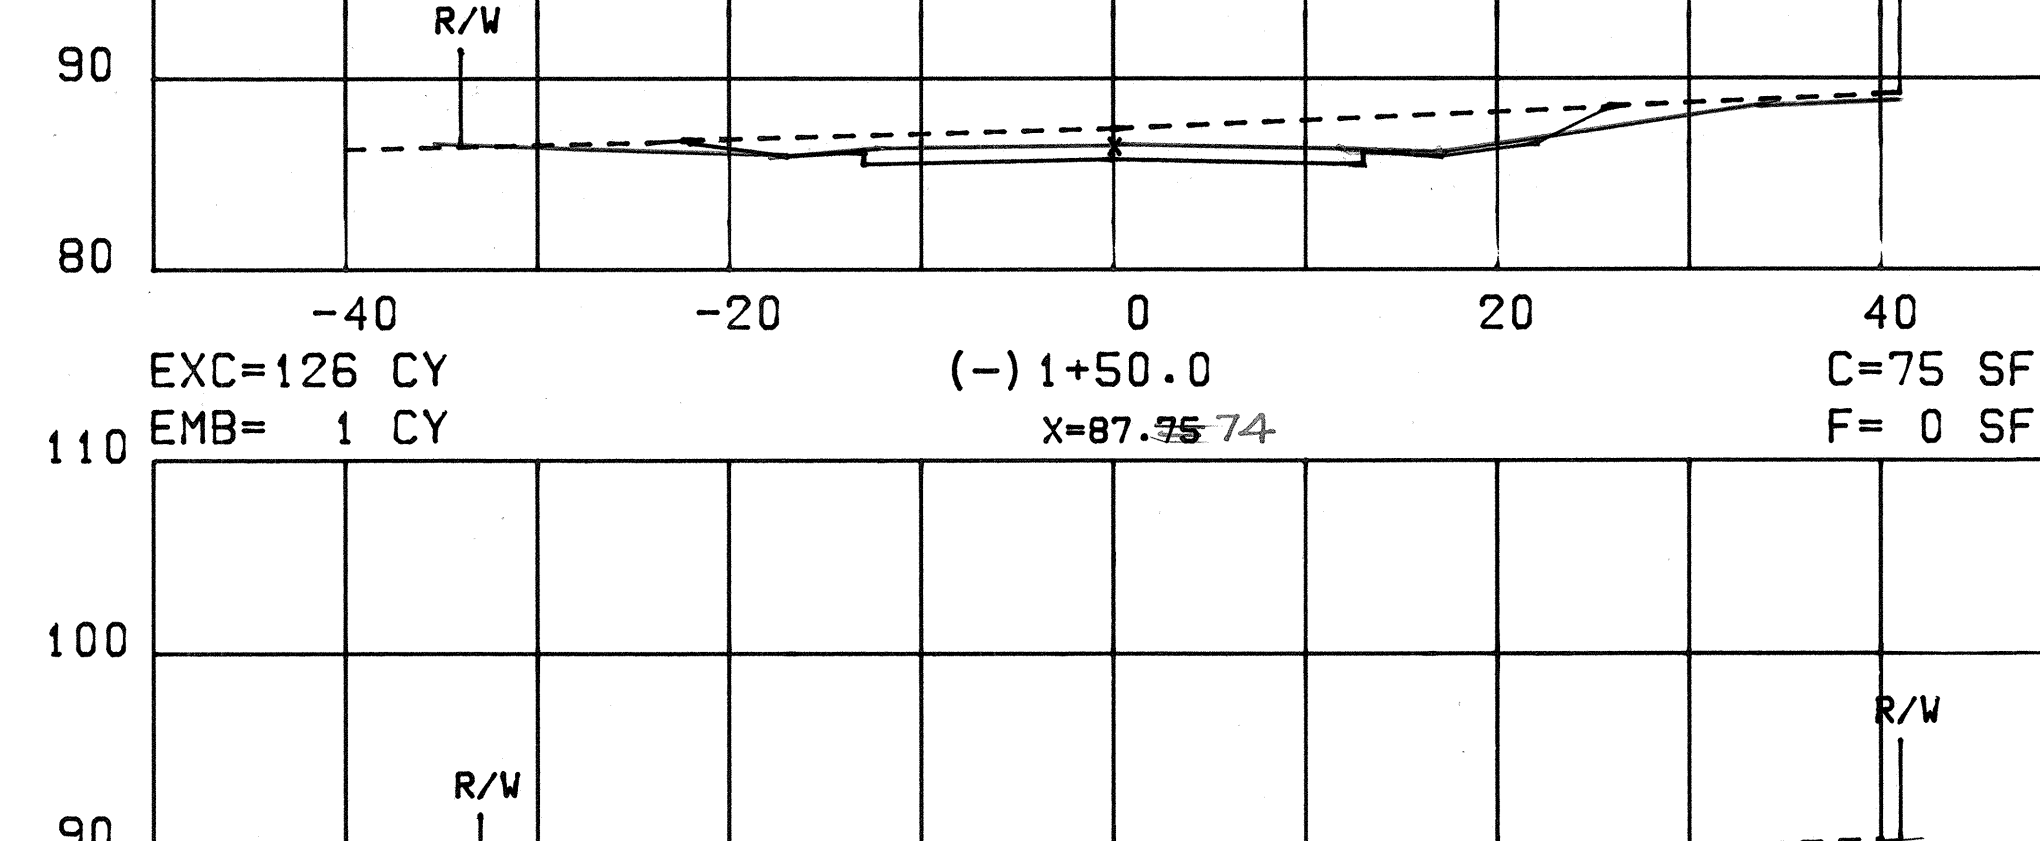
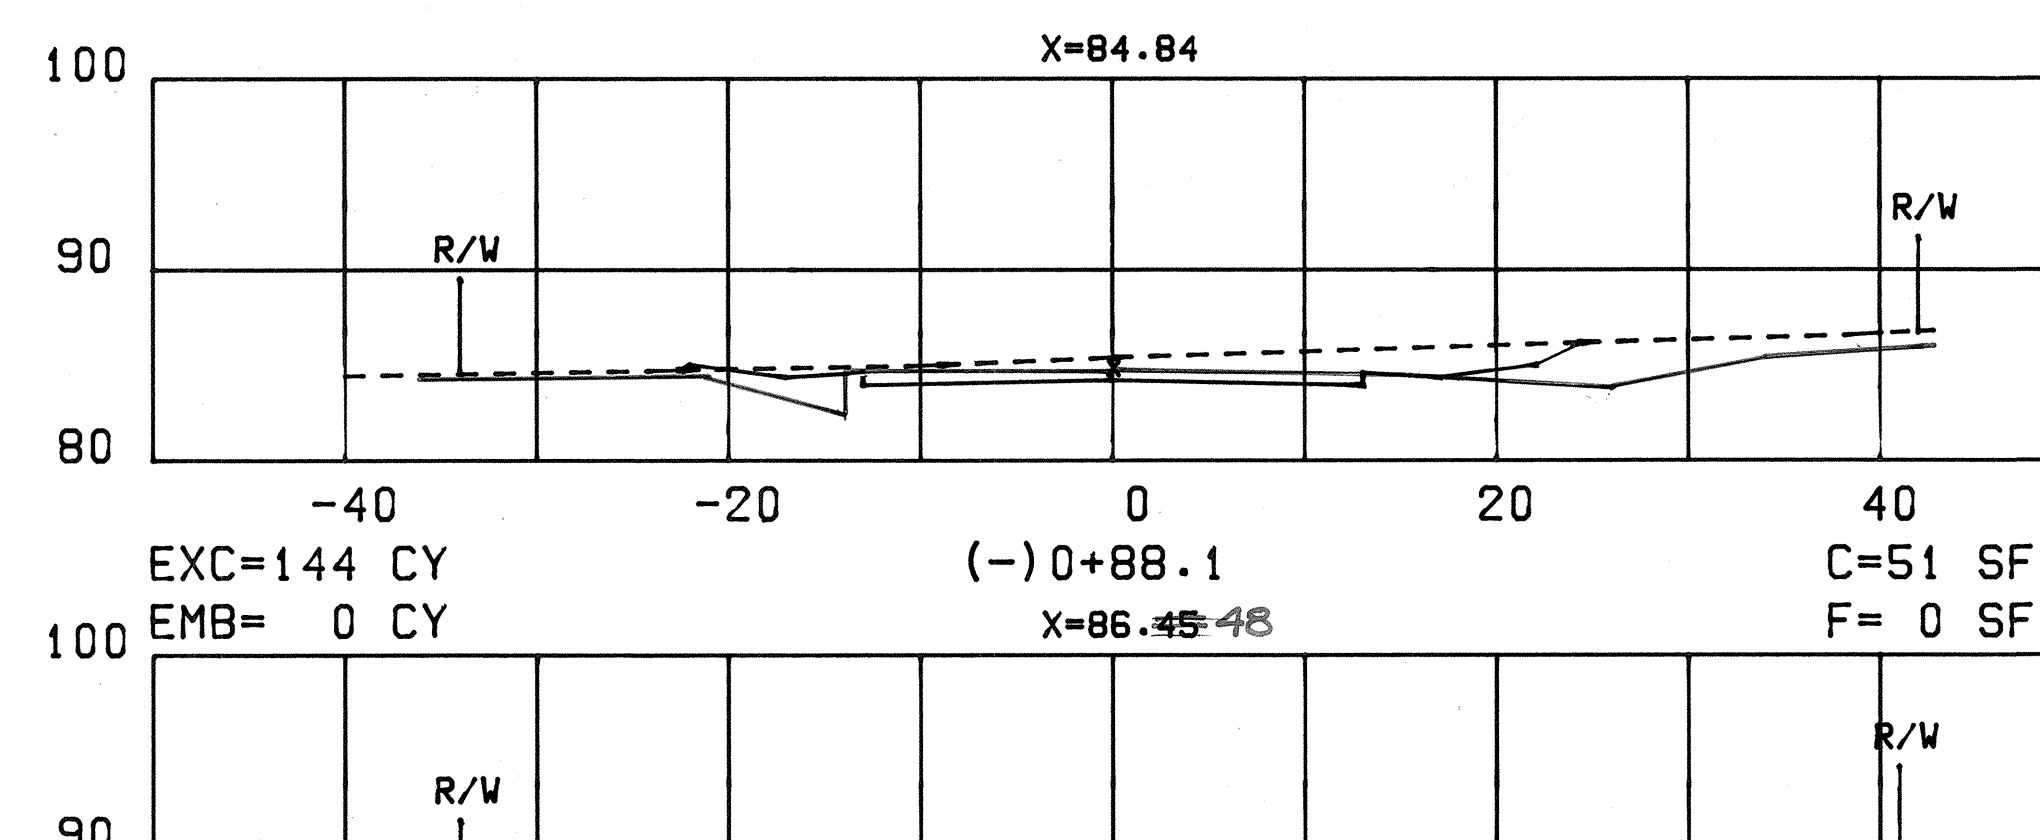
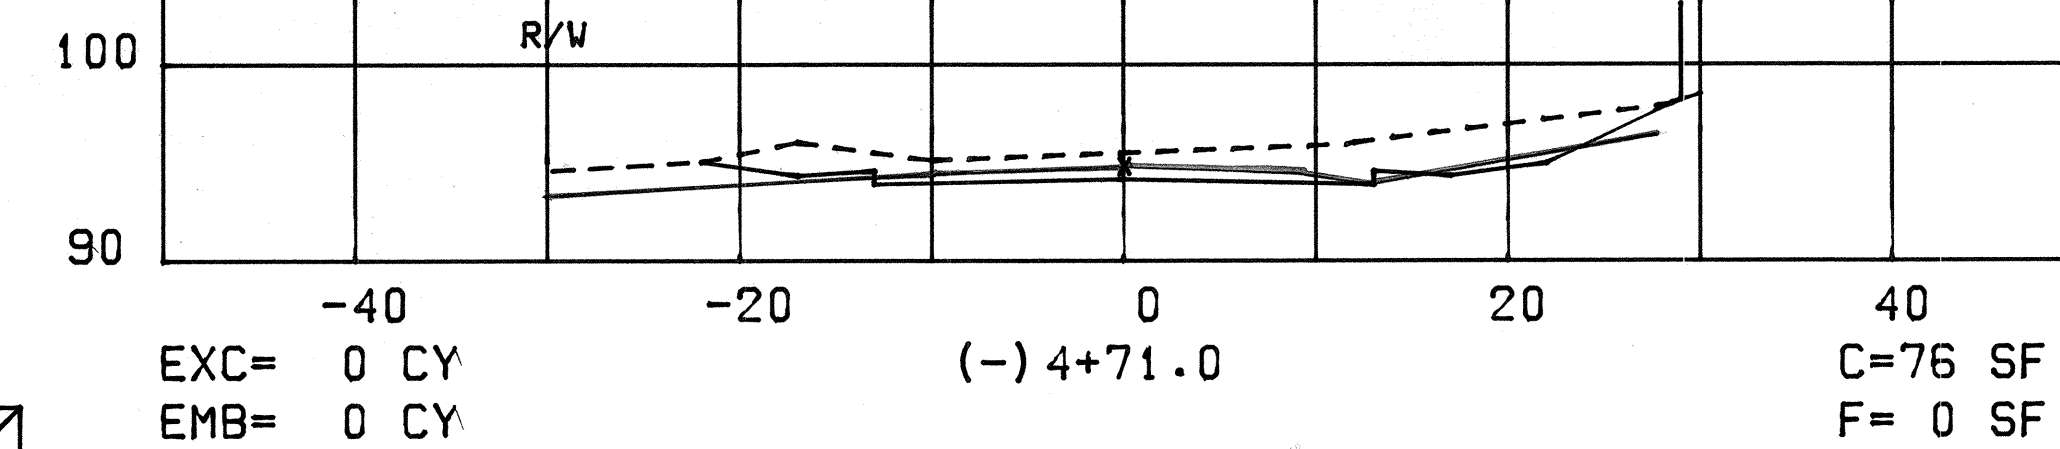
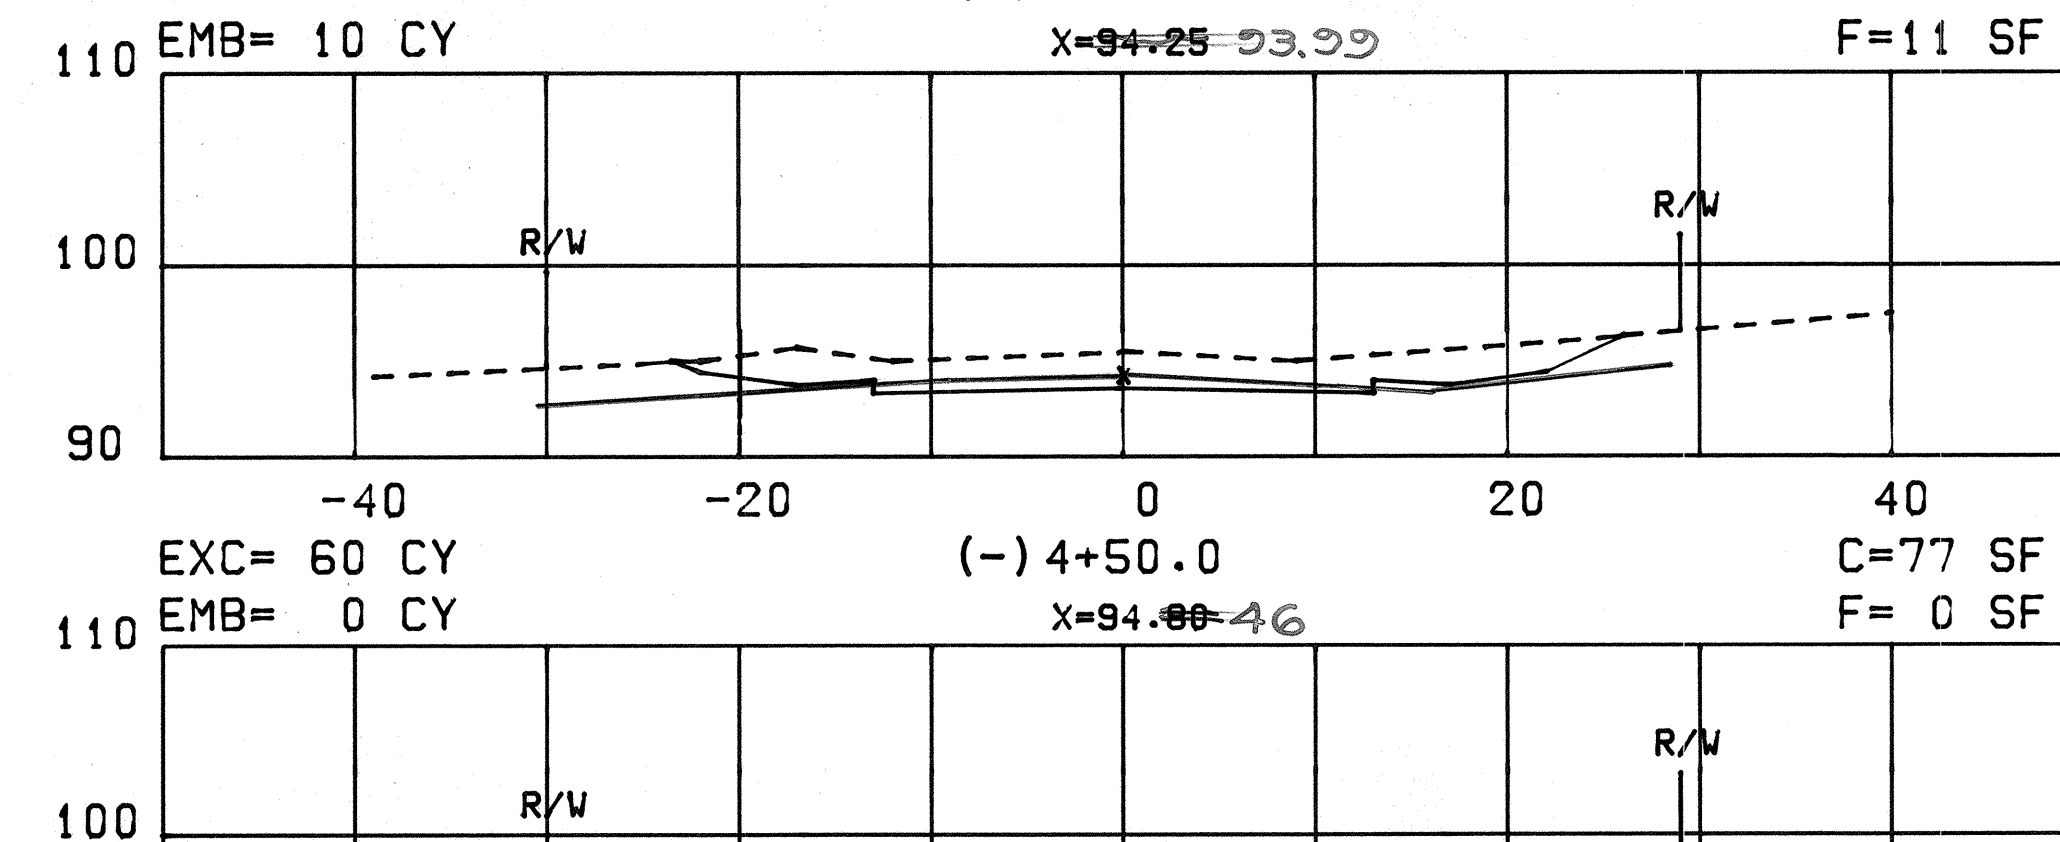
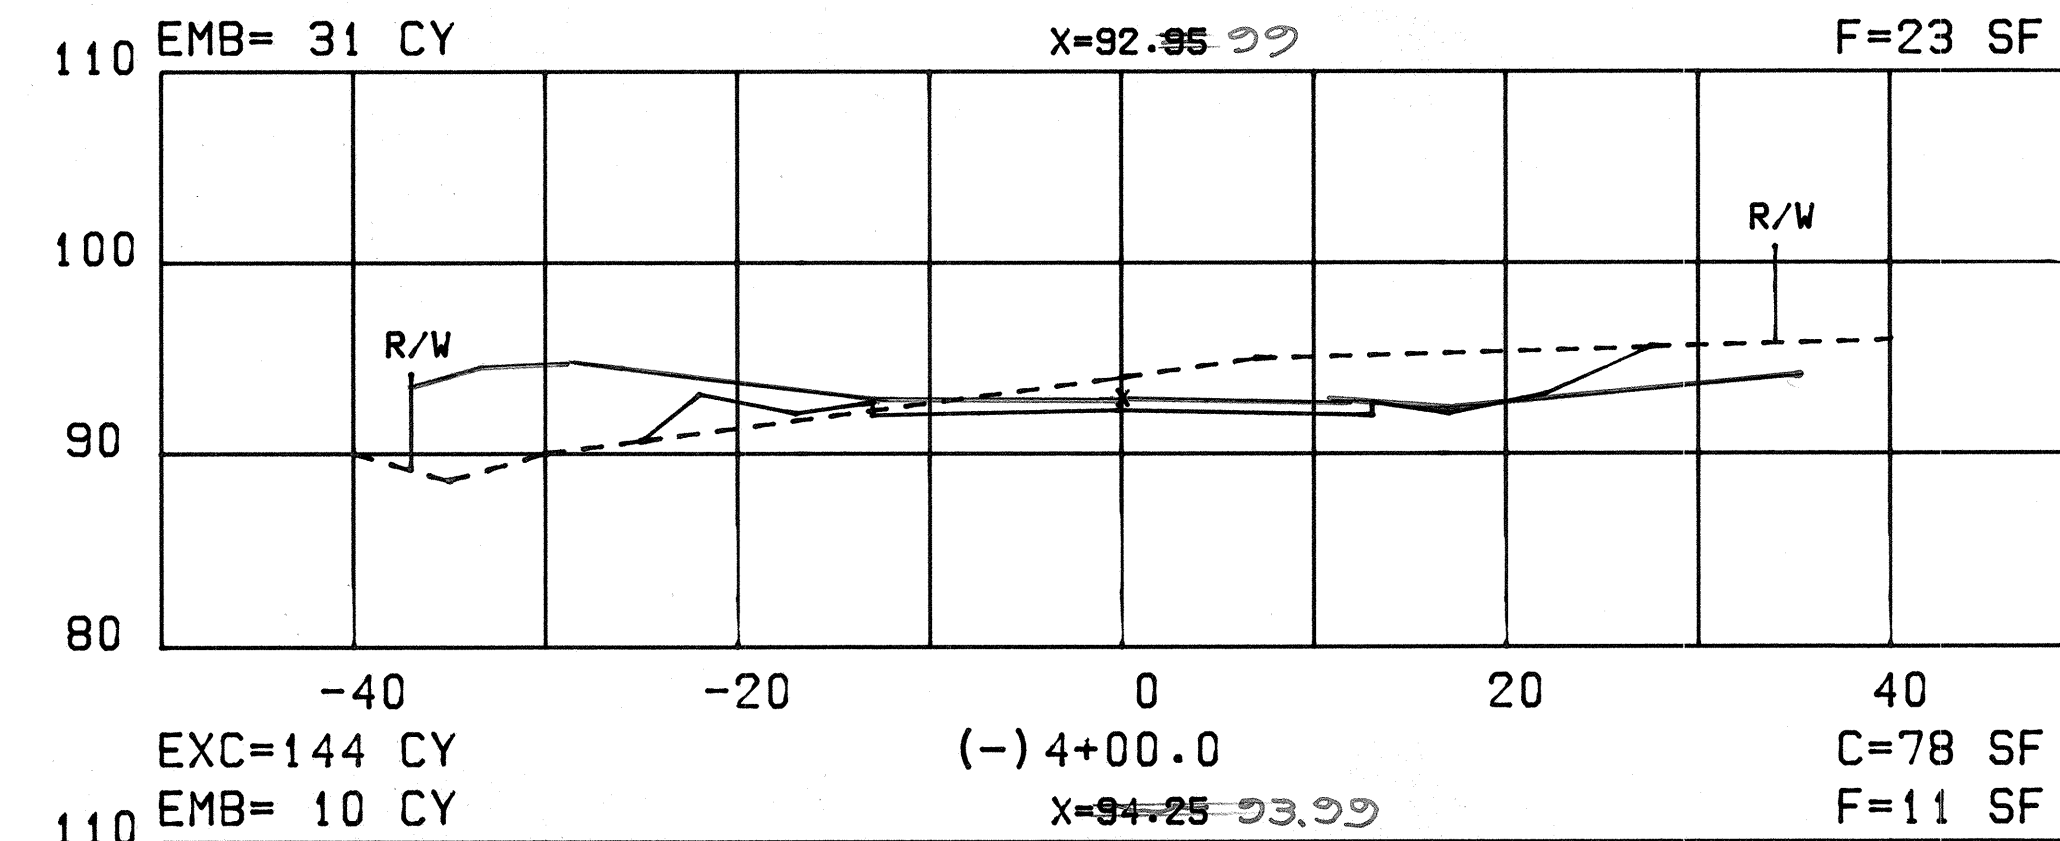
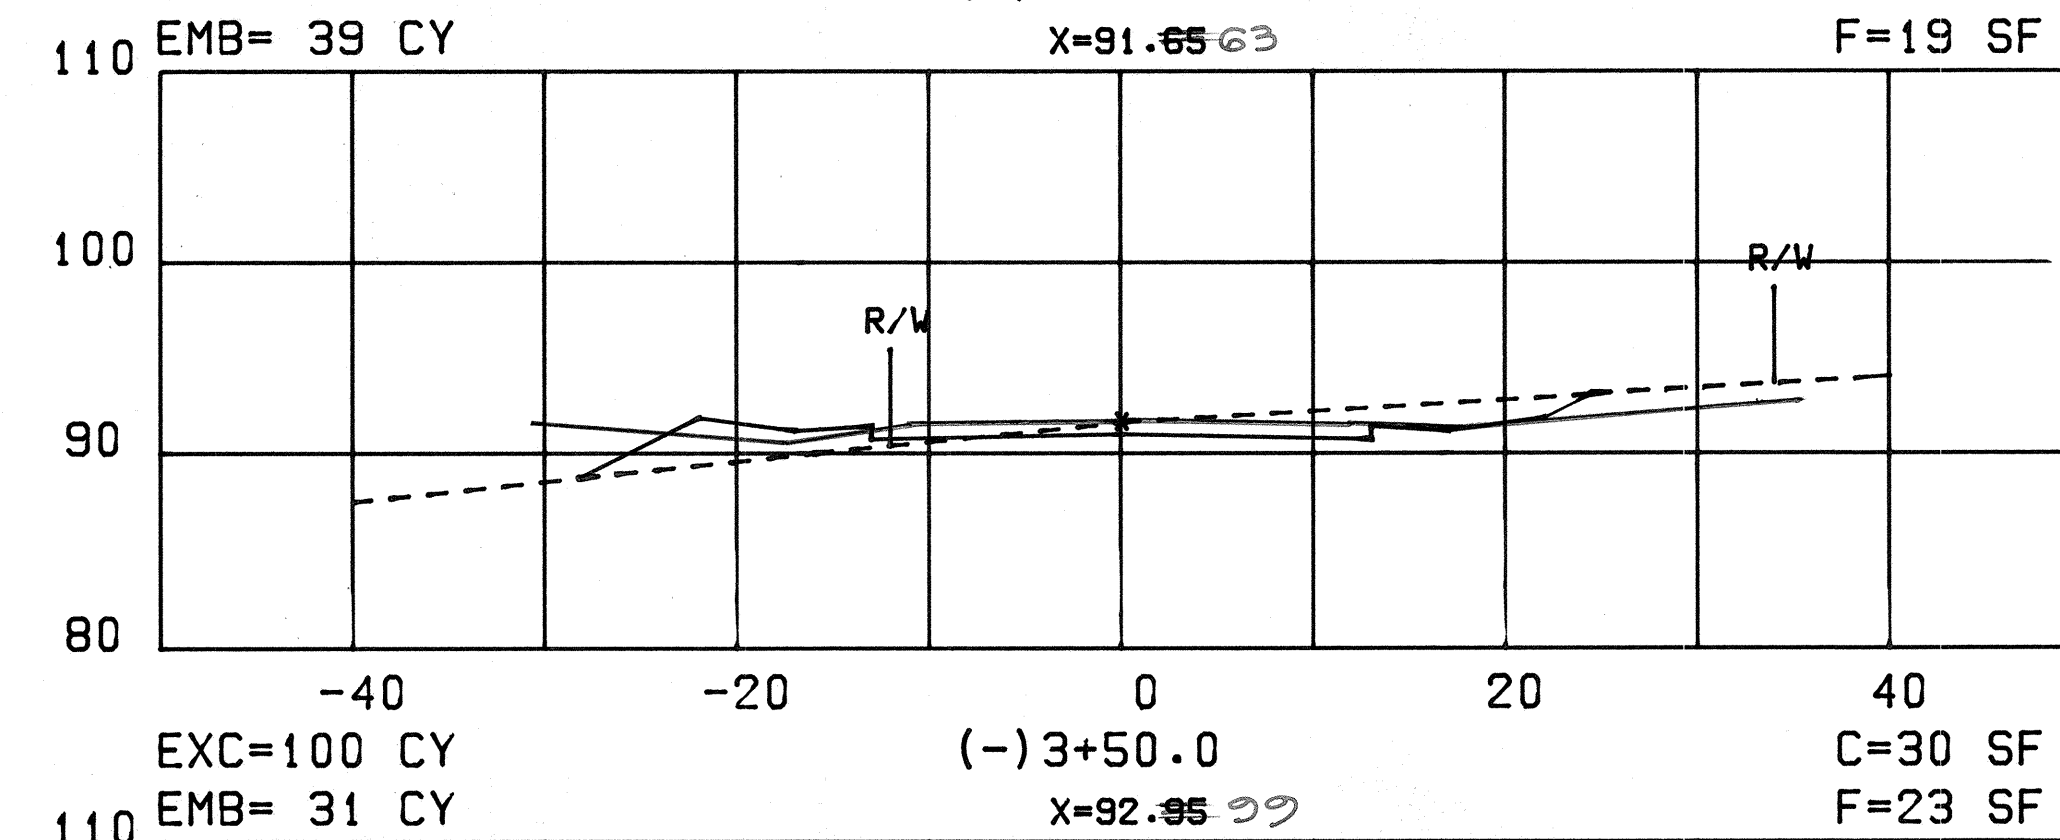


FED. ROAD DIST. NO.	STATE	FED. AID PROJ. NO.	FISCAL YEAR	SHEET NO.	TOTAL SHEETS
HAWAII	HAW.	F-RF-031- 1(6)	1978	150	158

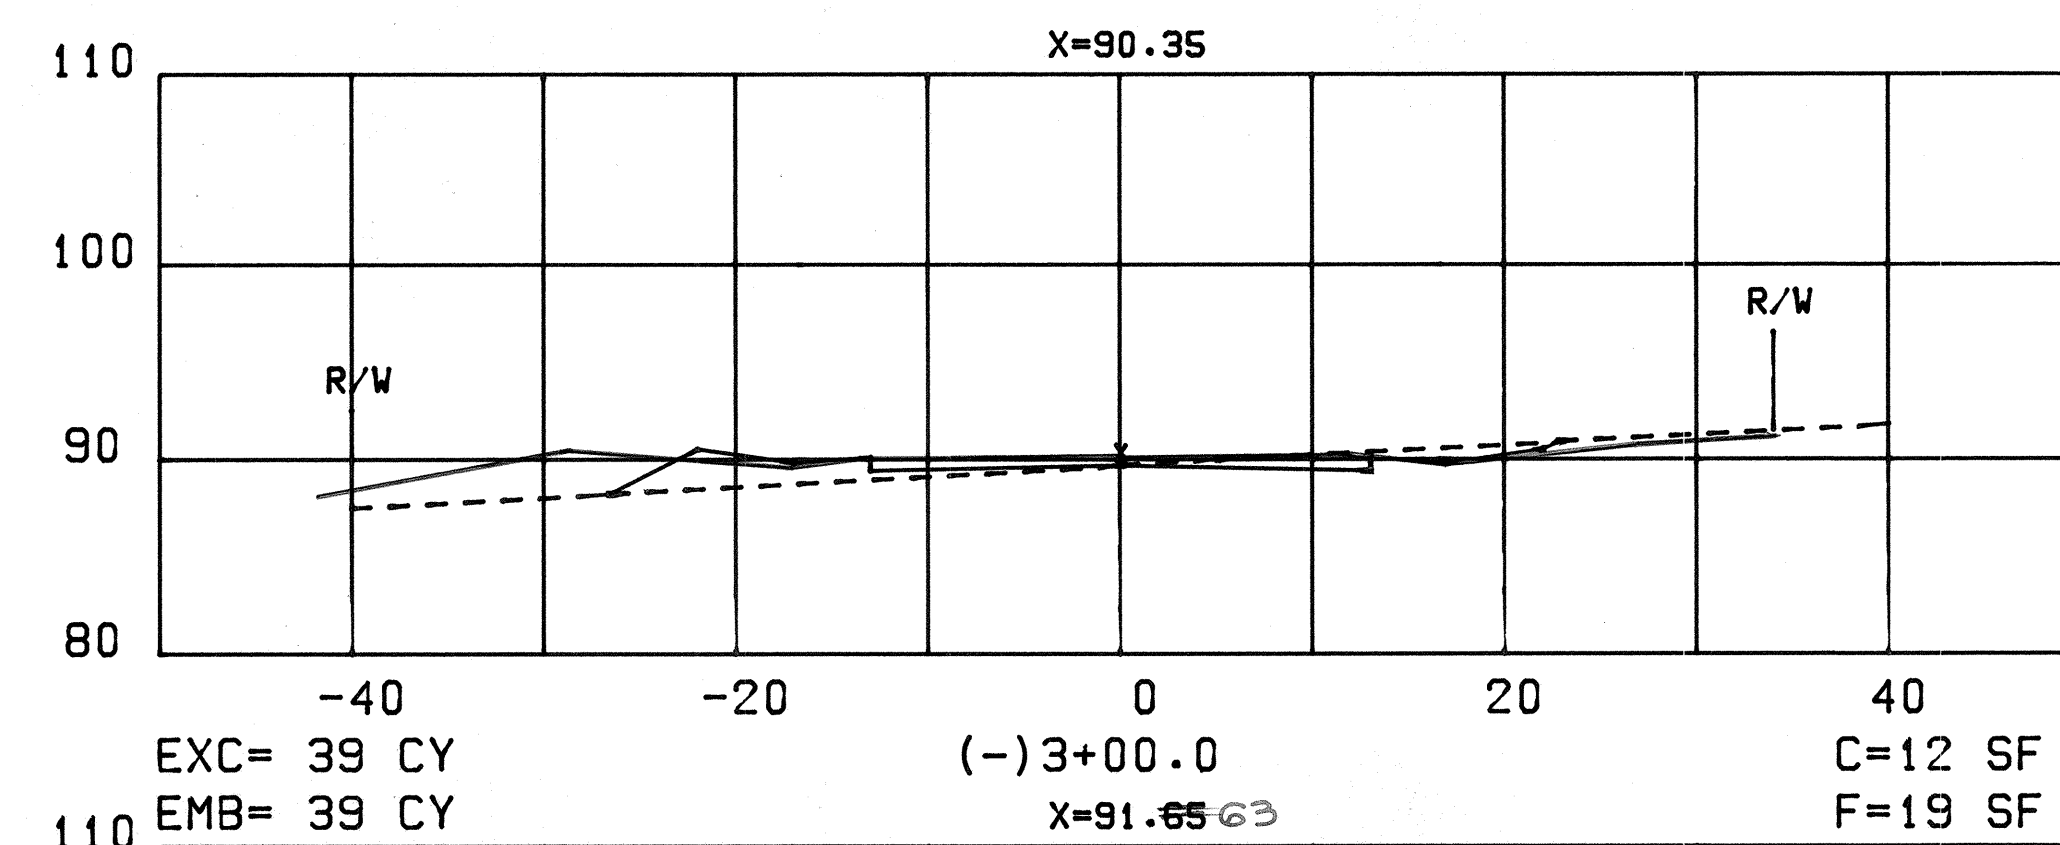




ROAD "K" - TREATMENT
PLANT ROAD

SHEET No.150 OF 158 SHEETS

150

ORIGINAL PLAN	SURVEY PLOTTED BY _____ DATE _____	
	DRAWN BY _____	" "
	TRACED BY _____	" "
NOTE BOOK	DESIGNED BY _____	" "
	QUANTITIES BY _____	" "
No. _____	CHECKED BY _____	" "
		" "

FED. ROAD DIST. NO.	STATE	FED. AID PROJ. NO.	FISCAL YEAR	SHEET NO.	TOTAL SHEETS
HAWAII	HAW.	F-RF-031-1(6)	1978	151	158

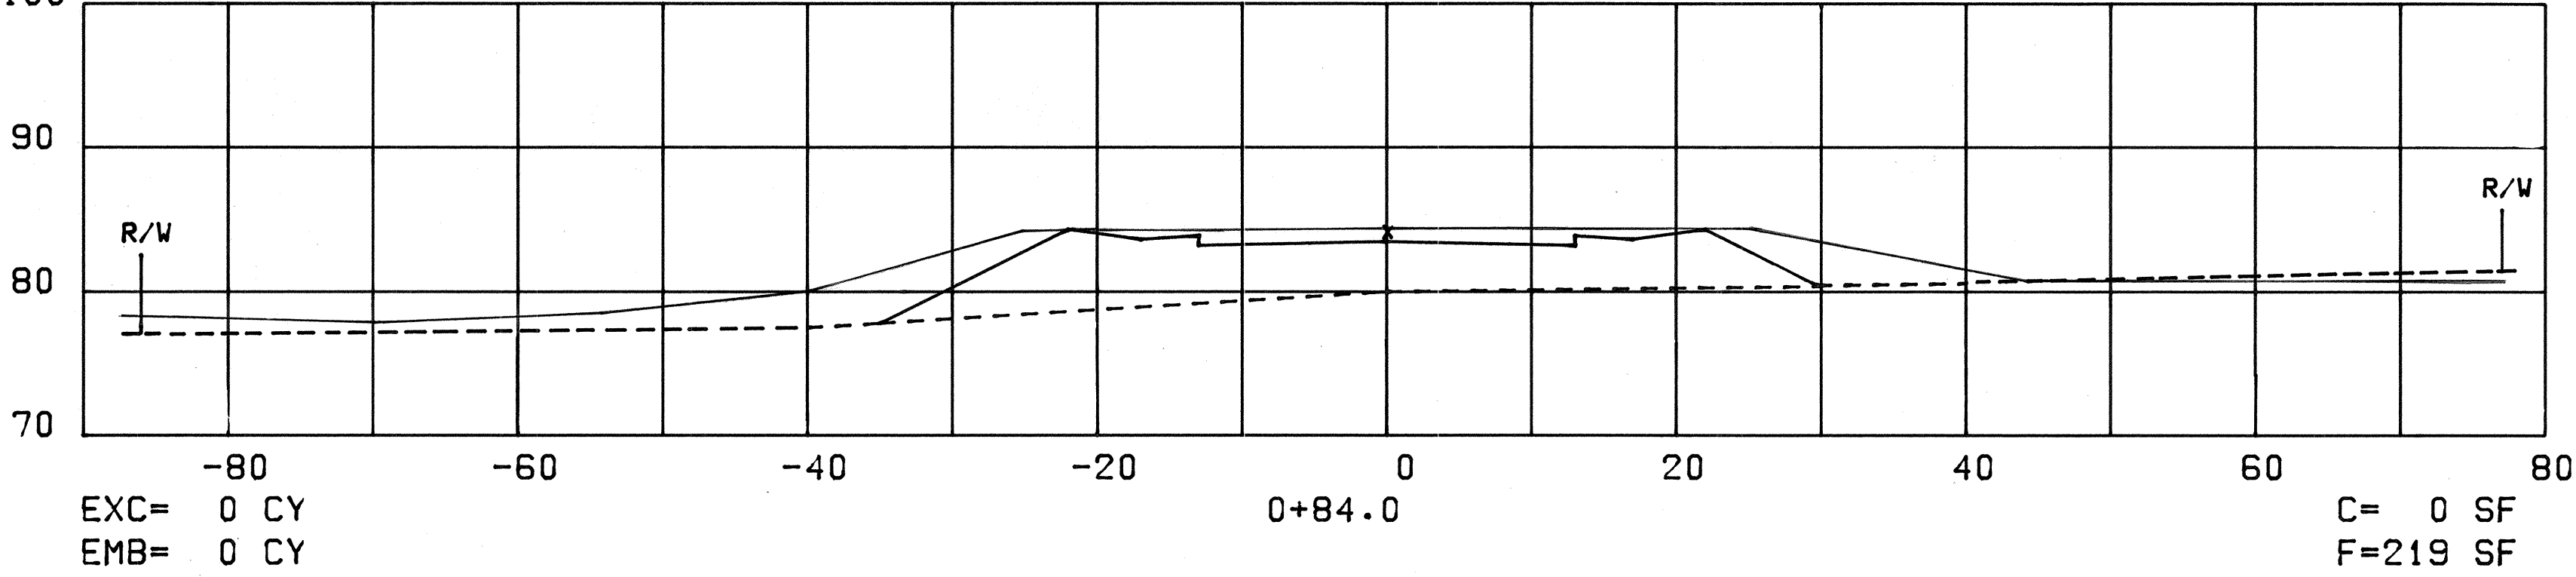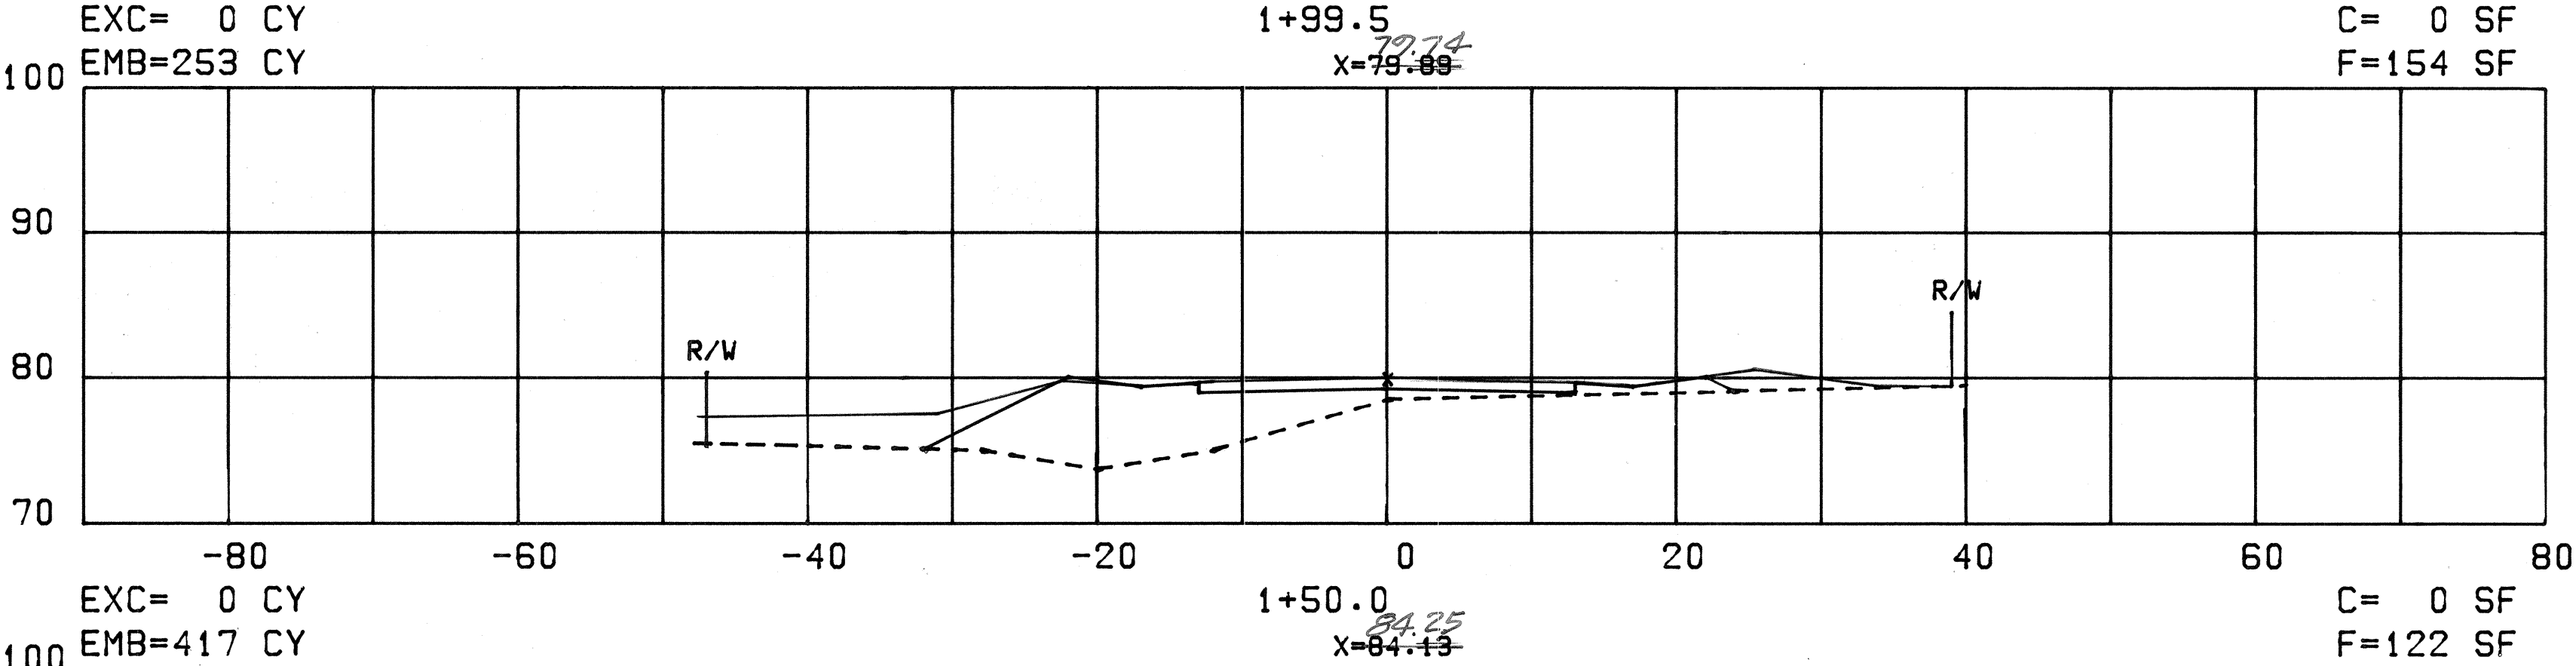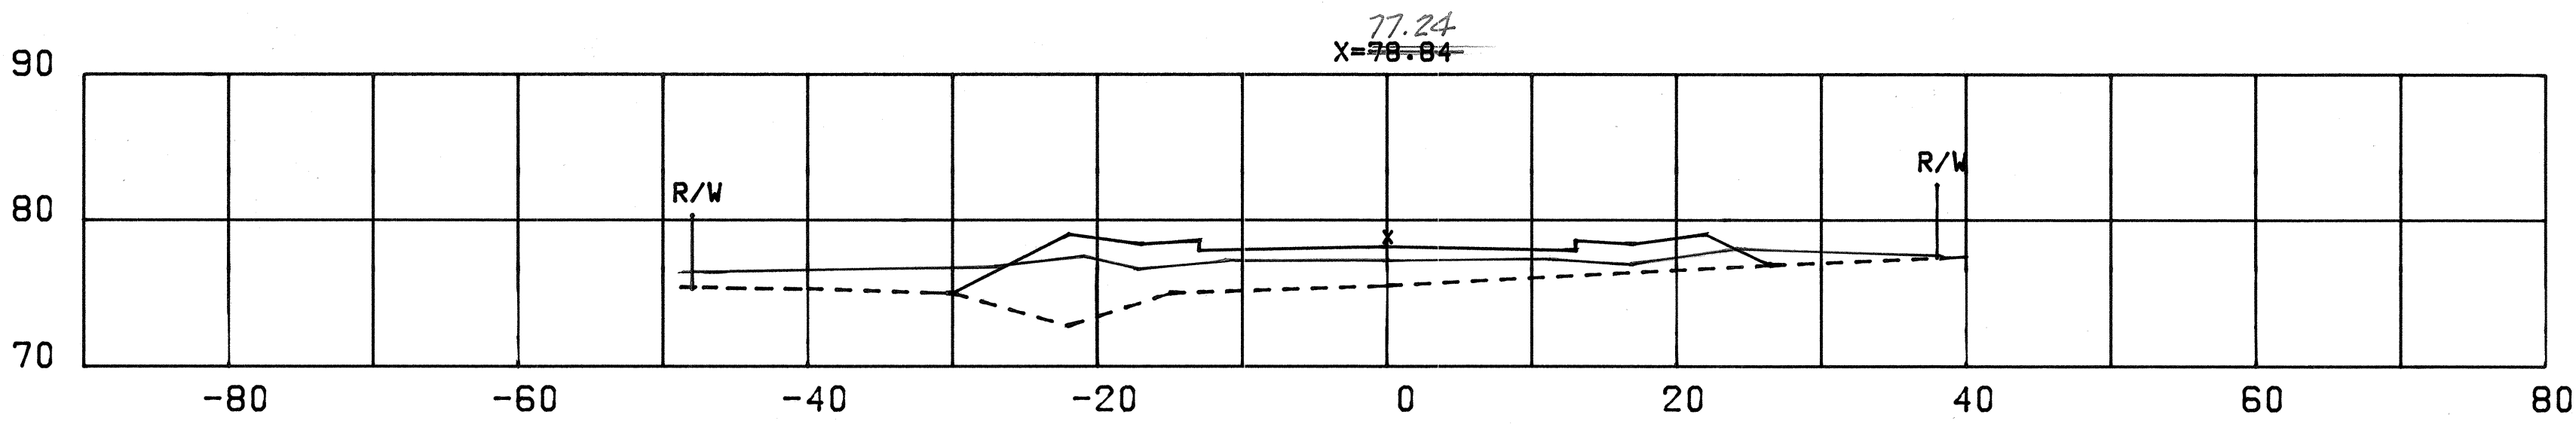

ROAD "K"- TREATMENT
PLANT ROAD

ORIGINAL PLAN	SURVEY PLOTTED BY	DATE
NOTE BOOK	DESIGNED BY	
QUANTITIES BY	CHECKED BY	
No.		