
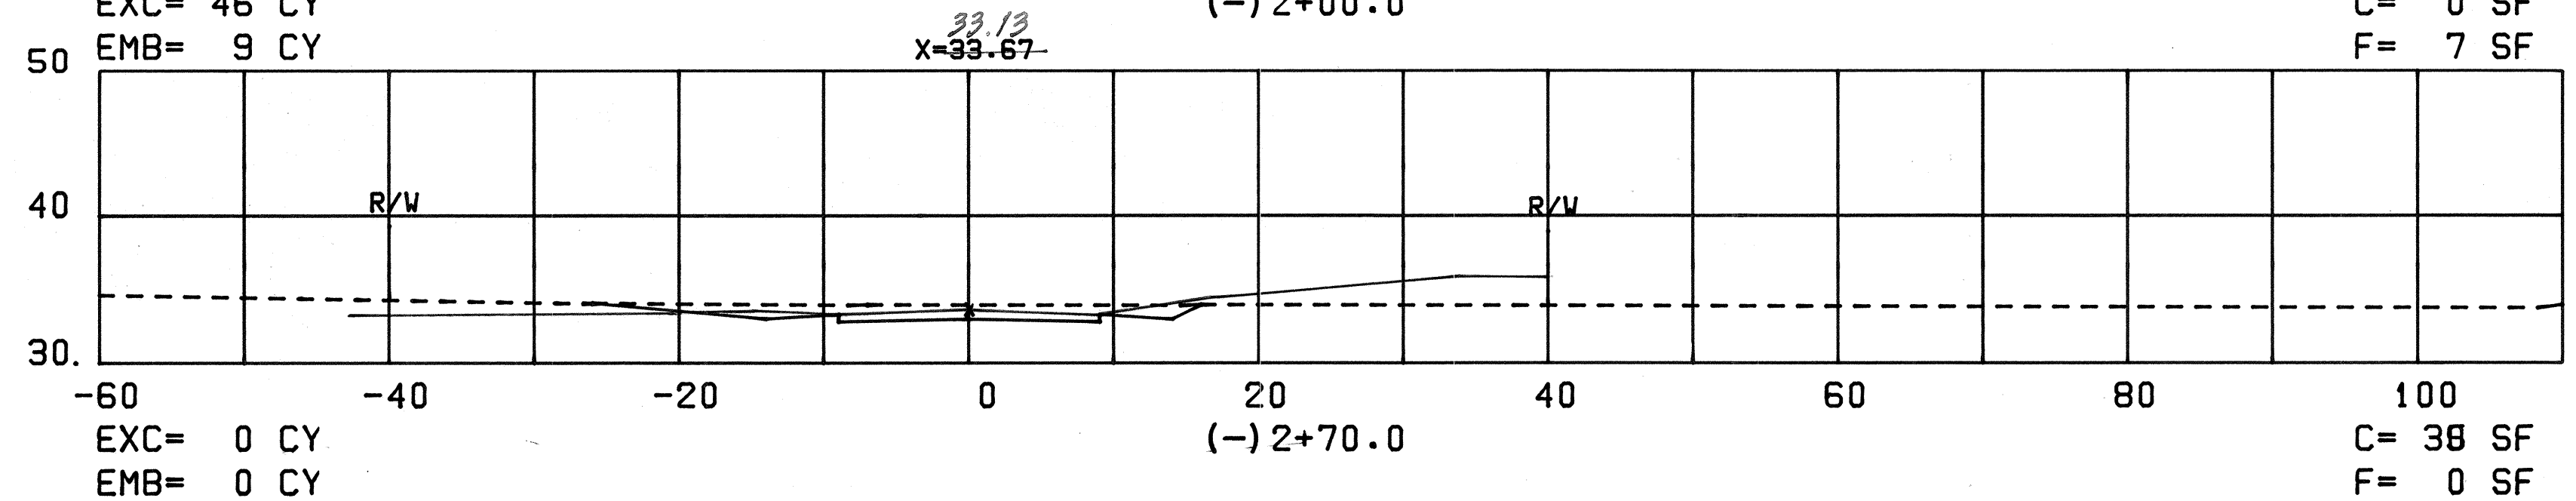
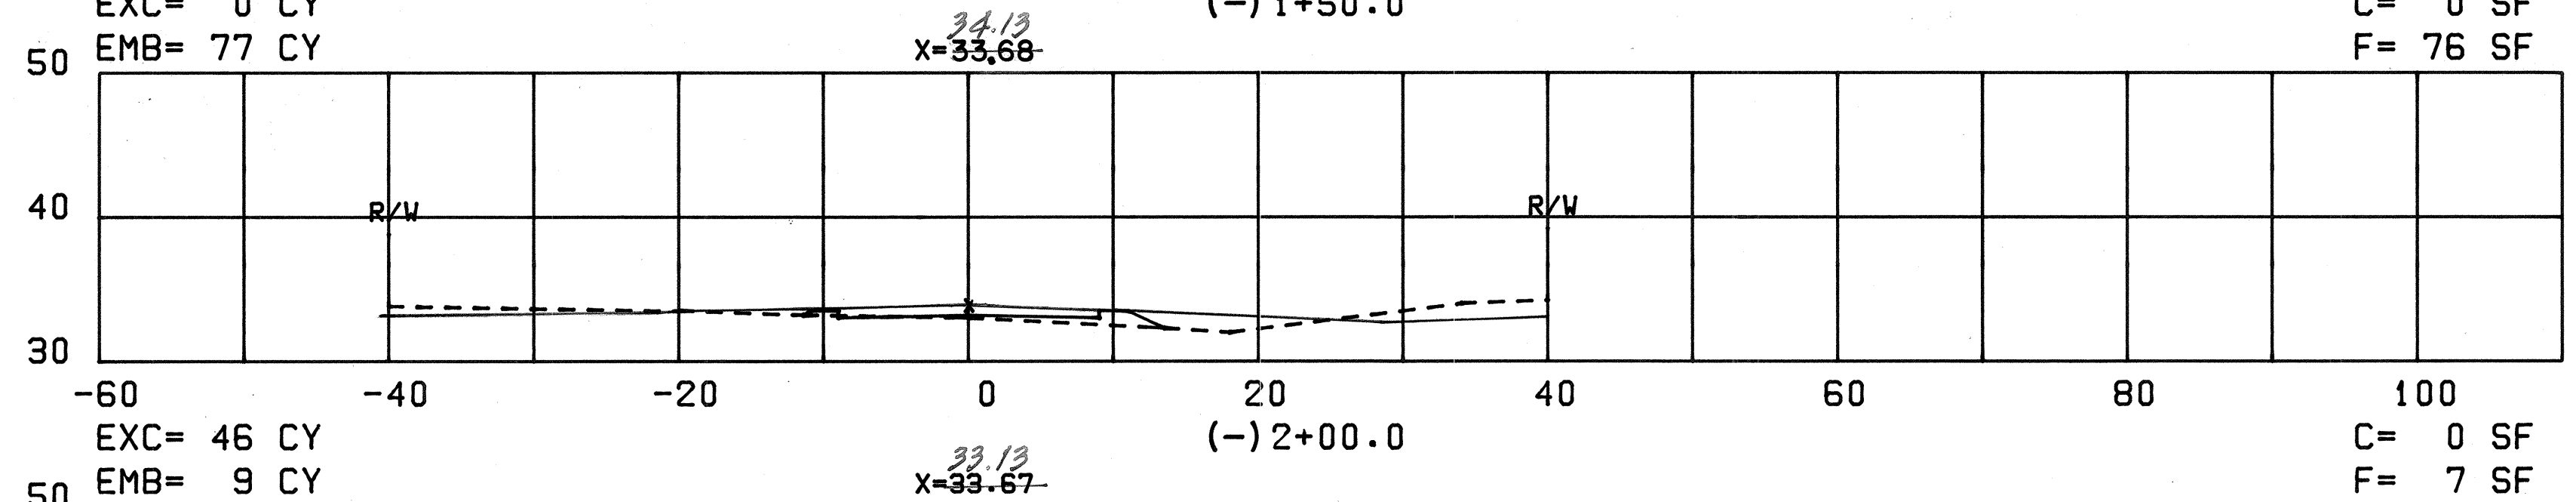
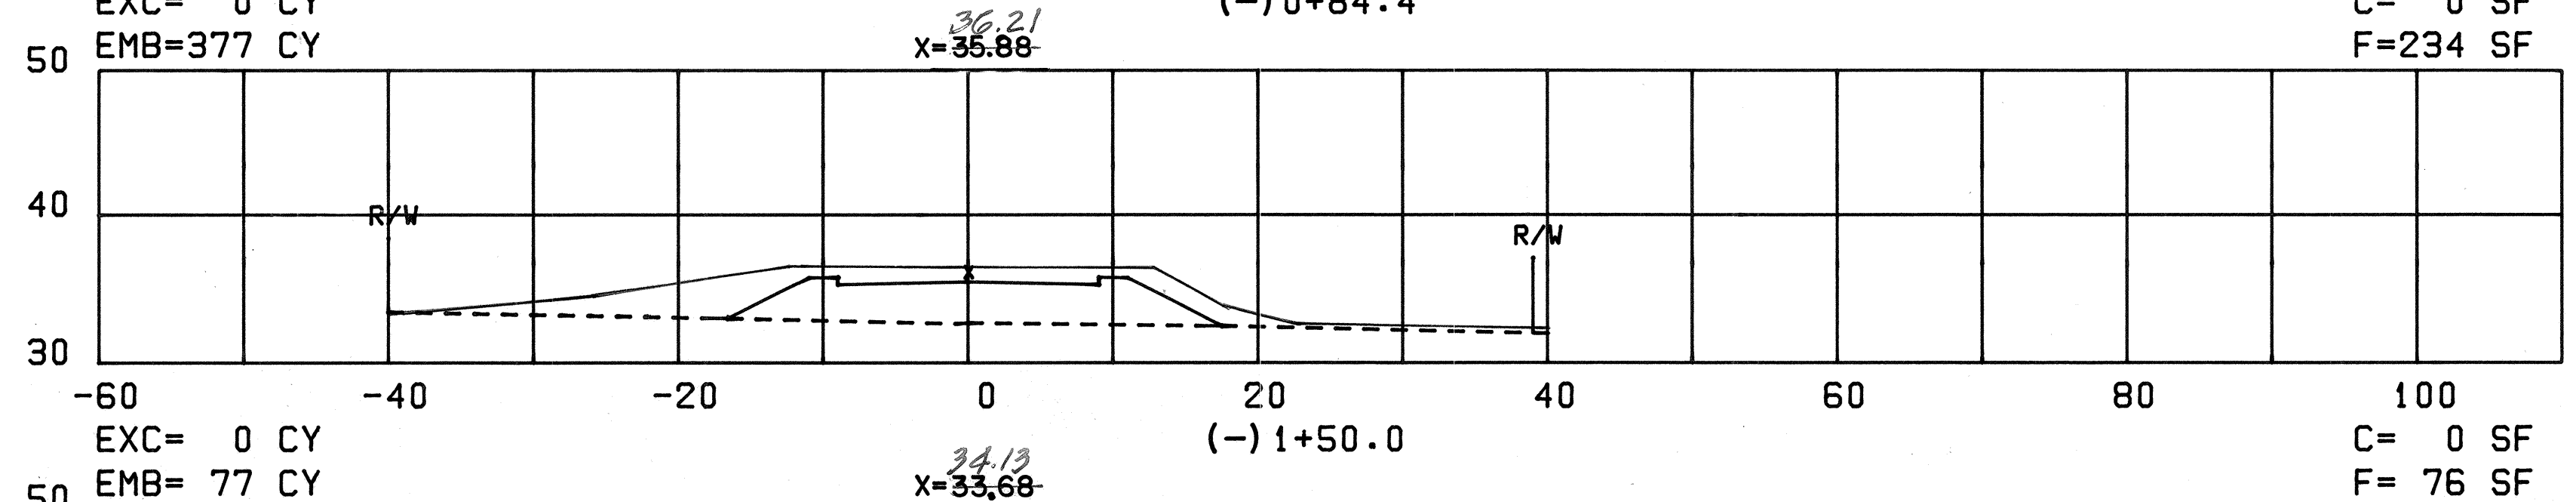
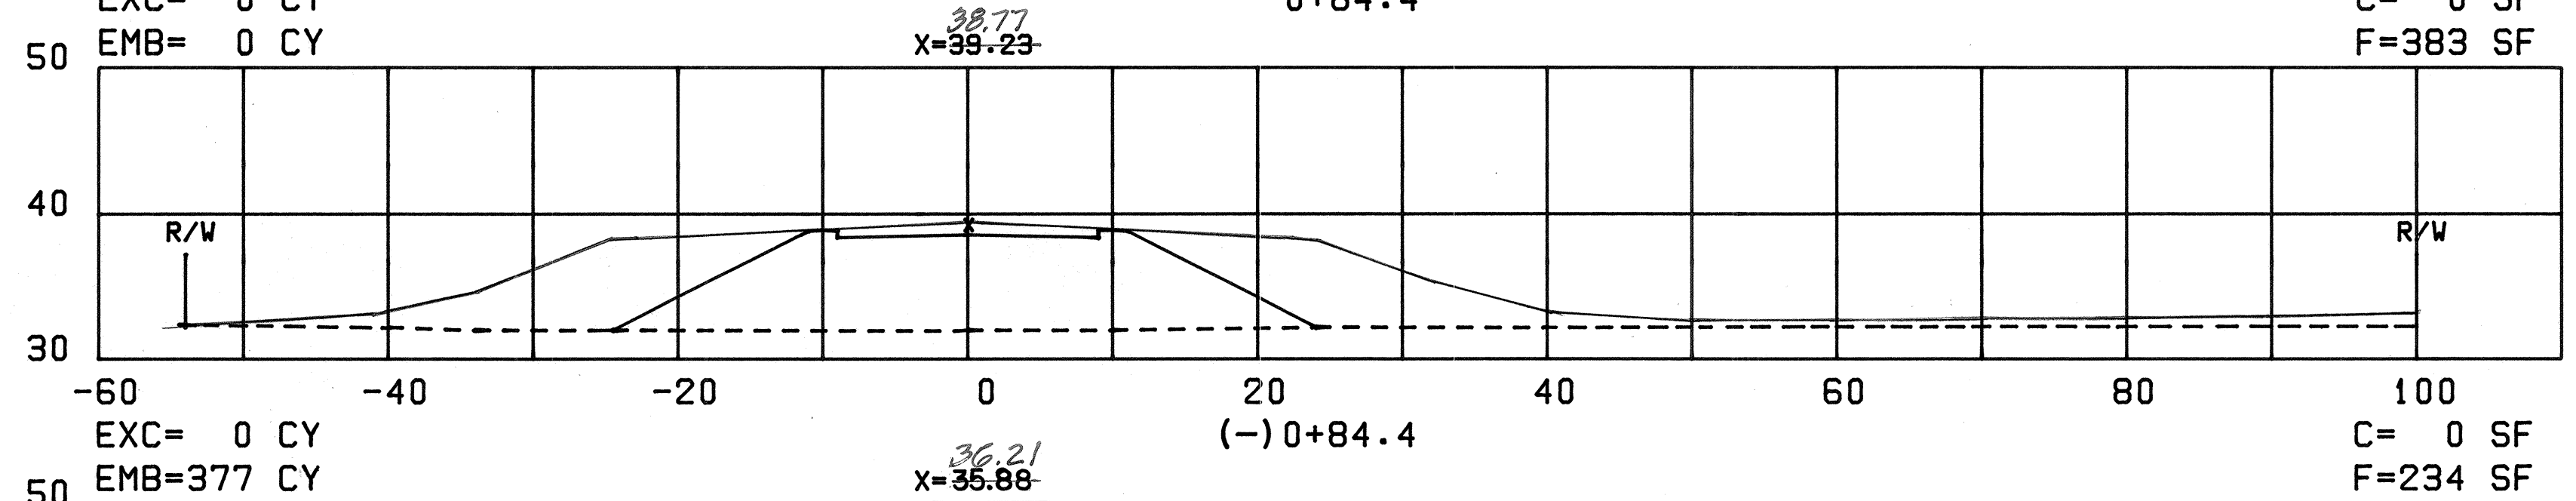
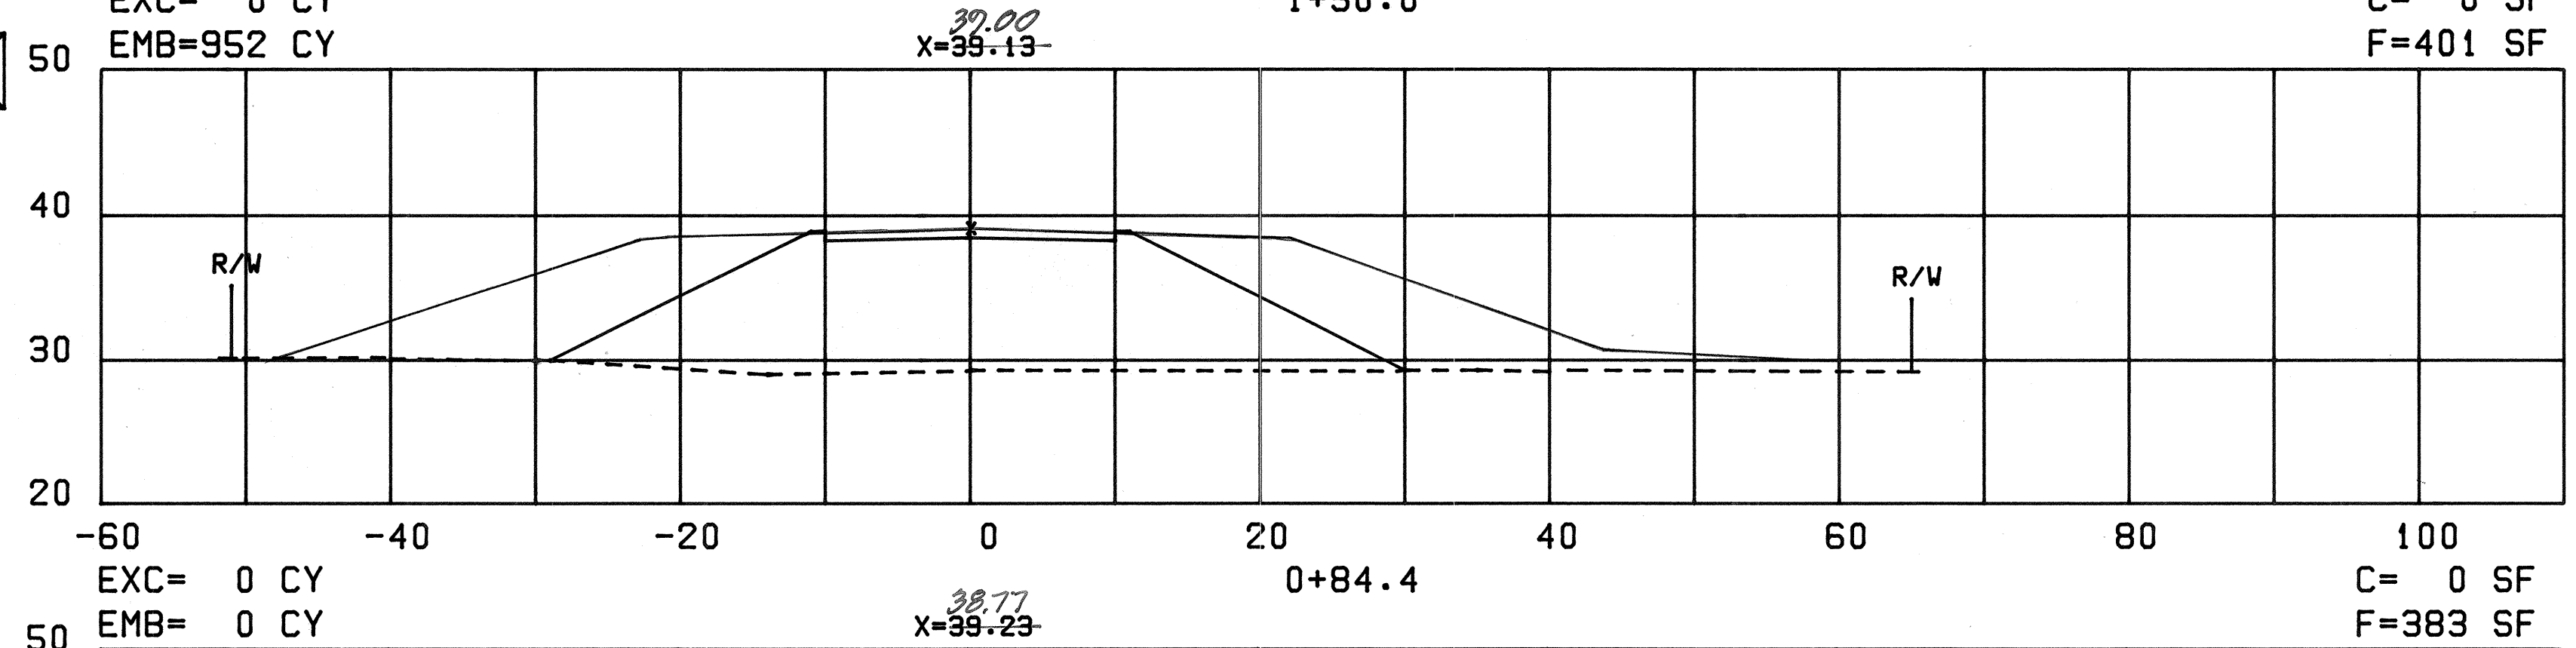




FED. ROAD DIST. NO.	STATE	FED. AID PROJ. NO.	FISCAL YEAR	SHEET NO.	TOTAL SHEETS
HAWAII	HAW.	F-RF-031-1(6)	1978	145	158

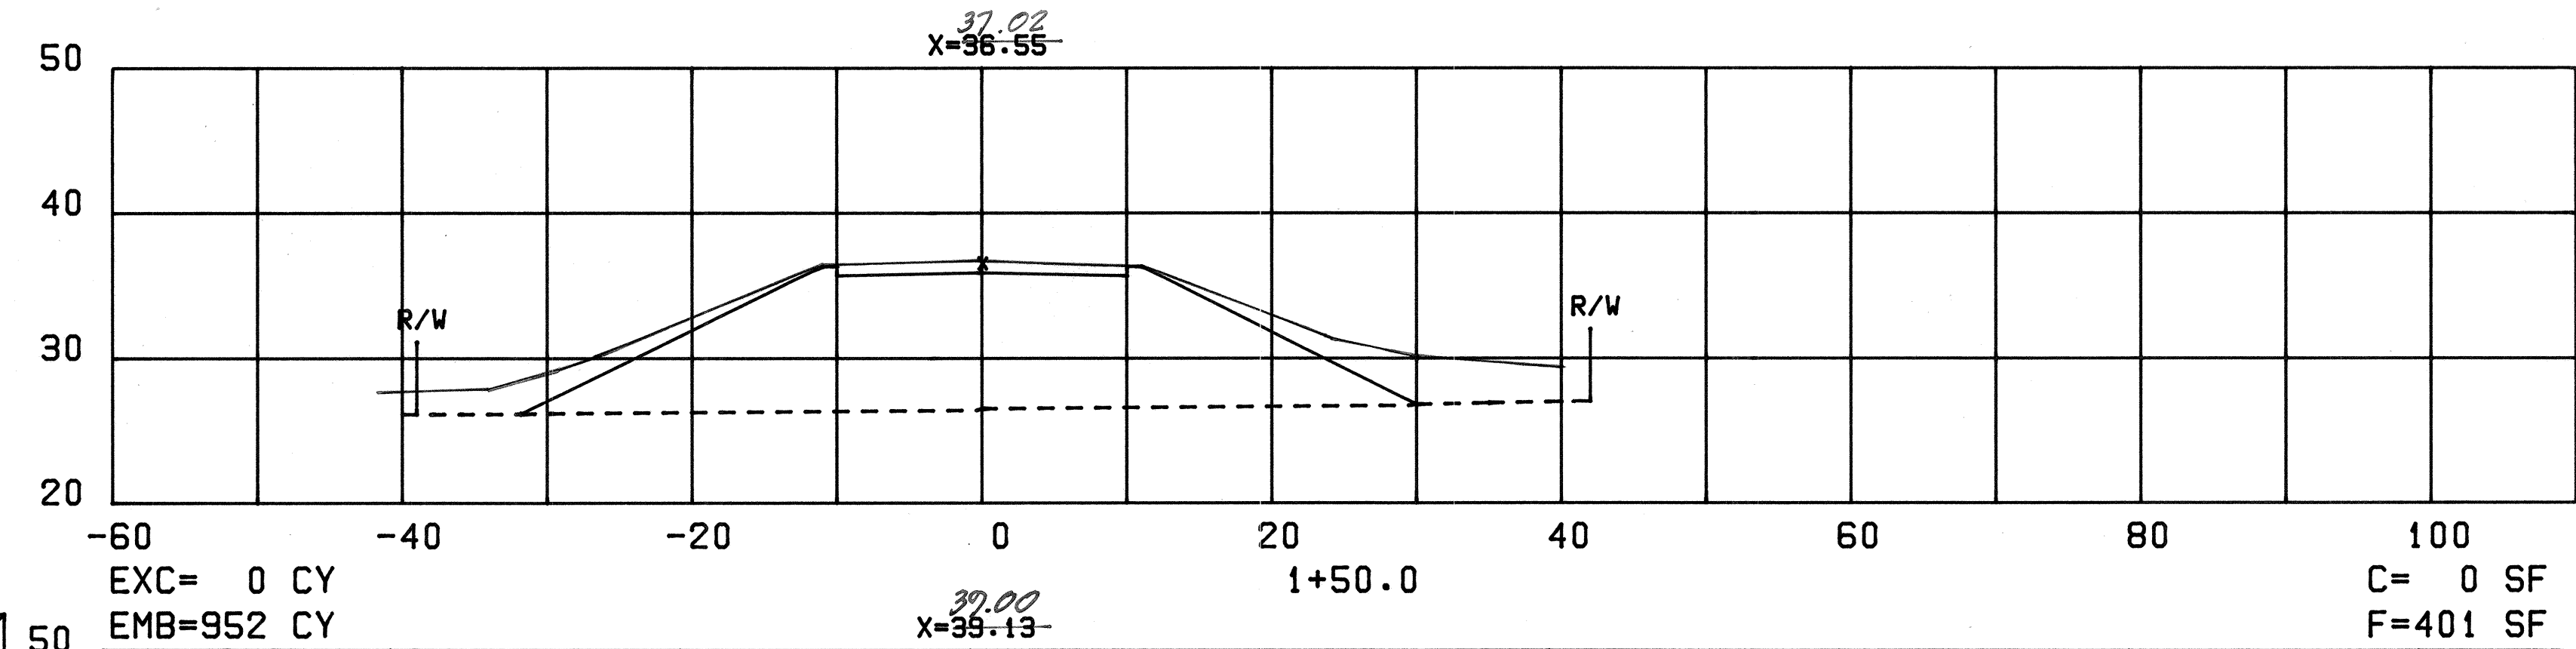

ROAD "C"- UWAPO ROAD

ORIGINAL PLAN	DATE
DESIGNED BY	
CHECKED BY	
NOTED BY	
QUANTITIES BY	
NO.	

FED. ROAD DIST. NO.	STATE	FED. AID PROJ. NO.	FISCAL YEAR	SHEET NO.	TOTAL SHEETS
HAWAII	HAW.	F-RP-031-1(6)	1978	146	158

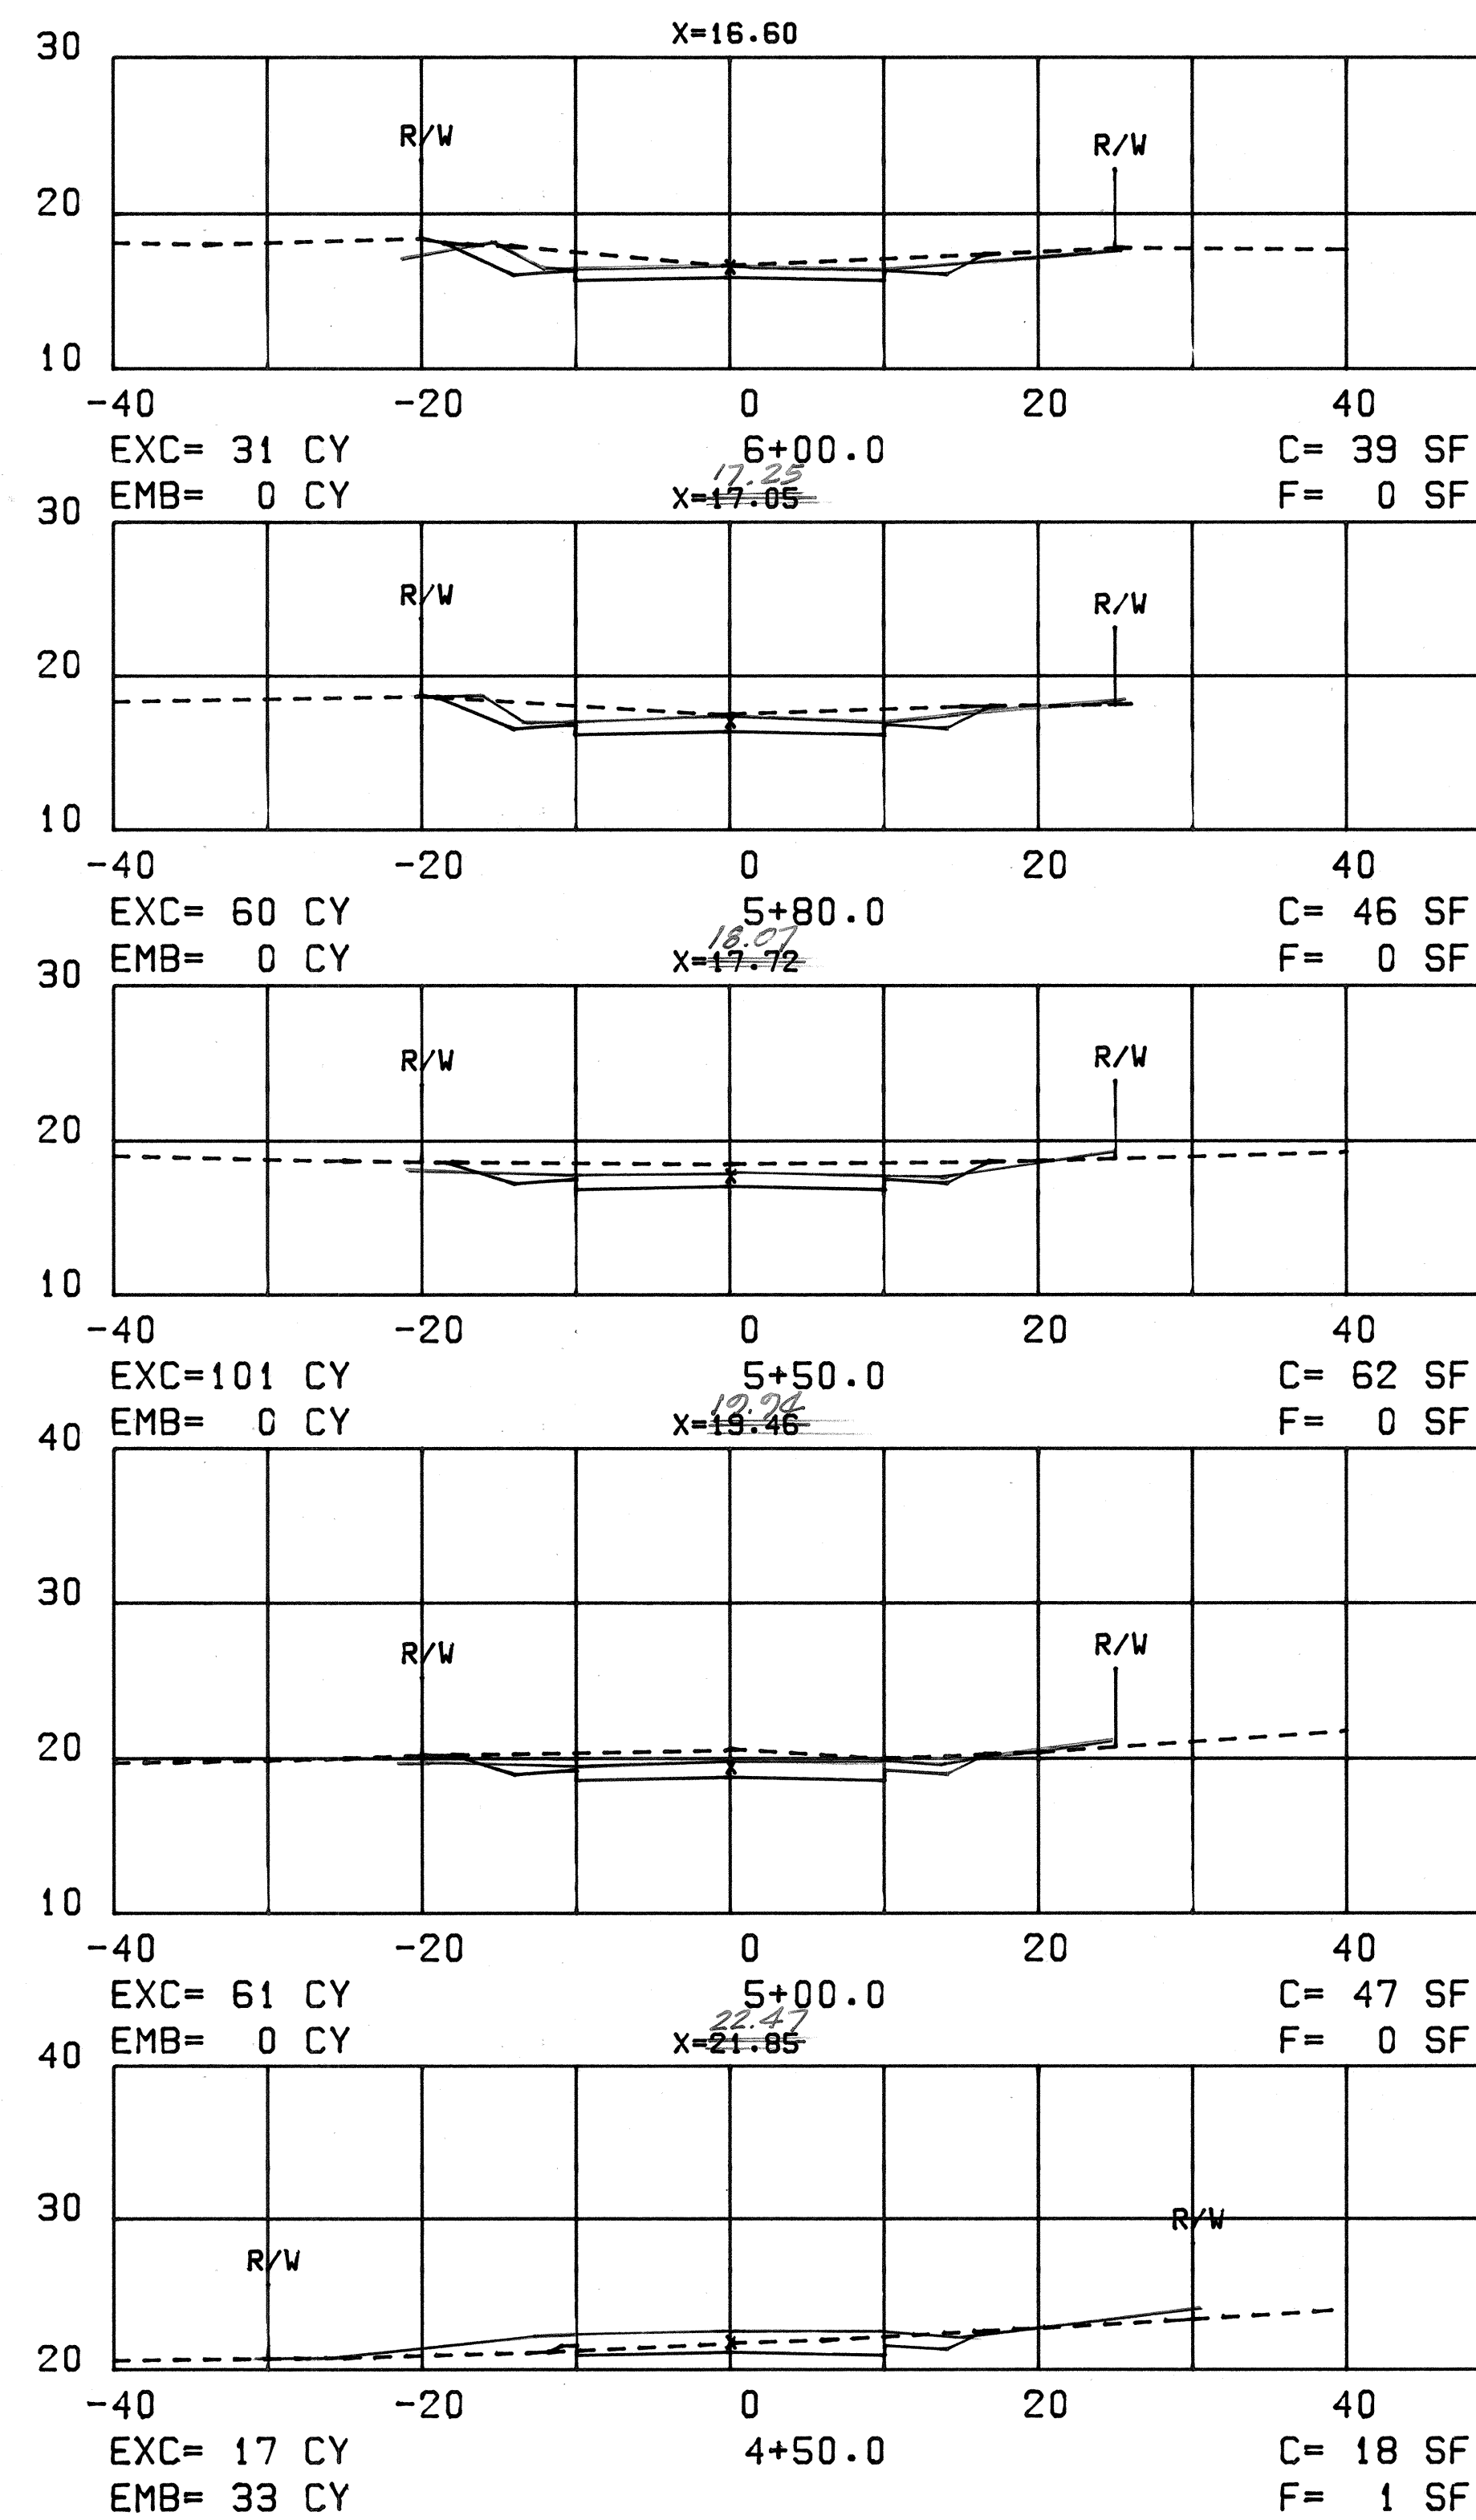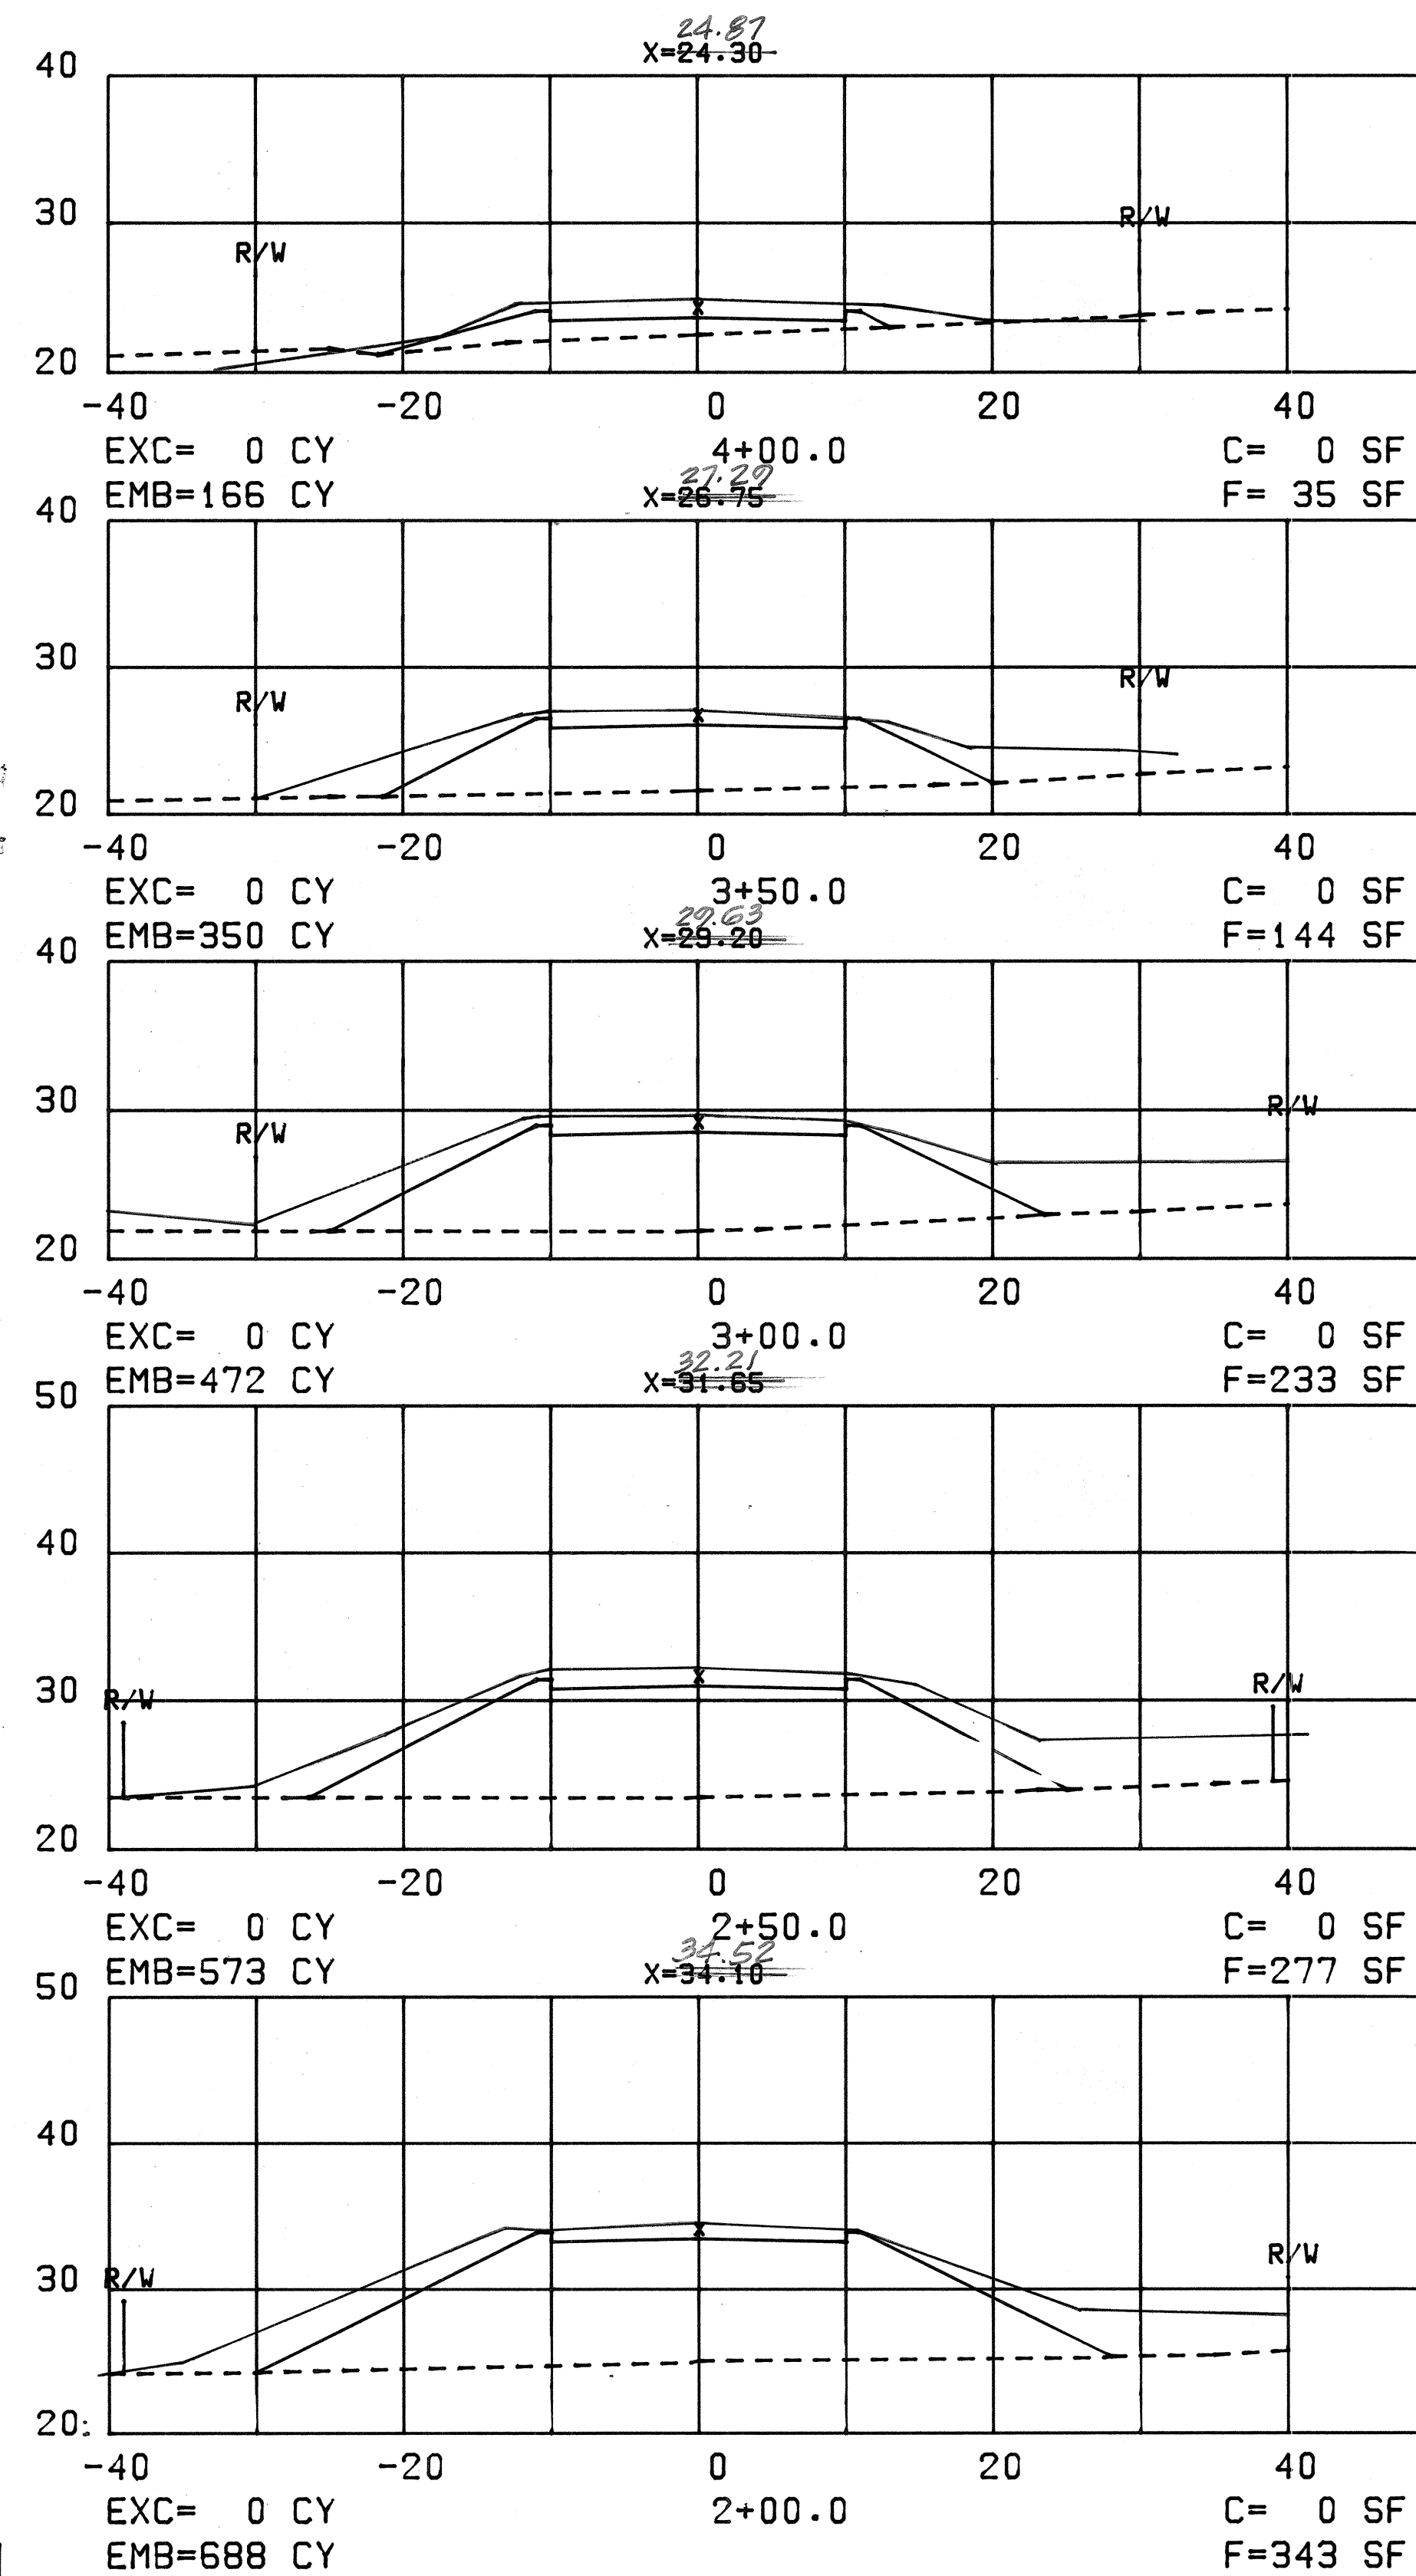

ROAD "C" - UWAPO ROAD

SHEET No.146 OF 158 SHEETS

146

ORIGINAL PLAN	SURVEY PLOTTED BY _____ DATE _____
	DRAWN BY _____ " _____
	TRACED BY _____ " _____
NOTE BOOK	DESIGNED BY _____ " _____
	QUANTITIES BY _____ " _____
No. _____	CHECKED BY _____ " _____