	INDEX TO DRAWINGS
SHEET NO.	DESCRIPTION
L	TITLE SHEET
2	SIGNING & STRIPING PLAN
3	TRAFFIC SIGNAL PLAN
4	GENERAL NOTES
5 - 12	STANDARD DETAILS
*.	
	•
/	



STATE OF HAWAII



DEPARTMENT OF TRANSPORTATION HIGHWAYS DIVISION

"AS BUILT"
PLANS FOR


PIILANI HIGHWAY TRAFFIC SIGNALS

AT

MOKULELE HIGHWAY


PROJECT NO. 31B - 01 - 82

DISTRICT OF WAILUKU ISLAND OF MAUI

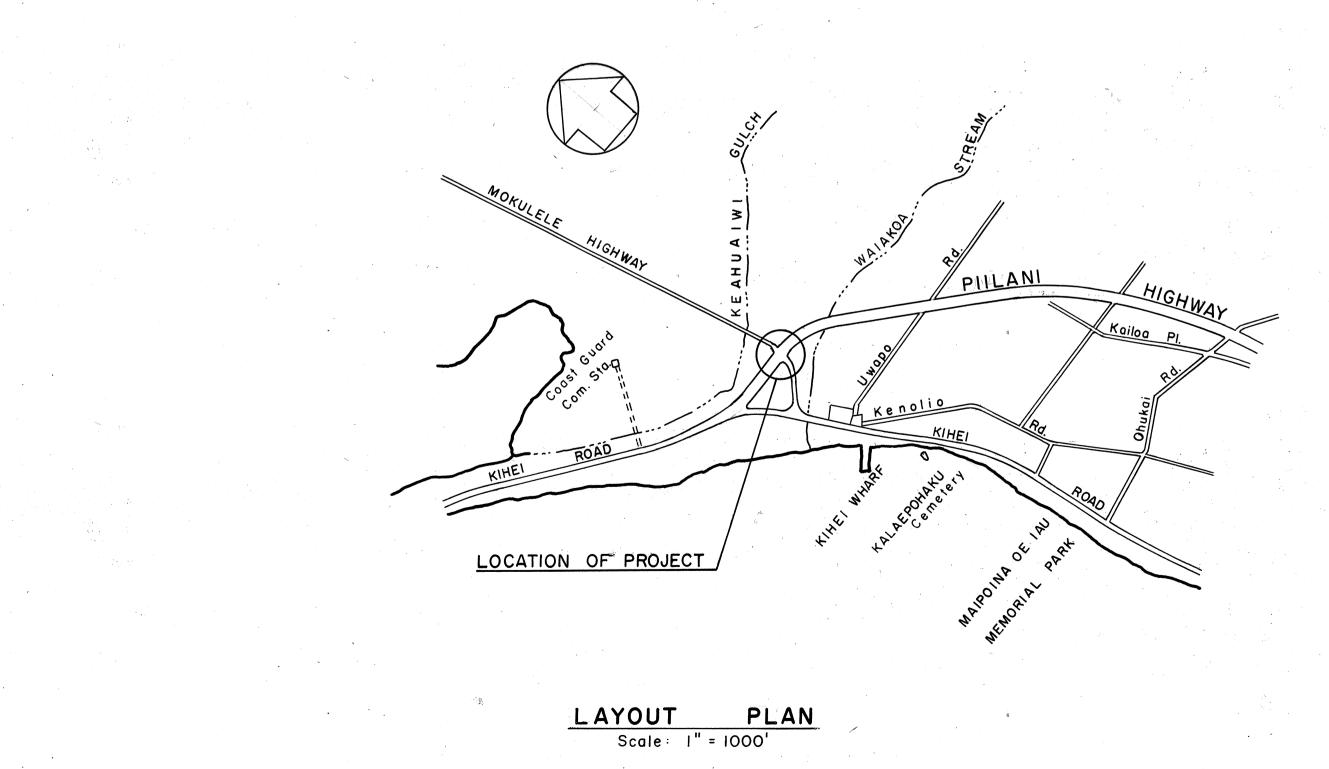

FED. ROAD DIST. NO. STATE PROJ. NO. FISCAL SHEET TOTAL YEAR NO. SHEETS

HAWAII HAW. 31B - OI - 82 1981 1 12

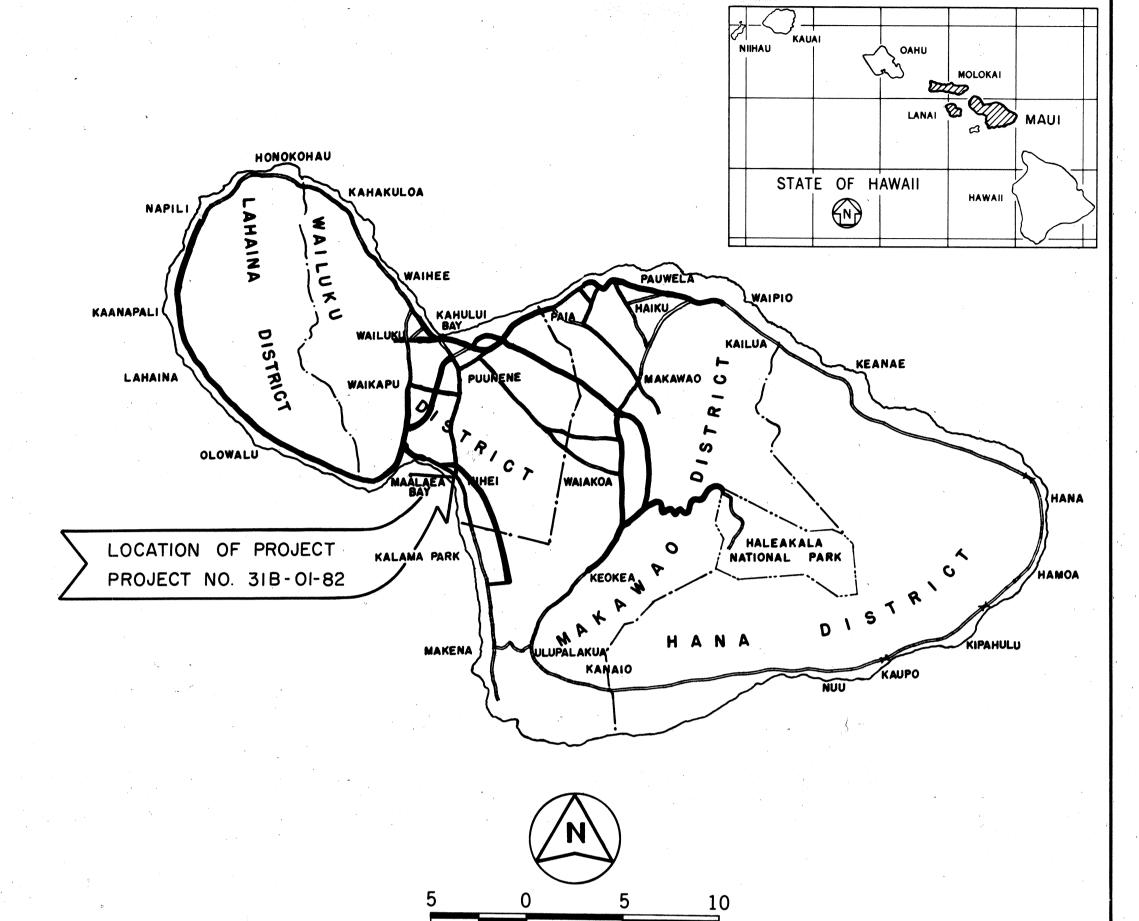

FEDERAL AID PROJECTS PREVIOUSLY CONSTRUCTED OR UNDER CONSTRUCTION

ALL CHANGES MADE DURING CONSTRUCTION HAVE BEEN INCORPORATED ON THESE PLANS IN RED EXCEPT CHANGES IN THE ORIGINAL THEORETICAL QUANTITIES. FOR ACTUAL QUANTITIES, REFER TO PROJECT LEDGER AND/OR COMPUTATION BOOK.

RESIDENT ENGINEER 10/29/82
DATE

DEPARTMENT OF TRANSPORTATION
STATE OF HAWAII

APPROVED:

DIR. OF TRANSPORTATION