

INDEX TO DRAWINGS	
SHEET NO	DESCRIPTION
1	TITLE SHEET
2	STANDARD PLANS SUMMARY
3-4	TYPICAL SECTIONS
5-8	PLAN & PROFILE
9	BORING LOGS
① 10-15	DETAIL PLAN OF ROADWAY
16-18	DRAINAGE SUMMARY
19-21	DRAINAGE PLANS
22-37	DRAINAGE DETAILS
38-39	WATER UTILITY PLAN
40-46	SIGNING & PAVEMENT MARKINGS
47-49	EROSION CONTROL PLAN
50-69	CROSS SECTIONS

Plan Sht. No. ① C.O. 14S-1 is a supplementary sheet to this project.
TOTAL SHEET COUNT after "AS-BUILT" postings.
70 Sheets.

STATE OF HAWAII
DEPARTMENT OF TRANSPORTATION
HIGHWAYS DIVISION
HONOLULU, HAWAII

"AS-BUILT"
PLANS OF
PIILANI HIGHWAY

VICINITY OF KILOHANA STREET TO
WAILEA IKE DRIVE


F. A. PROJECT NO. F-031-1(3)

DISTRICT OF MAKAWAO

ISLAND OF MAUI


SCALES

PLANS 1"=100'
PROFILES HOR. 1"=100'
VERT. 1"=10'
DETAIL ROADWAY PLANS 1"=50'

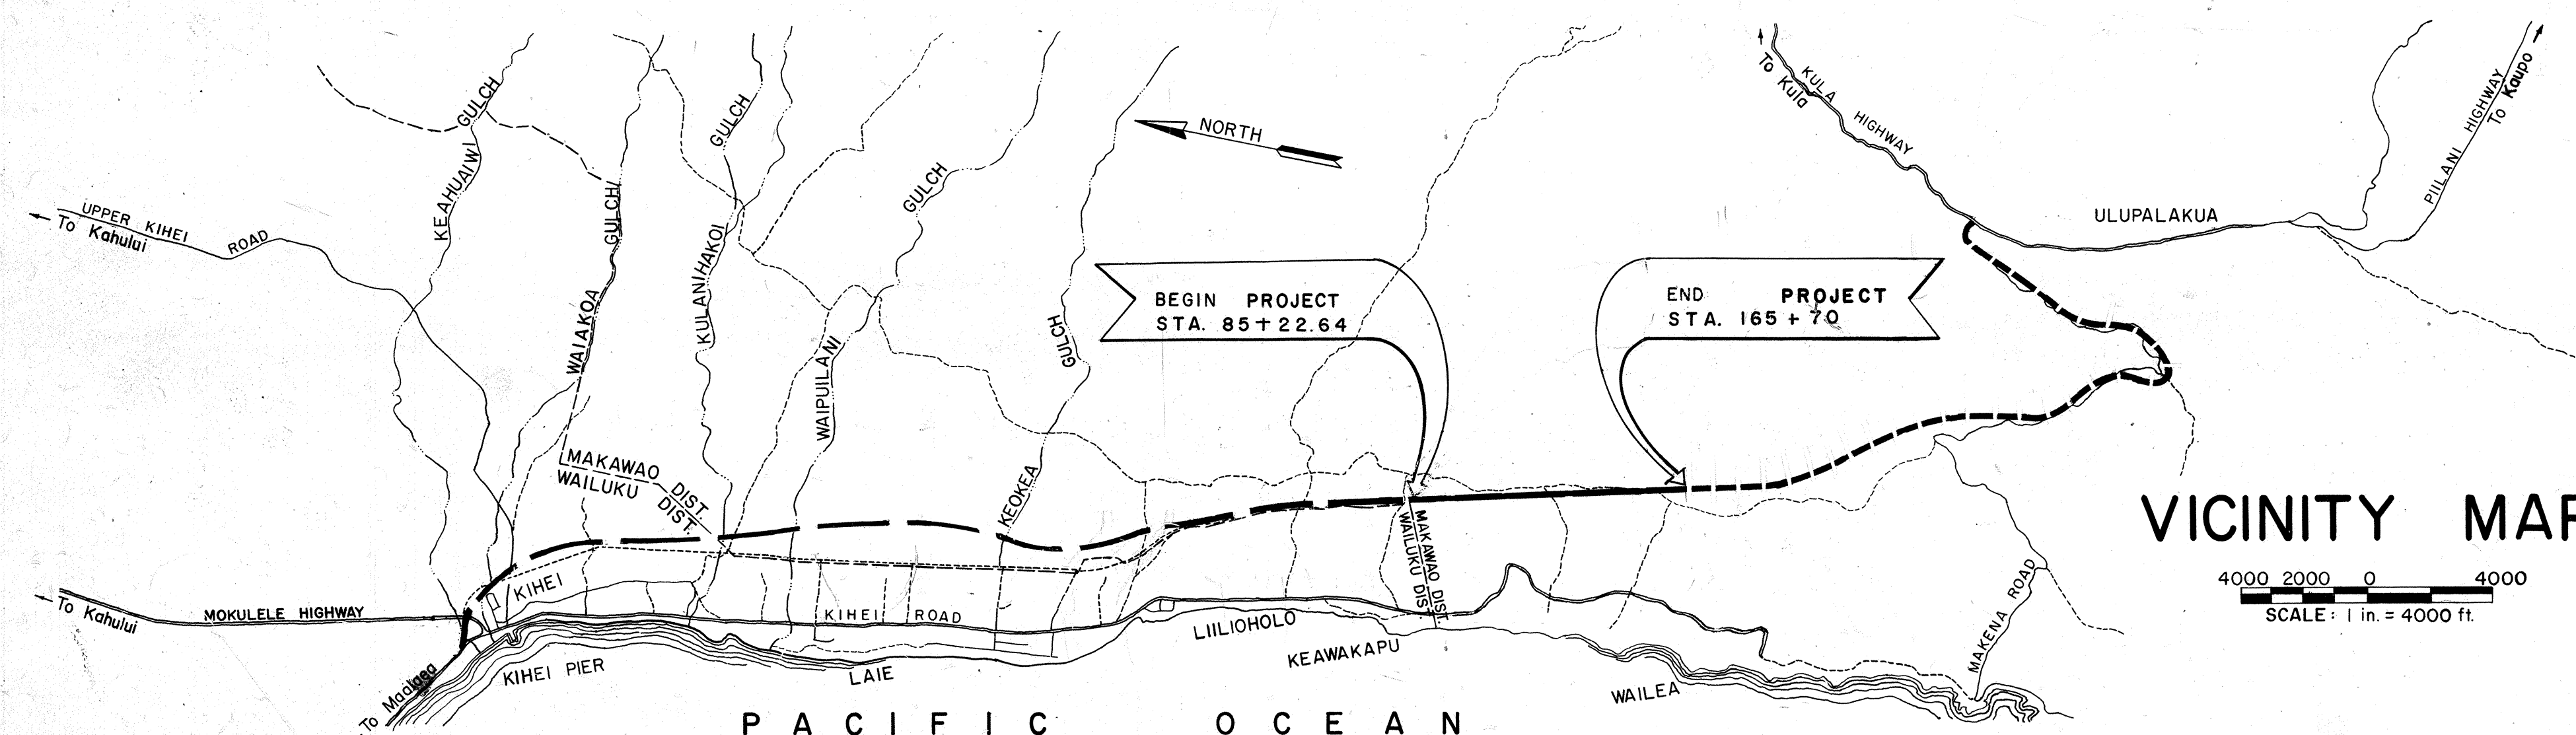

VICINITY MAP

4000 2000 0 4000
SCALE: 1 in. = 4000 ft.

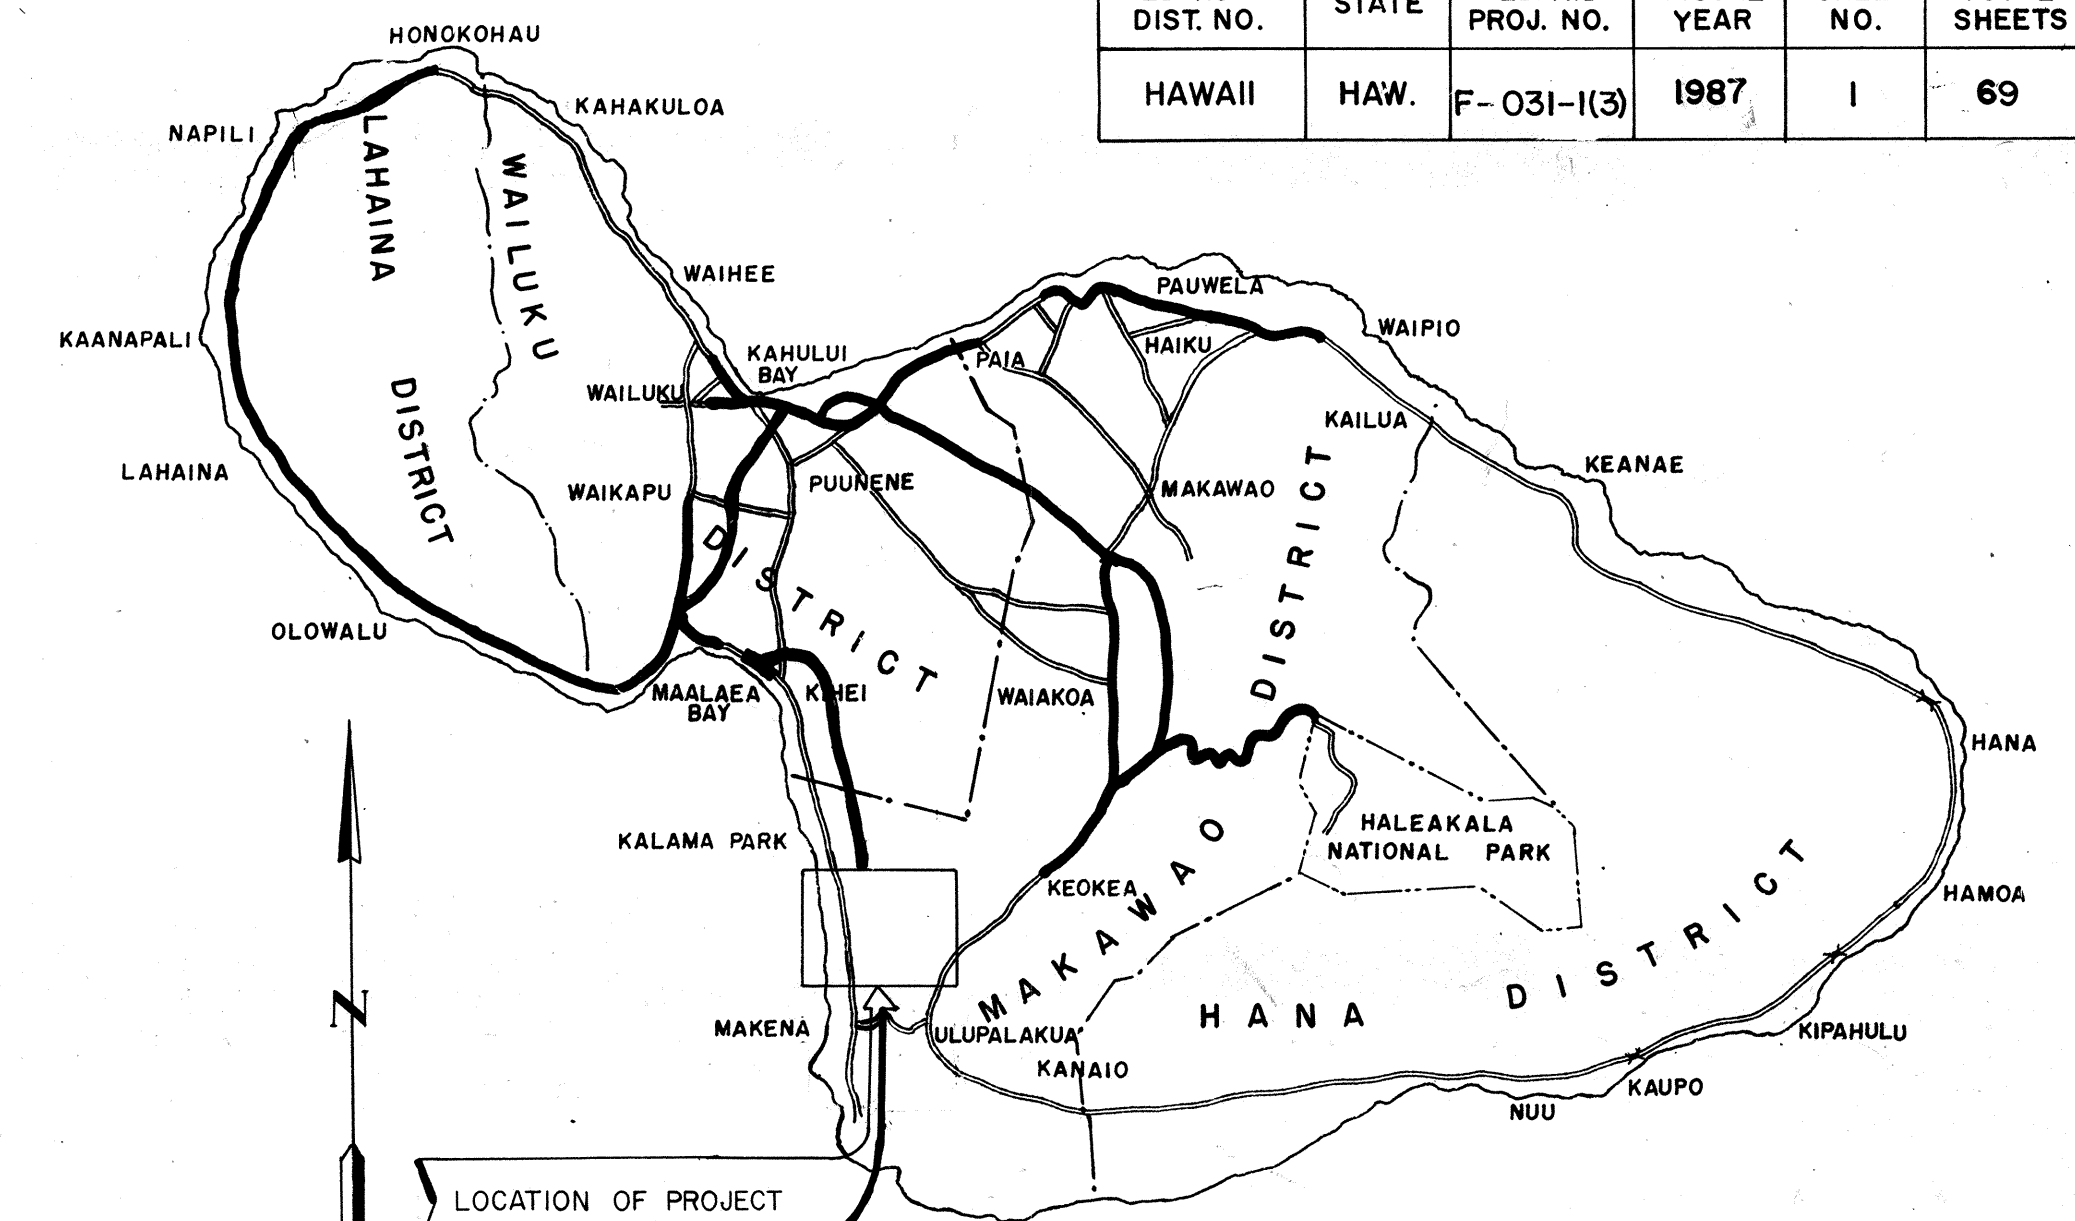

LOCATION MAP

— FEDERAL AID PROJECTS PREVIOUSLY CONSTRUCTED OR UNDER CONSTRUCTION

DESIGN DESIGNATION

ADT(1987) 4800
ADT(2007) 17500
DHV 1600 (K=9.0)
D 70/30
T 3%
T₂₄ 6%
V 50 MPH

GROSS LENGTH OF PROJECT 1.5 MILES
ROADWAY LENGTH 1.2 MILES

ALL CHANGES MADE DURING CONSTRUCTION HAVE BEEN
NOTED IN RED ON THESE TRACINGS AND CHECKED BY

Michael Lanning 3-31-98
RESIDENT ENGINEER DATE

DEPARTMENT OF TRANSPORTATION
FEDERAL HIGHWAY ADMINISTRATION
APPROVED: *Michael Lanning* 8/8/88
DIVISION ADMINISTRATOR DATE

DEPARTMENT OF TRANSPORTATION
STATE OF HAWAII
APPROVED: *Edward J. Hata* 12/1/87
DIR. OF TRANSPORTATION DATE