	INDEX TO DRAWINGS
SHEET NO.	DESCRIPTION
1	TITLE SHEET
2	STANDARD PLANS SUMMARY
3	ROADWAY INTERSECTION PLAN
4	TRAFFIC LEGEND, DETAILS & NOTES
5	PAVEMENT MARKING & SIGNING PLAN
6	TRAFFIC SIGNAL LEGEND, DETAILS, & NOTES
7	TRAFFIC SIGNAL PLAN
8	SWING SIGN BRACKET DETAIL
9	LOOP DETECTOR DETAIL

STATE OF HAWAII

DEPARTMENT OF TRANSPORTATION

HIGHWAYS DIVISION
HONOLULU, HAWAII


"AS-BUILT"

PLANS FOR

PIILANI HIGHWAY

INTERSECTION IMPROVEMENTS AT LIPOA STREET PROJECT NO. 31B-01-94

DISTRICT OF KIHEI ISLAND OF MAUI

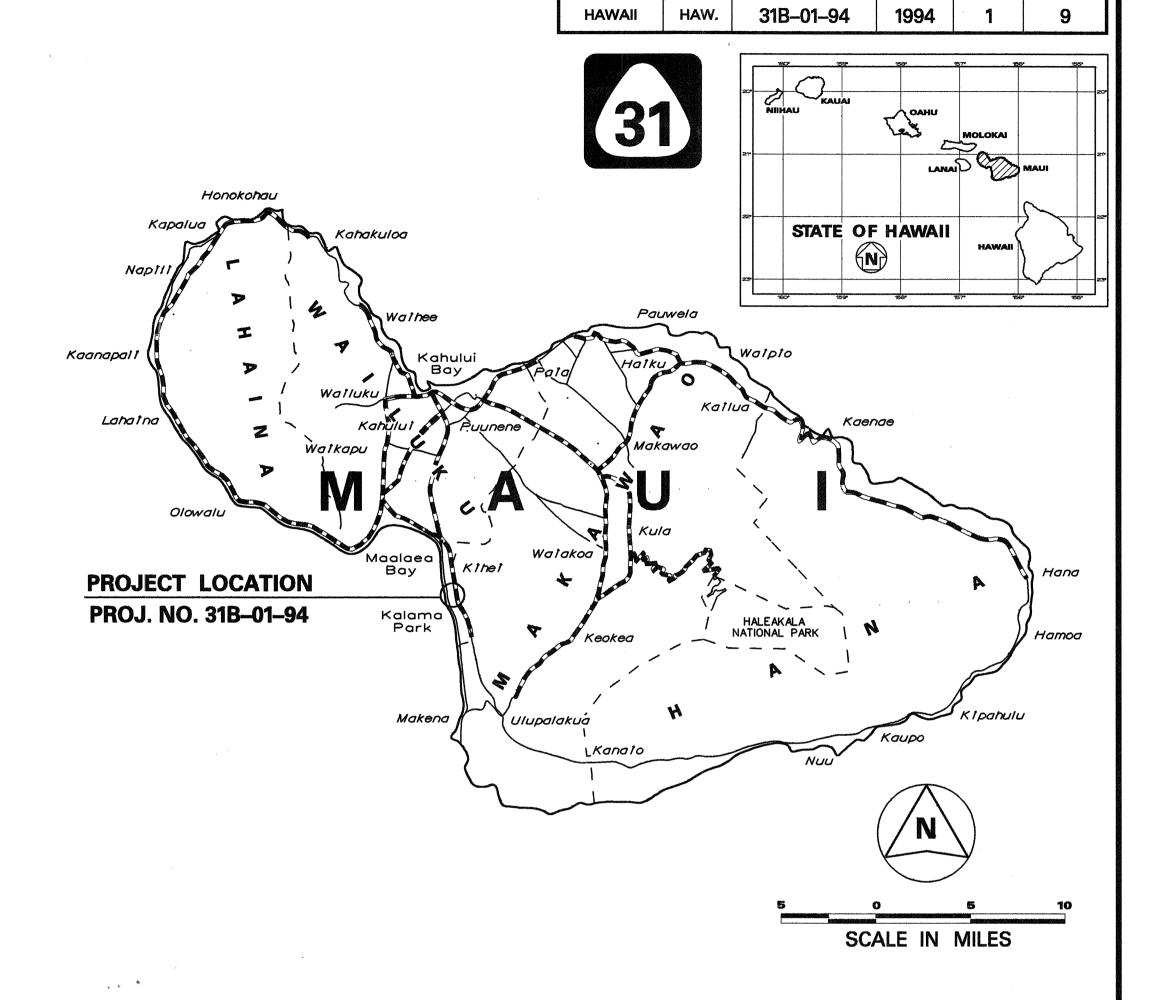

FEDERAL AID PROJECTS PREVIOUSLY CONSTRUCTED OR UNDER CONSTRUCTION

FISCAL SHEET YEAR NO.

MILE POST 2.77 TO MILE POST 2.87

CHANGES MADE DURING CONSTRUCTION HAVE
BEEN INCORPORATED ON THESE PLANS EXCEPT
CHANGES IN THE ORIGINAL THEORETICAL
QUANTITIES. FOR ACTUAL QUANTITIES REFER TO
PROJECT LEDGER AND/OR COMPUTATION BOOK,

RESIDENT ENGINEER 10/30/96.

DEPARTMENT OF TRANSPORTATION STATE OF HAWAII		
APPROVED:		
Stamo	3/1/74	
DIR. OF TRANSPORTATION	DATE	

